


[illegible]

FED. ROAD DIST. NO.	STATE	PROJ. NO.	FISCAL YEAR	SHEET NO.	TOTAL SHEET
HAWAII	HAW.	63A-01-75M	1975	1	10

RESIDENT ENGINEER

DEPARTMENT OF TRANSPORTATION  
STATE OF HAWAII

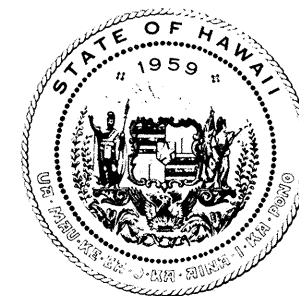

STATE OF HAWAII

DEPARTMENT OF TRANSPORTATION  
HIGHWAYS DIVISION

HONOLULU, HAWAII

"AS-BUILT"

PLANS FOR

LIKELIKE HIGHWAY RESURFACING

VICINITY OF KULA KOLEA DR. TO OLD FOREST RESERVE BOUNDARY

PROJECT NO. 63A-01-75M

DISTRICT OF HONOLULU  
ISLAND OF OAHU

## LAYOUT PLAN

GROSS LENGTH OF PROJECT\_\_\_ 1.259 MI.  
NET LENGTH OF PROJECT\_\_\_ 1.259 MI.