




FED. ROAD DIST. NO.	STATE	PROJ. NO.	FISCAL YEAR	SHEET NO.	TOTAL SHEETS
HAWAII	HAW.	63A-01-75M	1975	2	10

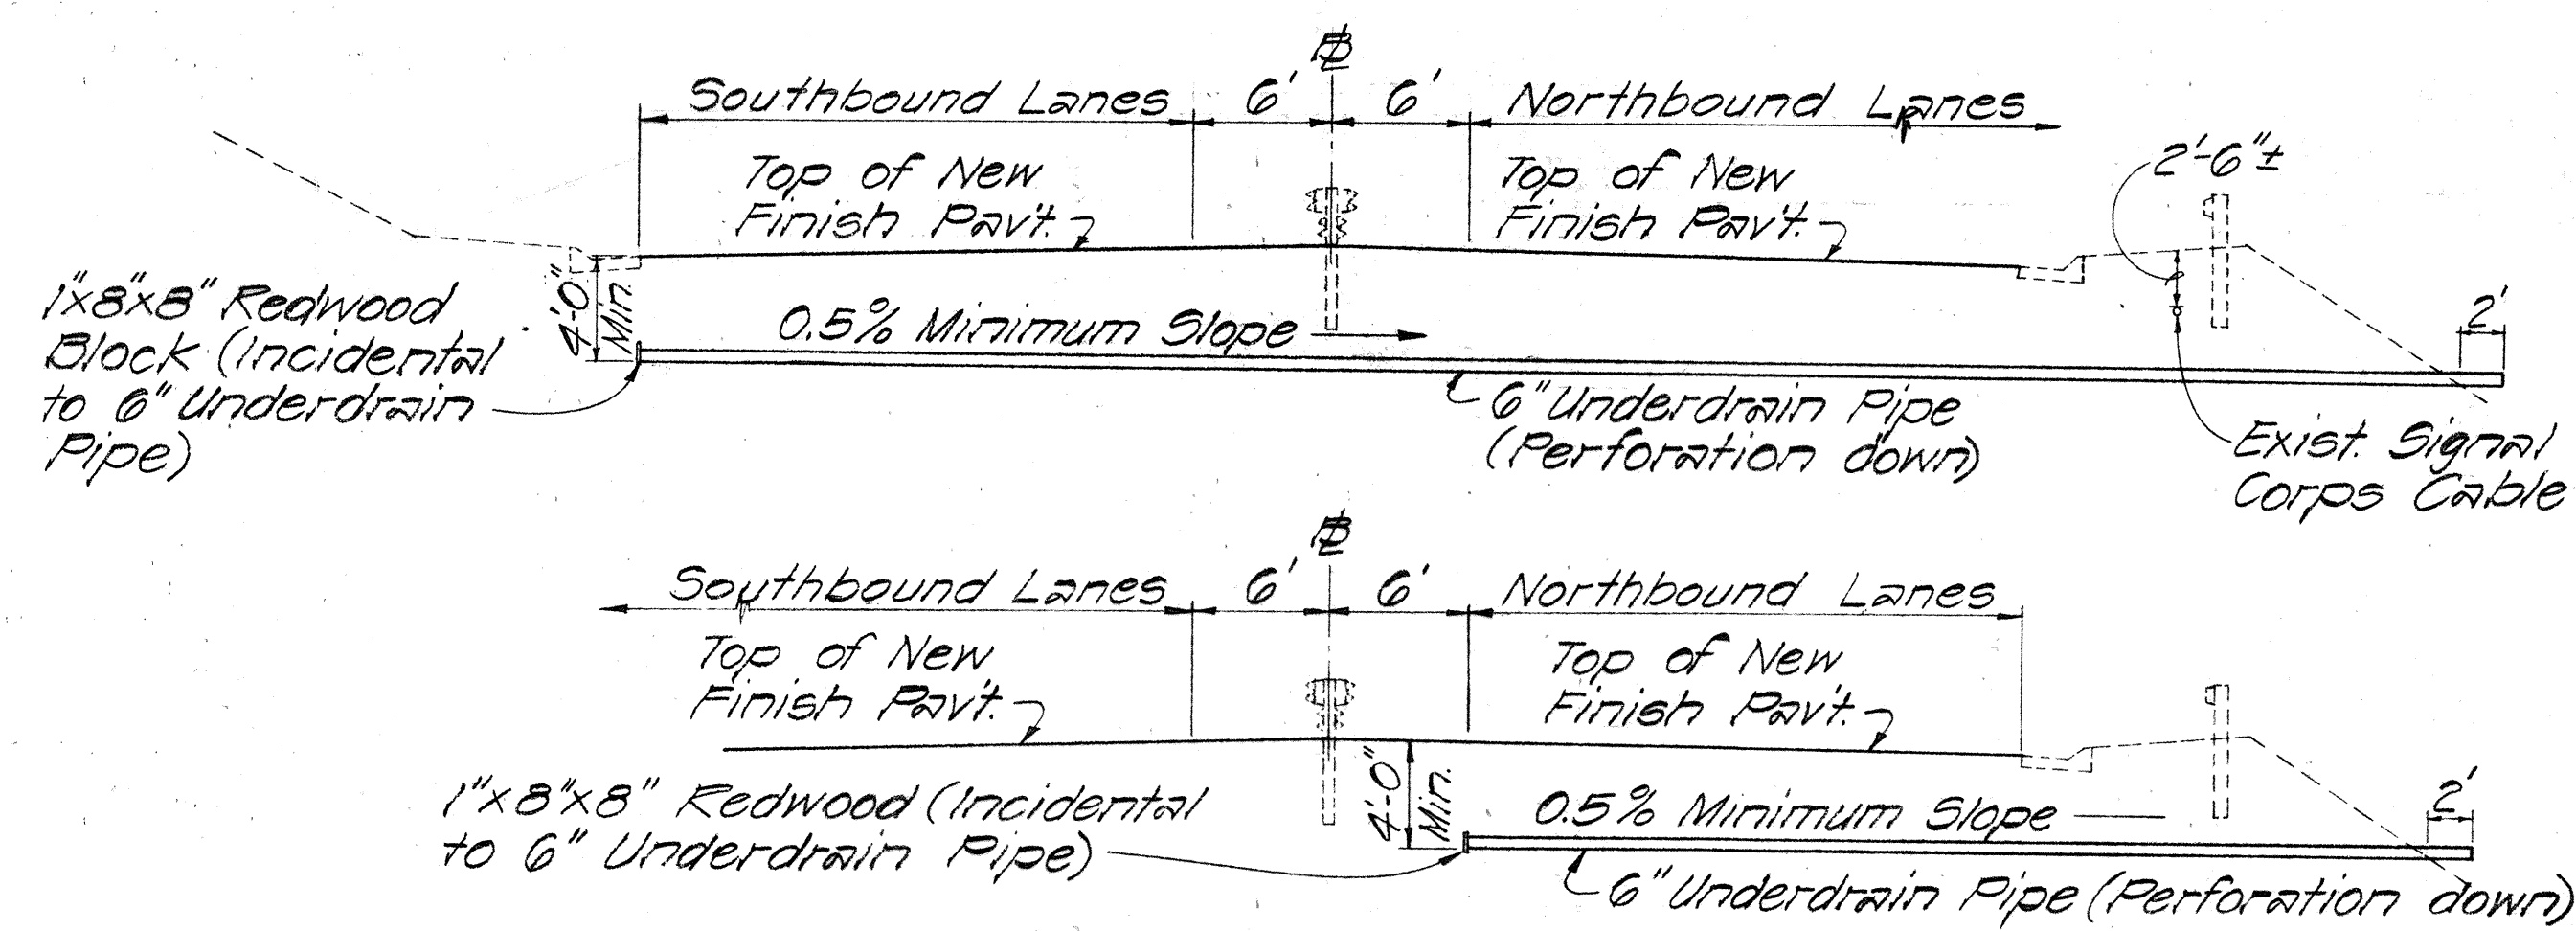


TYPICAL UNDERDRAIN DETAILS
Scale: 1/8"=1'-0"

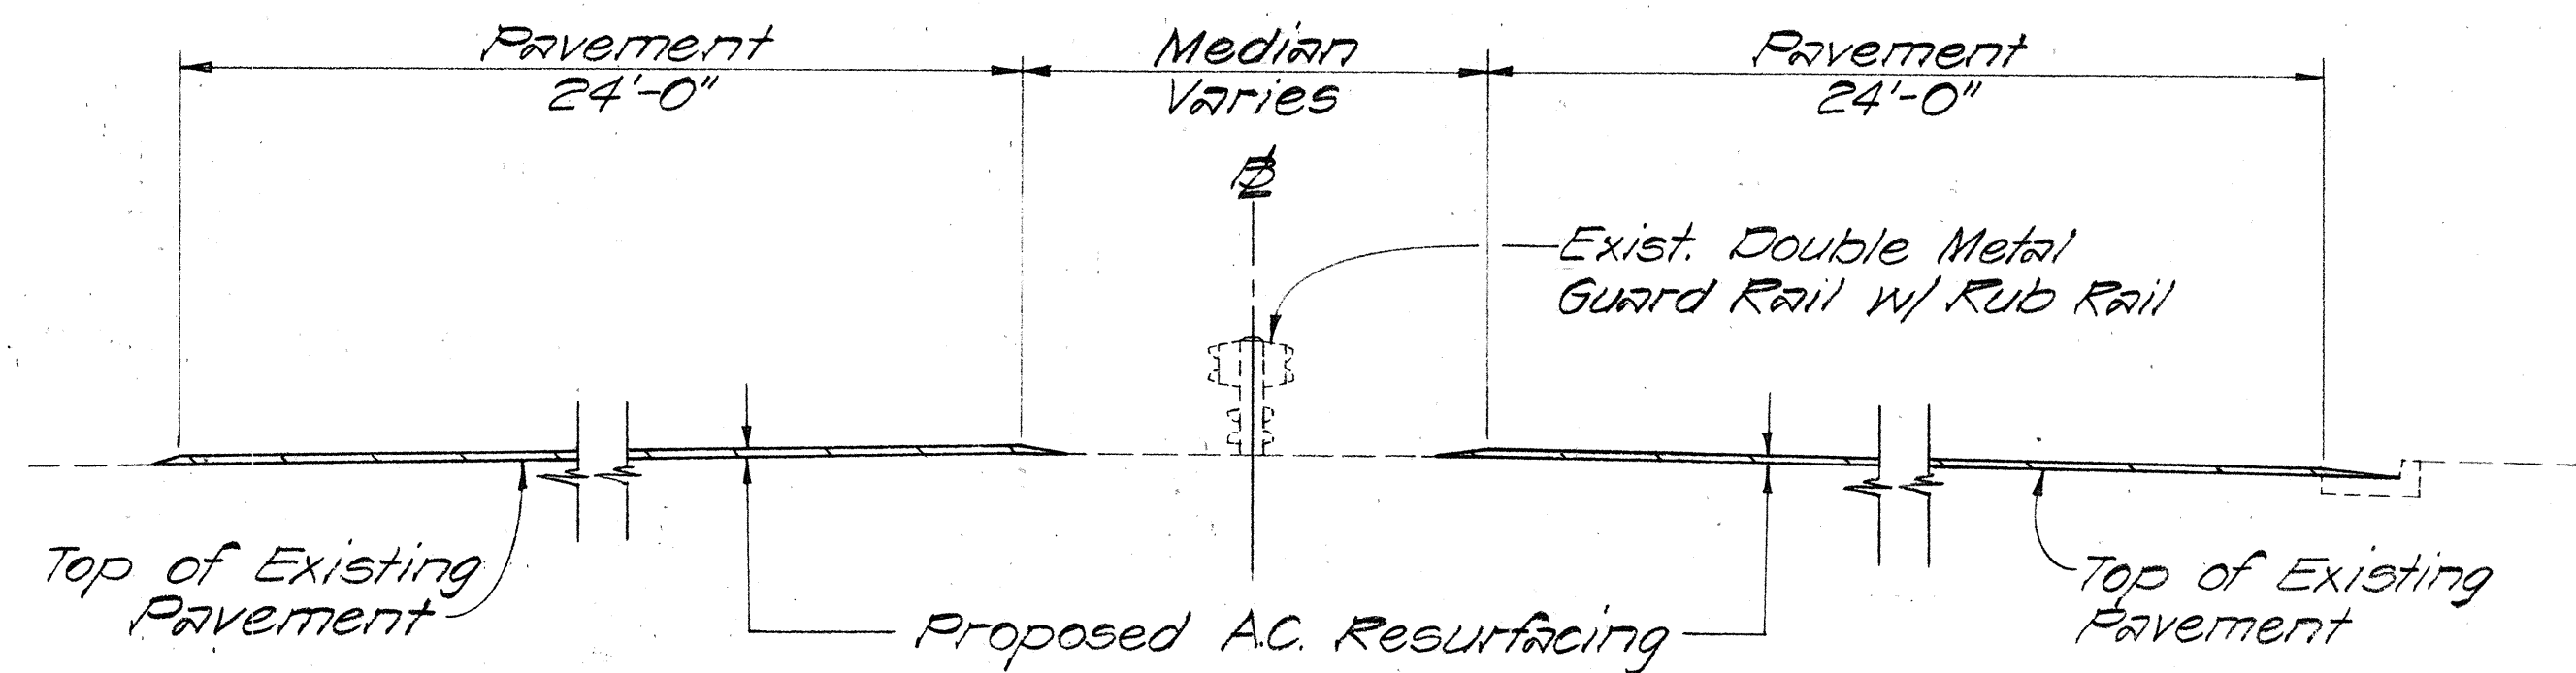


TYPICAL SECTION
Scale: 1"=1'-0"

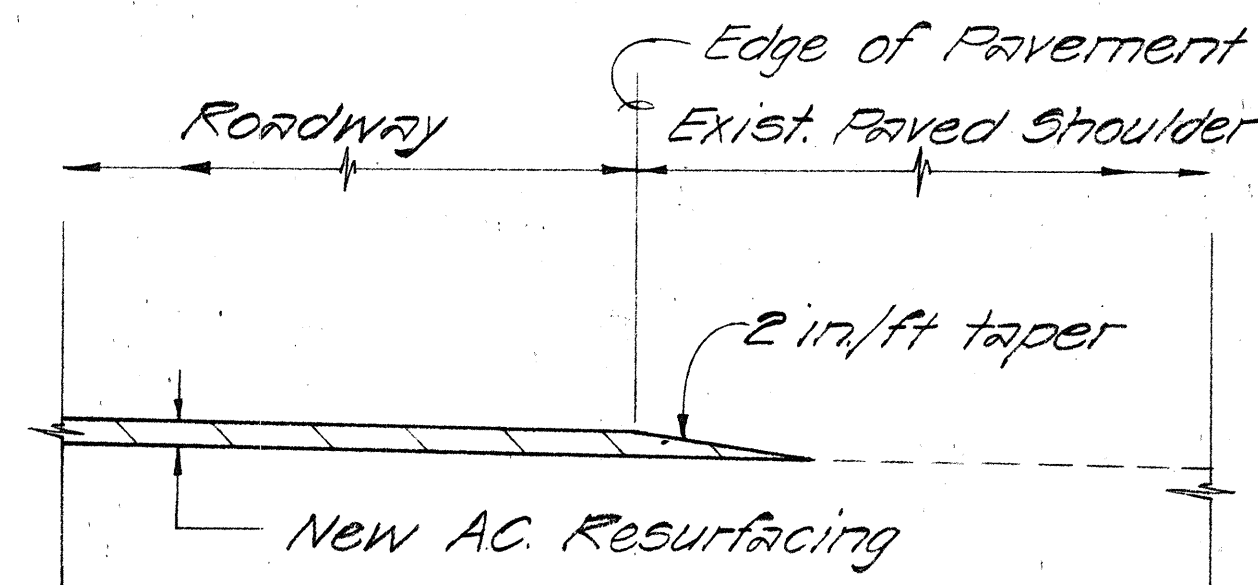

TYPICAL SECTION AT A.C. PAVED SHOULDER
Scale: 1"=1'-0"

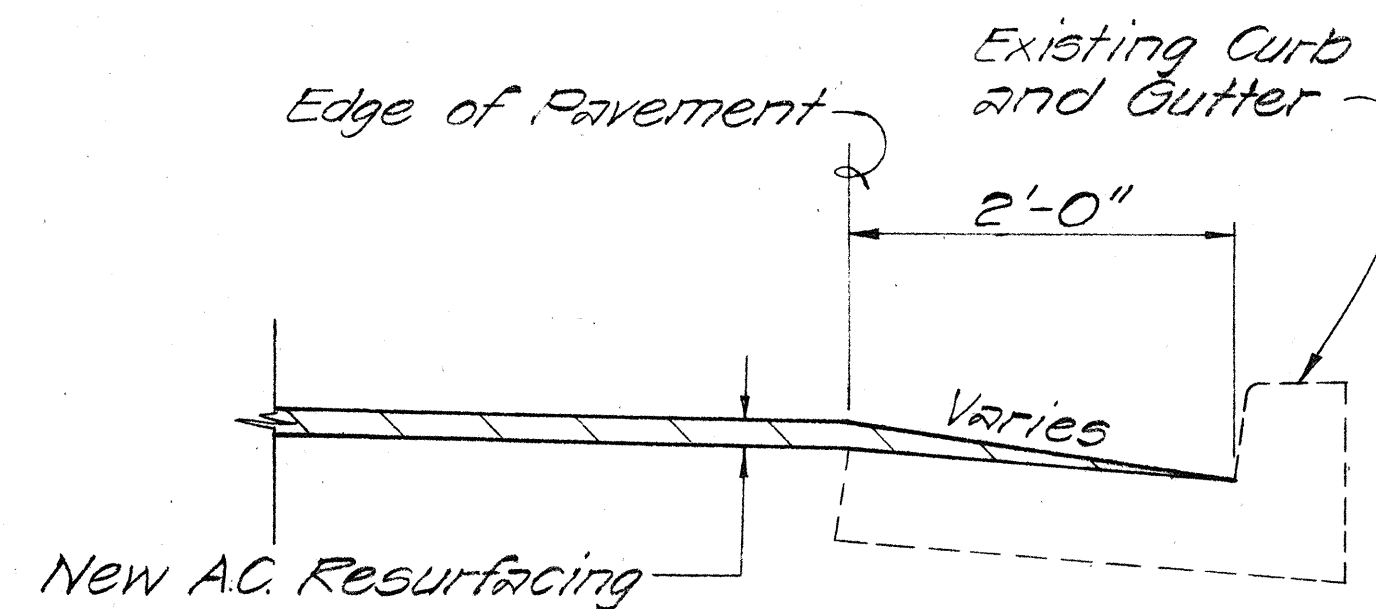


TYPICAL SECTION AT CURB AND GUTTER
Scale: 1"=1'-0"

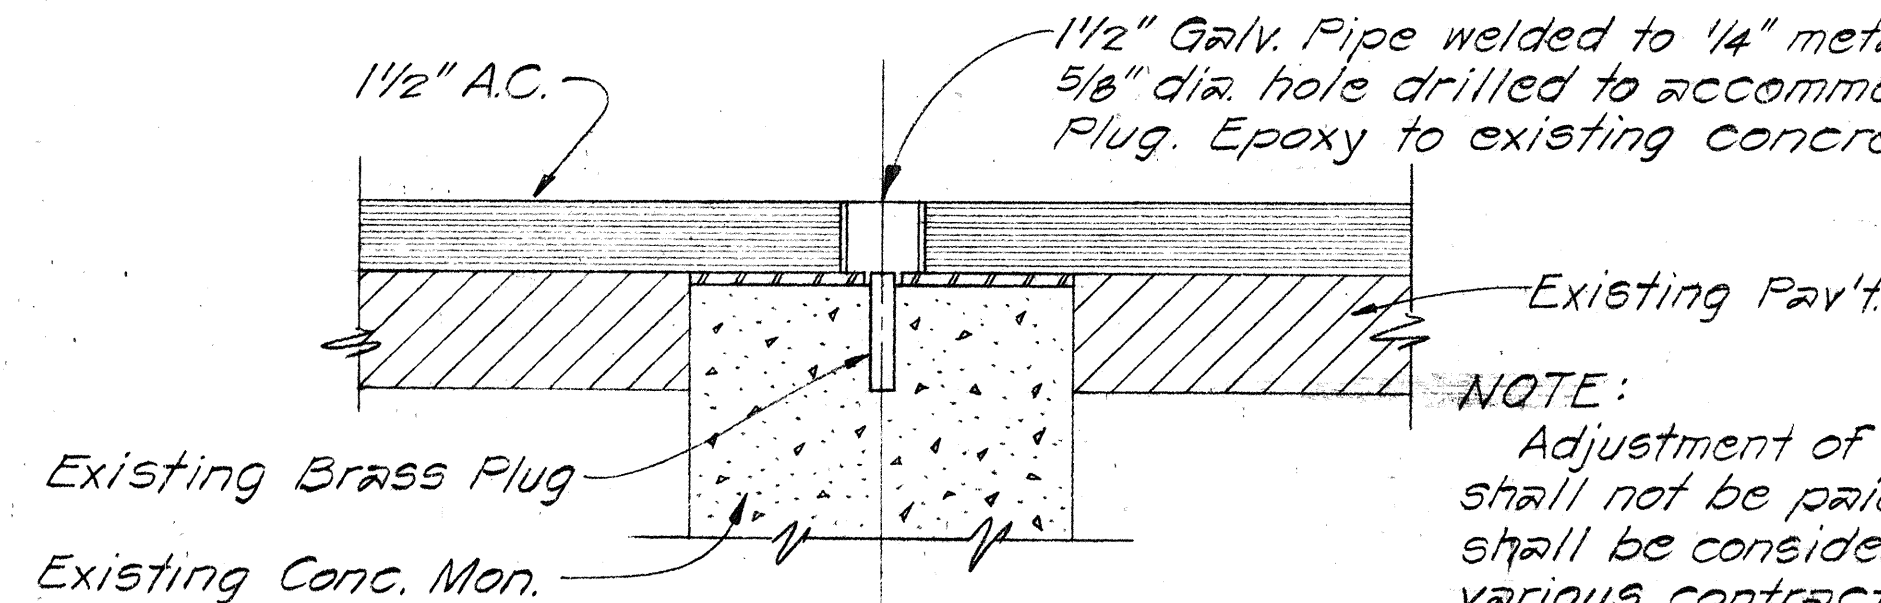


ADJUSTED MONUMENT
Scale: 3"=1'-0"

NOTE:
Adjustment of Centerline Monument shall not be paid for separately, but shall be considered incidental to the various contract items.

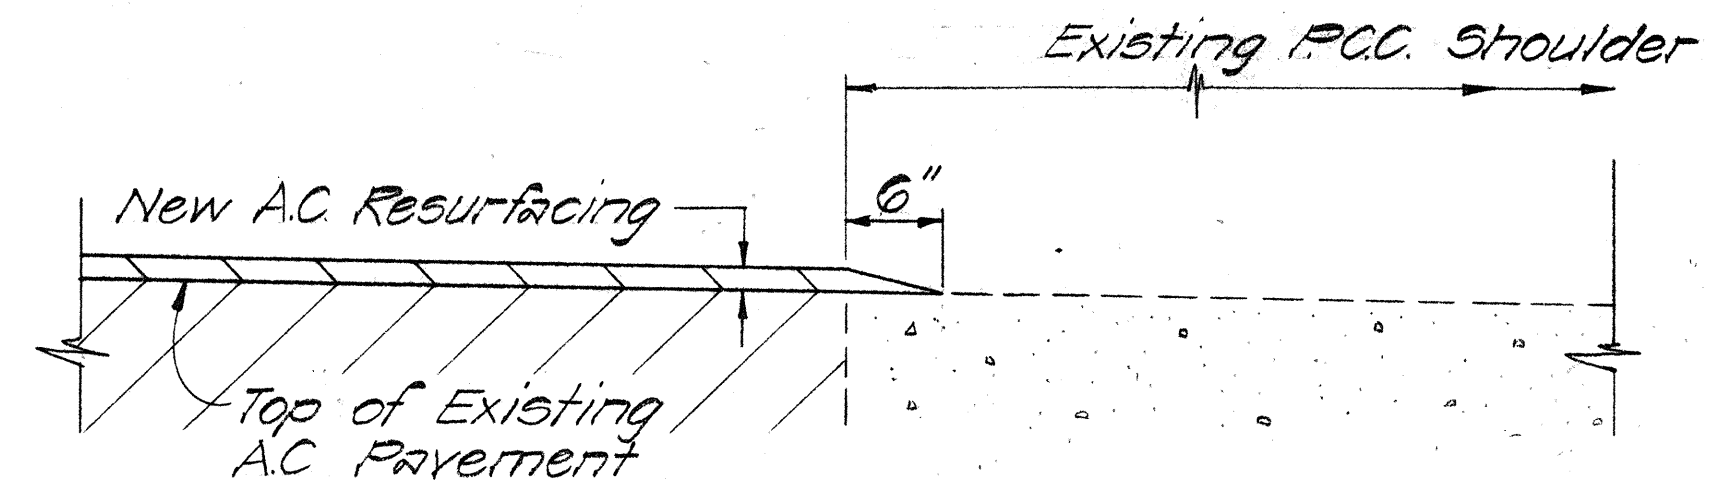


TYPICAL SECTION ALONG PCC SHOULDERS
Scale: 1"=1'-0"

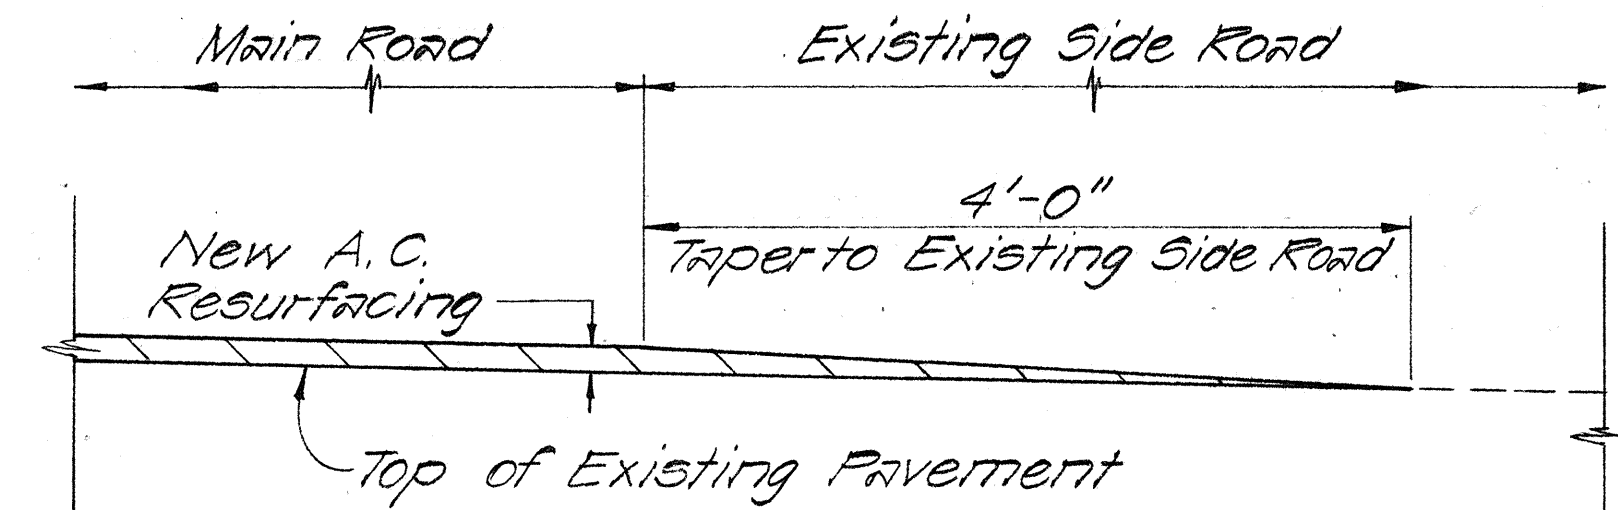

TYPICAL SECTION ~ SIDE ROAD CONNECTION
Scale: 1"=1'-0"


Fill exist. pavement depressions with a layer of leveling course of AC Pavt. Mix No. II

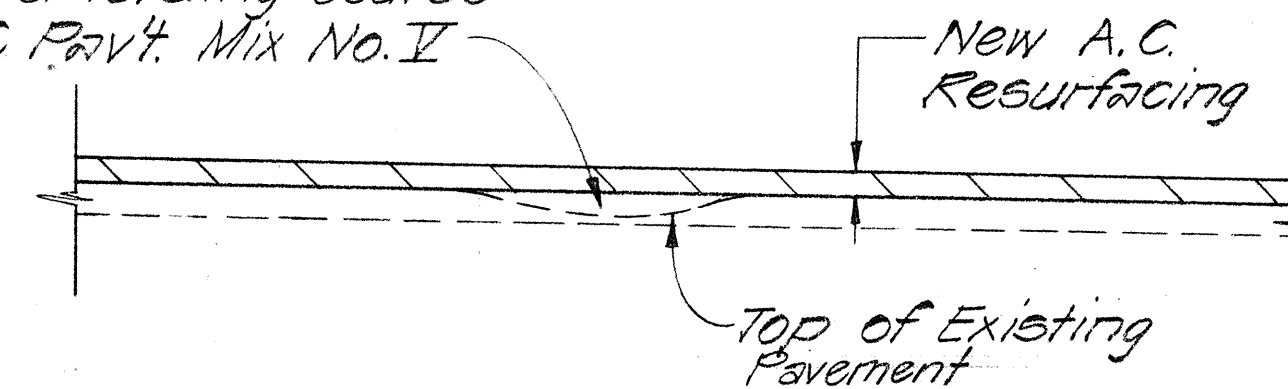

LEVELING COURSE DETAIL
Scale: 1"=1'-0"

NOTE
In the shoulders and medians, existing improvements above the Filter Material for underdrains shall be restored. All restoration work will not be measured and paid for separately, but will be considered incidental to the various contract items.

6 INCHES DIAMETER PERFORATED UNDERDRAIN
Scale: 1/2"=1'-0"

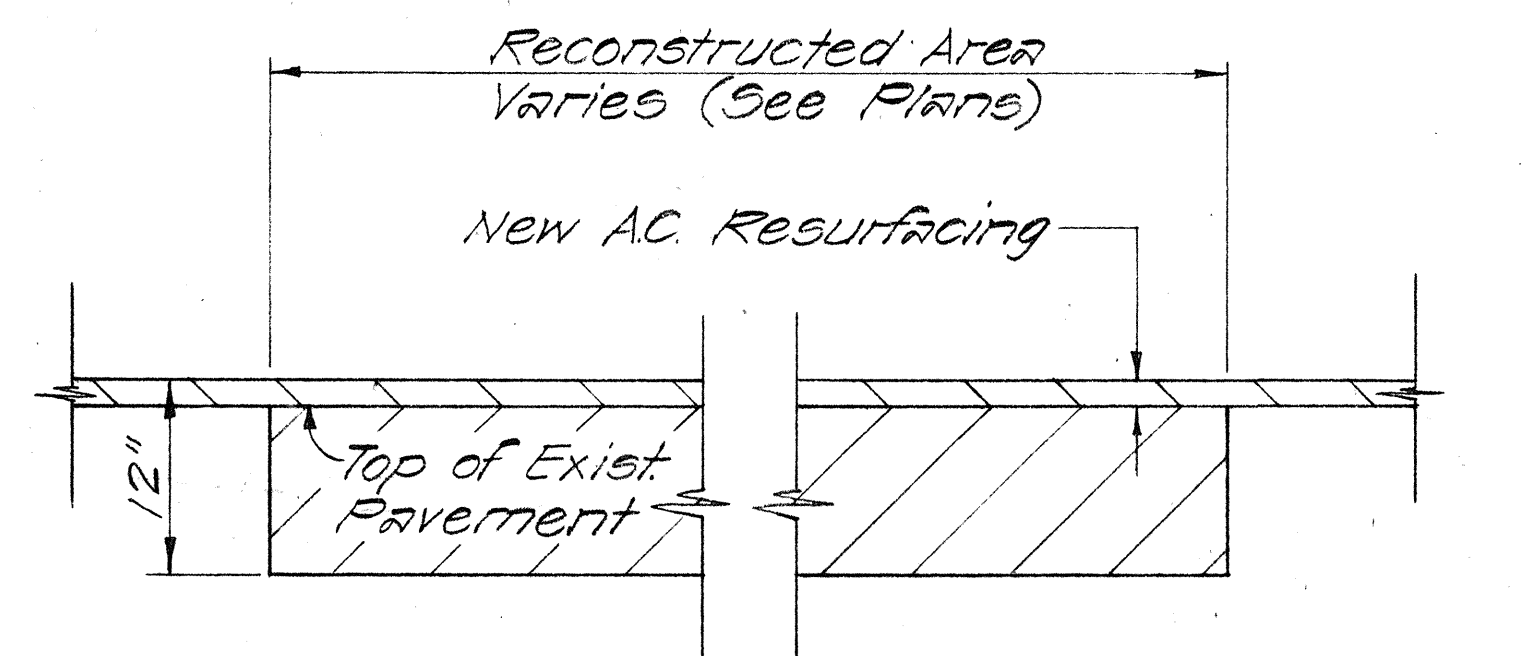

TYPICAL SECTION ~ RECONSTRUCTED AREA
Scale: 1"=1'-0"

STATE OF HAWAII DEPARTMENT OF TRANSPORTATION HIGHWAYS DIVISION
<u>TYPICAL SECTIONS AND GENERAL NOTES</u>
<u>LIKELIKE HWY. RESURFACING</u> <u>PROJECT NO. 63A-01-75M</u>
Scale: As Noted Date: Jan. 1975
SHEET NO. 1 OF 1 SHEETS