


FED. ROAD DIST. NO.	STATE	PROJ. NO.	FISCAL YEAR	SHEET NO.	TOTAL SHEETS
HAWAII	HAW.	63A-01-76M	1976	2	19

GENERAL NOTES

- Only the hatched area shown on the plan sheets shall be resurfaced.
- Provide smooth transition at connections to existing pavement.
- Ruts on the existing roadway pavement shall be filled with a thin layer of leveling course Mix No. I prior to resurfacing.
- The exact limits of the reconstructed areas shall be determined in the field by the Engineer.
- The bidders attention is directed to Sub-section 104-09, Availability of Funds of the Special Provisions.
- The A.C. overlay thickness shall be 1 1/2" unless otherwise directed by the Engineer, except at Ramp K-6 which shall be 2".
- The Contractor shall not pave over the backfilled trenches of the underdrain pipes for a minimum of 21 calendar days.
- Frame and Cover of existing C & C Monuments shall be raised to new grade. This work shall be considered incidental to the various contract items and no separate payment shall be made thereof.
- Existing Centerline Monuments shall be adjusted as shown on this sheet.


NOTE
In the shoulders and medians, existing improvements above the Filter Material for underdrains shall be restored. All restoration work will not be measured and paid for separately, but will be considered incidental to the various contract items.

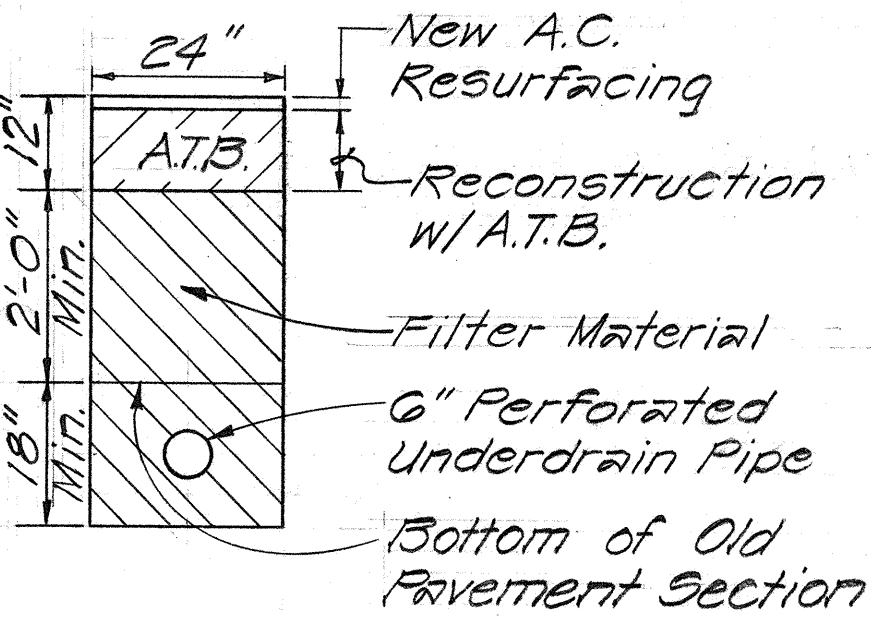


6 INCHES DIAMETER PERFORATED UNDERDRAIN
Scale: 1/2"=1'-0"

STATE OF HAWAII DEPARTMENT OF TRANSPORTATION HIGHWAYS DIVISION	
TYPICAL SECTIONS AND GENERAL NOTES	
LIKELIKE HWY. RESURFACING PROJECT NO. 63A-01-76M	
Scale: As Noted	Date: July, 1975
SHEET NO. 1 OF 1 SHEETS	

* 1'-0" at P.C.C. Pavement
6" at P.C.C. Shoulders

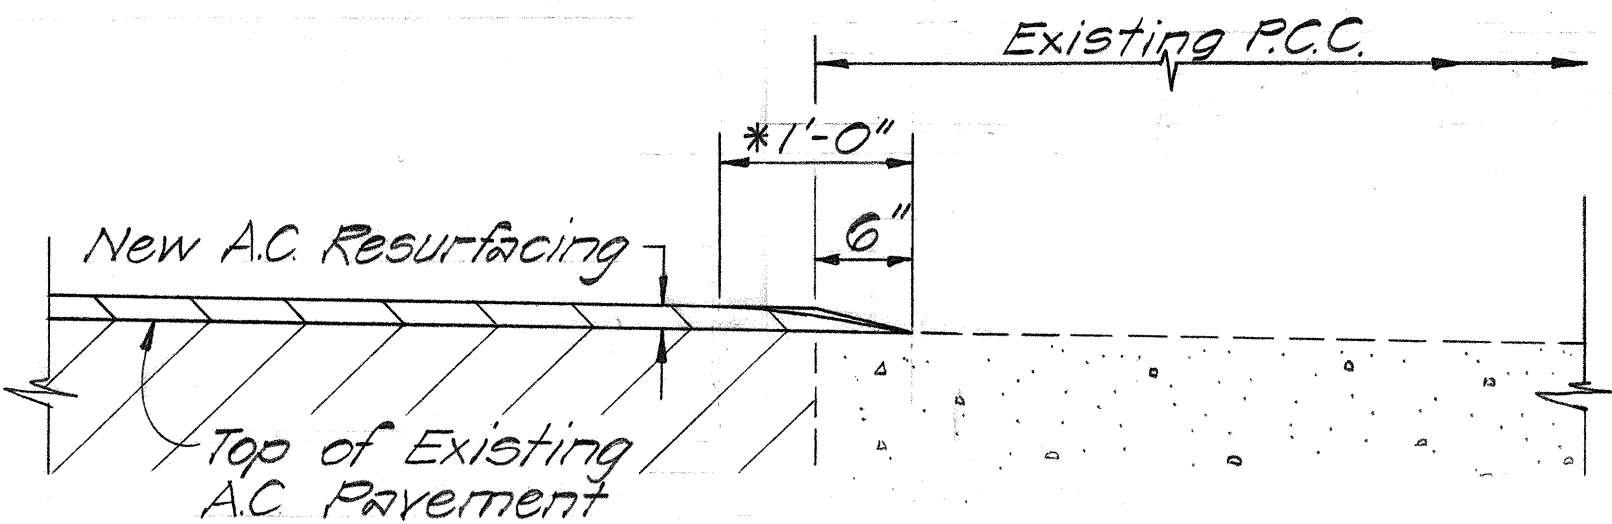


TYPICAL SECTION ALONG P.C.C. SHOULDERS & PAVEMENT
Scale: 1"=1'-0"

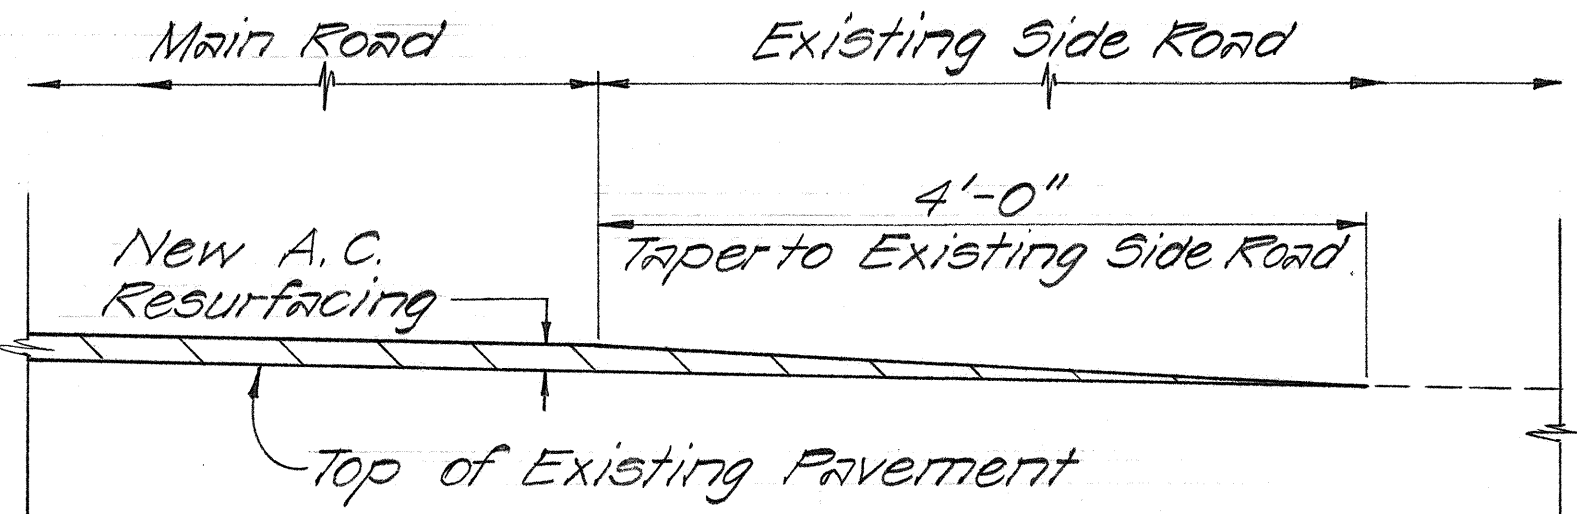


TYPICAL SECTION ~ SIDE ROAD CONNECTION
Scale: 1"=1'-0"


Fill exist. pavement depressions with a layer of leveling course of A.C. Pavt. Mix No. I

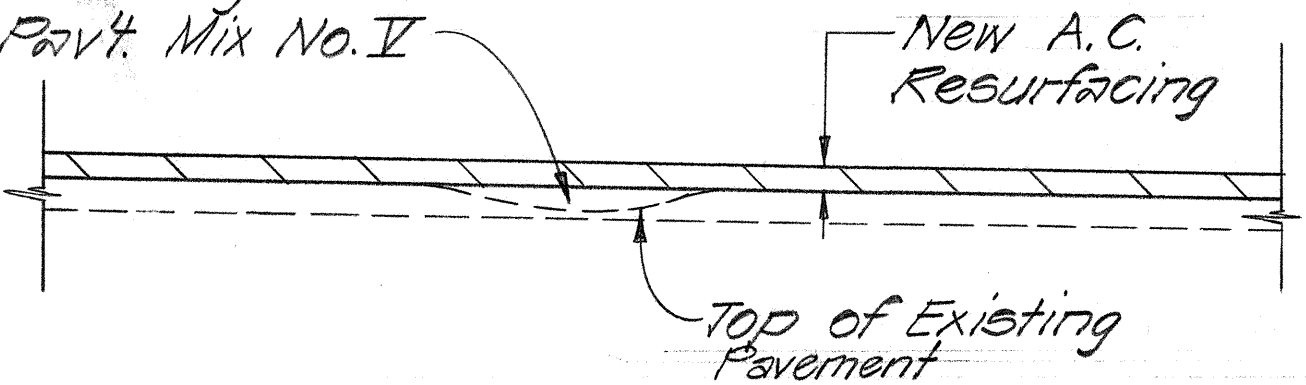


LEVELING COURSE DETAIL
Scale: 1"=1'-0"

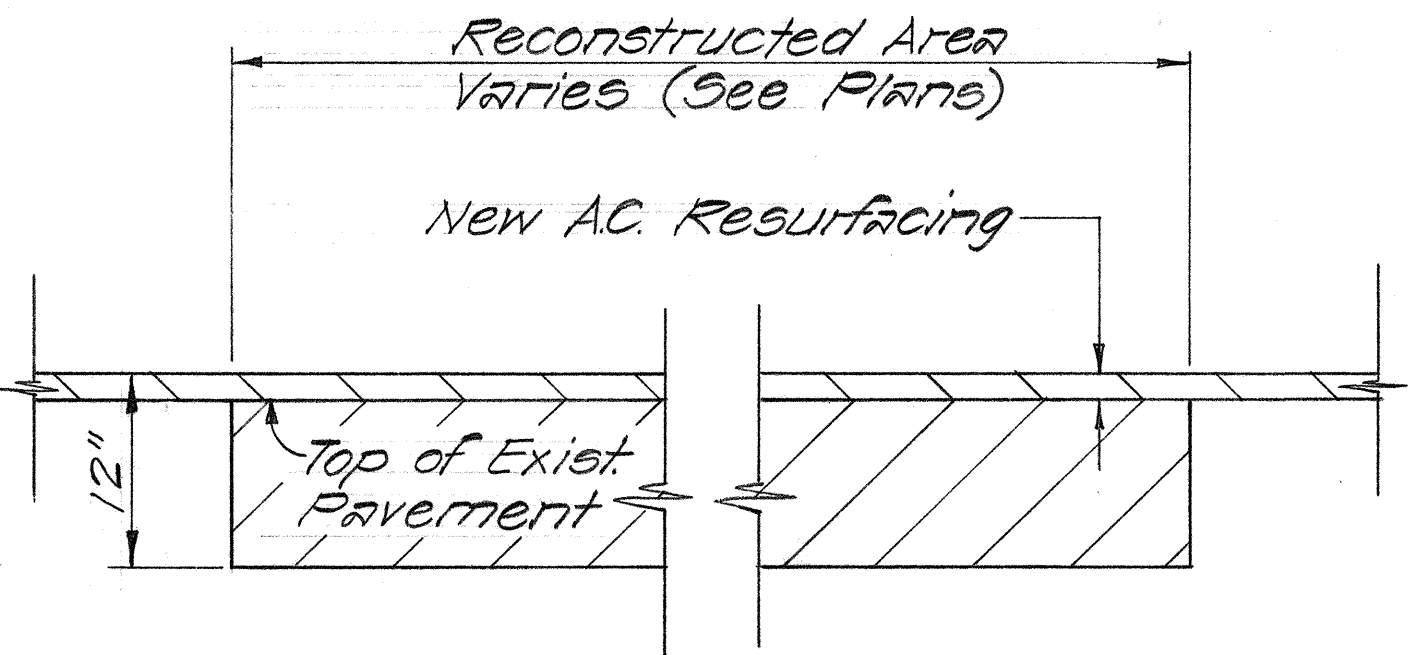


TYPICAL SECTION ~ RECONSTRUCTED AREA
Scale: 1"=1'-0"

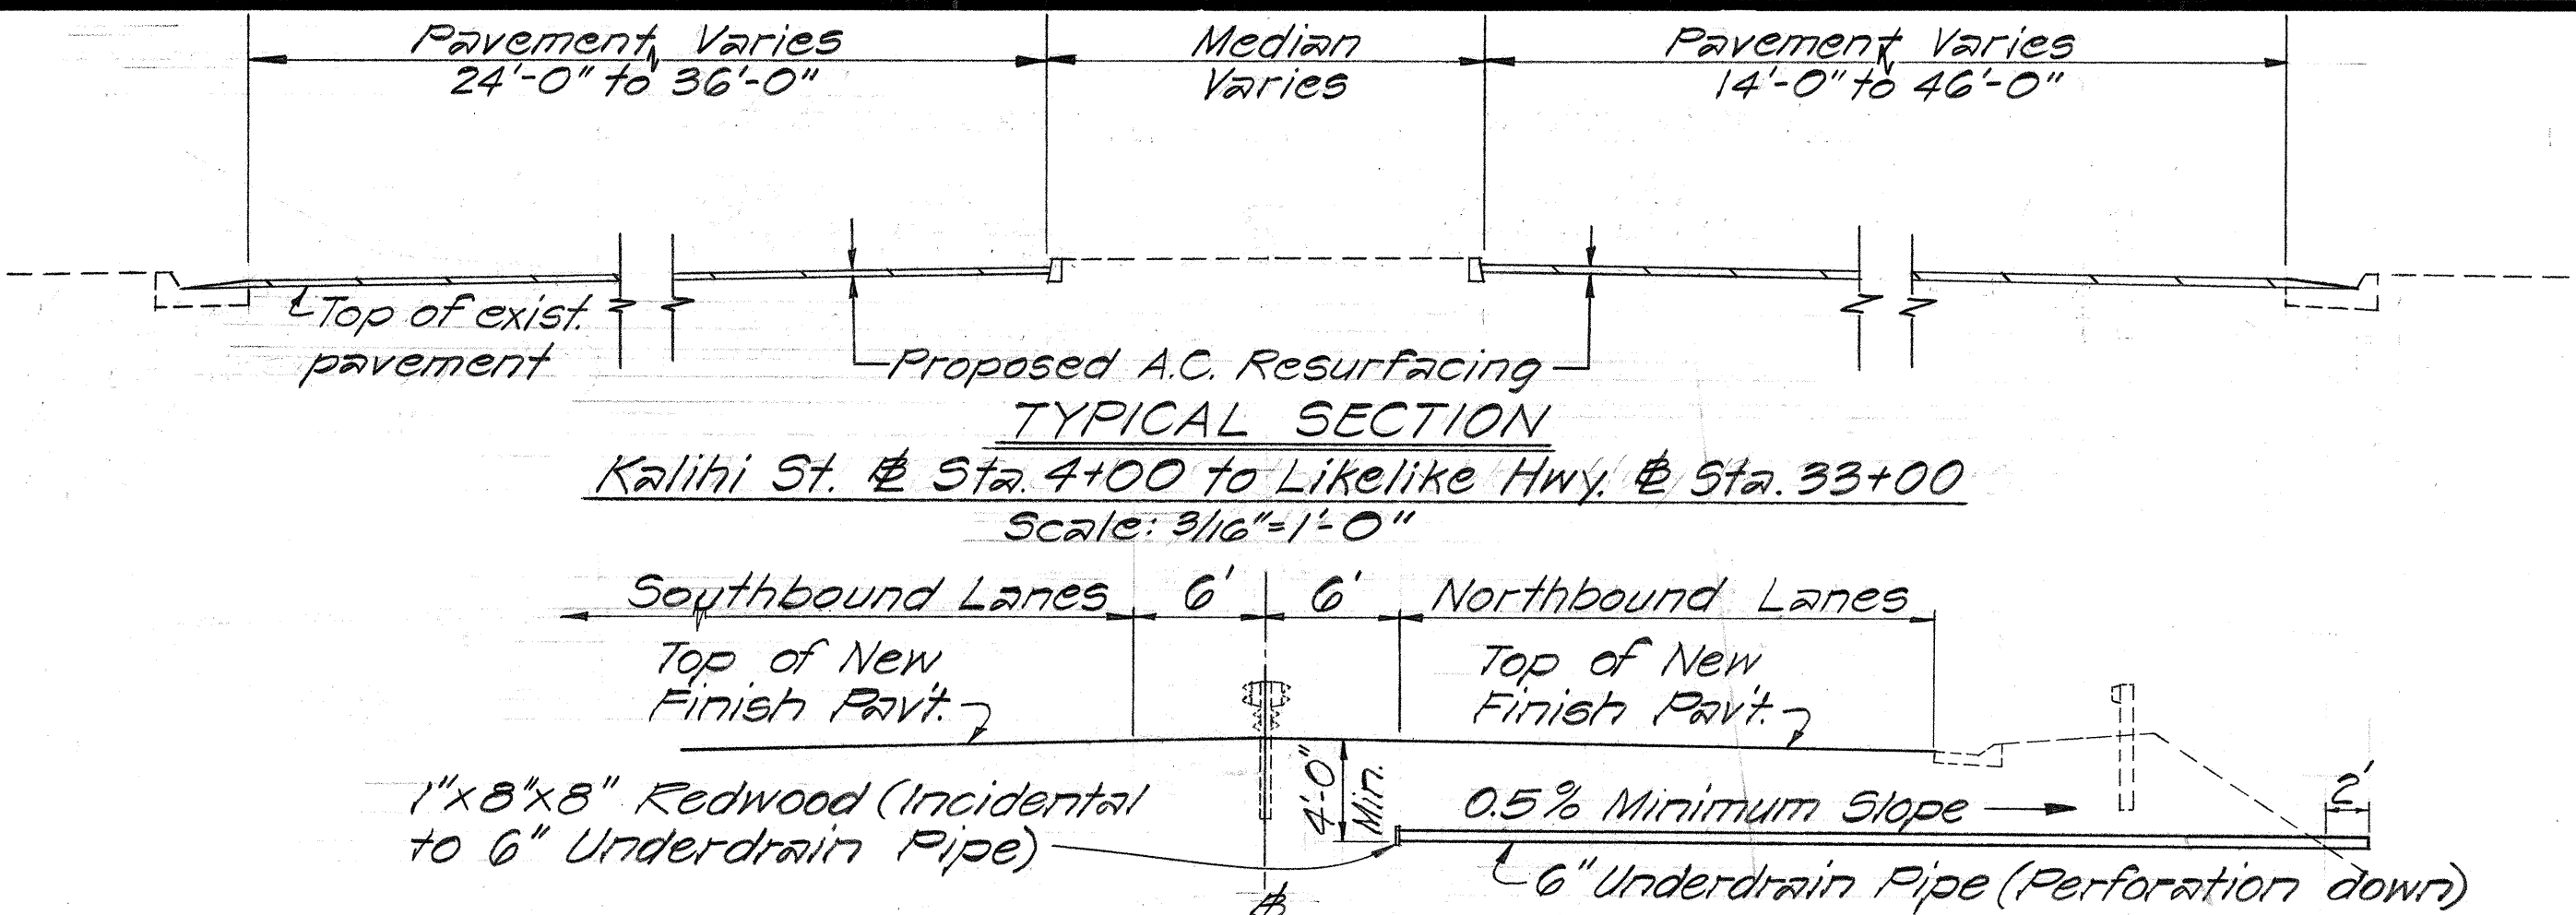


TYPICAL UNDERDRAIN DETAILS
Scale: 1/8"=1'-0"

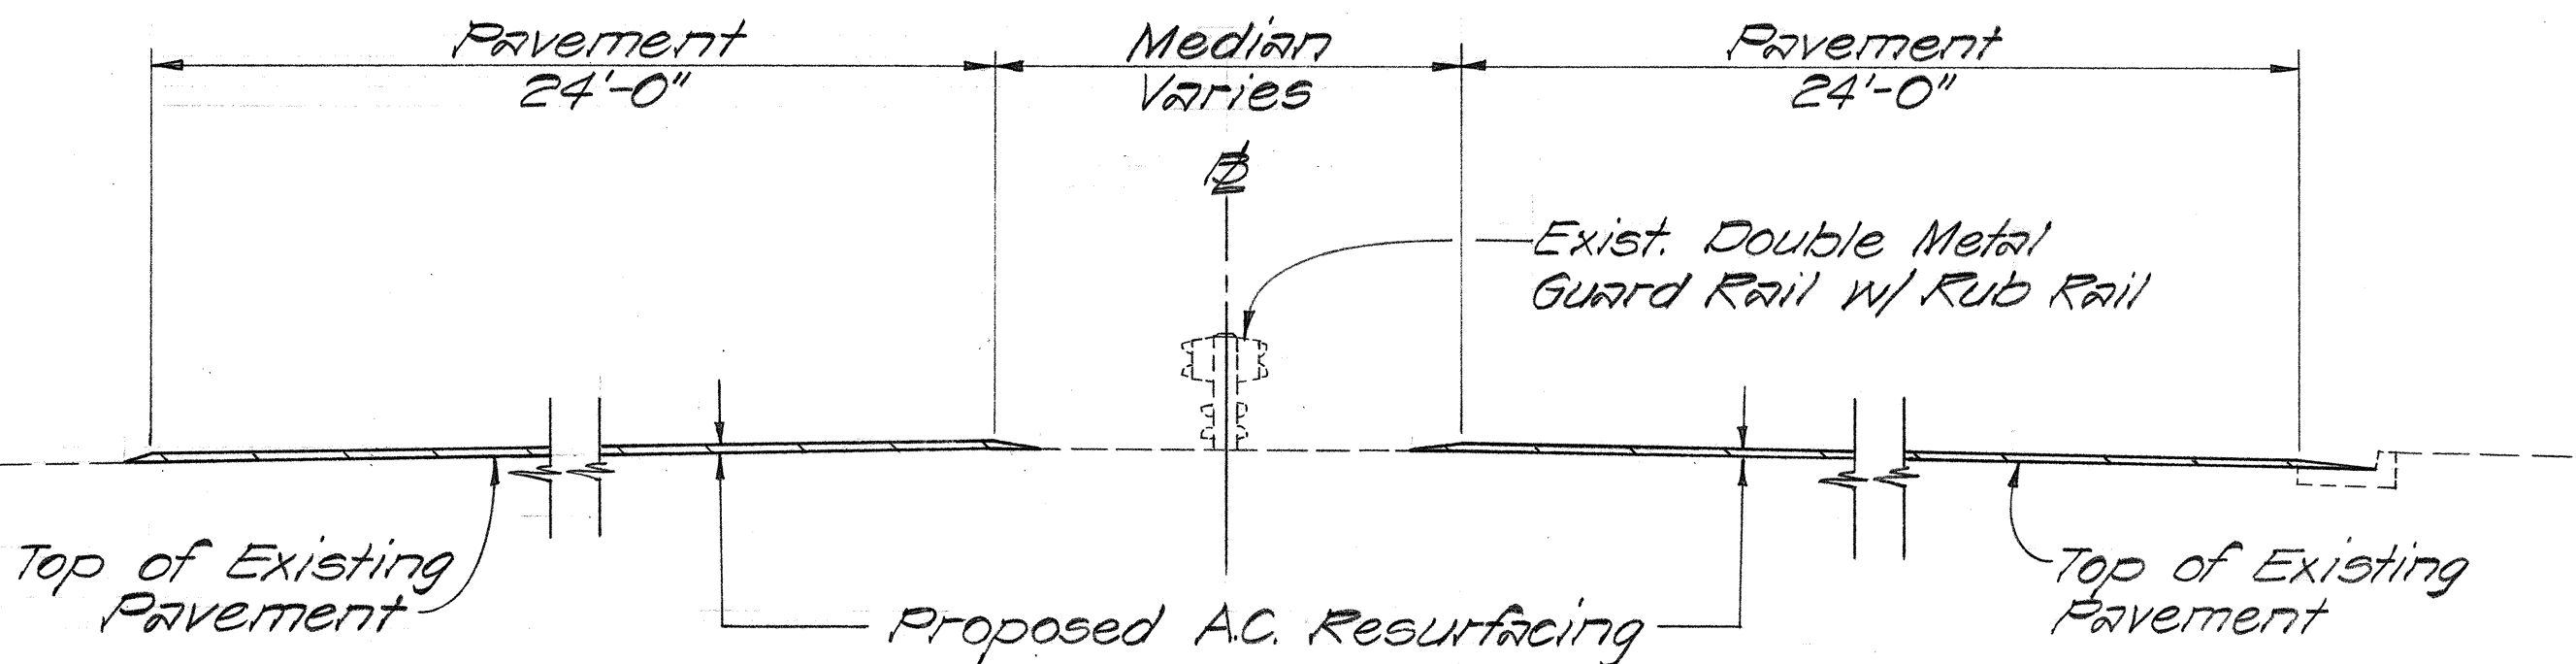


TYPICAL SECTION
Likelike Hwy. Sta. 33+00 to Likelike Hwy. Sta. 75+00
Scale: 3/16"=1'-0"

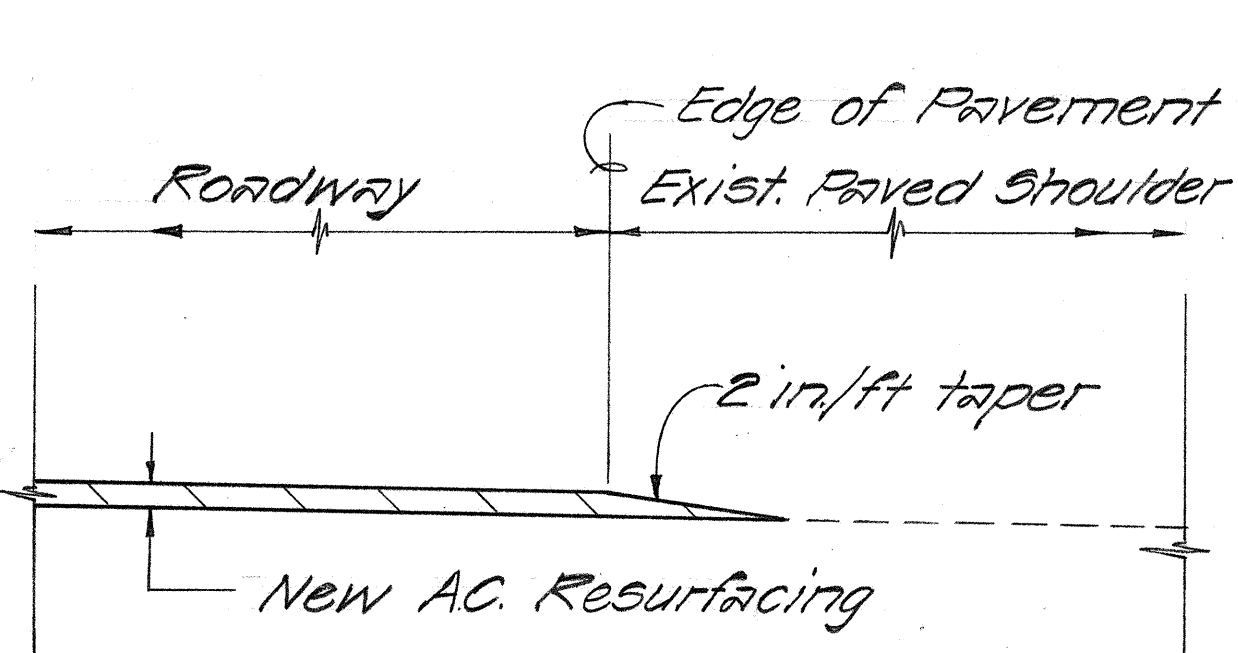

TYPICAL SECTION AT A.C. PAVED SHOULDER
Scale: 1"=1'-0"

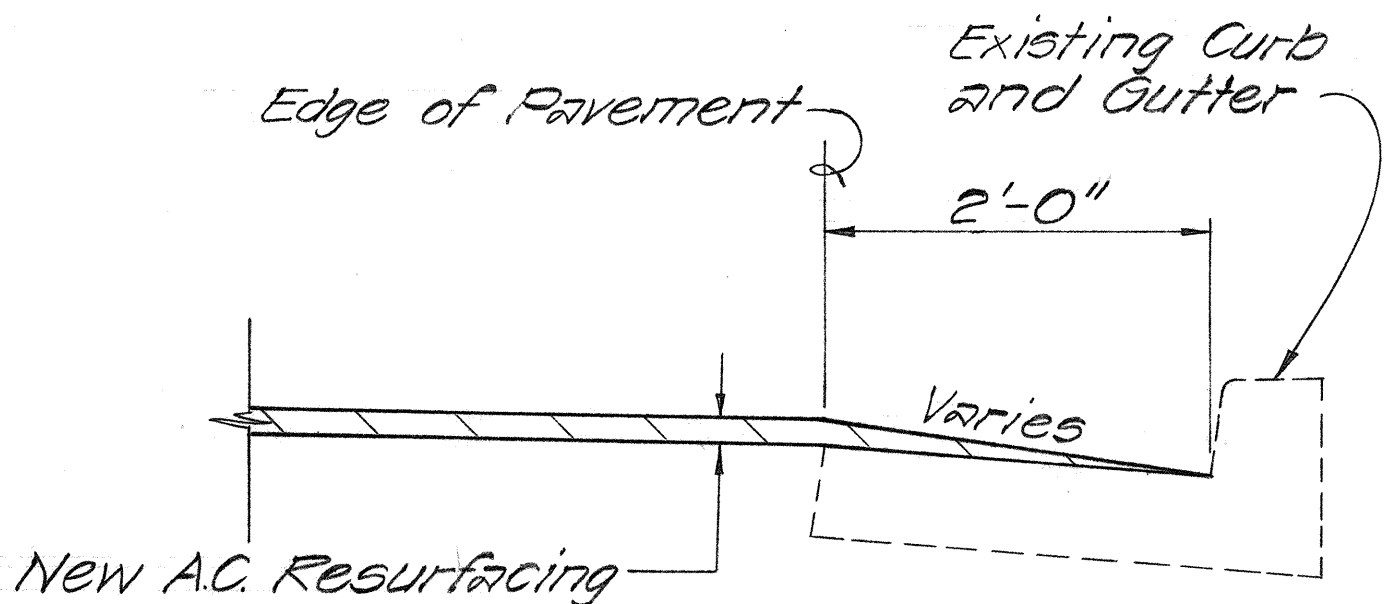

TYPICAL SECTION AT CURB AND GUTTER
Scale: 1"=1'-0"

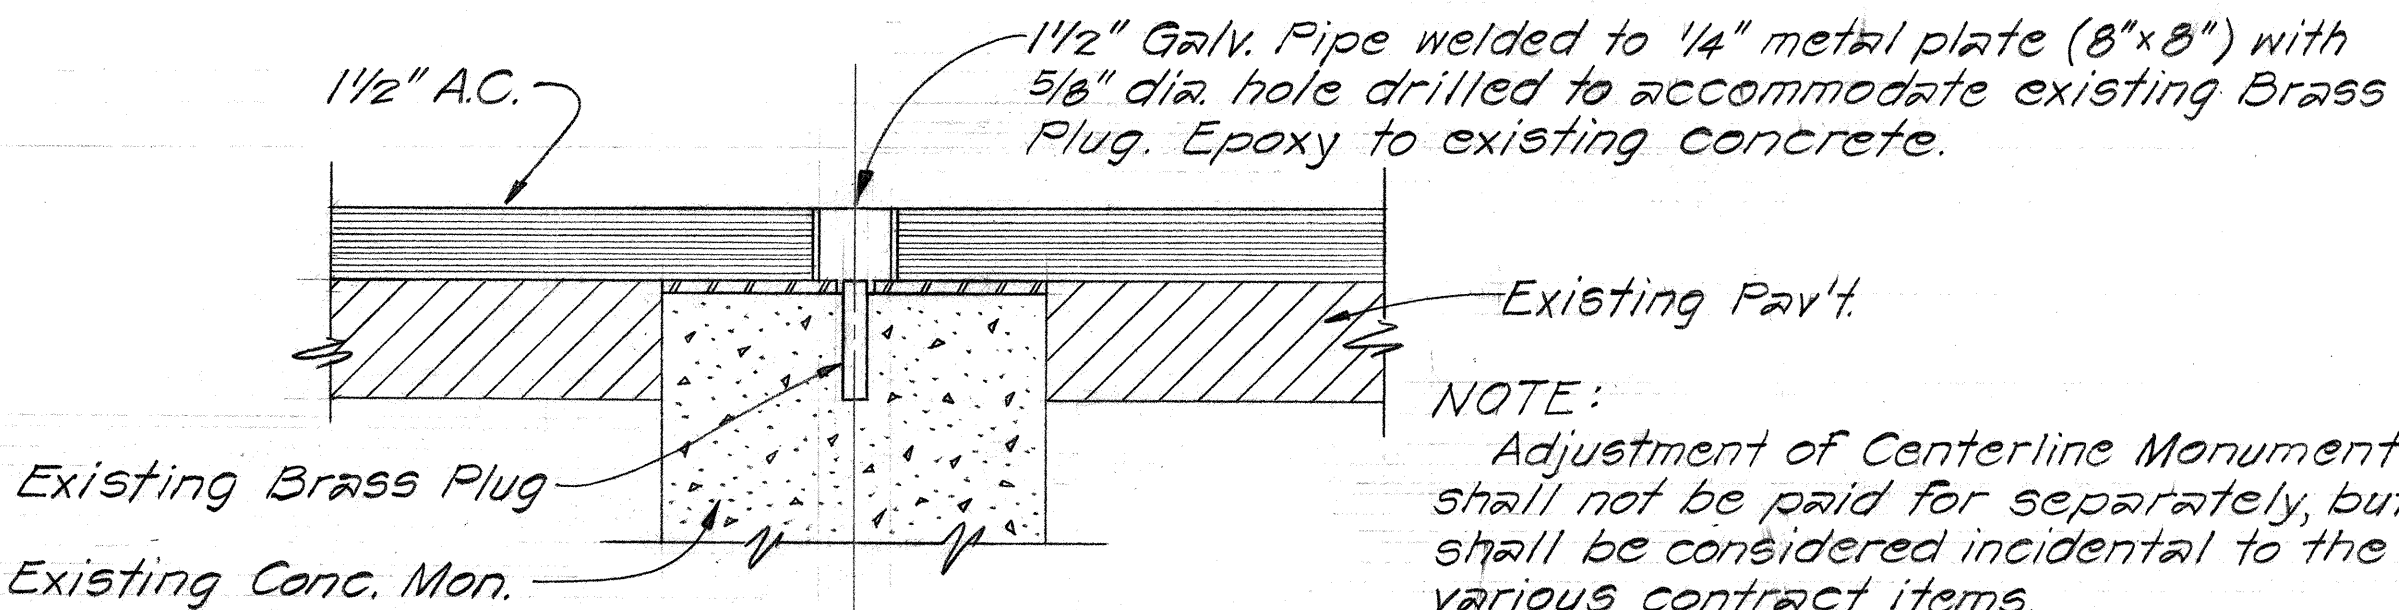

NOTE:
Adjustment of Centerline Monument shall not be paid for separately, but shall be considered incidental to the various contract items.

ADJUSTED CENTERLINE MONUMENT
Scale: 3"=1'-0"

DATE	BY
DESIGNED BY	DATE
DRAWN BY	BY
CHECKED BY	DATE
NOTED BY	BY
QUANTITIES BY	DATE
ORIGINAL PLAN	NO.