


ORIGINAL PLAN	SURVEY PLOTTED BY	DATE
NO. 1	DRAWN BY	
NO. 2	DESIGNED BY	
NO. 3	QUANTITIES BY	
NO. 4	CHECKED BY	

LEGEND

Areas to be reconstructed

FED. ROAD DIST. NO.	STATE	PROJ. NO.	FISCAL YEAR	SHEET NO.	TOTAL SHEETS
HAWAII	HAW.	G3A-03-76M	1976	3	6

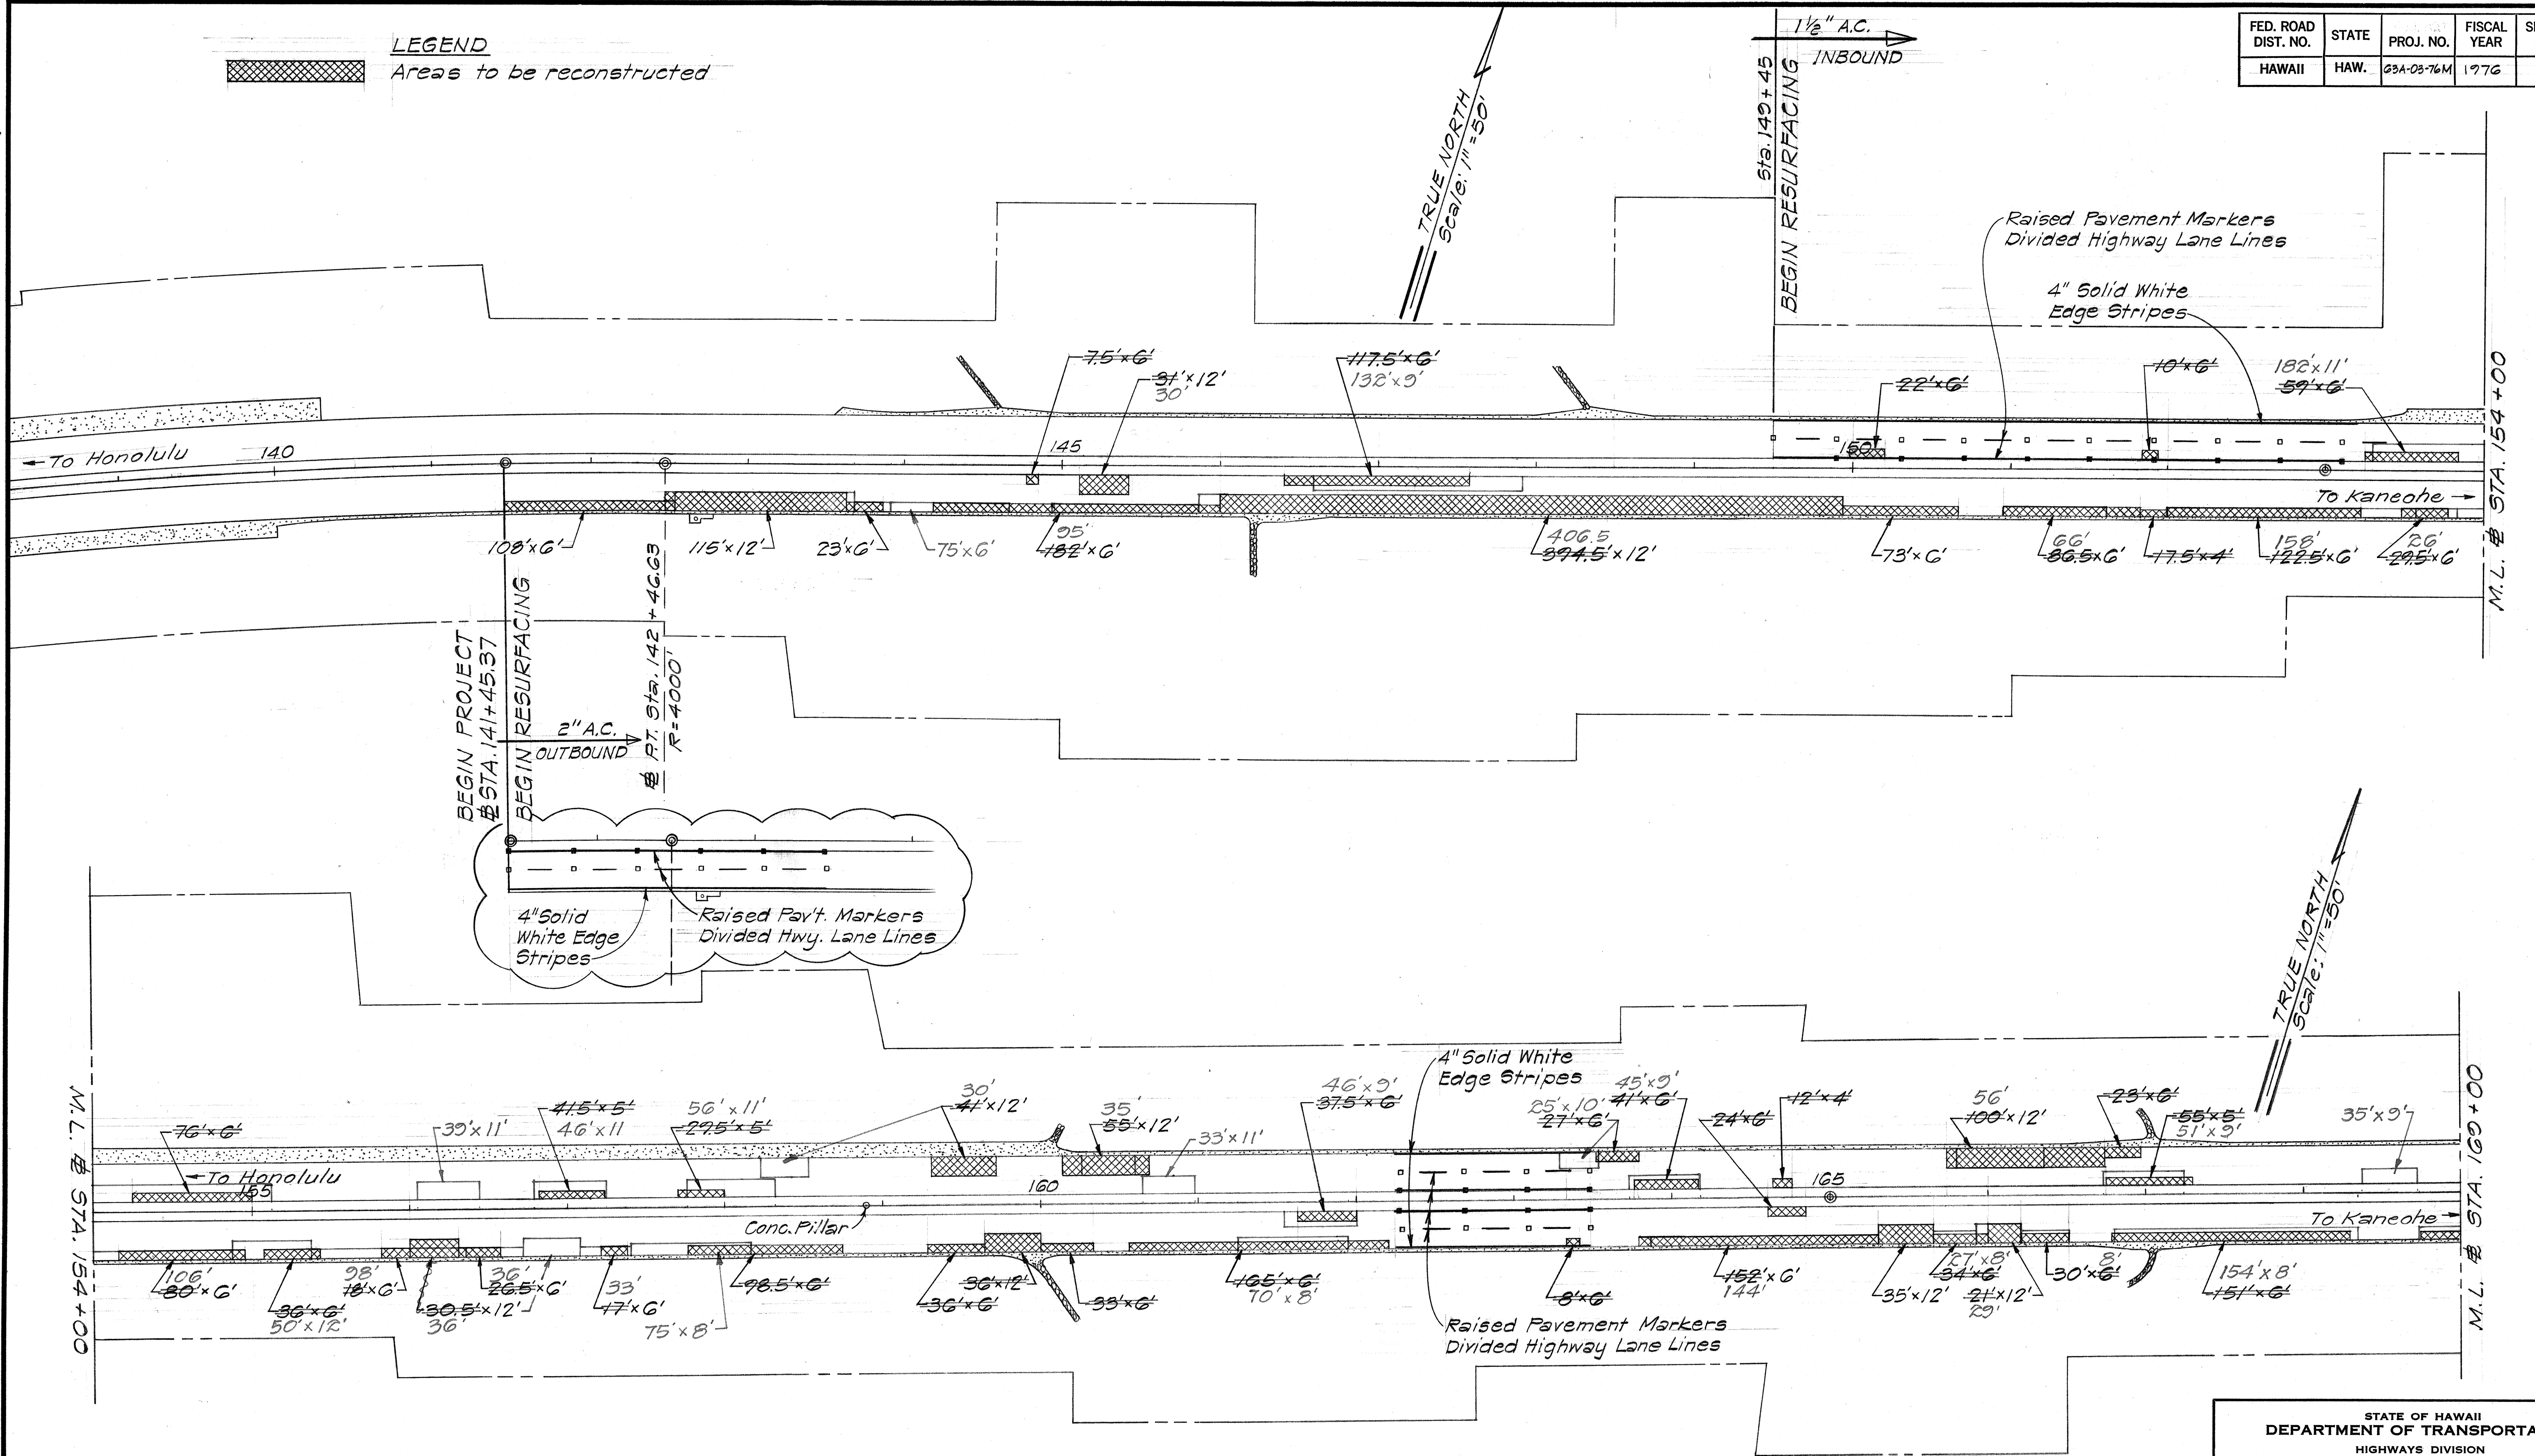

STATE OF HAWAII
DEPARTMENT OF TRANSPORTATION
HIGHWAYS DIVISION



ROADWAY AND PAVEMENT
MARKINGS

LIKELIKE HIGHWAY RESURFACING
Proj. No. G3A-03-76M

Scale: 1" = 50' Date: June, 1976

SHEET NO. 1 OF 4 SHEETS

FED. ROAD DIST. NO.	STATE	PROJ. NO.	FISCAL YEAR	SHEET NO.	TOTAL SHEETS
HAWAII	HAW.	63A-03-76M	1976	4	8

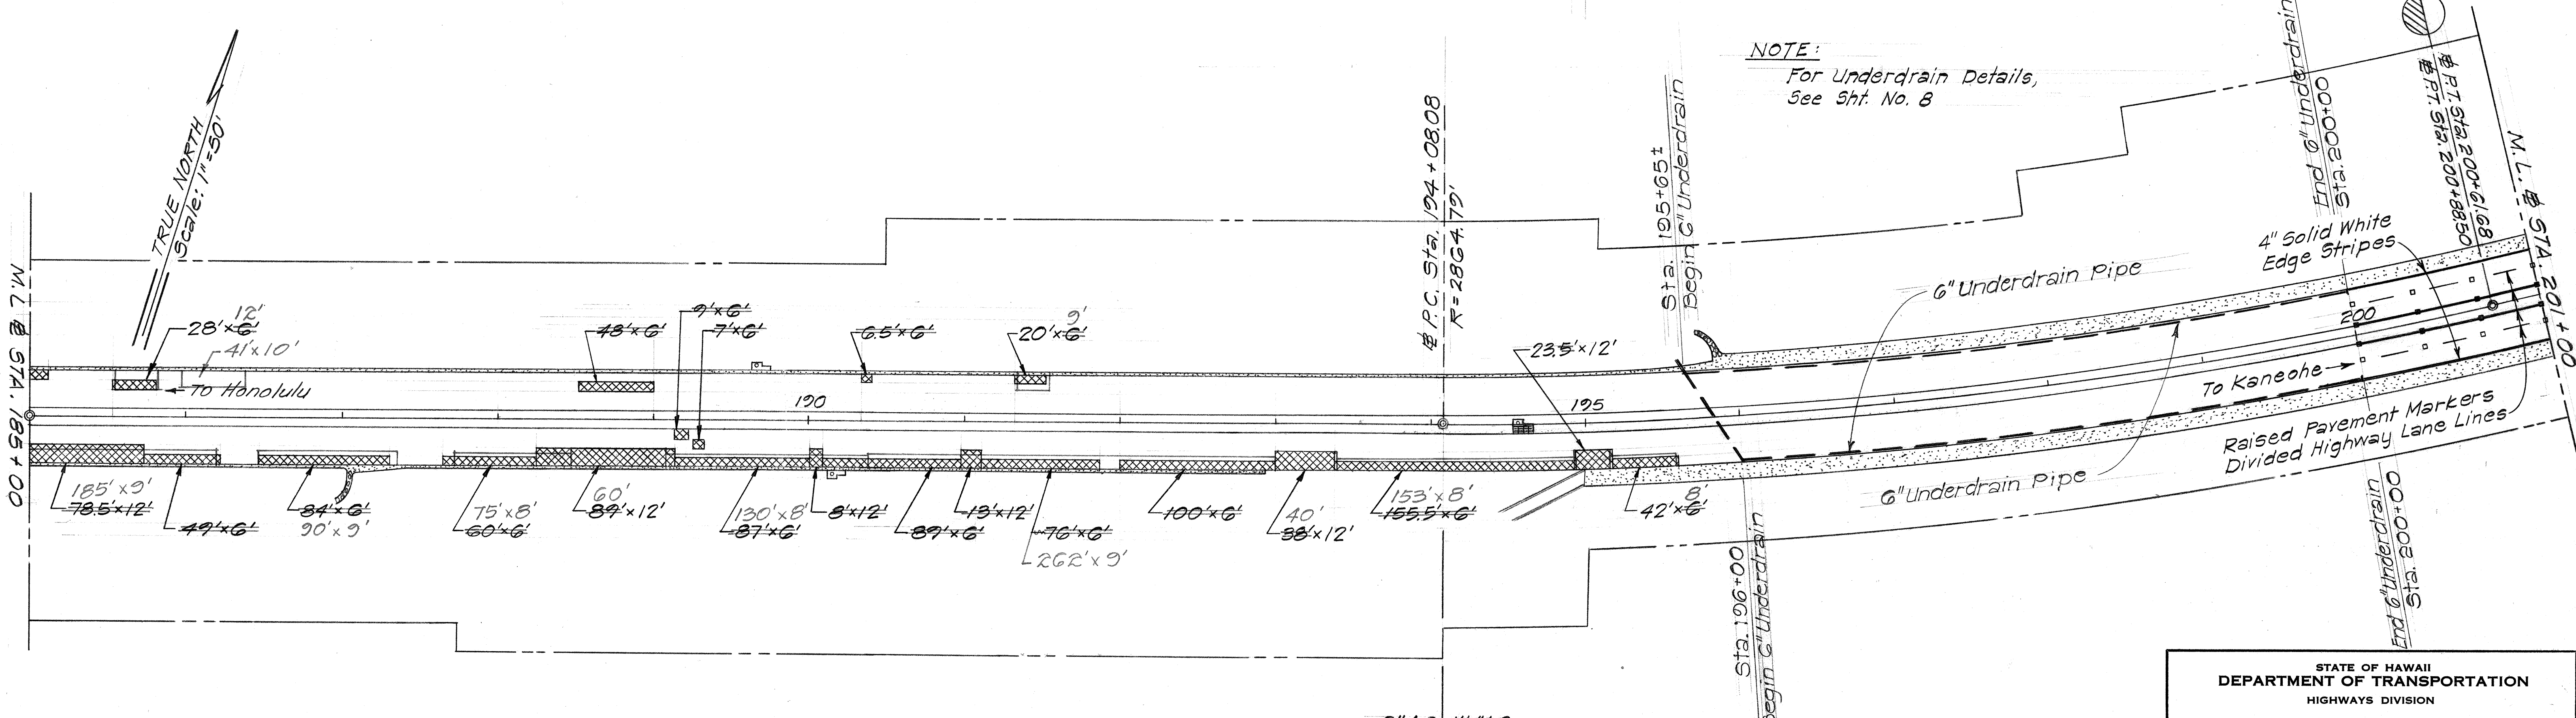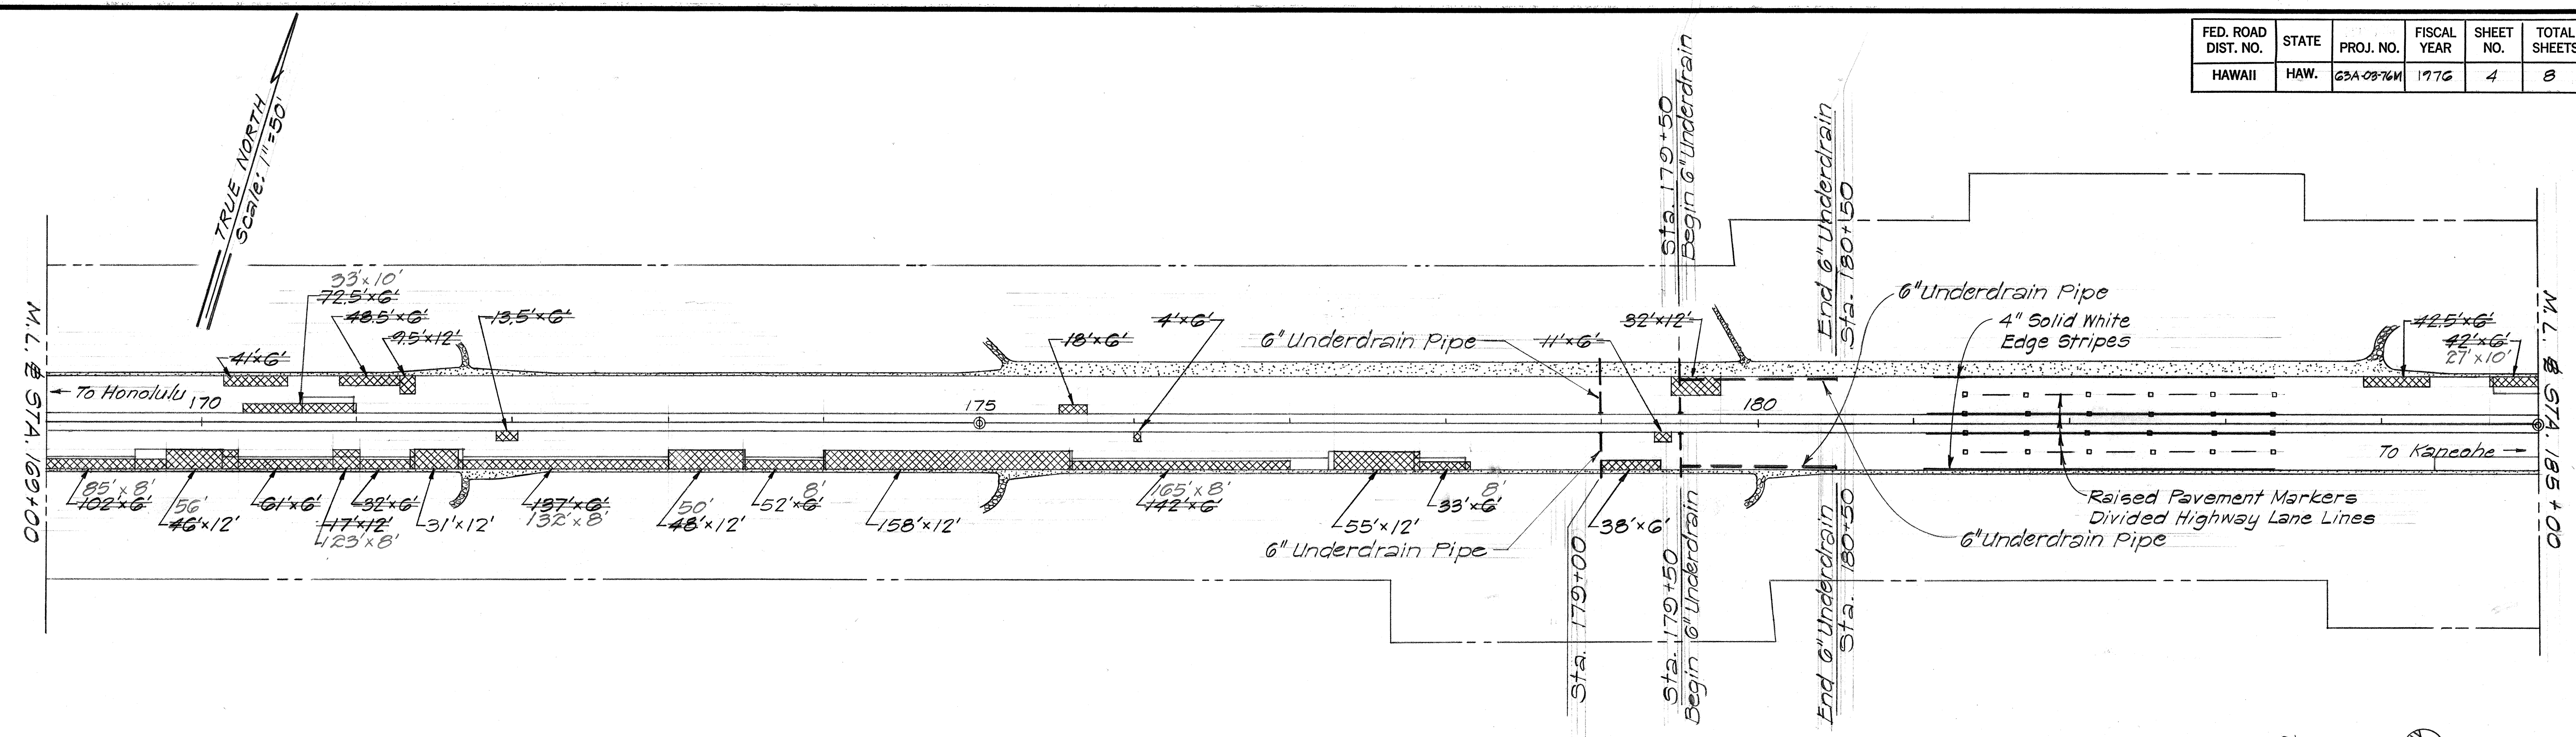

NOTE:
For Underdrain Details,
See Sht. No. 8

2" A.C. 1 1/2" A.C.
Provide Smooth Riding Transition

SURVEY PLOTTED BY	DATE
DRAWN BY	
DESIGNED BY	
QUANTITIES BY	
CHECKED BY	

STATE OF HAWAII
DEPARTMENT OF TRANSPORTATION
HIGHWAYS DIVISION



ROADWAY AND PAVEMENT MARKINGS

LIKELIKE HIGHWAY RESURFACING
Proj. No. 63A-03-76M

Scale: 1"=50' Date: June, 1976

SHEET NO. 2 OF 4 SHEETS

FED. ROAD DIST. NO.	STATE	PROJ. NO.	FISCAL YEAR	SHEET NO.	TOTAL SHEETS
HAWAII	HAW.	63A-03-76M	1976	5	8

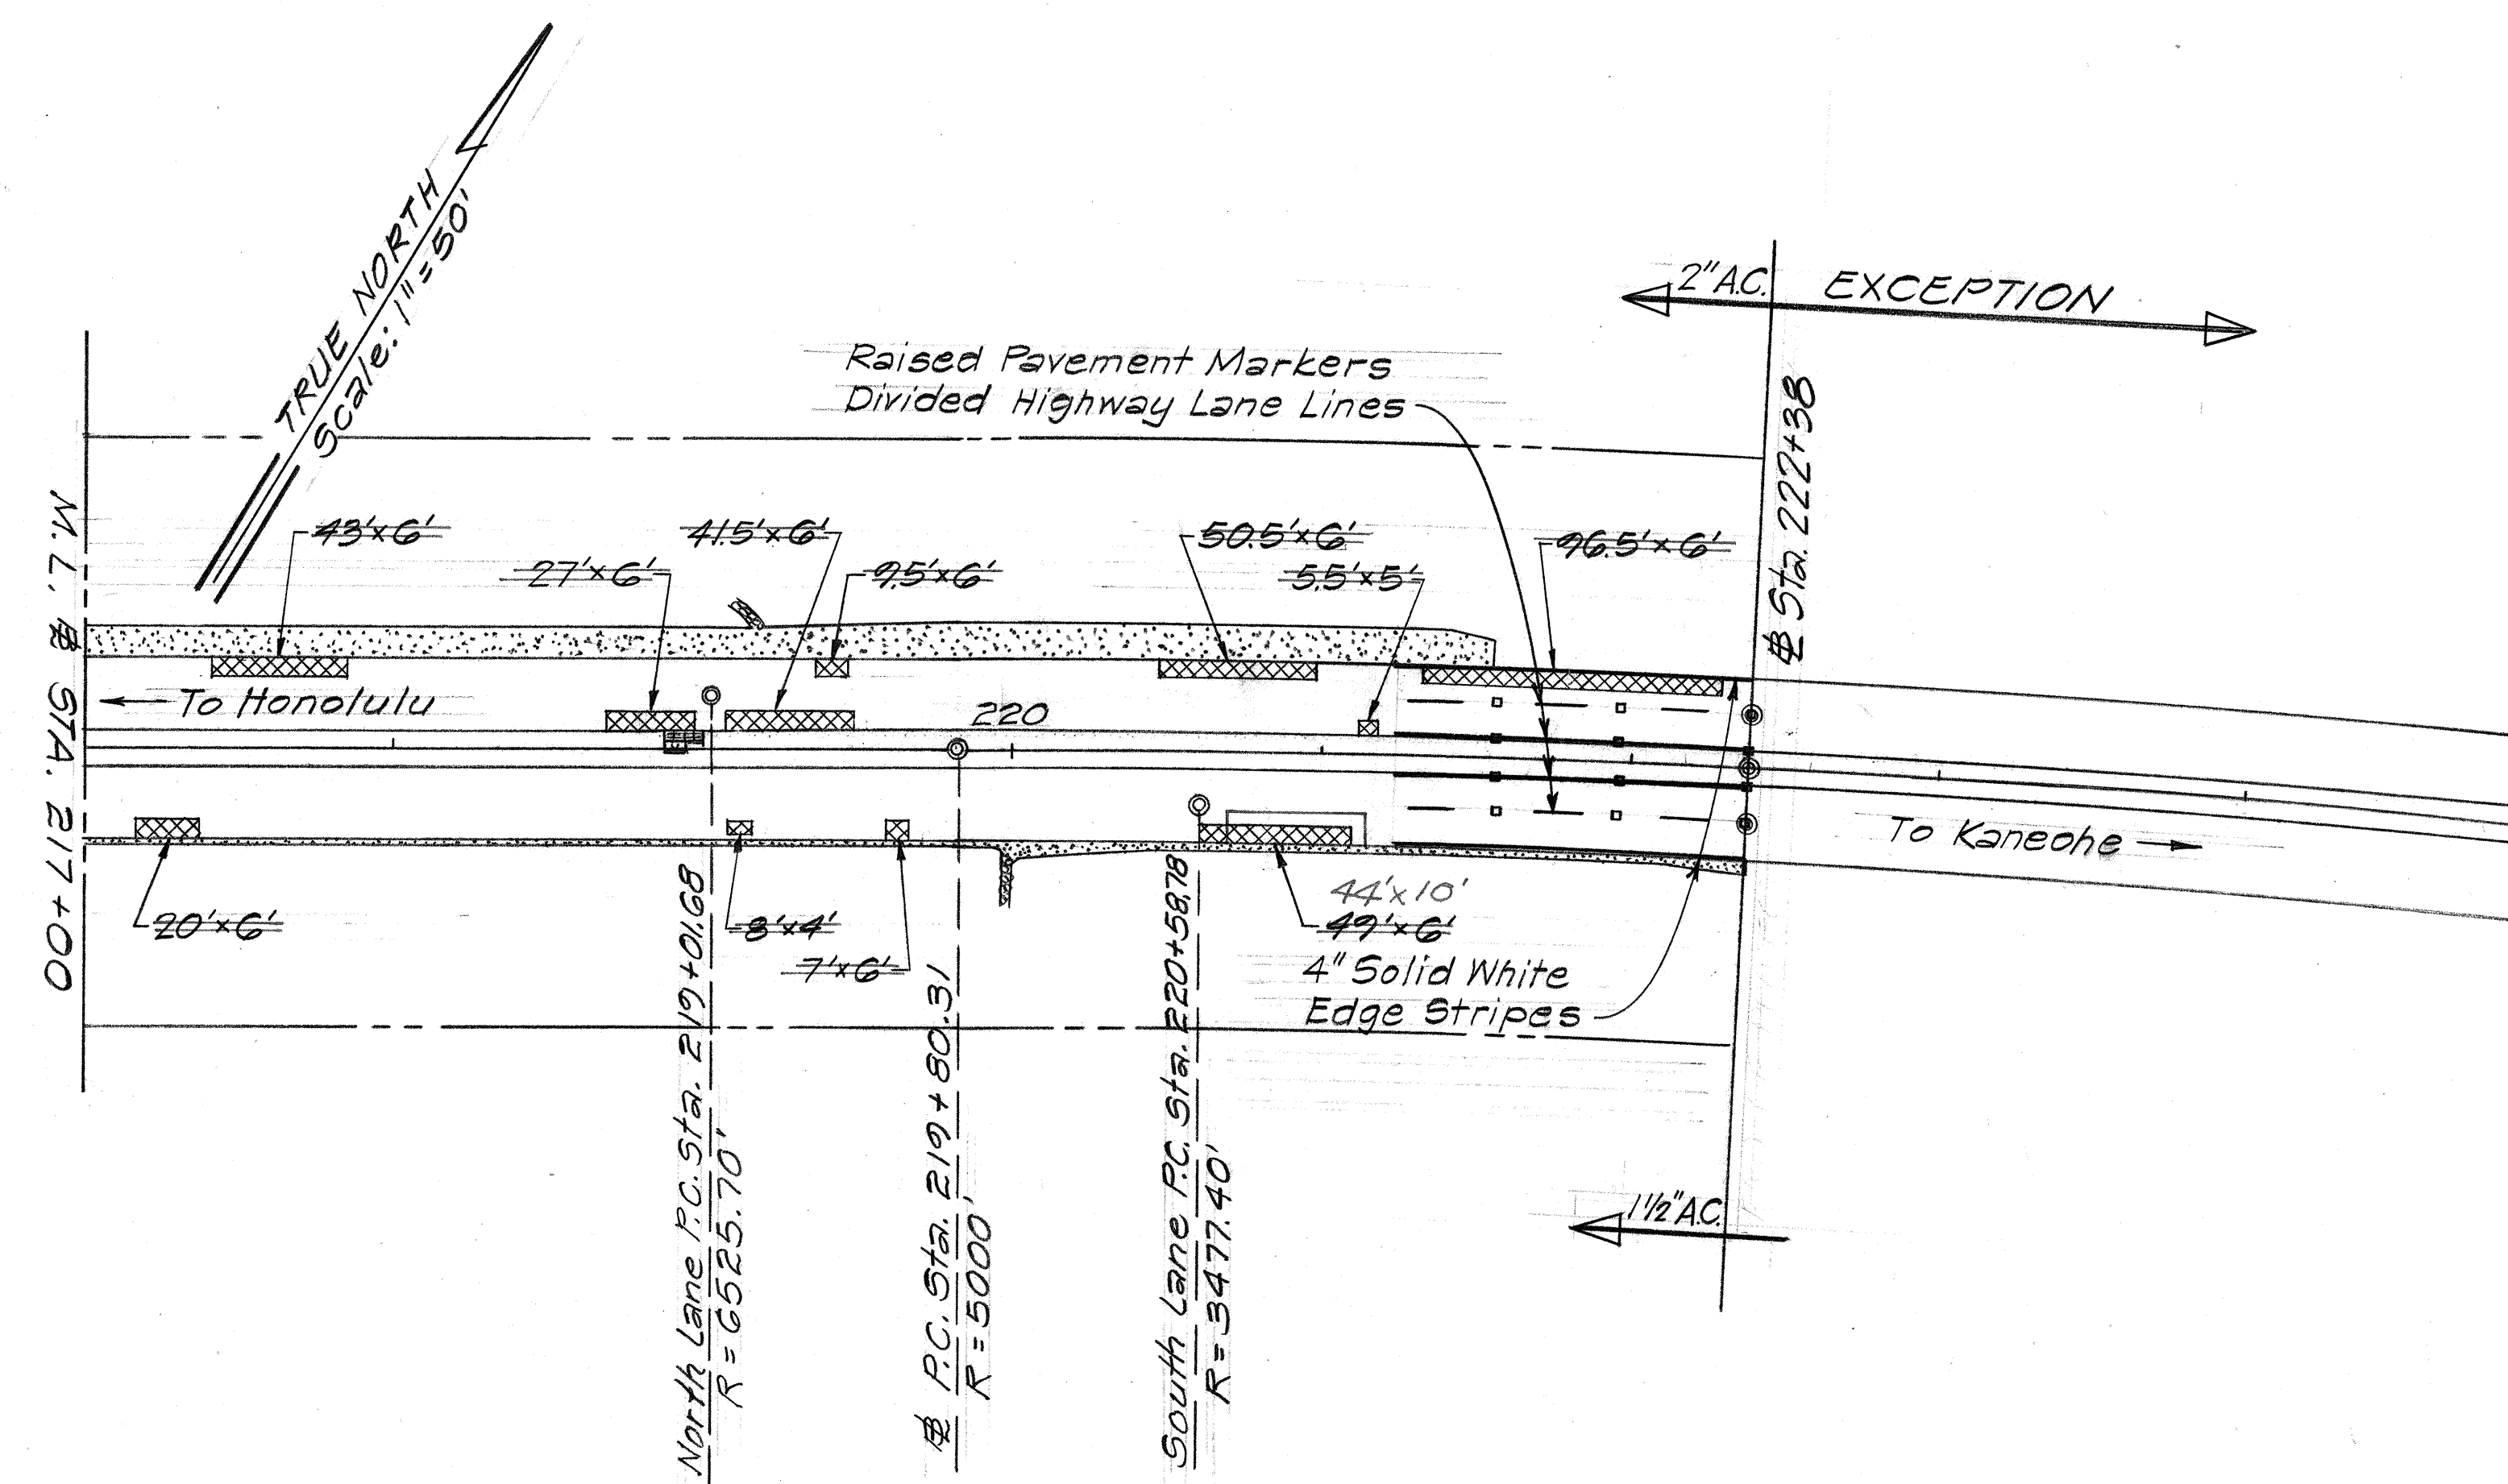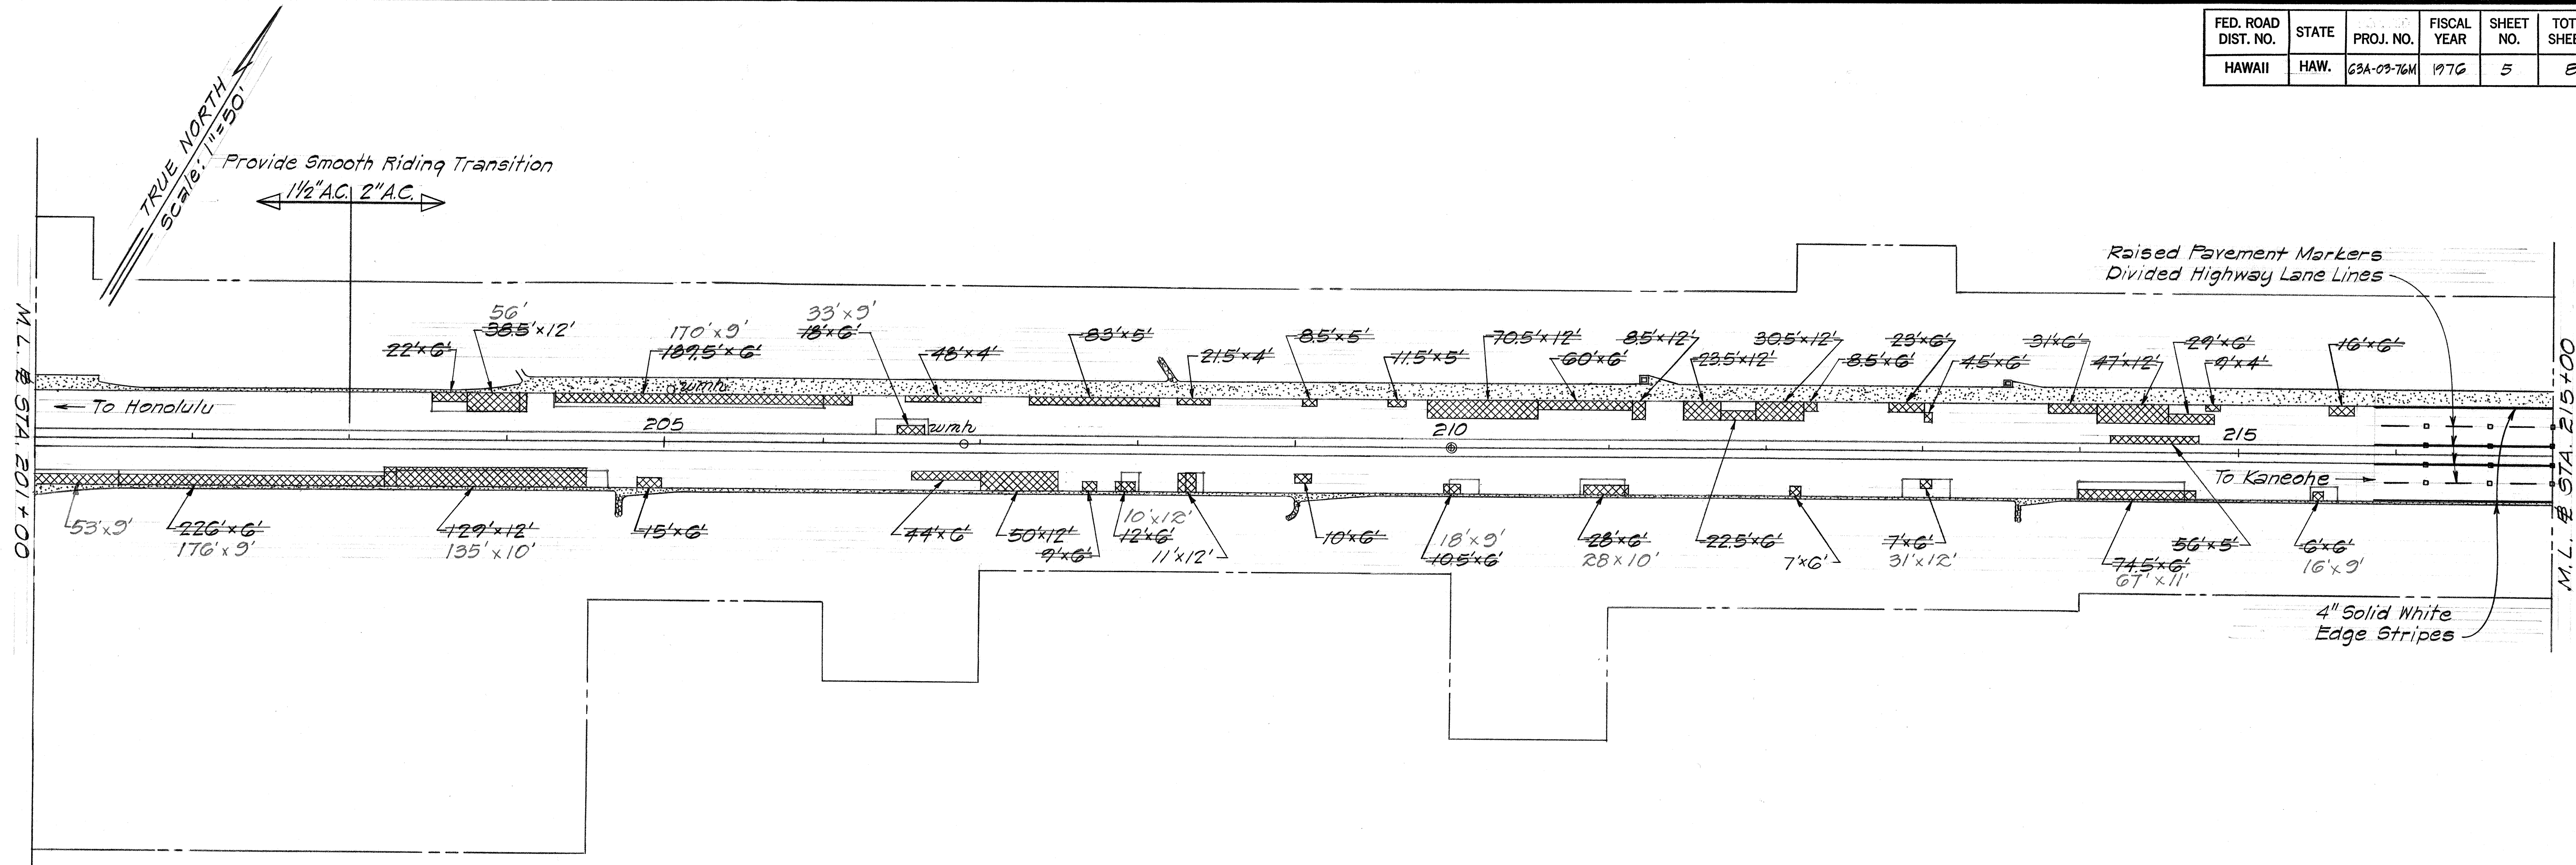

ORIGINAL PLAN	DATE
DESIGNED BY	
TRACED BY	
NOTED BY	
QUANTITIES BY	
CHECKED BY	


STATE OF HAWAII
DEPARTMENT OF TRANSPORTATION
HIGHWAYS DIVISION

ROADWAY AND PAVEMENT MARKINGS
LIKELIKE HIGHWAY RESURFACING
Proj. No. 63A-03-76M

Scale: 1"=50' Date: June, 1976
SHEET NO. 3 OF 4 SHEETS

DATE	REVISION
6/29/76	Increased scope of work from Sta. 12+00 to Sta. 56+00 in accordance with Subsection 104.03, Availability of Funds.

FED. ROAD DIST. NO.	STATE	PROJ. NO.	FISCAL YEAR	SHEET NO.	TOTAL SHEETS
HAWAII	HAW.	63A-03-T6M	1976	6	8

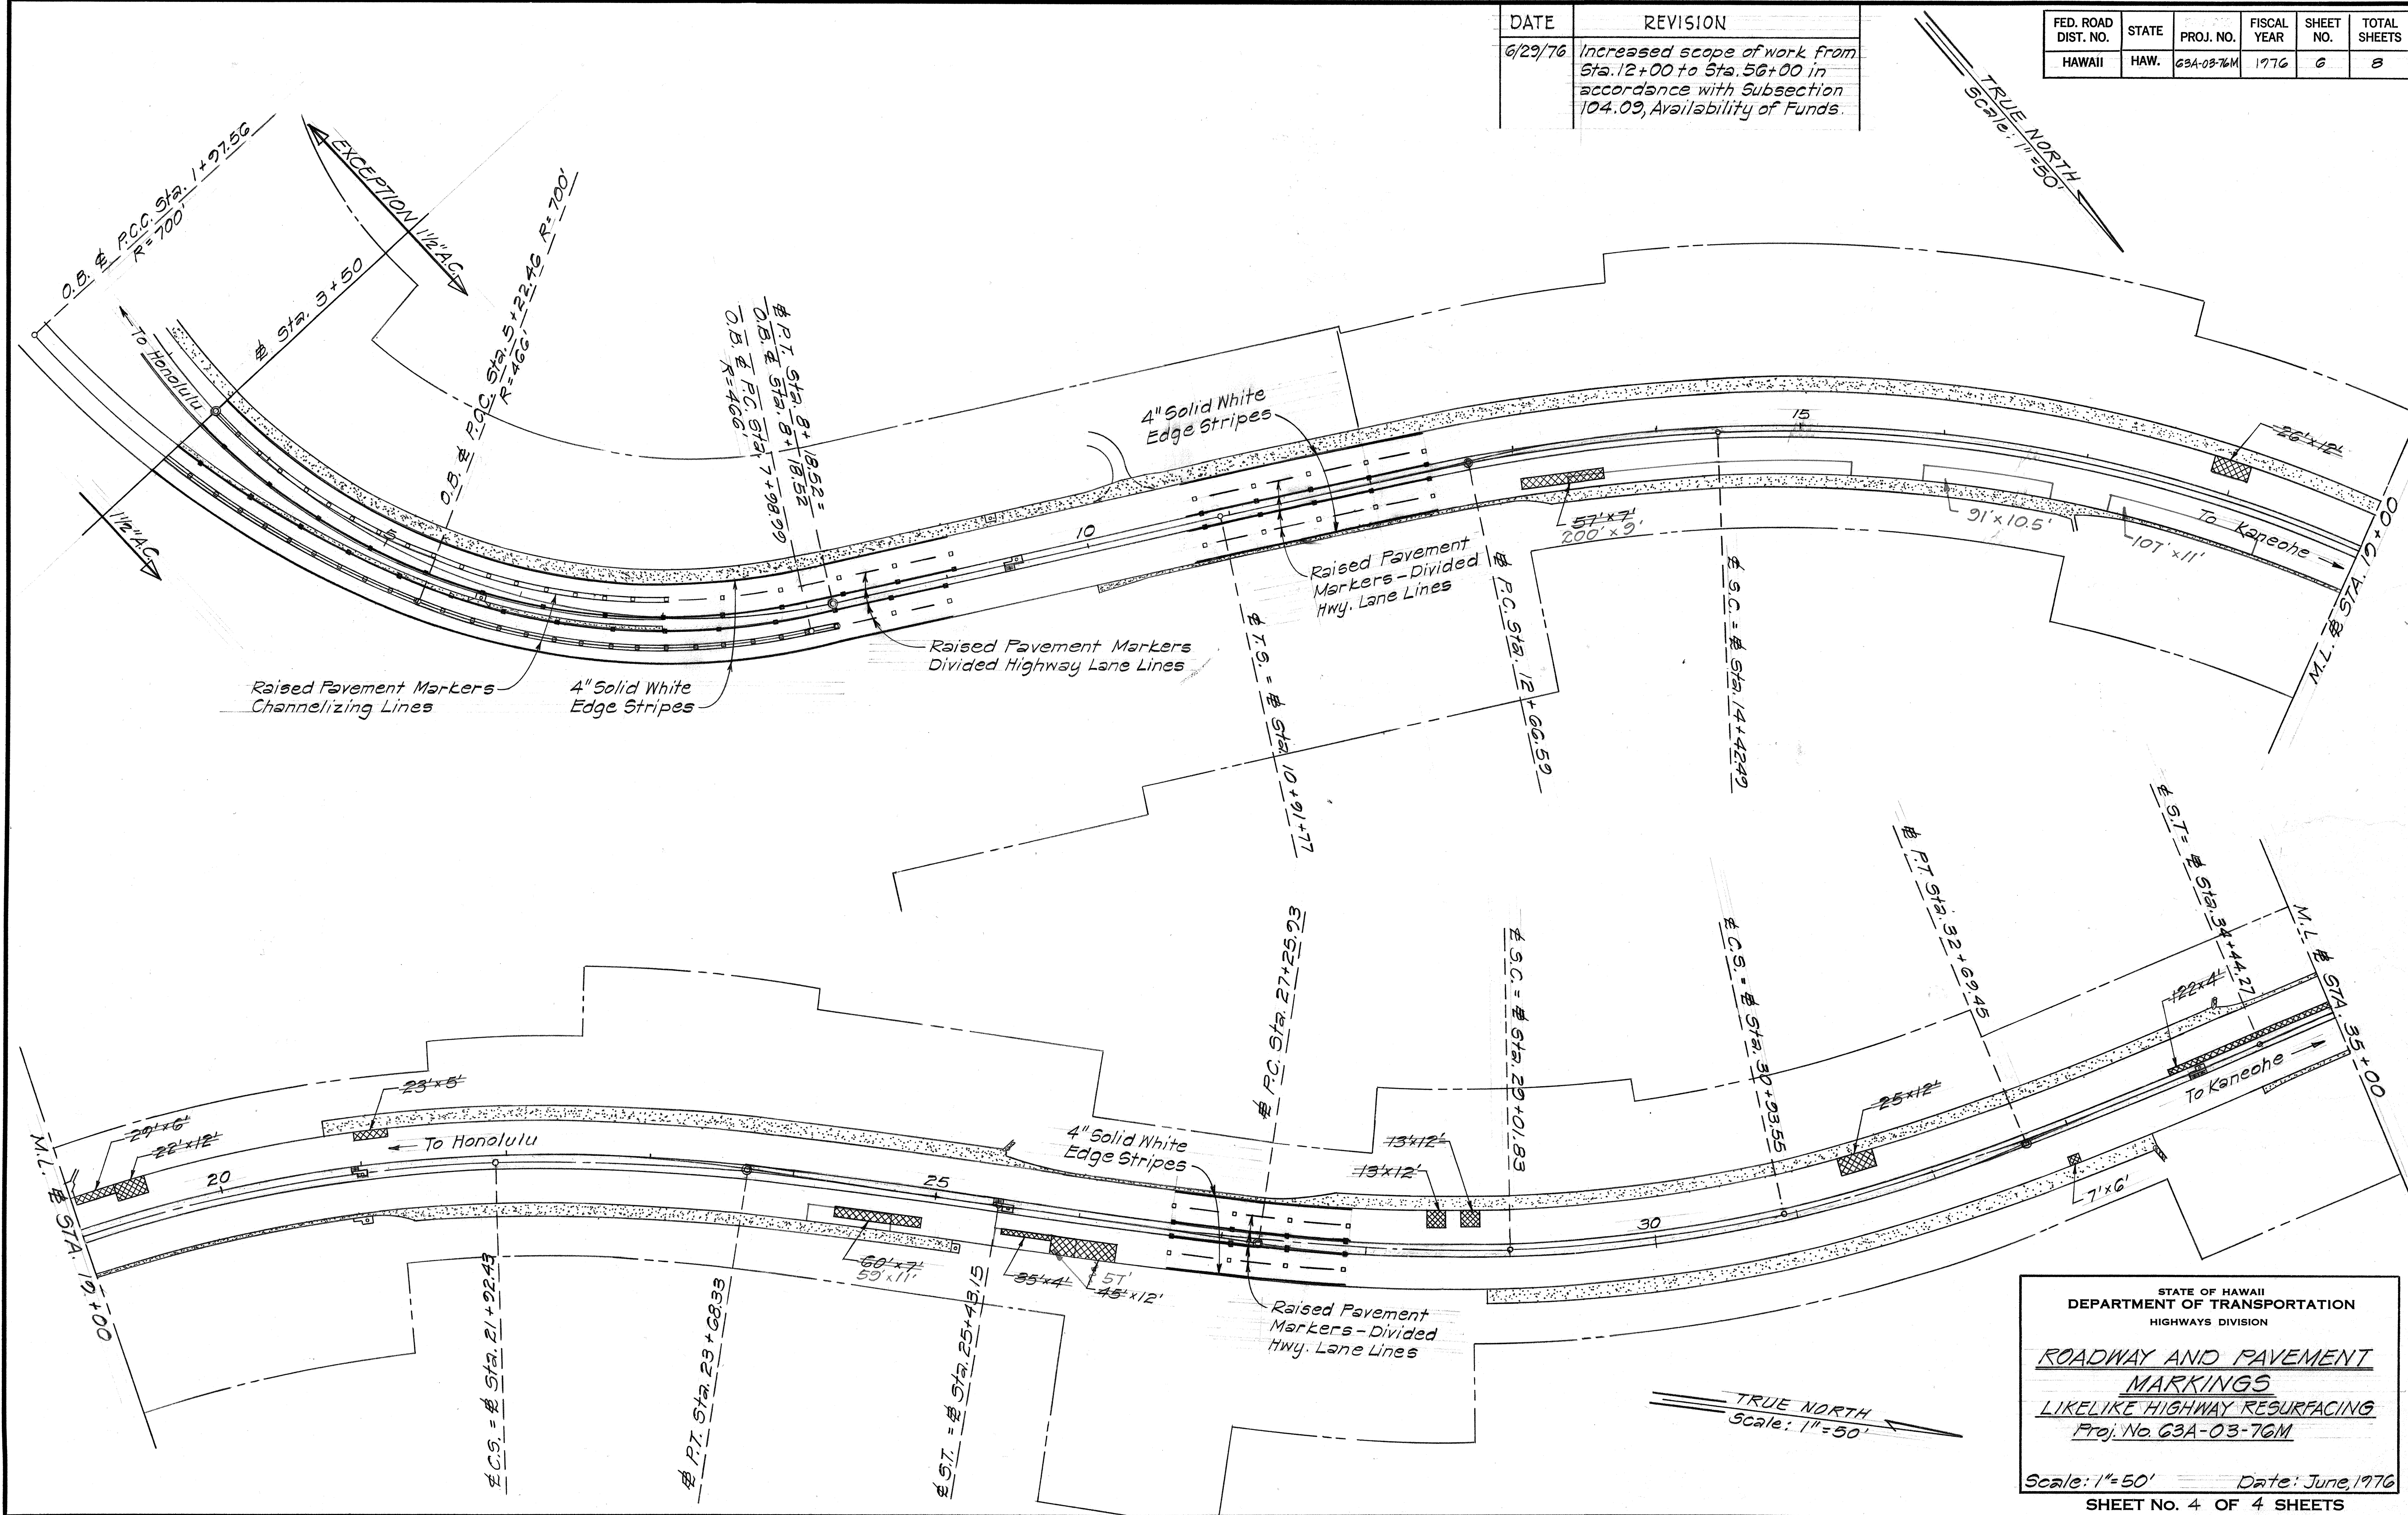

ORIGINAL PLAN	DATE
SURVEY PLOTTED BY	
DRAWN BY	
DESIGNED BY	
CHECKED BY	
NO.	

STATE OF HAWAII
DEPARTMENT OF TRANSPORTATION
HIGHWAYS DIVISION

ROADWAY AND PAVEMENT MARKINGS
LIKELIKE HIGHWAY RESURFACING
Proj. No. 63A-03-T6M

Scale: 1"=50' Date: June, 1976
SHEET NO. 4 OF 4 SHEETS

