


LT-DT \_\_\_\_\_  
DESIGNED BY \_\_\_\_\_  
F. Abeshima  
P. S. & E. BY \_\_\_\_\_  
548-4042 Dec. 1, 1977  
PHONE \_\_\_\_\_ DATE \_\_\_\_\_



"AS BUILT"  
PLANS FOR  
HIGHWAY LIGHTING IMPROVEMENT  
ON LIKELIKE HIGHWAY  
EEN WILSON TUNNEL & KAMEHAMEHA HIGHWAY  
PROJECT NO. 63A-01-72 UNIT II  
DISTRICT OF KOOLAUPOKO  
ISLAND OF OAHU

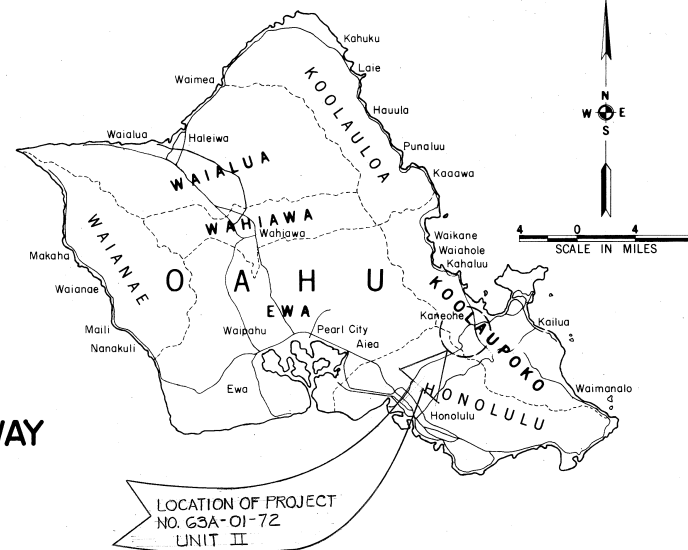

NOTE :  
ALL CHANGES MADE DURING CONSTRUCTION HAVE  
BEEN INCORPORATED ON THESE PLANS IN RED  
EXCEPT CHANGES IN THE ORIGINAL THEORETICAL  
QUANTITIES.

Robert Y. Mironaka  
PROJECT ENGINEER

3/5/79  
DAT

DEPARTMENT OF TRANSPORTATION STATE OF HAWAII	
APPROVED: <i>R. Higashionna</i>	12-15-
DIRECTOR OF TRANSPORTATION	DATE