

LEGEND

- oooo

4EA TYPE "A" RAISED PAVEMENT MARKERS

....

4EA TYPE "J" RAISED PAVEMENT MARKERS

⊕

TYPE "C" RAISED PAVEMENT MARKER

□

TYPE "D" RAISED PAVEMENT MARKER

■

TYPE "H" RAISED PAVEMENT MARKER



4" YELLOW LINE W/ TYPE "H" MARKERS 40'-0" o.c.




4" DOUBLE YELLOW LINE W/ TYPE "D" MARKERS 20'-0" o.c.



8" WHITE LINE W/ TYPE "C" MARKERS 20'-0" o.c.



PAVEMENT ARROW

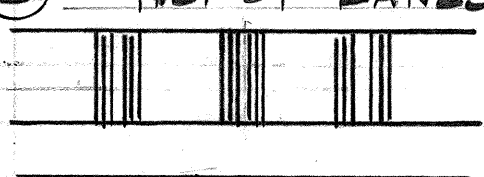

CROSSWALK & STOP LINE (ALL STOP LINES 10'-0" FROM CROSSWALKS UNLESS OTHERWISE NOTED).




4" GUIDE LINE (COLOR AS NOTED ON PLANS)

PAVEMENT MARKING SUMMARY

DESCRIPTION	QUANTITY
TYPE "A" RAISED PAVEMENT MARKERS	1,812 EA.
TYPE "C" RAISED PAVEMENT MARKERS	718 EA.
TYPE "D" RAISED PAVEMENT MARKERS	210 EA.
TYPE "H" RAISED PAVEMENT MARKERS	476 EA.
TYPE "J" RAISED PAVEMENT MARKERS	576 EA.
PAVEMENT ARROWS	38 EA.
PAVEMENT STRIPING	64,700 L.F.
CROSSWALKS	76 LANES

GENERAL NOTES

- LOCATIONS OF NEW PAVEMENT MARKINGS SHALL BE STAKED OUT IN THE FIELD BY THE CONTRACTOR & APPROVED BY THE ENGINEER PRIOR TO FINAL INSTALLATION.
- ALL TURNING RADII SHALL BE A MINIMUM OF 50'-0".
- THE CONTRACTOR SHALL RESTORE ALL EXISTING STRIPING OUTSIDE THE RESURFACED AREA THAT HAS BEEN DAMAGED DURING RESURFACING. DETERMINATION SHALL BE MADE BY THE ENGINEER.
- LOCATIONS & INSTALLATION OF ALL CONSTRUCTION SIGNS SHALL BE APPROVED IN THE FIELD BY THE ENGINEER.

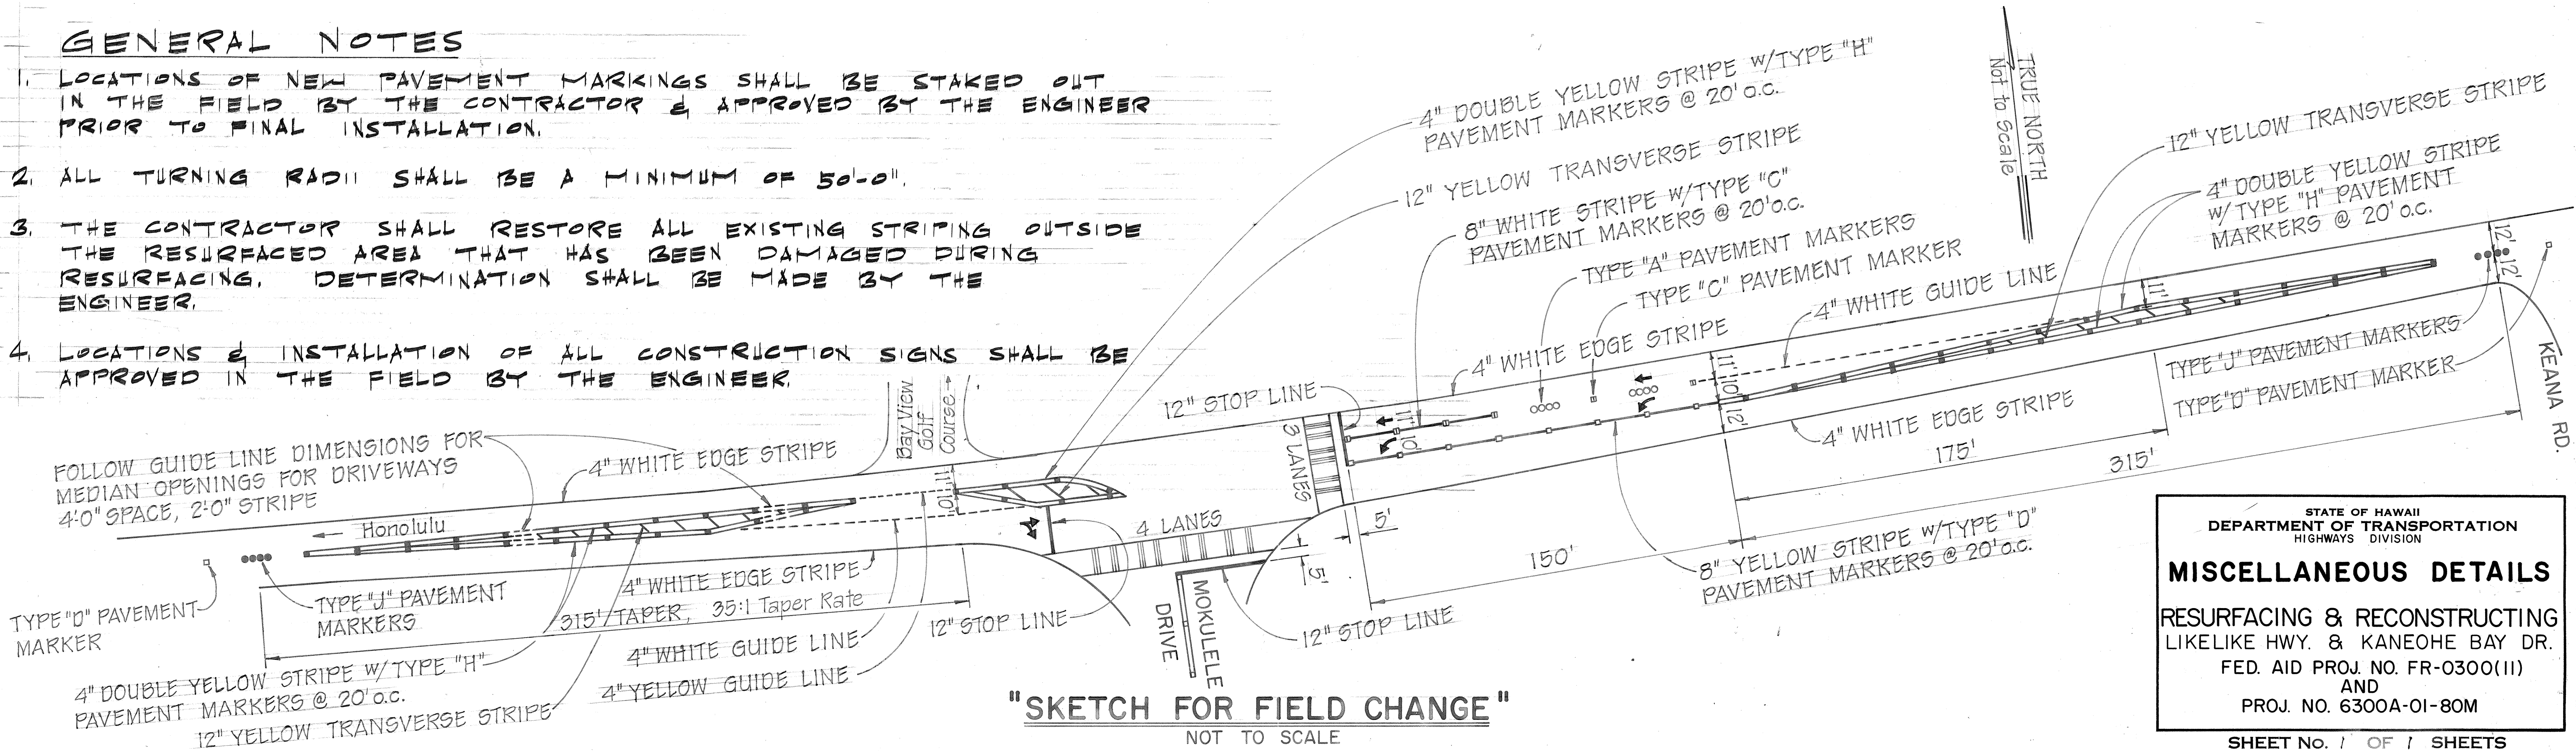

STATE OF HAWAII

DEPARTMENT OF TRANSPORTATION

HIGHWAYS DIVISION

MISCELLANEOUS DETAILS

RESURFACING & RECONSTRUCTING

LIKELIKE HWY. & KANEOHE BAY DR.

FED. AID PROJ. NO. FR-0300(II)

AND

PROJ. NO. 6300A-01-80M

SHEET NO. 1 OF 1 SHEETS

16