
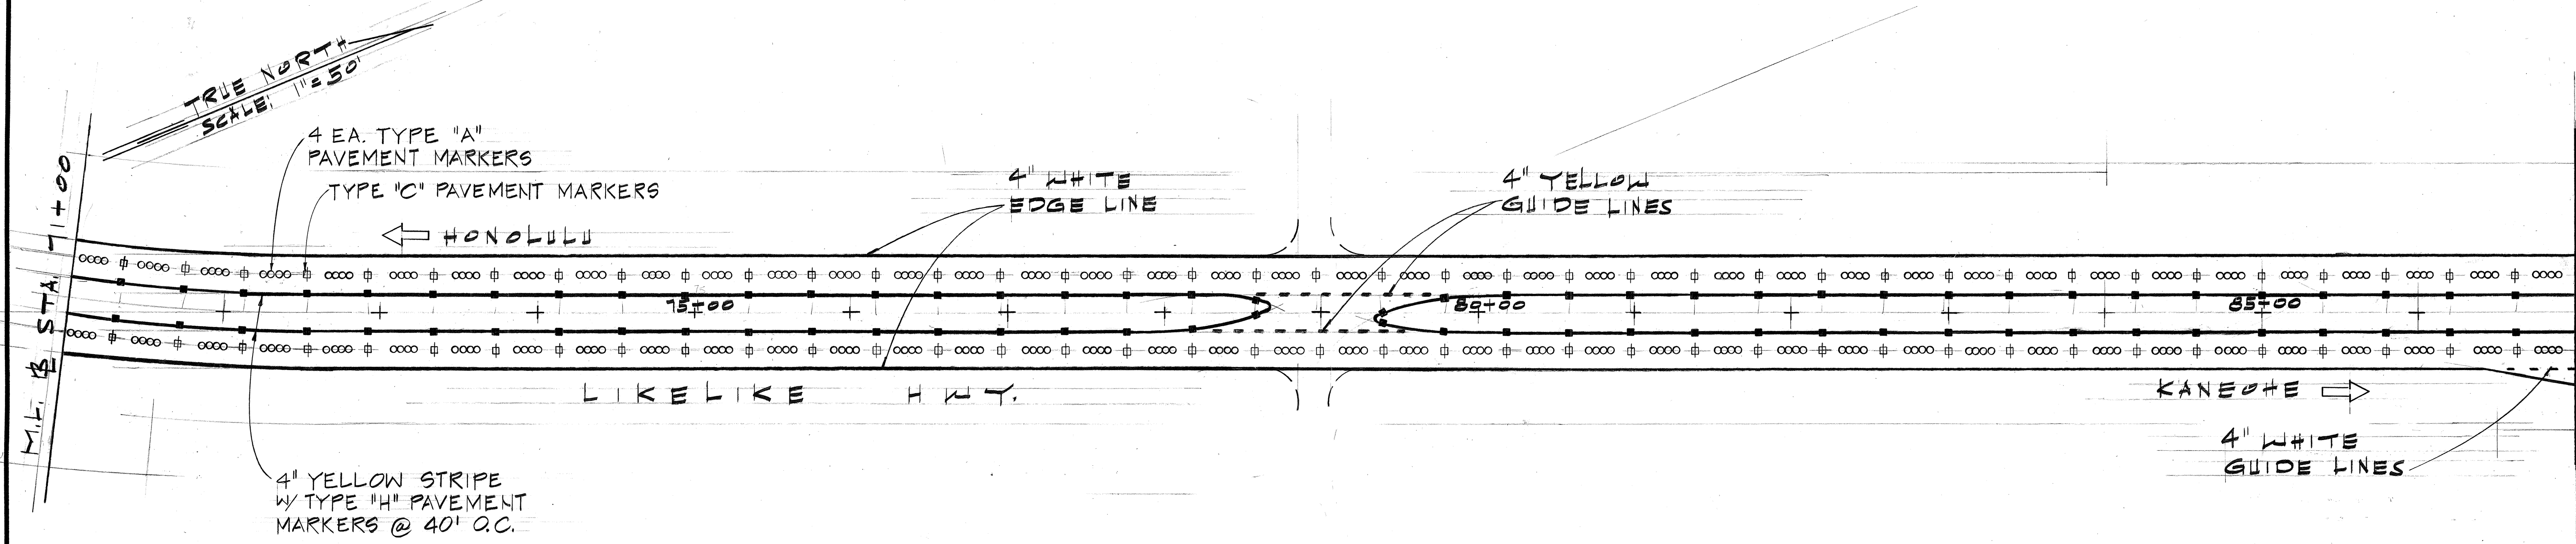


FED. ROAD DIST. NO.	STATE	FED. AID PROJ. NO.	FISCAL YEAR	SHEET NO.	TOTAL SHEETS
HAWAII	HAW.	FR-0300(II) 6300A-01-80M	1980	10	21

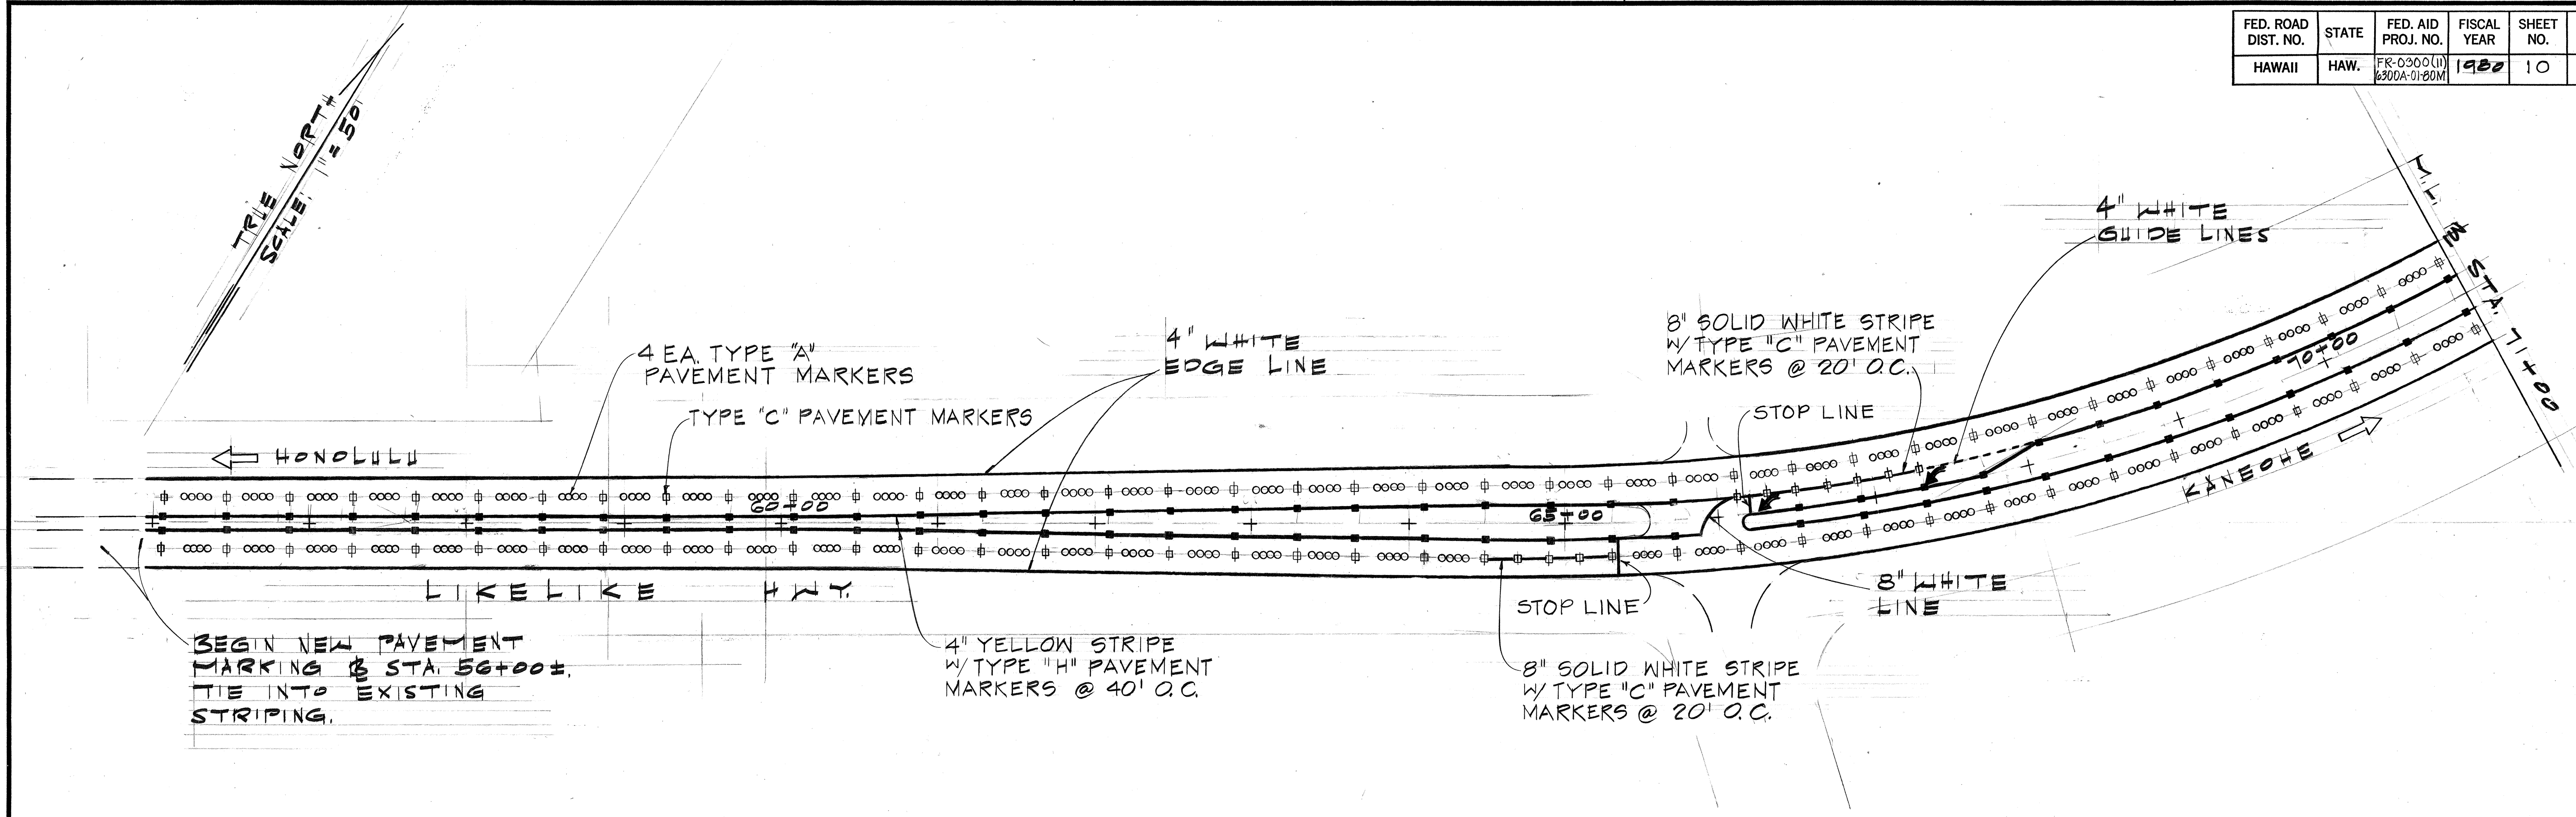

STATE OF HAWAII
DEPARTMENT OF TRANSPORTATION
HIGHWAYS DIVISION

PAVEMENT MARKINGS



RESURFACING & RECONSTRUCTING
LIKELIKE HWY. & KANE OHE BAY DR.
FED. AID PROJ. NO. FR-0300(II)
AND
PROJ. NO. 6300A-01-80M

SCALE: 1" = 50'

SHEET NO. 10 OF 21 SHEETS

ORIGINAL PLAN	SURVEY PLOTTED BY	DATE
NOTE BOOK	DRAWN BY	
	DESIGNED BY	
	QUANTITIES BY	
	CHECKED BY	

FED. ROAD DIST. NO.	STATE	FED. AID PROJ. NO.	FISCAL YEAR	SHEET NO.	TOTAL SHEETS
HAWAII	HAW.	FR-0300(II) 6300A-01-80M	1980	11	21

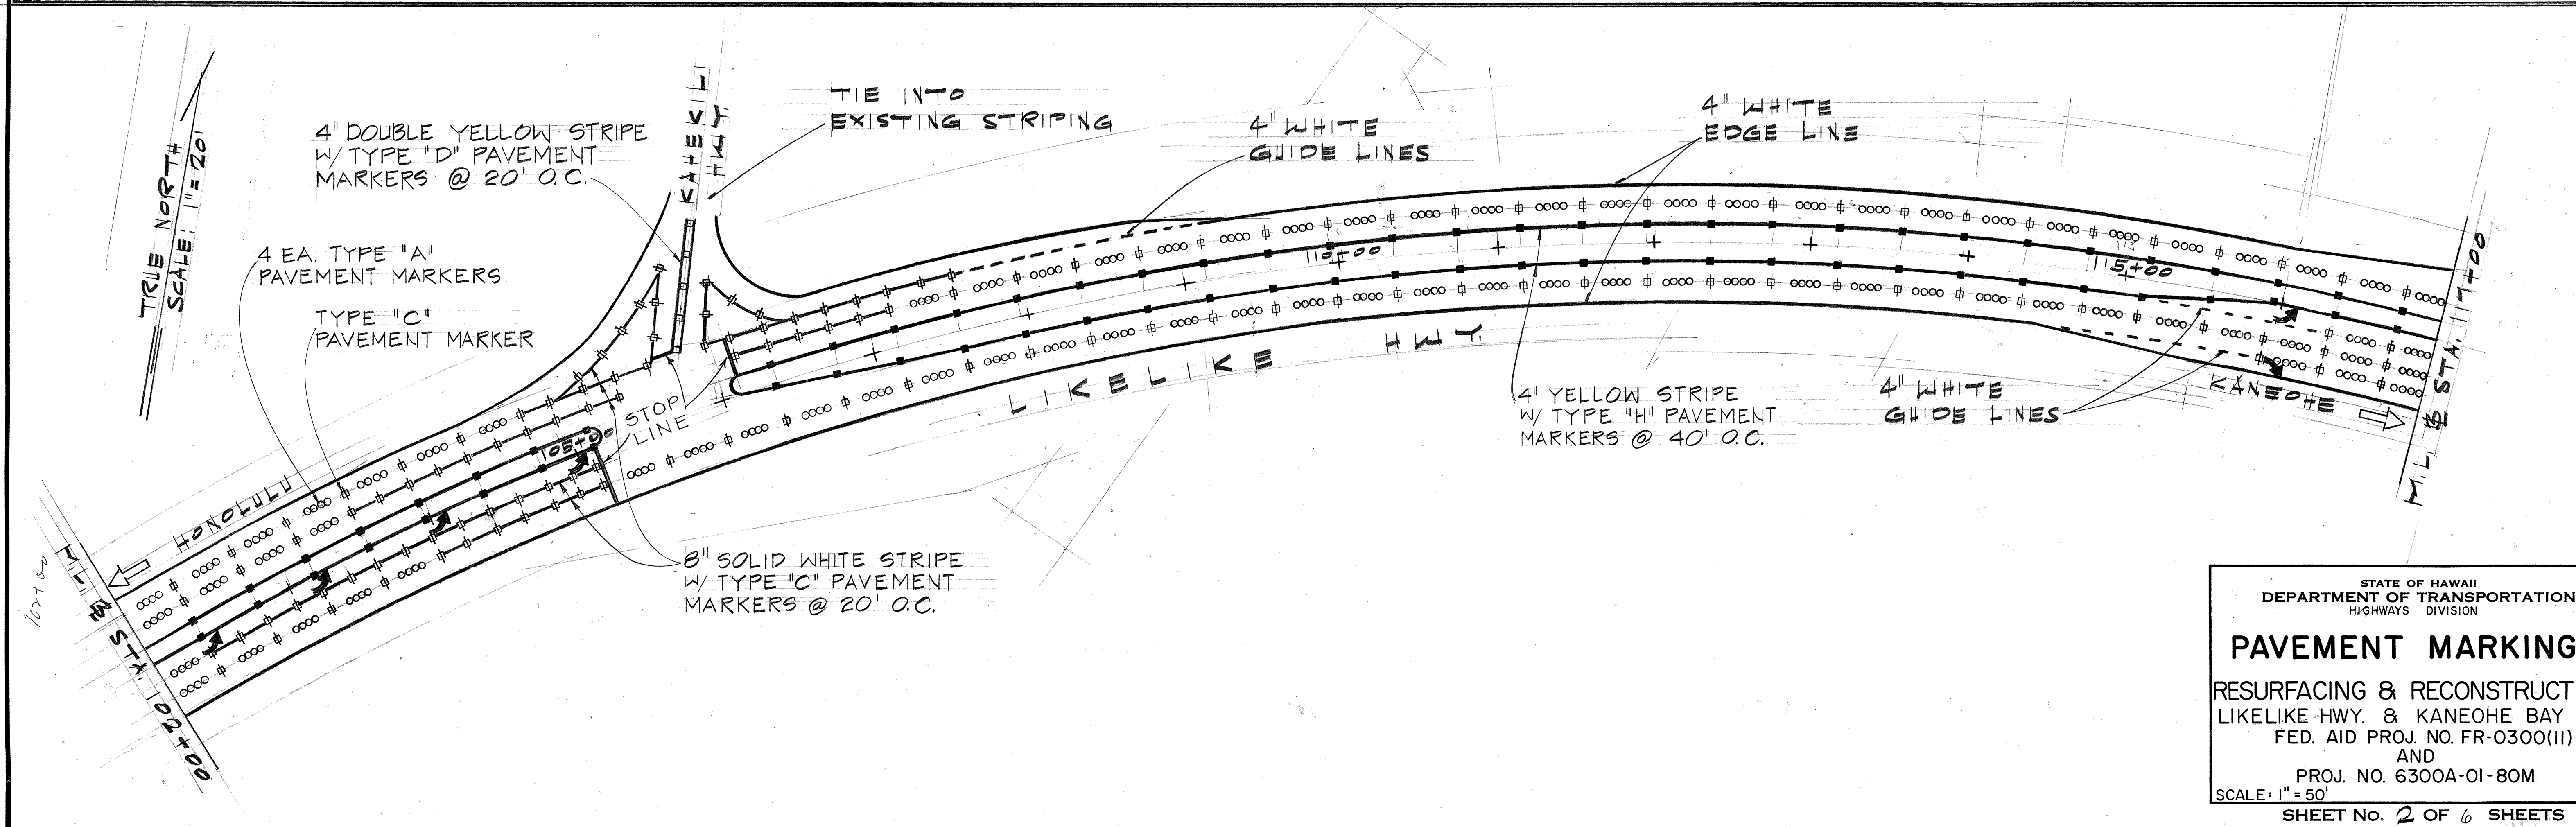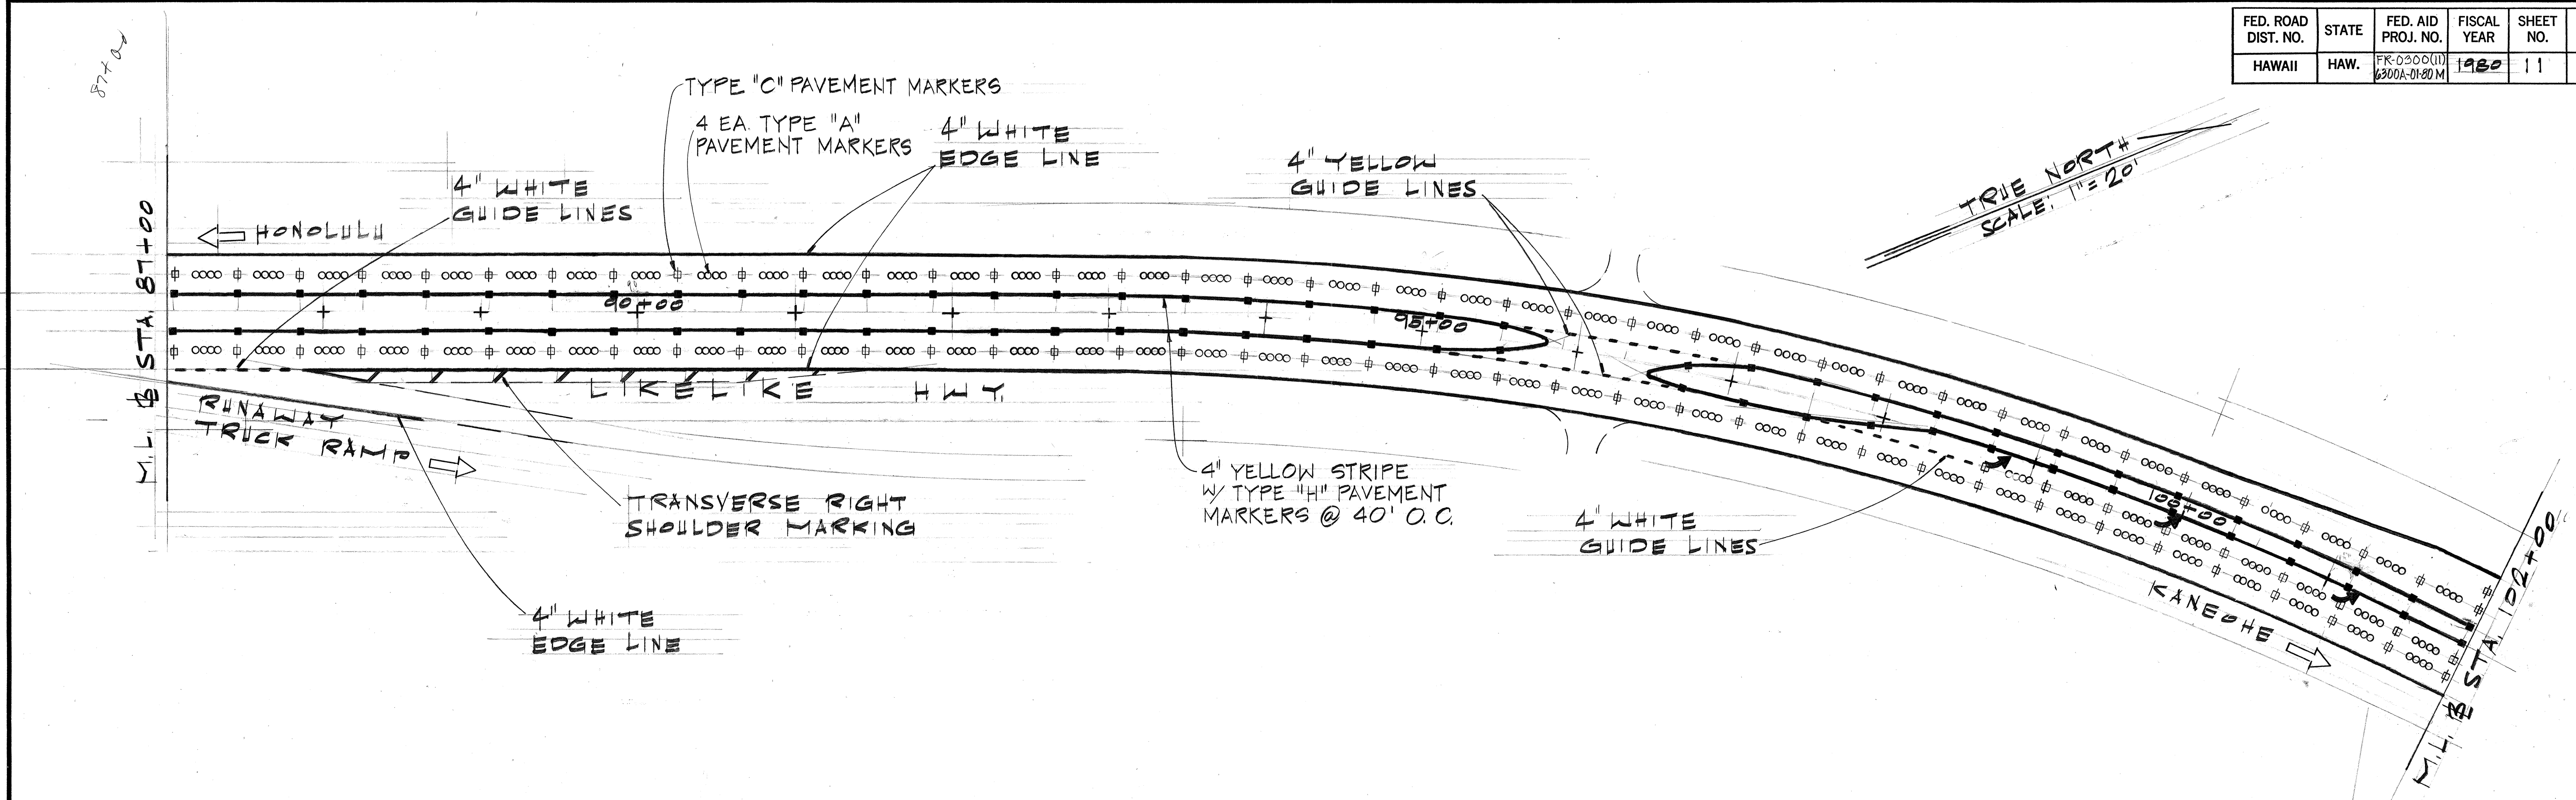

STATE OF HAWAII
DEPARTMENT OF TRANSPORTATION
HIGHWAYS DIVISION

PAVEMENT MARKINGS




RESURFACING & RECONSTRUCTING
LIKELIKE HWY. & KANEOHE BAY DR.
FED. AID PROJ. NO. FR-0300(II)
AND
PROJ. NO. 6300A-01-80M
SCALE: 1" = 50'

SHEET NO. 2 OF 6 SHEETS

ORIGINAL PLAN	SURVEY PLOTTED BY	DATE
DESIGNED BY	DRAWN BY	
NOTED BY	TRACED BY	
QUANTITIES BY	CHECKED BY	
NO.		

NOTE:
LIKELIKE HWY. &
AND RD. 1 ALL STOP
LINES 5'-0" FROM
CROSSWALKS.

FED. ROAD DIST. NO.	STATE	FED. AID PROJ. NO.	FISCAL YEAR	SHEET NO.	TOTAL SHEETS
HAWAII	HAW.	FR-0300(II) 6300A-01-80M	1980	12	21

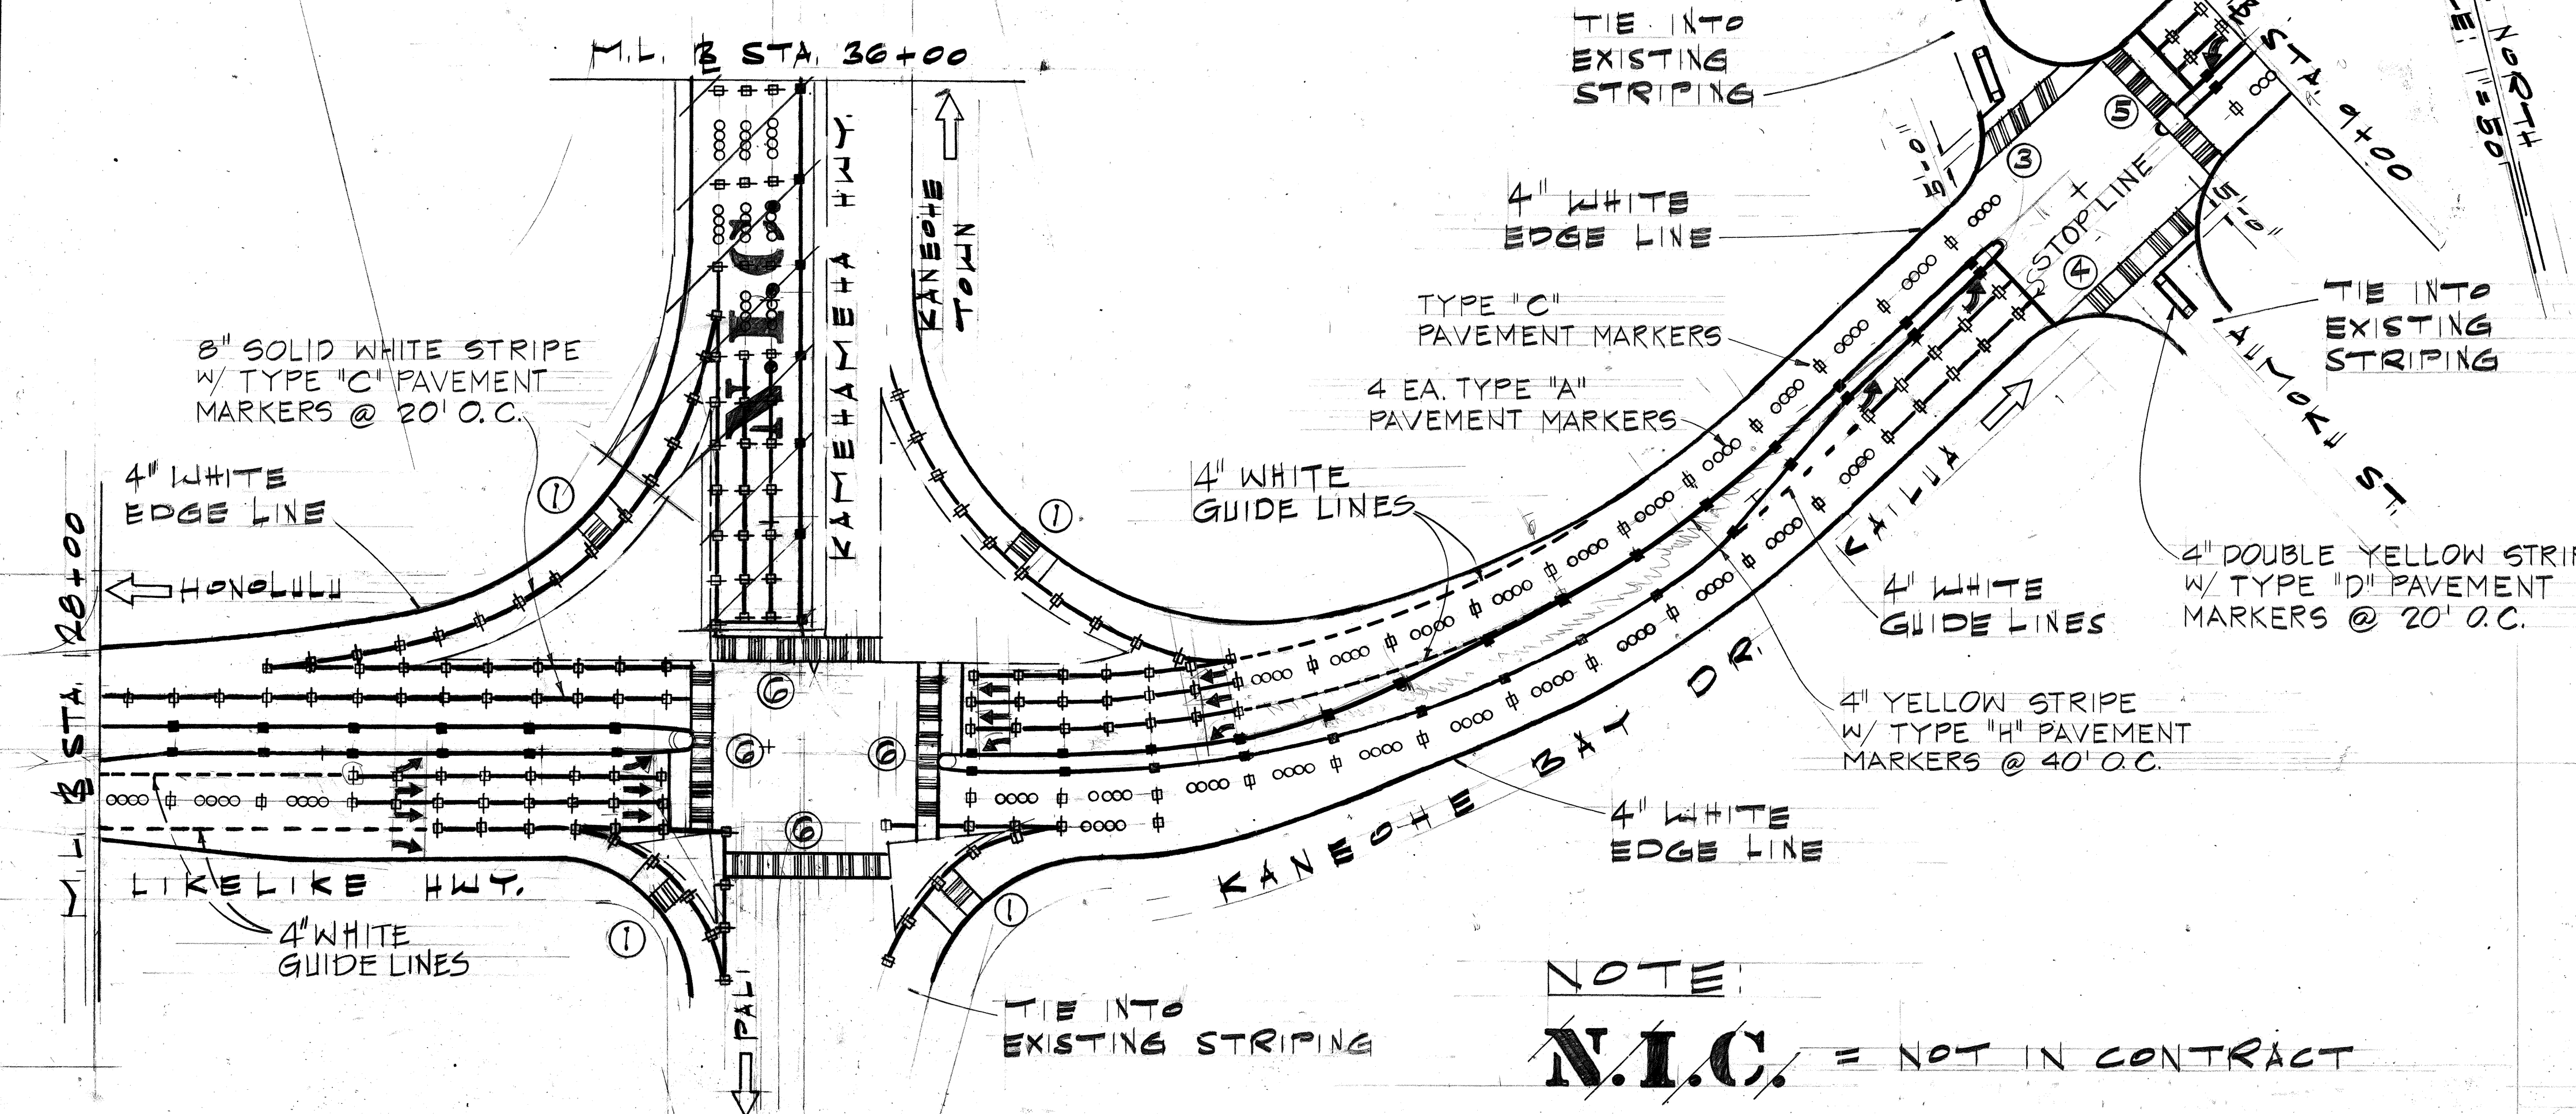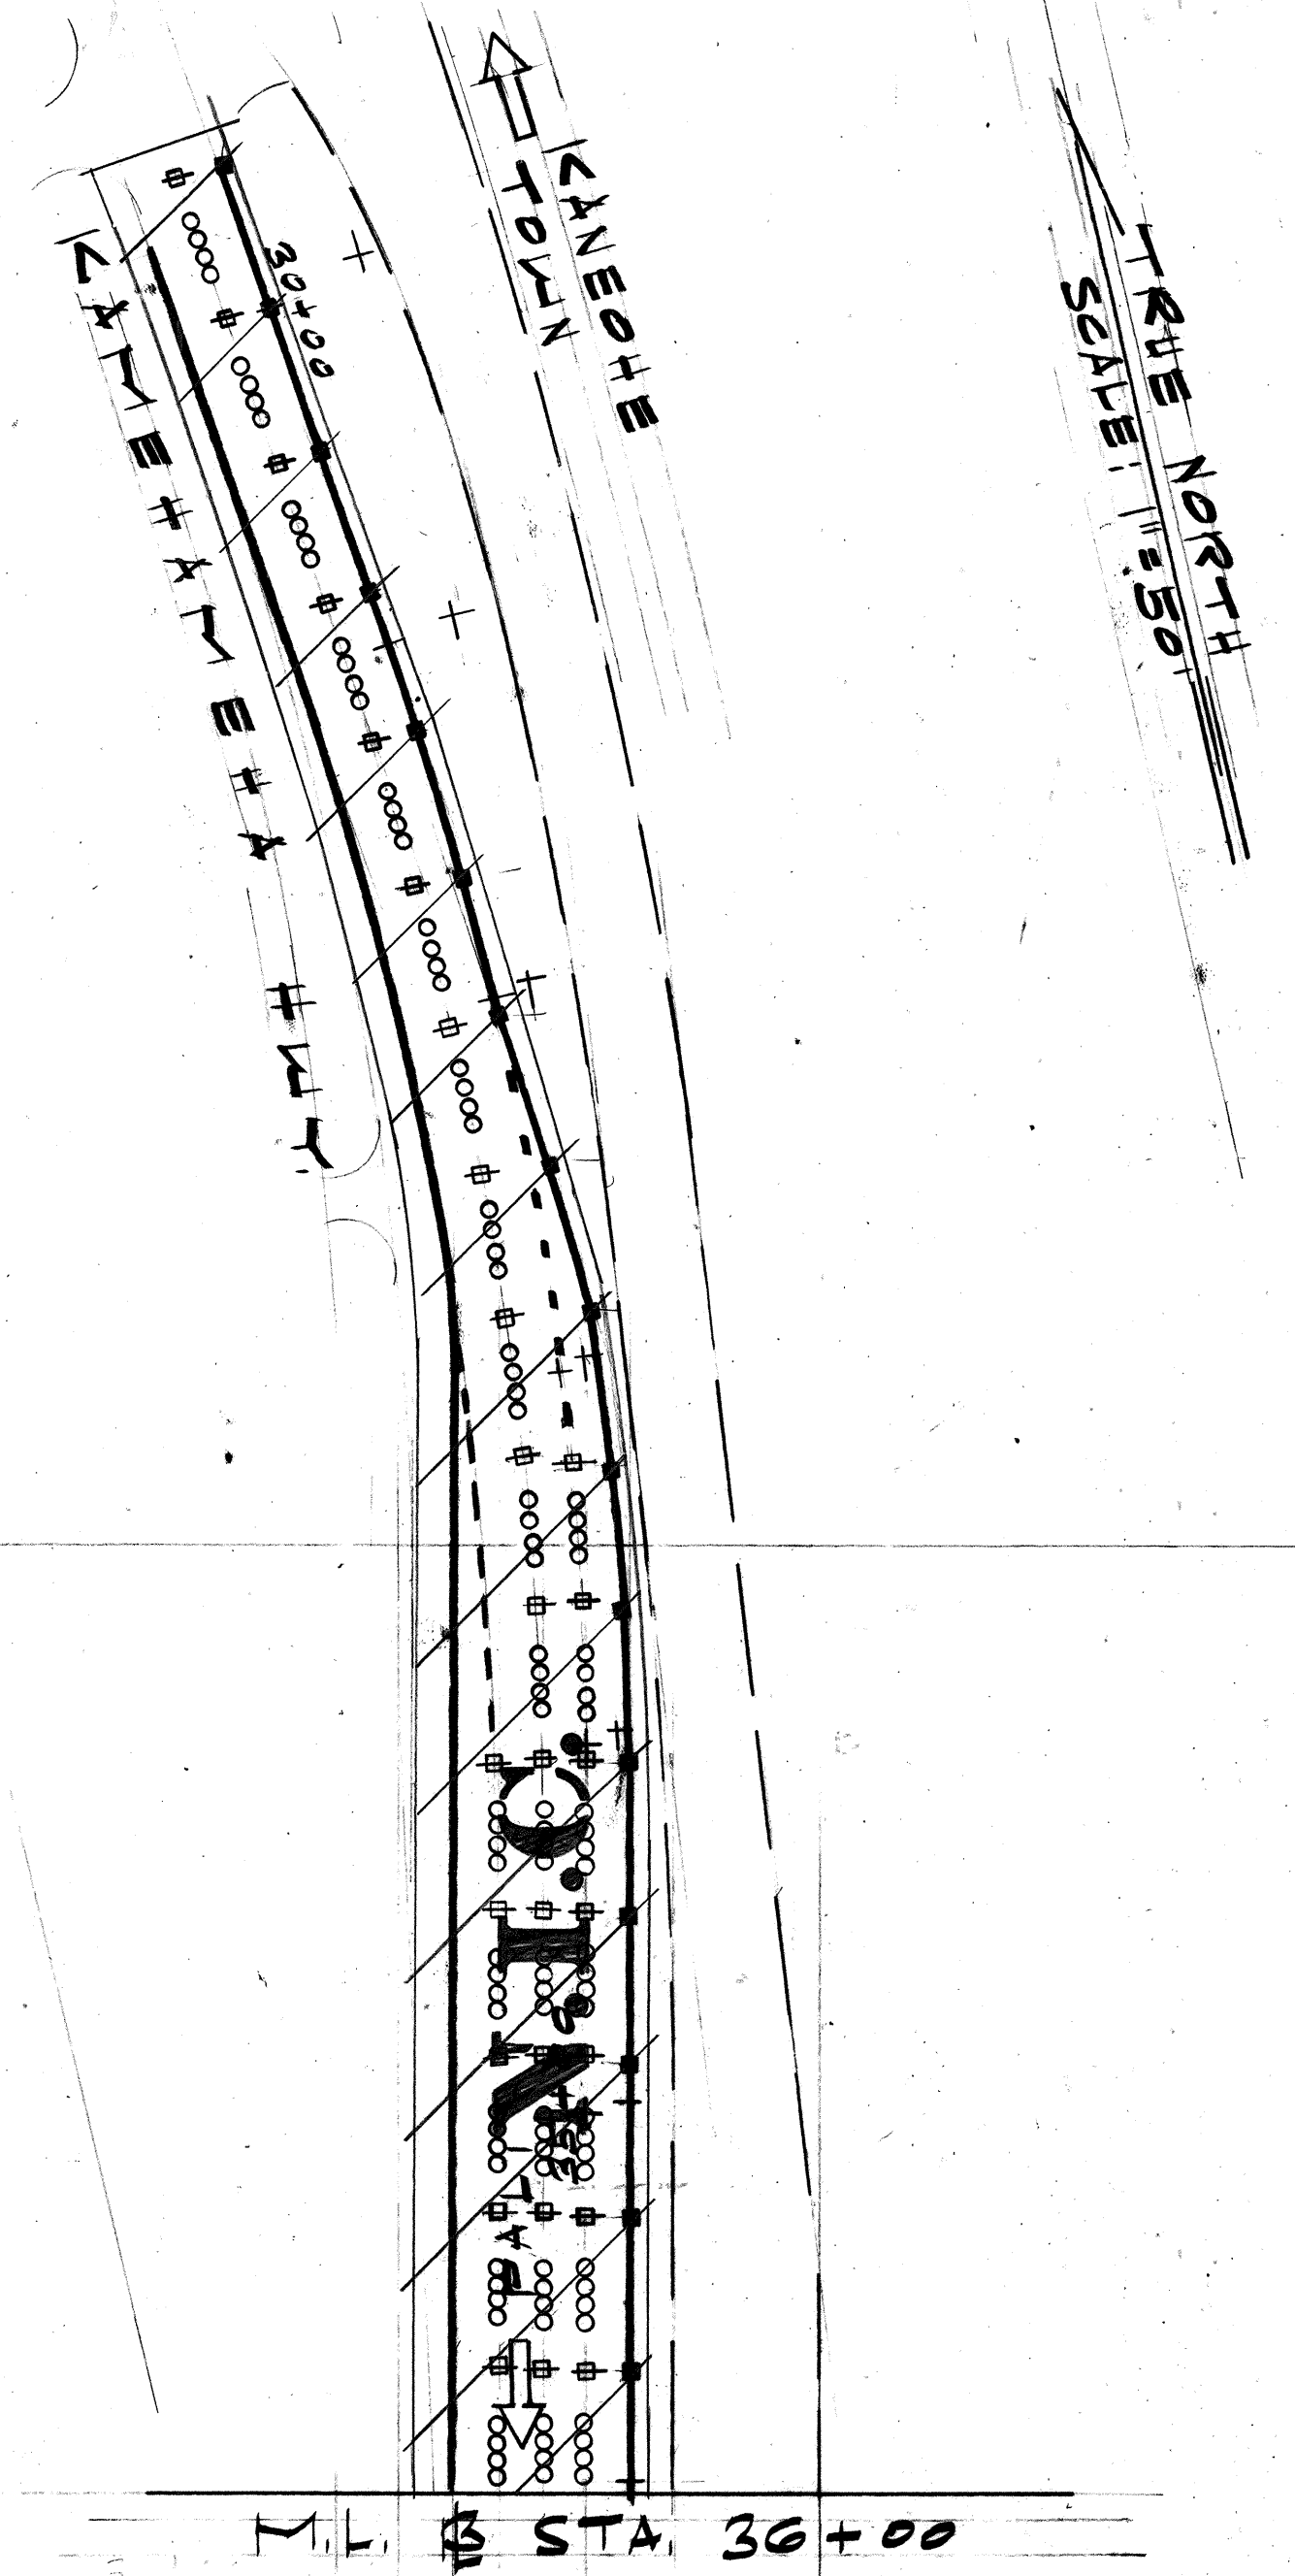
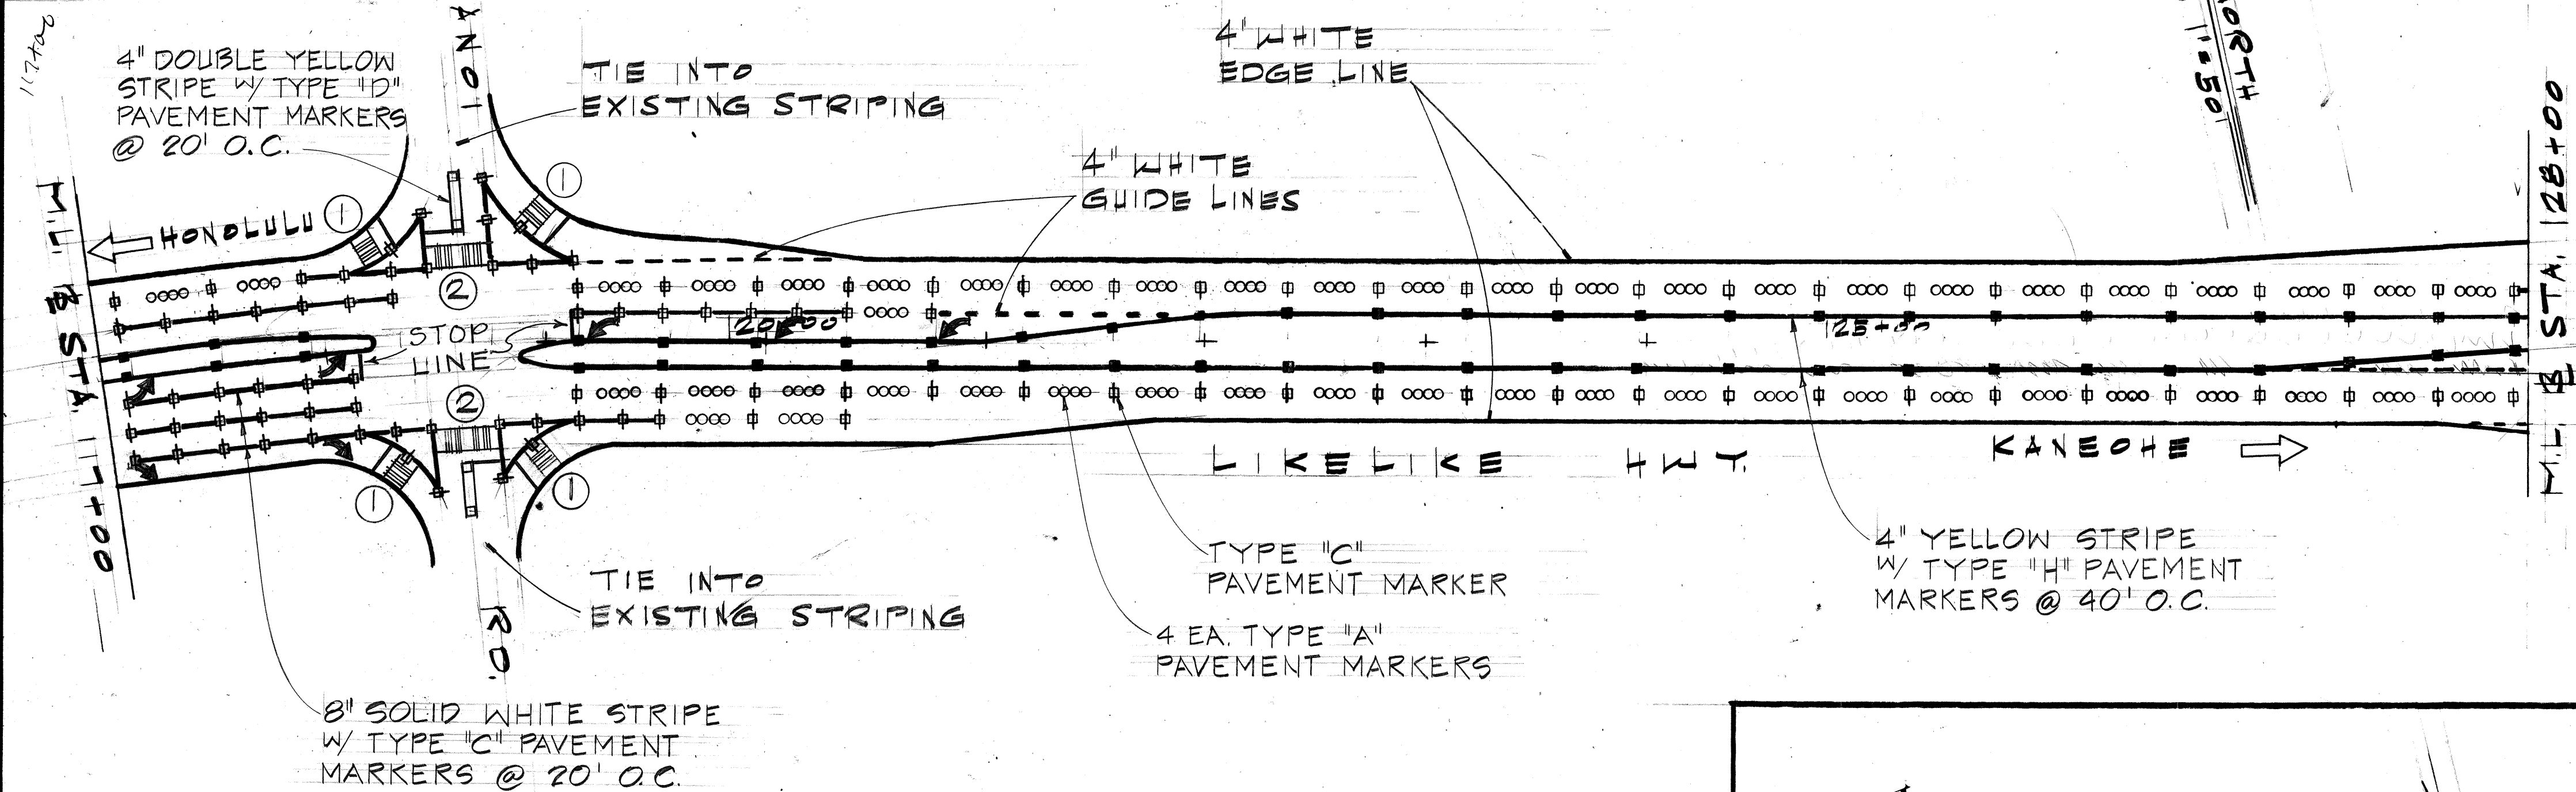


NOTE:
N.I.C. = NOT IN CONTRACT

STATE OF HAWAII
DEPARTMENT OF TRANSPORTATION
HIGHWAYS DIVISION
PAVEMENT MARKINGS
RESURFACING & RECONSTRUCTING
LIKELIKE HWY. & KANE OHE BAY DR.
FED. AID PROJ. NO. FR-0300(II)
AND
PROJ. NO. 6300A-01-80M
SCALE: 1" = 50'
SHEET No. 3 OF 6 SHEETS

DATE	_____
SURVEY PLOTTED BY	_____
DRAWN BY	_____
TRACED BY	_____
NOTED BY	_____
CHECKED BY	_____
ORIGINAL PLAN	_____
NOTE BOOK	_____
No.	_____

FED. ROAD DIST. NO.	STATE	FED. AID PROJ. NO.	FISCAL YEAR	SHEET NO.	TOTAL SHEETS
HAWAII	HAW.	FR-0300(II) 6300A-01-80M	1980	13	21

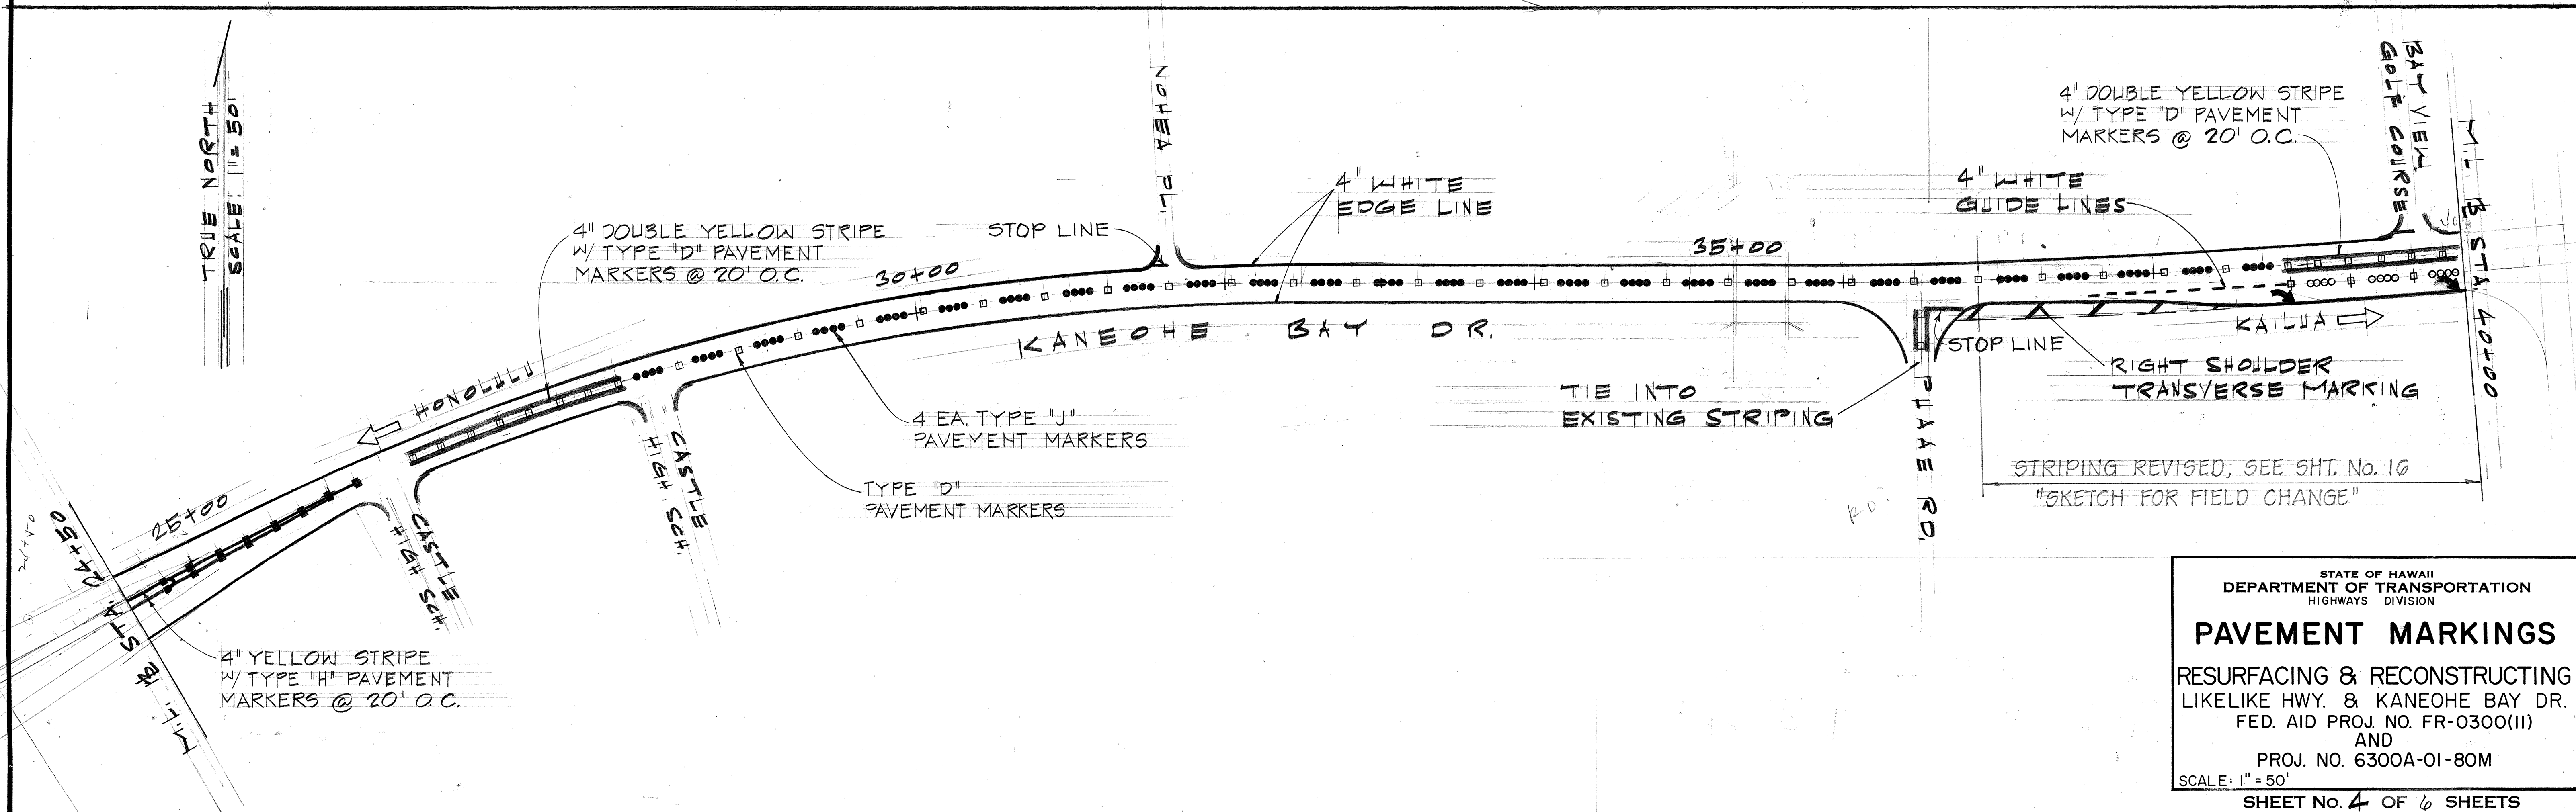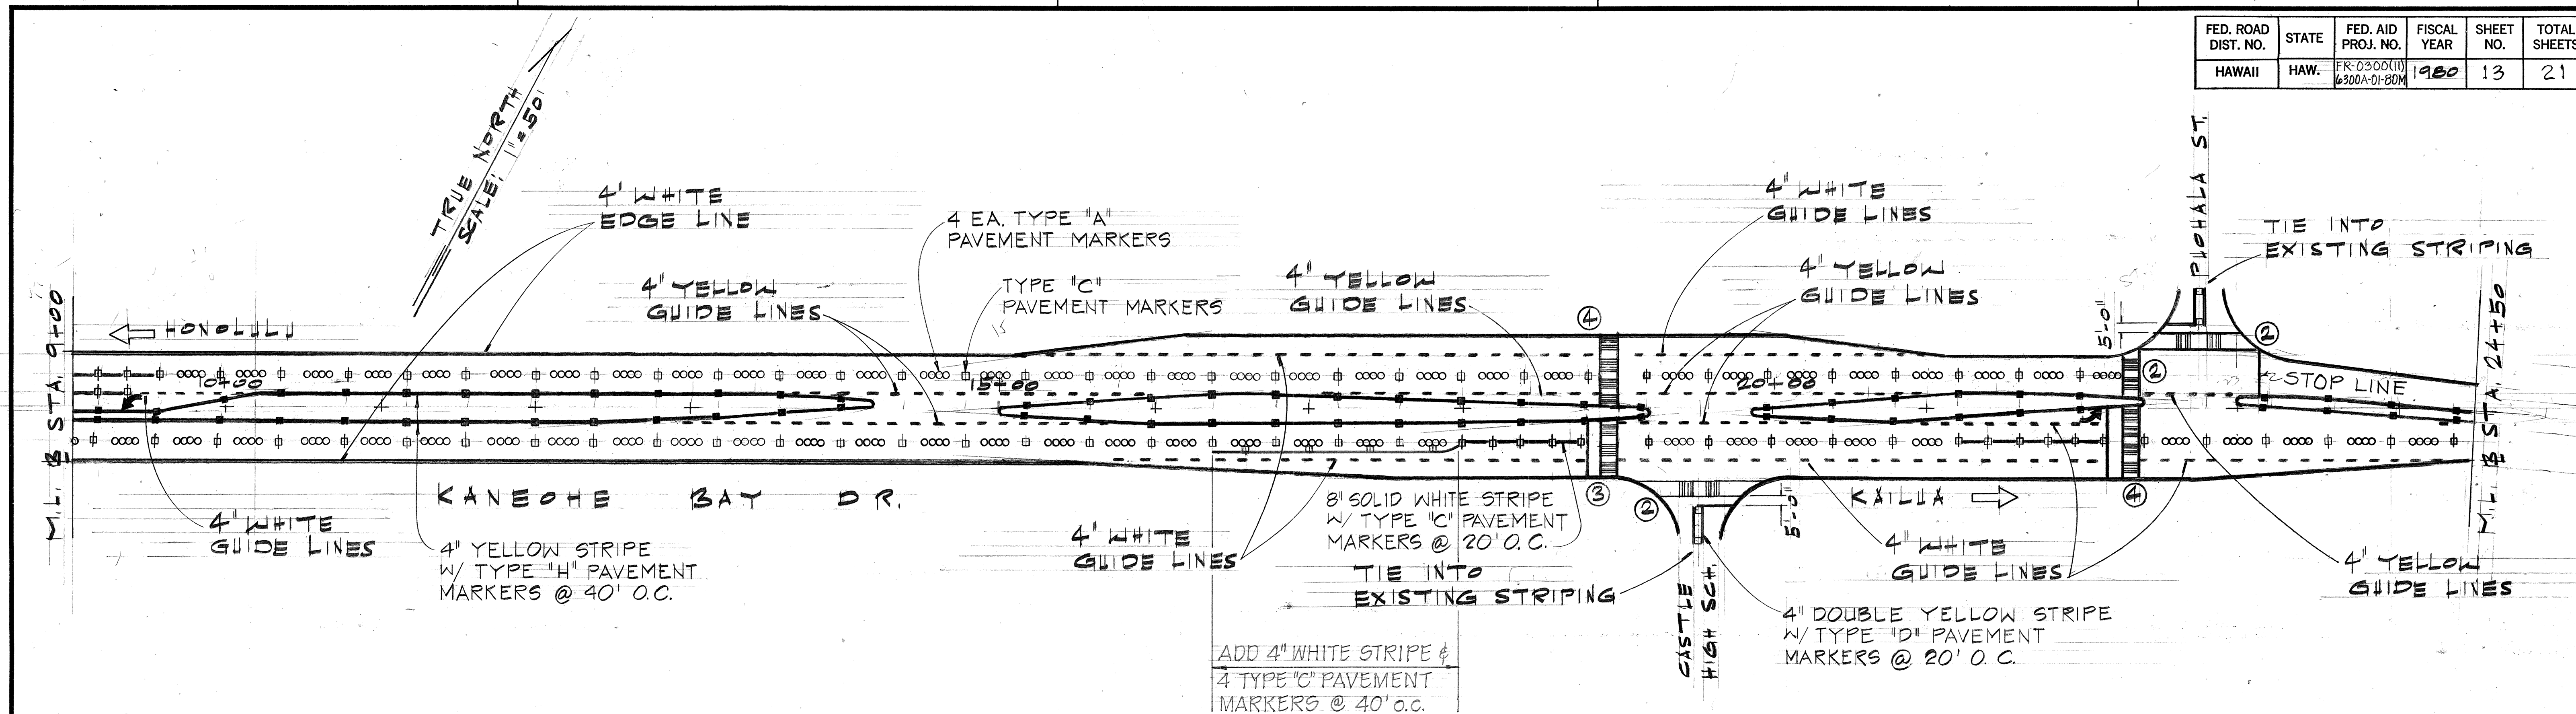

ORIGINAL PLAN	SURVEY PLOTTED BY	DATE
NOTE BOOK	DRAWN BY	" "
NO.	DESIGNED BY	" "
	CHECKED BY	" "

STATE OF HAWAII
DEPARTMENT OF TRANSPORTATION
HIGHWAYS DIVISION



PAVEMENT MARKINGS

RESURFACING & RECONSTRUCTING
LIKELIKE HWY. & KANEOHE BAY DR.
FED. AID PROJ. NO. FR-0300(II)
AND
PROJ. NO. 6300A-01-80M

SCALE: 1" = 50'

SHEET No. 4 OF 6 SHEETS

FED. ROAD DIST. NO.	STATE	FED. AID PROJ. NO.	FISCAL YEAR	SHEET NO.	TOTAL SHEETS
HAWAII	HAW.	FR-0300(II) 6300A-01-80M	1980	14	21

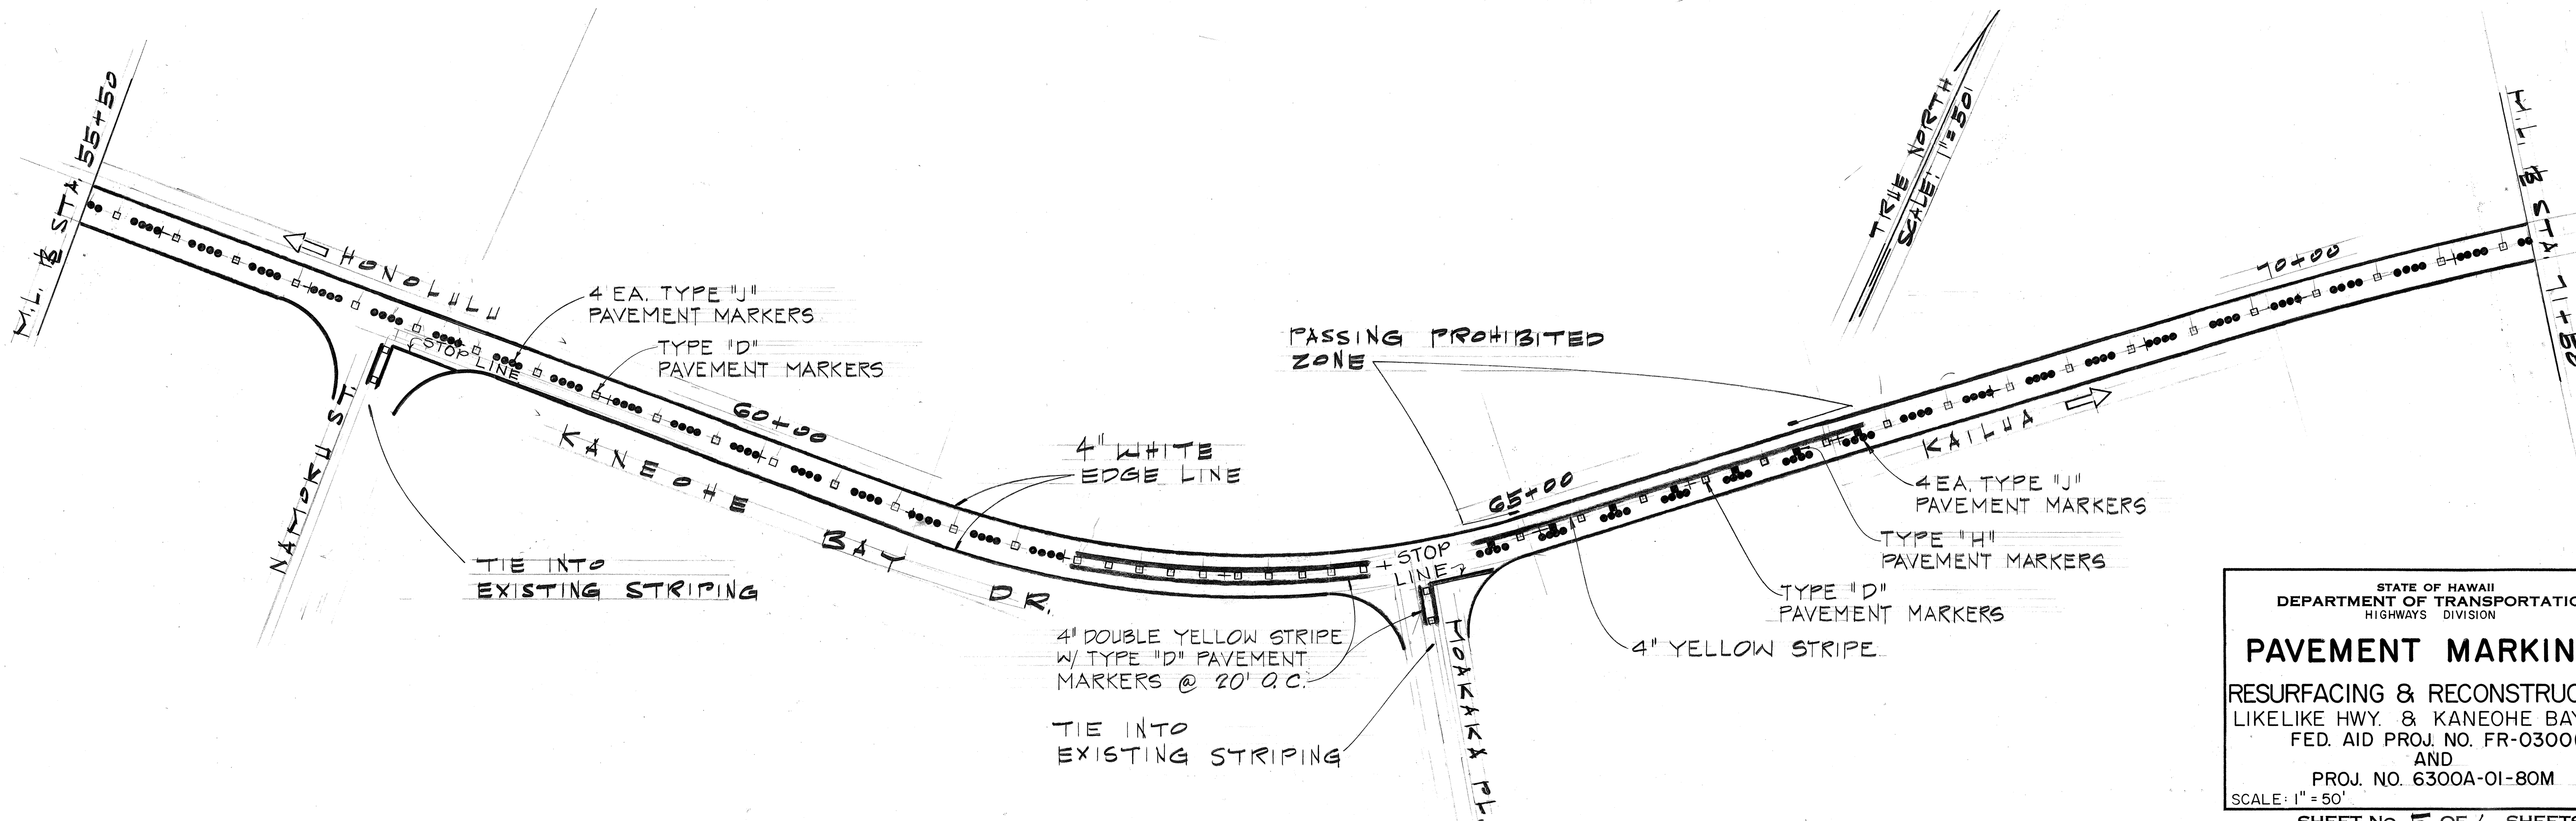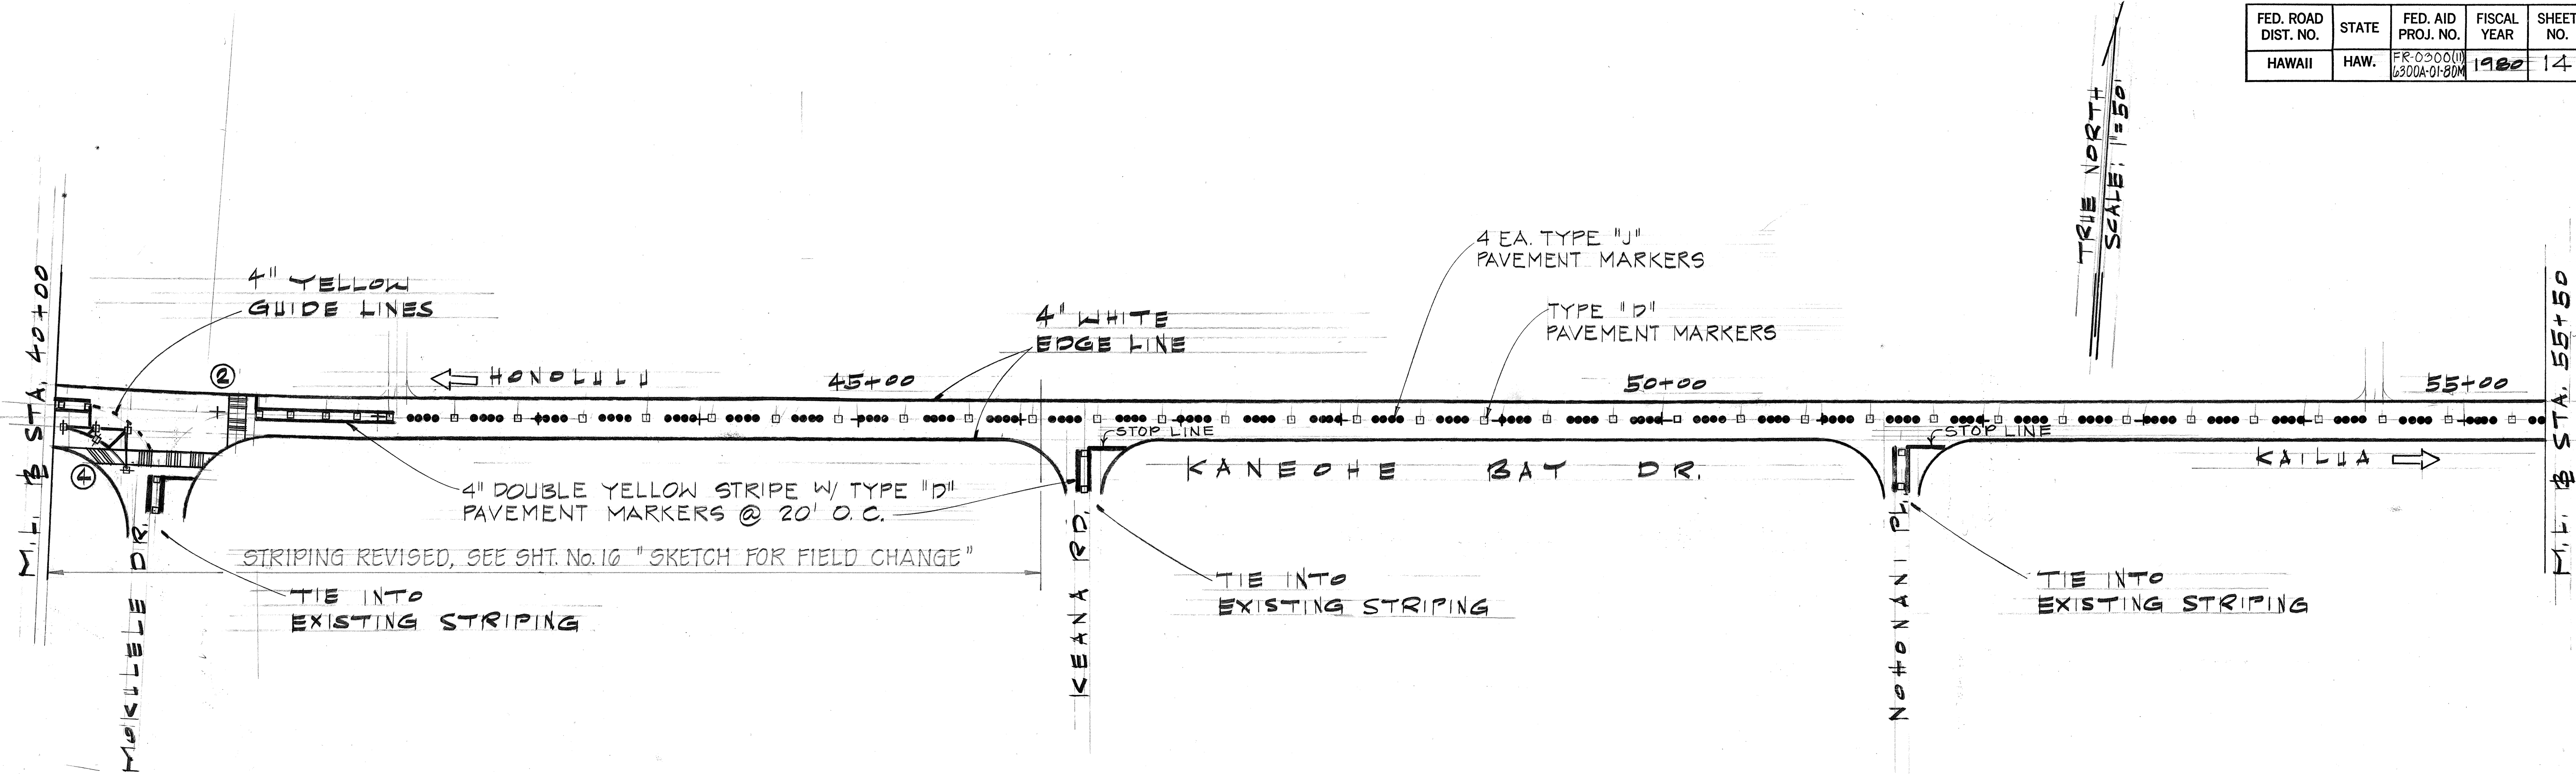

ORIGINAL PLAN	DATE
SURVEY PLOTTED BY	
DESIGNED BY	
NOTED BY	
CHECKED BY	

STATE OF HAWAII
DEPARTMENT OF TRANSPORTATION
HIGHWAYS DIVISION



PAVEMENT MARKINGS

RESURFACING & RECONSTRUCTING
LIKELIKE HWY. & KANEOHE BAY DR.
FED. AID PROJ. NO. FR-0300(II)
AND
PROJ. NO. 6300A-01-80M

SCALE: 1" = 50'

SHEET NO. 5 OF 6 SHEETS

FED. ROAD DIST. NO.	STATE	FED. AID PROJ. NO.	FISCAL YEAR	SHEET NO.	TOTAL SHEETS
HAWAII	HAW.	FR-0300(II) 6300A-01-80M	1980	15	21

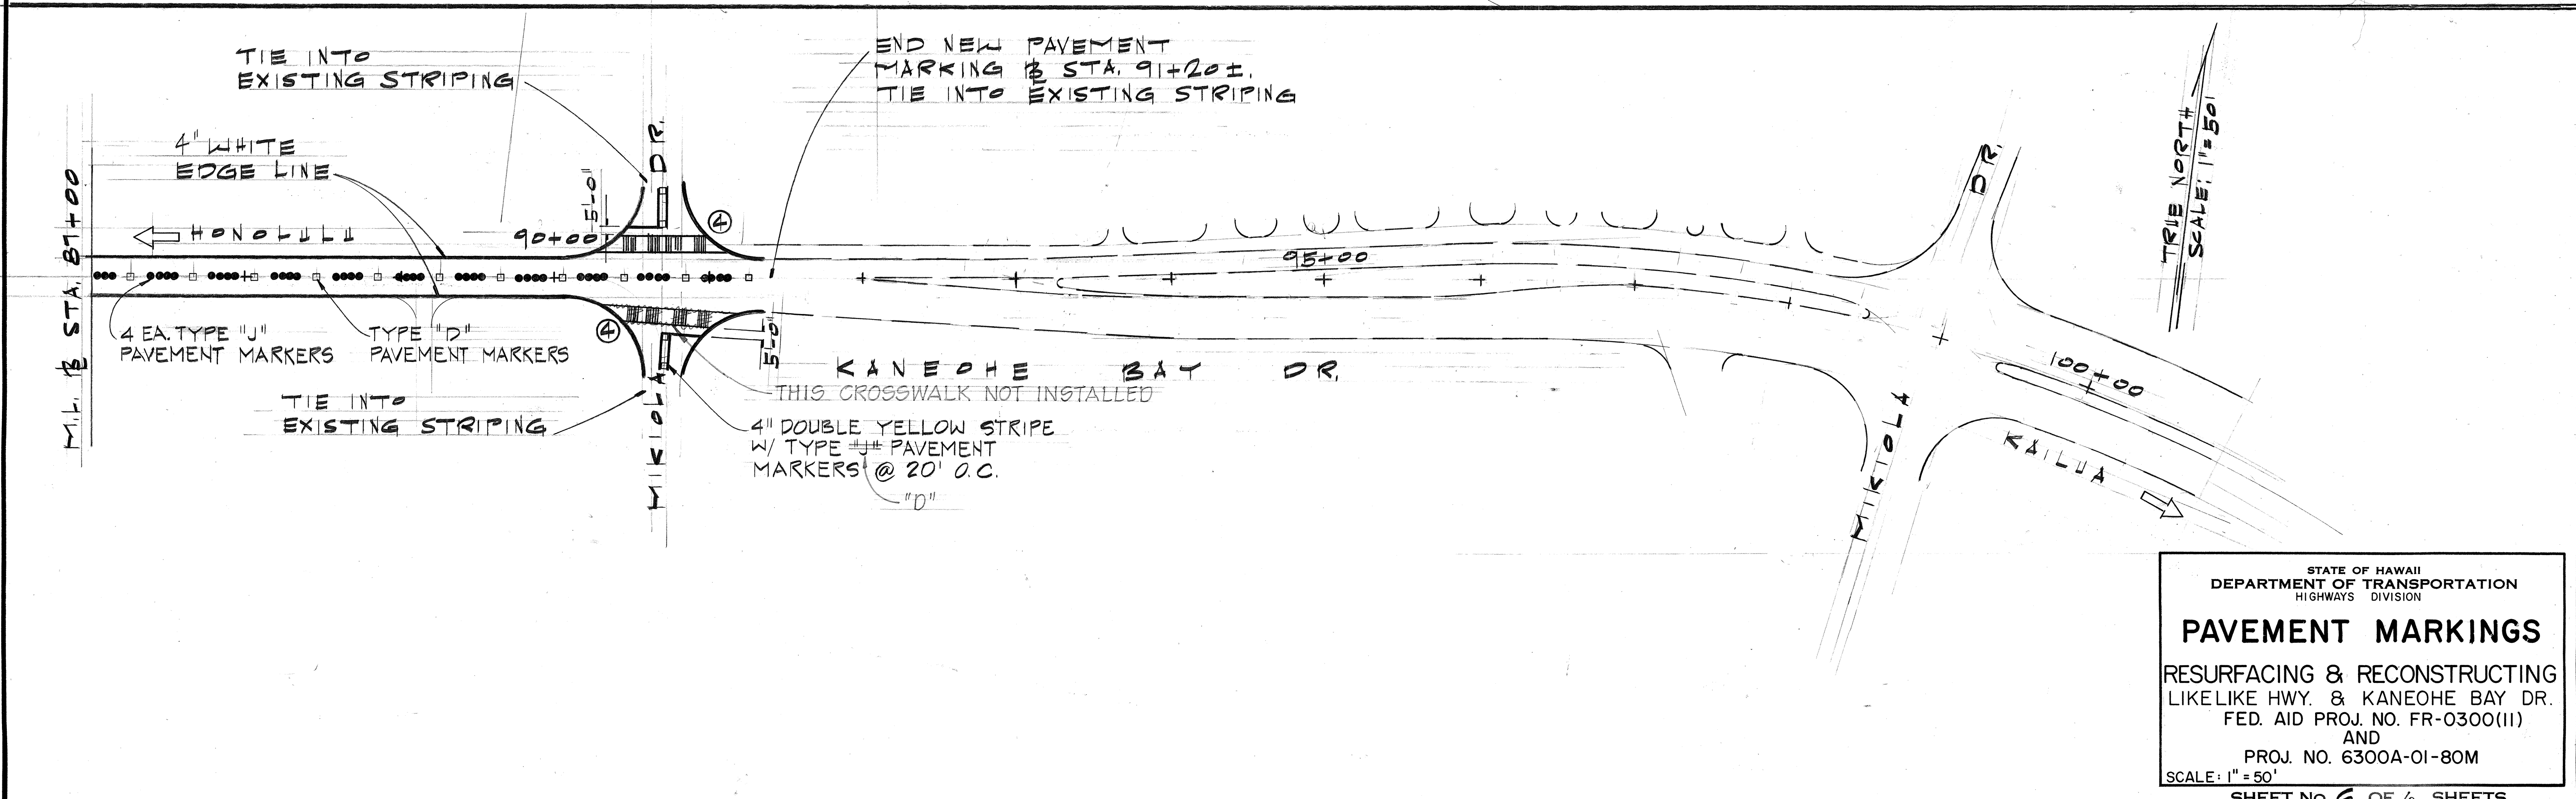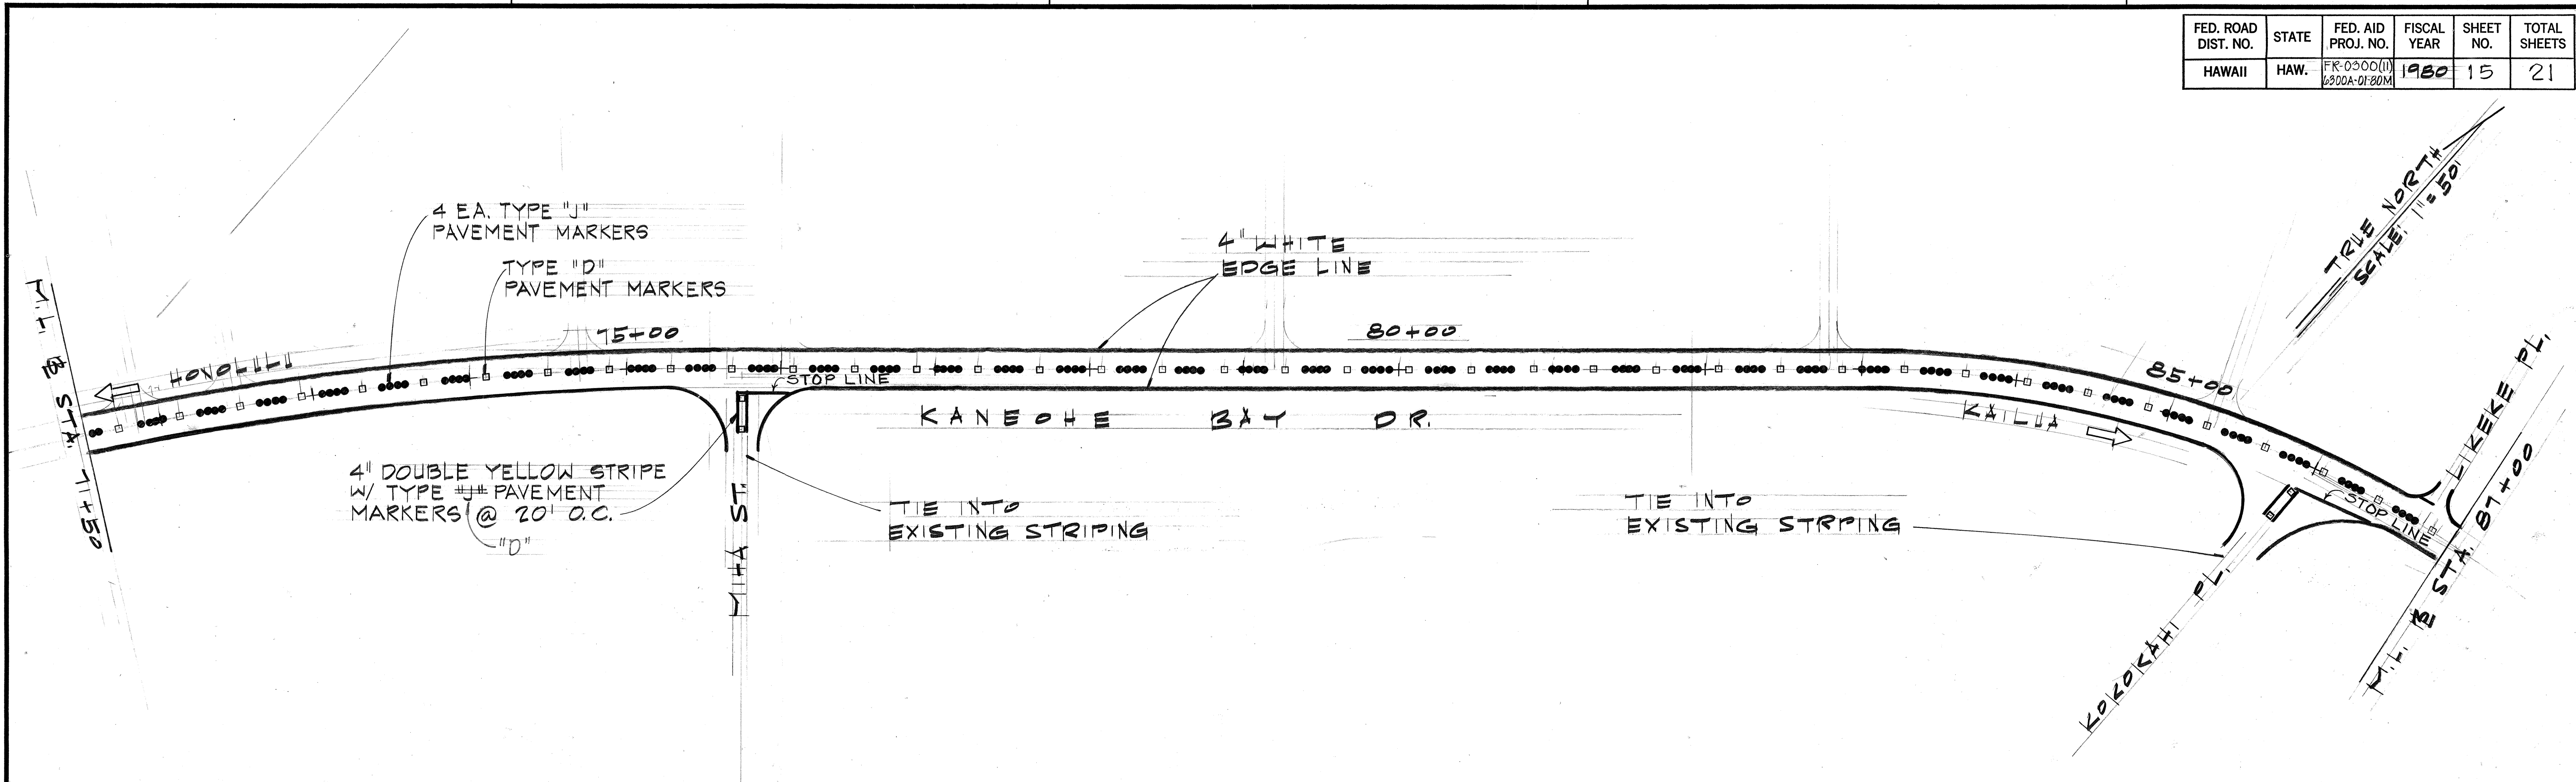

DATE	_____
SURVEY PLOTTED BY	_____
DRAWN BY	_____
TRACED BY	_____
QUANTITIES BY	_____
CHECKED BY	_____
ORIGINAL PLAN	_____
NOTE BOOK	_____
No.	_____

STATE OF HAWAII
DEPARTMENT OF TRANSPORTATION
HIGHWAYS DIVISION

PAVEMENT MARKINGS

RESURFACING & RECONSTRUCTING
LIKELIKE HWY. & KANE O H E B A Y D R.
FED. AID PROJ. NO. FR-0300(II)
AND
PROJ. NO. 6300A-01-80M
SCALE: 1" = 50'

SHEET No. 6 OF 6 SHEETS