

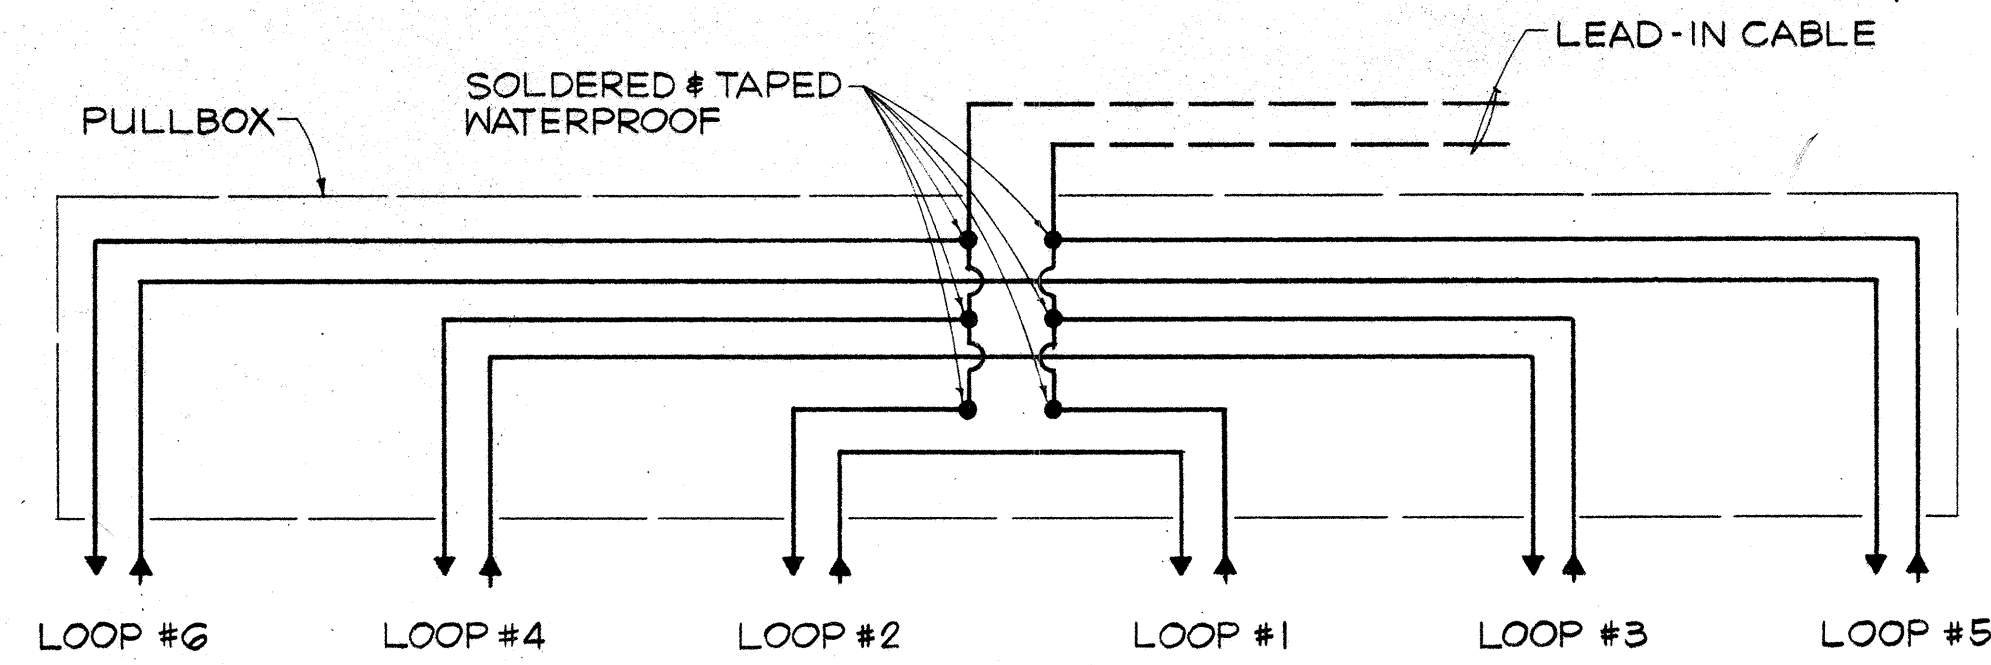






FED. ROAD DIST. NO.	STATE	PROJ. NO.	FISCAL YEAR	SHEET NO.	TOTAL SHEETS
HAWAII	HAW.	63A-01-80	1980	4	16

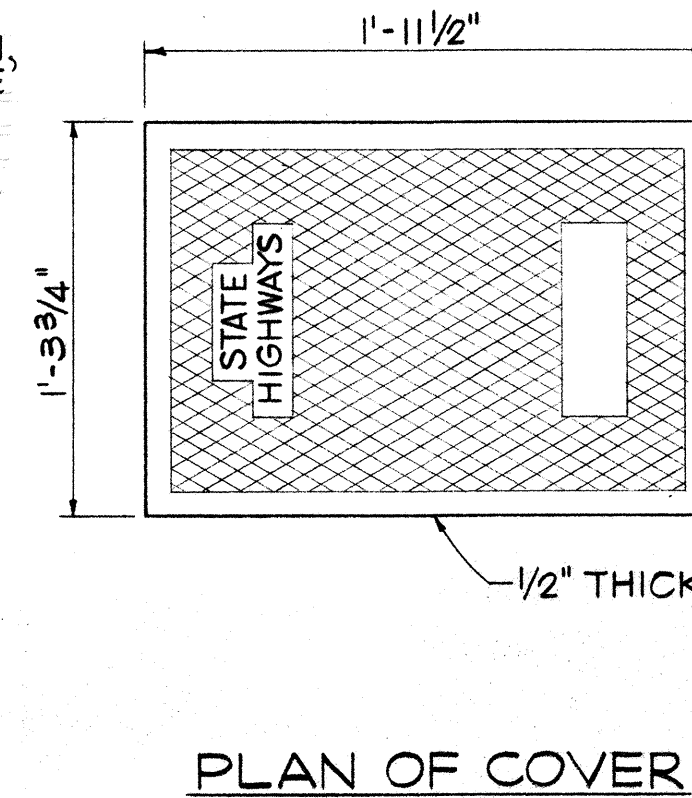

TYPICAL SERIES-PARALLEL LOOP CONNECTION
NOT TO SCALE

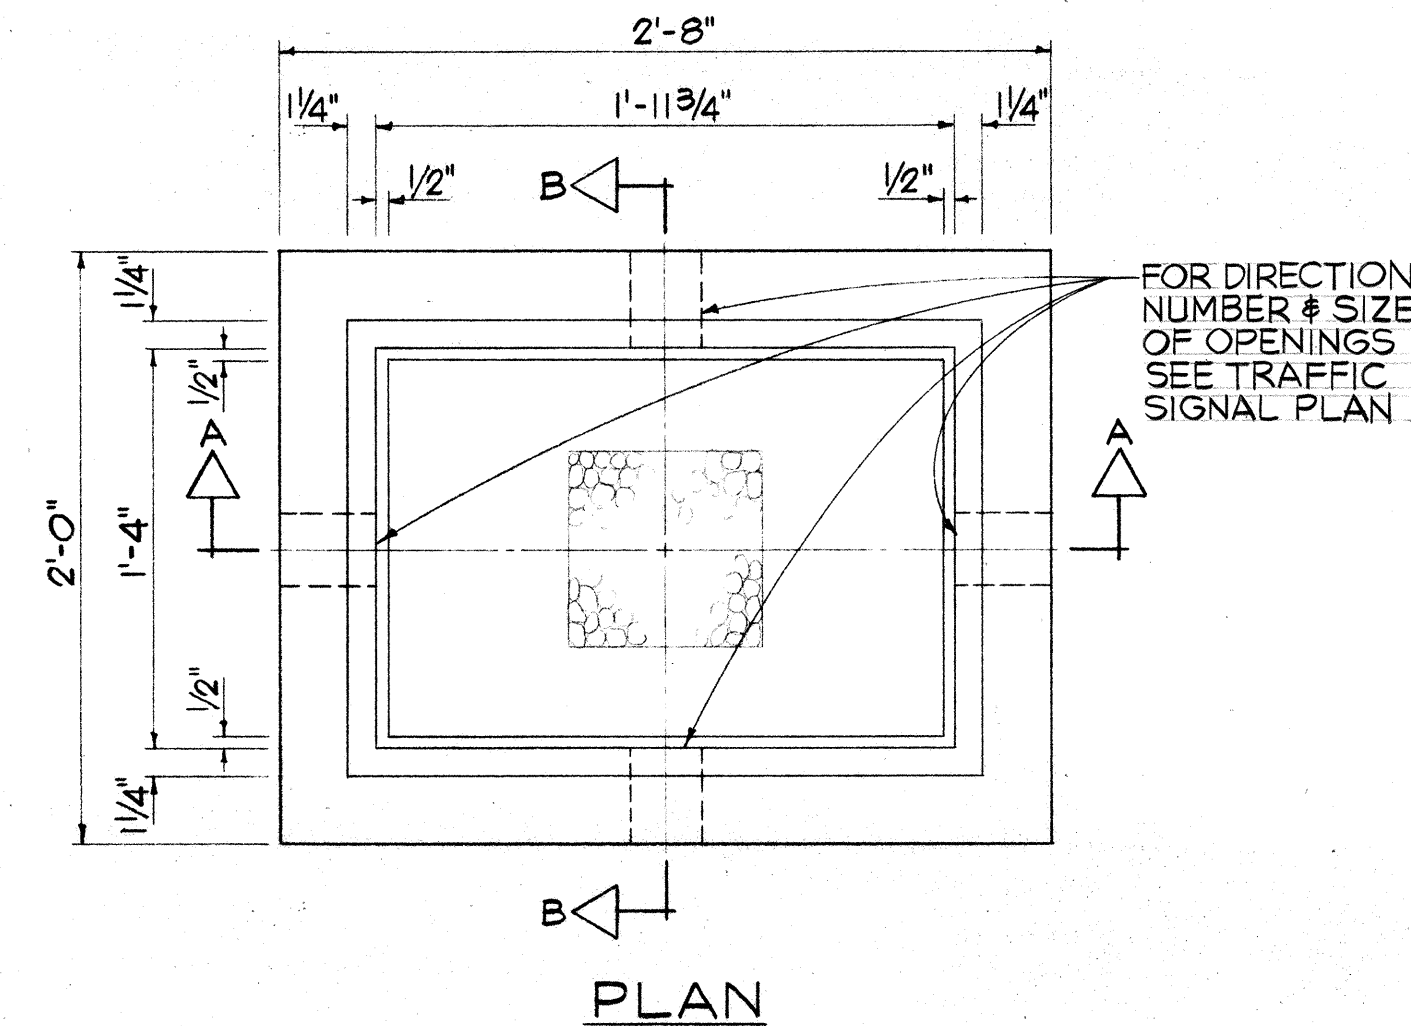


NOTE:
EXCEPT AS NOTED, COVER DETAILS SHALL CONFORM TO TYPE "B" PULLBOX COVER SEE SHEET DT 401

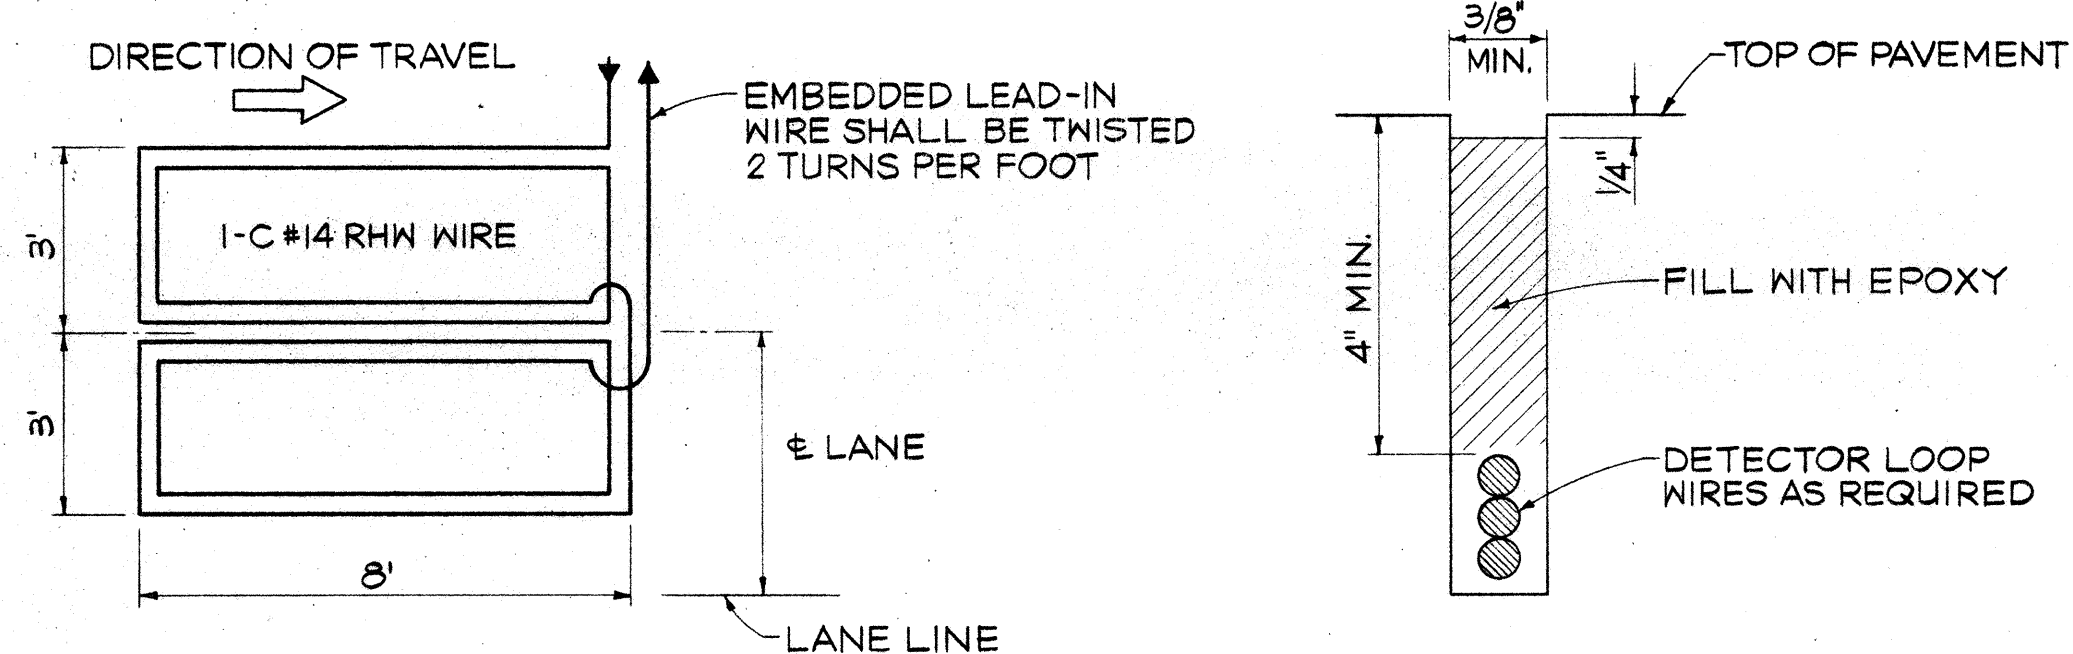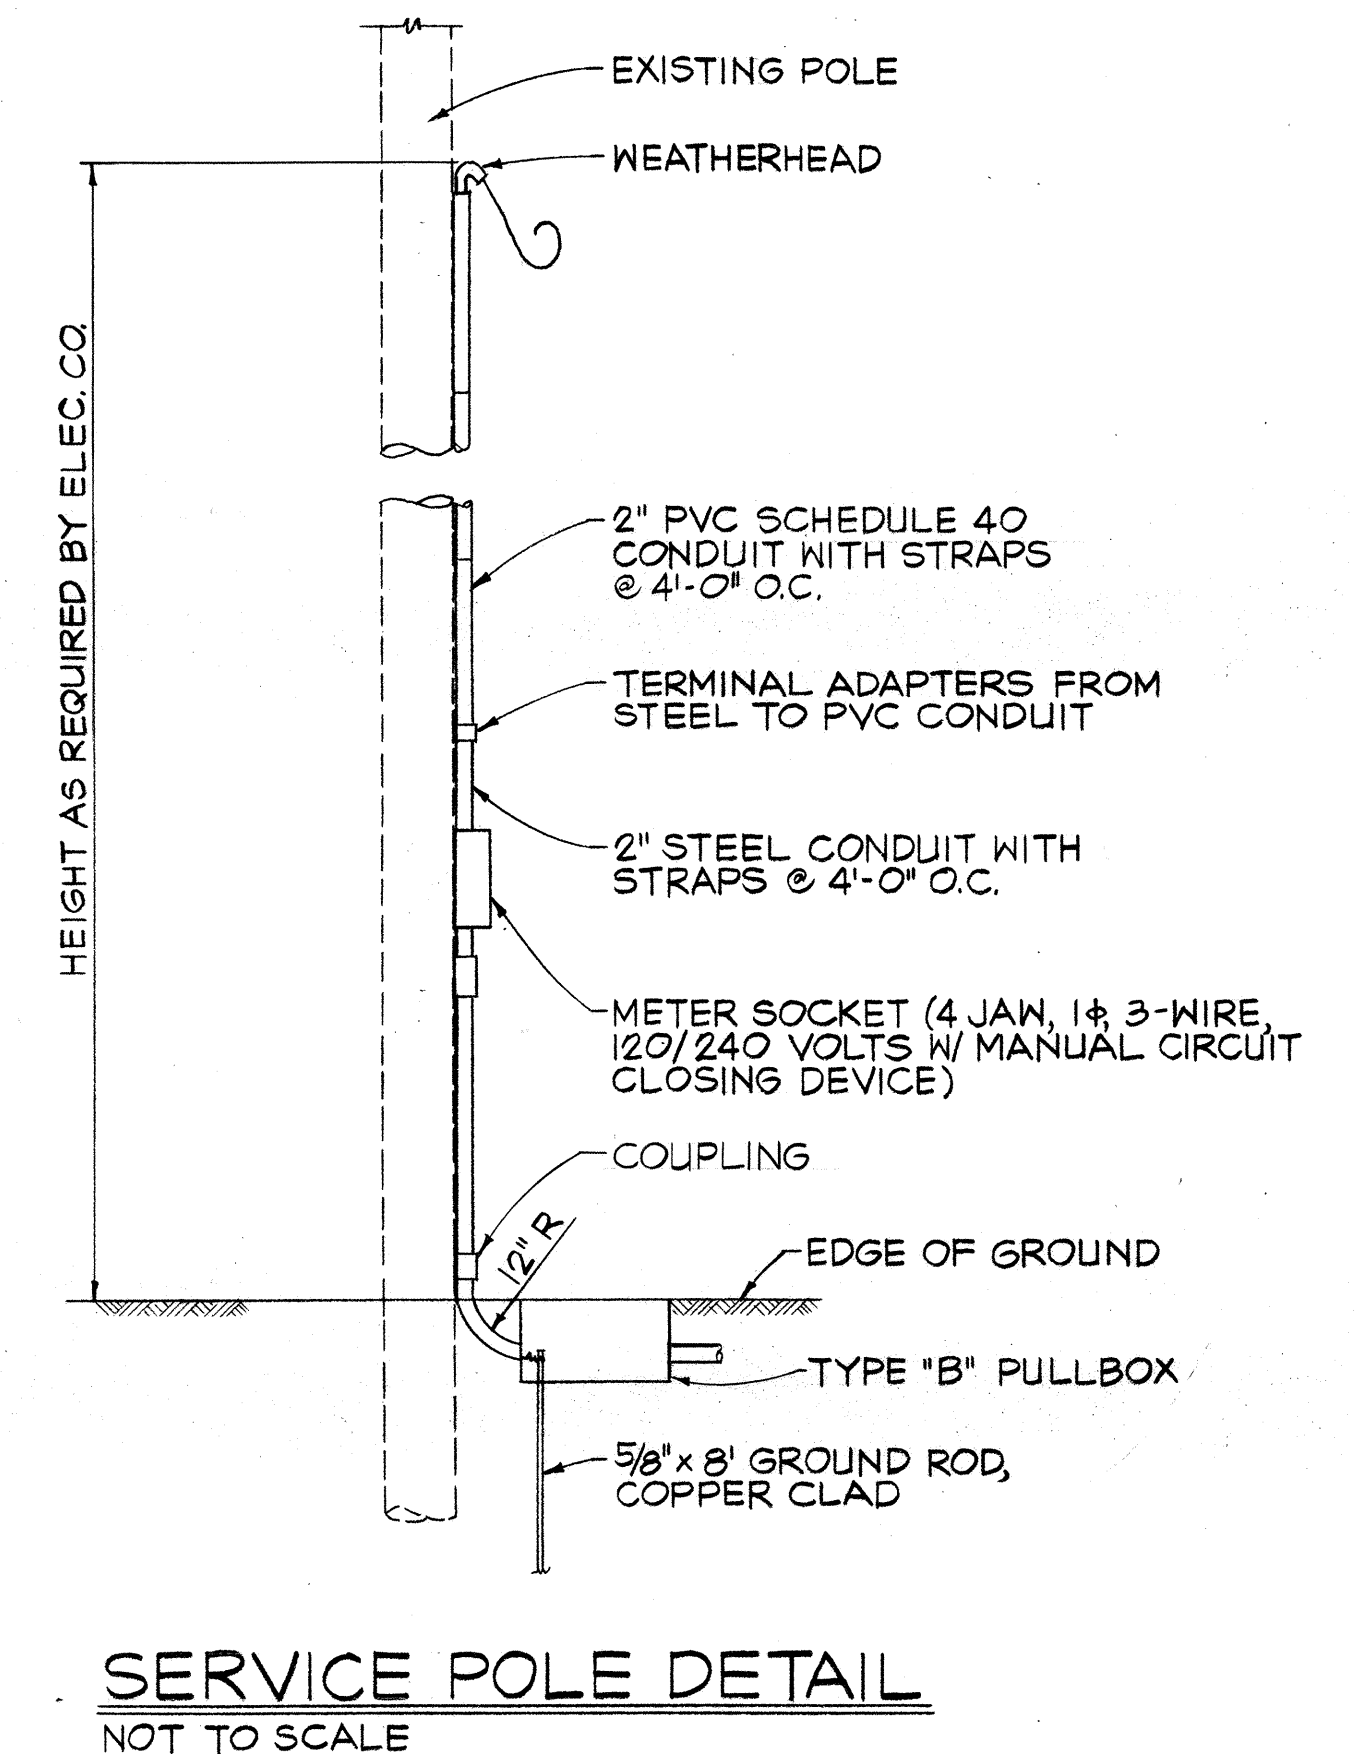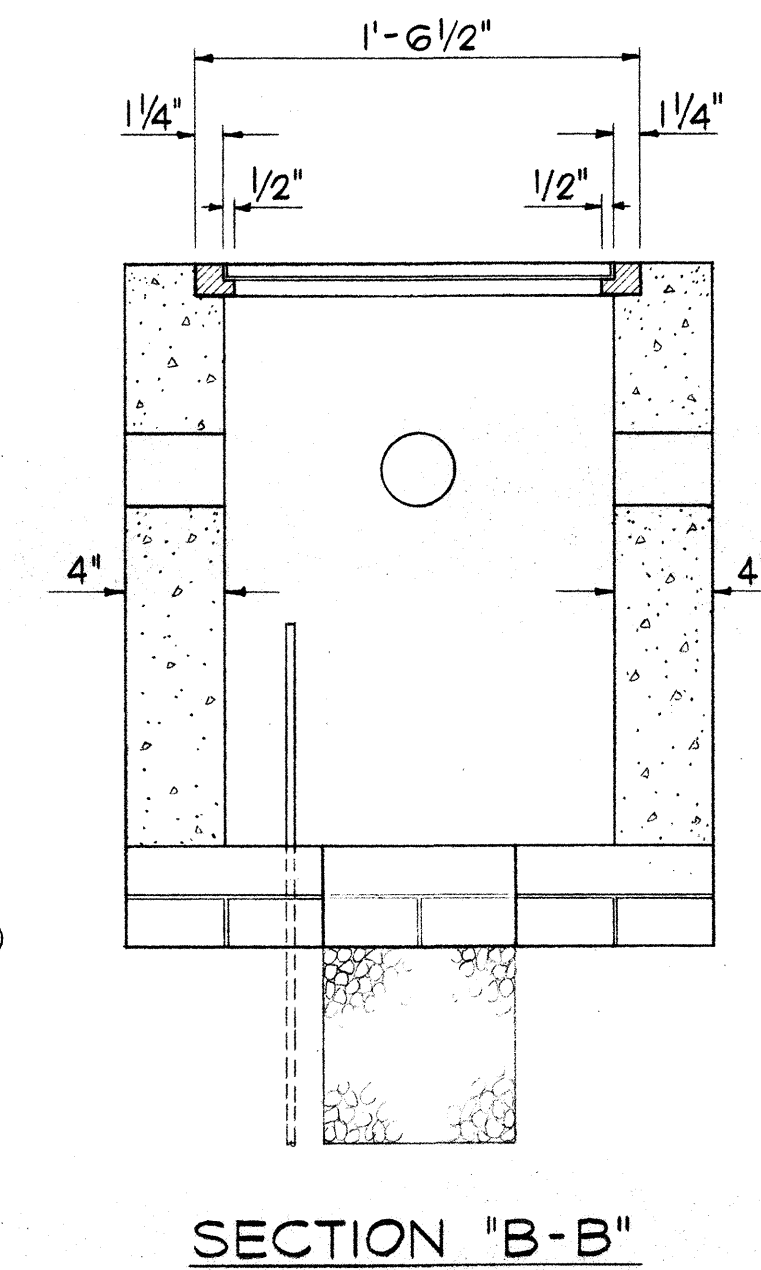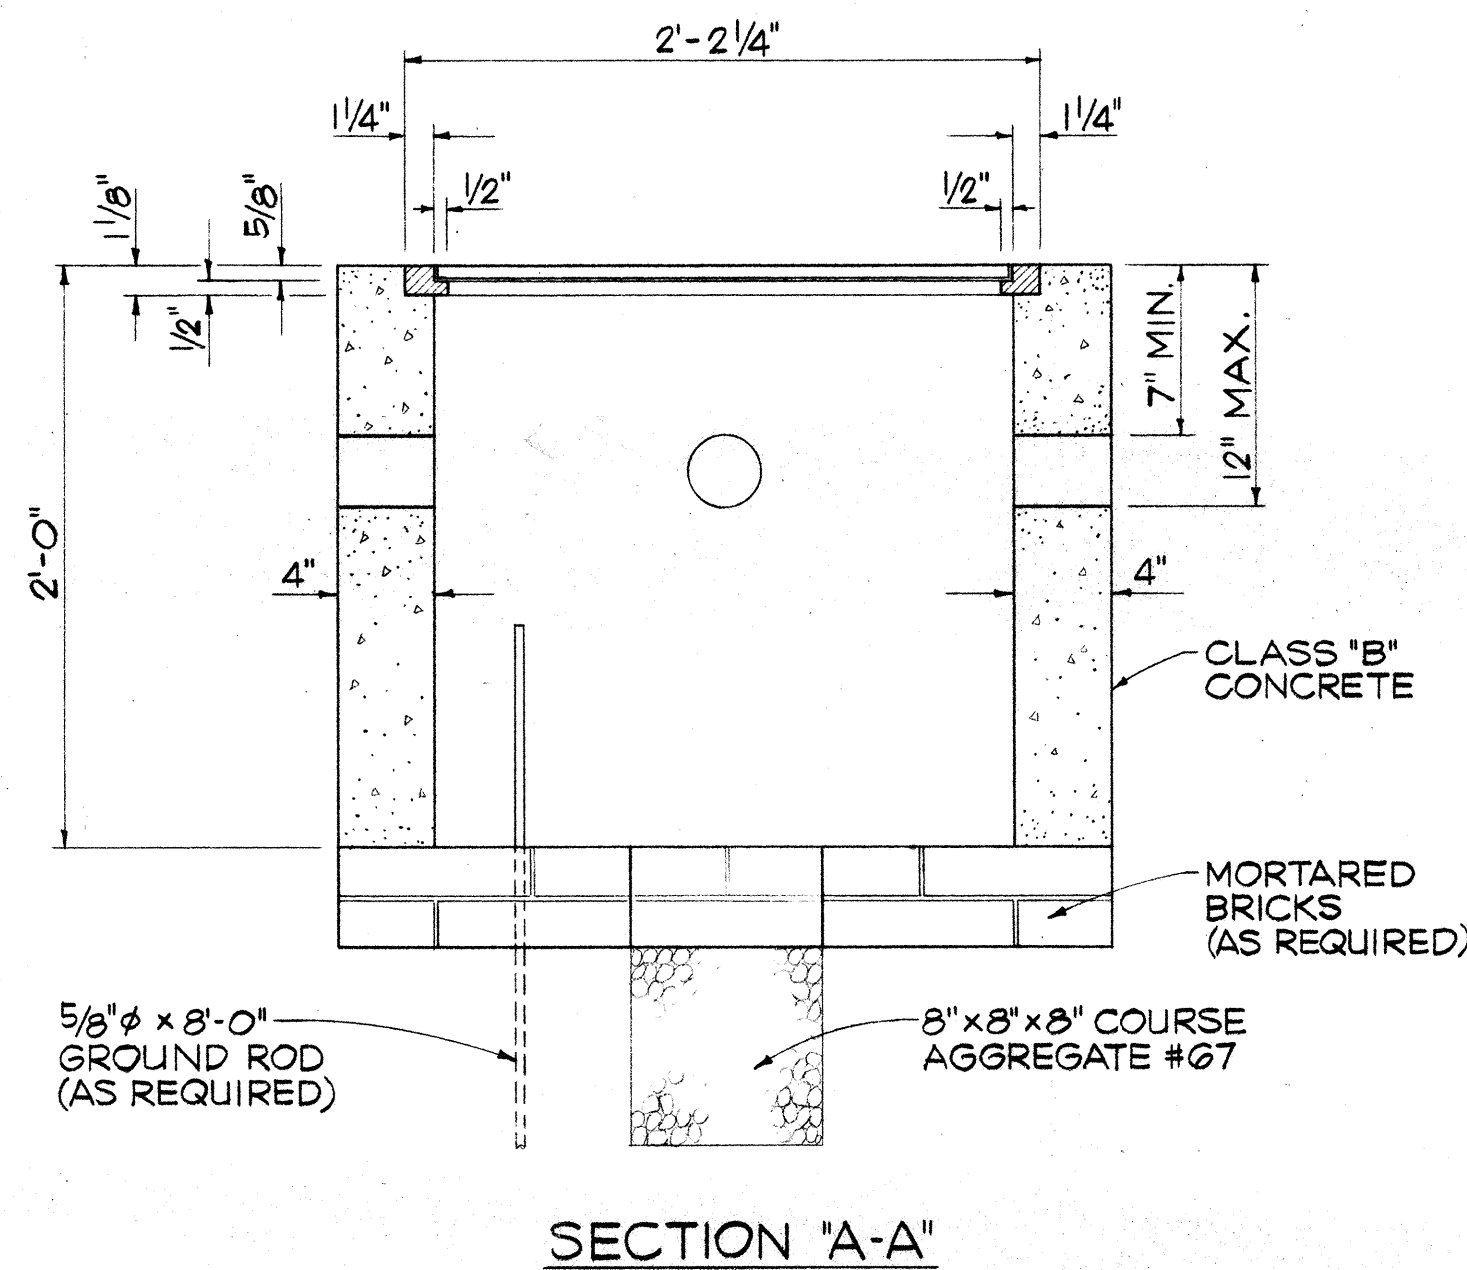


TYPICAL DETECTOR LOOP SAW-CUT
NOT TO SCALE

TYPICAL WIRING FOR 8' x 6' LOOP DETECTOR
NOT TO SCALE

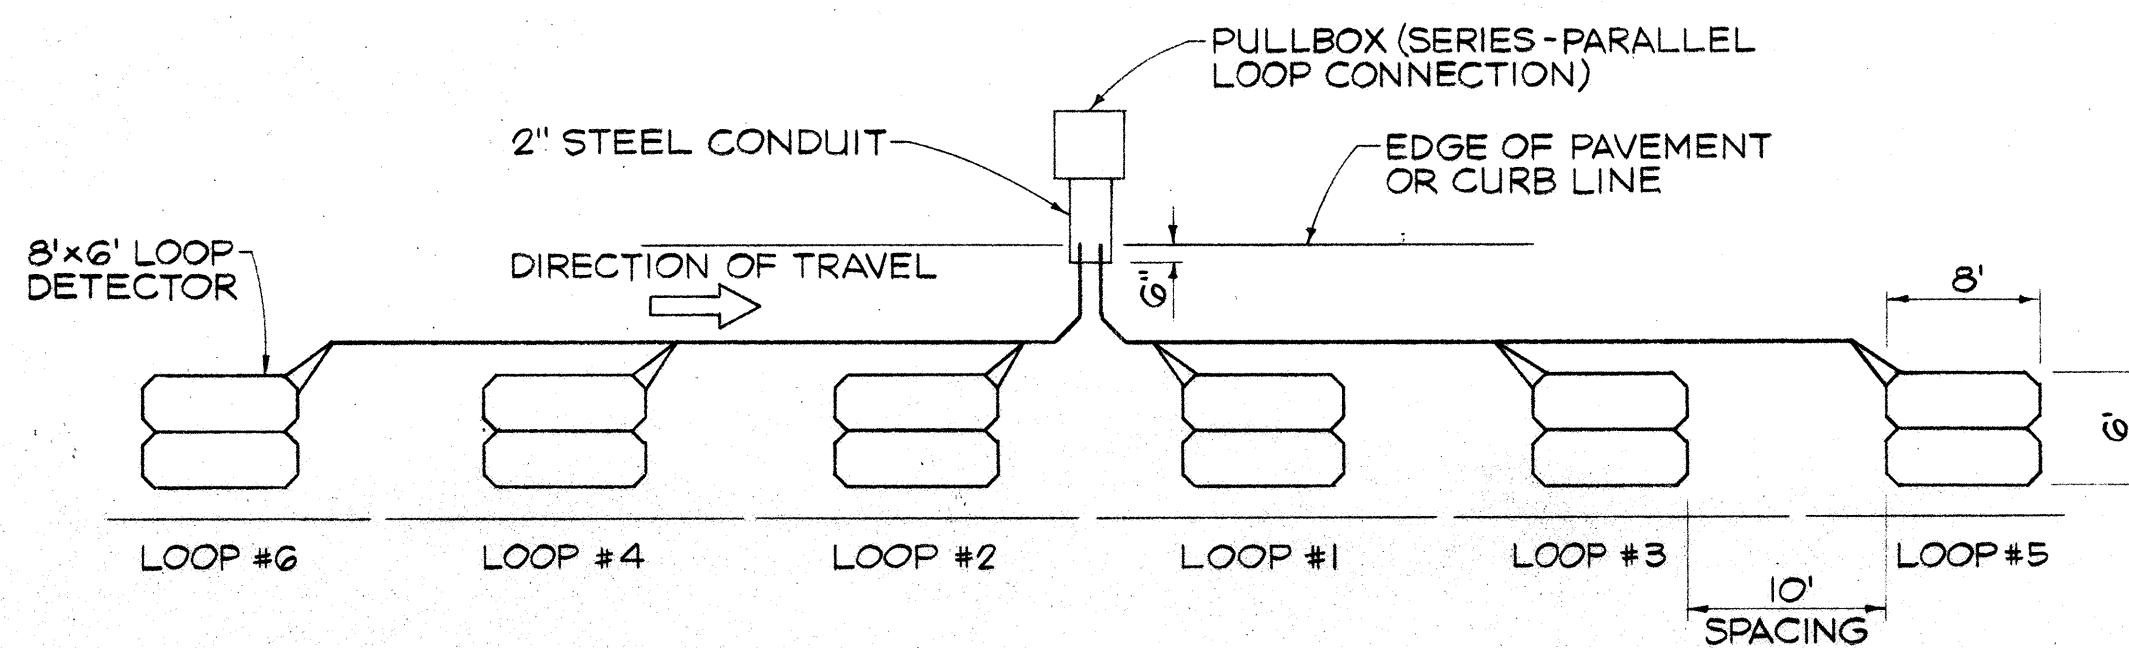


PLAN-LEFT TURN LANE LOOP LAYOUT
NOT TO SCALE

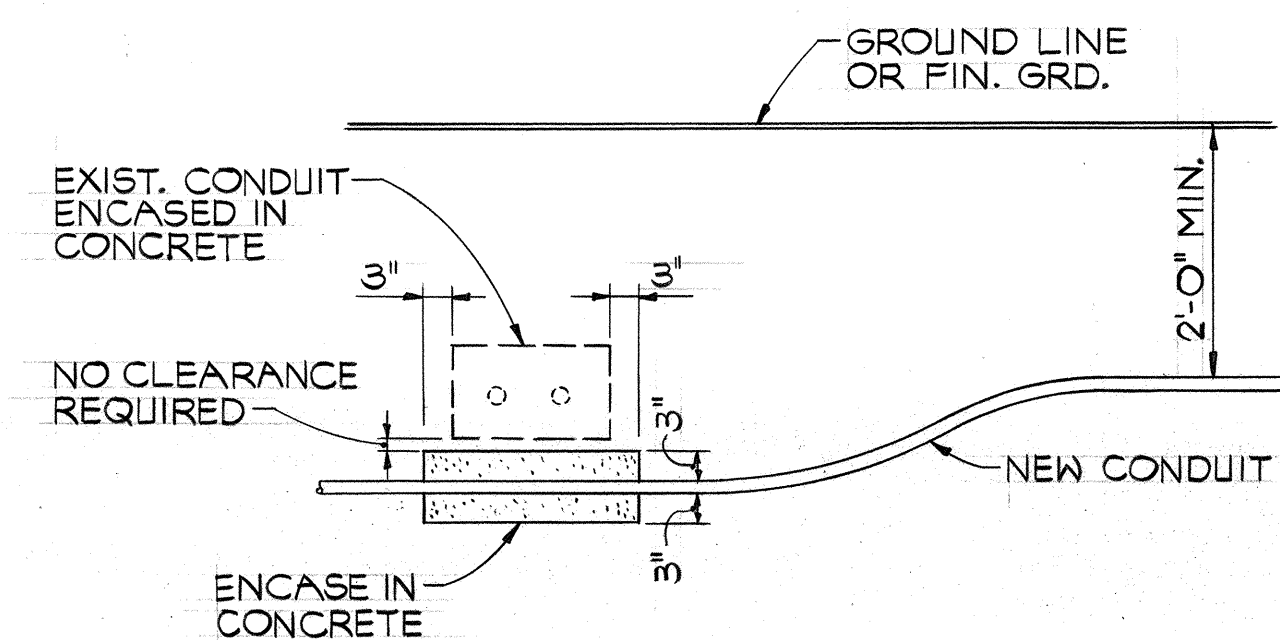

CONDUIT BY-PASS DETAIL
NOT TO SCALE

TYPE "D" PULLBOX
SCALE: 1 1/2" = 1'-0"

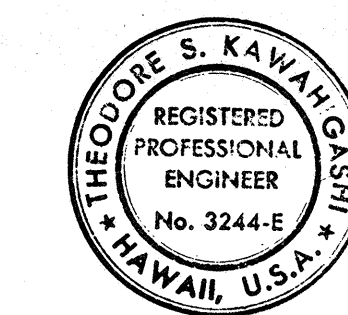

THIS WORK WAS PREPARED BY ME OR UNDER MY SUPERVISION
Theodore S. Kawahara
Signature

STATE OF HAWAII
DEPARTMENT OF TRANSPORTATION
HIGHWAYS DIVISION
LIKELIKE HIGHWAY
TRAFFIC SIGNALS AT
KALIHI STREET
PROJECT NO. 63A-01-80
MISCELLANEOUS DETAILS
SCALE: AS SHOWN DATE: 8-1-79
SHEET NO. 1 OF 1 SHEETS