INDEX TO DRAWINGS		
SHEET NO.		DESCRIPTION
	TITLE SHEET	
2	STRIPING PLAN AND DETAILS	
3	TRAFFIC SIGNAL PLAN	
4	MISCELLANEOUS DETAILS	
5-16	STANDARD DETAILS	
1		



STATE OF HAWAII

VAII

DEPARTMENT OF TRANSPORTATION

HIGHWAYS DIVISION

HONOLULU, HAWAII

"AS-BUILT"


PLANS FOR


LIKELIKE HIGHWAY

TRAFFIC SIGNALS AT KALIHI STREET

PROJECT NO. 63A-01-80

DISTRICT OF HONOLULU ISLAND OF OAHU

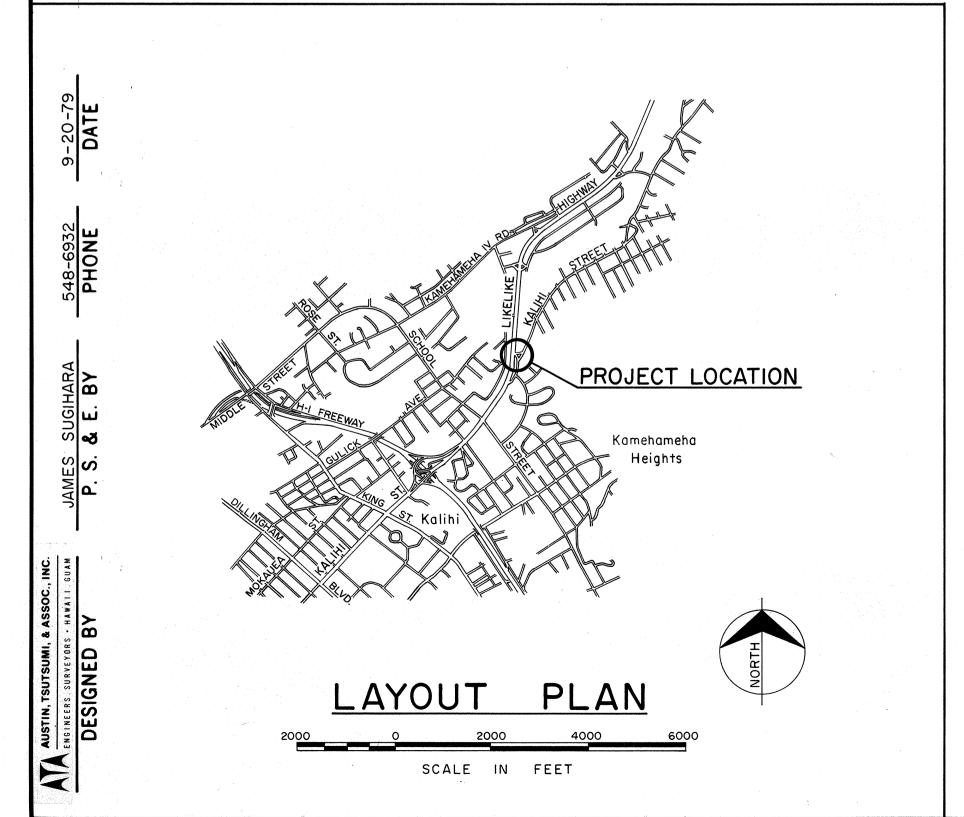

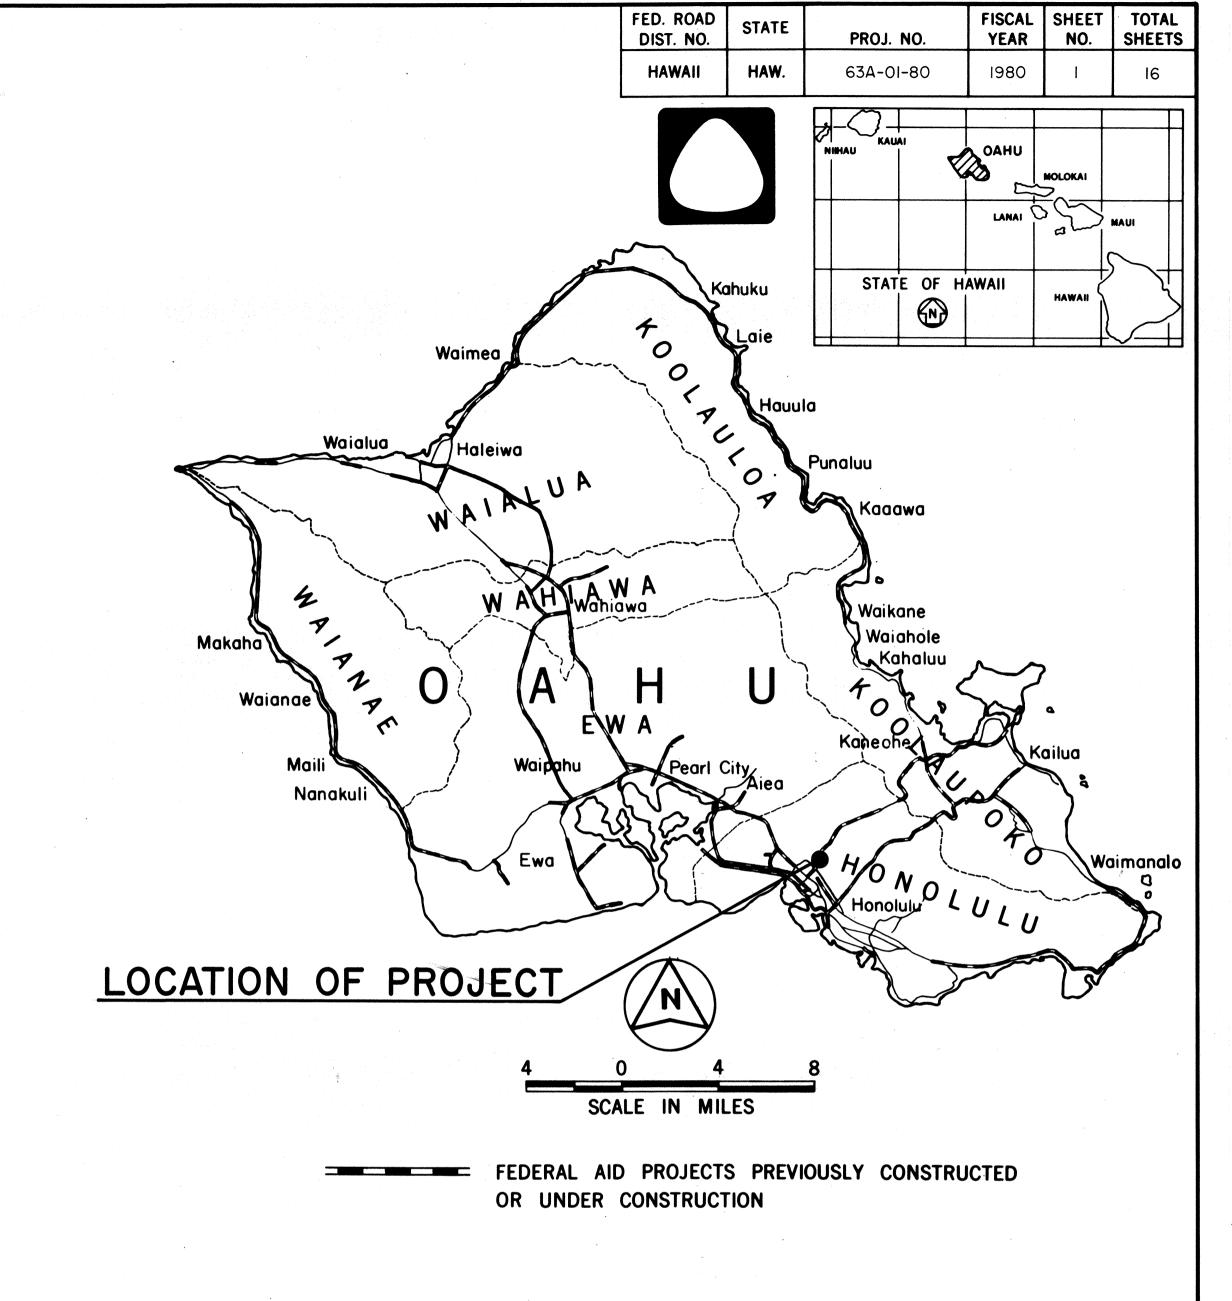

ALL CHANGES MADE DURING CONSTRUCTION HAVE BEEN INCORPORATED ON THESE PLANS IN RED EXCEPT CHANGES IN THE ORIGINAL THEORETICAL QUANTITIES. FOR ACTUAL QUANTITIES, REFER TO PROJECT LEDGER AND/OR COMPUTATION BOOK.

RESIDENT ENGINEER

11/17/8/ DATE

DEPARTMENT OF TRANSPORTATION
STATE OF HAWAII

APPROVED:

James K. Carras 8/2/19
FOR DIR. OF TRANSPORTATION DATE