


FED. ROAD DIST. NO.	STATE	FED. AID PROJ. NO.	FISCAL YEAR	SHEET NO.	TOTAL SHEETS
HAWAII	HAW.	HES-063-1(13)	1979	2	20

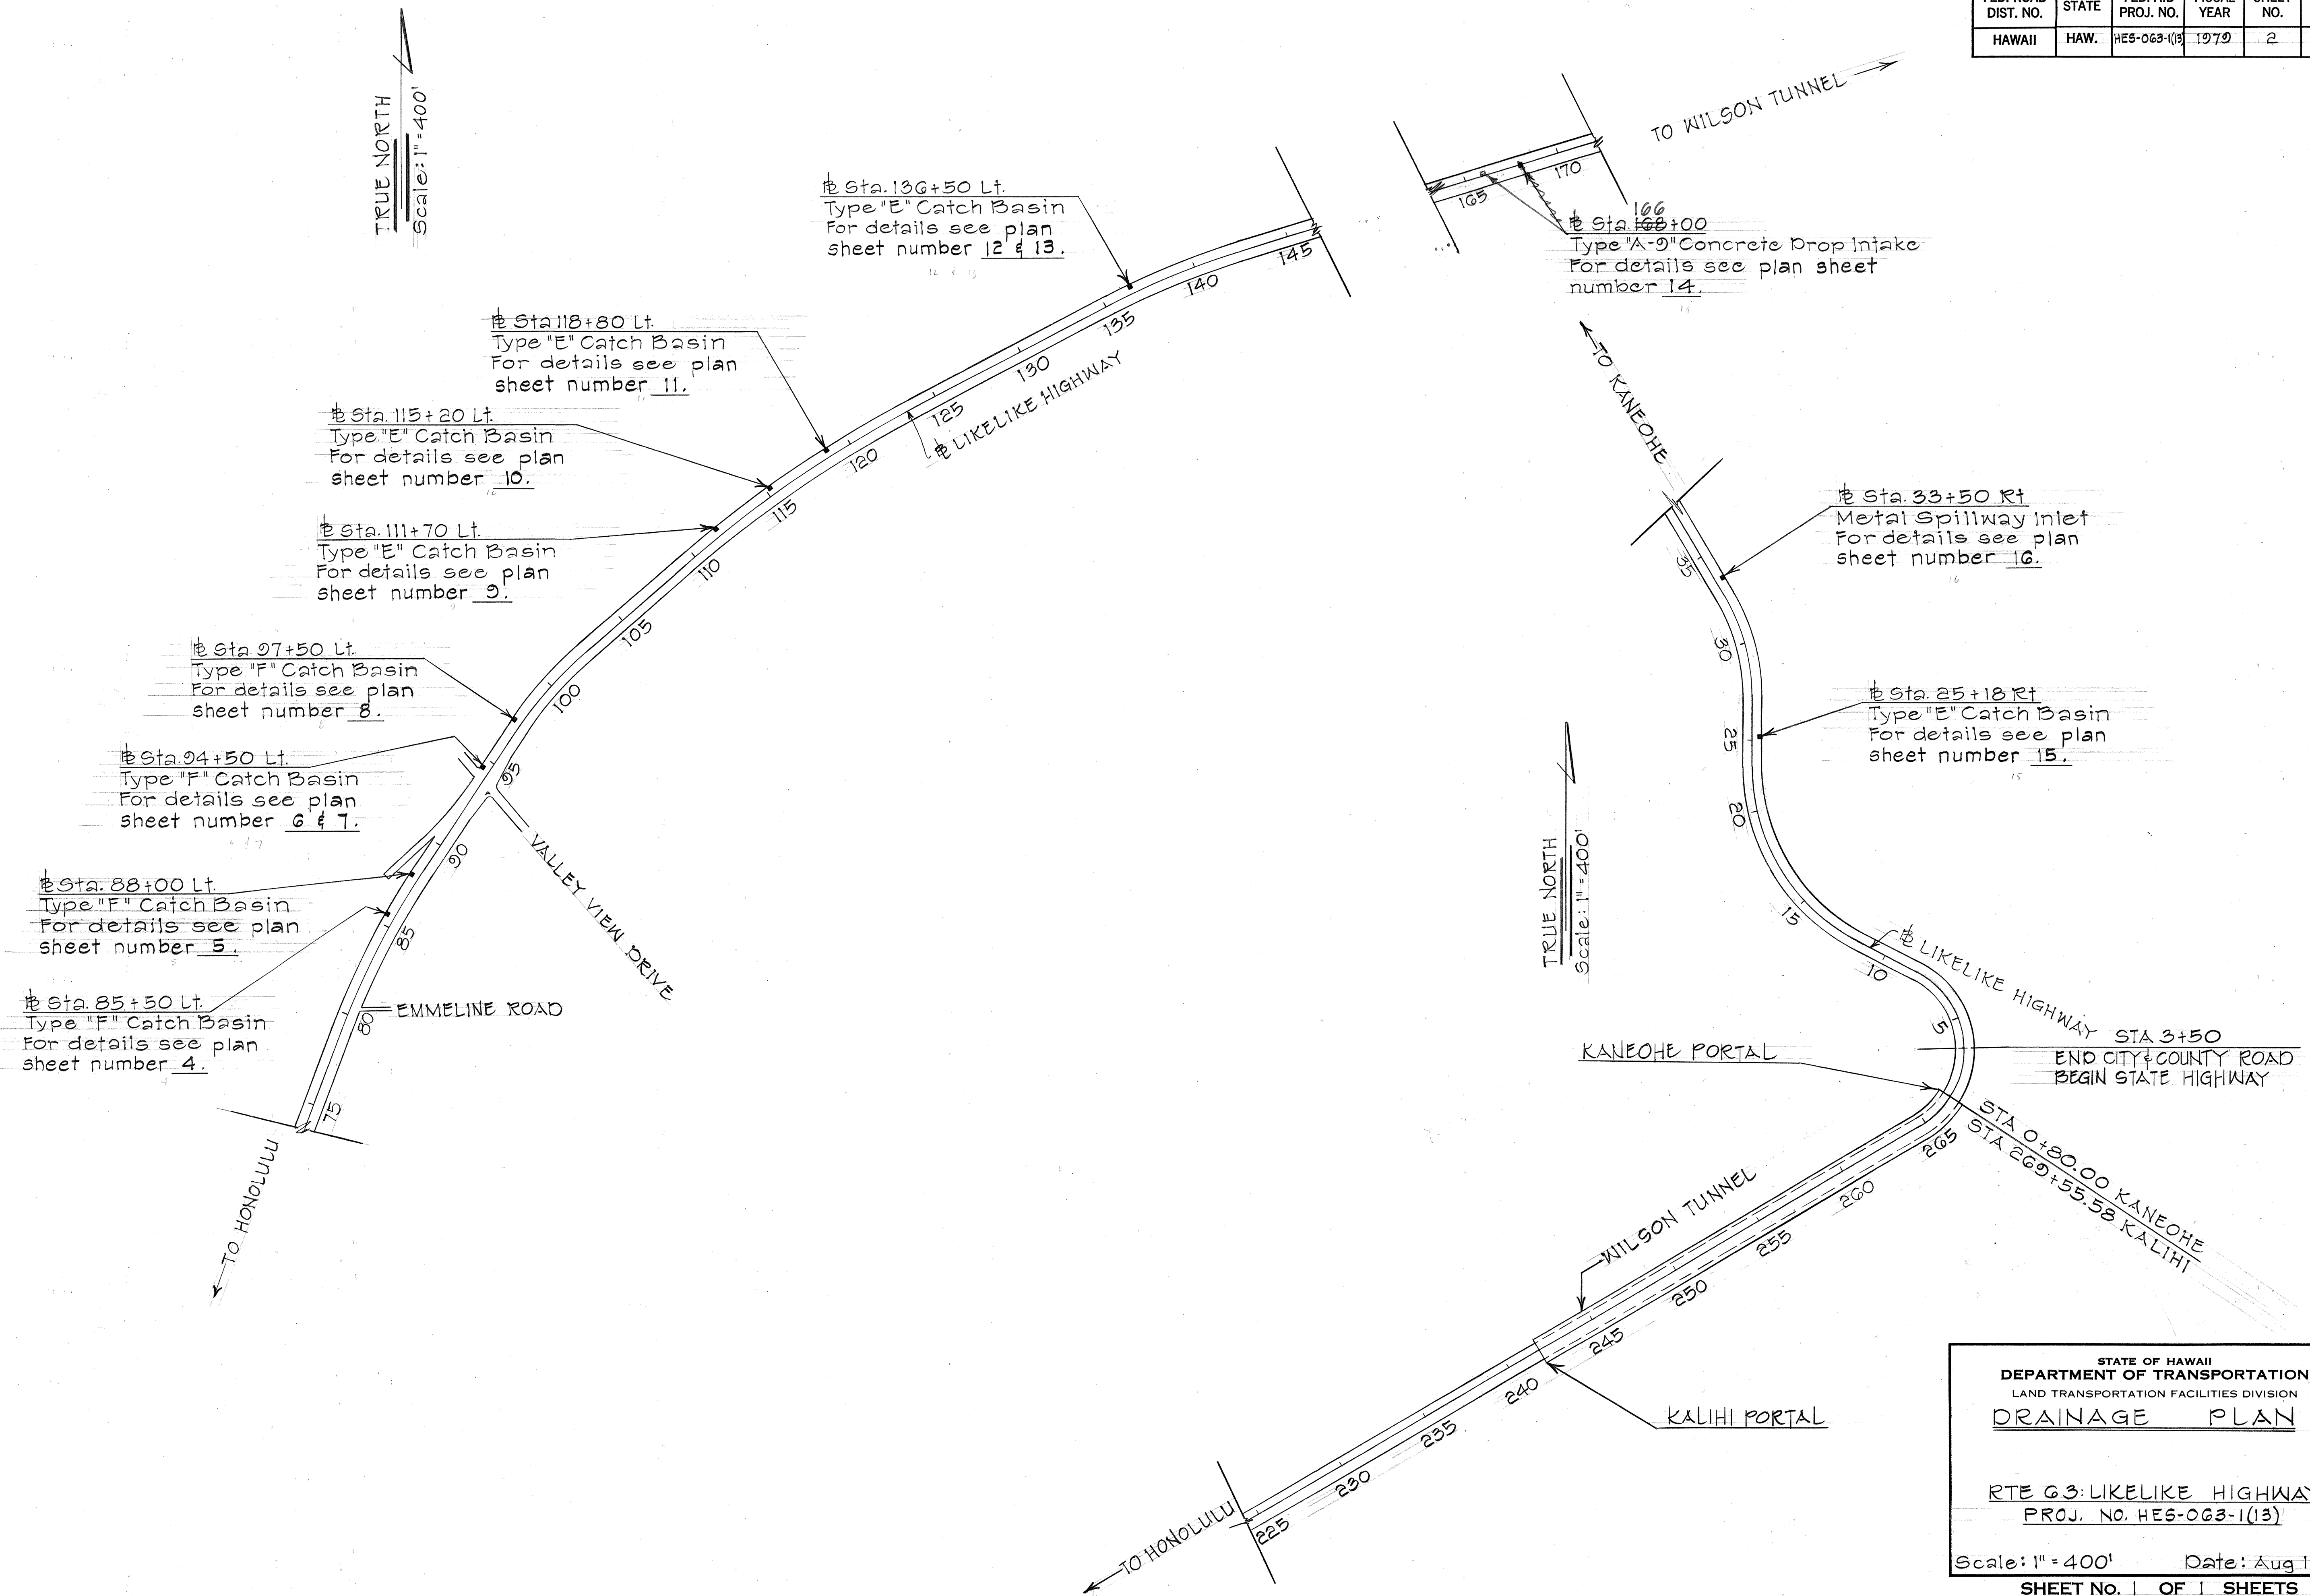

ORIGINAL PLAN	SURVEY PLOTTED BY	DATE
NOTED BY	DRAWN BY	" "
NOTED BY	TRACED BY	" "
NOTED BY	CHECKED BY	" "
NOTED BY	CHECKED BY	" "
STATE OF HAWAII
DEPARTMENT OF TRANSPORTATION
LAND TRANSPORTATION FACILITIES DIVISION
DRAINAGE PLAN

RTE 63: LIKELIKE HIGHWAY
PROJ. NO. HES-063-1(13)

Scale: 1" = 400' Date: Aug 1979

SHEET NO. 1 OF 1 SHEETS