

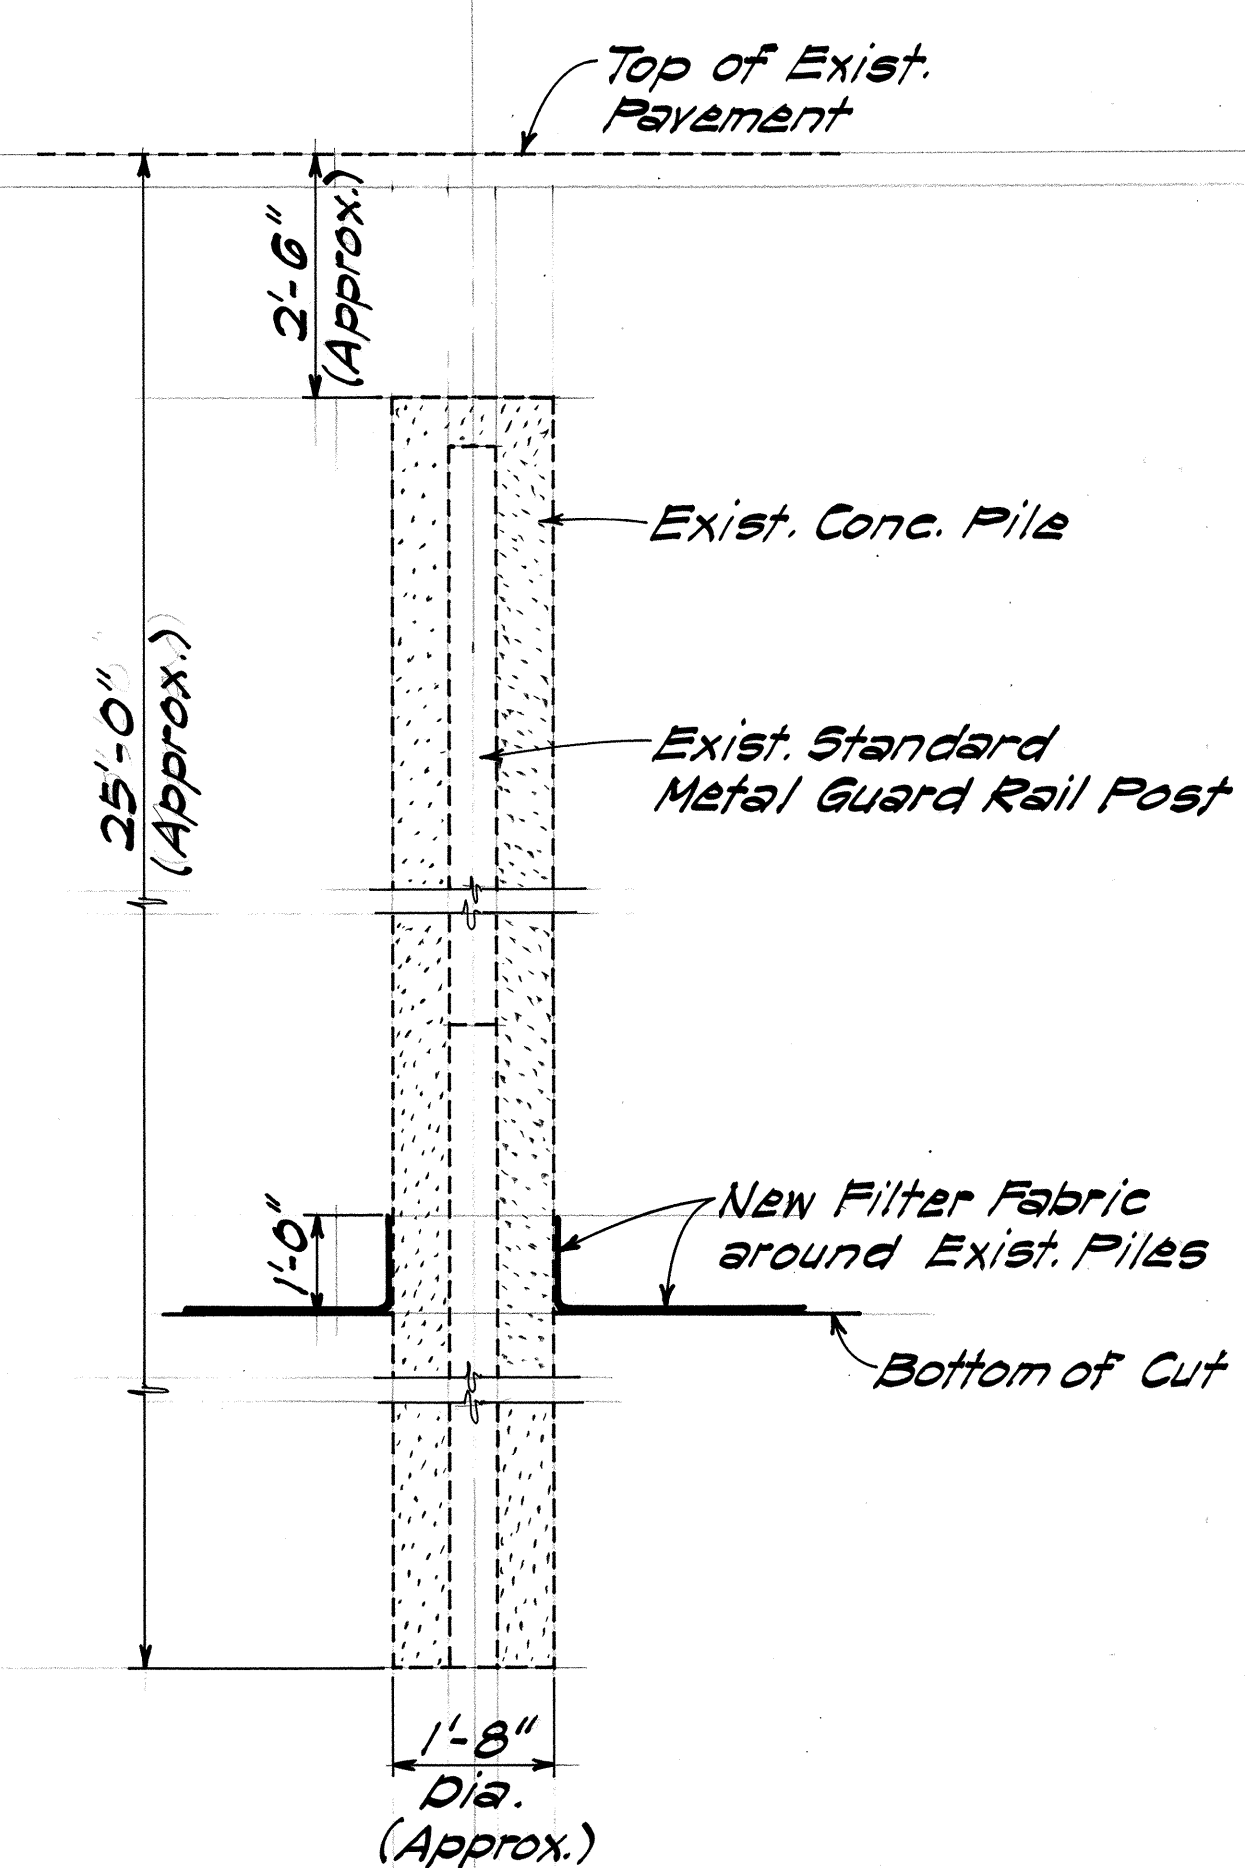



FED. ROAD DIST. NO.	STATE	PROJ. NO.	FISCAL YEAR	SHEET NO.	TOTAL SHEETS
HAWAII	HAW.	63A-01-81	1982	3	18

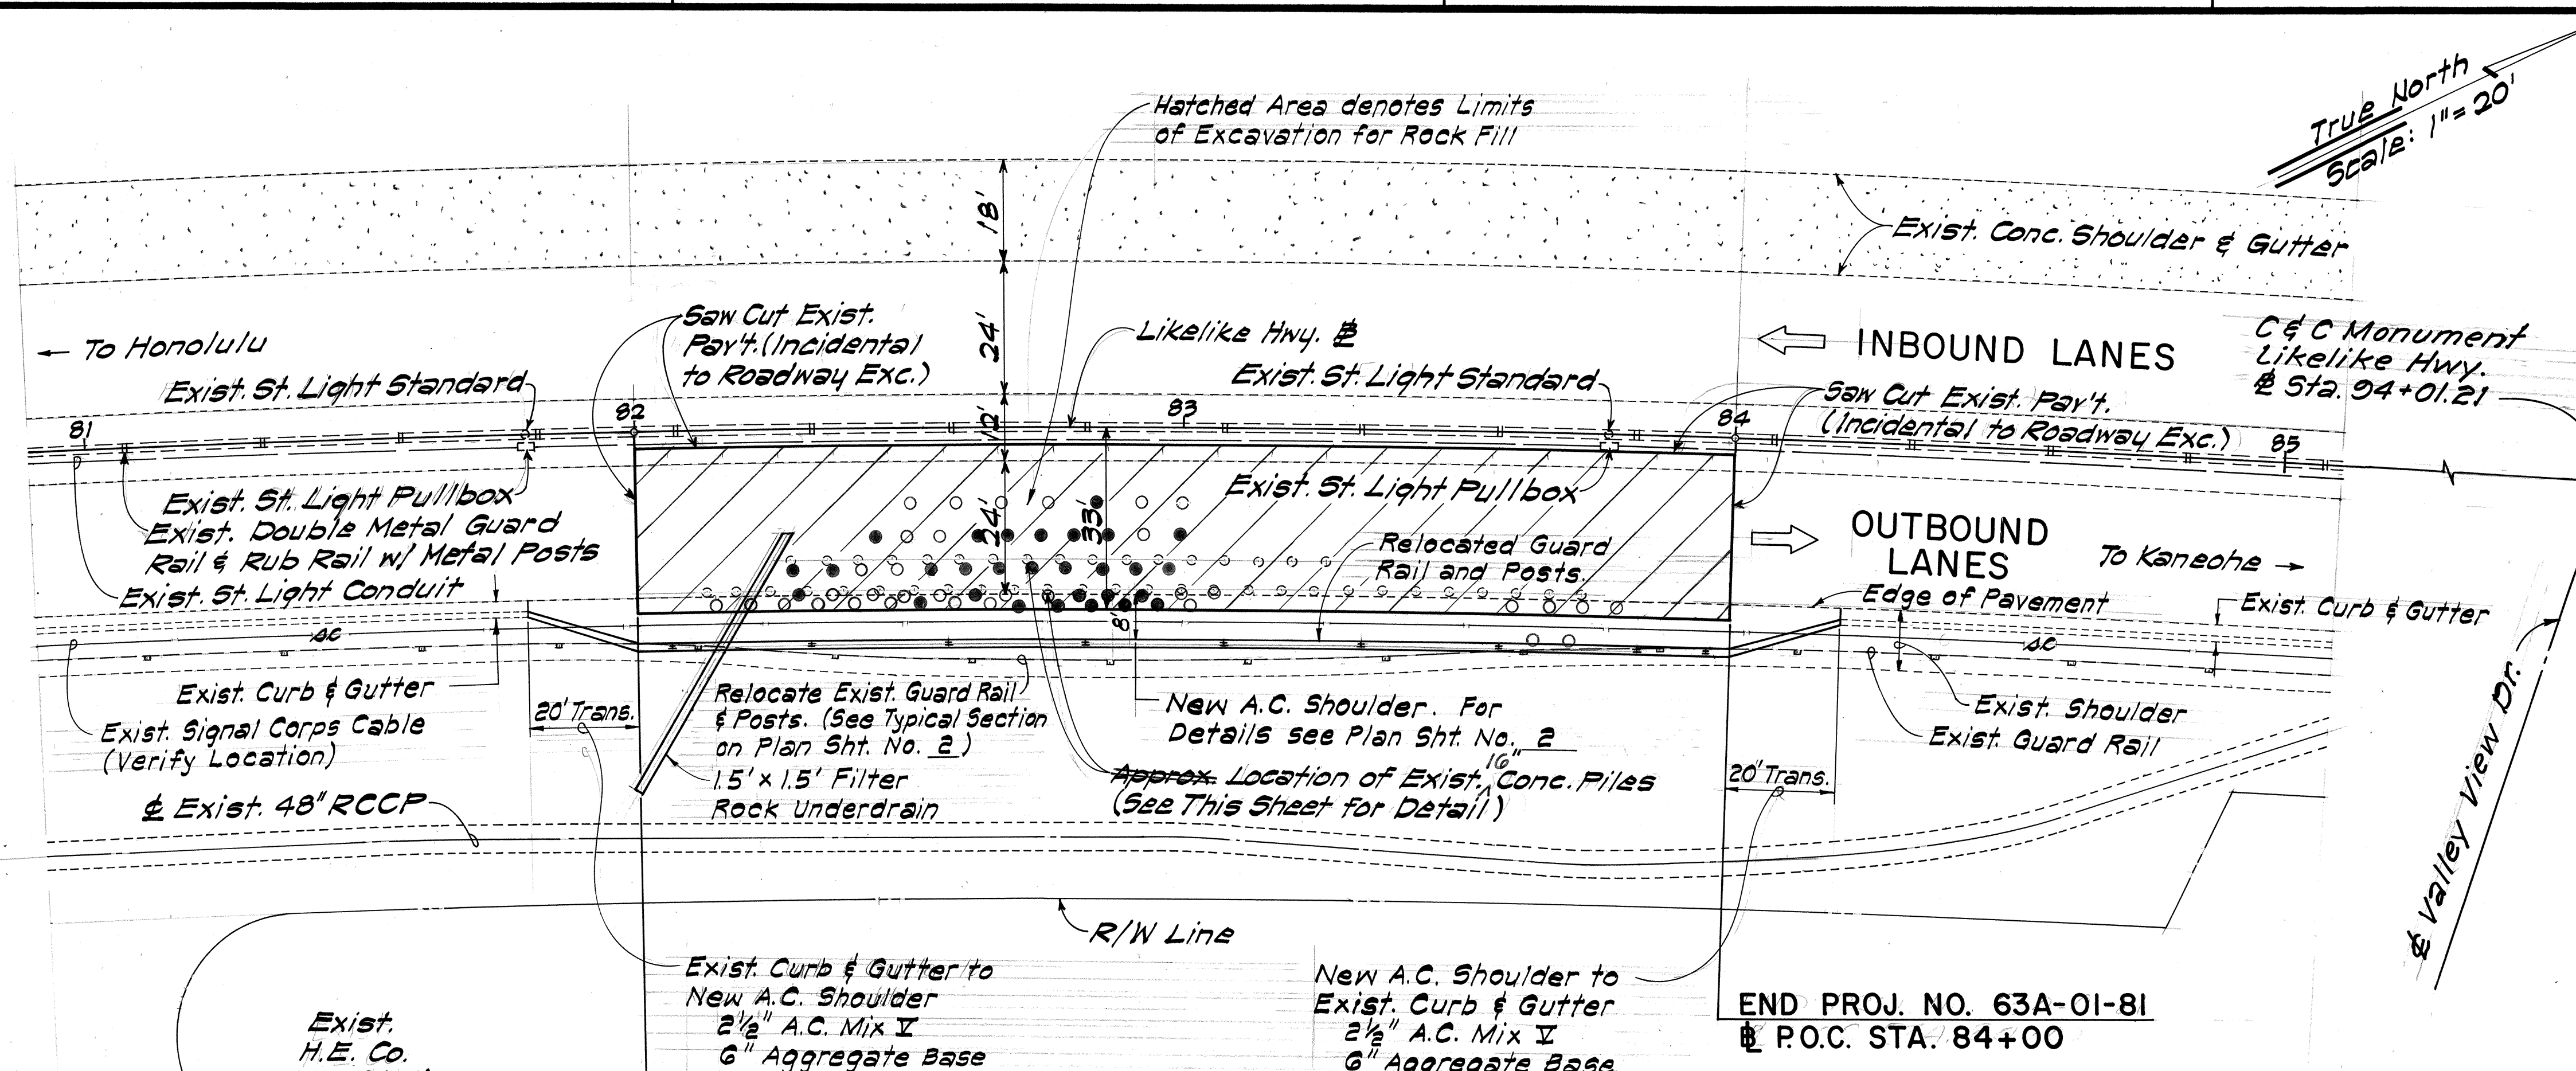

PLACEMENT DETAIL OF
NEW FILTER FABRIC
AROUND EXISTING PILES

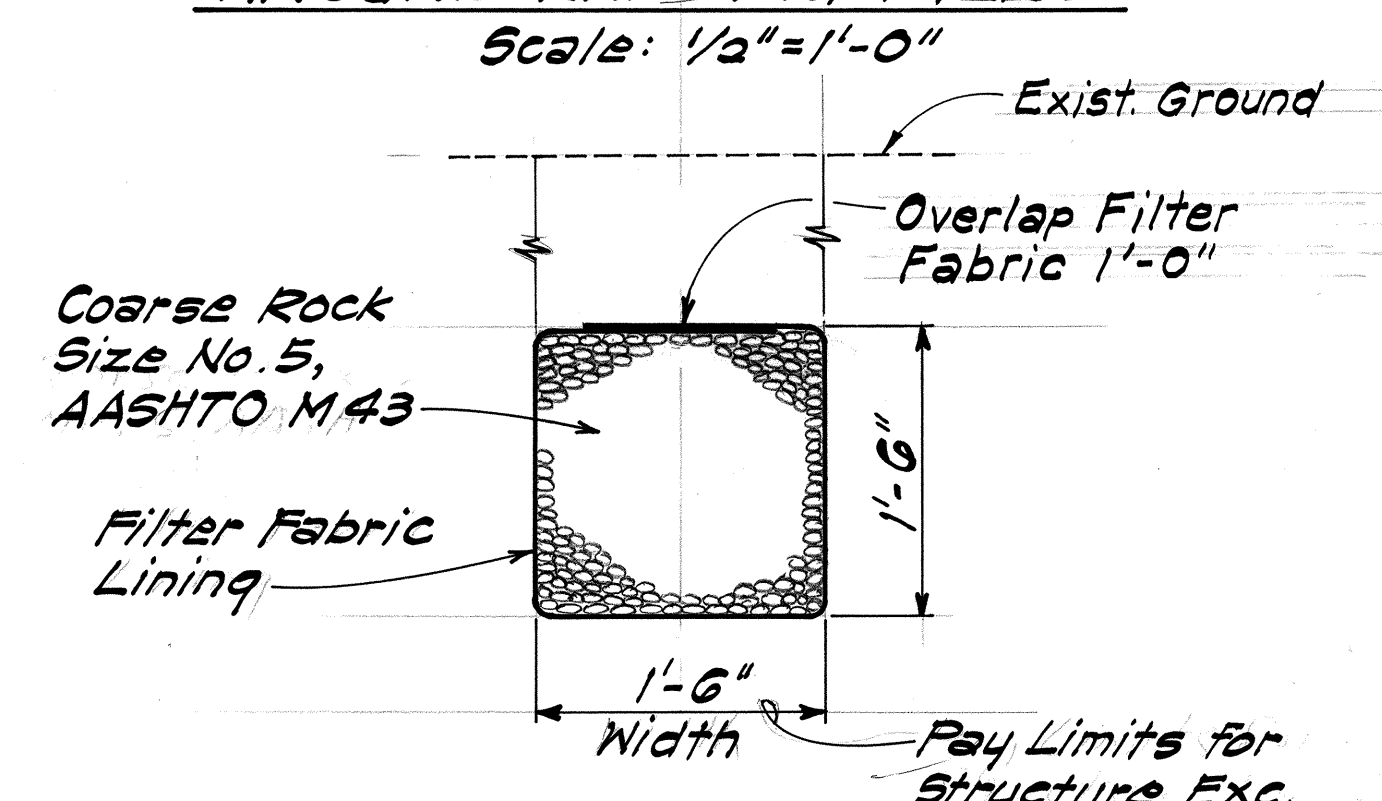

FILTER ROCK
UNDERDRAIN DETAIL

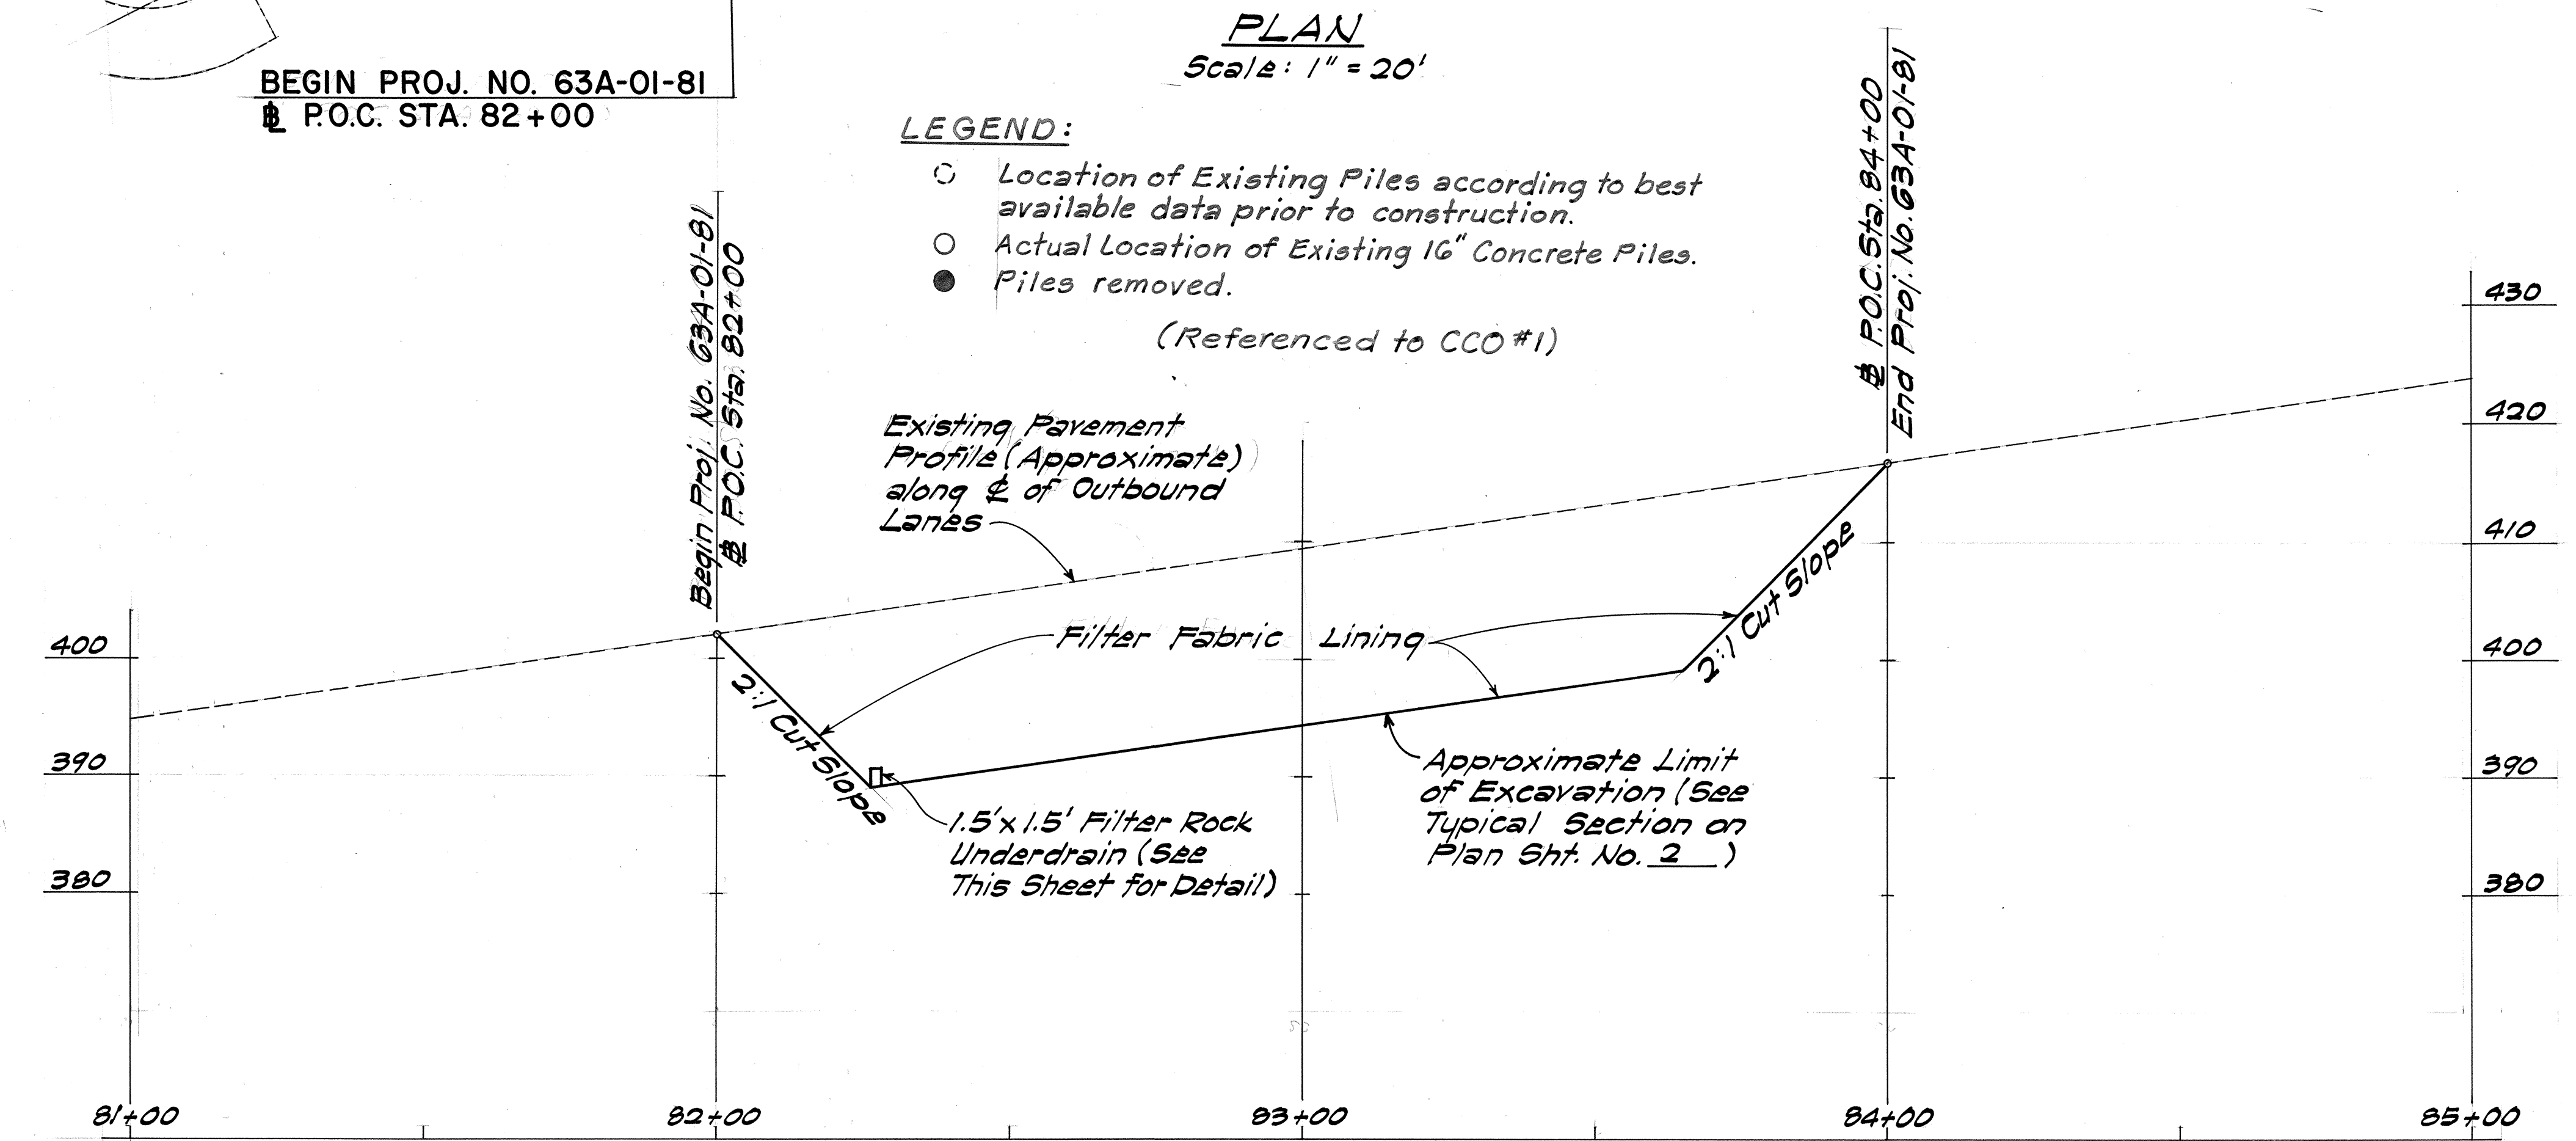

PROFILE
Scale: Horiz. 1" = 20'
Vert. 1" = 10'

- LEGEND:
- Location of Existing Piles according to best available data prior to construction.
 - Actual Location of Existing 16" Concrete Piles.
 - Piles removed.
- (Referenced to CCO #1)

STATE OF HAWAII
DEPARTMENT OF TRANSPORTATION
LAND TRANSPORTATION FACILITIES DIVISION

PLAN, PROFILE & DETAILS

**LIKELIKE HIGHWAY
STABILIZATION OF FILL**
PROJ. NO. 63A-01-81
Scale: As Shown Date: Apr., 1982
SHEET NO. 1 OF 1 SHEETS

SURVEY PLOTTED BY	DATE
DRAWN BY	
CHECKED BY	
DESIGNED BY	
QUANTITIES BY	
CHECKED BY	
ORIGINAL PLAN	
NOTE BOOK	
No.	