	INDEX TO DRAWINGS
SHEET NO.	DESCRIPTION
l	TITLE SHEET
* 2	TYPICAL SECTIONS & GEN. NOTES
3	PLAN, PROFILE & DETAILS
4-6	GUARDRAIL STANDARD DETAILS
7-18	DETOUR, GEN. NOTES, LEGEND, PLANS & DETAILS
* 2S-I	CROSS SECTIONS
3	
THE STATE OF THE S	
MARKAT ETATON KATANINA INA KATANINA KATANINA KATANINA KATANINA KATANINA KATANINA KATANINA KATANINA KATANINA KA	
THE STATE OF THE S	

TOTAL SHEET COUNT AFTER "AS - BUILT" POSTINGS: 19 SHEETS

P. S. & E. BY



STATE OF HAWAII

DEPARTMENT OF TRANSPORTATION


"AS - BUILT"
PLANS FOR

LIKELIKE HIGHWAY

STABILIZATION OF FILL
BETWEEN KULA KOLEA DR. AND VALLEY VIEW DR.

PROJECT NO. 63A-01-81

DISTRICT OF HONOLULU ISLAND OF OAHU

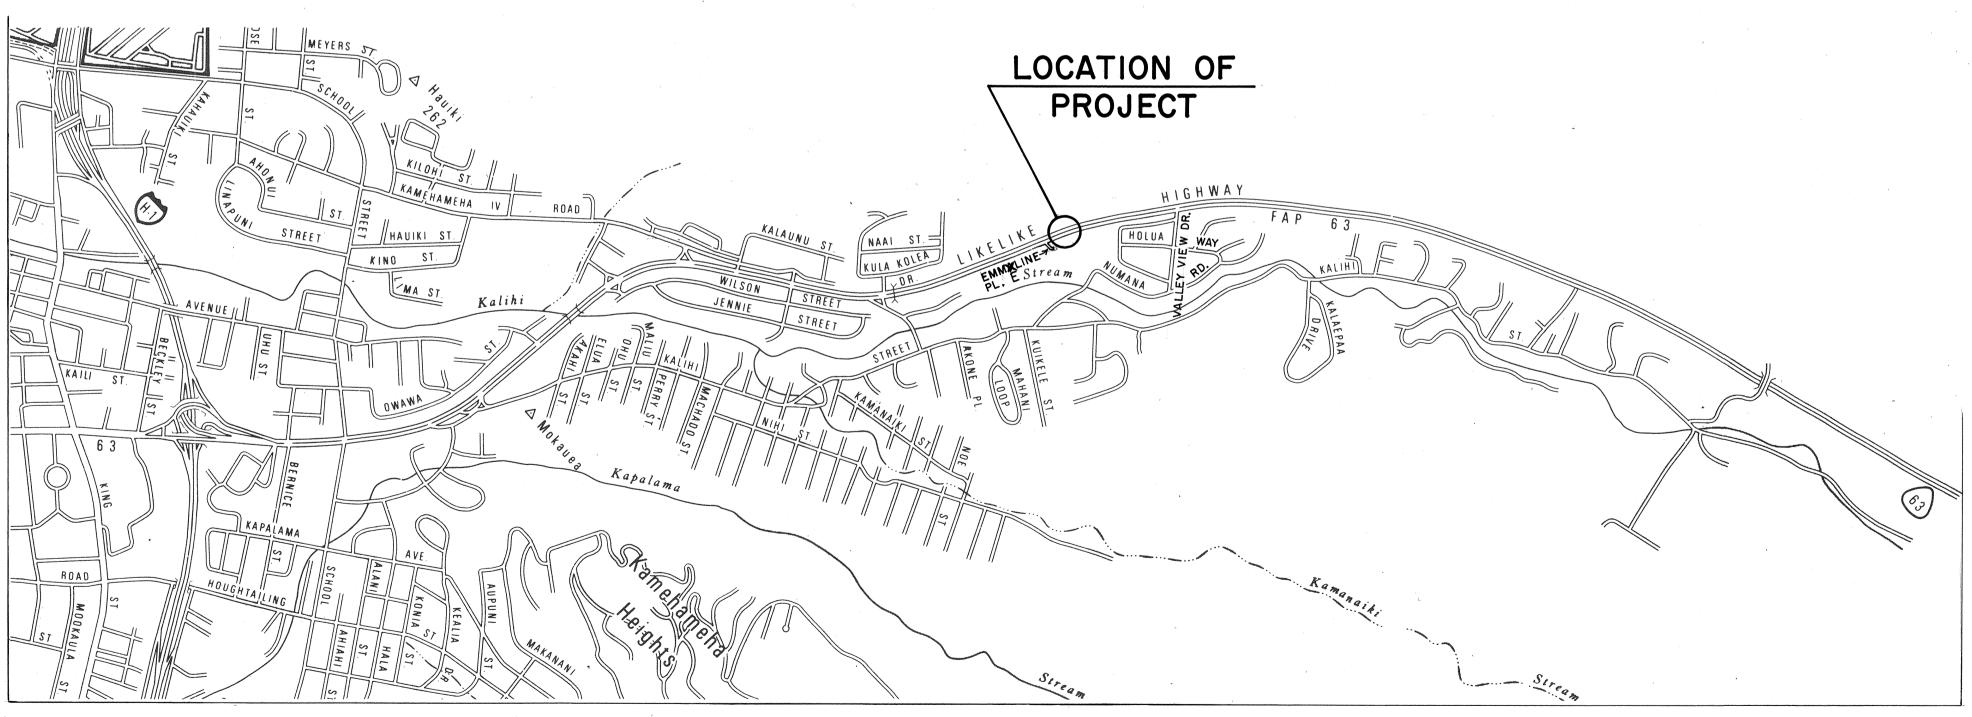

Wainana Waina Wainana Wainana Wainana Wainana

FED. ROAD DIST. NO.

FEDERAL AID PROJECTS PREVIOUSLY CONSTRUCTED
OR UNDER CONSTRUCTION

ALL CHANGES MADE DURING CONSTRUCTION HAVE BEEN INCORPORATED ON THESE PLANS IN RED EXCEPT CHANGES IN THE ORIGINAL THEORETICAL QUANTITIES, FOR ACTUAL QUANTITIES, REFER TO PROJECT LEDGER AND/OR COMPUTATION BOOK.

Hand Tamashiro

3/30/83 DATE

FISCAL SHEET TOTAL YEAR NO. SHEETS

63A-01-81

RESIDENT ENGINEER

DEPARTMENT OF TRANSPORTATION STATE OF HAWAII

APPROVED:

James R. Carras 5/10/82
JOIR. OF TRANSPORTATION DATE

SCALE IN THOUSAND FEET

LAYOUT PLAN

