

D-4-3



STATE OF HAWAII

HIGHWAYS DIVISION


" AS BUILT "

PLANS FOR

LIKELIKE HIGHWAY
SAFETY IMPROVEMENTS IN THE
VICINITY OF BISHOP MUSEUM
PROJECT NO. 63A-02-83

DISTRICT OF HONOLULU
ISLAND OF OAHU

LAYOUT PLAN

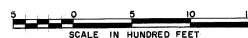

Phil Menear
RESIDENT ENGINEER

1/31/84
DATE

APPROVED: R Higashimura 5/19/83
DIR. OF TRANSPORTATION DATE