




FED. ROAD DIST. NO.	STATE	PROJ. NO.	FISCAL YEAR	SHEET NO.	TOTAL SHEETS
HAWAII	HAW.	63A-01-84	1984	4	16

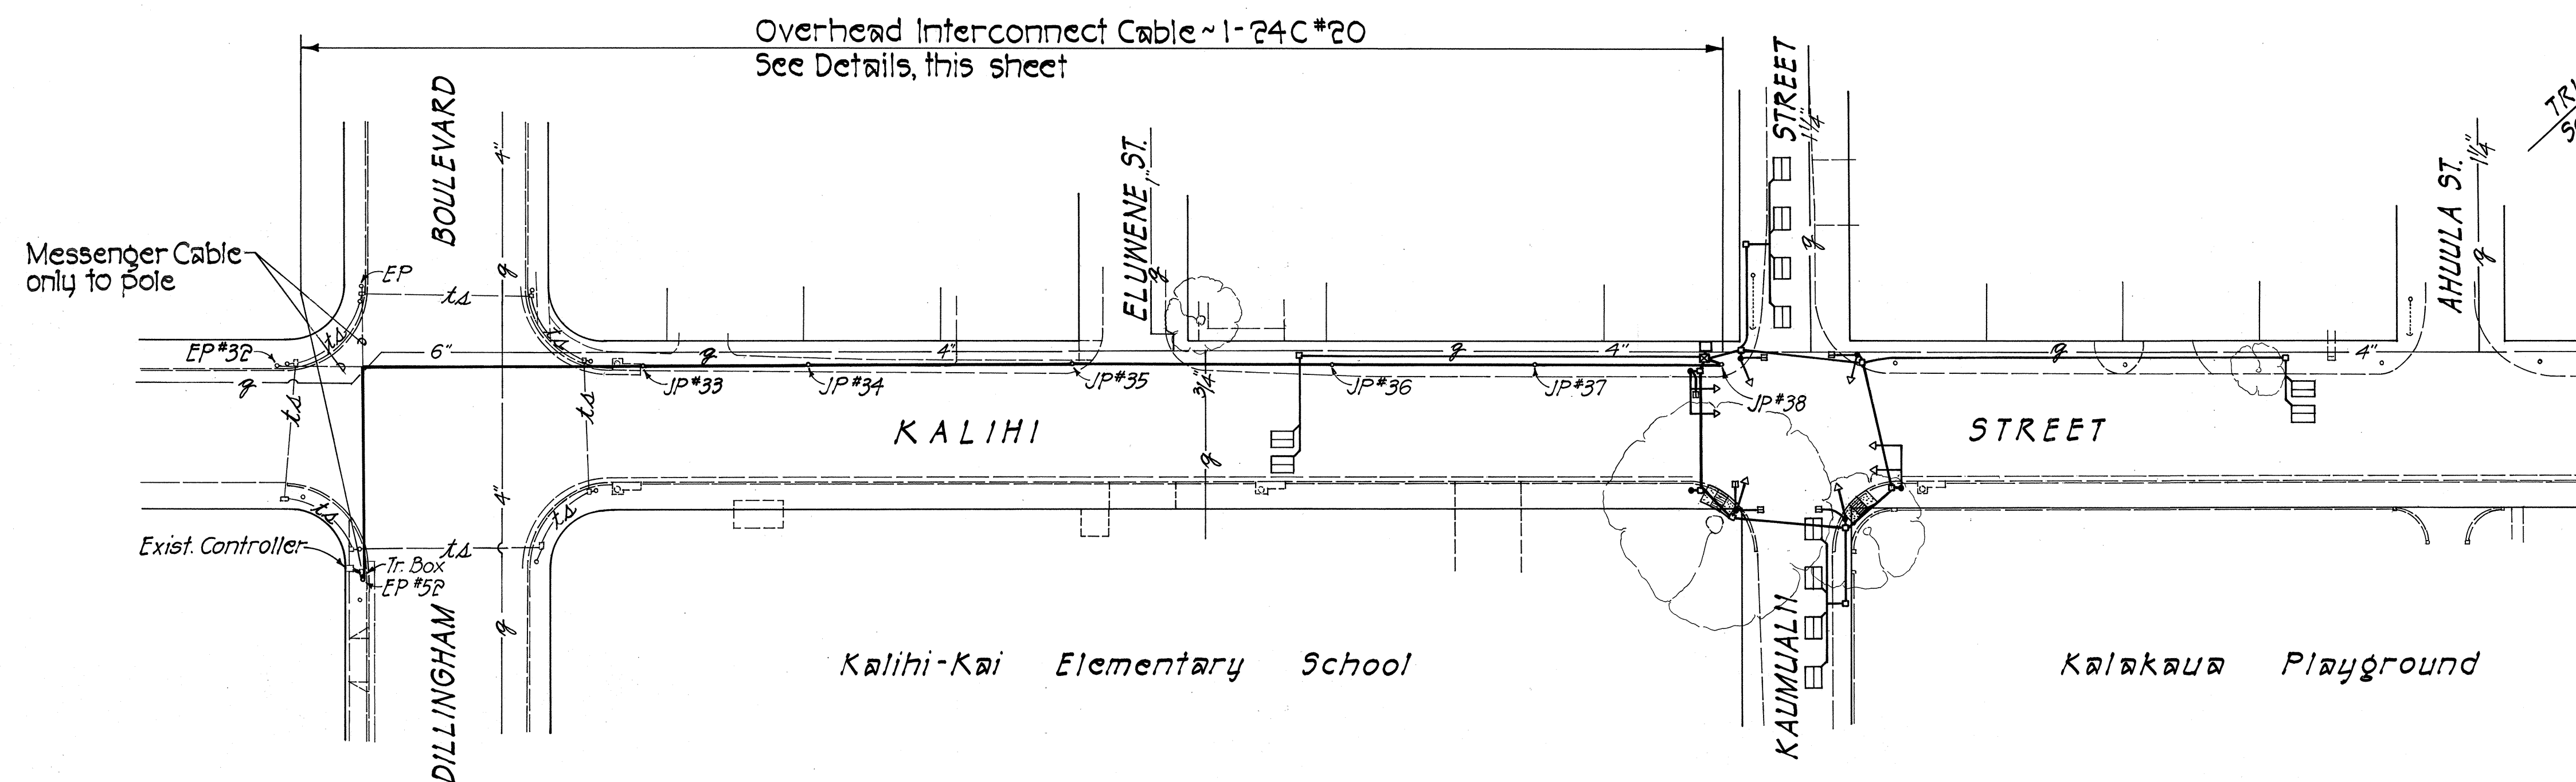

PLAN
Scale: 1"=40'

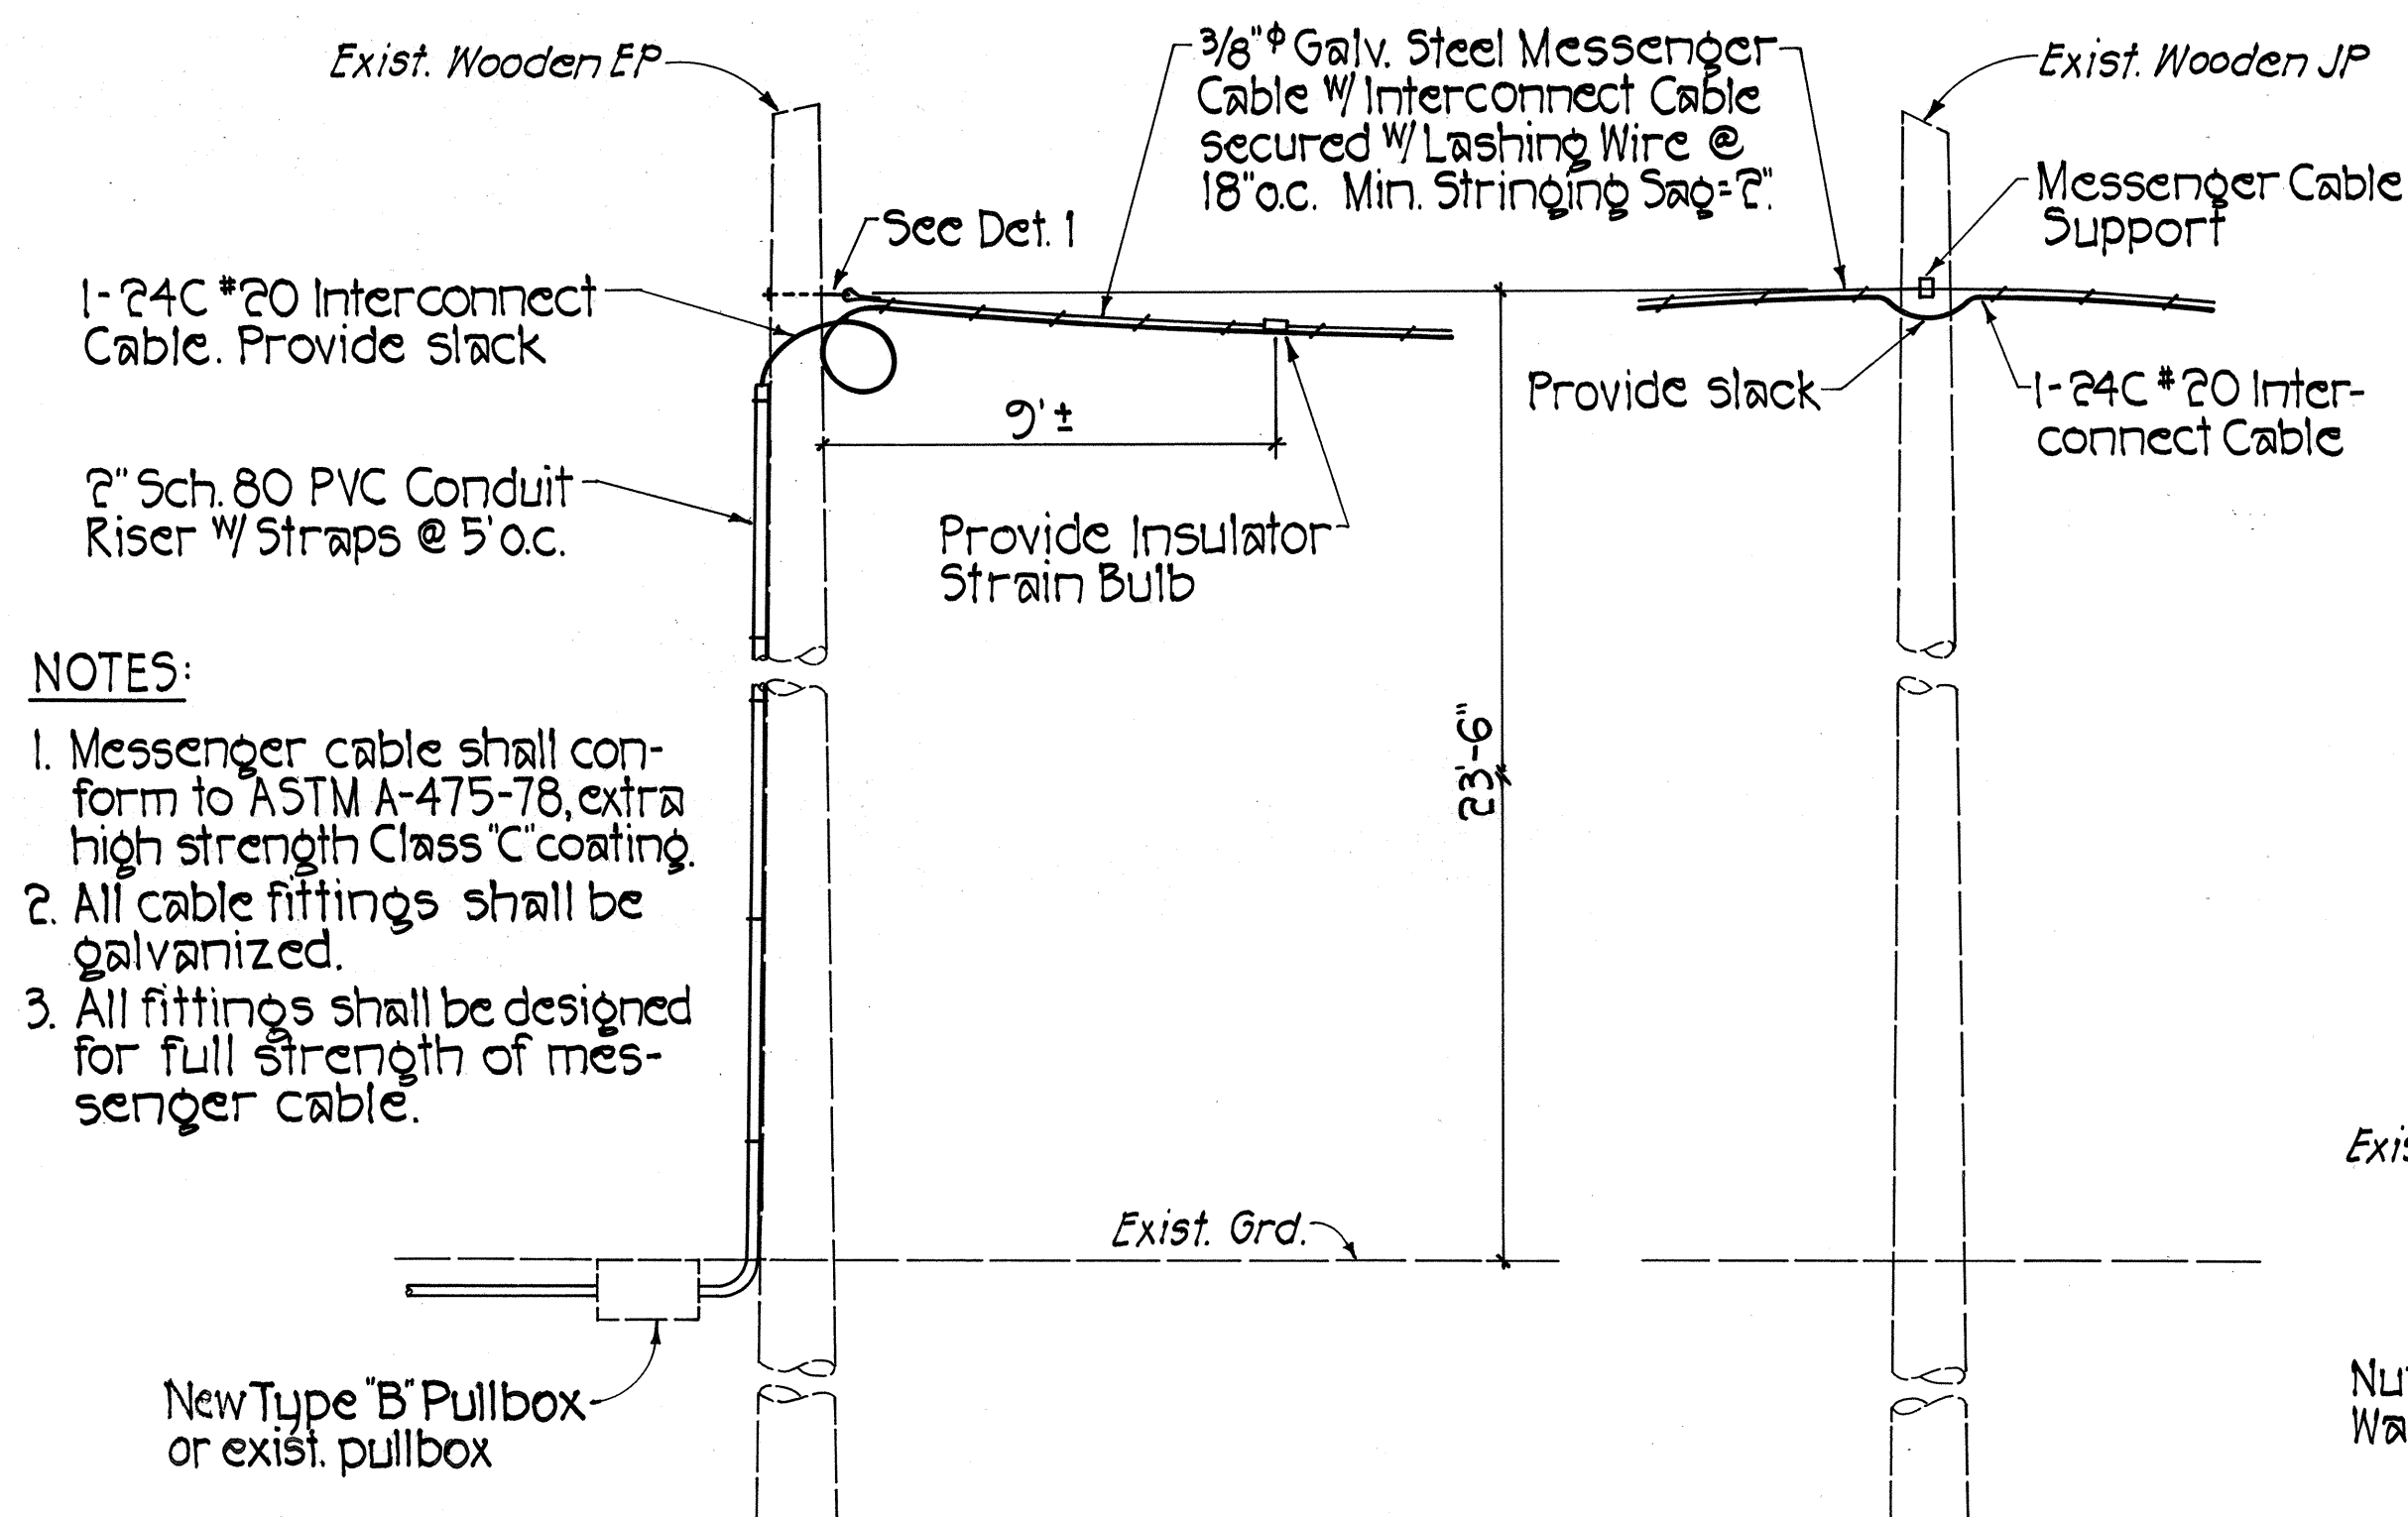


TYPICAL OVERHEAD INSTALLATION
Not To Scale

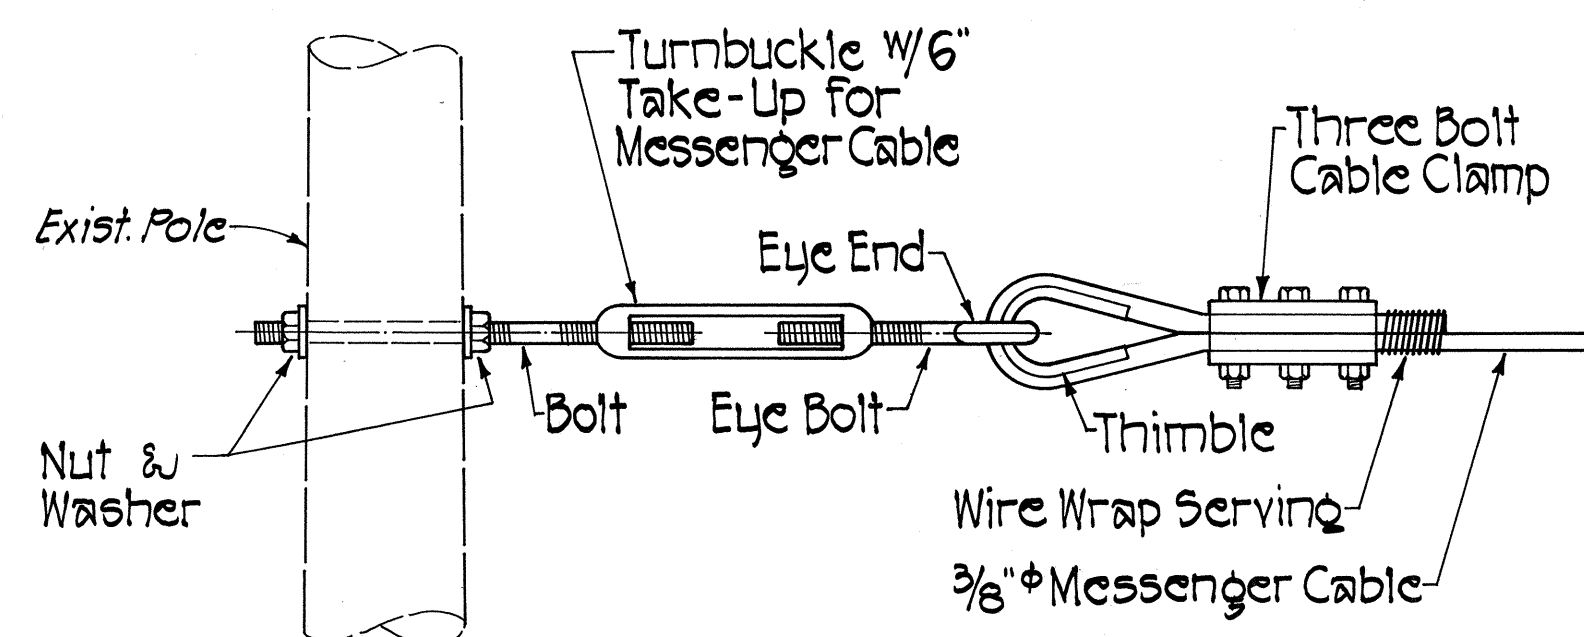

DETAIL 1
Not To Scale

- NOTES:**
1. Messenger cable shall conform to ASTM A-475-78, extra high strength Class 'C' coating.
 2. All cable fittings shall be galvanized.
 3. All fittings shall be designed for full strength of messenger cable.

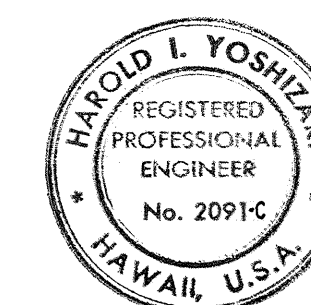

THIS WORK WAS PREPARED BY
ME OR UNDER MY SUPERVISION.
Harold I. Yoshizaki

STATE OF HAWAII
DEPARTMENT OF TRANSPORTATION
HIGHWAYS DIVISION

**PLAN ~ TRAFFIC SIGNAL SYSTEM
& DETAILS**

KALIHI STREET TRAFFIC SIGNAL SYSTEM
AT KAUMUALII STREET
PROJECT NO. 63A-01-84
SCALE: 1"=20' DATE: MAY 15, 1984

SHEET NO. 4 OF 4 SHEETS