



FED. ROAD DIST. NO.	STATE	PROJ. NO.	FISCAL YEAR	SHEET NO.	TOTAL SHEETS
HAWAII	HAW.	63A-01-84	1984	5	16

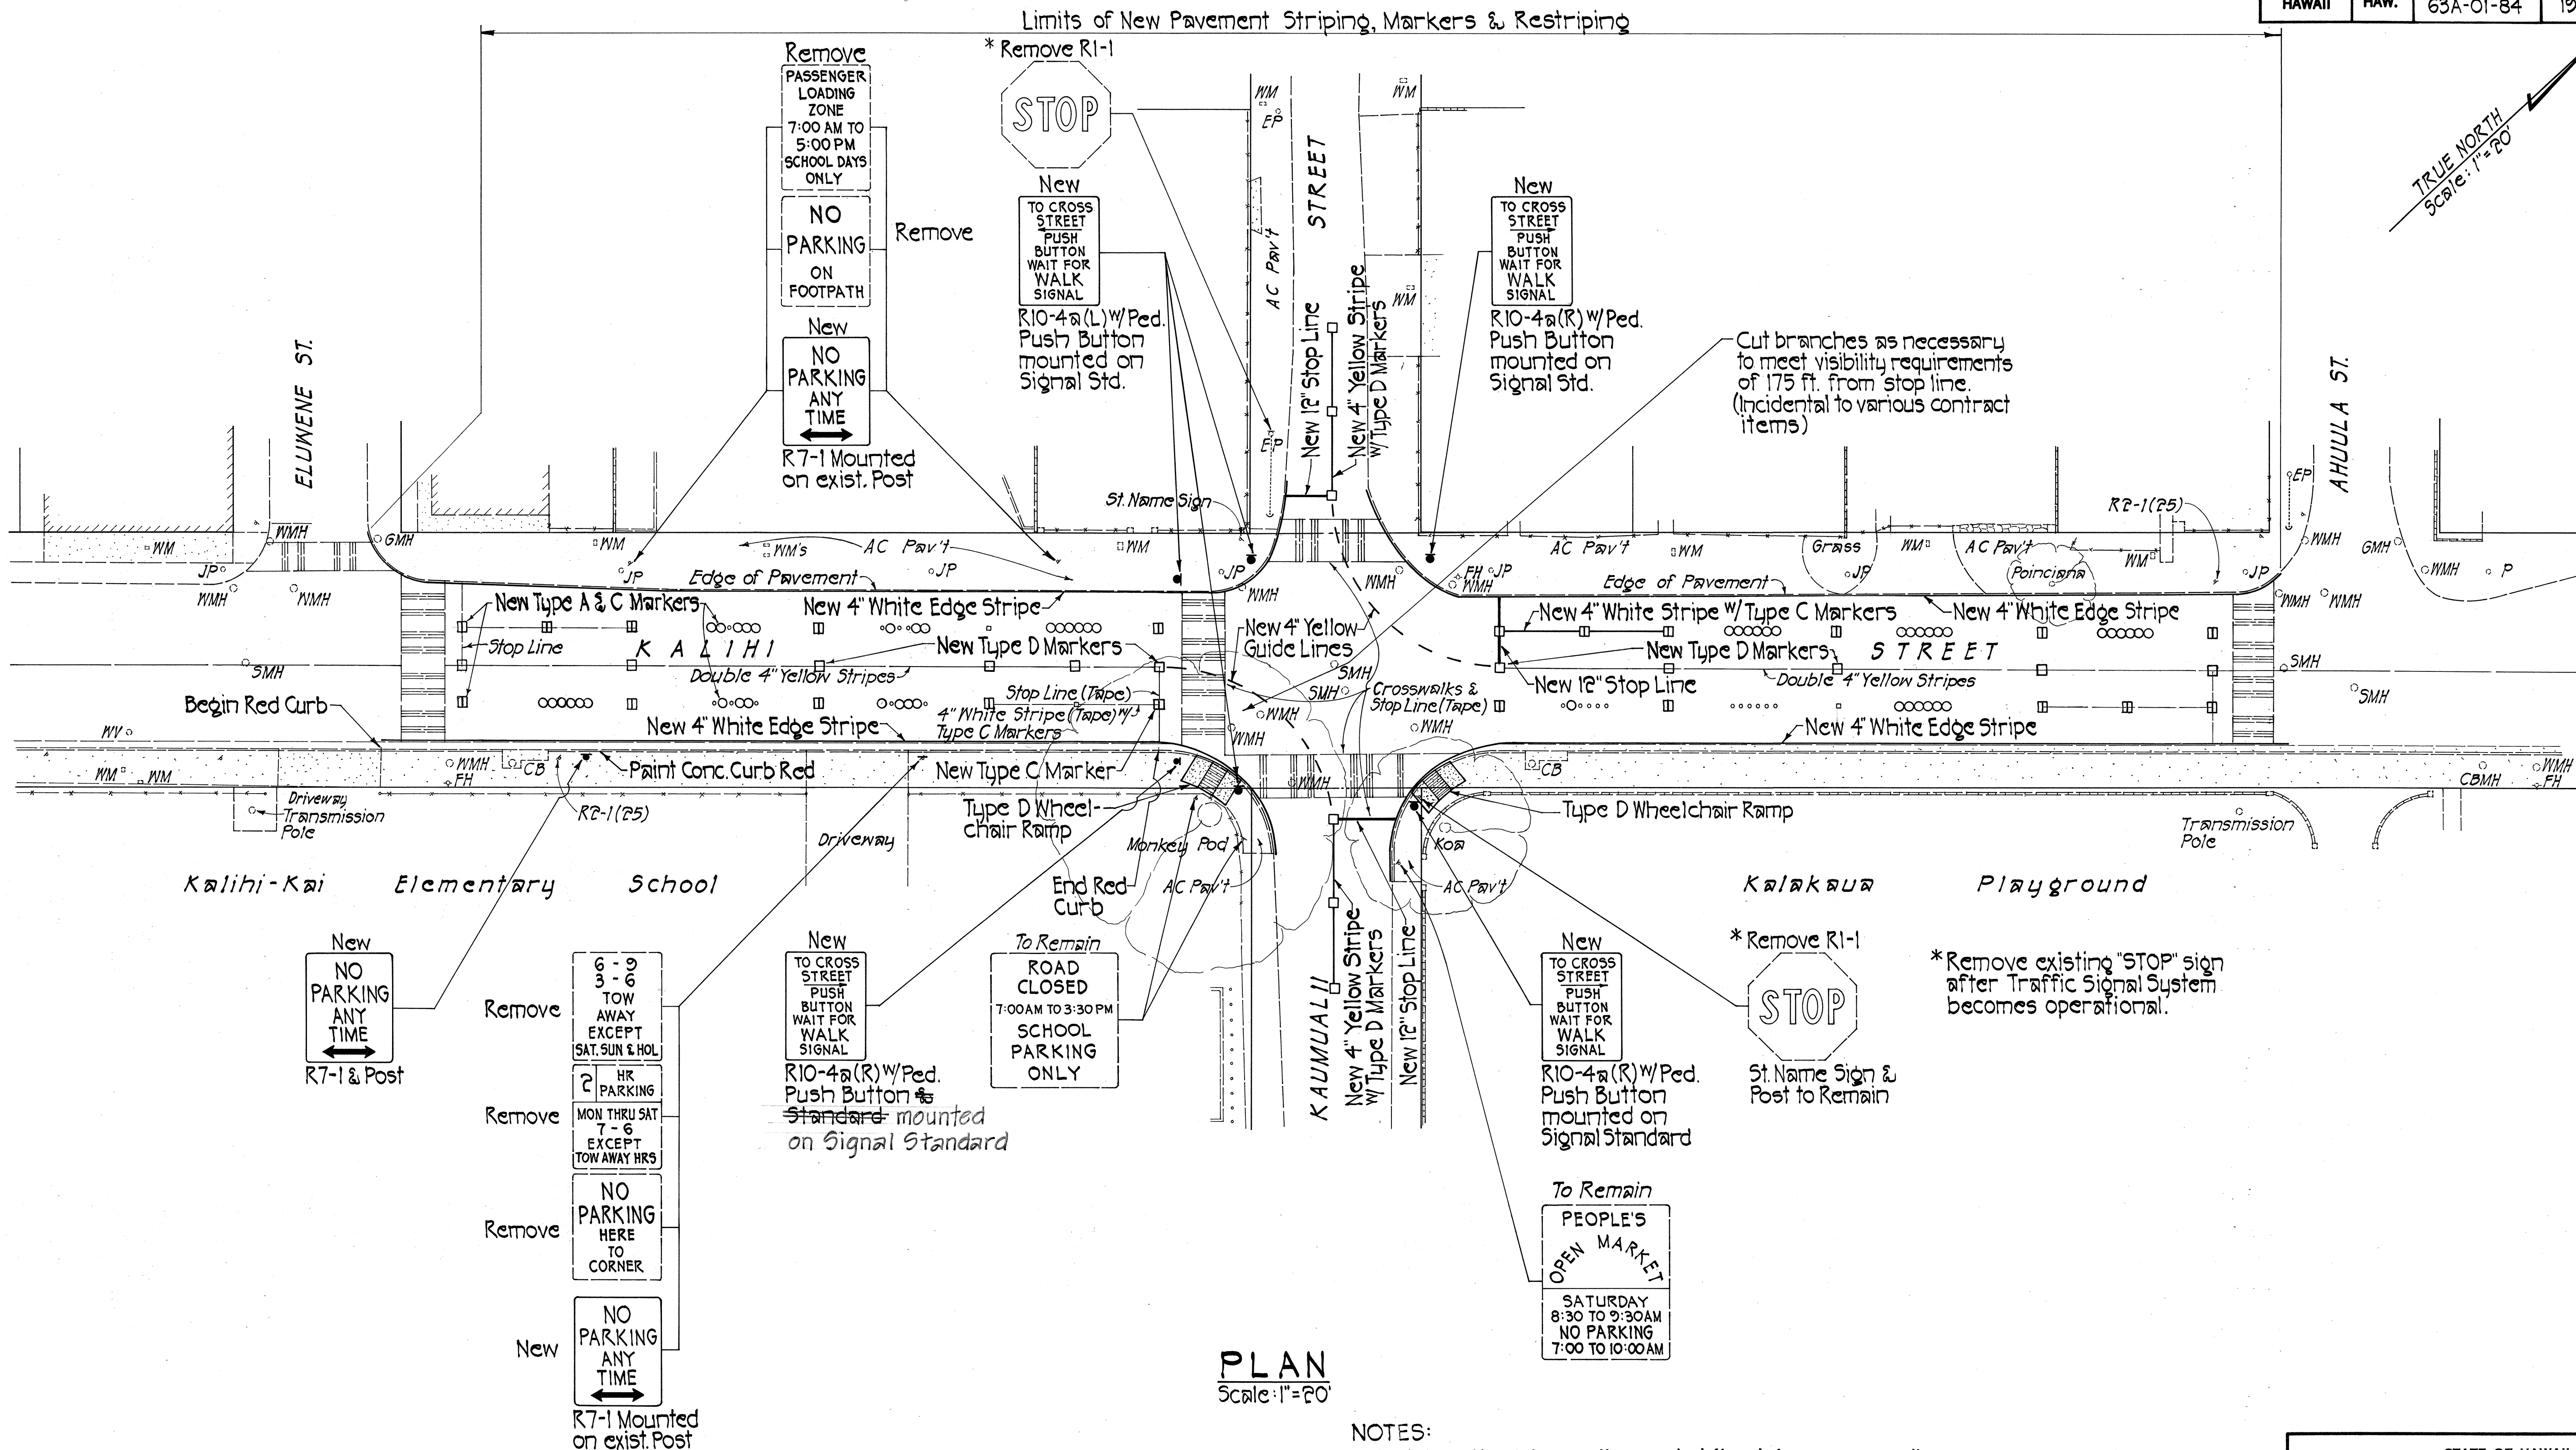

PLAN
Scale: 1"=20'

NOTES:

- Restripe all existing yellow and white stripes, crosswalks and stop lines.
- Install new pavement markers where markers are missing or damaged with proper type markers.
- Edge stripes and yellow guide lines shall be traffic paint.
- The following shall be tape:
 - 4" double yellow center lines.
 - Crosswalks.
 - Stop lines.
 - Lane lines.
 - Yellow center lines.
- Cost for painting concrete curb shall be incidental to various contract items.

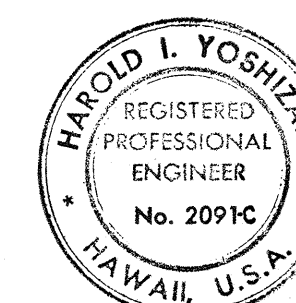

THIS WORK WAS PREPARED BY
ME OR UNDER MY SUPERVISION.
Harold I. Yoshizaki

STATE OF HAWAII
DEPARTMENT OF TRANSPORTATION
HIGHWAYS DIVISION

SIGNS, PAVEMENT MARKINGS & MISCELLANEOUS IMPROVEMENTS

KALIHII STREET TRAFFIC SIGNAL SYSTEM
AT KAUMUALII STREET

PROJECT NO. 63A-01-84
SCALE: 1"=20' DATE: MAY 15, 1984

SHEET NO. 1 OF 1 SHEETS