	INDEX TO DRAWINGS
SHEET NO.	DESCRIPTION
<b>l</b>	TITLE SHEET
2	NOTES & LEGEND
3-4	PLAN-TRAFFIC SIGNAL SYSTEM
5	SIGNS, PAVEMENT MARKINGS &
	MISCELLANEOUS IMPROVEMENTS
6	MISCELLANEOUS DETAILS
7-16	STANDARD DETAILS
**	
	en de la proposition de la company de la com
•	
* .	
·	



STATE OF



## TRANSPORTATION DEPARTMENT OF HIGHWAYS DIVISION


HONOLULU, HAWAII


"AS-BUILT"

PLANS FOR

## KALIHI STREET TRAFFIC SIGNALS AT KAUMUALII STREET PROJECT NO. 63A-01-84

DISTRICT OF HONOLULU ISLAND OF OAHU

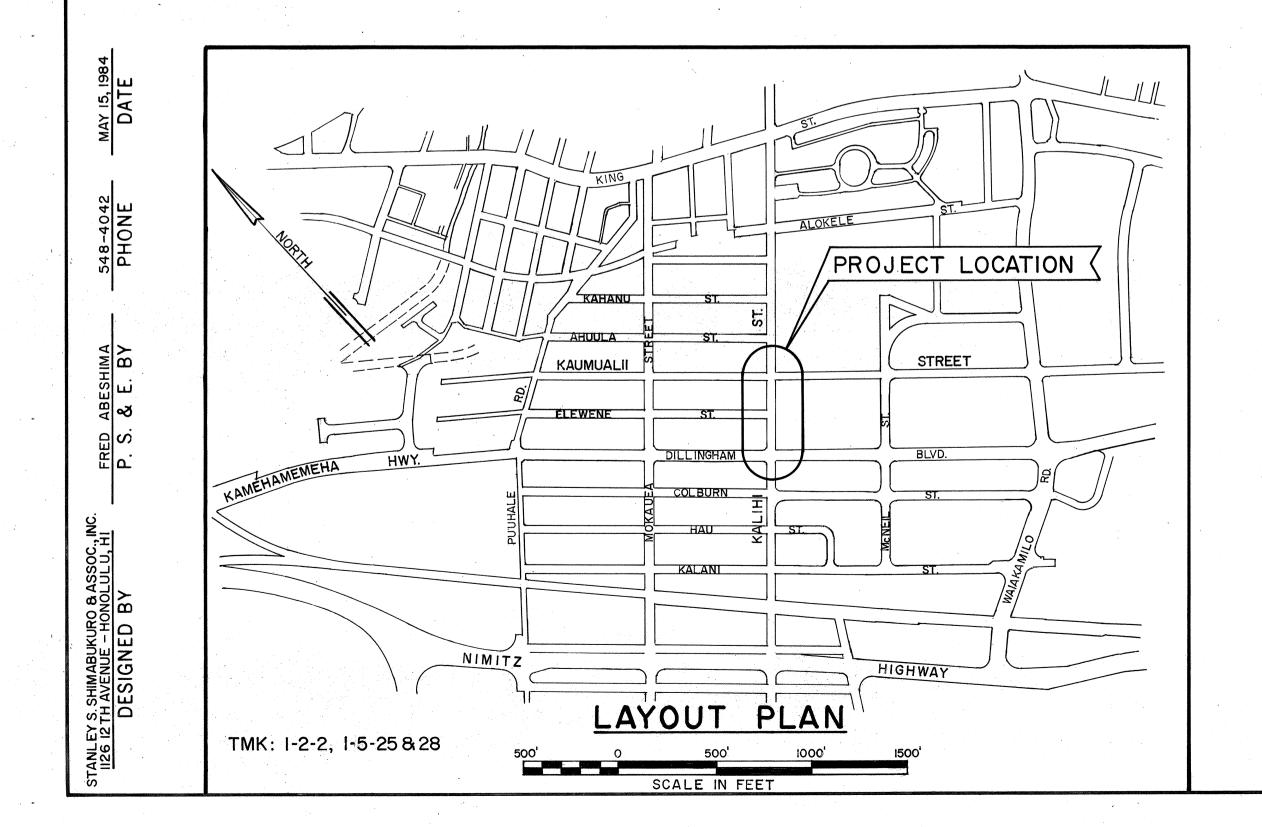

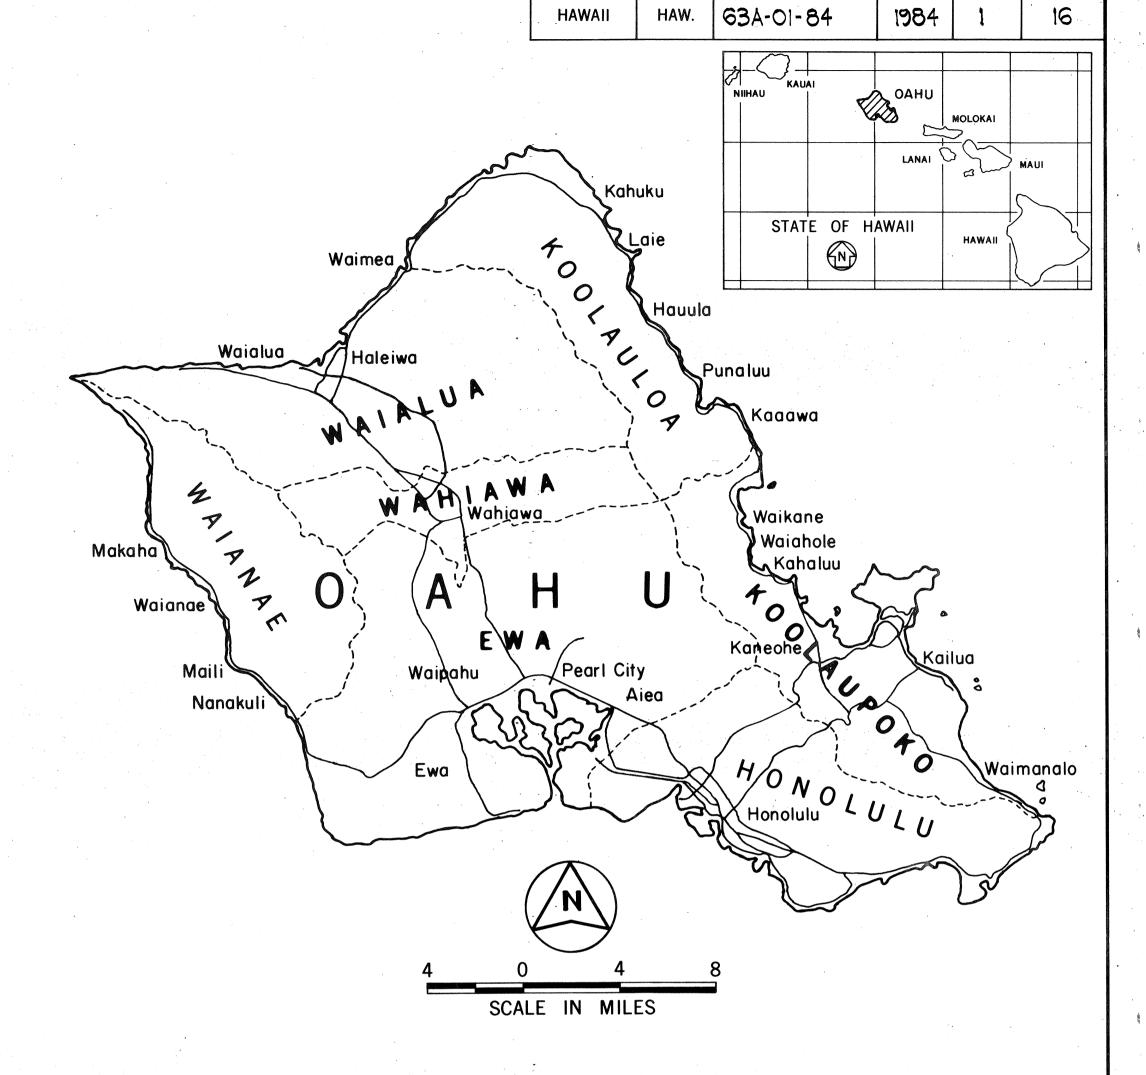

FED. ROAD DIST. NO.

FISCAL SHEET YEAR NO.

CHANGES MADE DURING CONSTRUCTION HAVE BEEN NOTED ON THESE PLANS AND CHECKED BY:

DEPARTMENT OF TRANSPORTATION STATE OF HAWAII APPROVED: 5/17/89 DATE