




FED. ROAD DIST. NO.	STATE	FED. AID PROJ. NO.	FISCAL YEAR	SHEET NO.	TOTAL SHEETS
HAWAII	HAW.	F-063-1(17)	1984	73	156

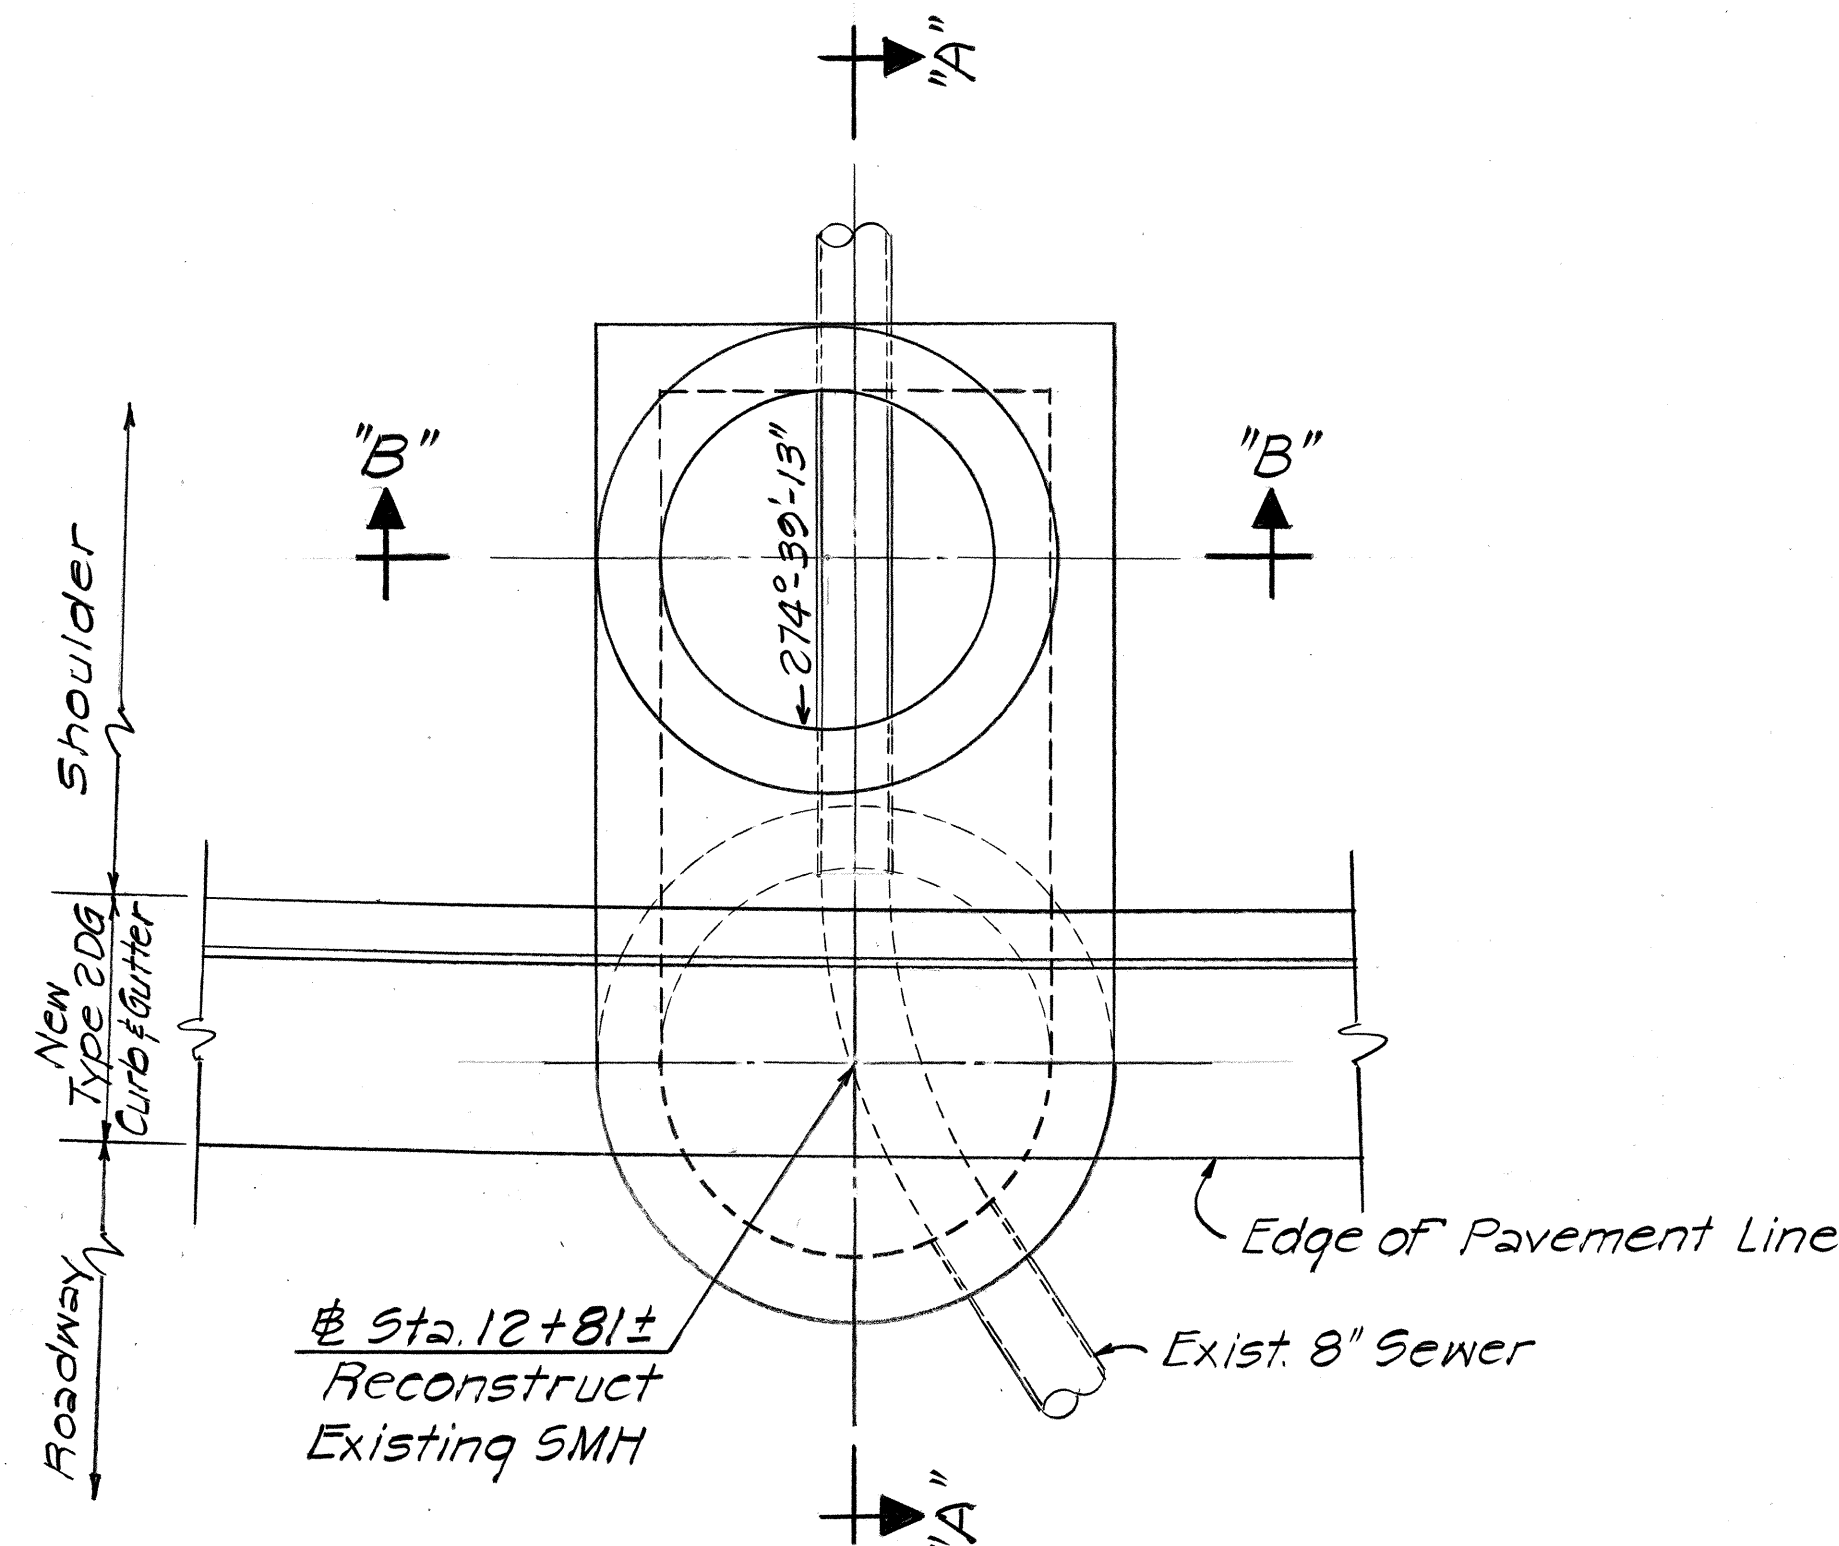


PLAN
SEWER MANHOLE @ STA. 12+81
Scale: 1/2"=1'-0"

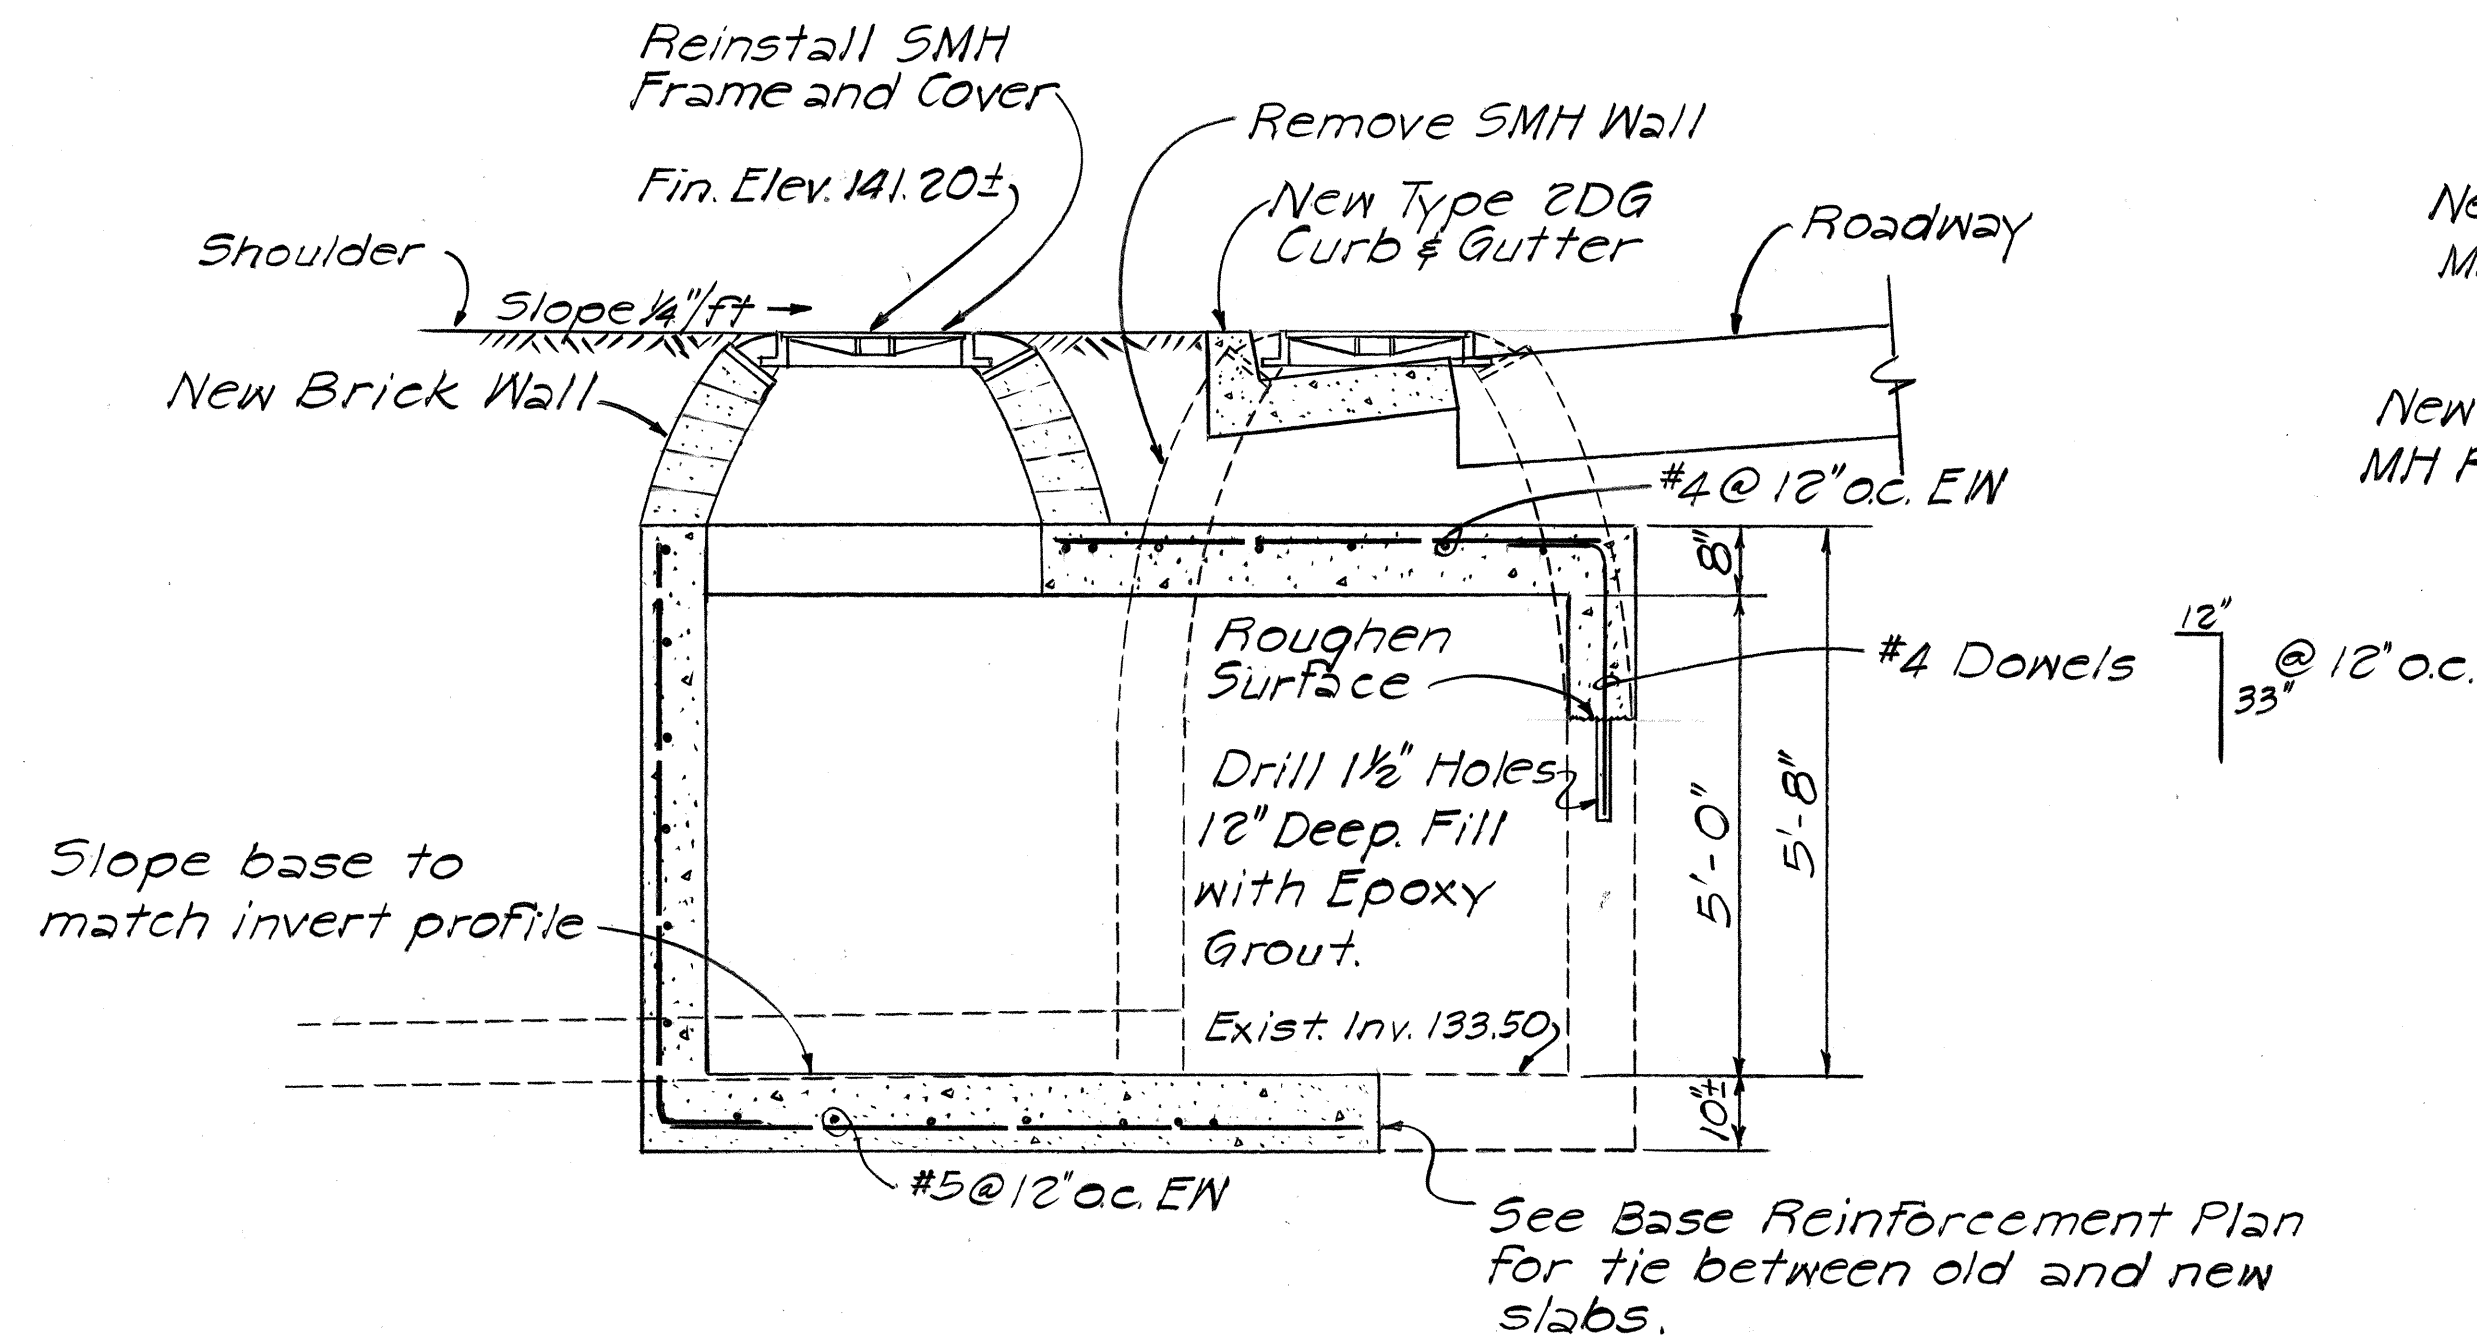


SECTION "A-A"
Scale: 1/2"=1'-0"

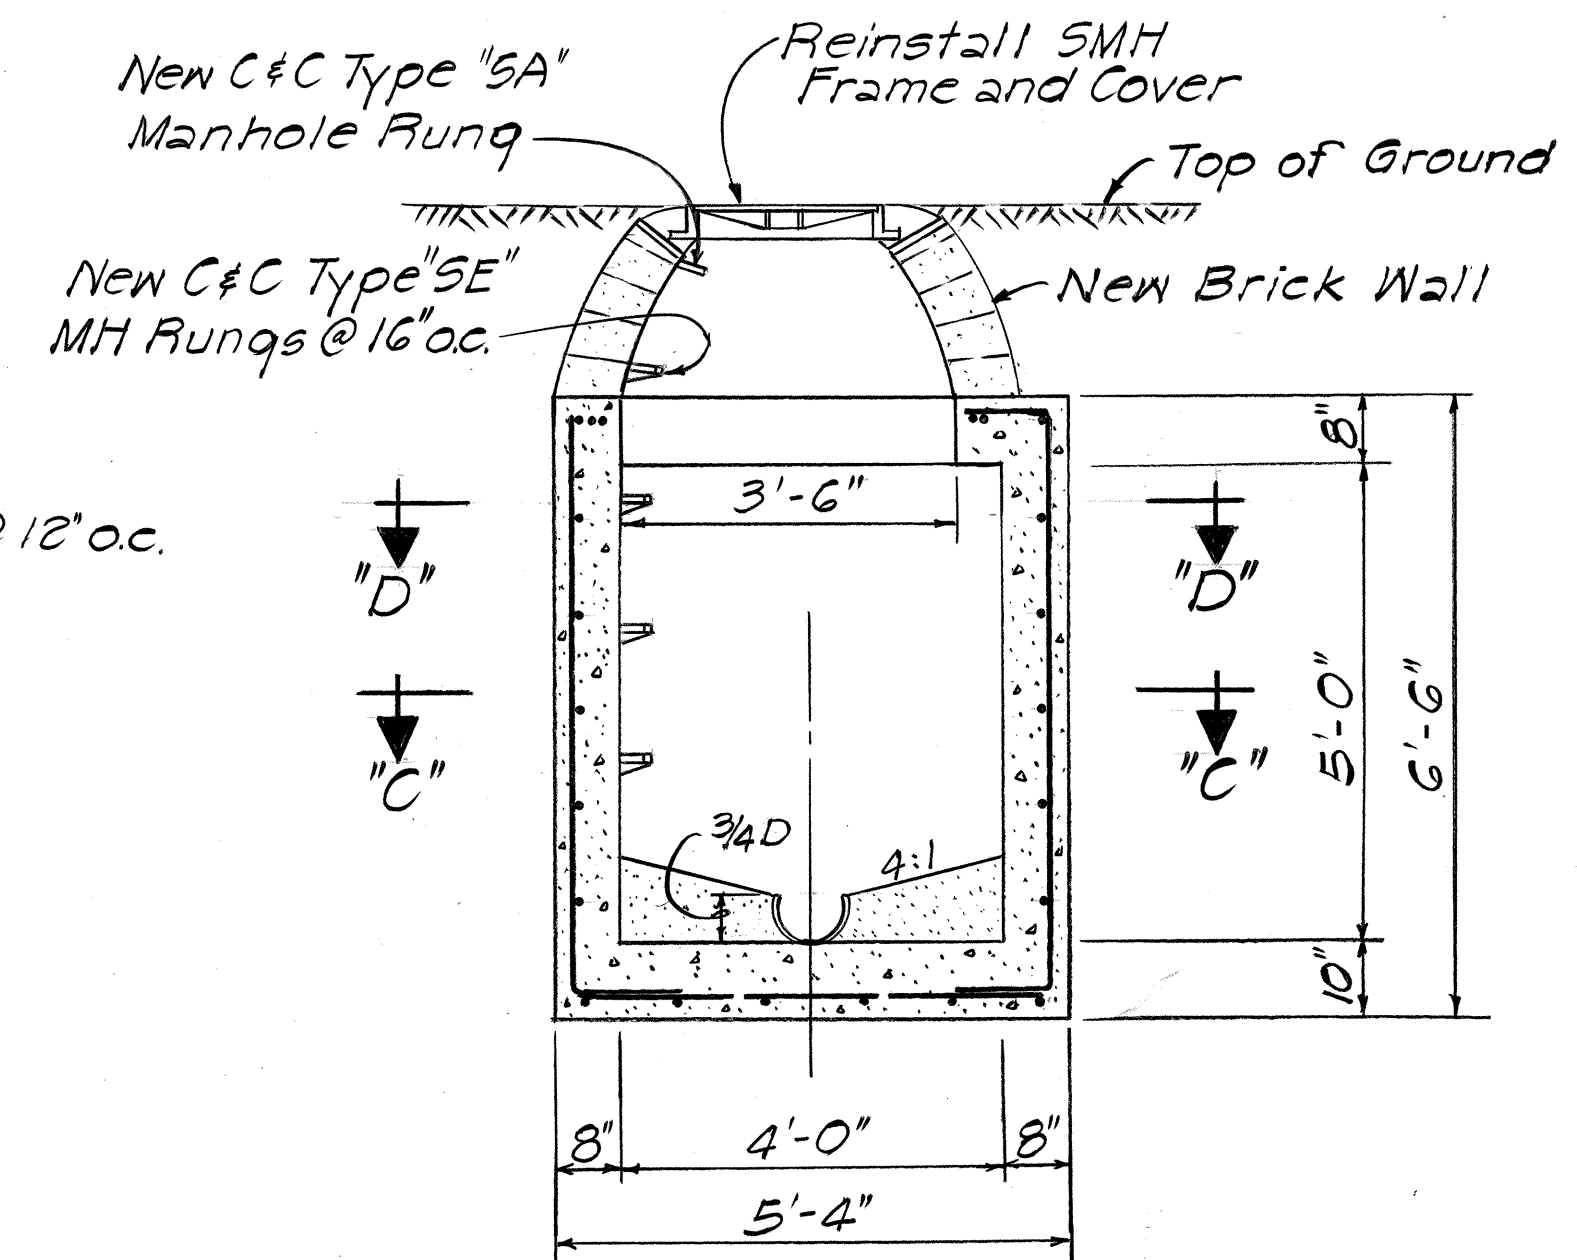


SECTION "B-B"
Scale: 1/2"=1'-0"

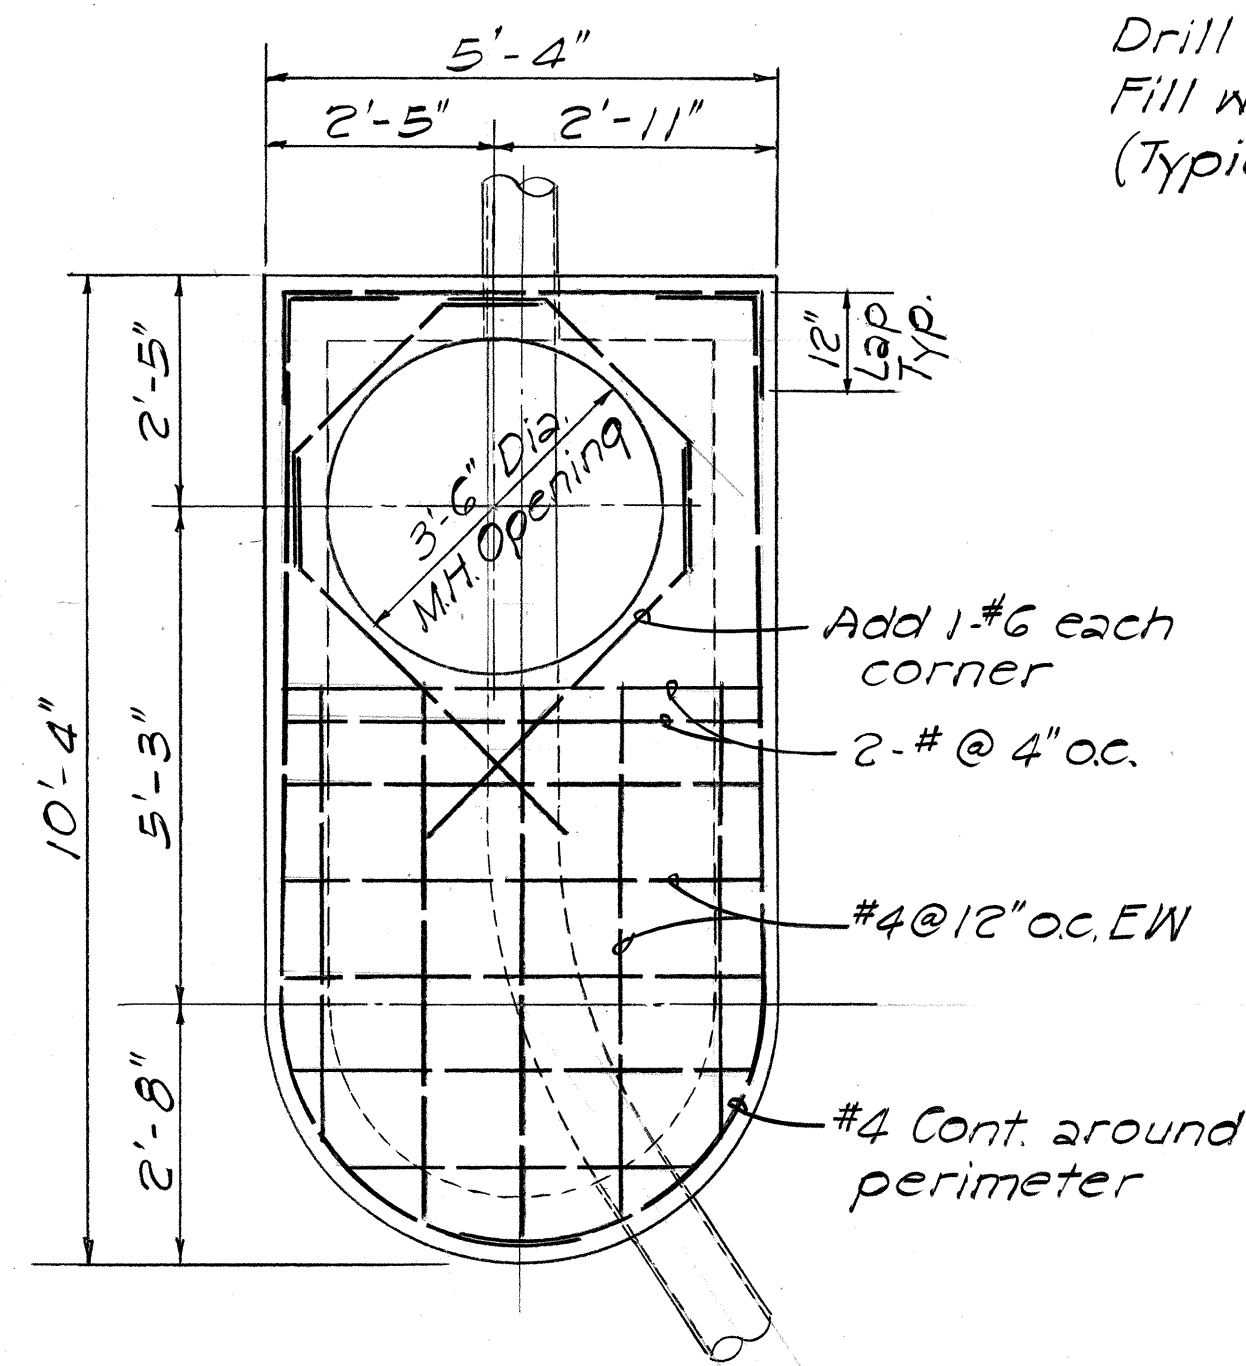


TOP SLAB REINFORCEMENT PLAN
Scale: 1/2"=1'-0"

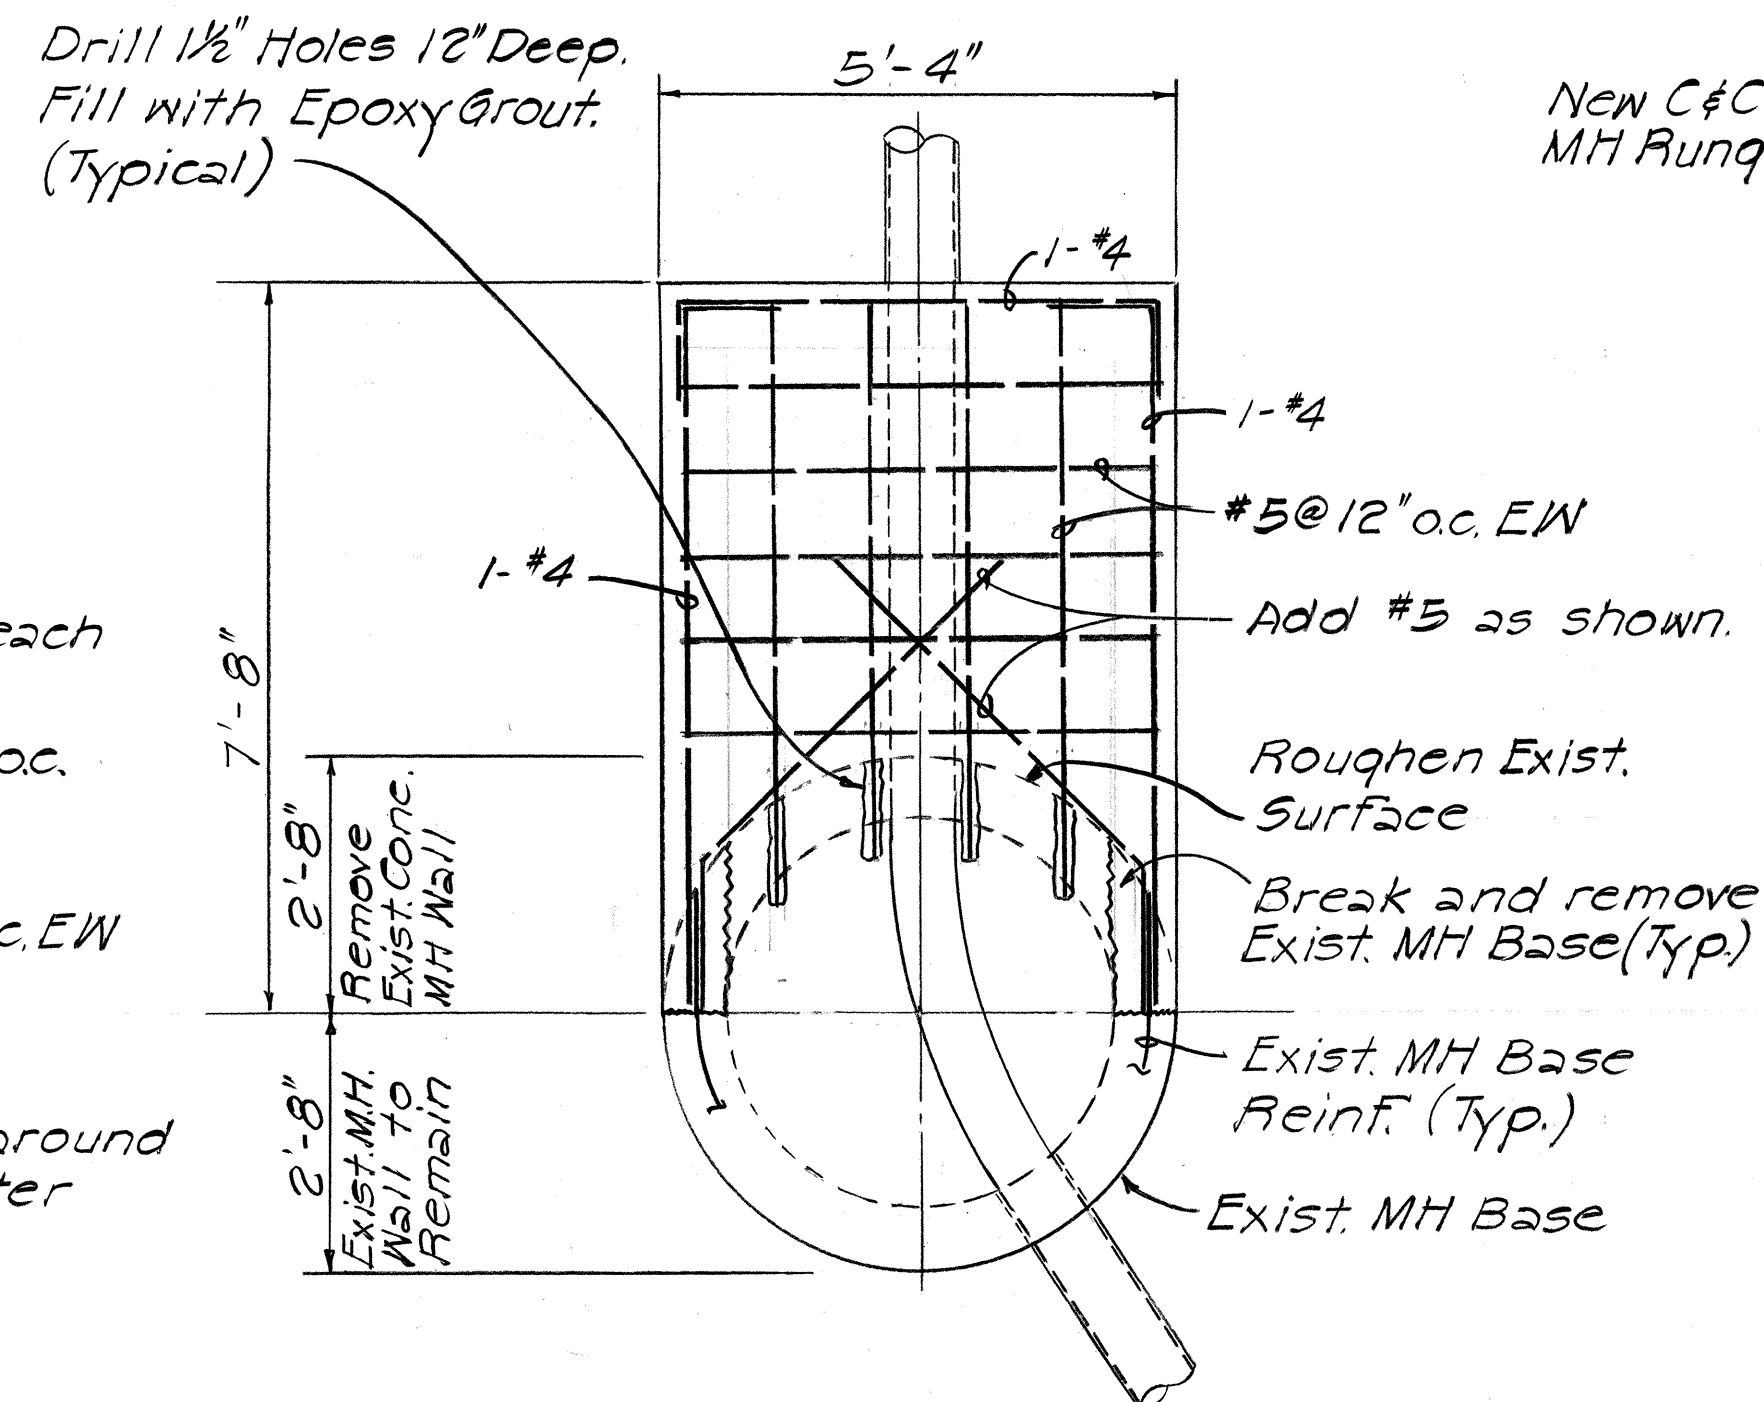


SMH BASE REINFORCEMENT PLAN
Scale: 1/2"=1'-0"

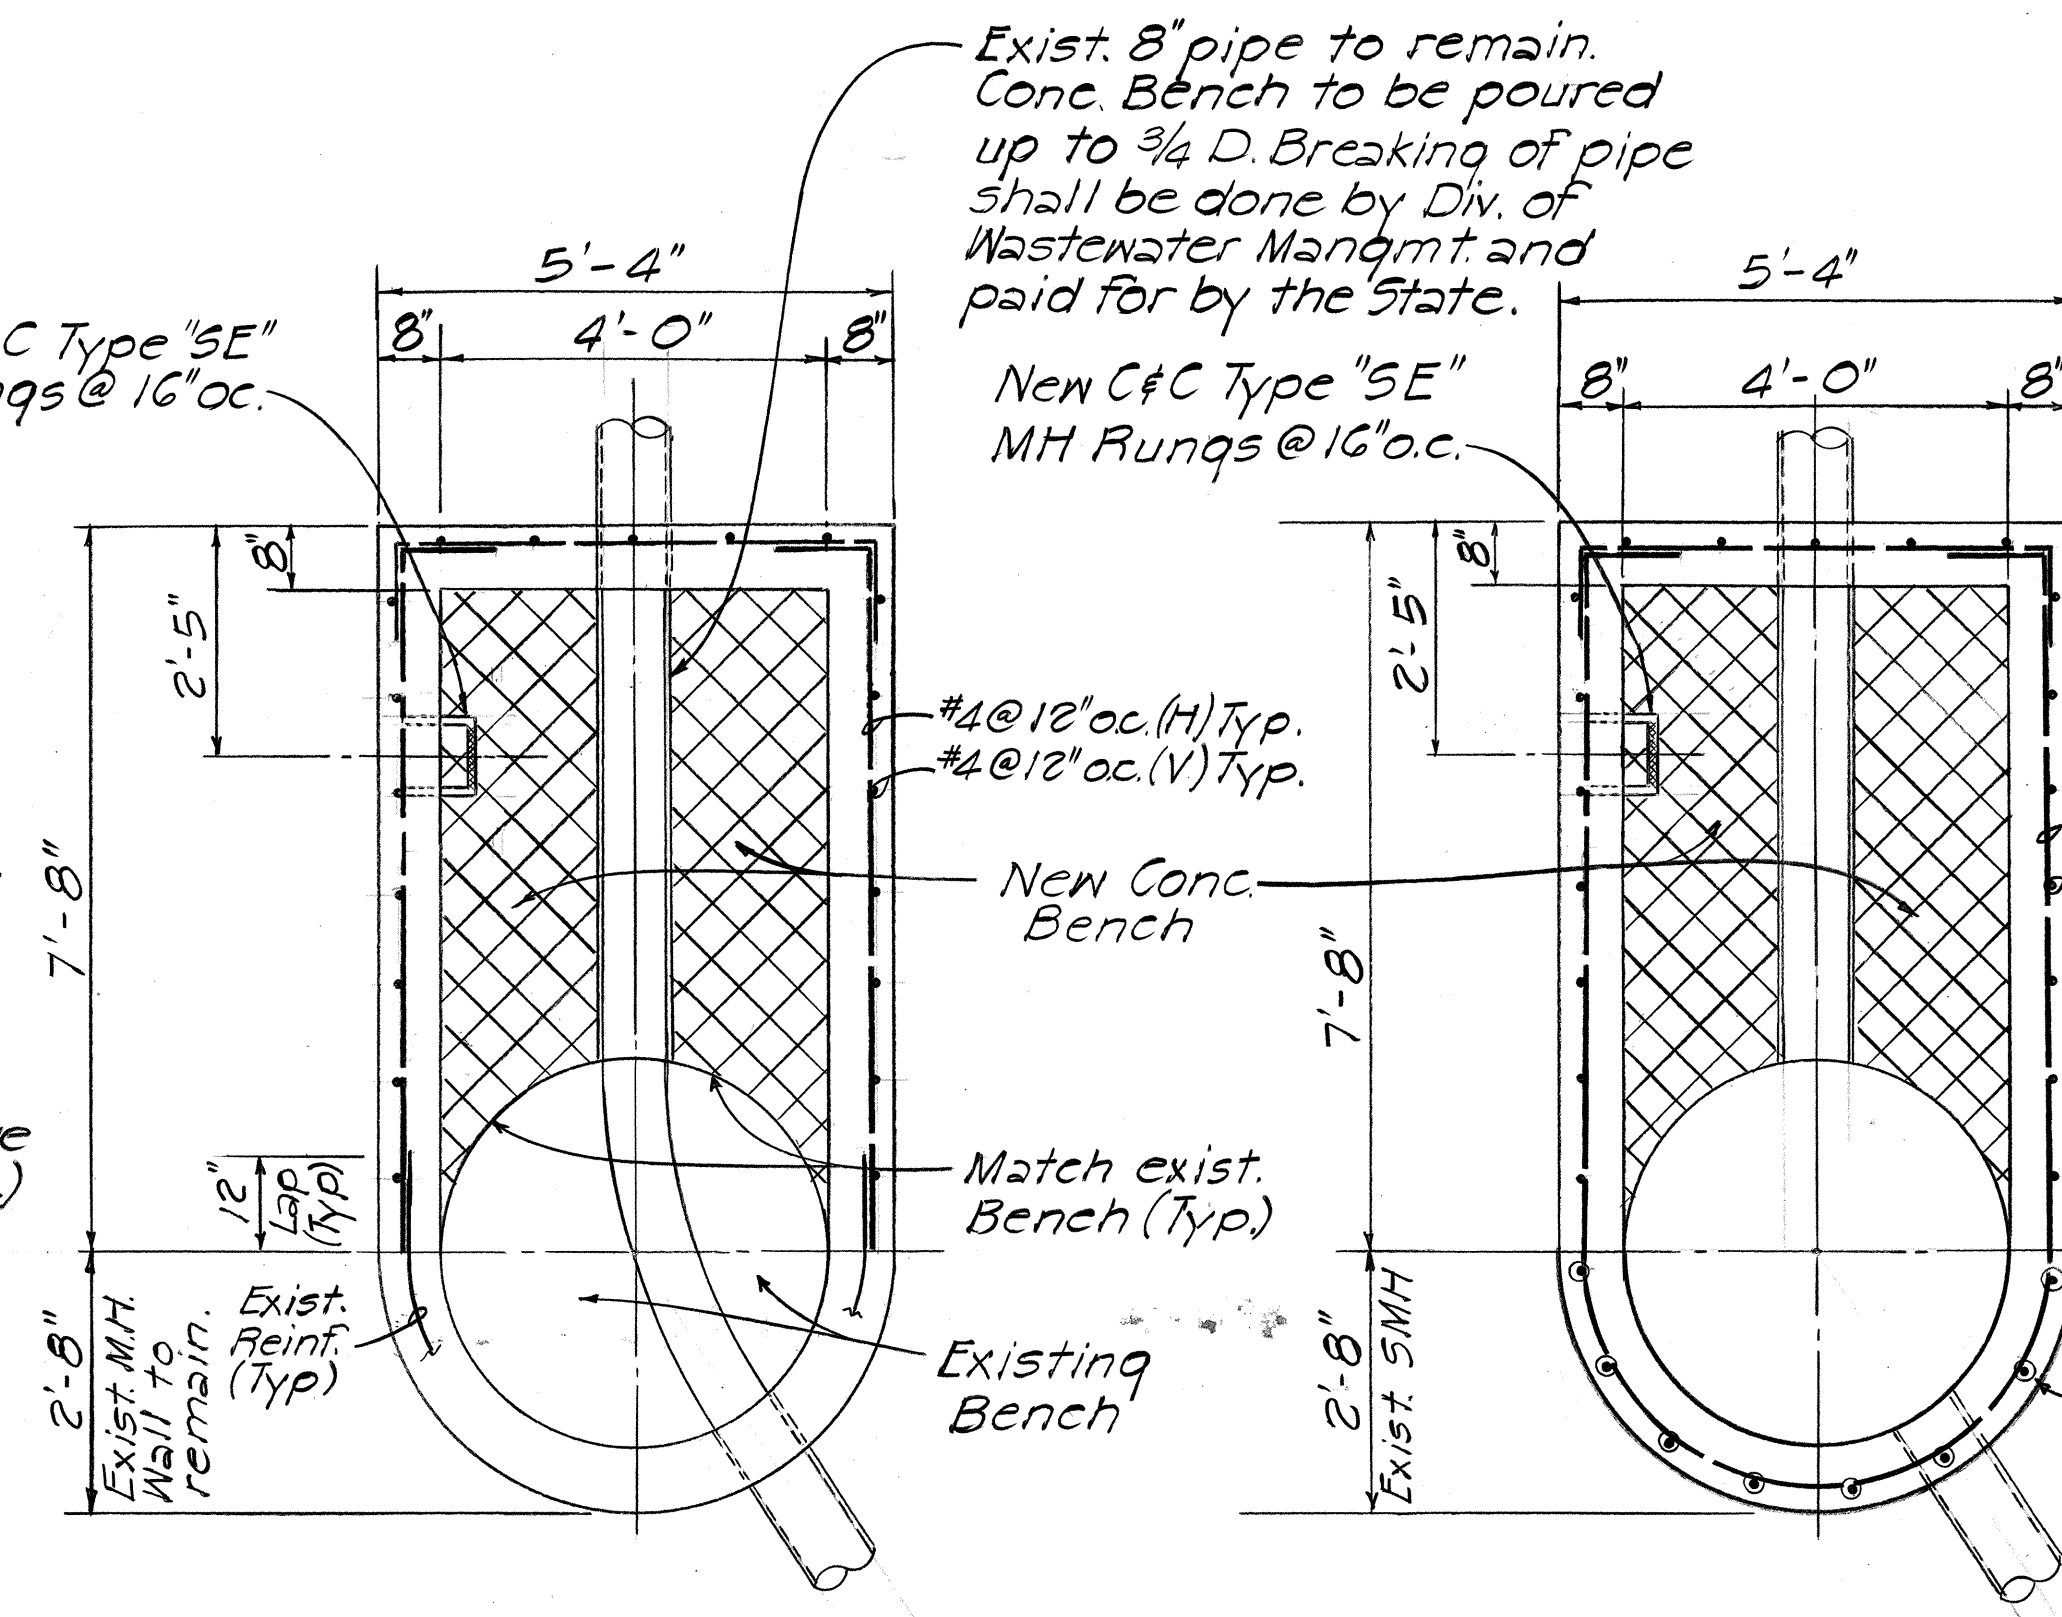

SECTION "C-C"
Scale: 1/2"=1'-0"

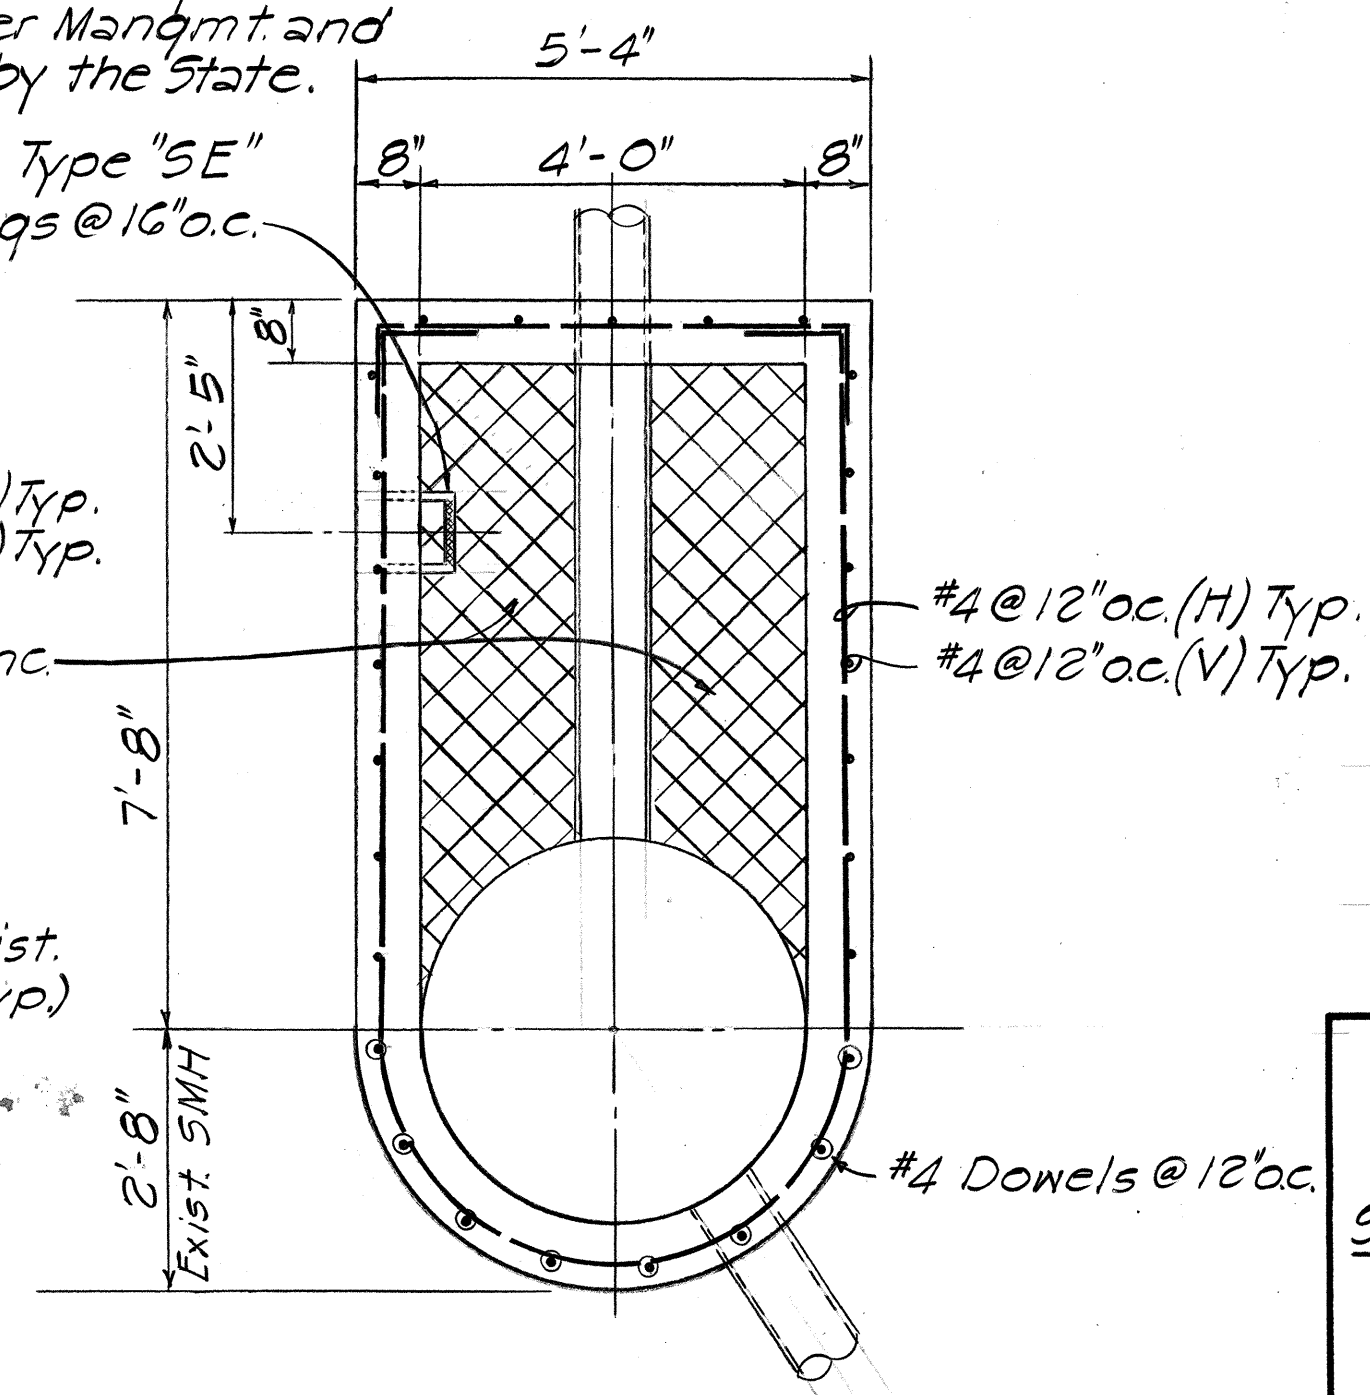

SECTION "D-D"
Scale: 1/2"=1'-0"

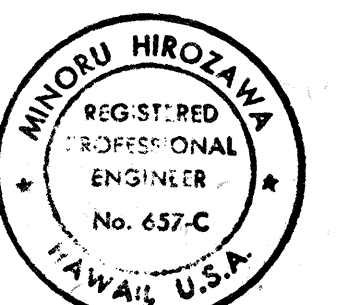

THIS WORK WAS PREPARED BY
ME OR UNDER MY SUPERVISION.
[Signature]
DATE: 2/10/84

APPROVED:

[Signature]
CHIEF, DIVISION OF WASTEWATER
MANAGEMENT, DPW

STATE OF HAWAII
DEPARTMENT OF TRANSPORTATION
LAND TRANSPORTATION FACILITIES DIVISION
SEWER MANHOLE RECONSTRUCTION
@ STA. 12+81
LIKELIKE HIGHWAY IMPROVEMENTS
KAM IV ROAD TO VICINITY OF KALIHI STREET
F.A. PROJ. NO. F-063-1(17)
SHEET NO. 1 OF 1 SHEETS