

INDEX TO DRAWINGS	
SHEET NO.	DESCRIPTION
51	TITLE SHEET
52	TYPICAL SECTIONS
53	GENERAL NOTES
54-56	PLAN AND PROFILE
57-62	DETAIL PLAN OF ROADWAY
63-67	PAVEMENT RECONSTRUCTION & GRADES
68-70	CONSTRUCTION PHASING PLAN
71-72	DRAINAGE DETAILS
73	SEWER MANHOLE RECONSTRUCTION
74	TYPE 4 GUARD RAIL TRANSITION
75	TRAFFIC CONTROL PLAN
76-77	SIGNING AND MARKING PLANS
	AND DETAILS
78-85	HIGHWAY LIGHTING AND TRAFFIC SIGNAL SYSTEMS
86-97	KALIHI STREAM BRIDGE WIDENING
98-106	KALIHI STREAM PEDESTRIAN STRUCTURES AND DETAILS
107	METAL GUARD RAIL CONNECTION AT BARRIER RAIL END POST
108-112	EXISTING KALIHI STREAM BRIDGE
113-116	CROSS SECTIONS





STATE OF HAWAII
DEPARTMENT OF TRANSPORTATION
HIGHWAYS DIVISION
HONOLULU, HAWAII


PLANS FOR
LIKELIKE HIGHWAY IMPROVEMENTS
KAM IV ROAD TO VICINITY OF KALIHI STREET
PROJECT NO. F-063-1(17)

DISTRICT OF HONOLULU
ISLAND OF OAHU

FED. ROAD DIST. NO.	STATE	FED. AID PROJ. NO.	FISCAL YEAR	SHEET NO.	TOTAL SHEETS
HAWAII	HAW.	F-063-1(17)	1984	51	156

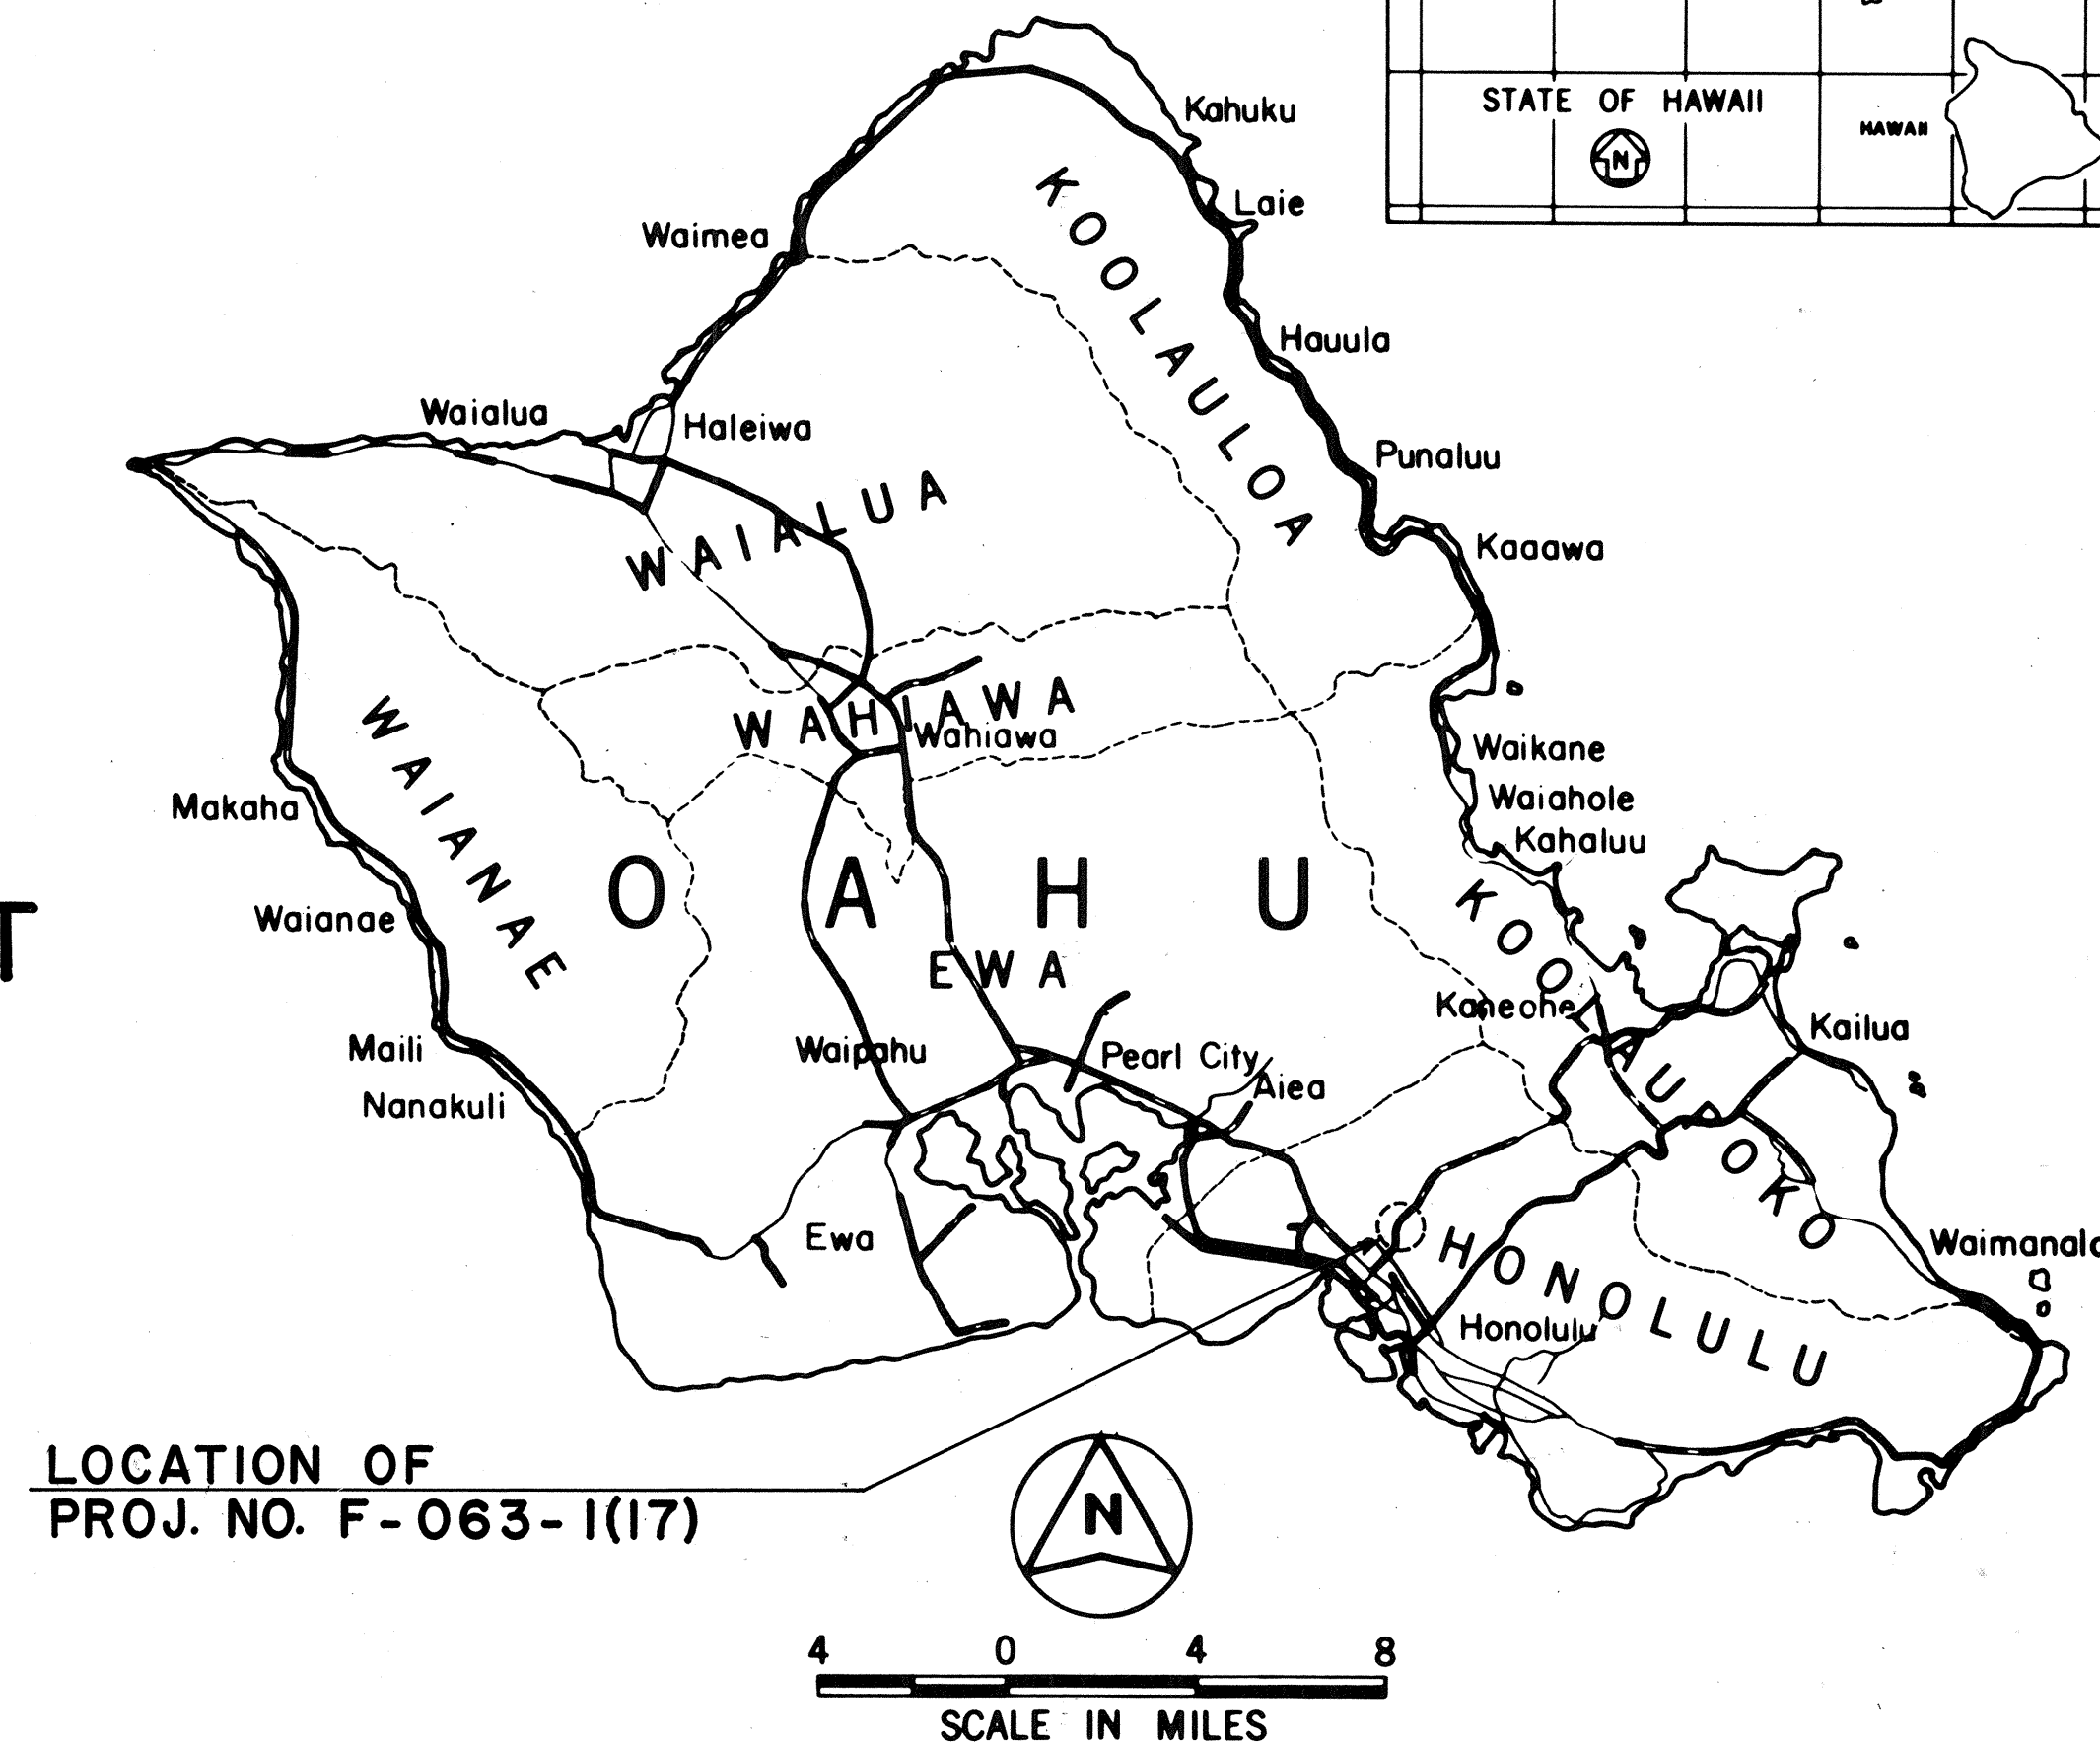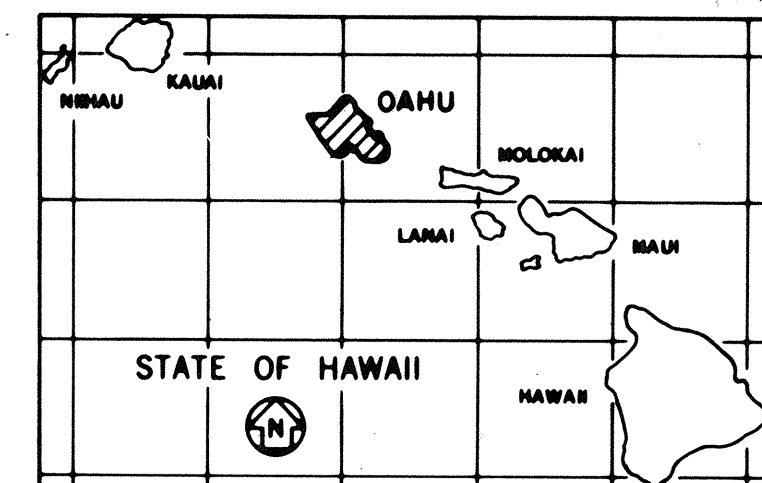

LOCATION OF
PROJ. NO. F-063-1(17)

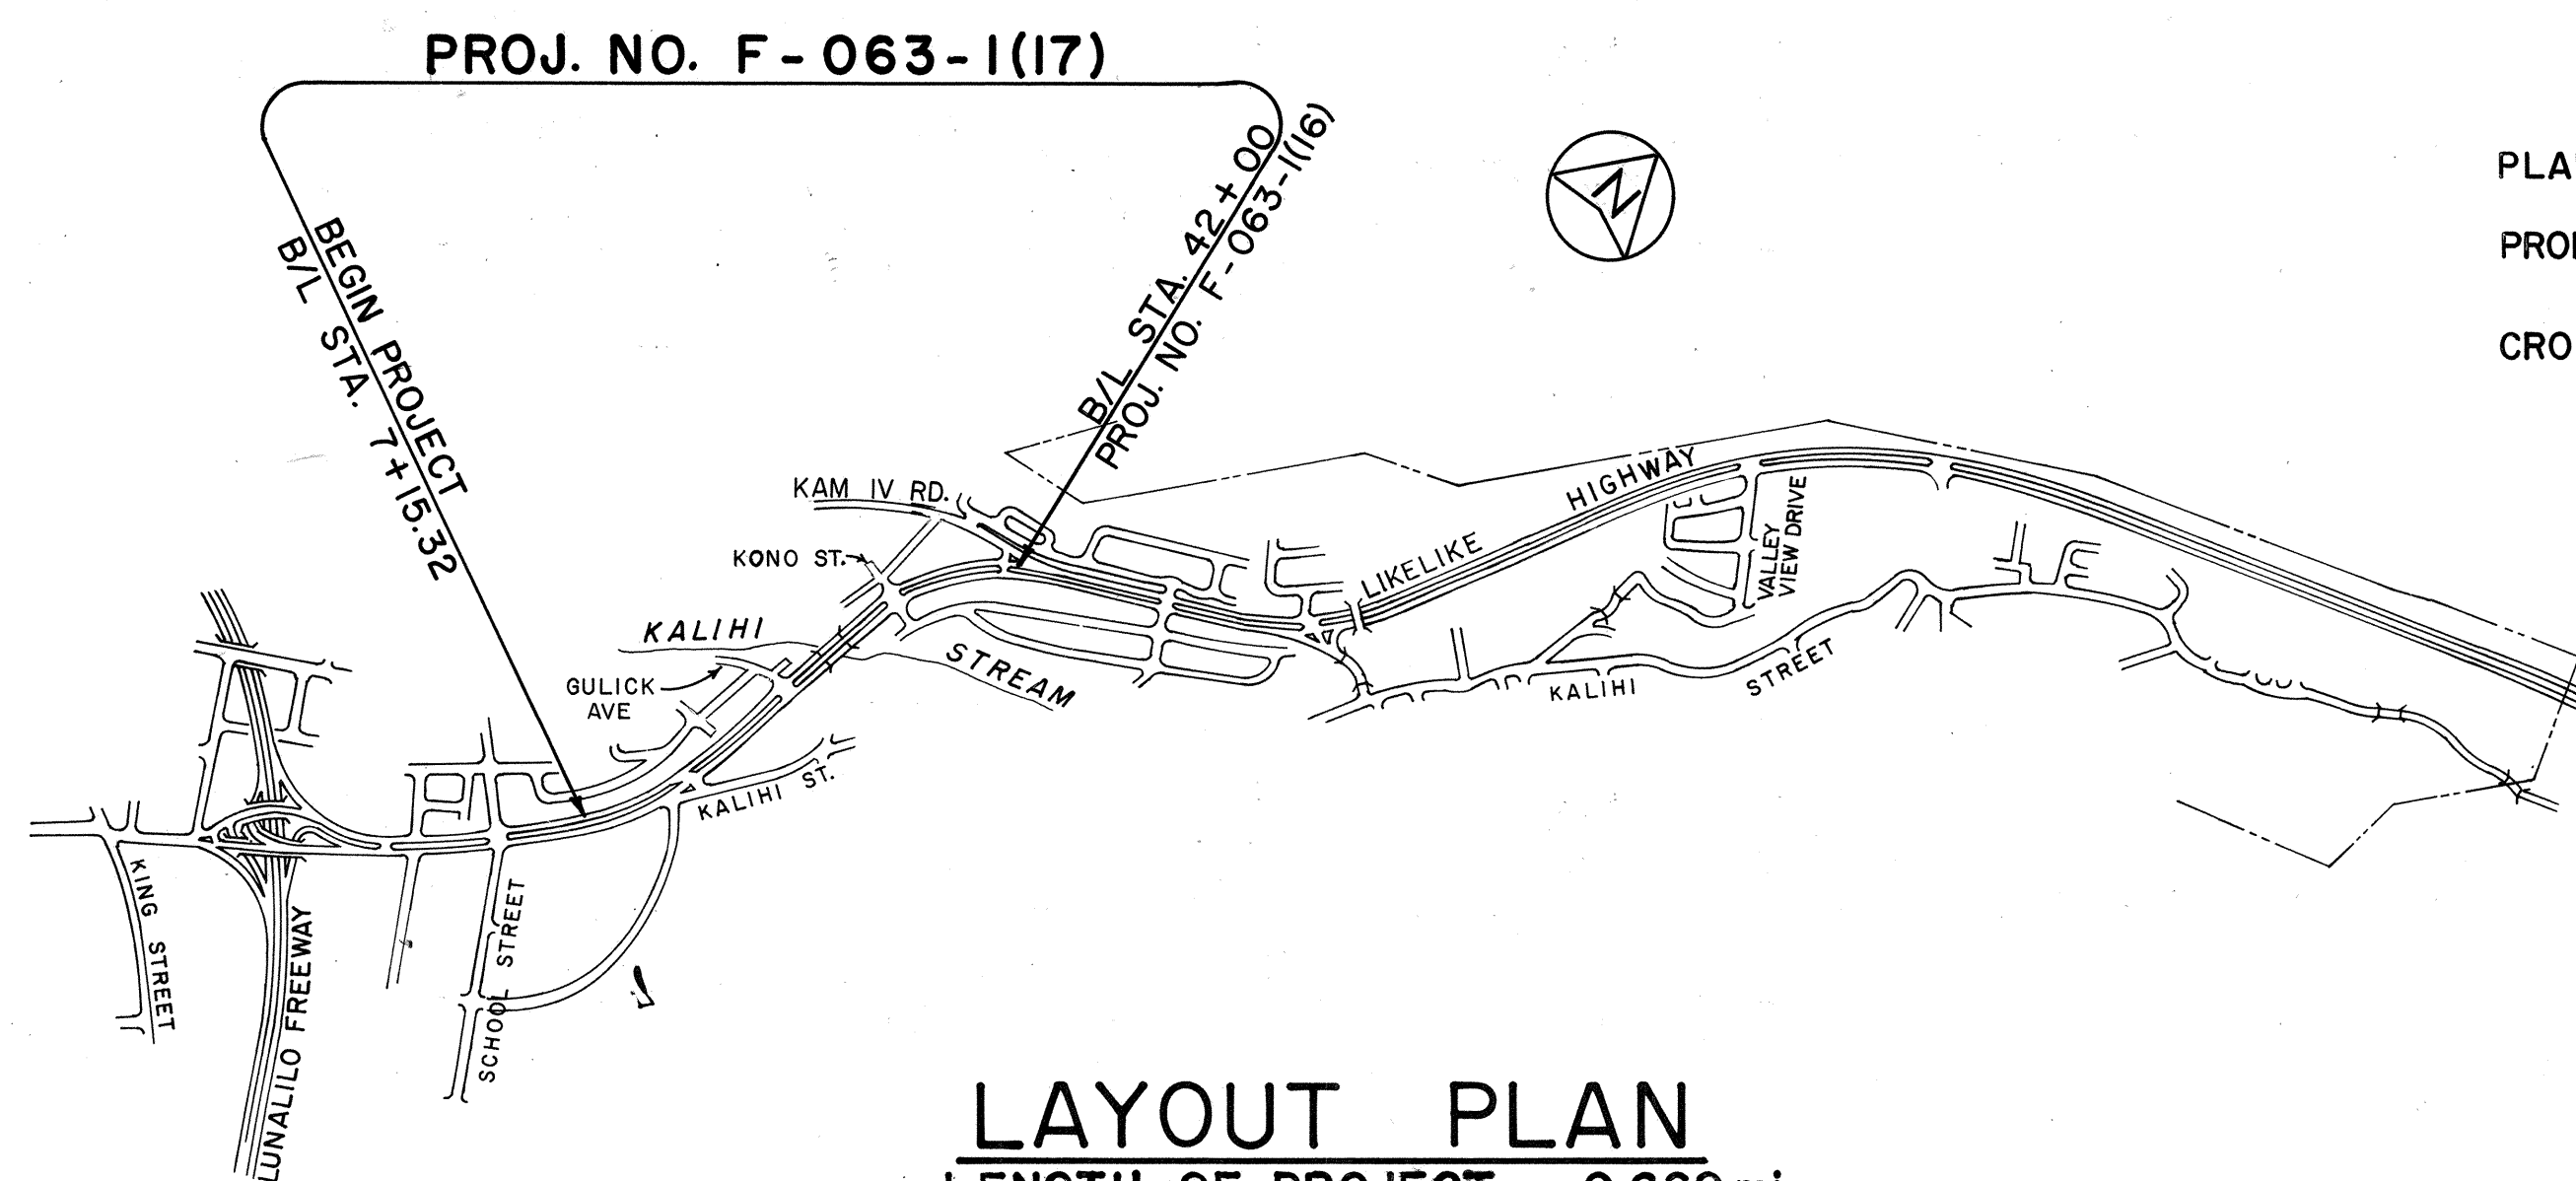

LAYOUT PLAN
LENGTH OF PROJECT....0.660 mi.

SCALES	
PLAN	1" = 50'
PROFILE	HOR. 1" = 50'
	VERT. 1" = 5'
CROSS SECTIONS	HOR. 1" = 10'
	VERT. 1" = 10'

— — — — — FEDERAL AID PROJECTS PREVIOUSLY CONSTRUCTED OR UNDER CONSTRUCTION

Thos. Lum & Assoc., Inc. Lincoln Char P. S. & E. BY 548-7532 548-7532 Aug. 1984 DATE