
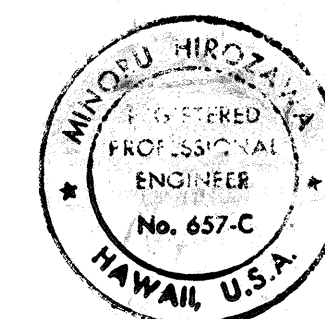
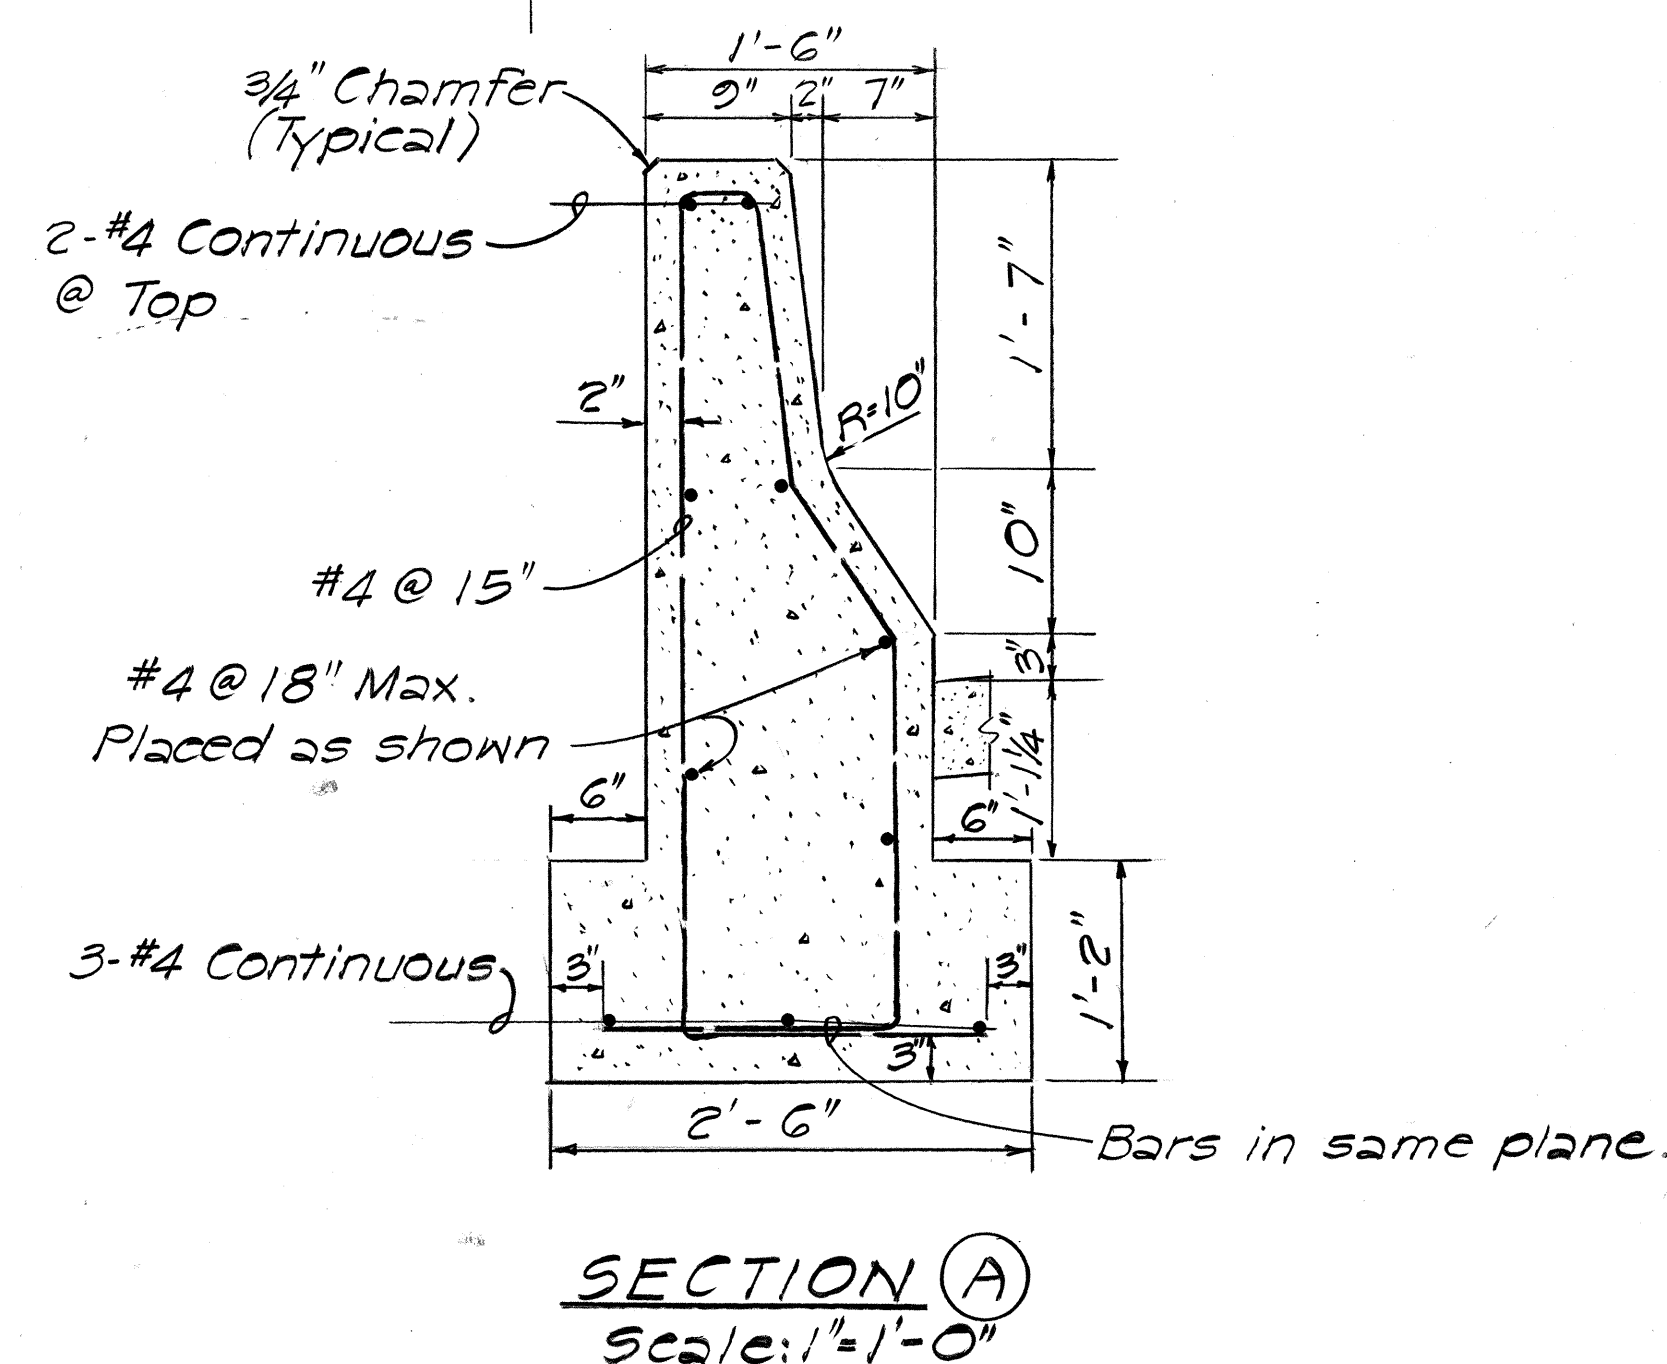
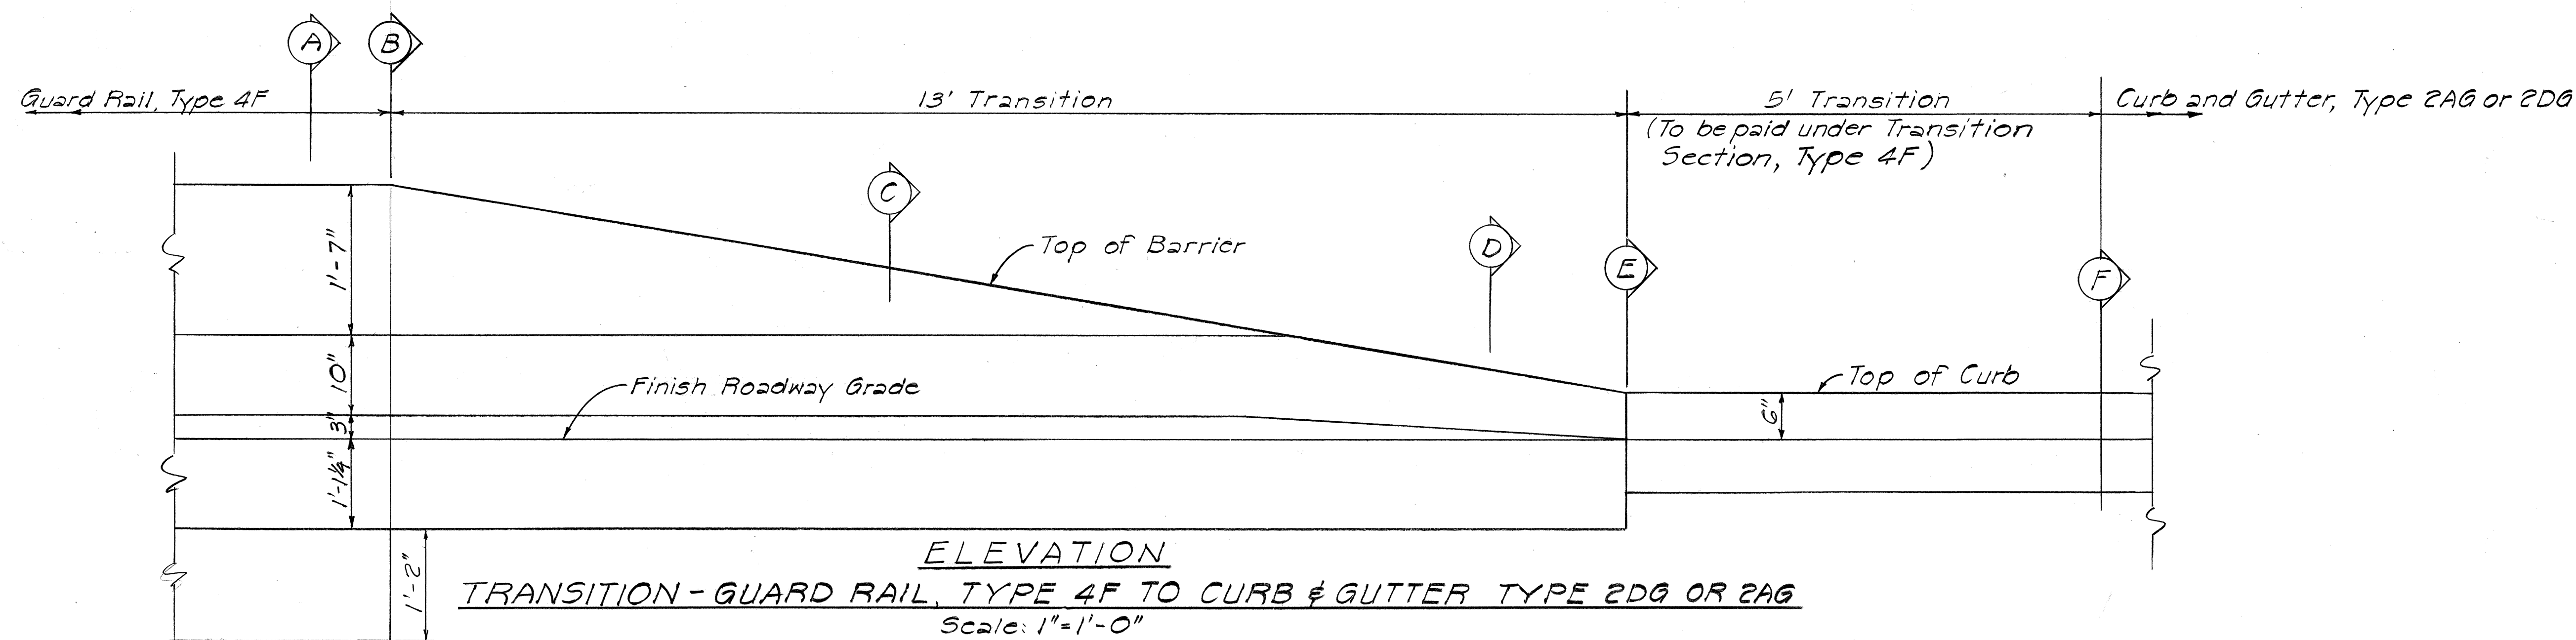
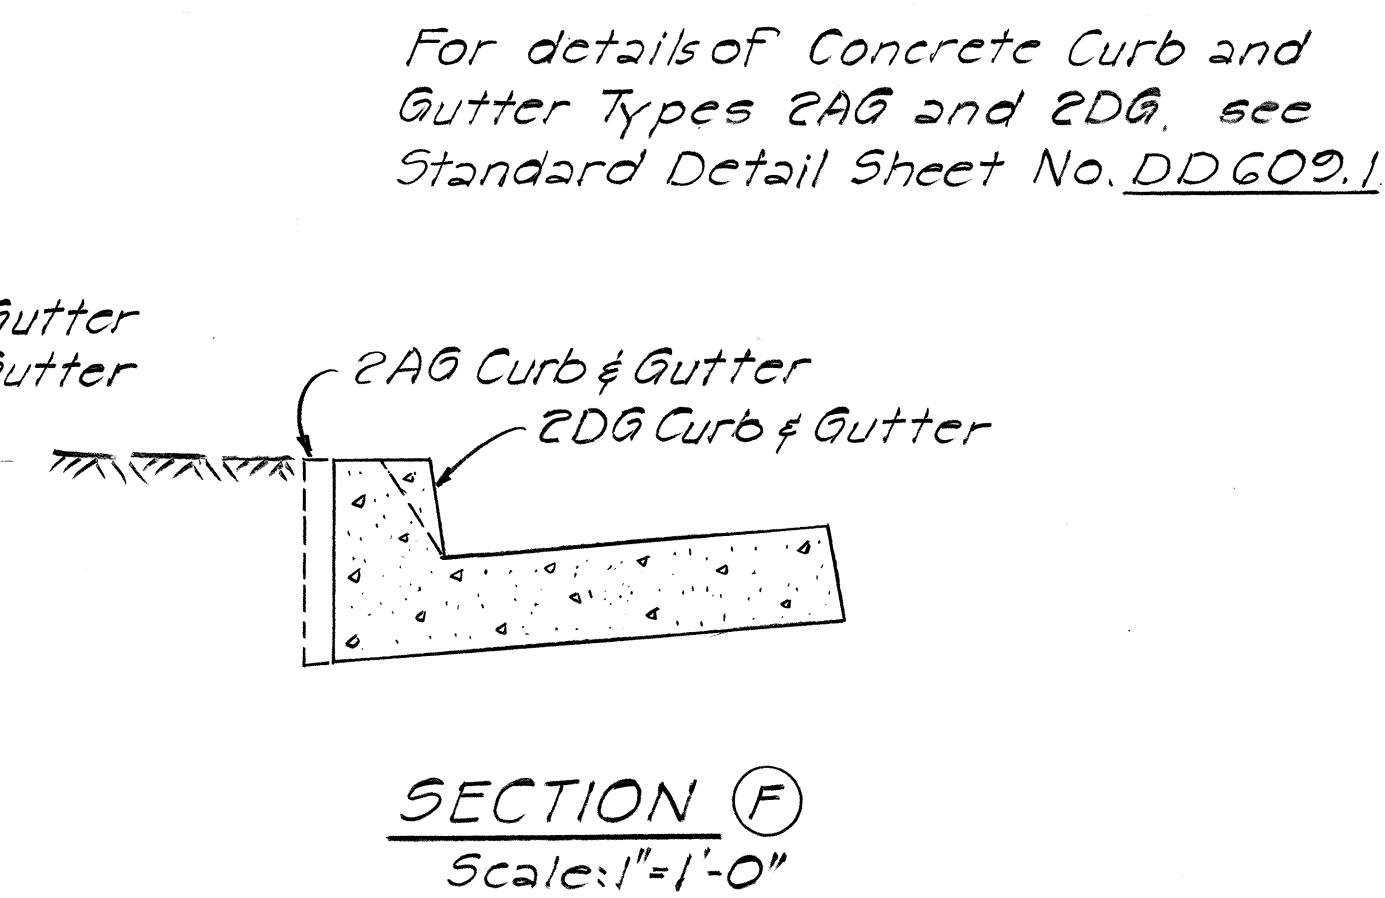
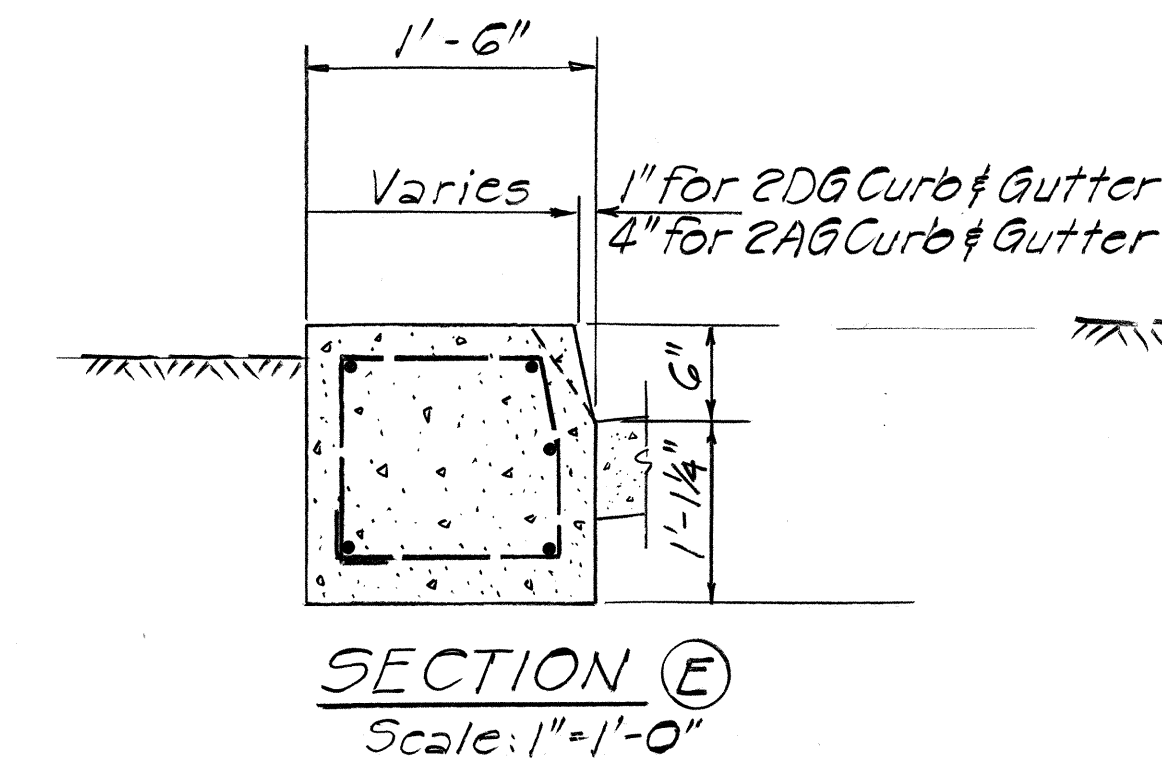
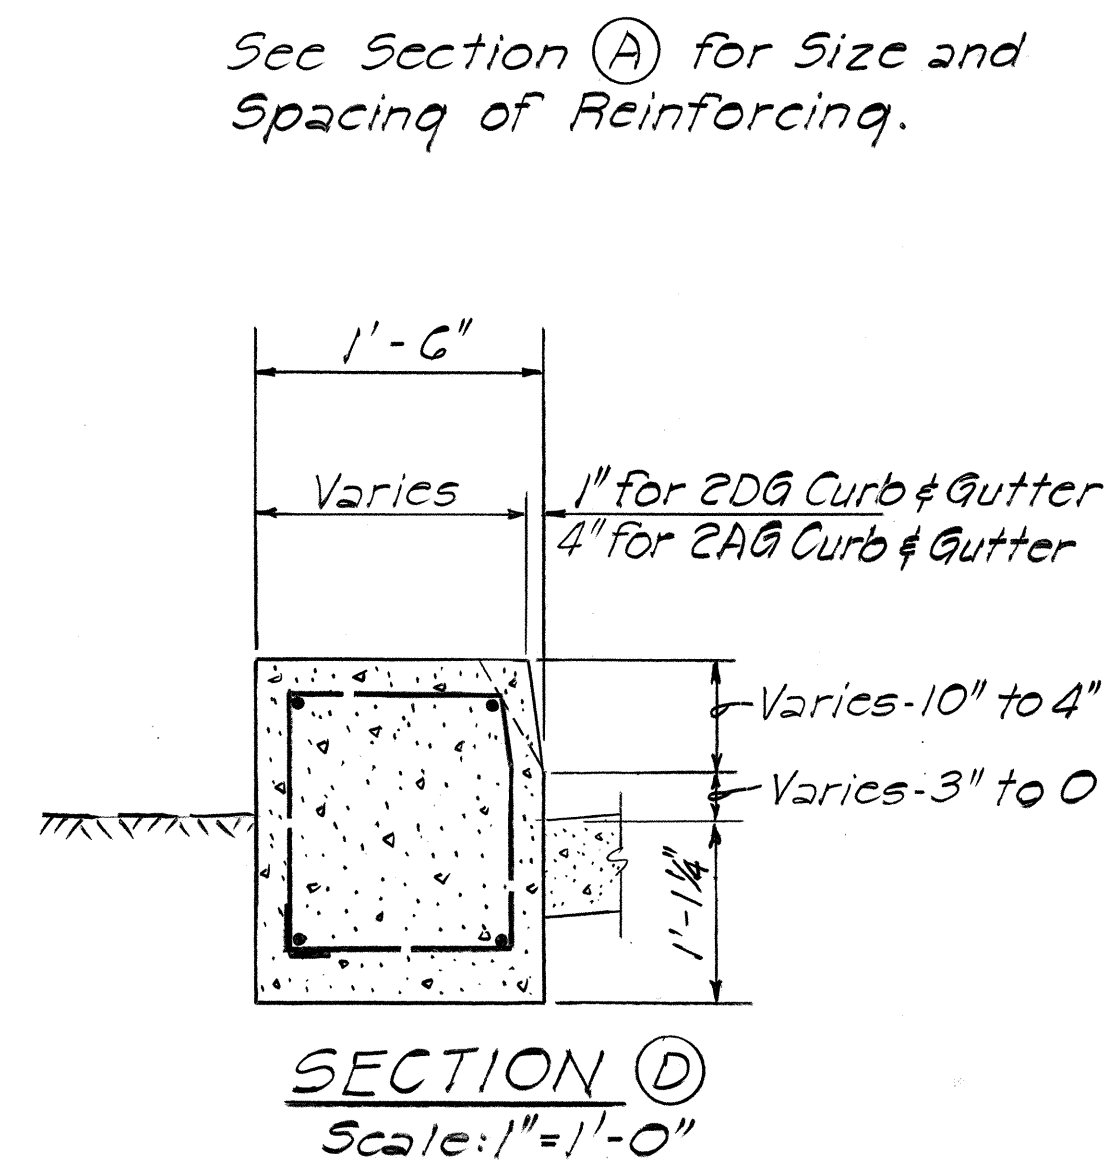
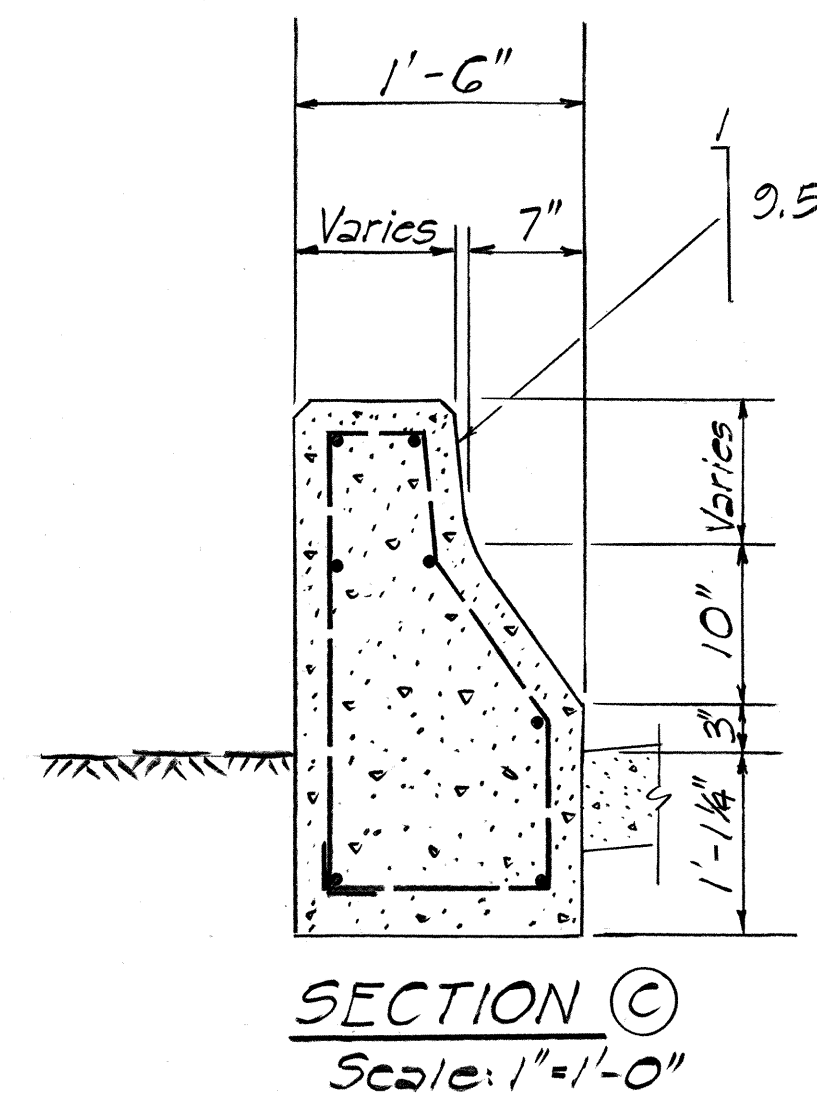


FED. ROAD DIST. NO.	STATE	FED. AID PROJ. NO.	FISCAL YEAR	SHEET NO.	TOTAL SHEETS
HAWAII	HAW.	F-063-1(17)	1984	74	156

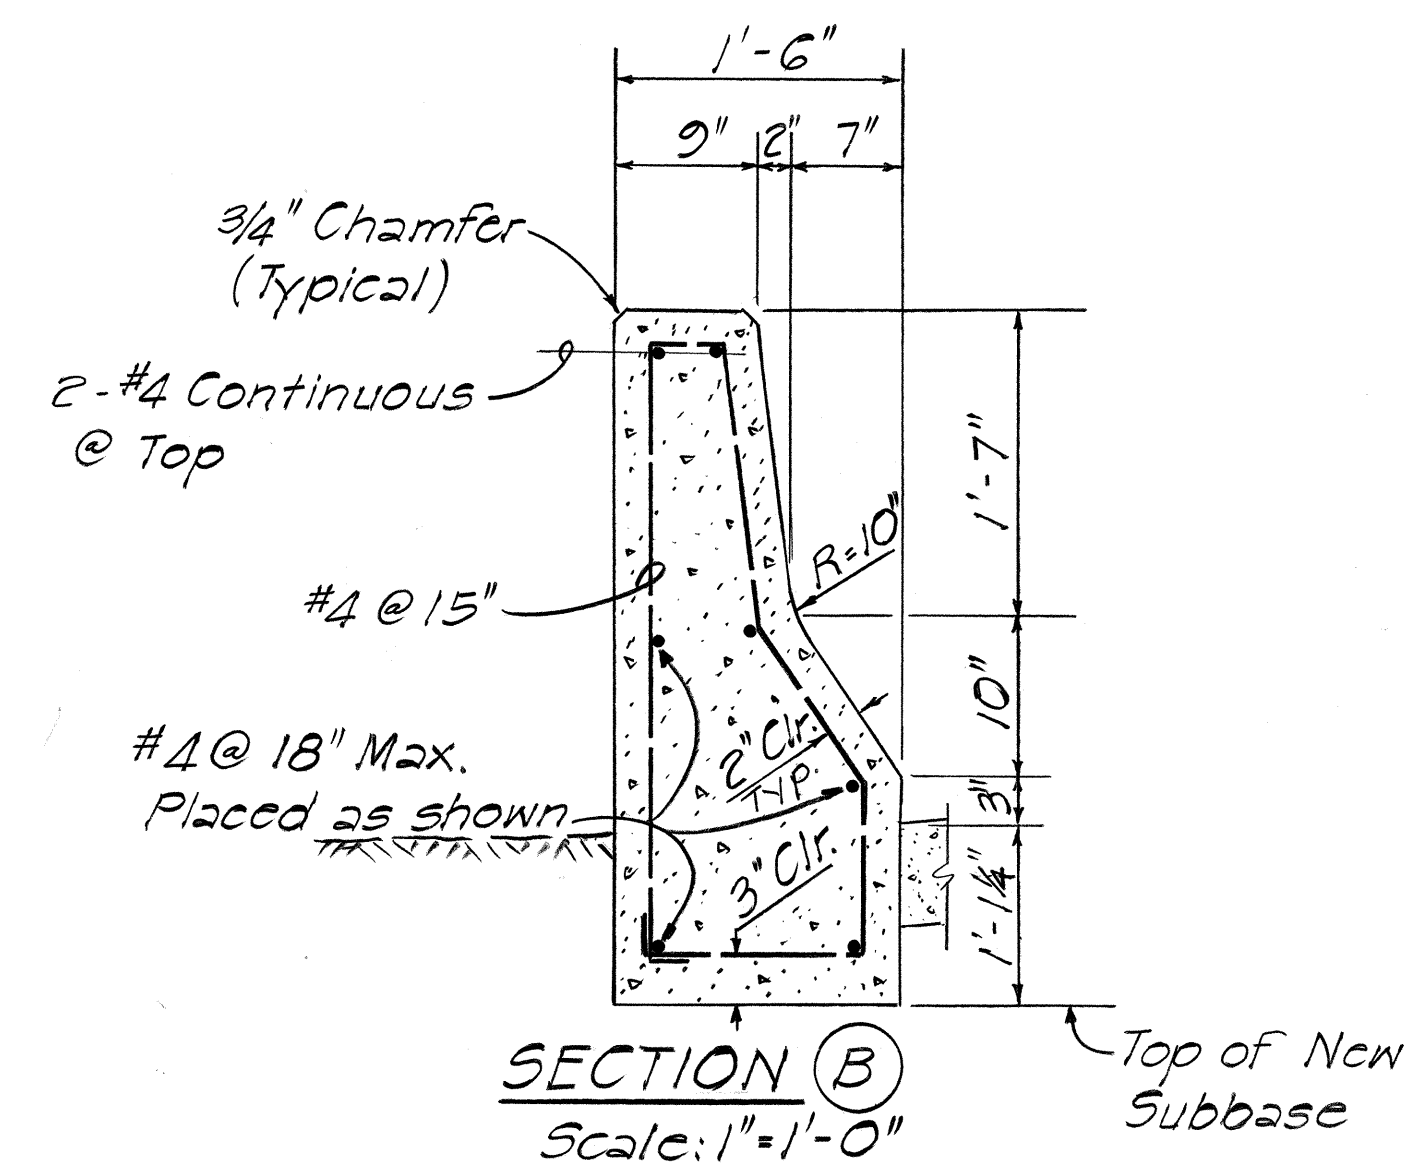

THIS WORK WAS PREPARED BY
ME OR UNDER MY SUPERVISION.
M. Hirozaki
Signature

STATE OF HAWAII
DEPARTMENT OF TRANSPORTATION
LAND TRANSPORTATION FACILITIES DIVISION
**GUARD RAIL TYPE 4,
CONCRETE RIGID BARRIER
TRANSITION DETAILS**
LIKELIKE HIGHWAY IMPROVEMENTS
KAM IV ROAD TO VICINITY OF KALIHU STREET
FA PROJ. NO. F-063-1(17) Scale as shown
SHEET No. 1 OF 1 SHEETS