	INDEX TO DRAWINGS
SHEET NO.	DESCRIPTION
2	TITLE SHEET
3	CONSTRUCTION NOTES
4-5	TYPICAL SECTIONS
6-8	PLAN AND PROFILE
9-14	DETAIL PLAN OF ROADWAY
15 - 26	ROADWAY AND DRAINAGE DETAILS
27	UTILITY PLAN-SEWER AND WATER
28-32	UTILITY DETAILS
33	TRAFFIC CONTROL PLAN
34-36	CONSTRUCTION PHASING PLAN
37-38	PAVEMENT STRIPING AND TRAFFIC SIGNING PLAN
39-47	LIGHTING AND TRAFFIC SIGNAL PLAN AND DETAILS
48-50	CROSS-SECTIONS
and a supplied of the supplined of the supplied of the supplied of the supplied of the suppli	
entrant to the second	-
a construction of the cons	



STATE OF HAWAII



TRANSPORTATION DEPARTMENT

HIGHWAYS DIVISION


HONOLULU, HAWAII

PLANS FOR


LIKELIKE HIGHWAY IMPROVEMENTS

VICINITY OF KULA KOLEA DRIVE TO KAM IV ROAD PROJECT NO. F - 063 - 1(16)

> DISTRICT OF HONOLULU ISLAND OF OAHU

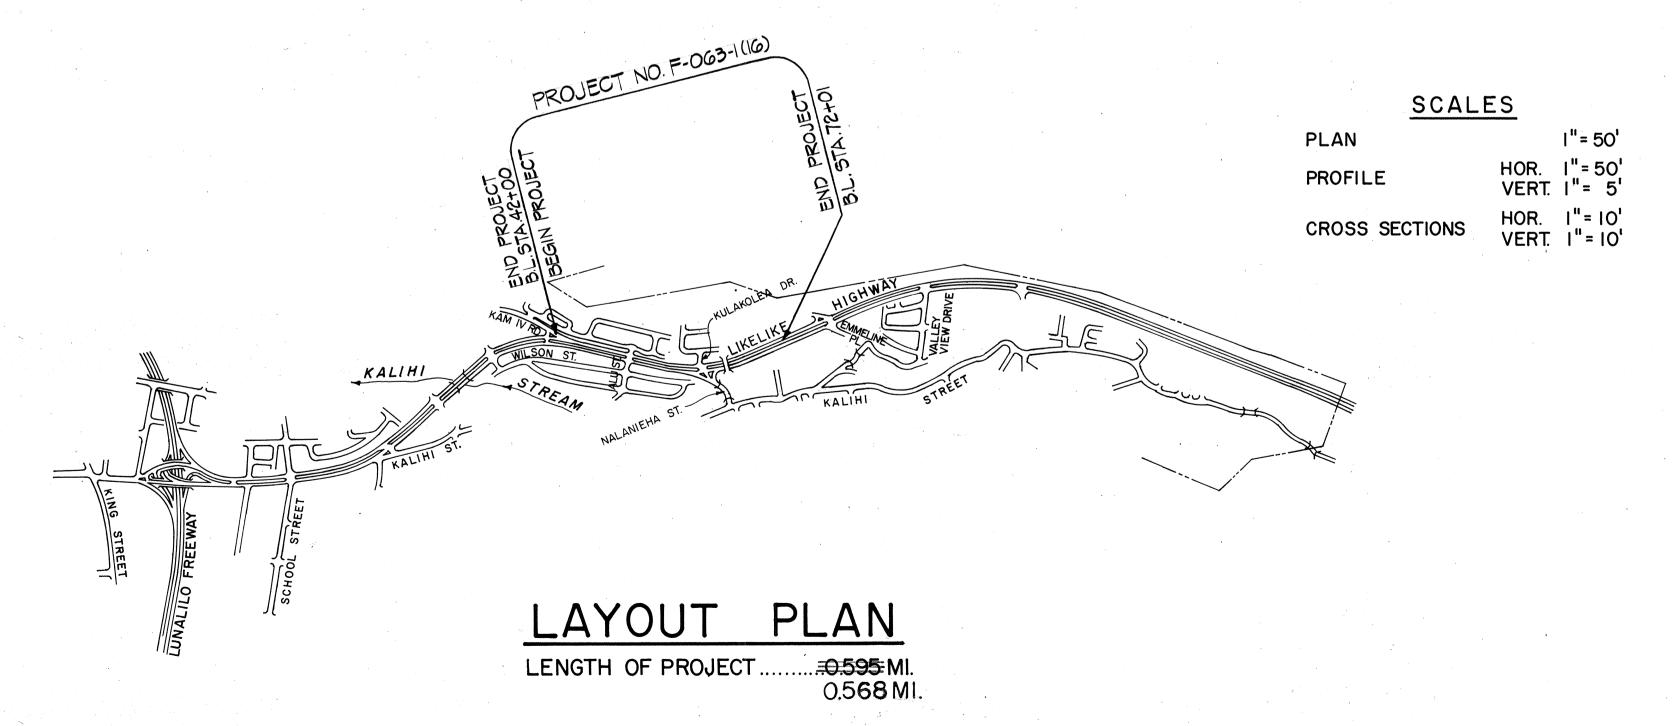

SCALE IN MILES

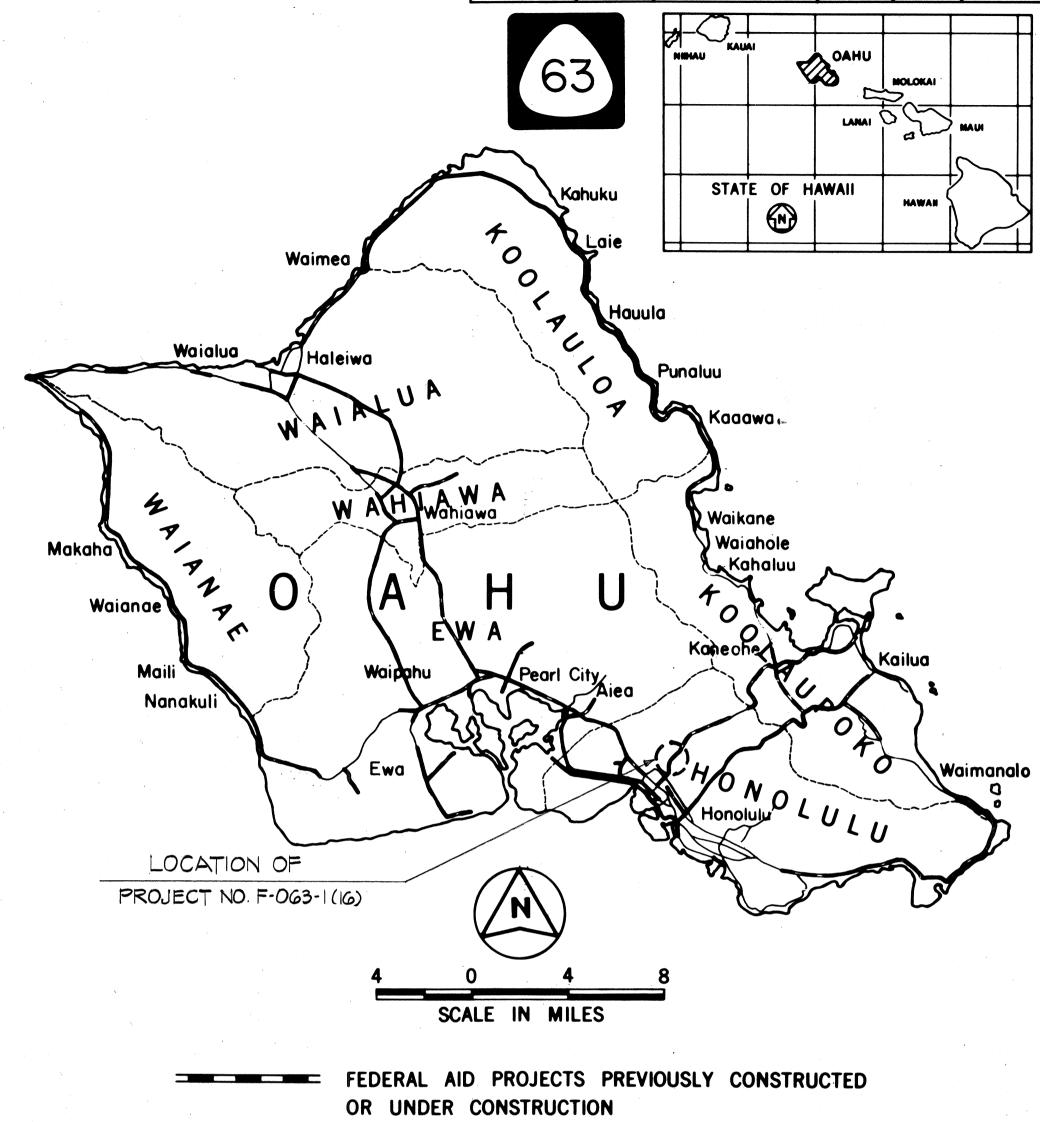

FED. ROAD DIST. NO.

FED. AID PROJ. NO.

F-063-1(16)