



| FED. ROAD DIST. NO. | STATE | PROJ. NO.               | FISCAL YEAR | SHEET NO. | TOTAL SHEETS |
|---------------------|-------|-------------------------|-------------|-----------|--------------|
| HAWAII              | HAW.  | 63A-01-86M<br>63A-02-86 | 1986        | 53        | 58           |

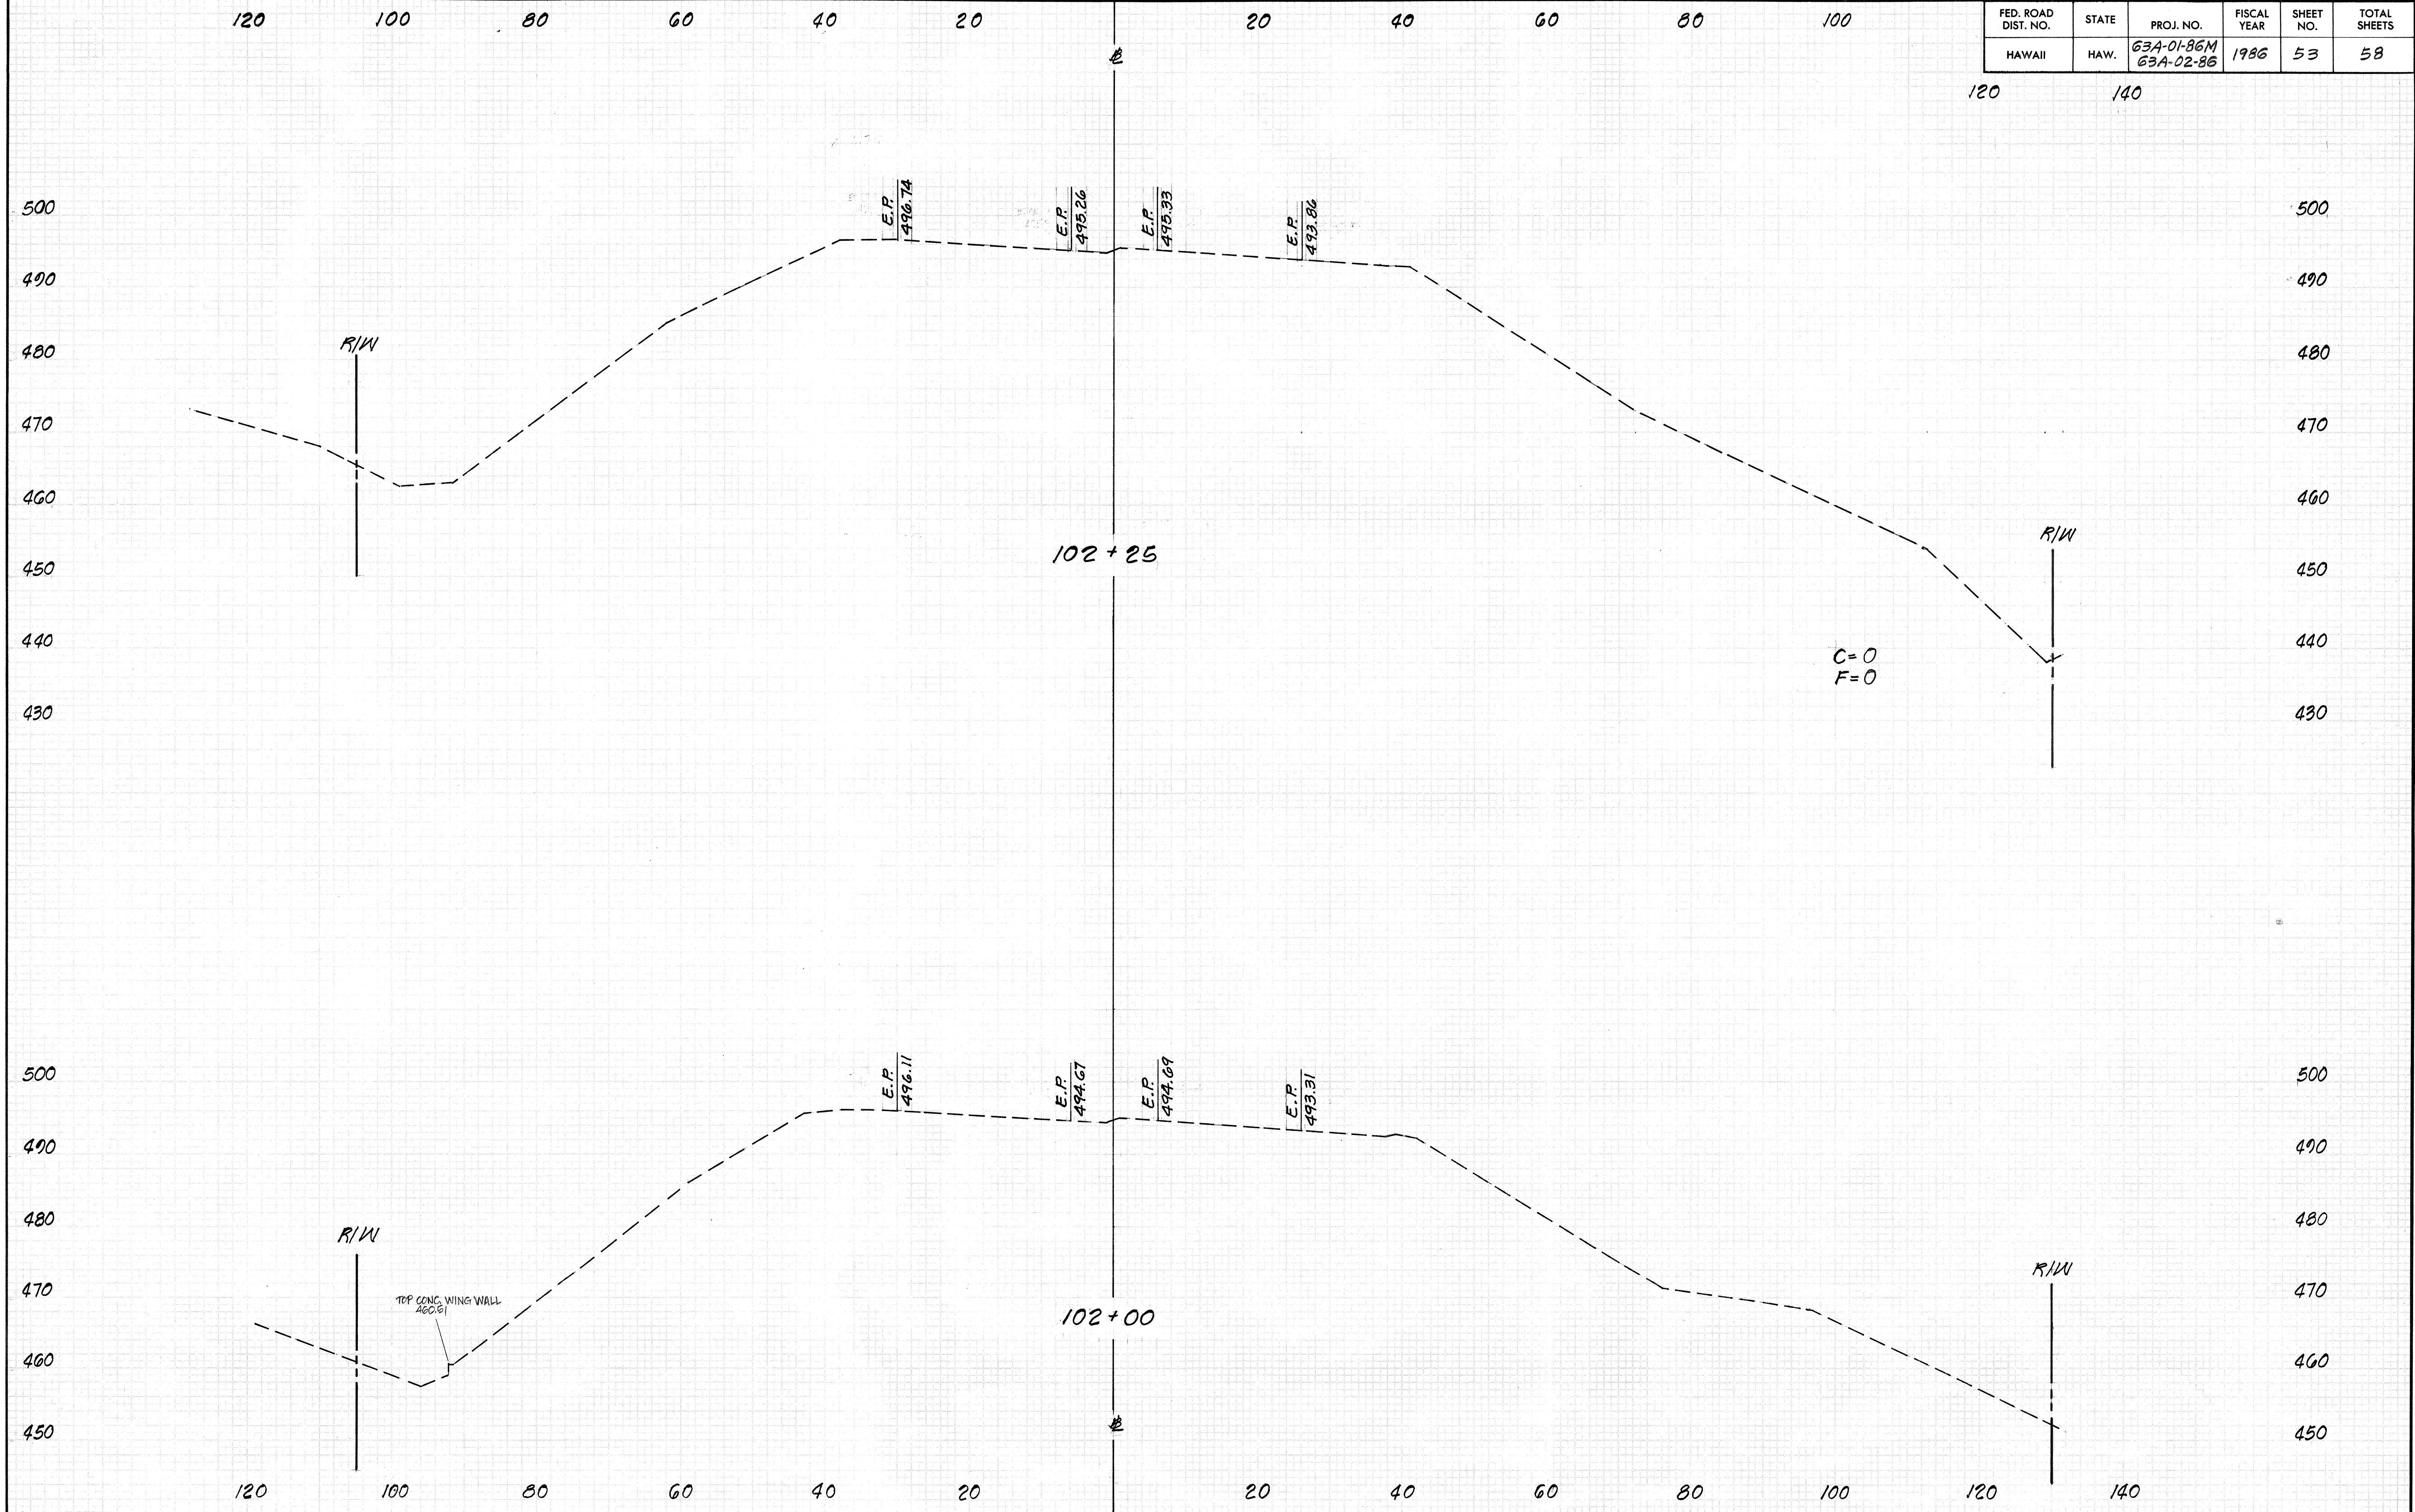


| FED. ROAD DIST. NO. | STATE | PROJ. NO.               | FISCAL YEAR | SHEET NO. | TOTAL SHEETS |
|---------------------|-------|-------------------------|-------------|-----------|--------------|
| HAWAII              | HAW.  | 63A-01-86M<br>63A-02-86 | 1986        | 54        | 58           |

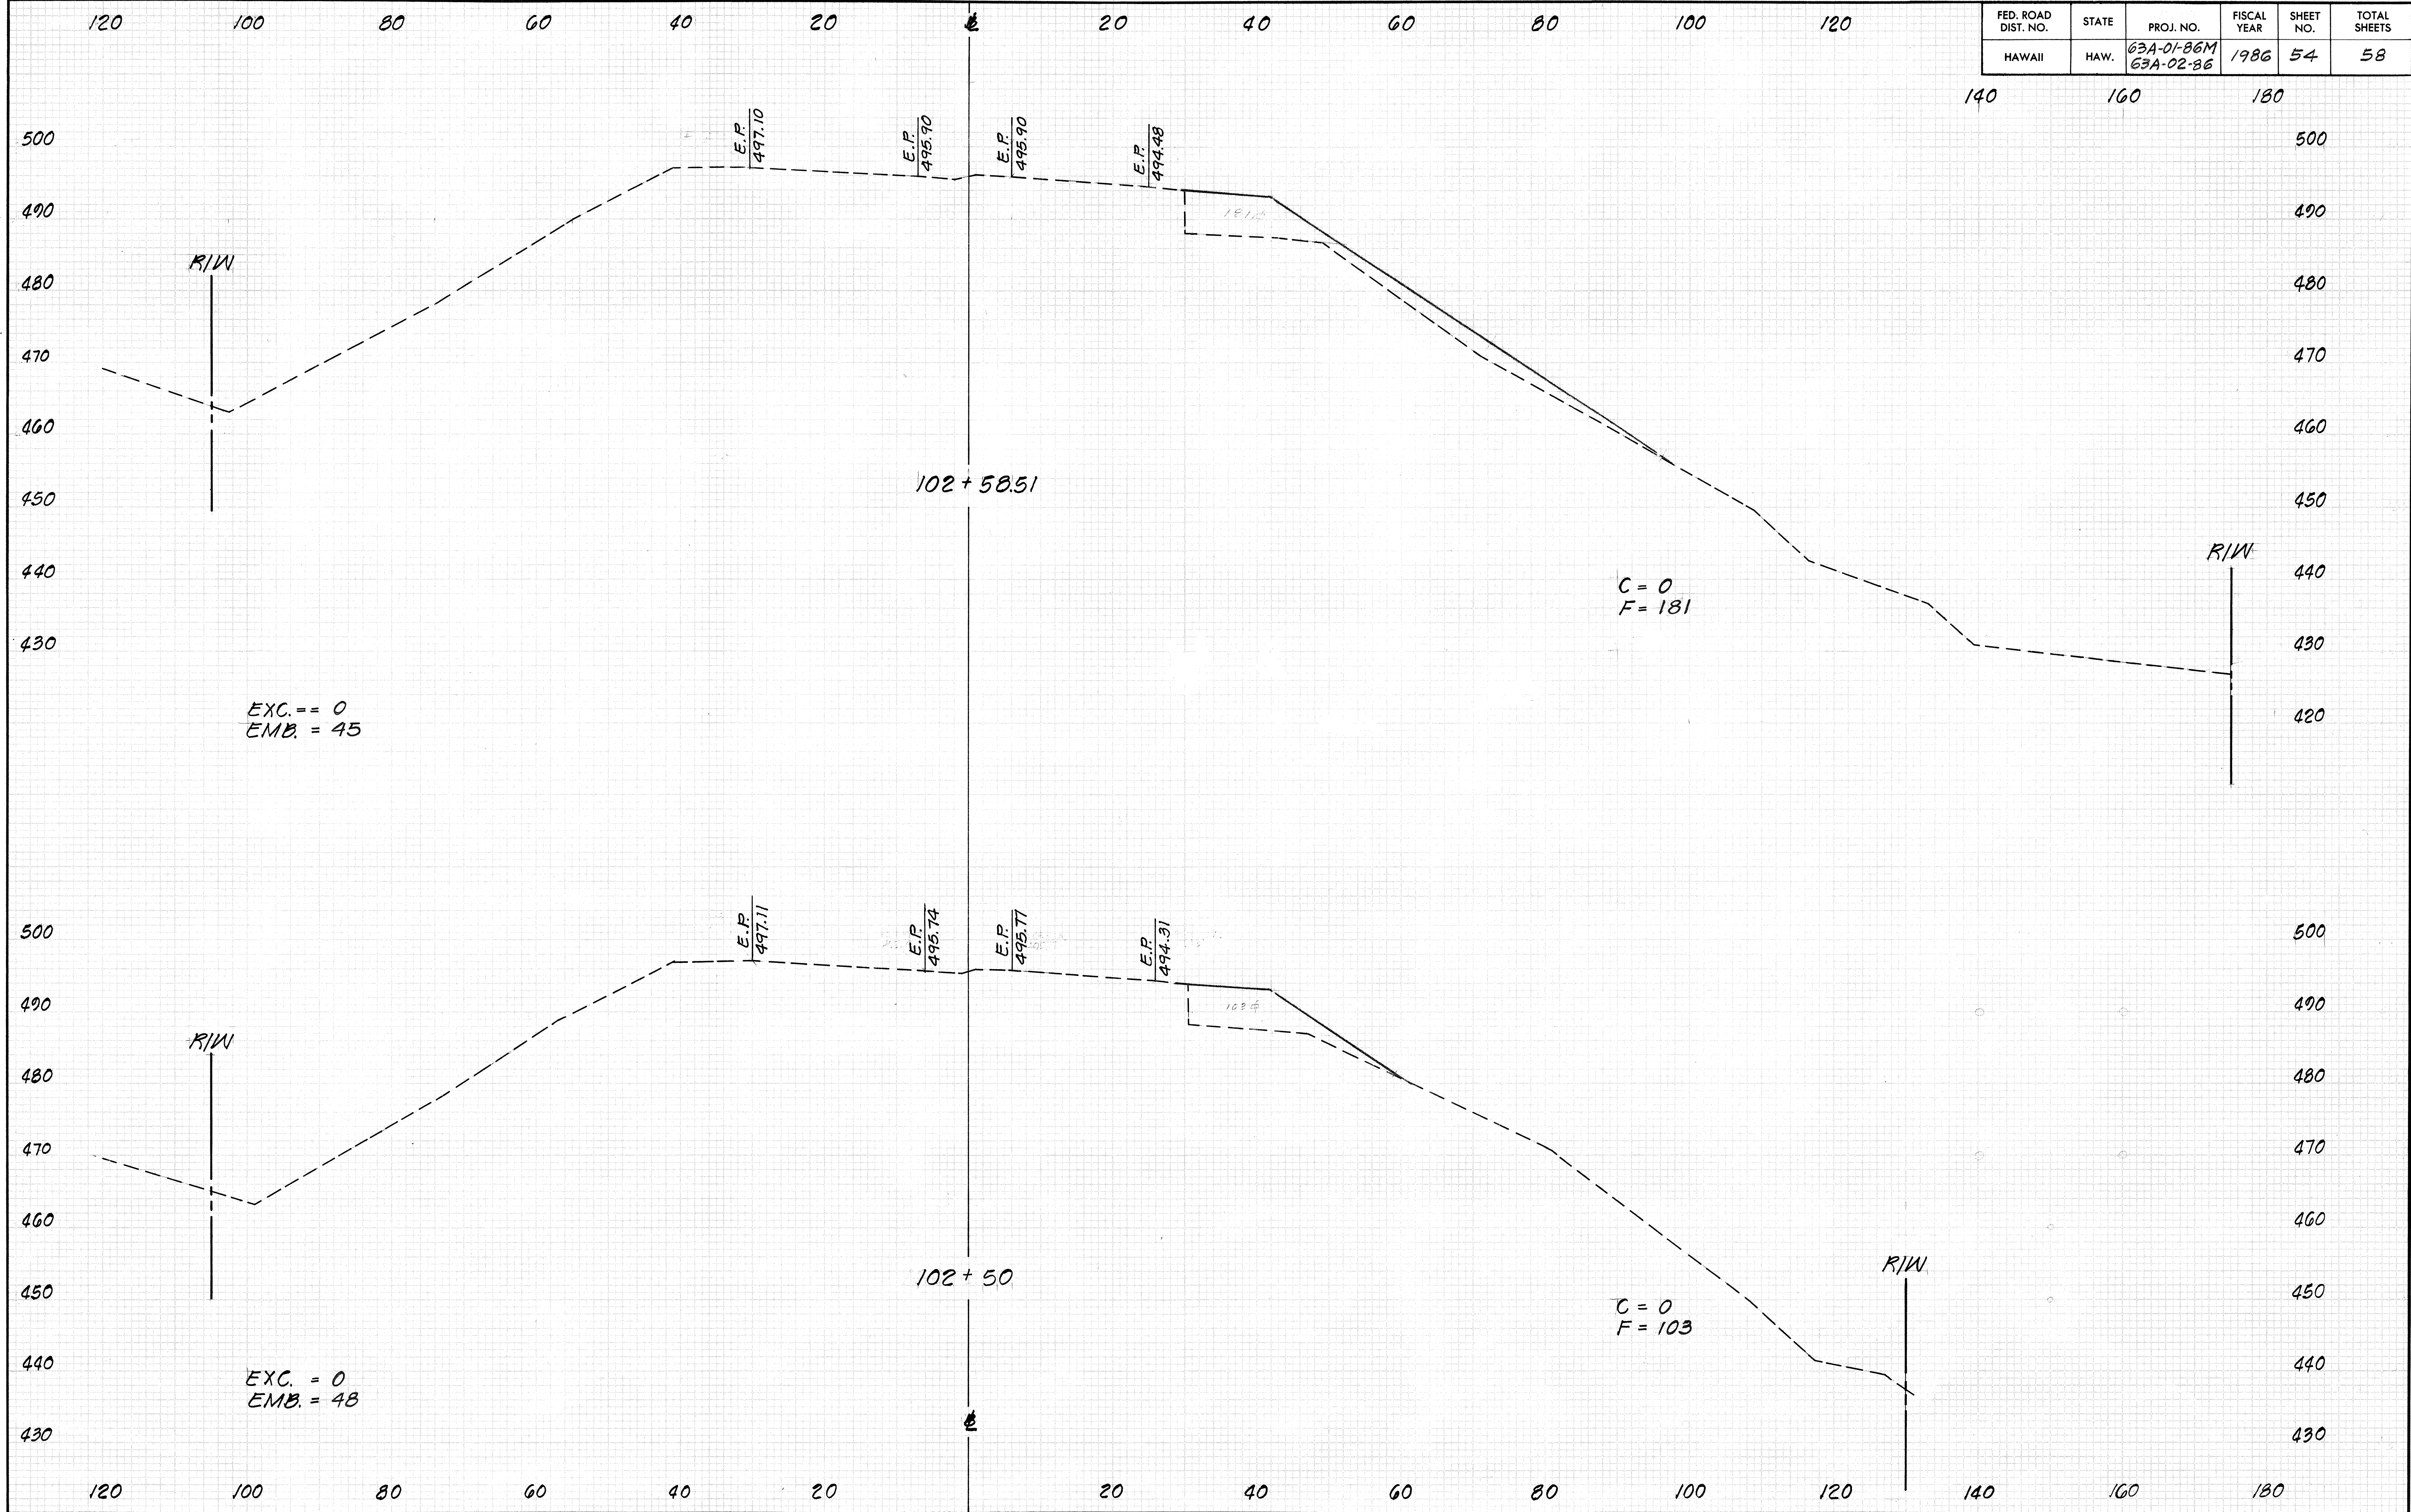


|              |              |
|--------------|--------------|
| DATE         | BY           |
| FINAL SURVEY | ENGINEER     |
| NOTE BOOK    | PLOTTED      |
| NO.          | AREA CHECKED |

|                 |              |
|-----------------|--------------|
| DATE            | BY           |
| ORIGINAL SURVEY | ENGINEER     |
| NOTE BOOK       | PLOTTED      |
| NO.             | AREA CHECKED |


| FED. ROAD DIST. NO. | STATE | PROJ. NO.               | FISCAL YEAR | SHEET NO. | TOTAL SHEETS |
|---------------------|-------|-------------------------|-------------|-----------|--------------|
| HAWAII              | HAW.  | 63A-01-86M<br>63A-02-86 | 1986        | 55        | 58           |

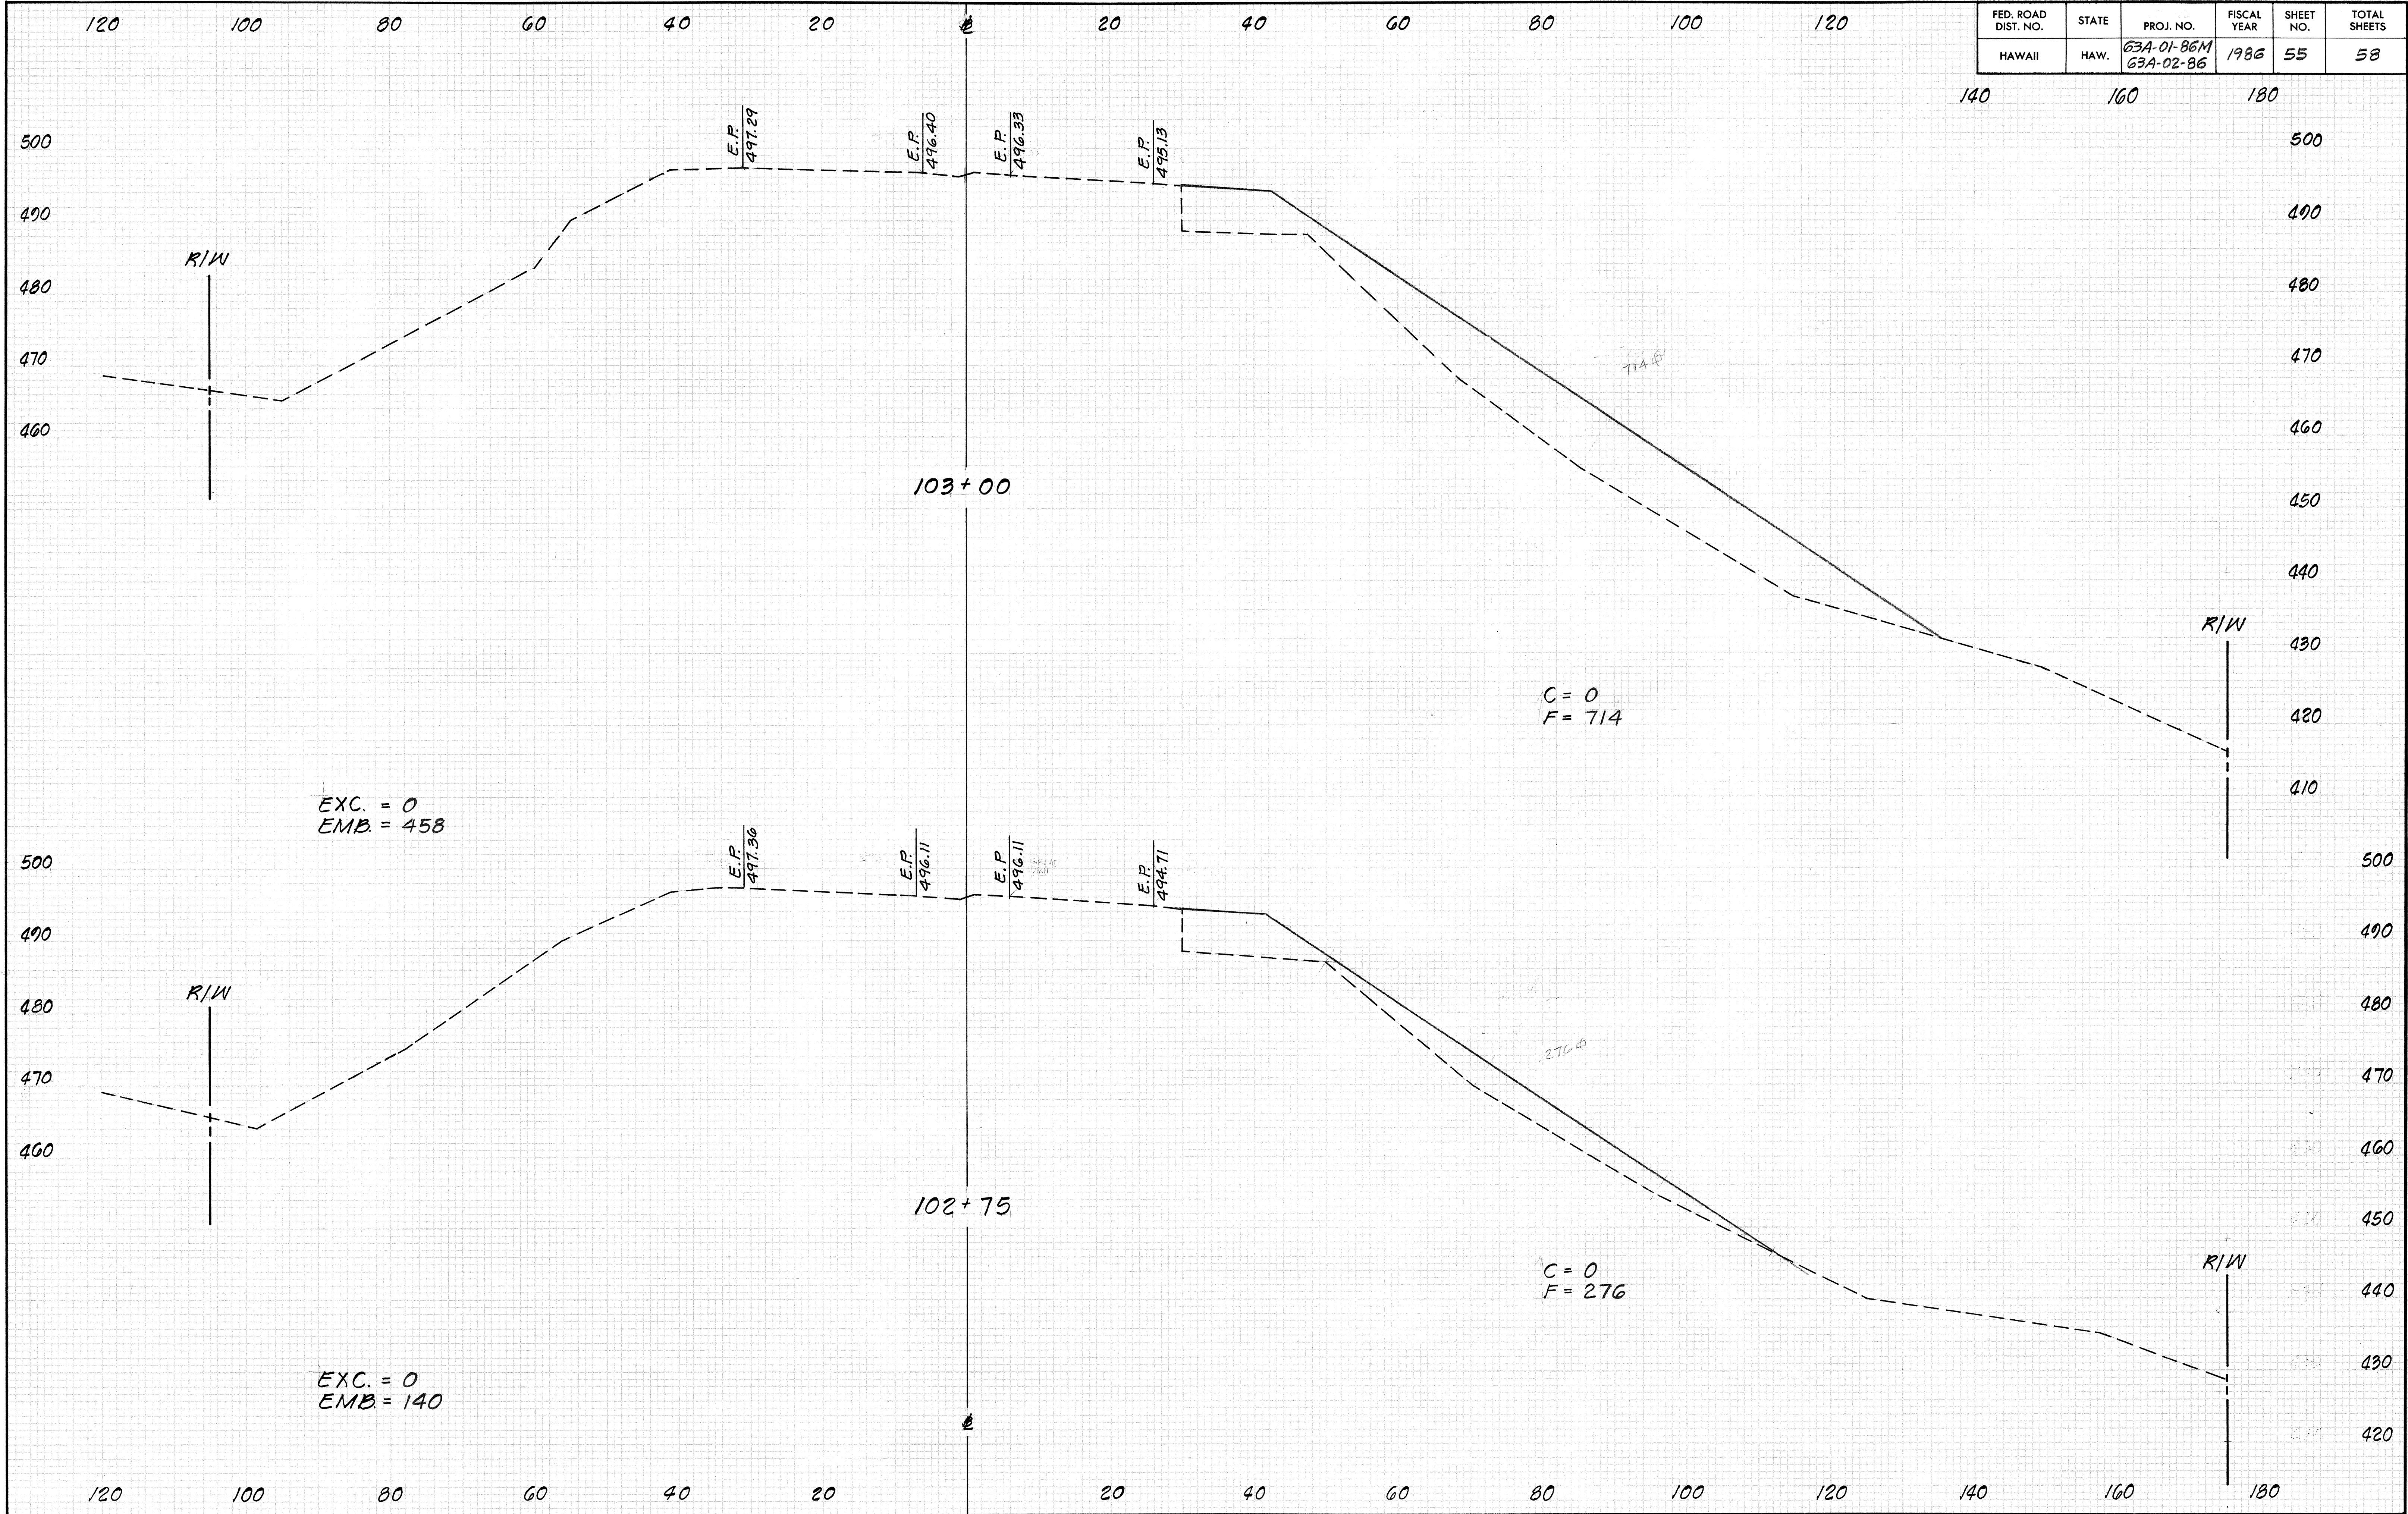

| FED. ROAD<br>DIST. NO. | STATE | PROJ. NO.               | FISCAL<br>YEAR | SHEET<br>NO. | TOTAL<br>SHEETS |
|------------------------|-------|-------------------------|----------------|--------------|-----------------|
| HAWAII                 | HAW.  | 63A-01-86M<br>63A-02-86 | 1986           | 56           | 58              |

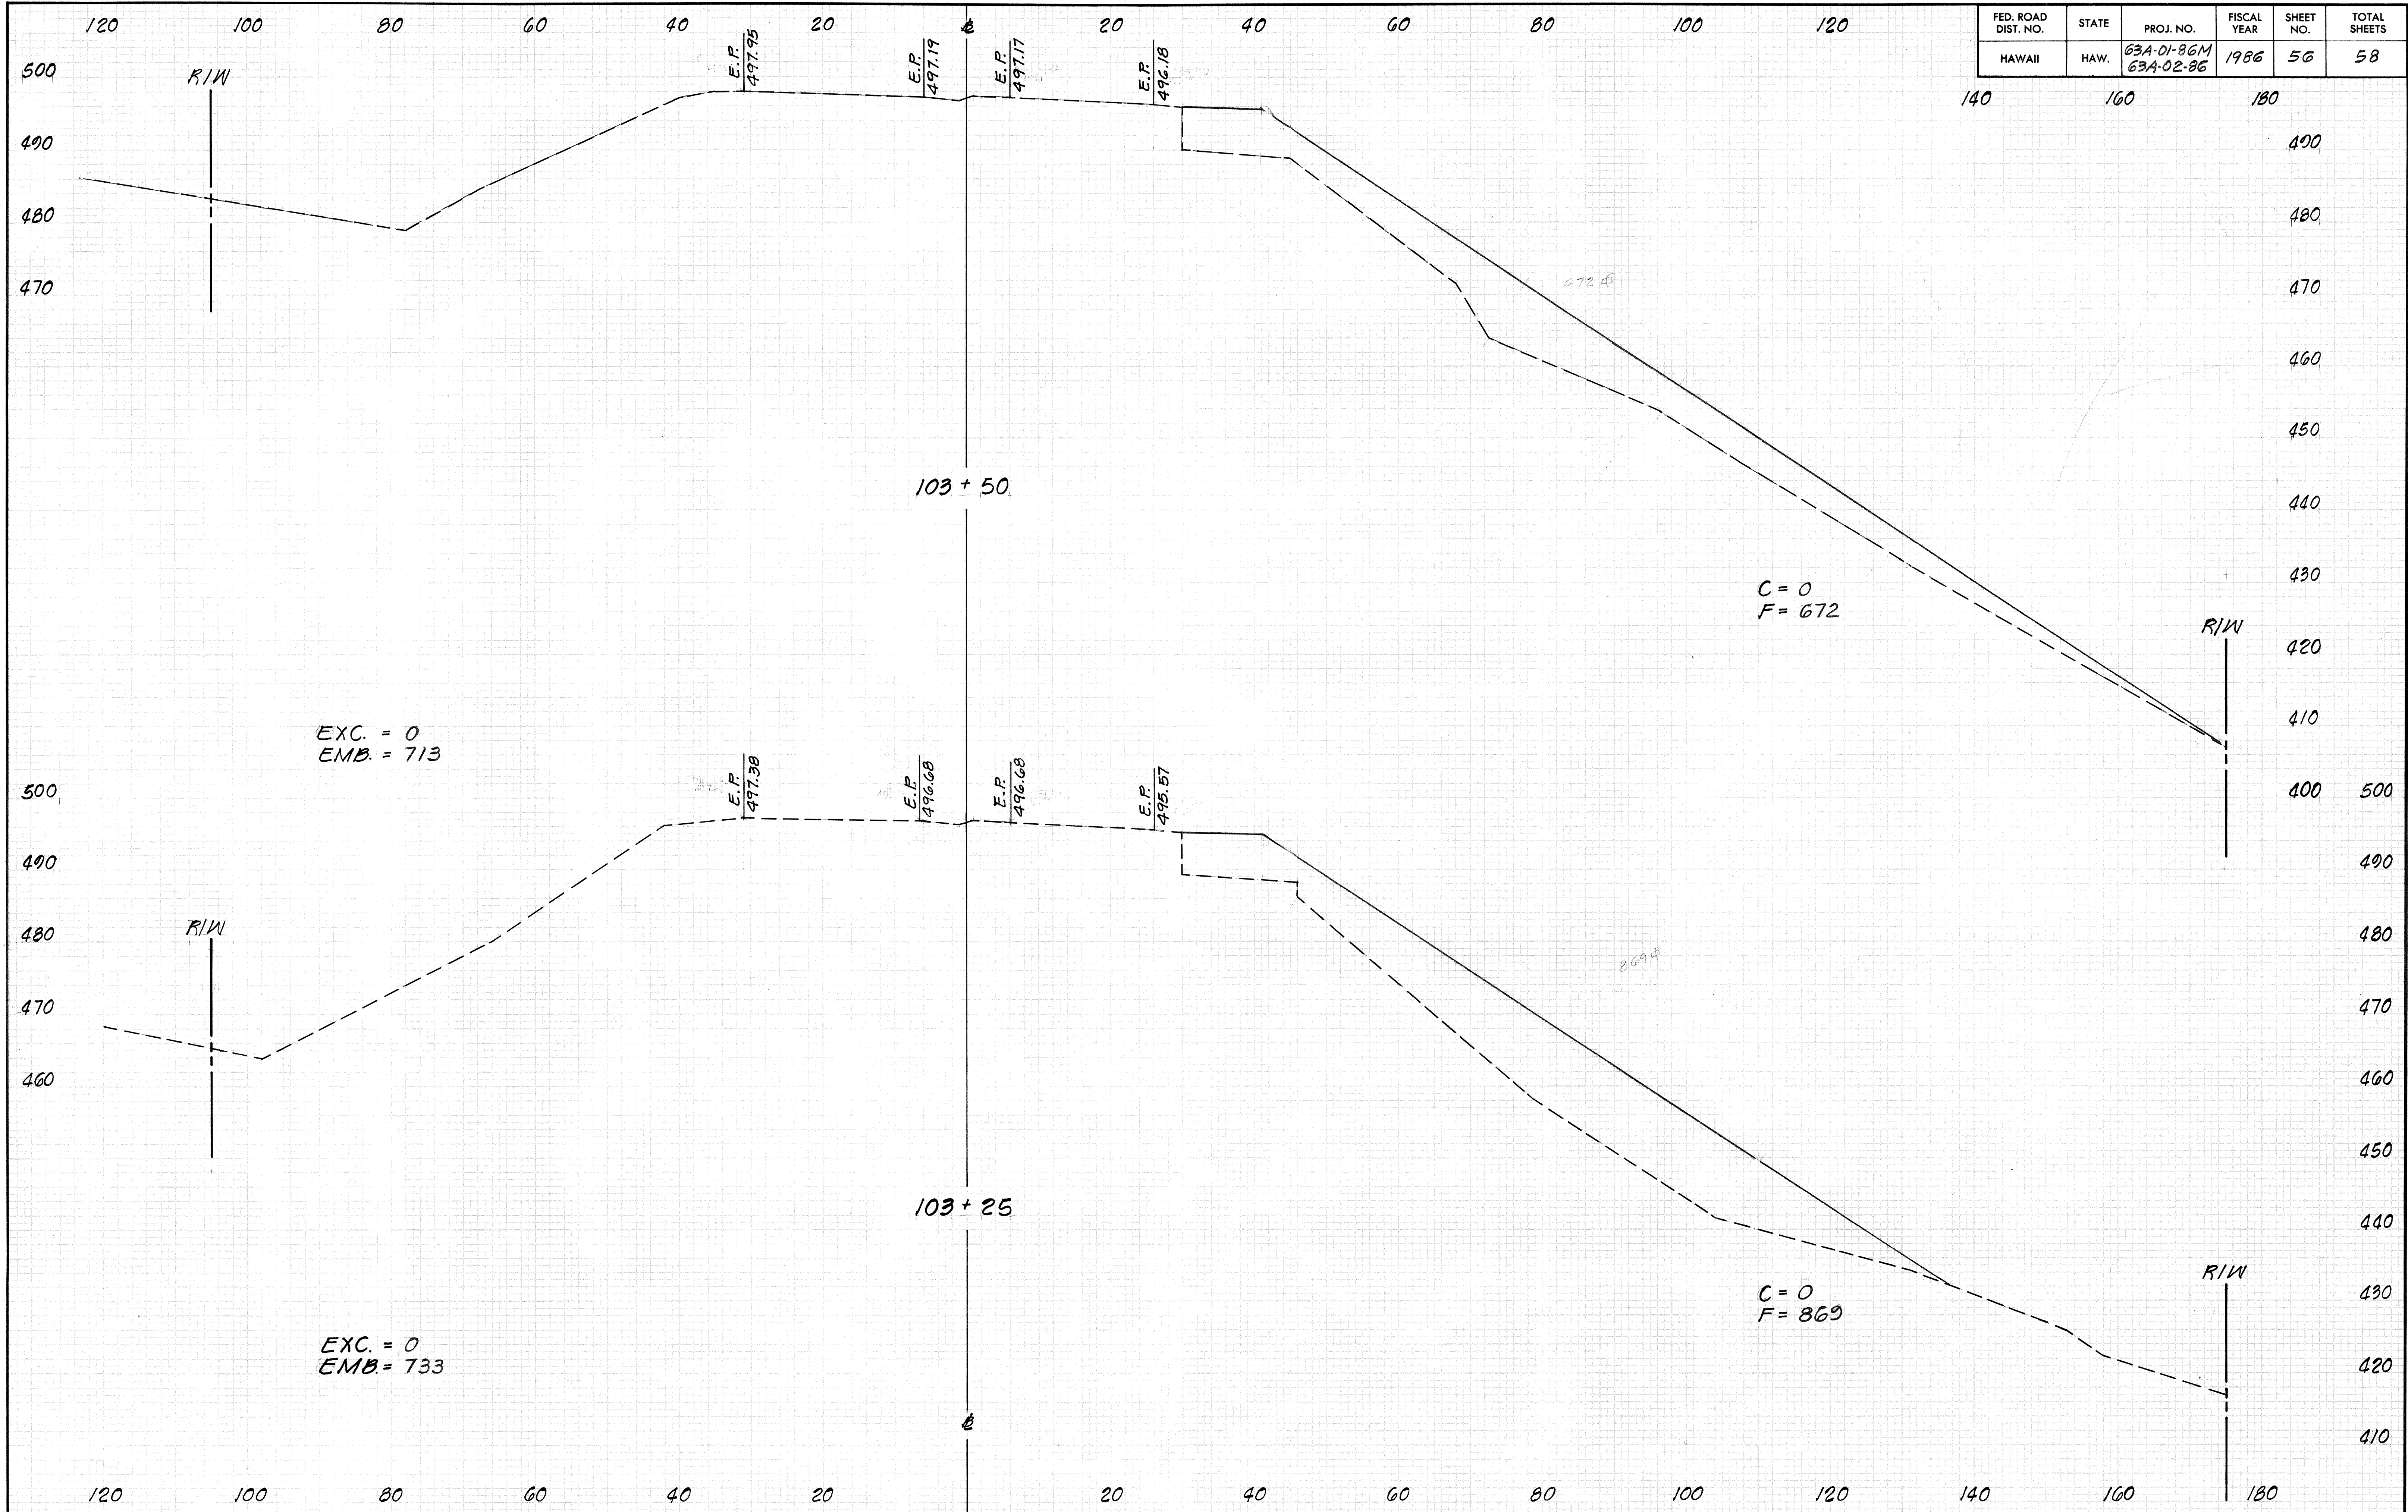

| FED. ROAD DIST. NO. | STATE | PROJ. NO.               | FISCAL YEAR | SHEET NO. | TOTAL SHEETS |
|---------------------|-------|-------------------------|-------------|-----------|--------------|
| HAWAII              | HAW.  | 63A-01-86M<br>63A-02-86 | 1986        | 57        | 58           |

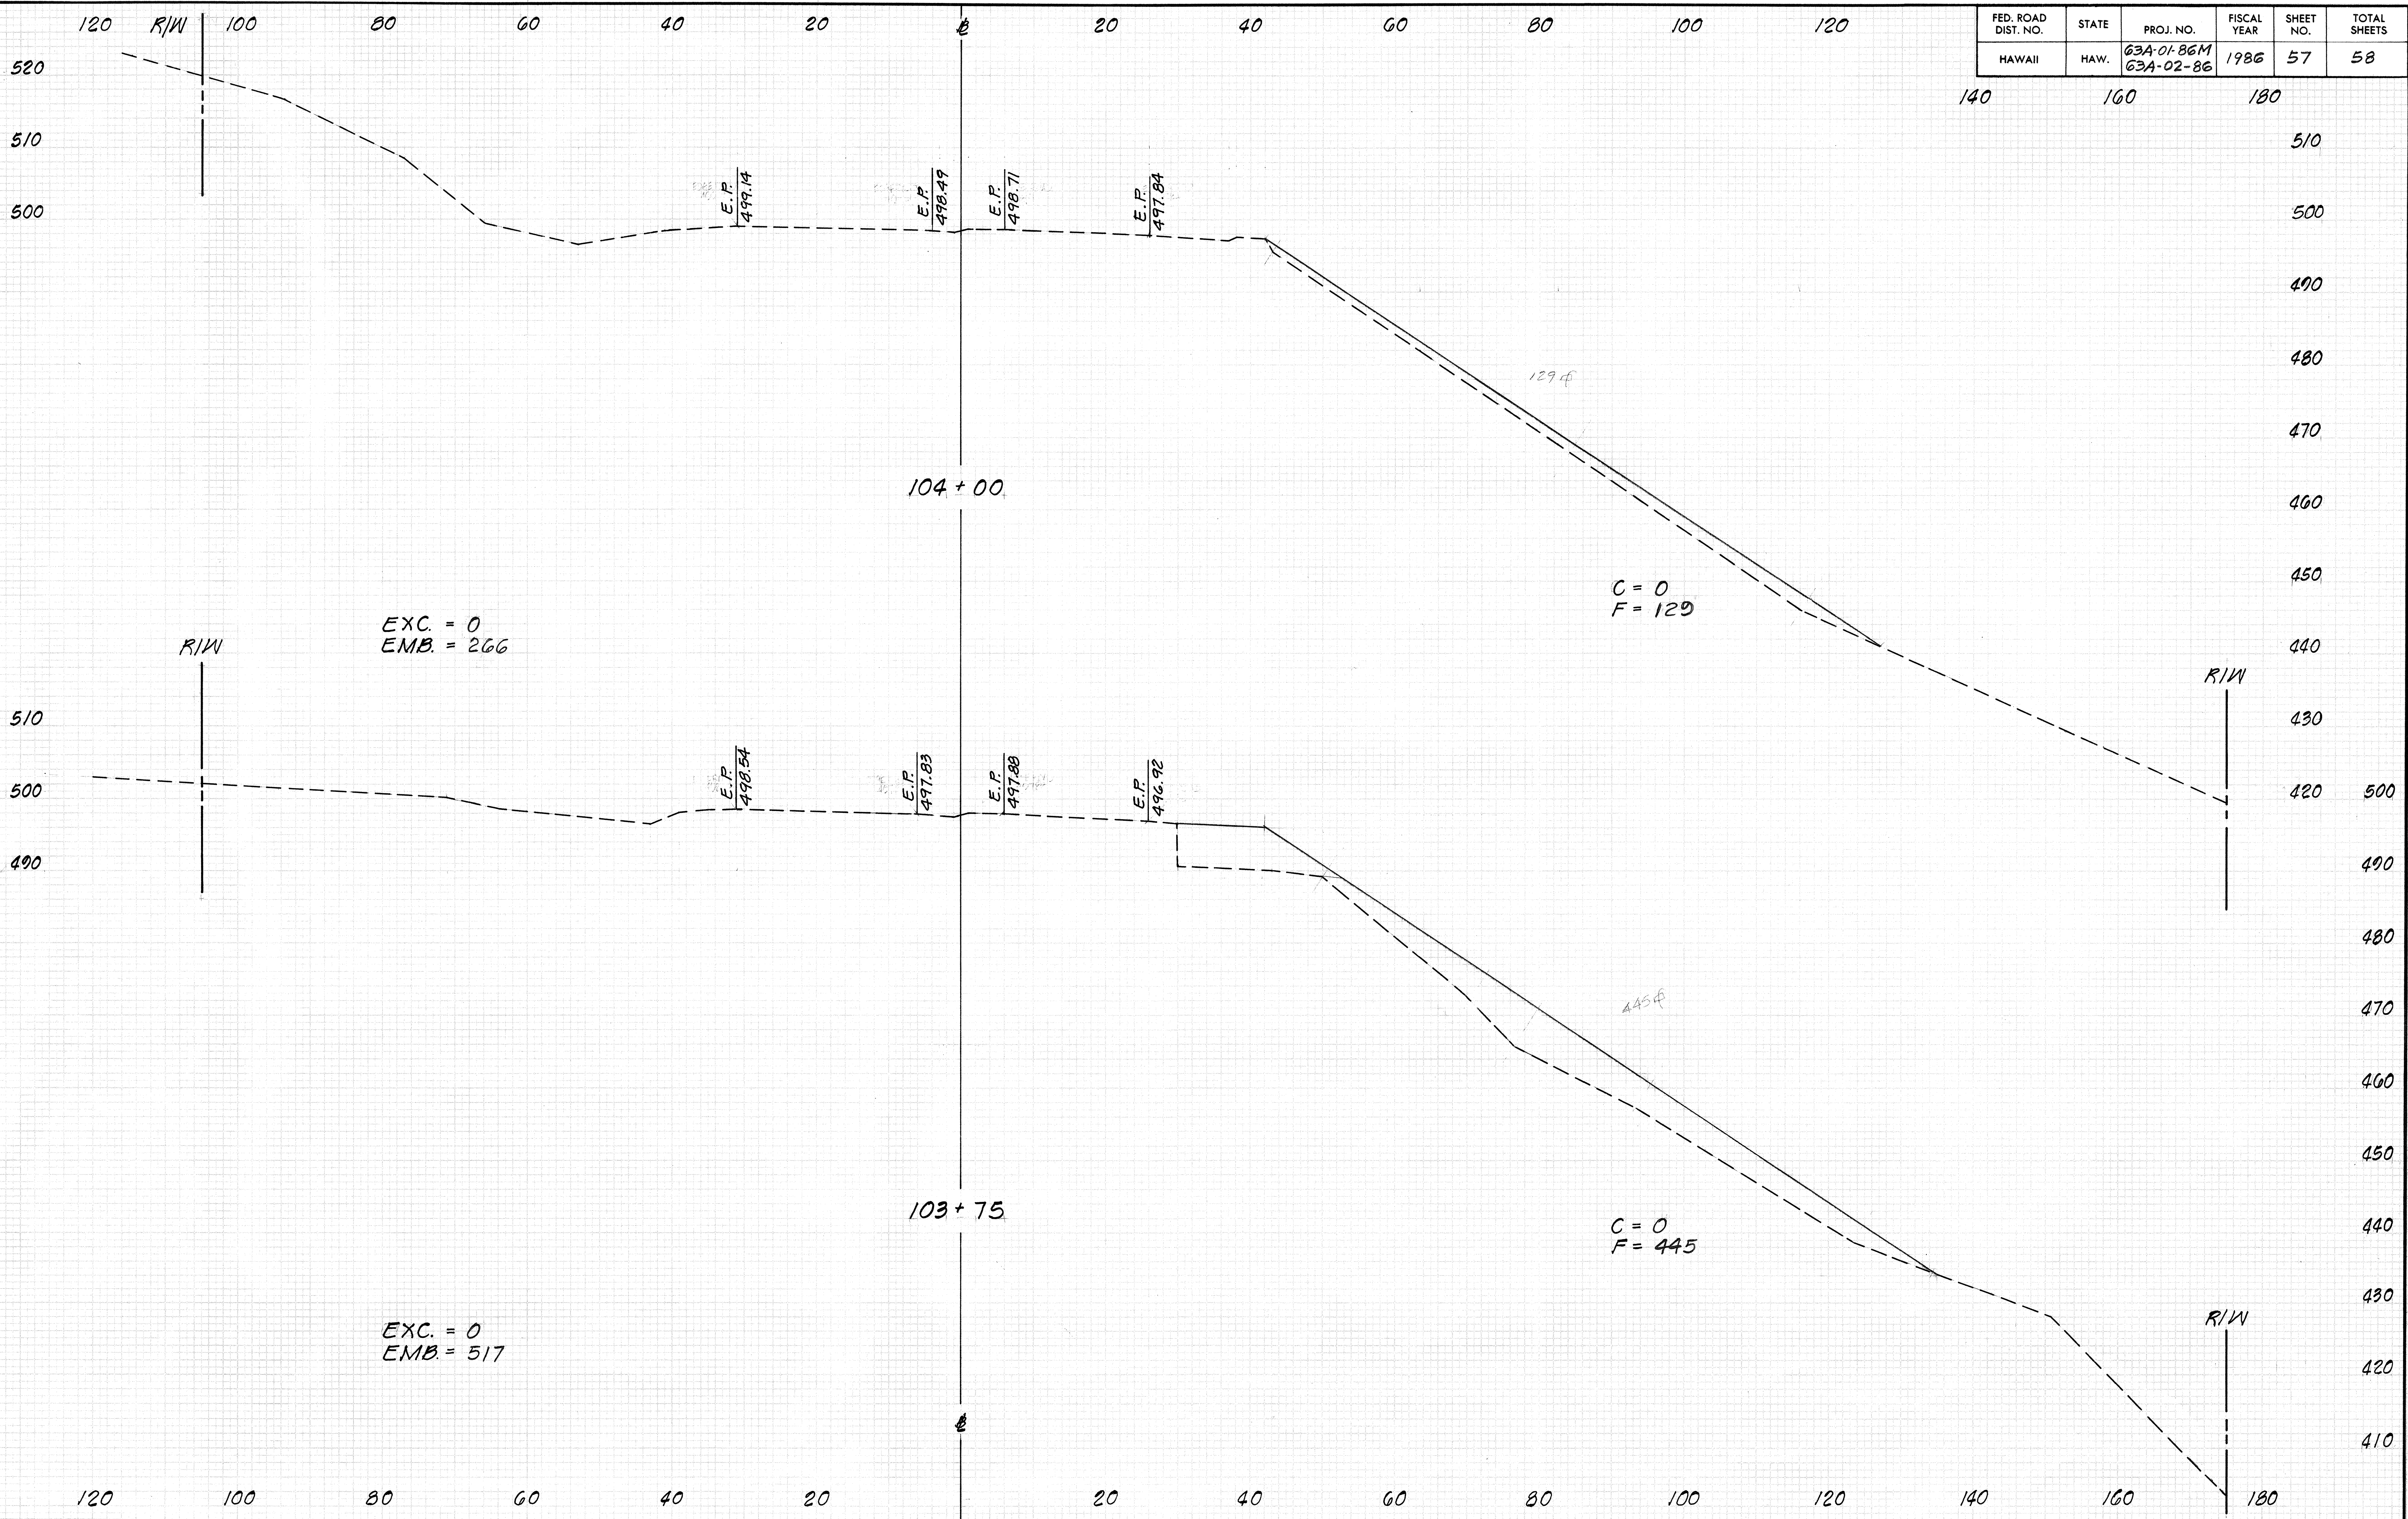

| FED. ROAD DIST. NO. | STATE | PROJ. NO.               | FISCAL YEAR | SHEET NO. | TOTAL SHEETS |
|---------------------|-------|-------------------------|-------------|-----------|--------------|
| HAWAII              | HAW.  | 63A-01-86M<br>63A-02-86 | 1986        | 58        | 58           |

