



FED. ROAD DIST. NO.	STATE	PROJ. NO.	FISCAL YEAR	SHEET NO.	TOTAL SHEETS
HAWAII	HAW.	63A-03-86	1987	5	7

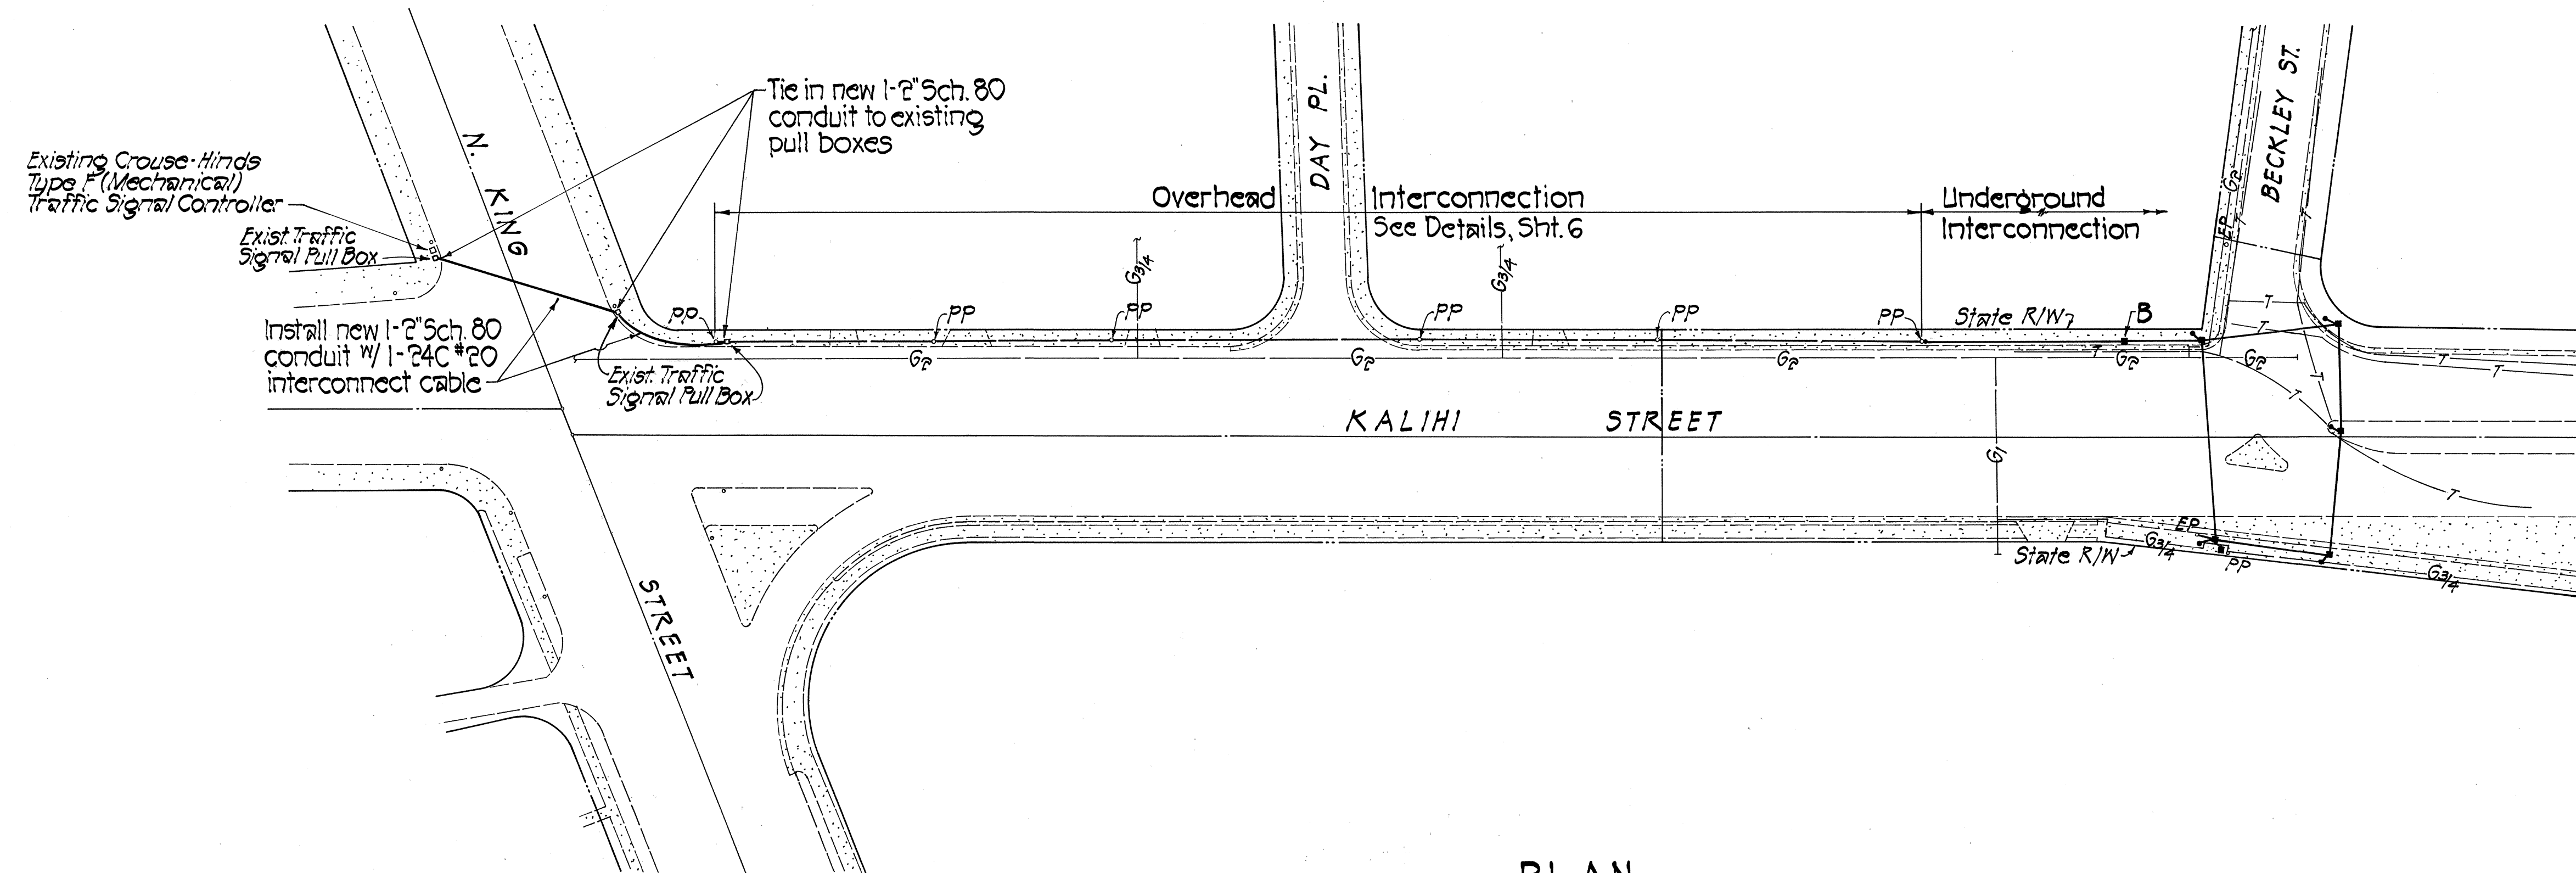

PLAN
Scale: 1"=40'

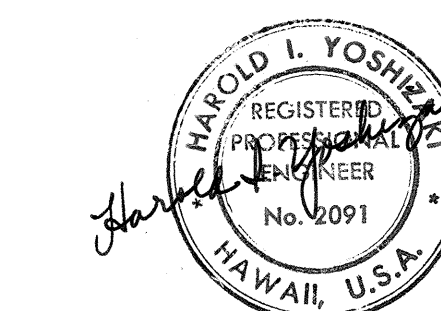

STATE OF HAWAII
DEPARTMENT OF TRANSPORTATION
HIGHWAYS DIVISION

TRAFFIC SIGNALS ON
KALIHl STREET AT BECKLEY STREET
TO N. KING ST./KALIHl ST.
INTERSECTION

PROJECT NO. 63A-03-86
SCALE: 1"=40' June 1986

SHEET NO. 5 OF 7 SHEETS

ORIGINAL PLAN	SURVEY PLOTTED BY	DATE
NOTE BOOK	DRAWN BY	" "
No.	DESIGNED BY	" "
	QUANTITIES BY	" "
	CHECKED BY	" "