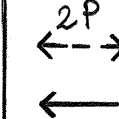
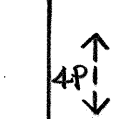
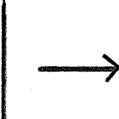


FED. ROAD DIST. NO.	STATE	PROJ. NO.	FISCAL YEAR	SHEET NO.	TOTAL SHEETS
HAWAII	HAW.	63A-03-86	1987	4	7

		R	R	R
DON'T WALK	WALK	Y	Y	Y
A-1	B-1	C-1	A-2	C-2
D-2	C-3	E-1	B-2 *	
E-3,4	D-1			
	E-2			


* Programmed Visibility Signal
SIGNAL INDICATIONS

			
1	2	3	4
			
5	6	7	8

PHASE DIAGRAM

WORK TO BE DONE BY OTHERS

Conduits 2, 5 & 11 for Kalihi street & conduit 4 for Beckley street will be installed by others

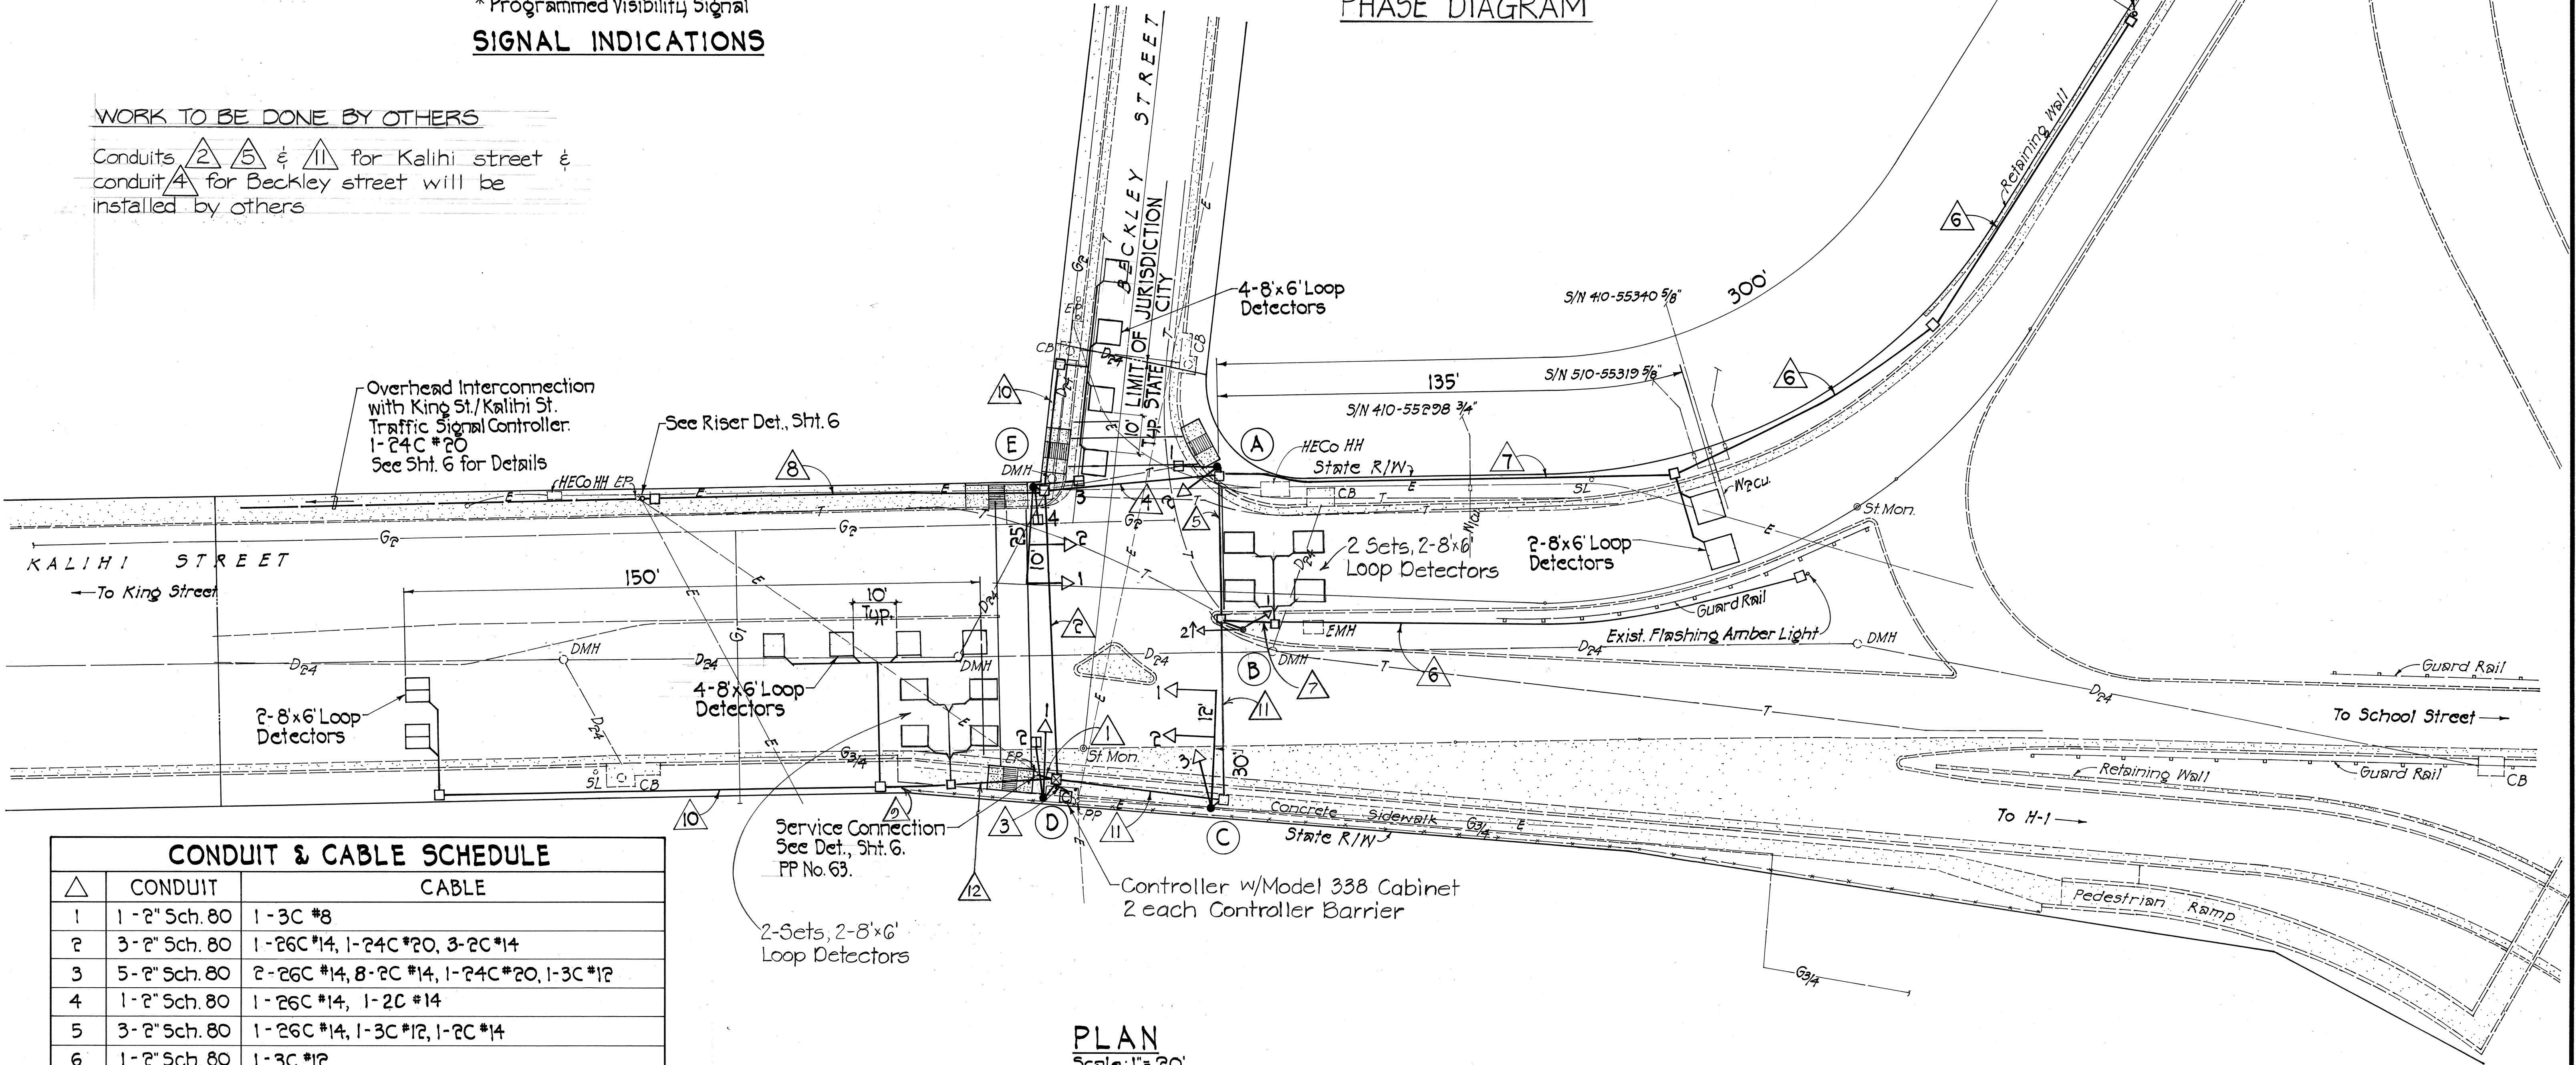


△	CONDUIT	CABLE
1	1-2" Sch. 80	1-3C #8
2	3-2" Sch. 80	1-26C #14, 1-24C #20, 3-2C #14
3	5-2" Sch. 80	2-26C #14, 8-2C #14, 1-24C #20, 1-3C #12
4	1-2" Sch. 80	1-26C #14, 1-2C #14
5	3-2" Sch. 80	1-26C #14, 1-3C #12, 1-2C #14
6	1-2" Sch. 80	1-3C #12
7	2-2" Sch. 80	1-3C #12, 1-2C #14
8	1-2" Sch. 80	1-24C #20
9	1-2" Sch. 80	2-2C #14
10	1-2" Sch. 80	1-2C #14
11	3-2" Sch. 80	1-26C #14, 1-3C #12, 2-2C #14
12	1-2" Sch. 80	3-2C #14

PLAN
Scale: 1"=20'
TMK: 1-3-05 & 1-6-21

APPROVED:

[Signature] 4/20/87
CHIEF, DIVISION OF ENGINEERING, DPW
(APPROVED FOR CONSTRUCTION W/IN CITY R/W ONLY)

[Signature] 3-11-82
for CHIEF, PLANNING & ENGINEERING, BWS
DATE

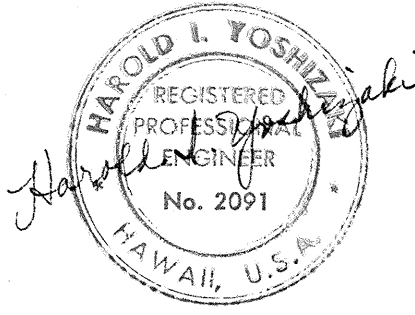

STATE OF HAWAII
DEPARTMENT OF TRANSPORTATION
HIGHWAYS DIVISION
TRAFFIC SIGNALS ON
KALIHI STREET AT BECKLEY STREET
PLAN-TRAFFIC SIGNAL SYSTEM
PROJECT NO. 63A-03-86
SCALE: 1"=20' June 1986
SHEET NO. 4 OF 7 SHEETS