	INDEX TO DRAWINGS
SHEET NO.	DESCRIPTION
	TITLE SHEET
2	STANDARD PLANS SUMMARY
3	GENERAL AND DRAINAGE NOTES
4-6	TYPICAL SECTIONS
7 - 9	TYPICAL DETAILS
10 - 23	PLANS ①-④
24 - 29	DRAINAGE DETAILS (5)
30 - 46	SIGNING AND PAVEMENT MARKING PLANS AND DETAILS
1000	
. ( )	

Plan Sht. Nos. © CO 23 S-1, CO 23 S-2, CO 23 S-3, CO 23 S-4, 8 CO 29 S-1 are supplementary sheets to this project.

TOTAL SHEET COUNT after "AS BUILT" postings.

51 Sheets.

STATE OF HAWAII

DEPARTMENT OF TRANSPORTATION HIGHWAYS DIVISION


HONOLULU, HAWAII
"AS BUILT"

PLANS FOR

LIKELIKE HIGHWAY RESURFACING BURMEISTER OVERPASS TO KAMEHAMEHA HWY.

PROJECT NO. 63A-01-89M

DISTRICTS OF HONOLULU & KOOLAUPOKO ISLAND OF OAHU

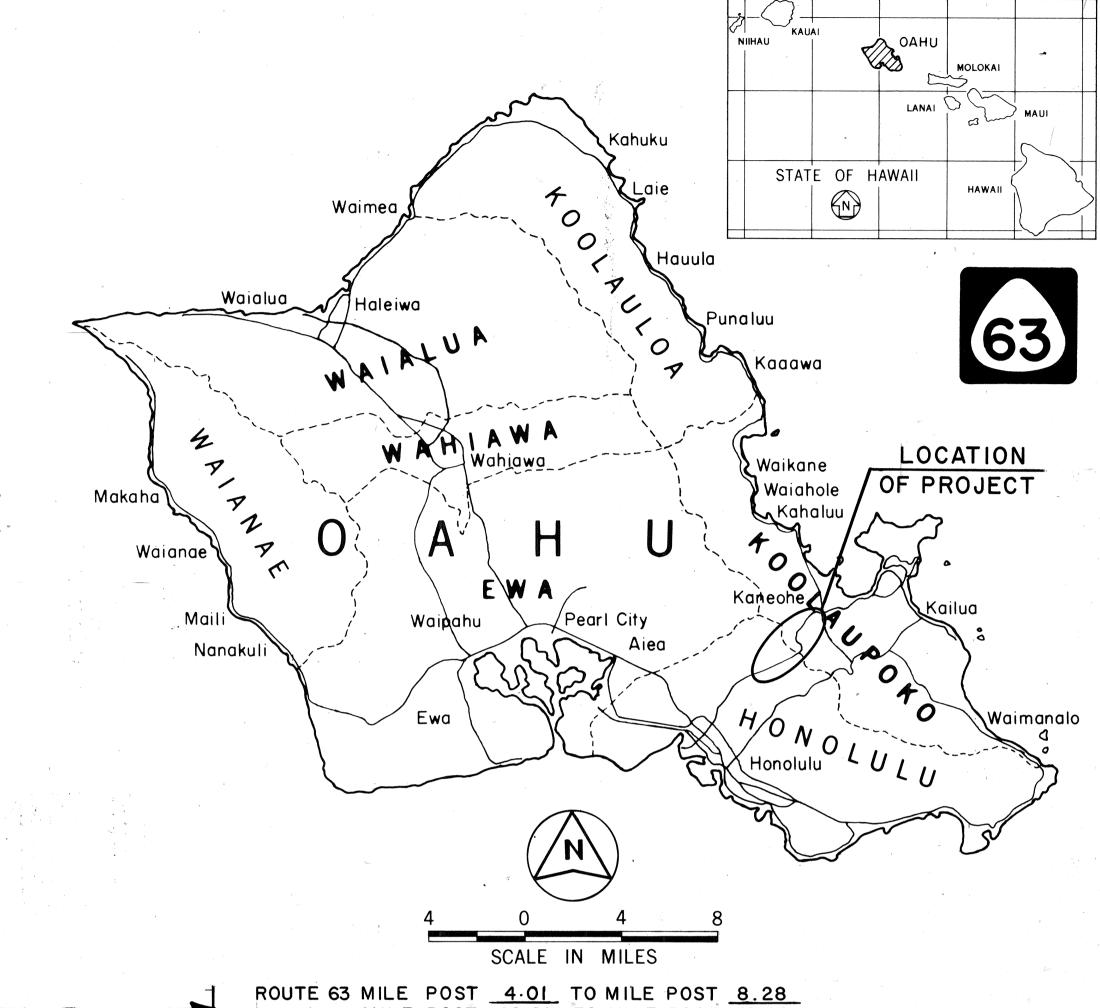

FED. ROAD DIST. NO. FISCAL SHEET YEAR NO.

