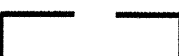
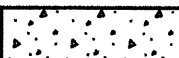


FED. ROAD DIST. NO.	STATE	FED. AID PROJ. NO.	FISCAL YEAR	SHEET NO.	TOTAL SHEETS
HAWAII	HAW.	NH-063-1(19)/STP-063-1(20)	1995	4	78

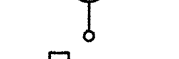
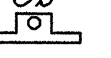
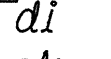
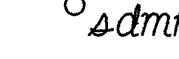
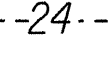
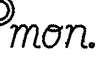
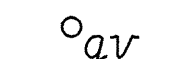
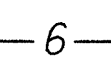
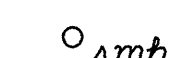
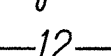
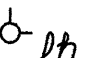
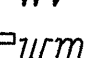
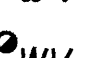
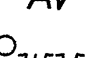
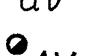
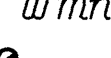
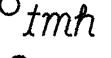
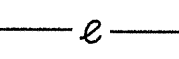
LEGEND

- 

Cold Planing Areas

Sidewalk Removal

P.C.C. Pav't. Areas

Resurfacing Limits
- 

Existing Electrical Line

Existing Joint Pole

Existing Power Pole

Existing Telephone Manhole

Adjusted Telephone Manhole

Adjusted Telephone Pullbox

Existing 12" Water Line

Existing Water Manhole

Adjusted Water MH Frame/Cover

Existing Water Air Valve

Adjusted Water Air Valve

Existing Water Valve

Adjusted Water Valve

Existing Water Meter

Existing Fire Hydrant

Existing Sewer Line

Existing Sewer Manhole

Adjusted Sewer Manhole

Existing 6" Gas Line

Existing Gas Valve

Existing Gas Manhole

Adjusting Gas Manhole

Existing Monument

Adjusted Monument

Existing 24" Drain Line

Existing Storm Drain Manhole

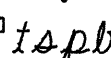
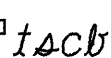
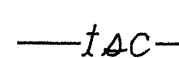
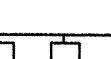
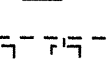
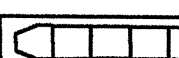
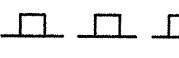
Adjusted Storm Drain MH Frame/Cover

Existing Drop Inlet

Existing Catch Basin

Existing Highway Lighting Conduit

Existing Highway Lighting Standard

Existing Highway Lighting Pull Box
- 

New Guardrail

Existing Guardrail

New Inertial Barrier (GREAT)

Existing Sign Base

Existing Loop Detectors

New Loop Detectors

Existing Traffic Signal Conduit

Existing Traffic Signal Control Box

Existing Traffic Signal Pole

Existing Traffic Signal Pullbox

Adjusted Traffic Signal Pullbox

New Traffic Signal Pullbox

New Traffic Signal Junction Box

ORIGINAL PLAN	SURVEY PLOTTED BY _____		DATE
	DRAWN BY _____	TRACED BY _____	5/8/96
NOTE BOOK	DESIGNED BY _____	QUANTITIES BY _____	
dd/da	CHECKED BY _____		
N. Ziemer			

5/8/96	Add New Traffic Signal Pullbox and New Traffic Signal Junction Box
6/21/95	Add Sidewalk Removal
DATE	REVISION
STATE OF HAWAII DEPARTMENT OF TRANSPORTATION HIGHWAYS DIVISION	
LEGEND	
LIKELIKE HIGHWAY RESURFACING	
F.A. Project No. NH-063-1(19)	
KALIHI STREET RESURFACING	
F.A. Project No. STP-063-1(20)	
Scale: As Shown	Date: May, 1995
SHEET No. 1 OF 1 SHEETS	