
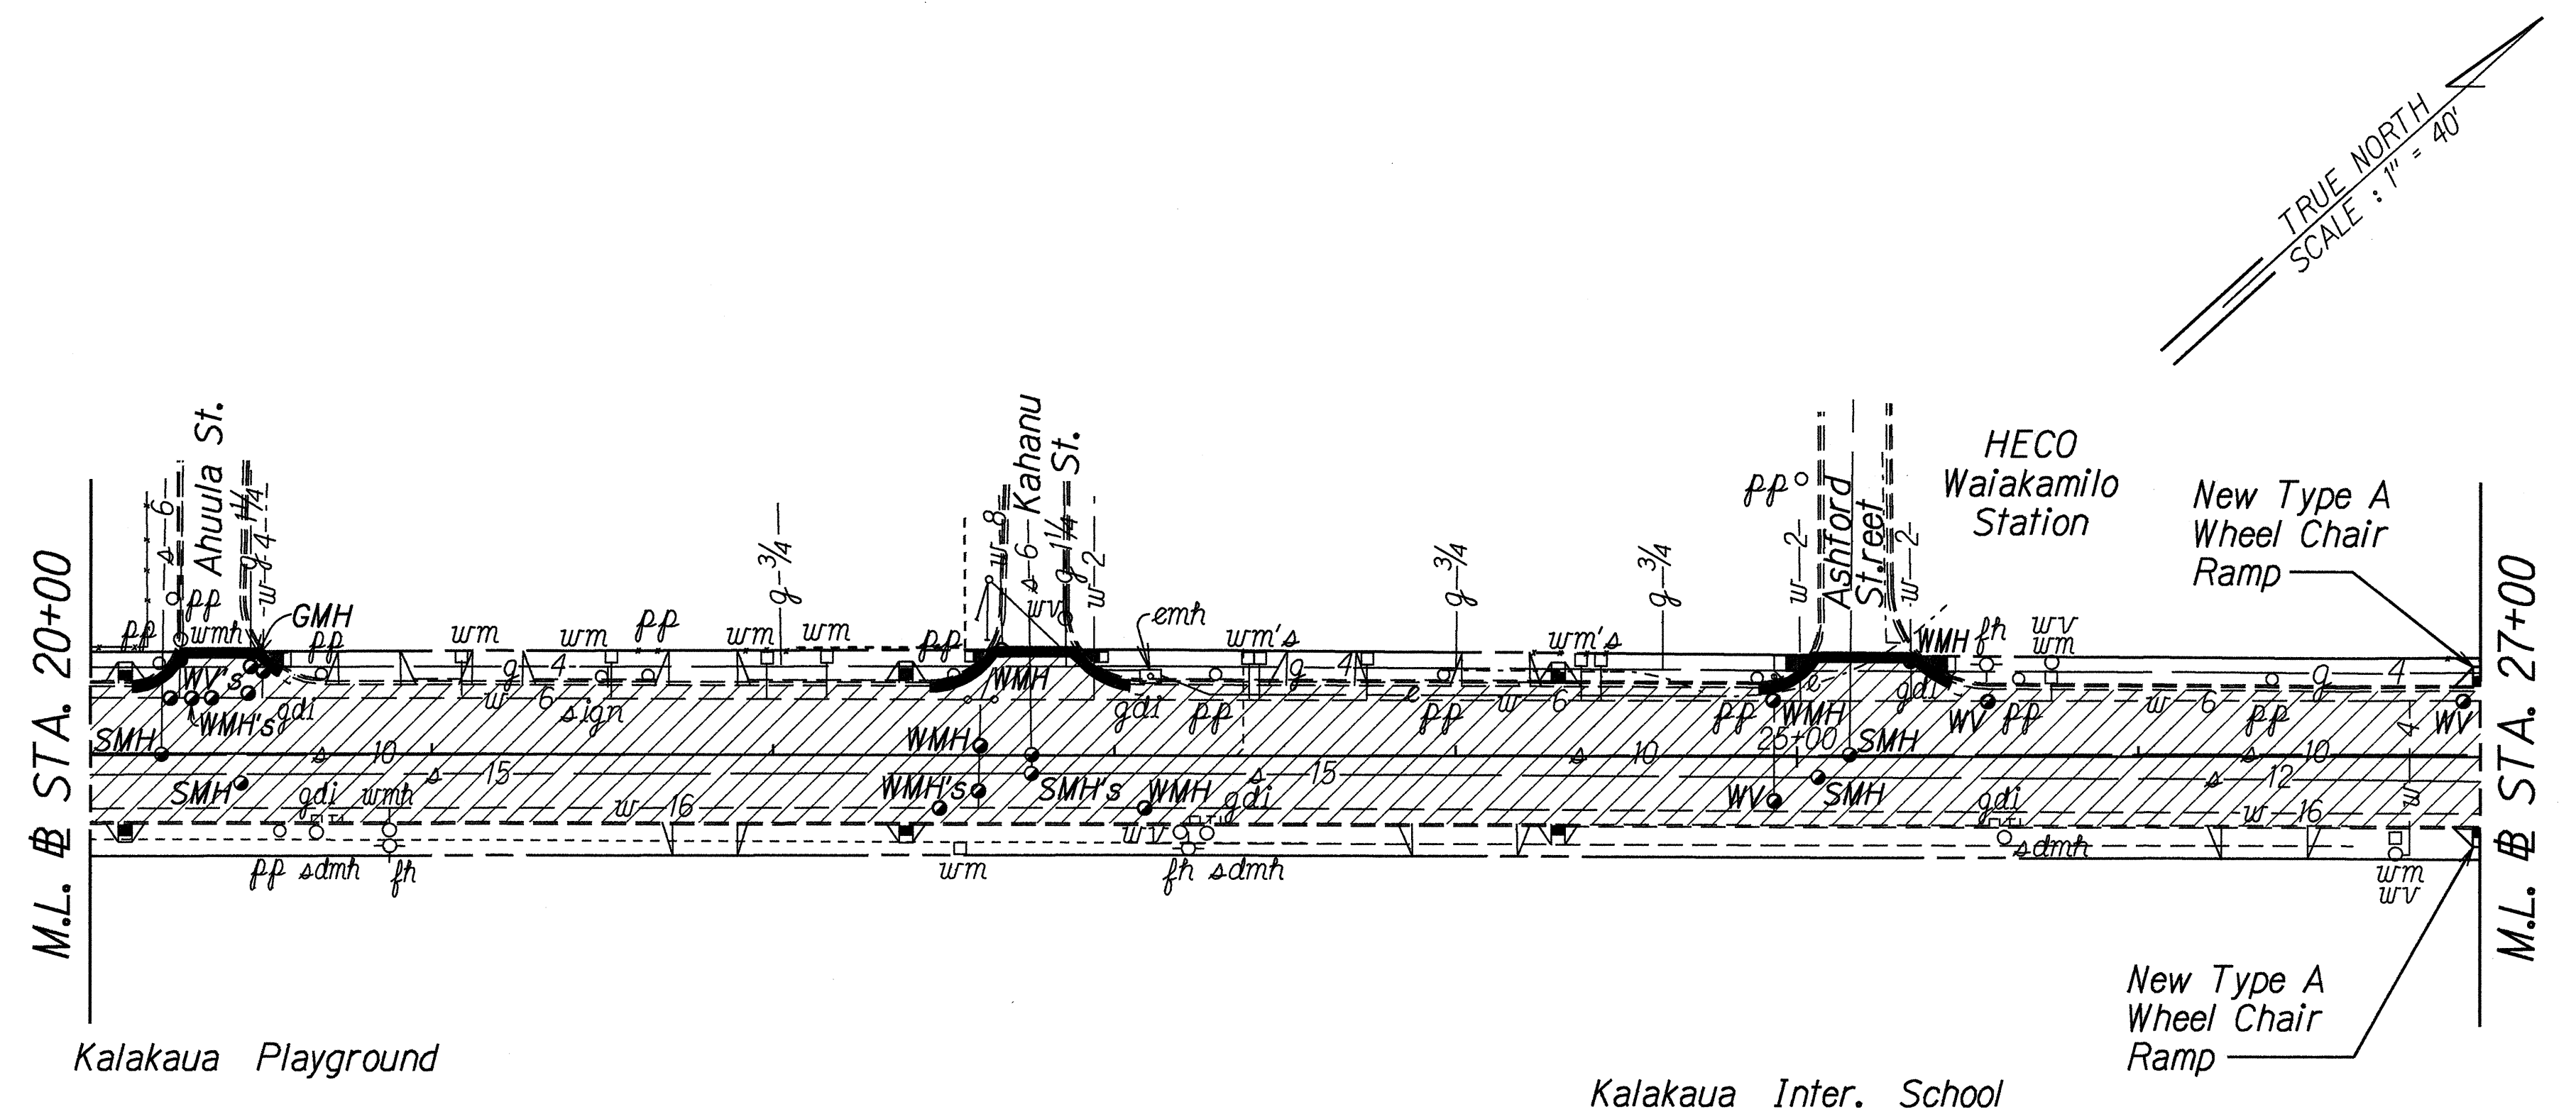


FED. ROAD DIST. NO.	STATE	FED. AID PROJ. NO.	FISCAL YEAR	SHEET NO.	TOTAL SHEETS
HAWAII	HAW.	STP-063-1(20)	1995	ADD. 26	78

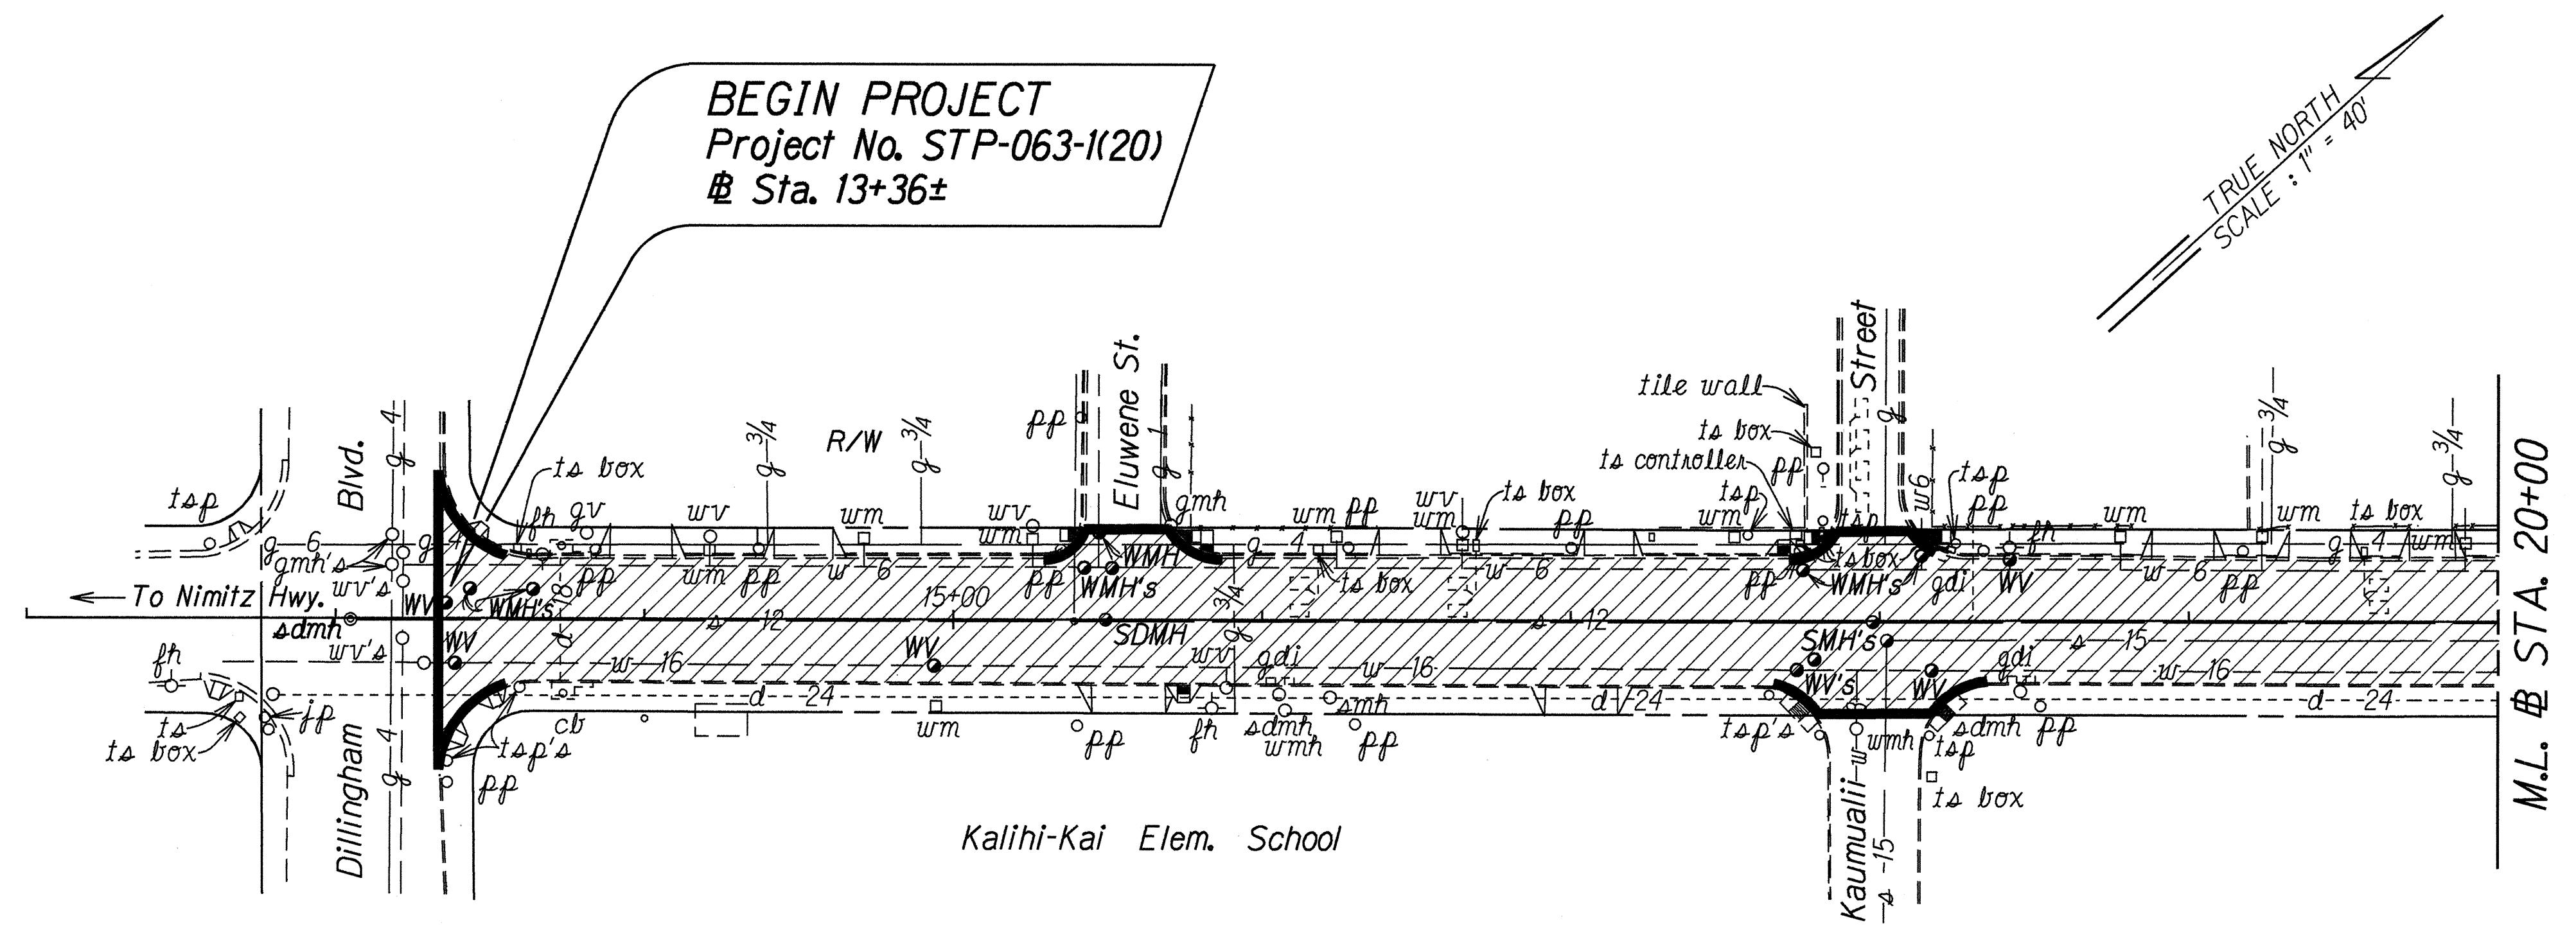


SURVEY PLOTTED BY	DATE
DRAWN BY	6/21/95
NOTED BY	
CHECKED BY	

6/21/95	Add 2 New Wheelchair Ramps at @ Sta. 27+00.
DATE	REVISION
STATE OF HAWAII DEPARTMENT OF TRANSPORTATION HIGHWAYS DIVISION	
PLAN	
KALIHI STREET RESURFACING Dillingham Blvd. to School St. Including Interchange On/Off Ramps Fed. Aid Proj. No. STP-063-1(20)	
Scale: 1" = 40'	Date: May, 1995
SHEET No. 1 OF 4 SHEETS	


FED. ROAD DIST. NO.	STATE	FED. AID PROJ. NO.	FISCAL YEAR	SHEET NO.	TOTAL SHEETS
HAWAII	HAW.	STP-063-1(20)	1995	ADD. 27	78

Kalihi St. @ Sta. 31+26± to @ Sta. 32+50± Lt.
Remove exist. curb & gutter (45± L.F.) and
exist. a.c. sidewalk and Construct New
Reinforced Concrete Sidewalk (59± S.Y.)
and Curb & Gutter, Type 2DG (79± L.F.).
See Plan Sht. 13 for Details.

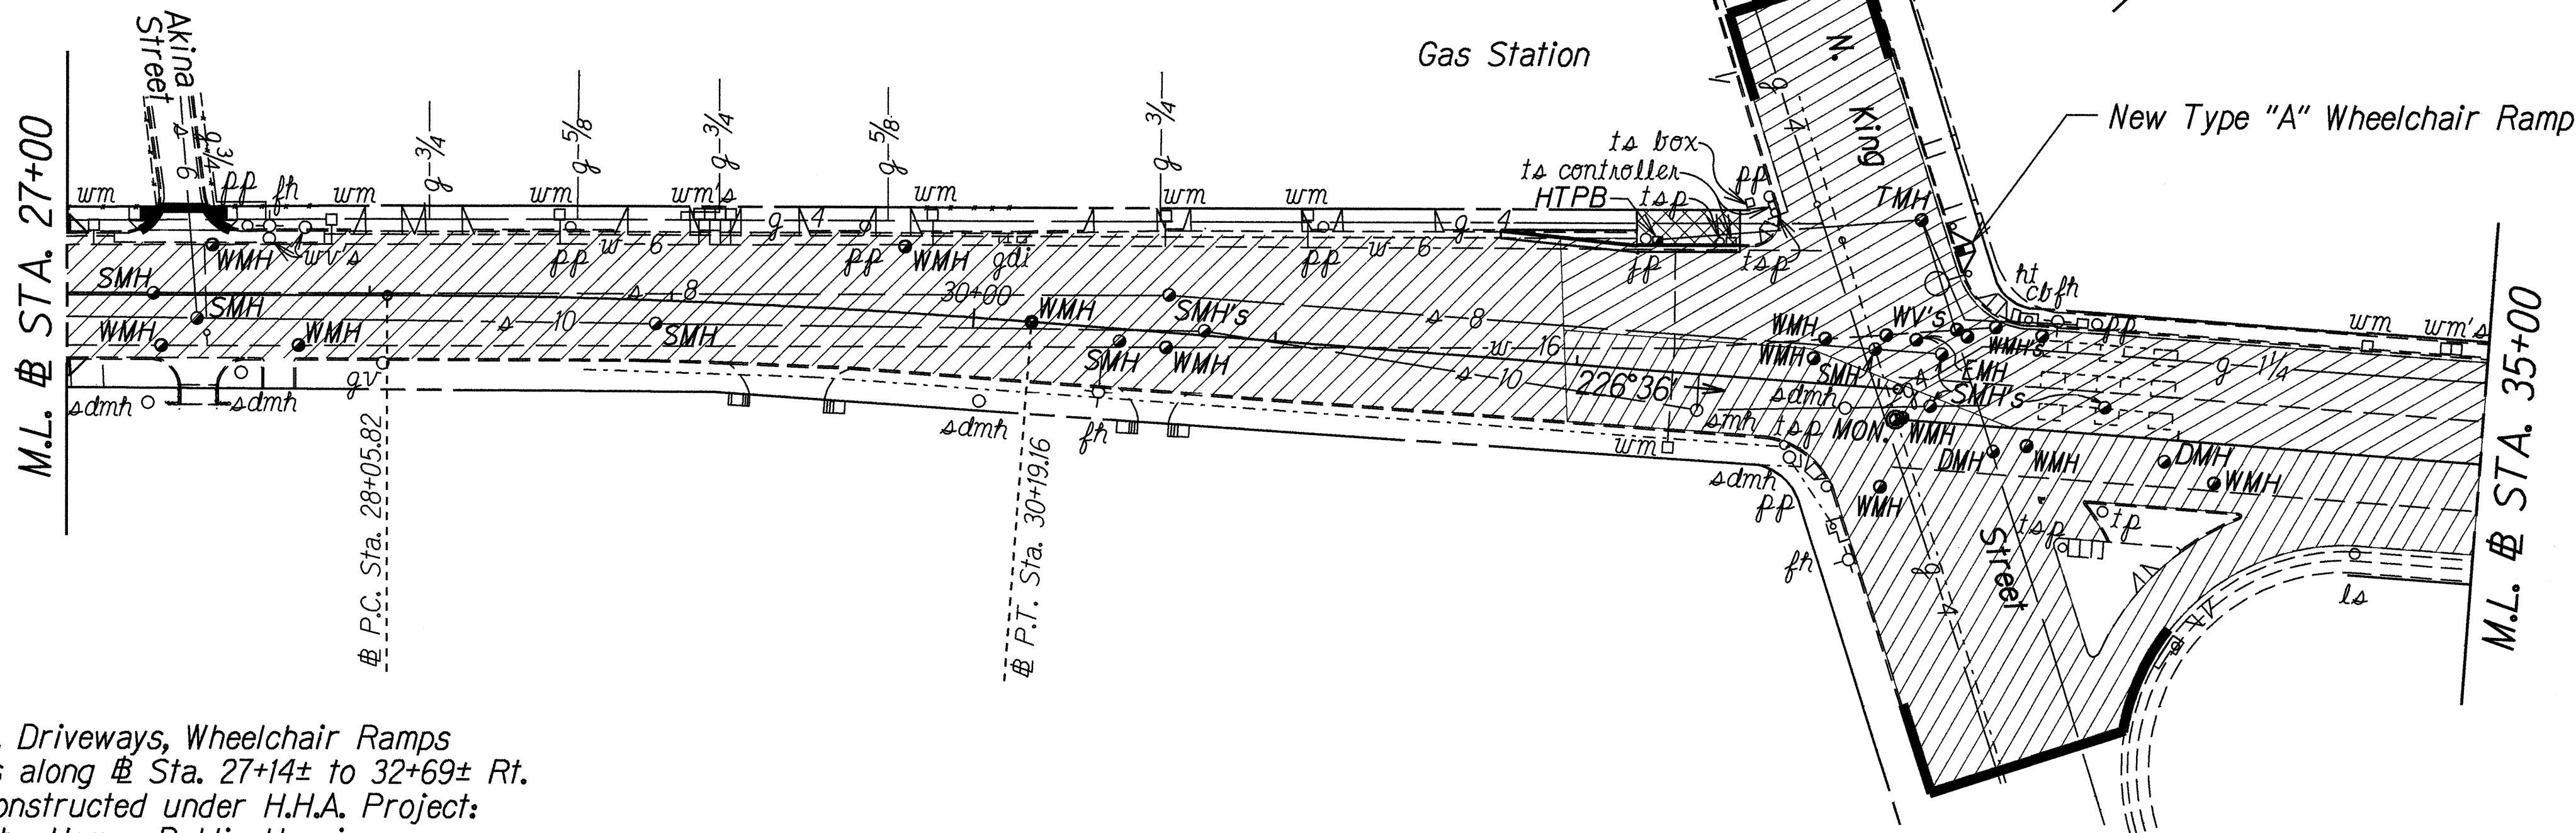

NOTE: Sidewalks, Driveways, Wheelchair Ramps
and Curbs along @ Sta. 27+14± to 32+69± Rt.
to be Reconstructed under H.H.A. Project:
Kamehameha Homes Public Housing,
Project. No. H-110-P001-009.

@ Sta. 39+29± o/s 38± Lt.
Partially demolish existing catch basin.
Construct Sidewalk, Curb, and Modified
Type "D2" Wheelchair Ramp. See Plan Sht.
No. 12 for Sidewalk Reconstruction Detail.

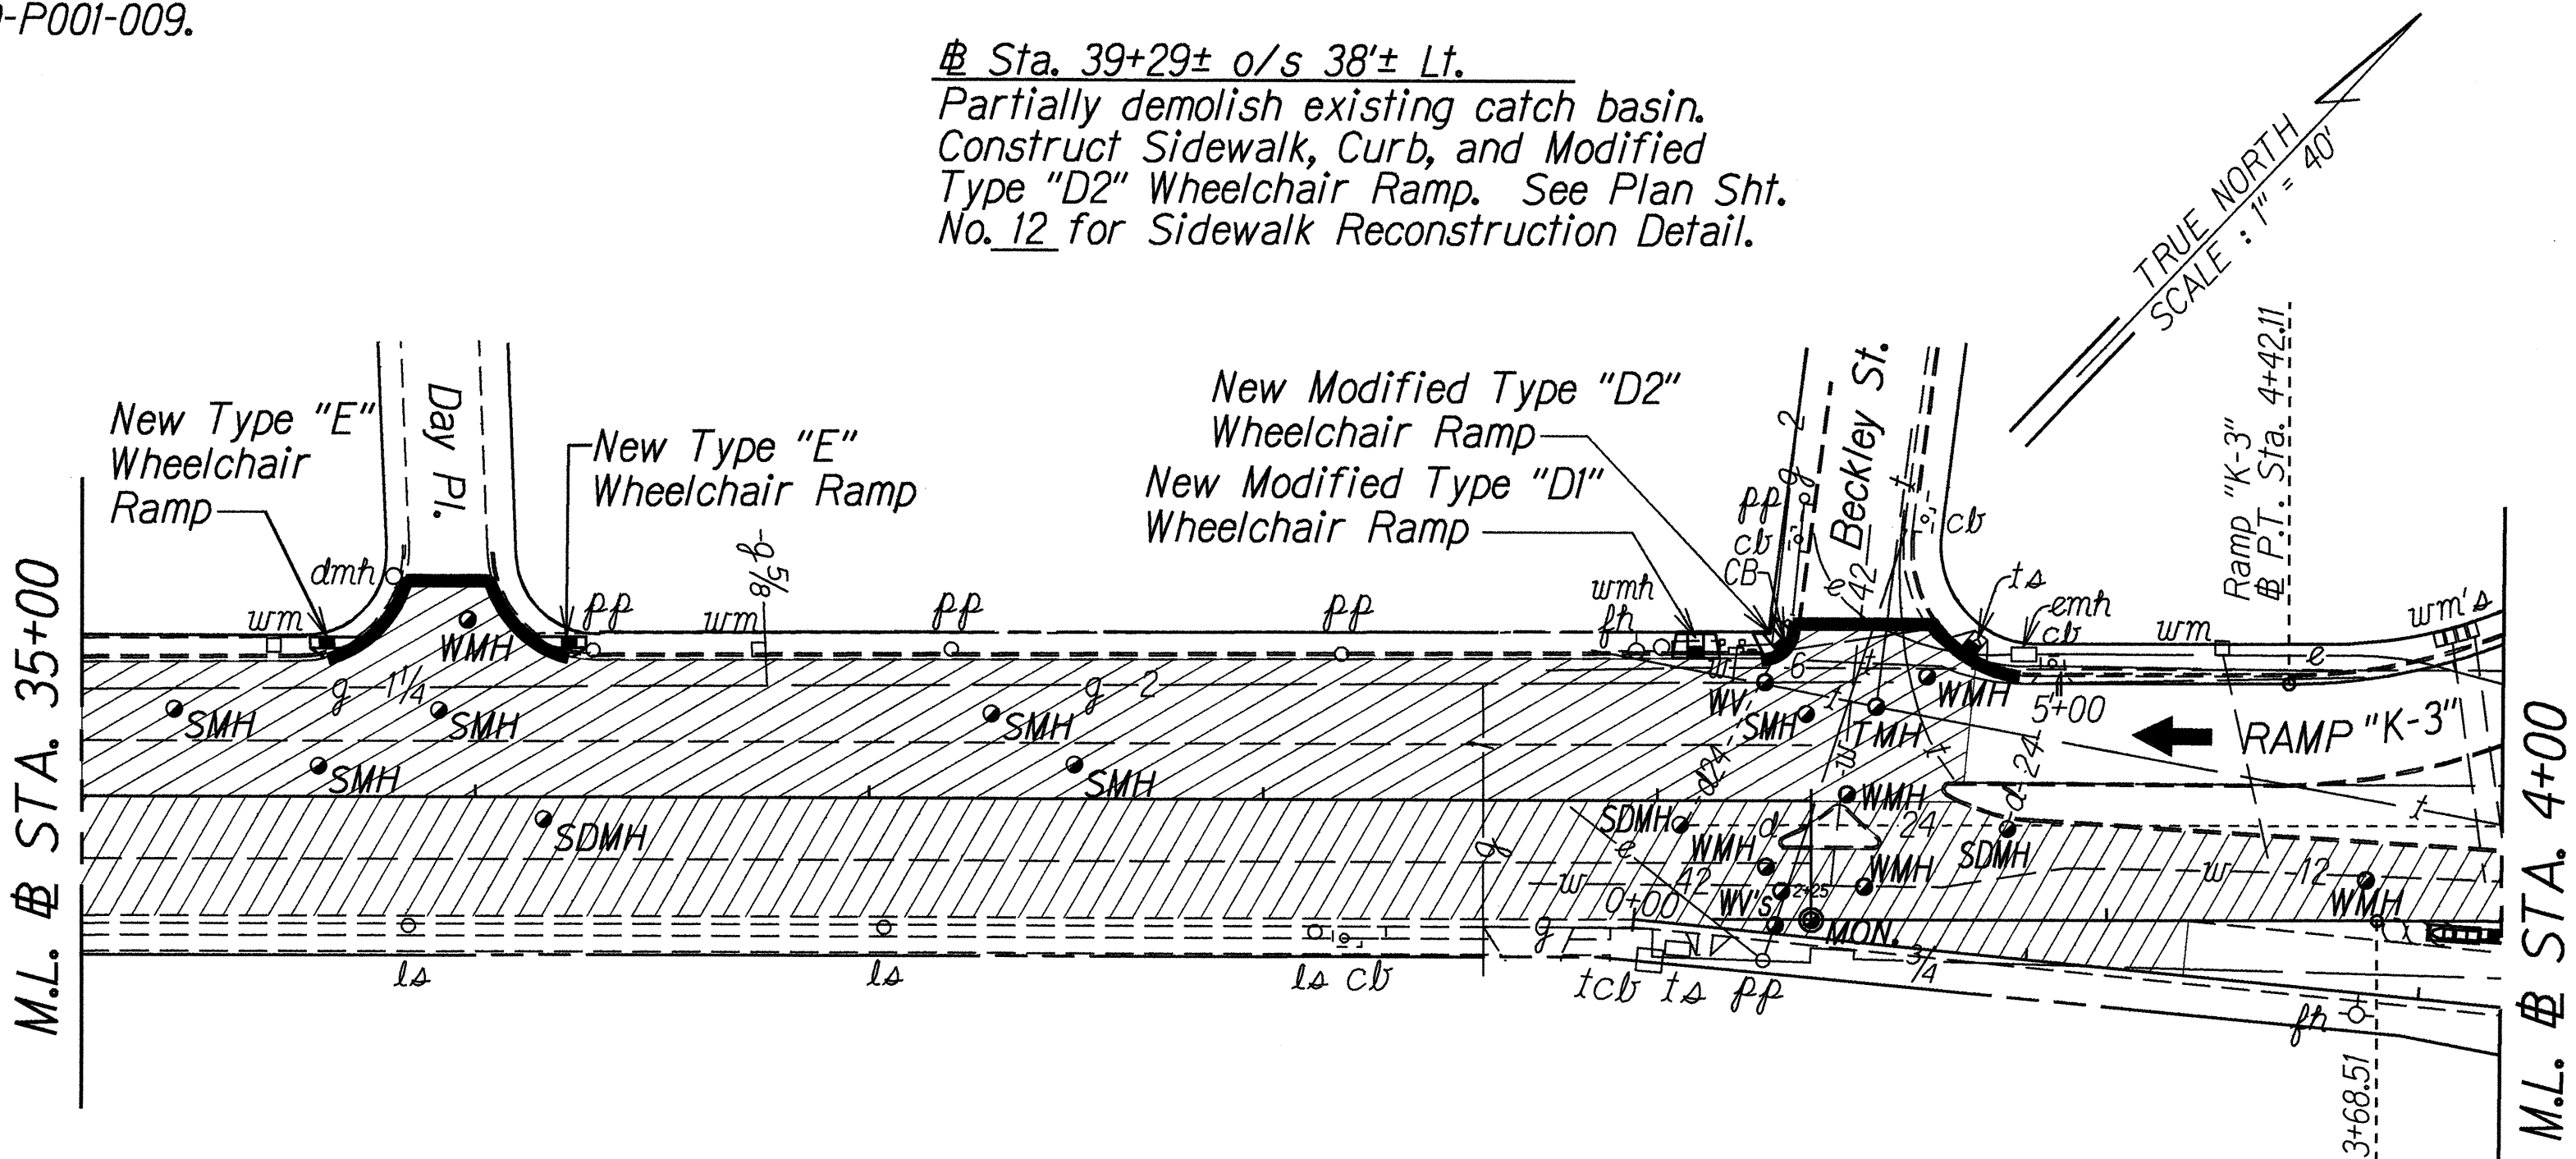

Ramp "K-3" @ Sta. 4+36± to @ Sta. 4+55± Rt.
Remove 19± L.F. exist. curb, Construct Curb,
Type "2D" (19± L.F.) and Connect to Match
exist. curb.

Ramp "K-6" @ Sta. 2+00± to @ Sta. 2+66± Lt.
Remove exist. inertial barrier, GREAT system, and
52 ± L.F. exist. guardrail. Install New GREAT System
(3 Bays), 42± L.F. New Guardrail, Type 3 - Thrie Beam
with Steel Post, and Type "L" End Post Upgrade.
Removal and disposal of the above will be considered
incidental to the various items. For Type "L" Upgrade,
See Plan Sht. No. 52.

SURVEY PLOTTED BY	DATE
DRAWN BY	11/20/95
TRACED BY	
CHECKED BY	
ORIGINAL PLAN	
NOTE BOOK	
DATE	
CHECKED BY	

11/20/95	Revise Wheelchair Ramp Types at Beckley Street.
6/21/95	Revise All Construction Notes except Ramp "K-3" Note and Add 1 Wheelchair Ramp at King Street.

DATE	REVISION
------	----------


STATE OF HAWAII
DEPARTMENT OF TRANSPORTATION
HIGHWAYS DIVISION

PLAN

KALIHI STREET RESURFACING
Dillingham Blvd. to School St.
Including Interchange On/Off Ramps
Fed. Aid Proj. No. STP-063-1(20)

Scale: 1" = 40'	Date: May, 1995
SHEET No. 2 OF 4 SHEETS	


FED. ROAD DIST. NO.	STATE	FED. AID PROJ. NO.	FISCAL YEAR	SHEET NO.	TOTAL SHEETS
HAWAII	HAW.	STP-063-1(20)	1995	28	78

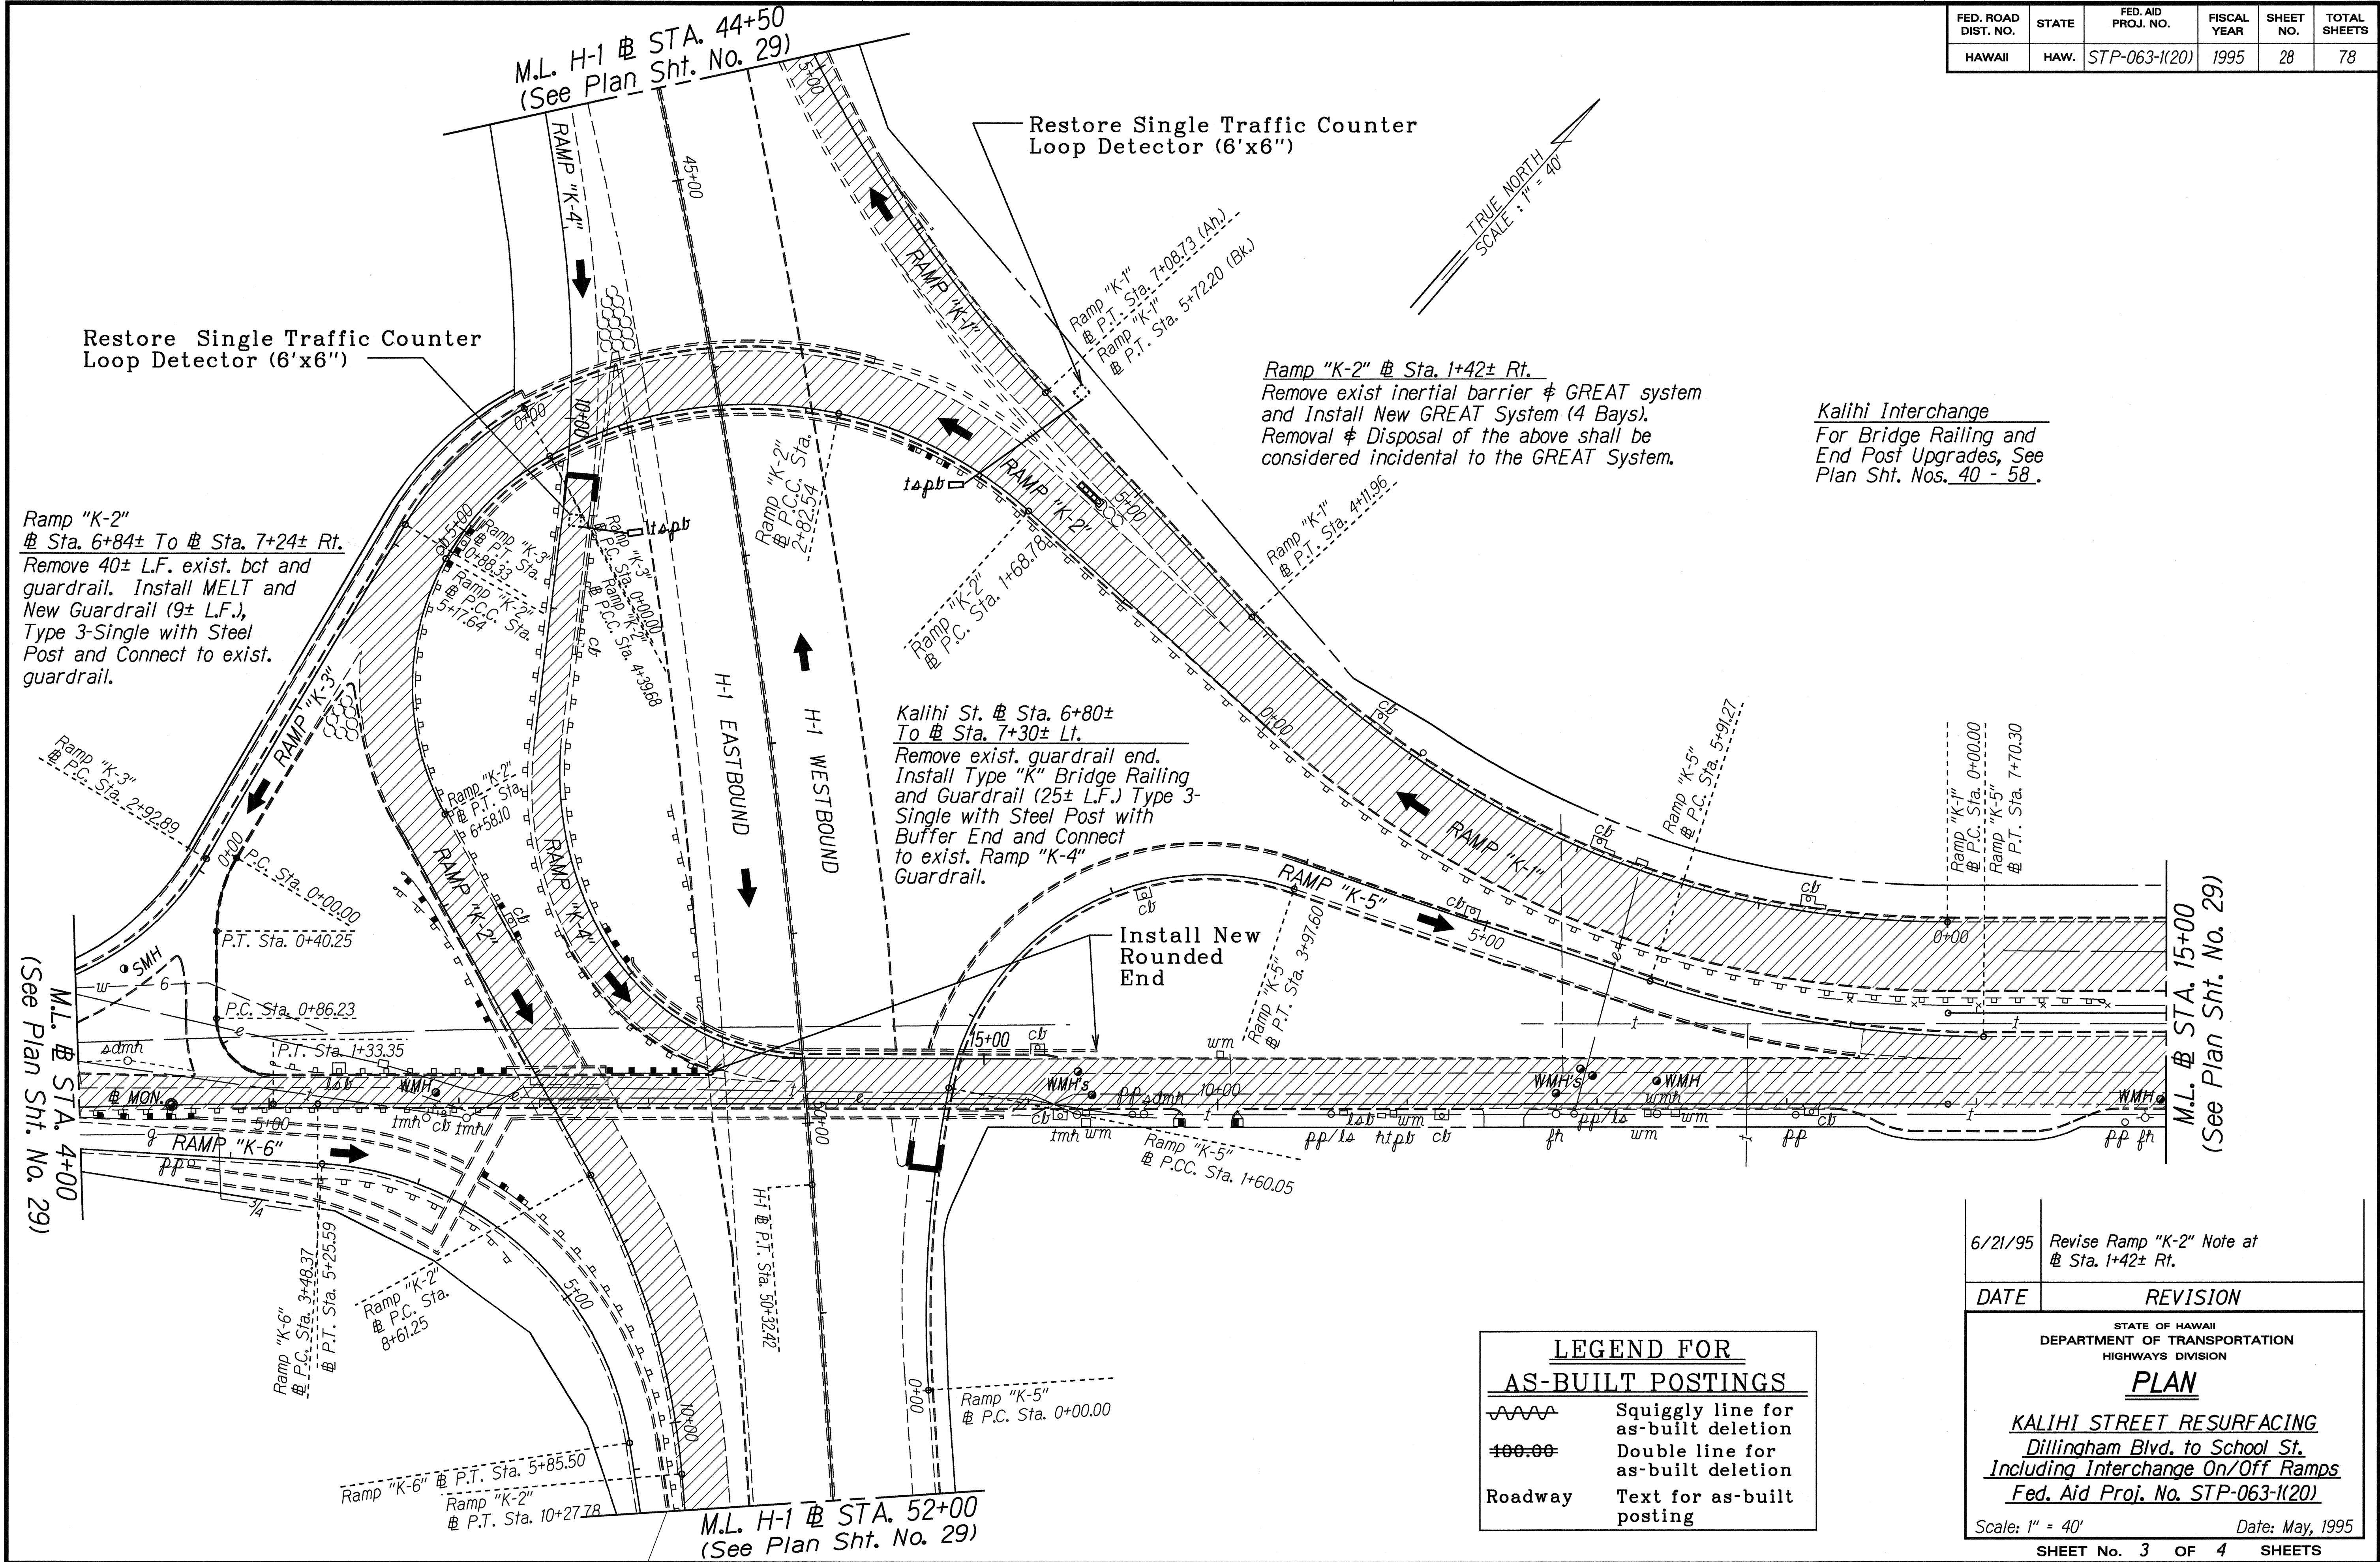

ORIGINAL PLAN	DATE	6/21/95
SURVEY PLOTTED BY		
DRAWN BY		
NOTED BY		
CHECKED BY		

"AS-BUILT"

FED. ROAD DIST. NO.	STATE	FED. AID PROJ. NO.	FISCAL YEAR	SHEET NO.	TOTAL SHEETS
HAWAII	HAW.	STP-063-1(20)	1995	29	78

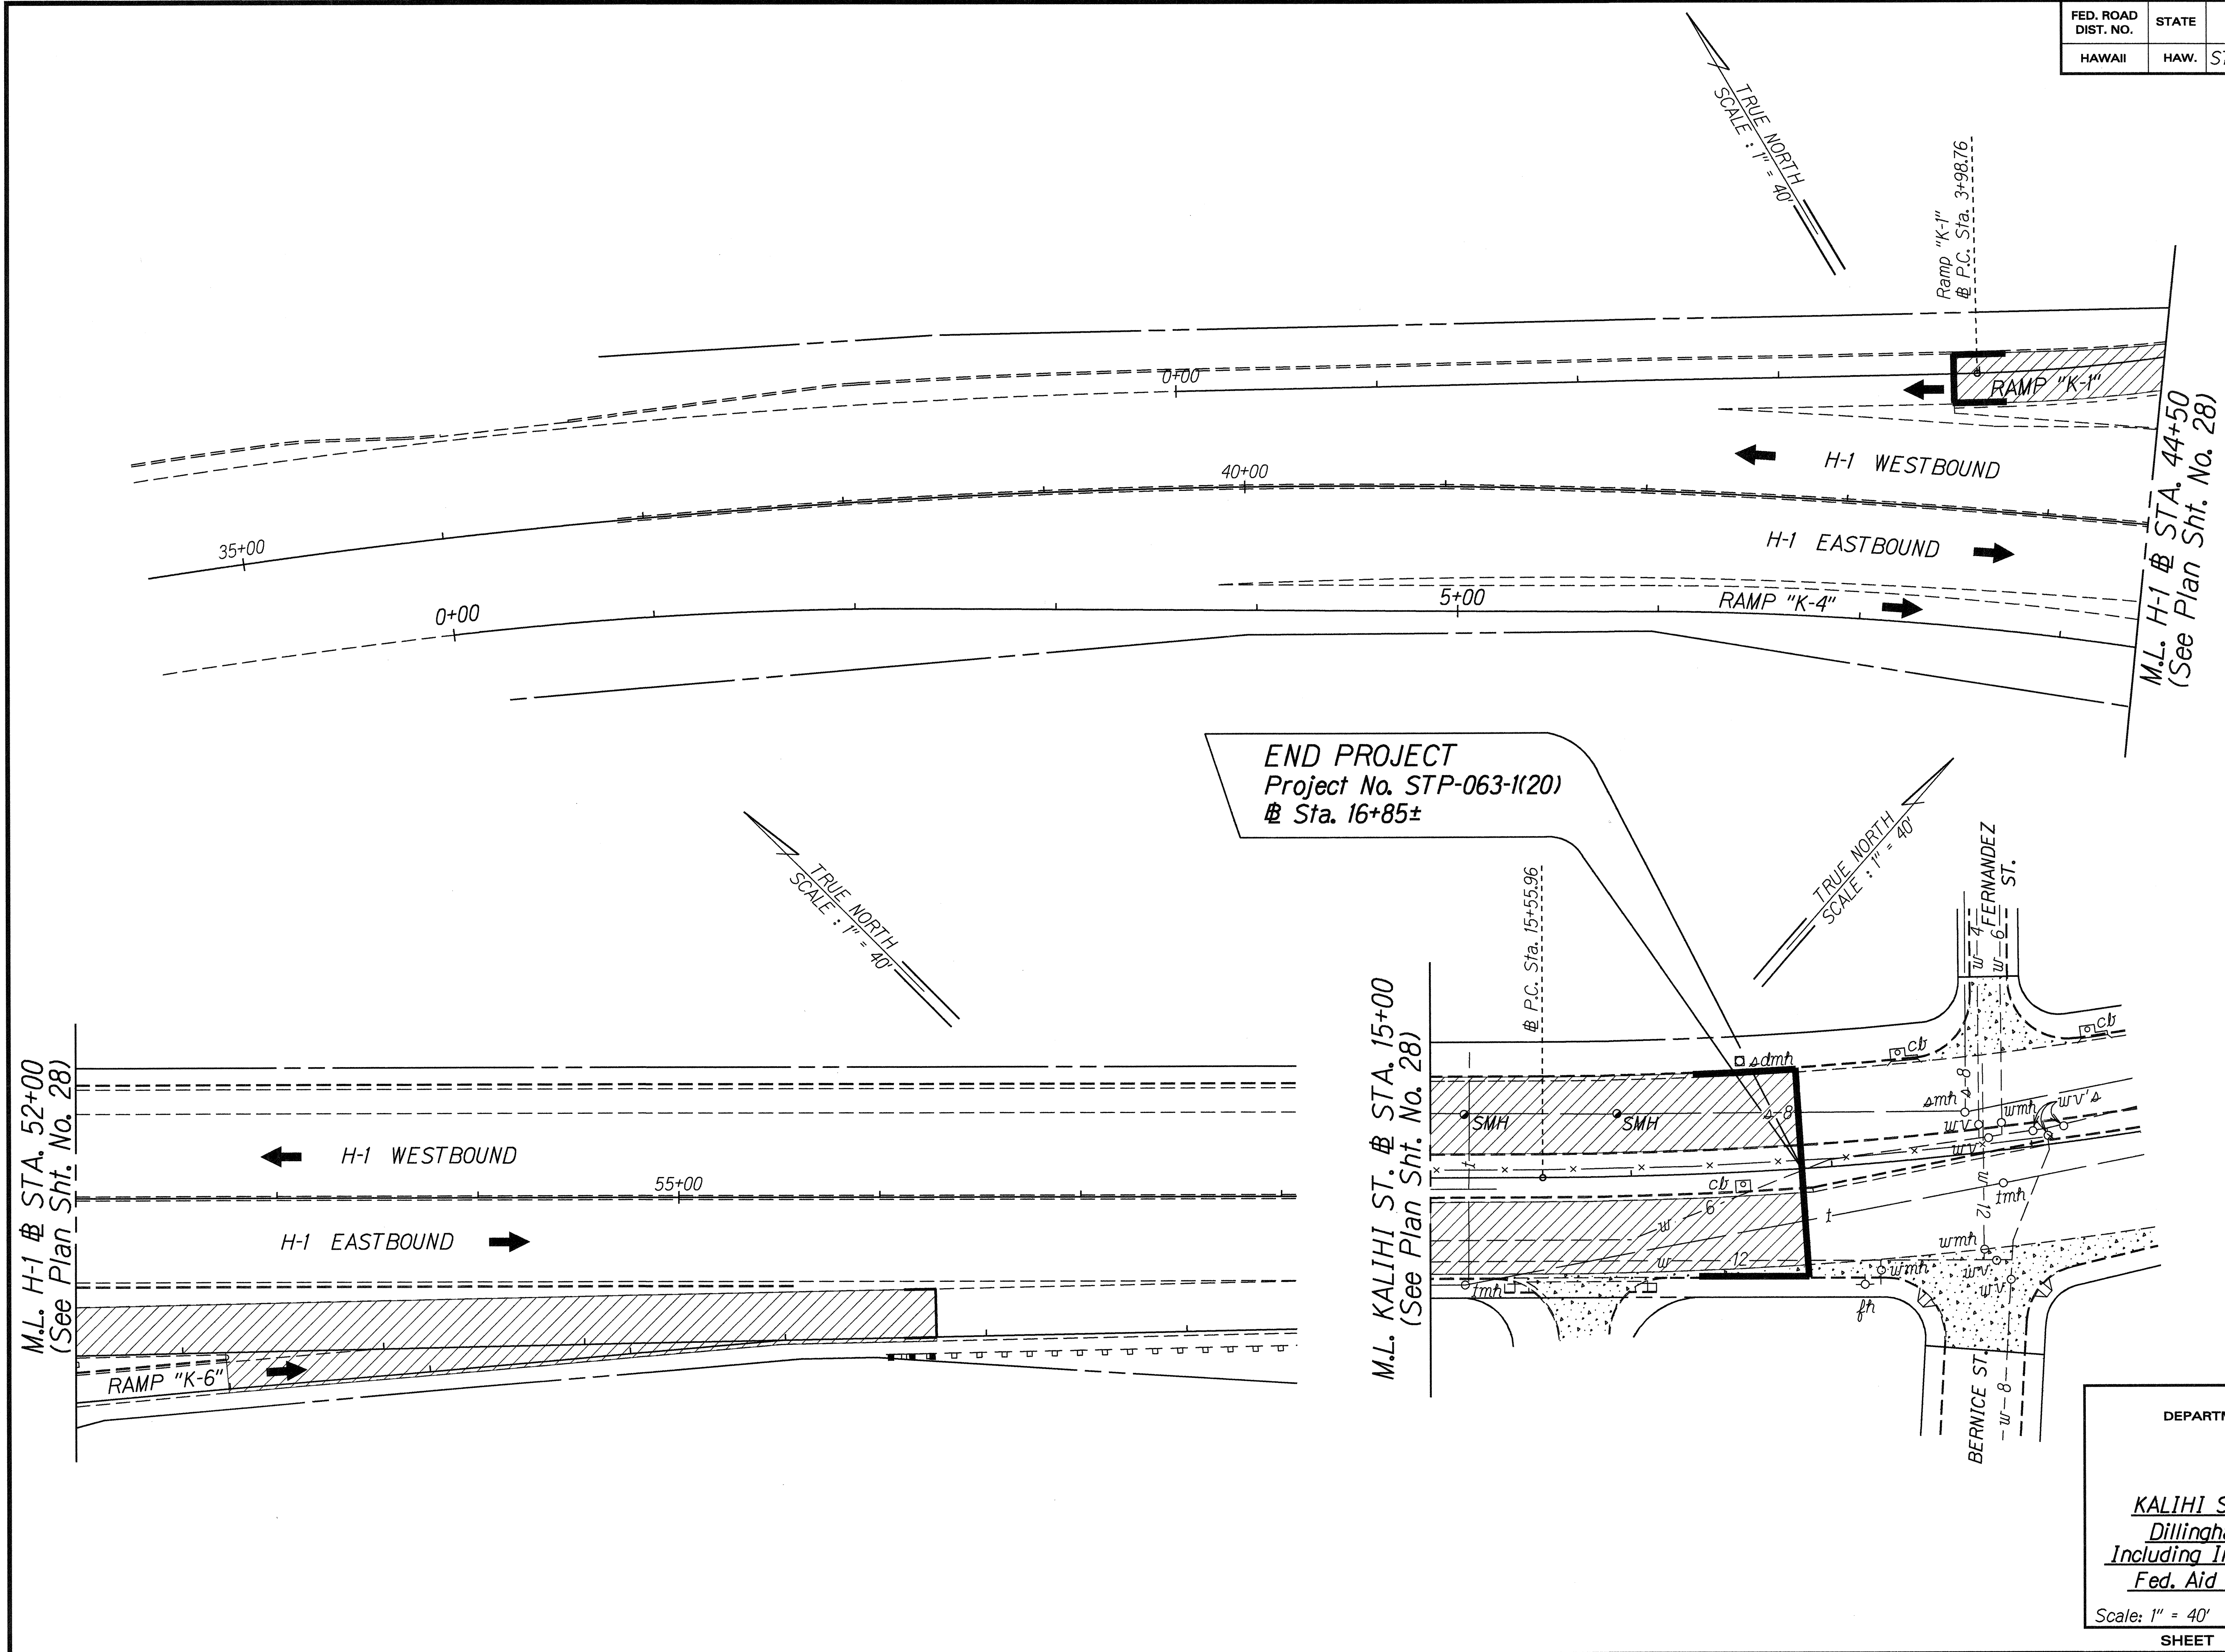

ORIGINAL	SURVEY PLOTTED BY	DATE
PLAN	DRAWN BY L. Misquith	5/30/95
NOTE BOOK	DESIGNED BY L. Yonamine	
	CHECKED BY N. Kihapala	

STATE OF HAWAII
DEPARTMENT OF TRANSPORTATION
HIGHWAYS DIVISION

PLAN
KALIHI STREET RESURFACING
Dillingham Blvd. to School St.
Including Interchange On/Off Ramps
Fed. Aid Proj. No. STP-063-1(20)

Scale: 1" = 40'
Date: May, 1995

SHEET No. 4 OF 4 SHEETS