
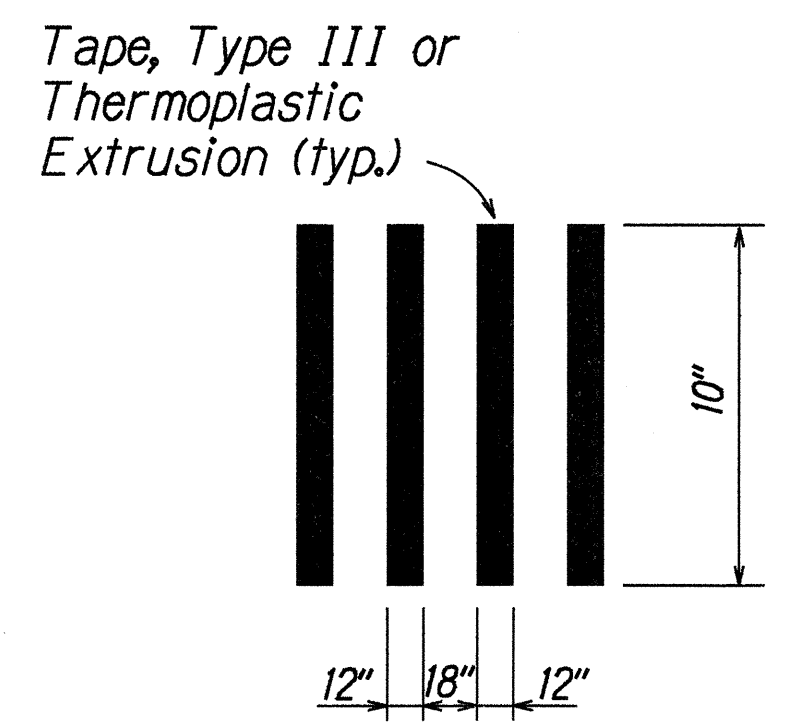


FED. ROAD DIST. NO.	STATE	FED. AID PROJ. NO.	FISCAL YEAR	SHEET NO.	TOTAL SHEETS
HAWAII	HAW.	STP-063-1(20)	1995	72	78

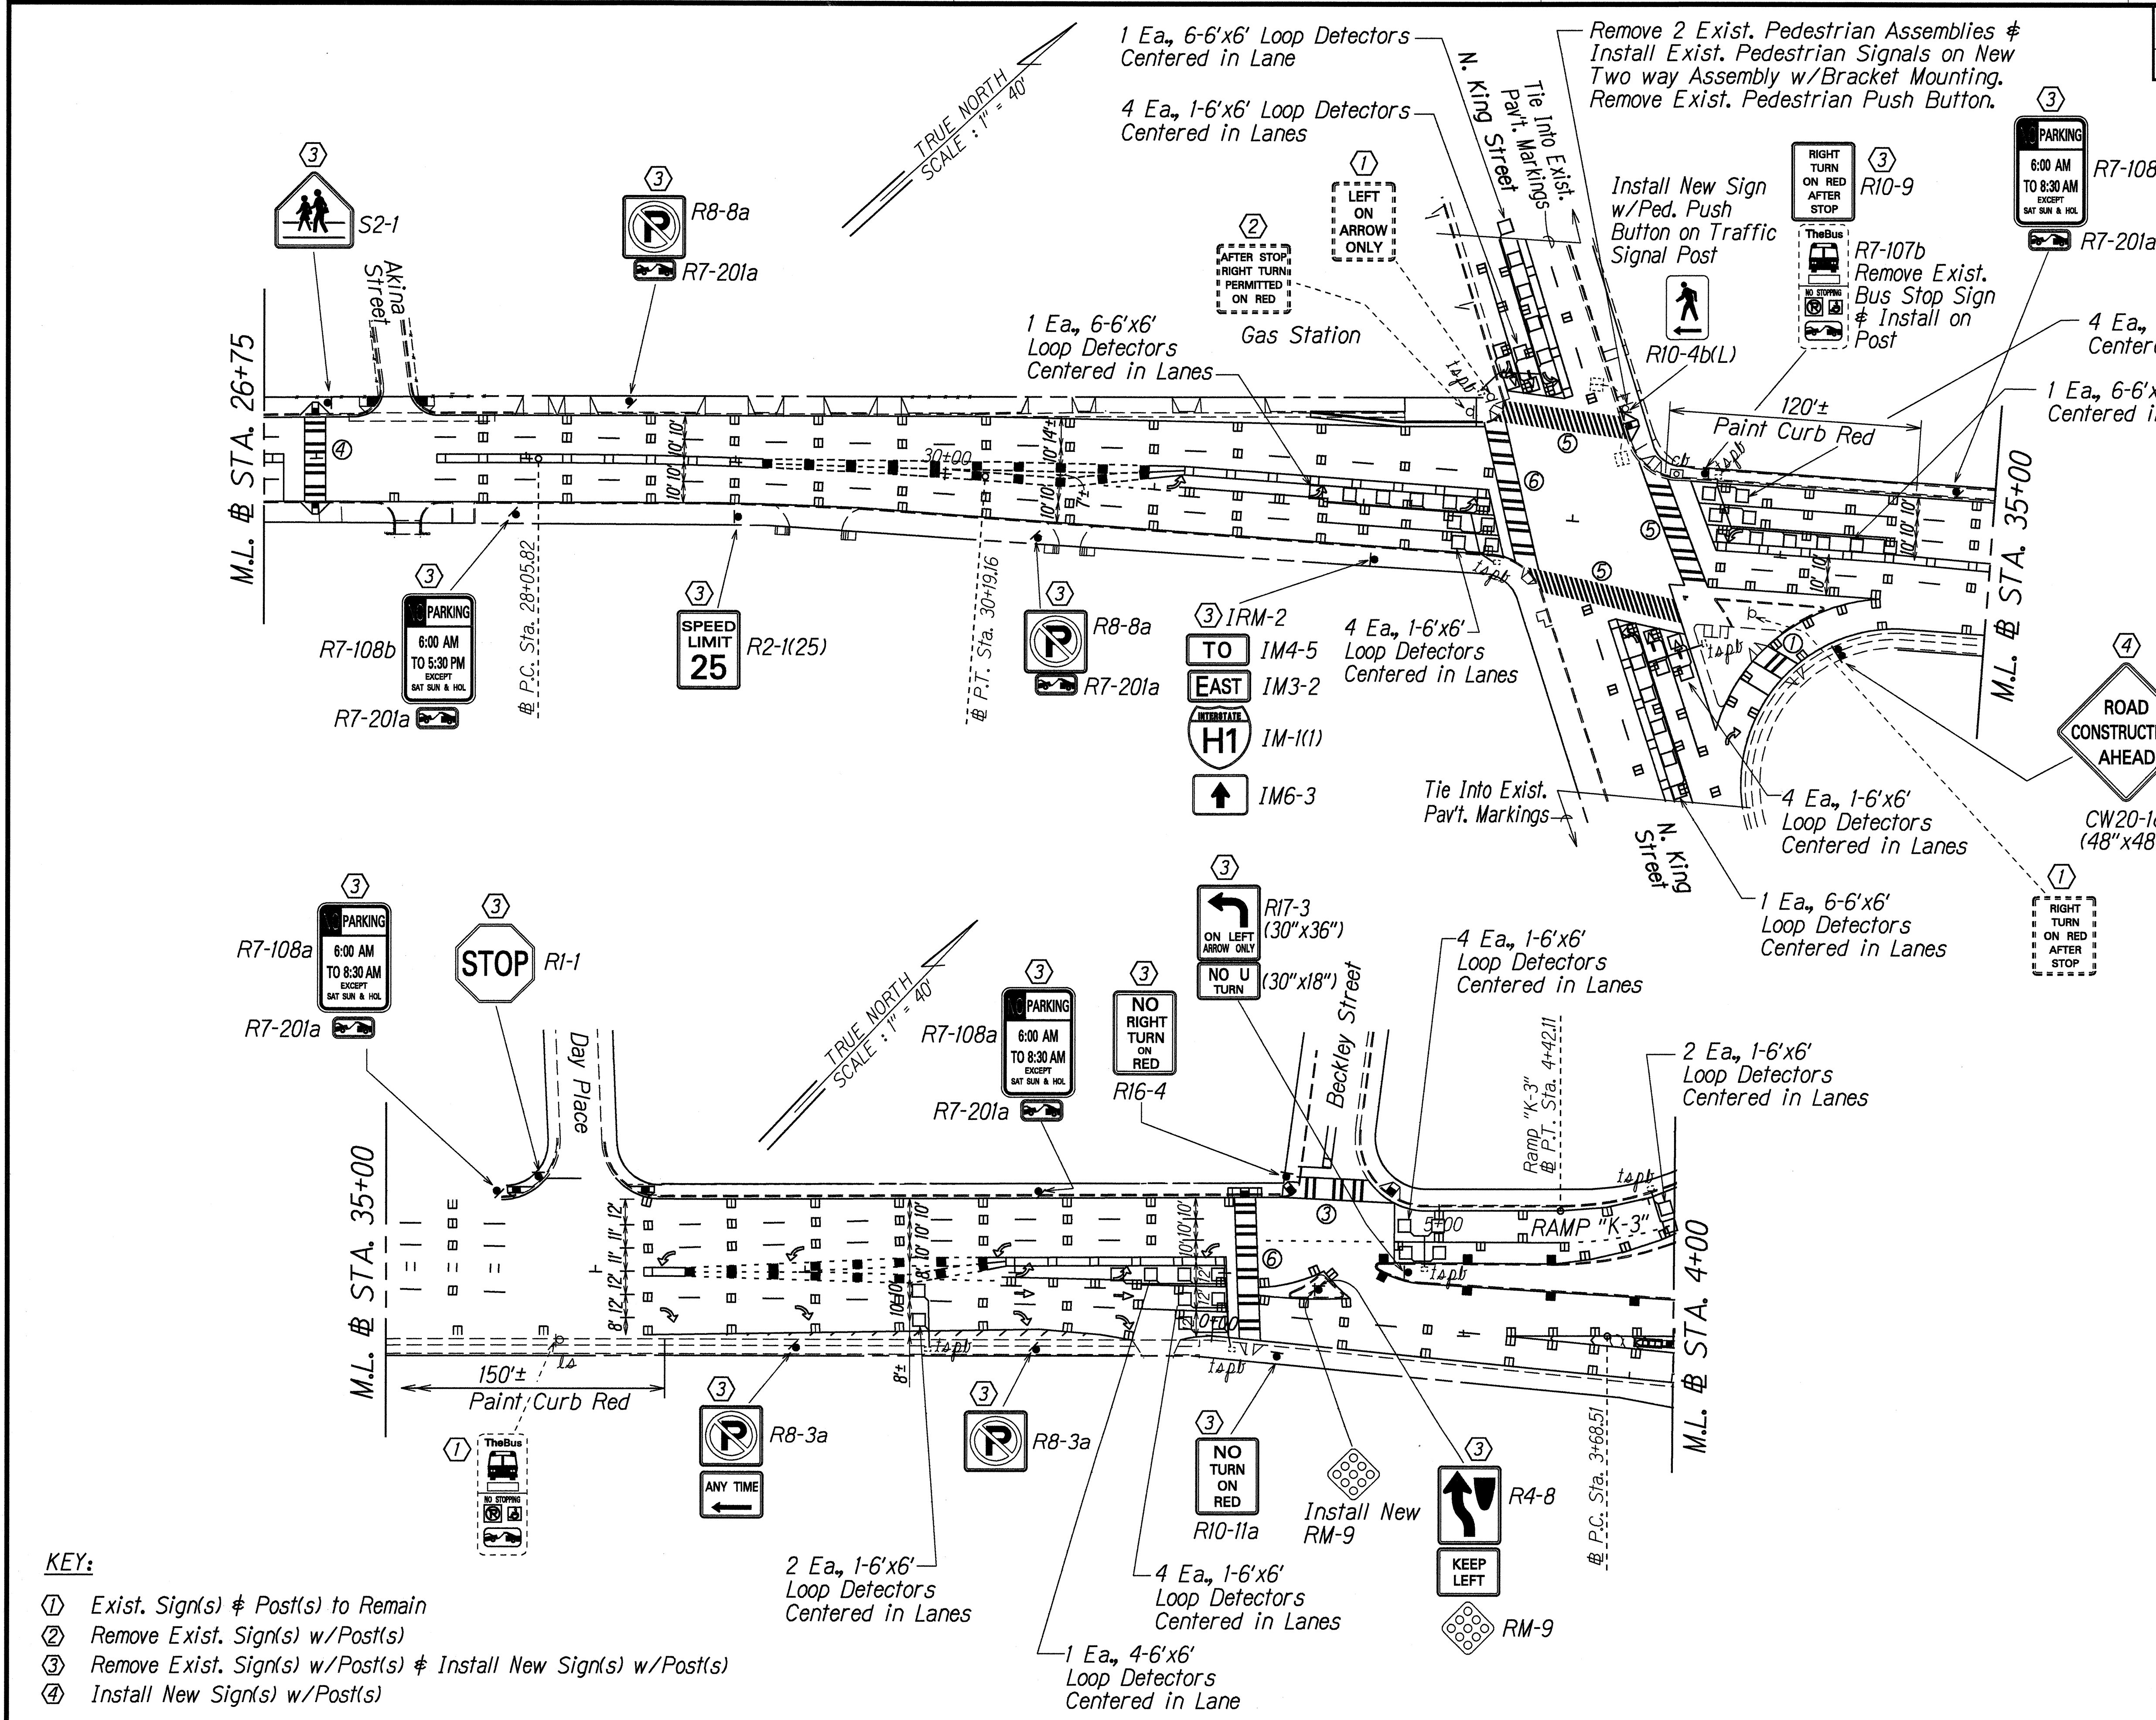

- KEY:**
- ① Exist. Sign(s) & Post(s) to Remain
 - ② Remove Exist. Sign(s) w/Post(s)
 - ③ Remove Exist. Sign(s) w/Post(s) & Install New Sign(s) w/Post(s)
 - ④ Install New Sign(s) w/Post(s)

SURVEY PLOTTED BY	DATE
DRAWN BY H. Aoki	4/15/95
DESIGNED BY K. KUNISHIGE	
NOTED BY	
QUANTITIES BY	
CHECKED BY	

DATE	REVISION
6/22/95	Add Painting Curb Red. Add Pav't. Markings on N. King St. Add Loop Detectors on N. King St. & Kalihi St. Add modifications to Ped. Signals and Push Button.

STATE OF HAWAII
DEPARTMENT OF TRANSPORTATION
HIGHWAYS DIVISION

PAVEMENT MARKING & SIGNING PLAN

KALIHI STREET RESURFACING
Dillingham Blvd. to School St.
Including Interchange On/Off Ramps
Fed. Aid Proj. No. STP-063-1(20)



Scale: 1" = 40' Date: Apr., 1995

SHEET No. 73 OF 7 SHEETS

FED. ROAD DIST. NO.	STATE	FED. AID PROJ. NO.	FISCAL YEAR	SHEET NO.	TOTAL SHEETS
HAWAII	HAW.	STP-063-1(20)	1995	74	78

KEY:

- ① Exist. Sign(s) & Post(s) to Remain
- ② Remove Exist. Sign(s) w/Post(s)
- ③ Remove Exist. Sign(s) w/Post(s) & Install New Sign(s) w/Post(s)
- ④ Install New Sign(s) w/Post(s)

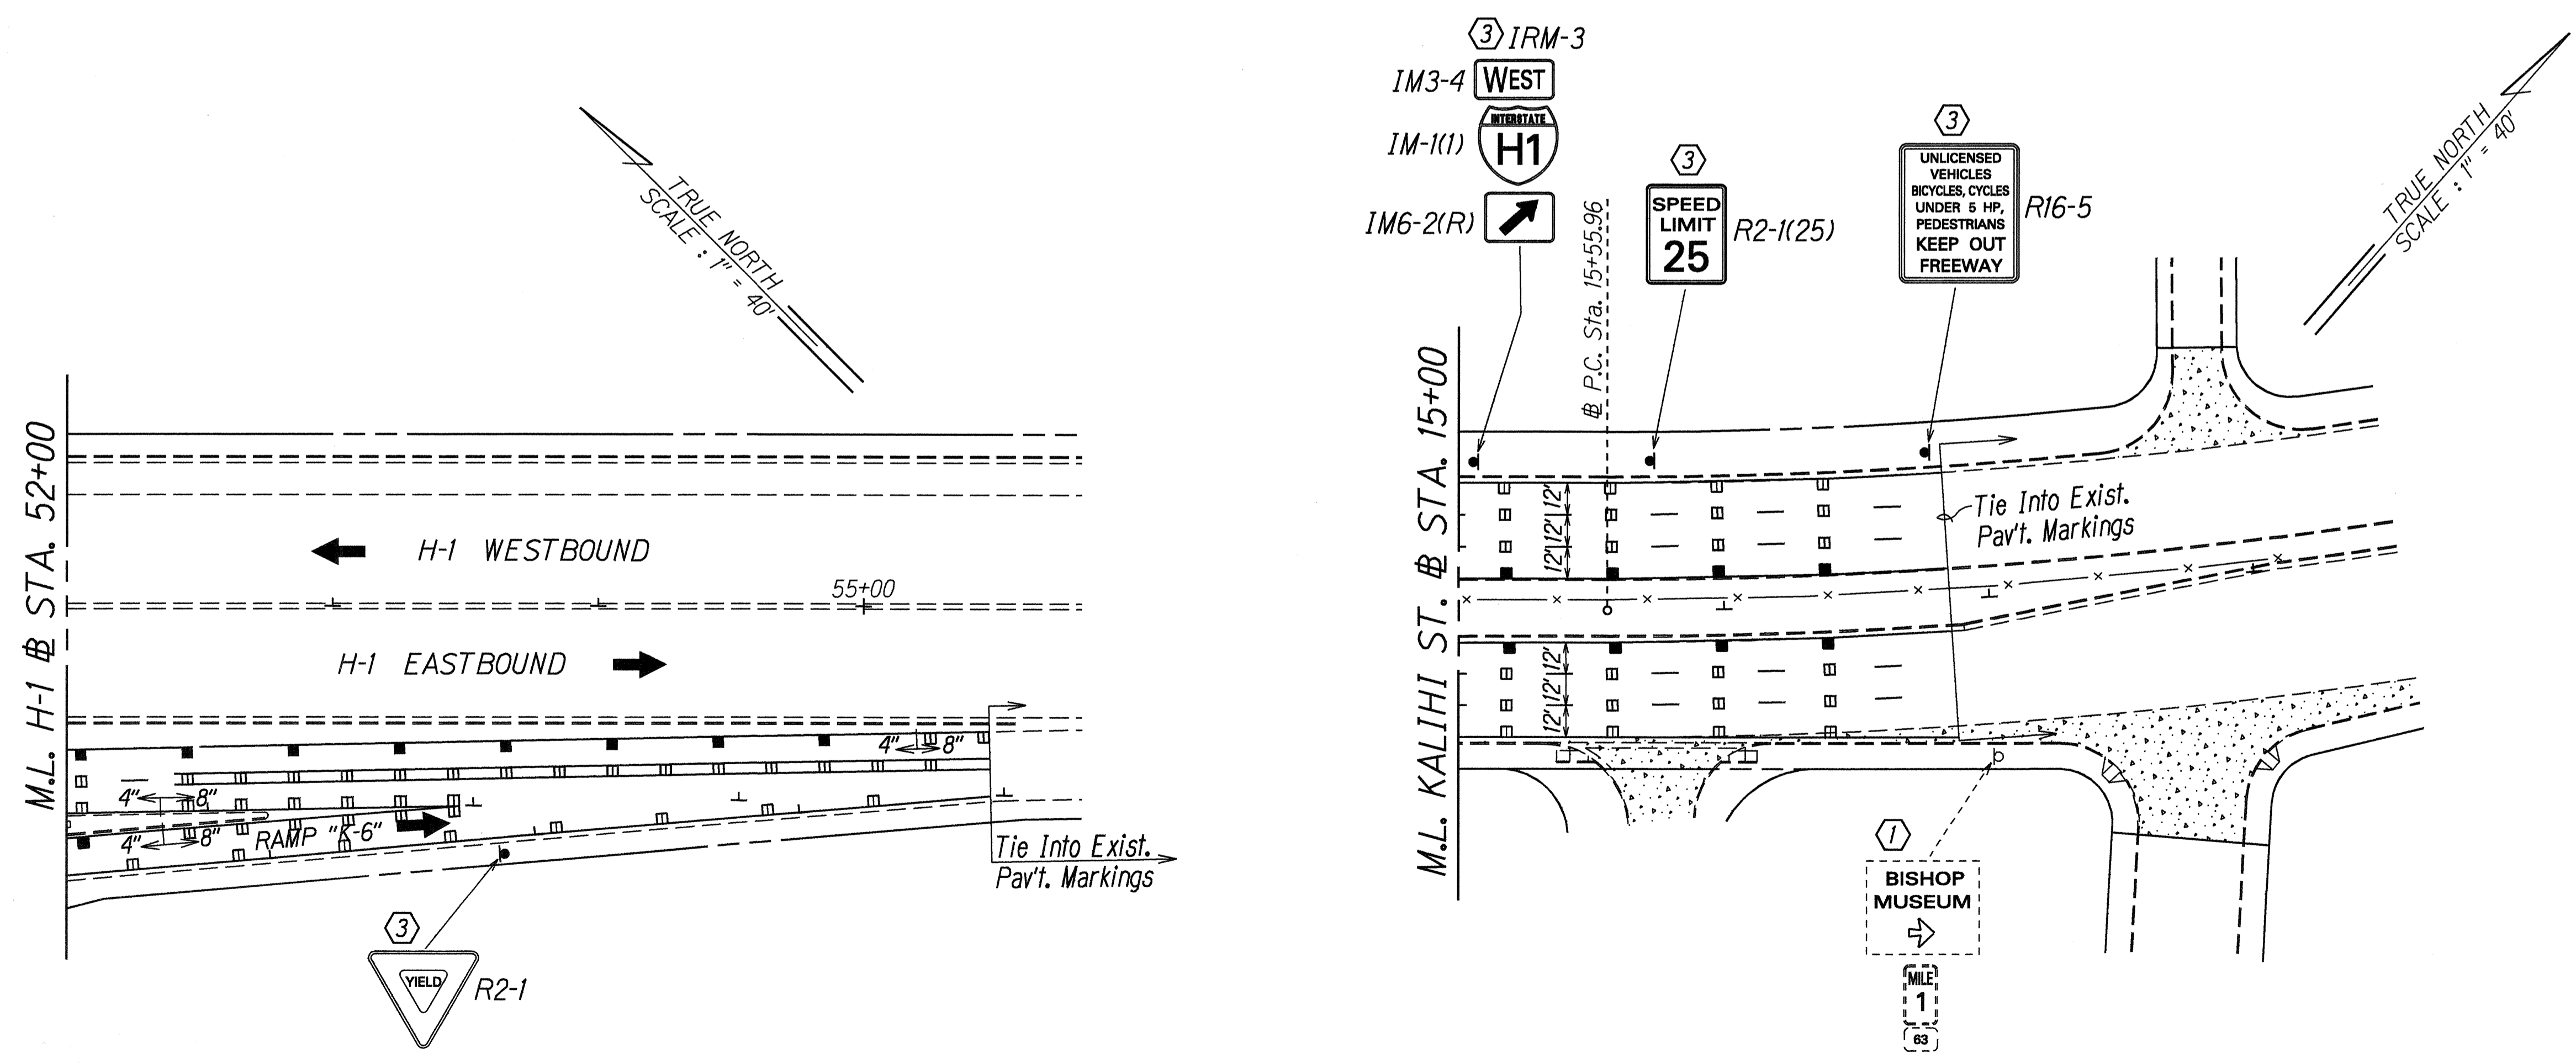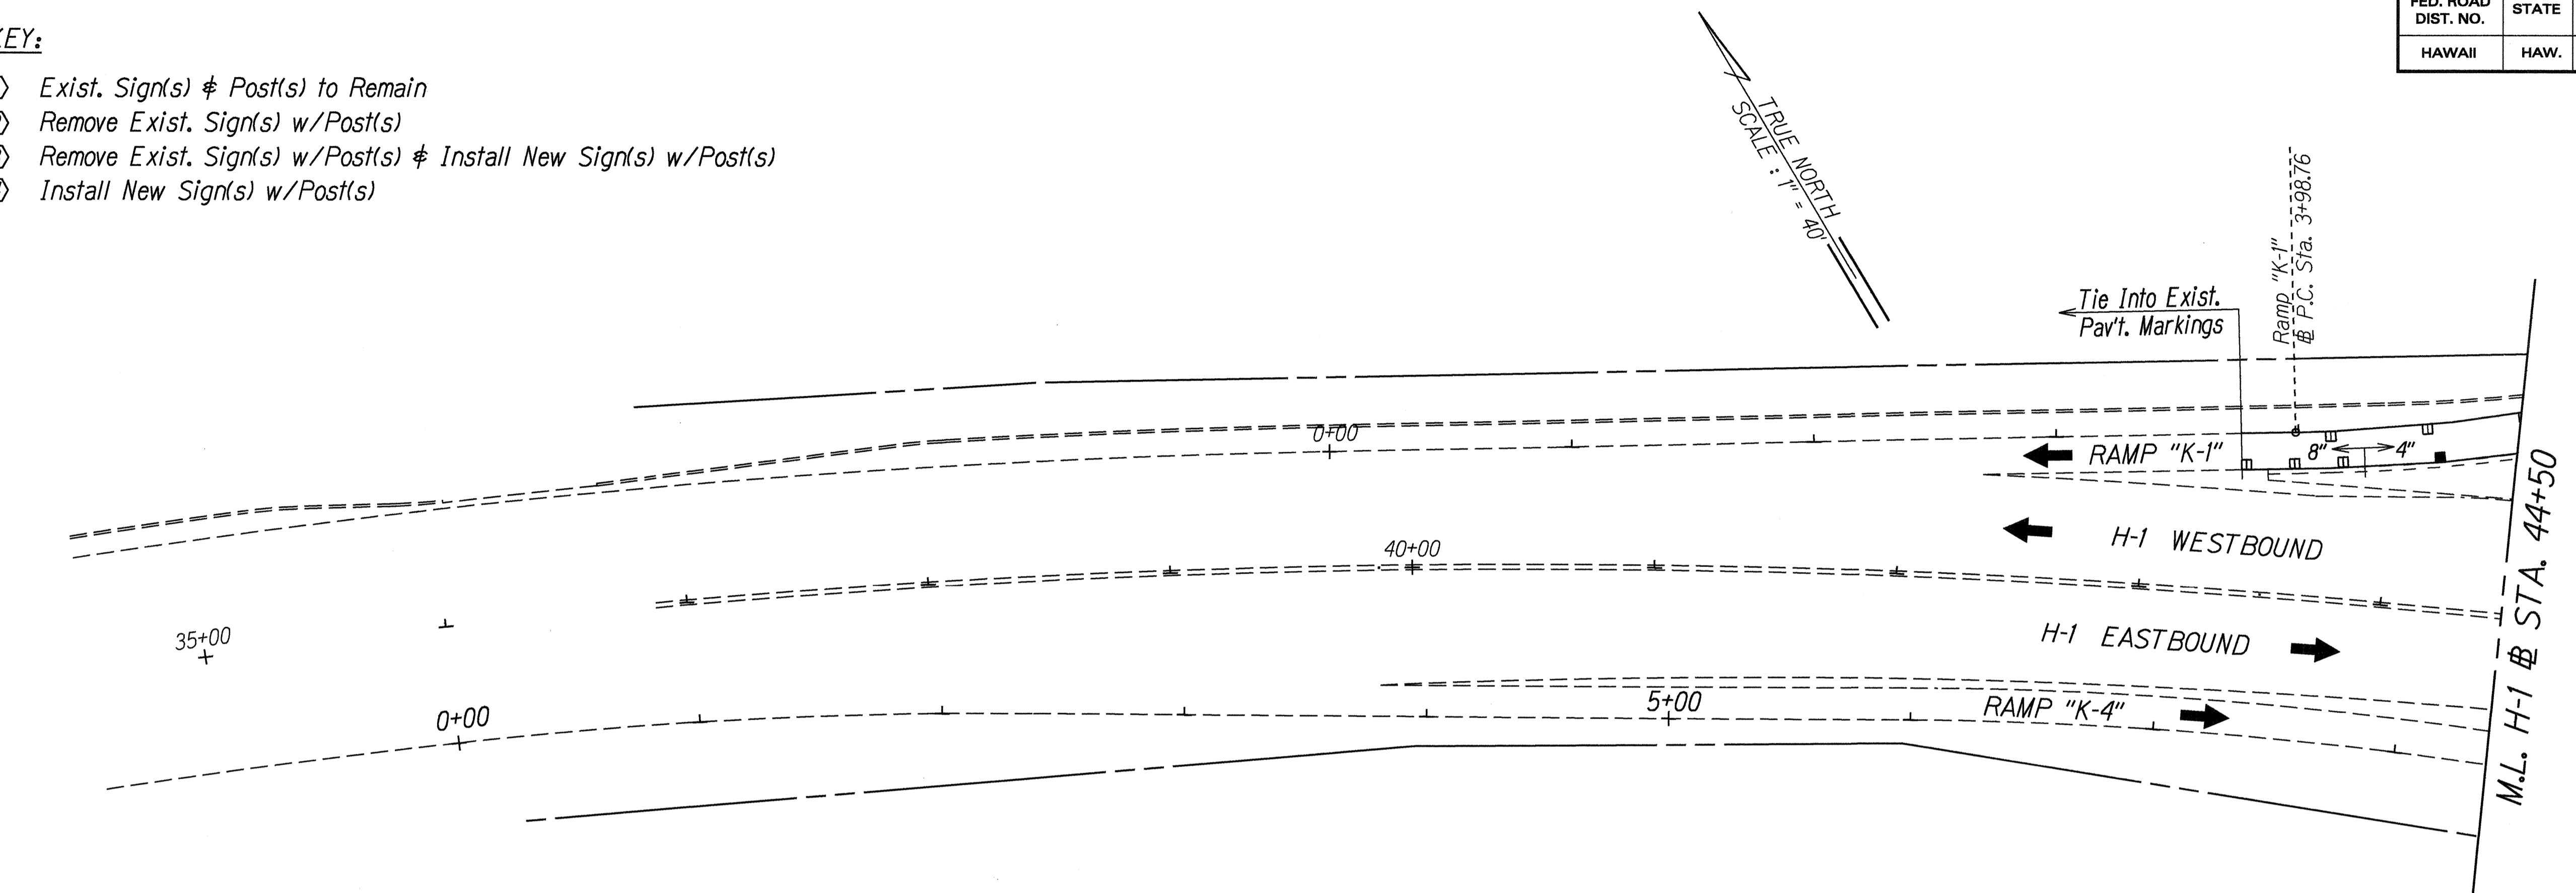

SURVEY PLOTTED BY	DATE
DRAWN BY	4/15/95
NOTE BOOK	
QUANTITIES BY	
CHECKED BY	
No.	

STATE OF HAWAII
DEPARTMENT OF TRANSPORTATION
HIGHWAYS DIVISION

PAVEMENT MARKING & SIGNING PLAN

*KALIHI STREET RESURFACING
Dillingham Blvd. to School St.
Including Interchange On/Off Ramps
Fed. Aid Proj. No. STP-063-1(20)*

Scale: 1" = 40' Date: Apr., 1995

SHEET No. 74 OF 7 SHEETS