


INDEX TO DRAWINGS	
SHEET NO.	DESCRIPTION
1	TITLE SHEET
2	STANDARD PLANS SUMMARY
3	GENERAL NOTES
4	LEGEND
5 - 8	TYPICAL SECTIONS
① 9 - 18	DETAILS
19 - 20	SCHEDULES
21 - 25	PLANS - Proj. No. NH-063-1(19)
26 - 29	PLANS - Proj. No. STP-063-1(20)
30 - 39	KALIHI STREAM BRIDGE
40 - 58	KALIHI INTERCHANGE
59	DRAINAGE PLAN
② 60	DRAINAGE DETAILS
F.A. Project No.: NH-063-1(19)	
61	PAVEMENT MARKING LEGEND, DETAILS & NOTES
③ 62 - 66	PAVEMENT MARKING & SIGNING PLAN
67	SIGN PANEL LAYOUT & NOTES
68	DETAILS
69	MISCELLANEOUS TRAFFIC SUMMARIES
F.A. Project No.: STP-063-1(20)	
70	PAVEMENT MARKING LEGEND, DETAILS & NOTES
71 - 74	PAVEMENT MARKING & SIGNING PLAN
75	DETAILS
76	TRAFFIC SUMMARIES
F.A. Project Nos.: NH-063-1(19) & STP-063-1(20)	
77	LOOP DETECTOR DETAILS
④ 78	NPDES GENERAL NOTES



Plan sht. Nos. ①ADD.13S-1, C.O.13S-2, ②C.O.60S-1 through C.O.60S-6, ③C.O.66S-1 and ④C.O.78S-1 are supplementary sheets to this project. TOTAL SHEET COUNT after "AS-BUILT" postings 88 Sheets.

DESIGNED BY JULIUS B. FRONDA
P.S. & E. BY
HWY-DD/UNIT A
MAY 1995
DATE
587-2246
PHONE

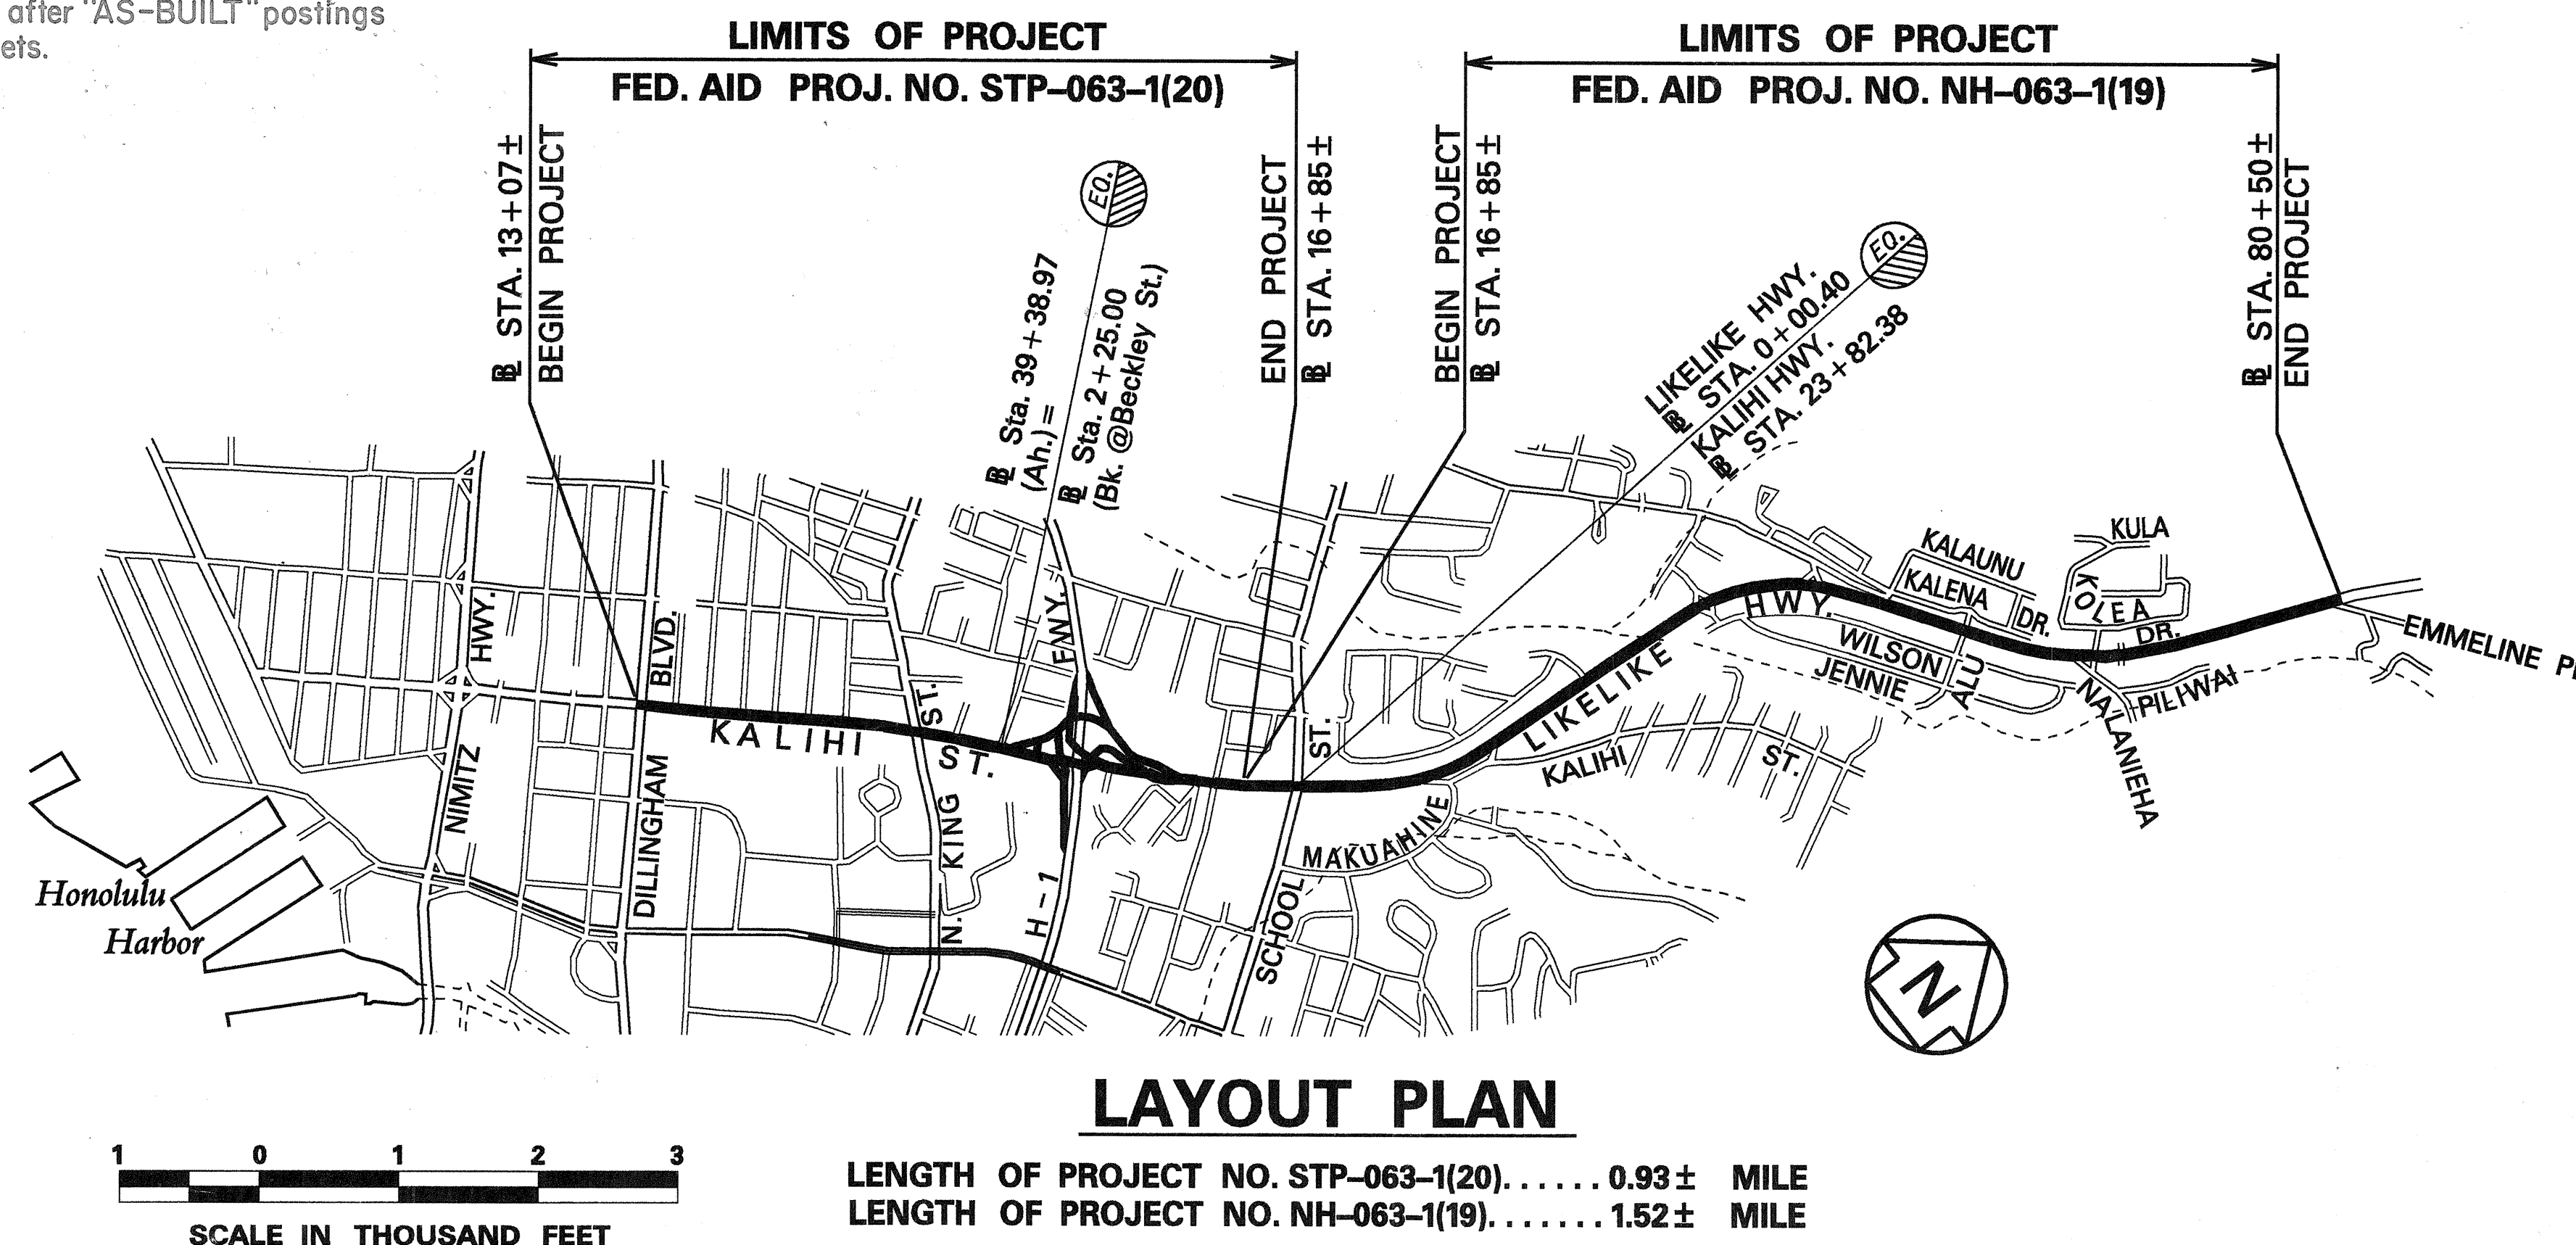

STATE OF HAWAII
DEPARTMENT OF TRANSPORTATION
HIGHWAYS DIVISION
HONOLULU, HAWAII
"AS-BUILT"
PLANS FOR
LIKELIKE HIGHWAY RESURFACING
SCHOOL STREET TO EMMELINE PLACE
FEDERAL AID PROJECT NO. NH-063-1(19)
DISTRICT OF HONOLULU
ISLAND OF OAHU
AND
KALIHI STREET RESURFACING
DILLINGHAM BLVD. TO SCHOOL ST.
INCLUDING INTERCHANGE ON/OFF RAMP
FEDERAL AID PROJECT NO. STP-063-1(20)
DISTRICT OF HONOLULU
ISLAND OF OAHU

FED. ROAD DIST. NO.	STATE	FED. AID PROJ. NO.	FISCAL YEAR	SHEET NO.	TOTAL SHEETS
HAWAII	HAW.	NH-063-1(19) STP-063-1(20)	1995	1	78

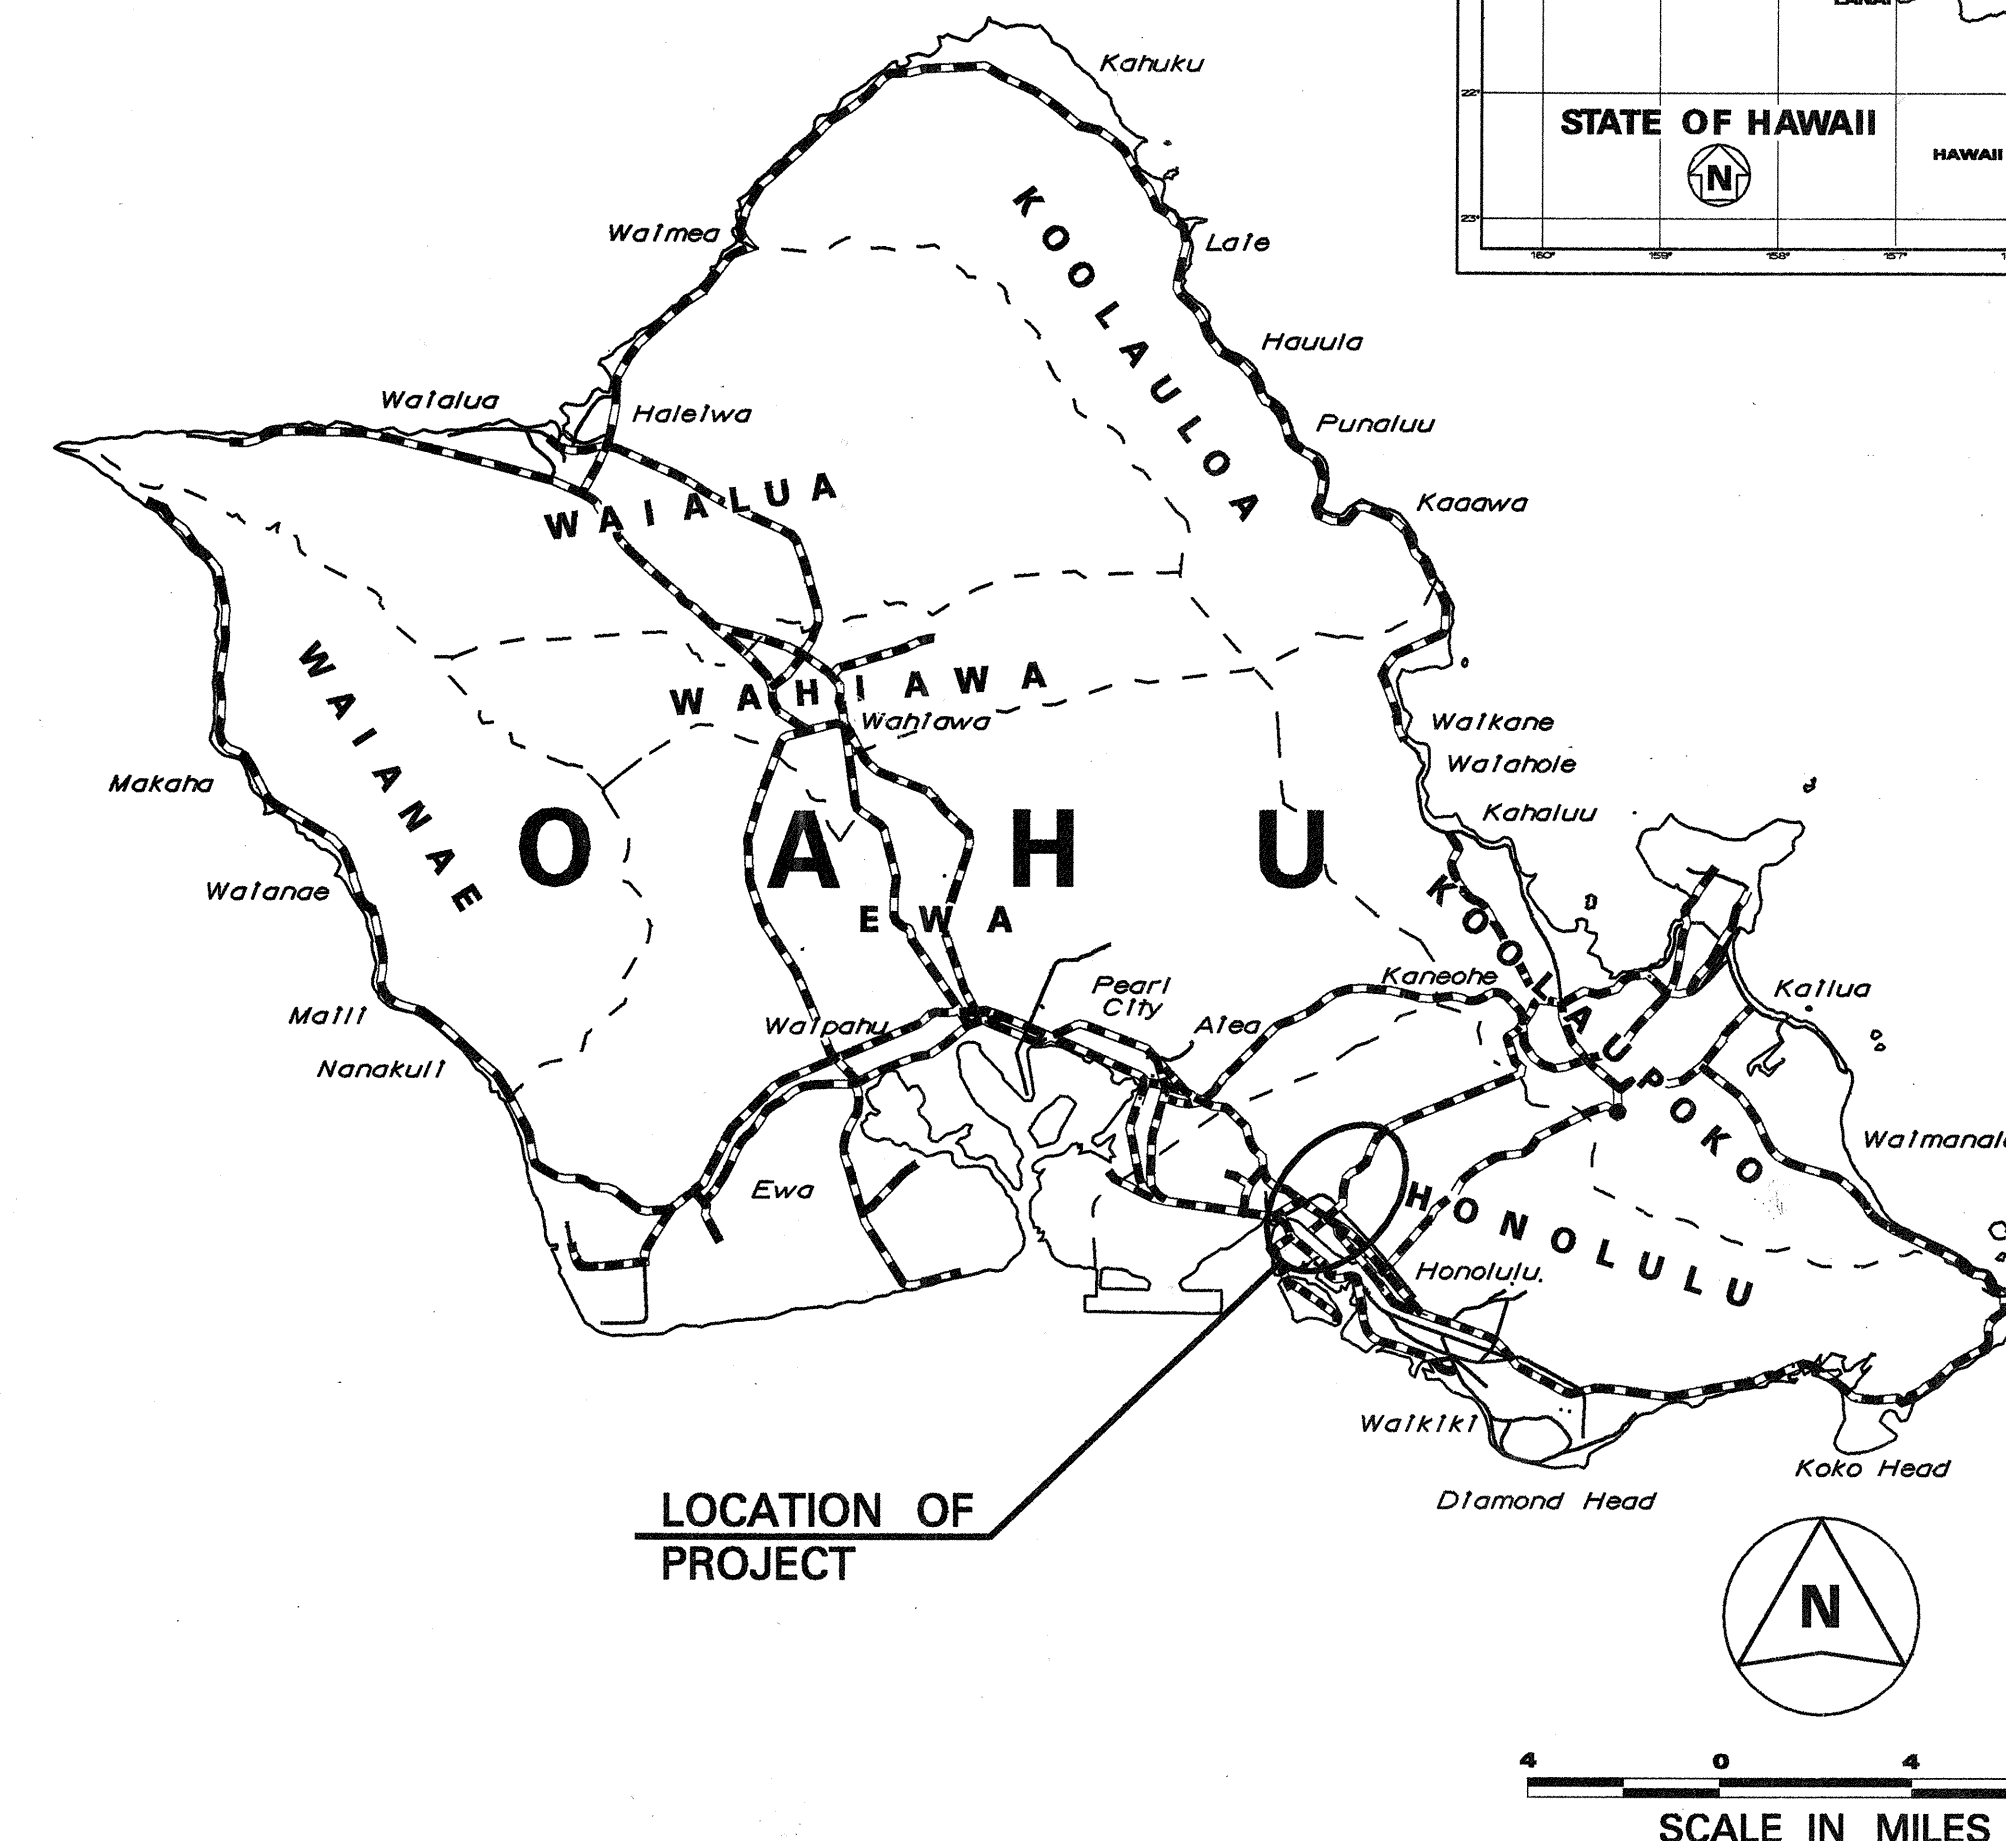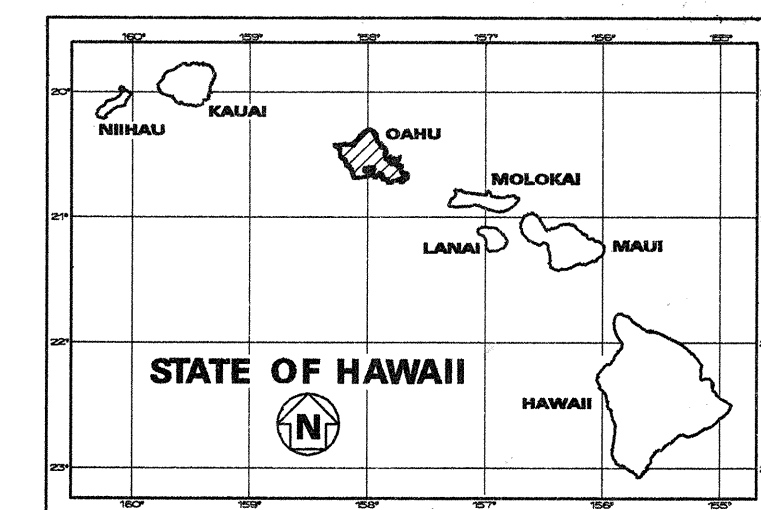

----- FEDERAL AID PROJECTS PREVIOUSLY CONSTRUCTED OR UNDER CONSTRUCTION

MILE POST .22 TO MILE POST 1.15 [STP-063-1(20)]
MILE POST 1.15 TO MILE POST 2.67 [NH-063-1(19)]

DESIGN DESIGNATION

LIKELIKE HIGHWAY	KALIHI STREET
ADT (1995)..... 71,200	ADT (1995)..... 79,200
ADT (2005)..... 95,400	ADT (2005)..... 91,710
DHV..... 6,700	DHV..... 7,010
D..... 75/25	D..... 70/30
T..... 4.5 %	T..... 4.5 %

CHANGES MADE DURING CONSTRUCTION HAVE BEEN INCORPORATED ON THESE PLANS EXCEPT CHANGES IN THE ORIGINAL THEORETICAL QUANTITIES. FOR ACTUAL QUANTITIES, REFER TO PROJECT LEDGER AND/OR COMPUTATION BOOK.
RESIDENT ENGINEER
DATE 4/28/00

DEPARTMENT OF TRANSPORTATION
STATE OF HAWAII
APPROVED:
DIR. OF TRANSPORTATION
DATE 4/9/95