



FED. ROAD DIST. NO.	STATE	FED. AID PROJ. NO.	FISCAL YEAR	TOTAL SHEETS
HAWAII	HAW.	STP-0300(66)	1998	811

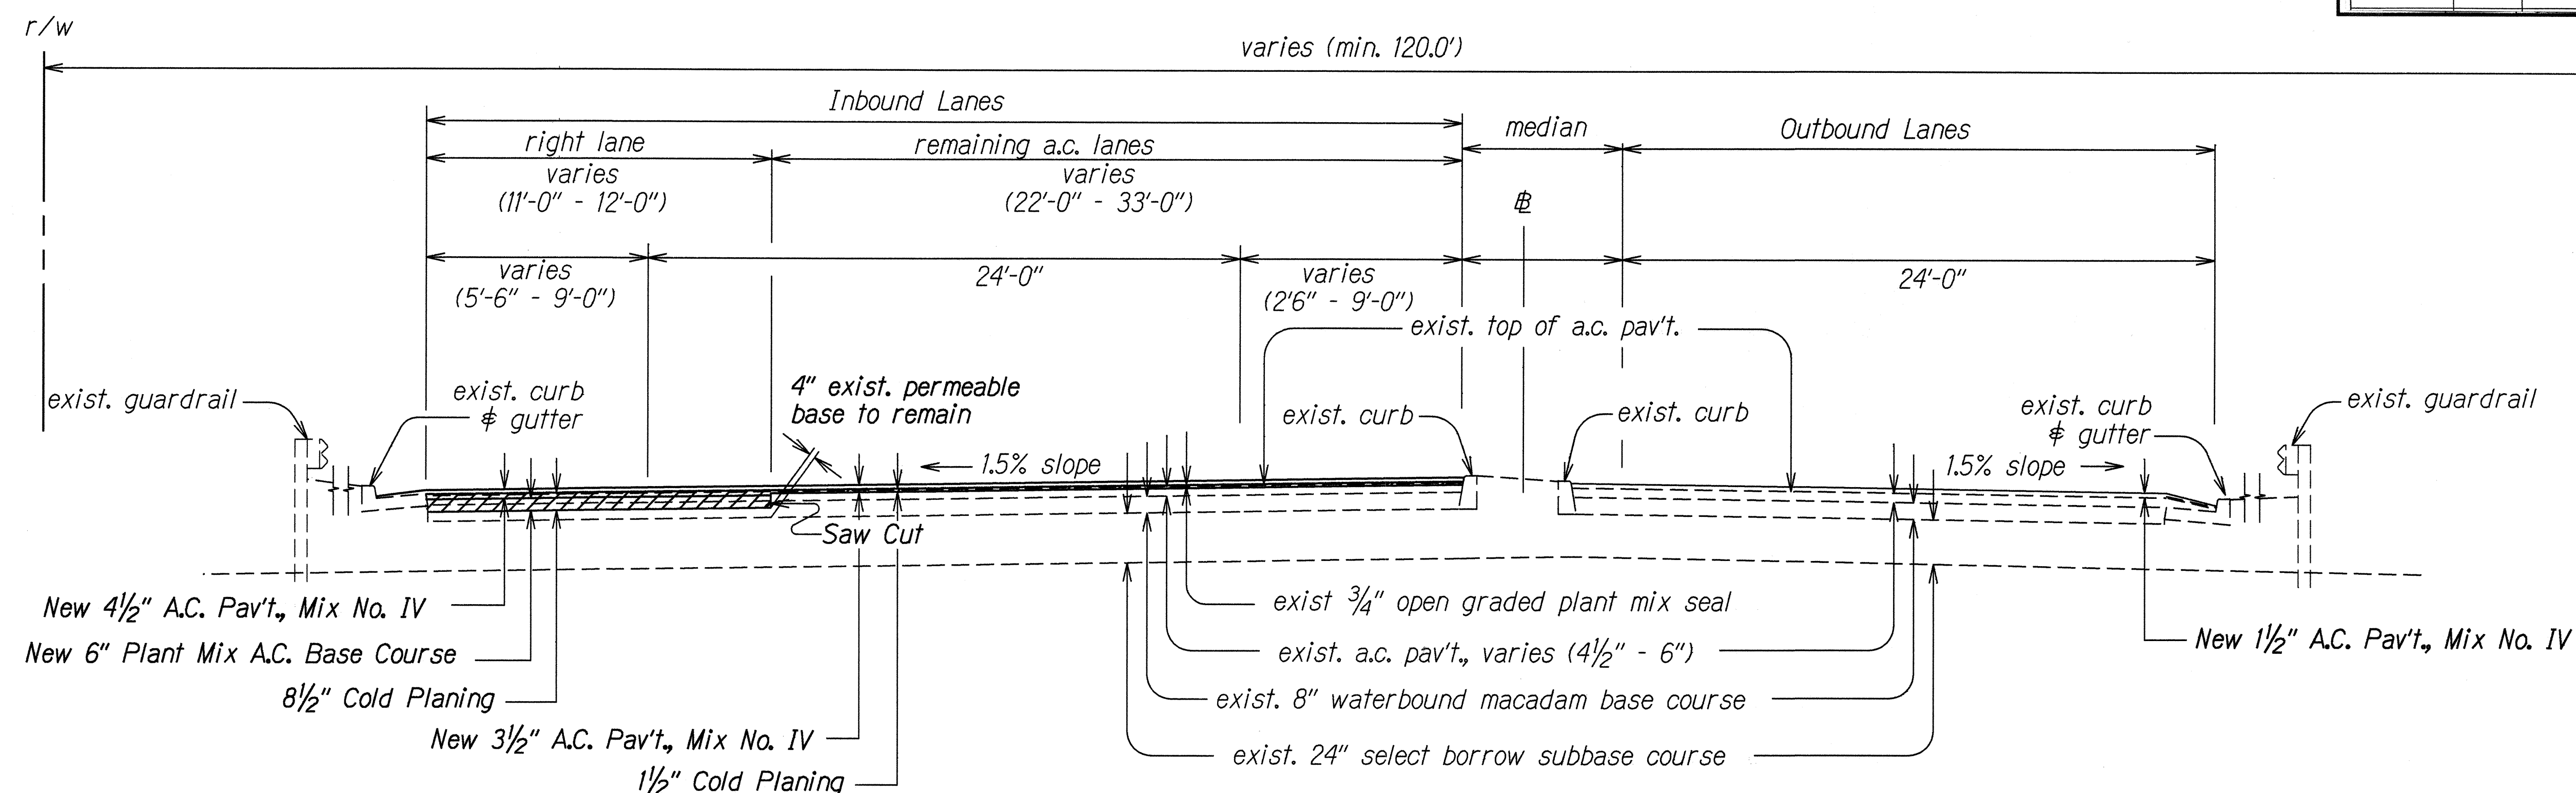

**TYPICAL SECTION ON TANGENT
LIKELIKE HIGHWAY**

Scale: 1/4" = 1'

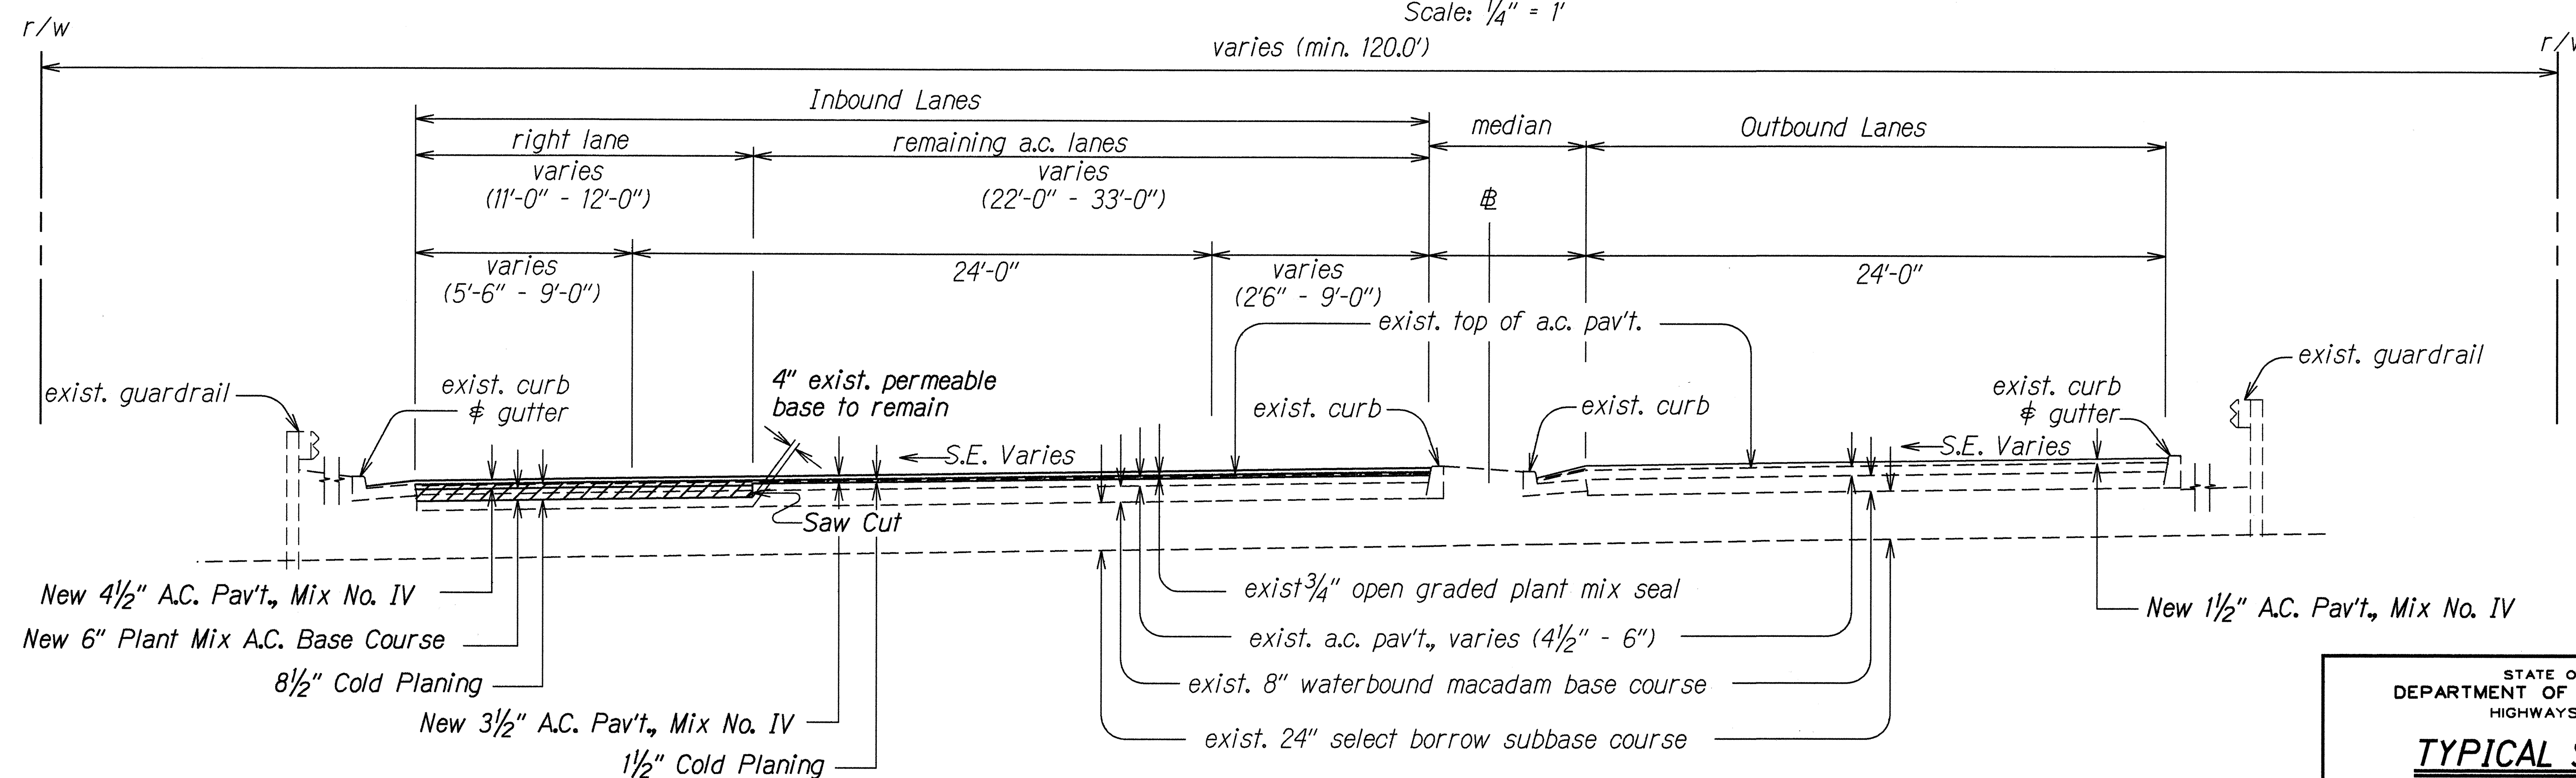

**TYPICAL SECTION ON CURVE
LIKELIKE HIGHWAY**

Scale: 1/4" = 1'


* Note: For Thickness, See Schedule on Plan Sht. No. 20

SURVEY PLOTTED BY	DATE	6/16/95
DRAWN BY		
DESIGNED BY		
QUANTITIES BY		
CHECKED BY		
ORIGINAL PLAN		
NOTE BOOK		
admm		
N-211015/150		

6/21/95	Delete Open Graded Plant Mix Seal from Outbound Lanes.
DATE	REVISION

STATE OF HAWAII DEPARTMENT OF TRANSPORTATION HIGHWAYS DIVISION
TYPICAL SECTIONS
LIKELIKE HIGHWAY RESURFACING
F.A. Project No. NH-063-1(119)
KALIHI STREET RESURFACING
F.A. Project No. STP-063-1(20)
Date: May, 1995
SHEET No. 1 OF 4 SHEETS

FED. ROAD DIST. NO.	STATE	FED. AID PROJ. NO.	FISCAL YEAR	TOTAL SHEETS
HAWAII	HAW.	STP-0300(66)	1998	811

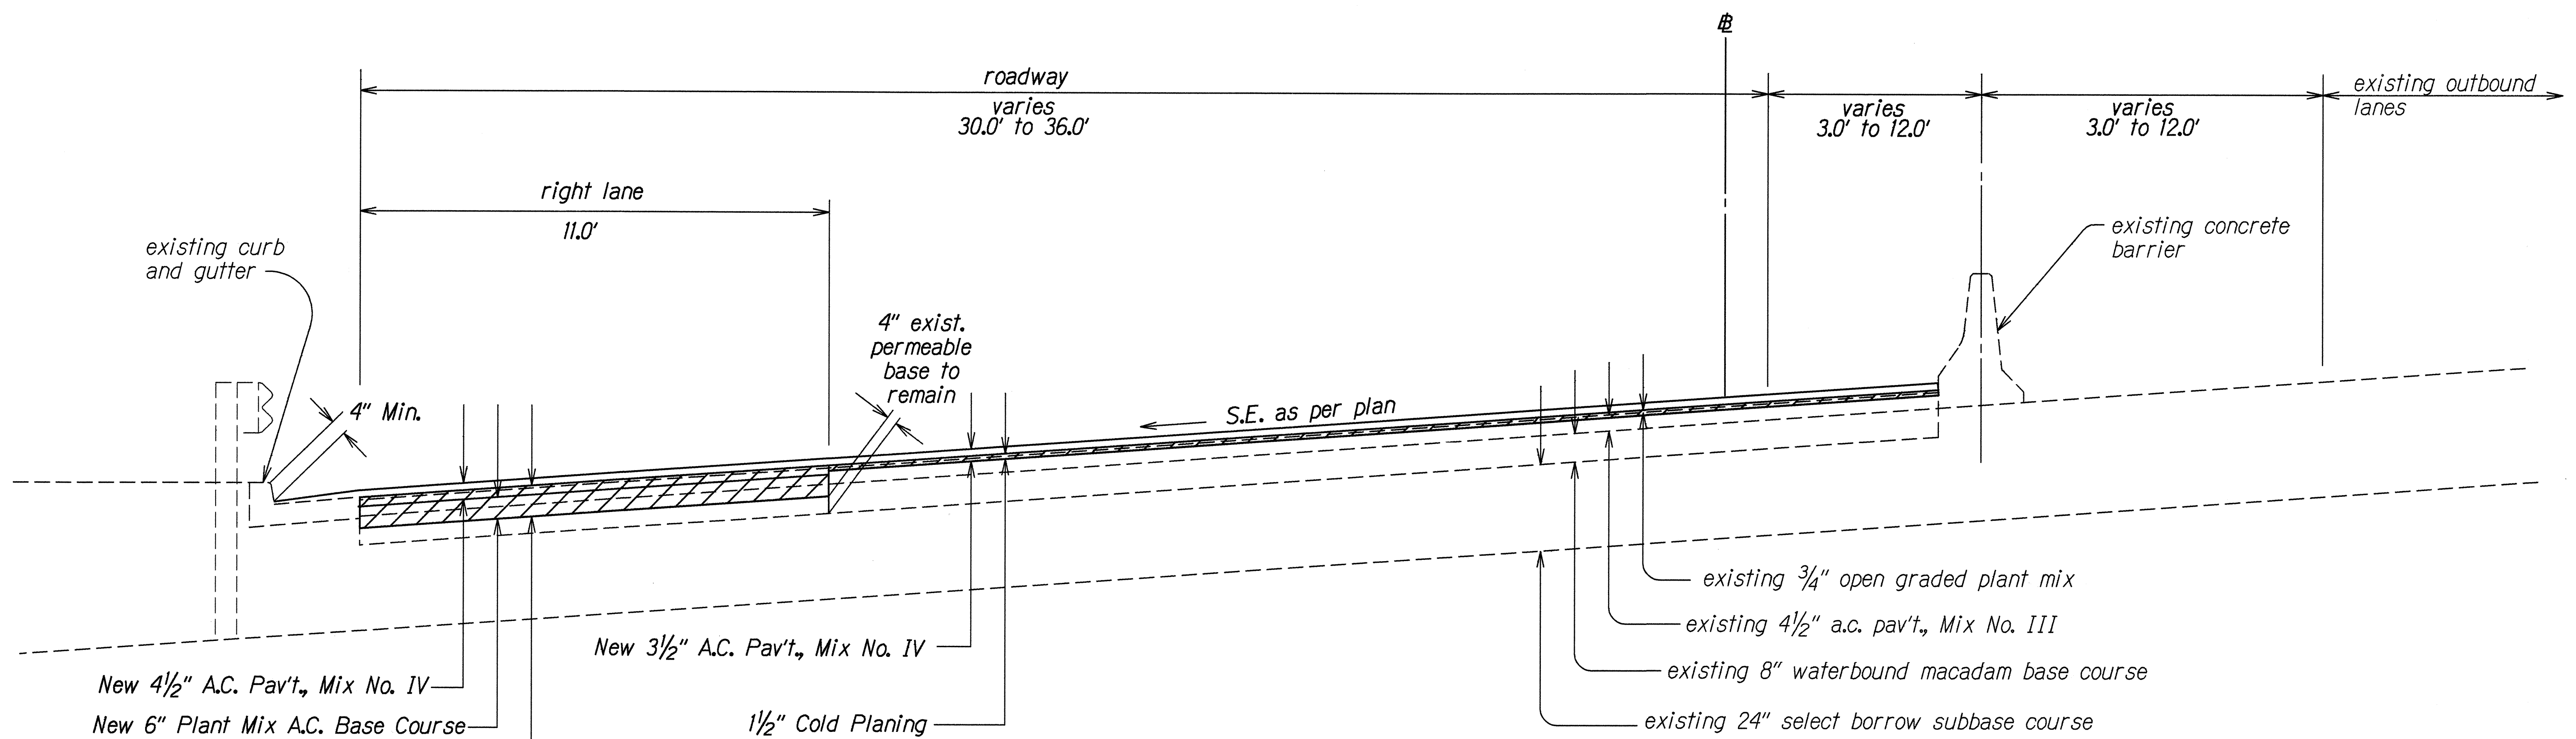

TYPICAL SECTION
LIKELIKE HIGHWAY
STA. 62+15.19 TO STA. 71+71
 Scale: 1/2"=1'-0"

ORIGINAL PLAN	SURVEY PLOTTED BY	DATE
NOTE BOOK	DRAWN BY K. Tanaka	6/21/95
edum	DESIGNED BY J. Franks/L. Yonamine	
QUANTITIES BY	CHECKED BY	
NE/10/2/95		

6/21/95	Set Grade Control: 4" Min. at Left Curb & Gutter
DATE	REVISION

STATE OF HAWAII
 DEPARTMENT OF TRANSPORTATION
 HIGHWAYS DIVISION

TYPICAL SECTION

LIKELIKE HIGHWAY RESURFACING


F.A. Project No. NH-063-1(19)

KALIHI STREET RESURFACING


F.A. Project No. STP-063-1(20)

Scale: As Shown Date: May, 1995

FED. ROAD DIST. NO.	STATE	FED. AID PROJ. NO.	FISCAL YEAR	TOTAL SHEETS
HAWAII	HAW.	STP-0300(66)	1998	811

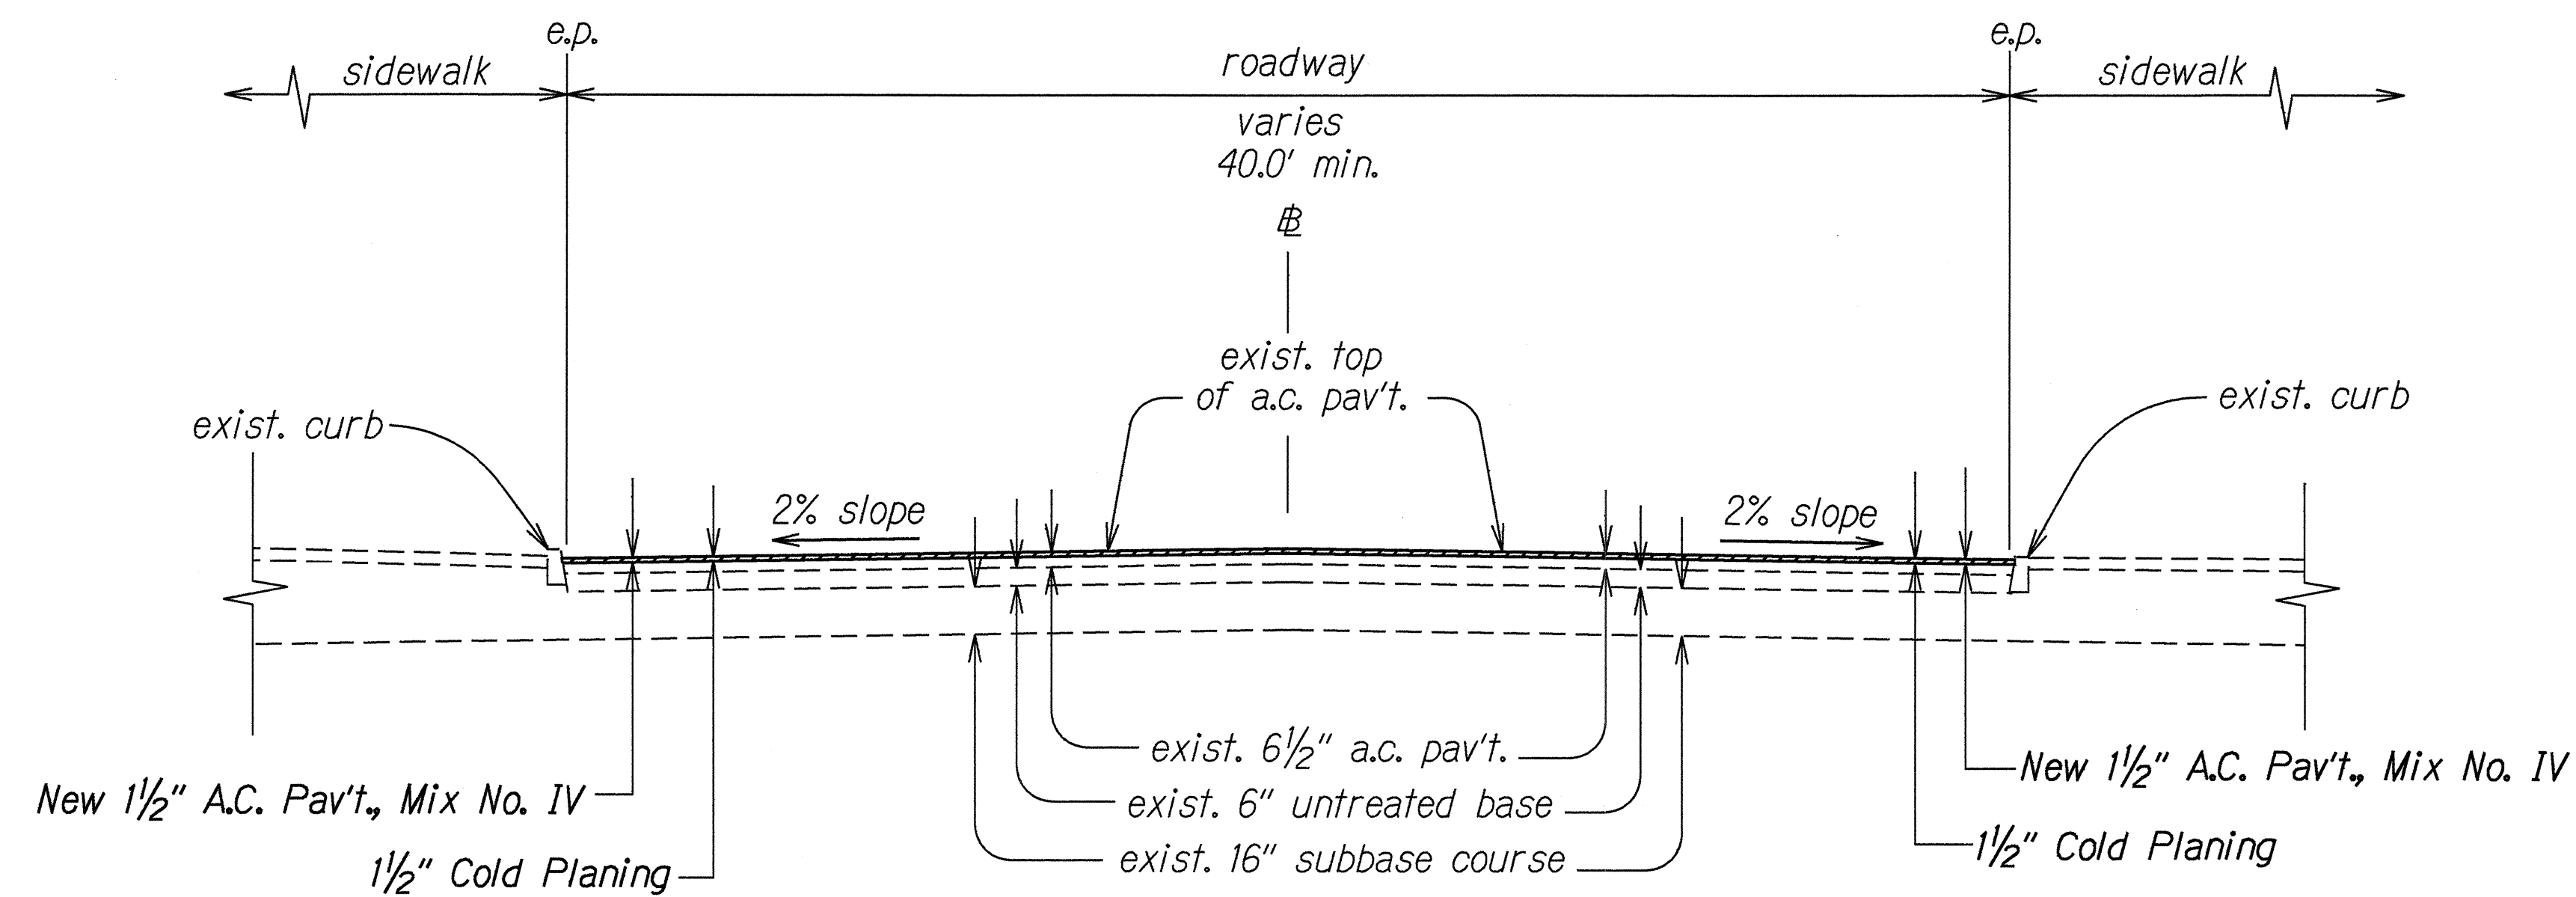

TYPICAL SECTION
KALIHI STREET
Dillingham Boulevard to King Street
 Scale: 1/4" = 1'

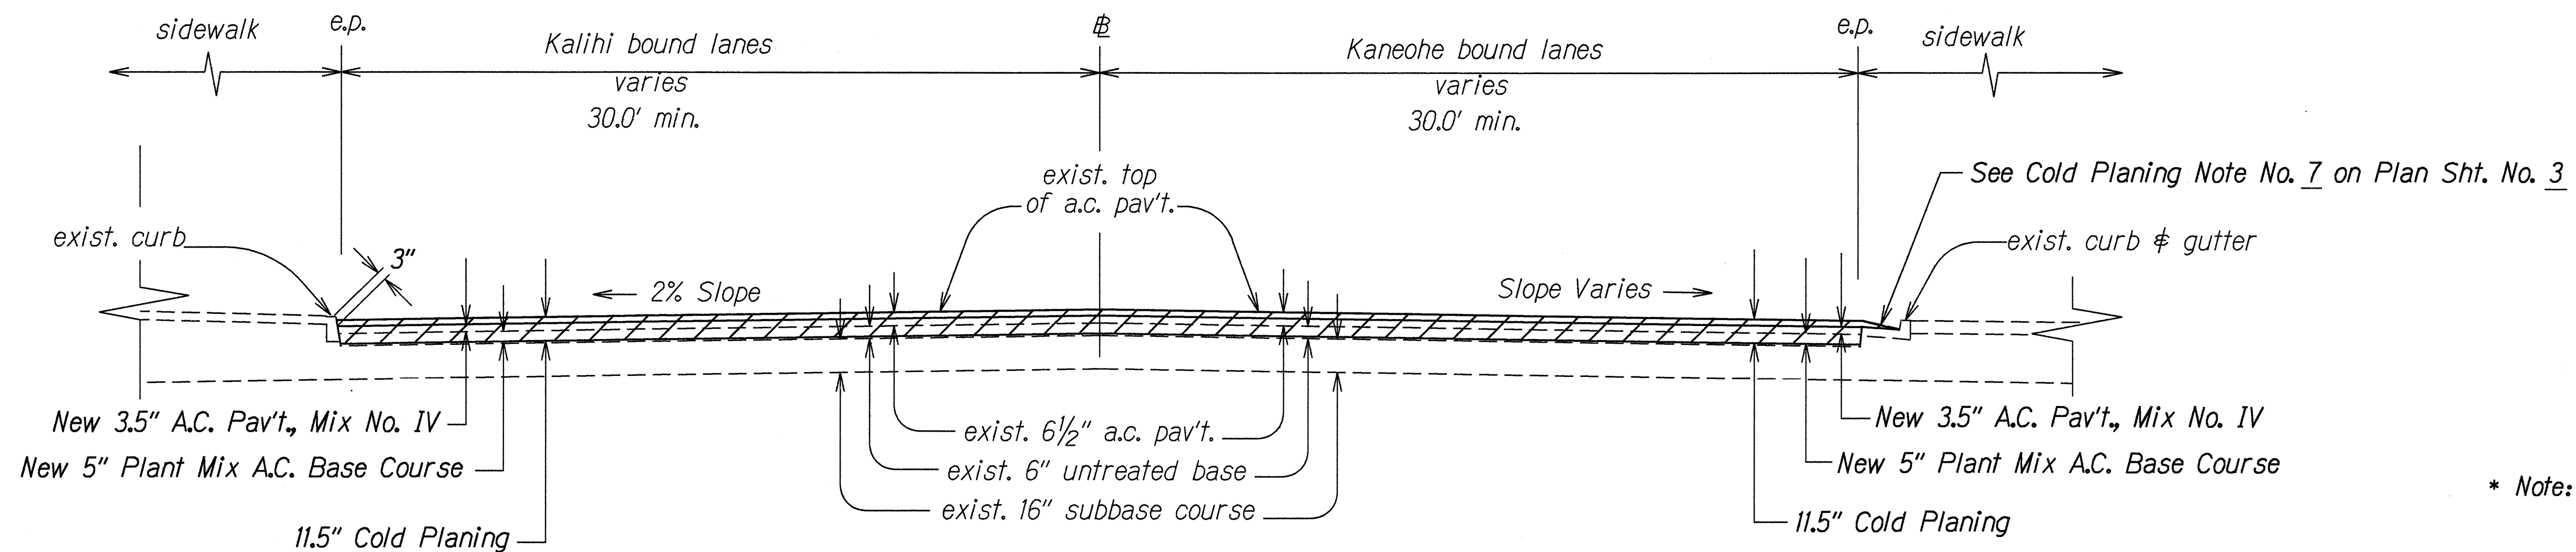

TYPICAL SECTION
KALIHI STREET
King Street to Beckley Street
 Scale: 1/4" = 1'


* Note: For Thickness, See Schedule on Plan Sht. No. 20

SURVEY PLOTTED BY	DATE
DRAWN BY	6/07/95
DESIGNED BY	
CHECKED BY	
NO.	


6/21/95	Set Grade Control for 2nd Typical: 3" at Left Curb
DATE	REVISION

STATE OF HAWAII DEPARTMENT OF TRANSPORTATION HIGHWAYS DIVISION
TYPICAL SECTIONS
LIKELIKE HIGHWAY RESURFACING F.A. Project No. NH-063-1(19)
KALIHI STREET RESURFACING F.A. Project No. STP-063-1(20)
Date: May, 1995
SHEET No. 3 OF 4 SHEETS


FED. ROAD DIST. NO.	STATE	FED. AID PROJ. NO.	FISCAL YEAR	TOTAL SHEETS
HAWAII	HAW.	STP-0300(66)	1998	811

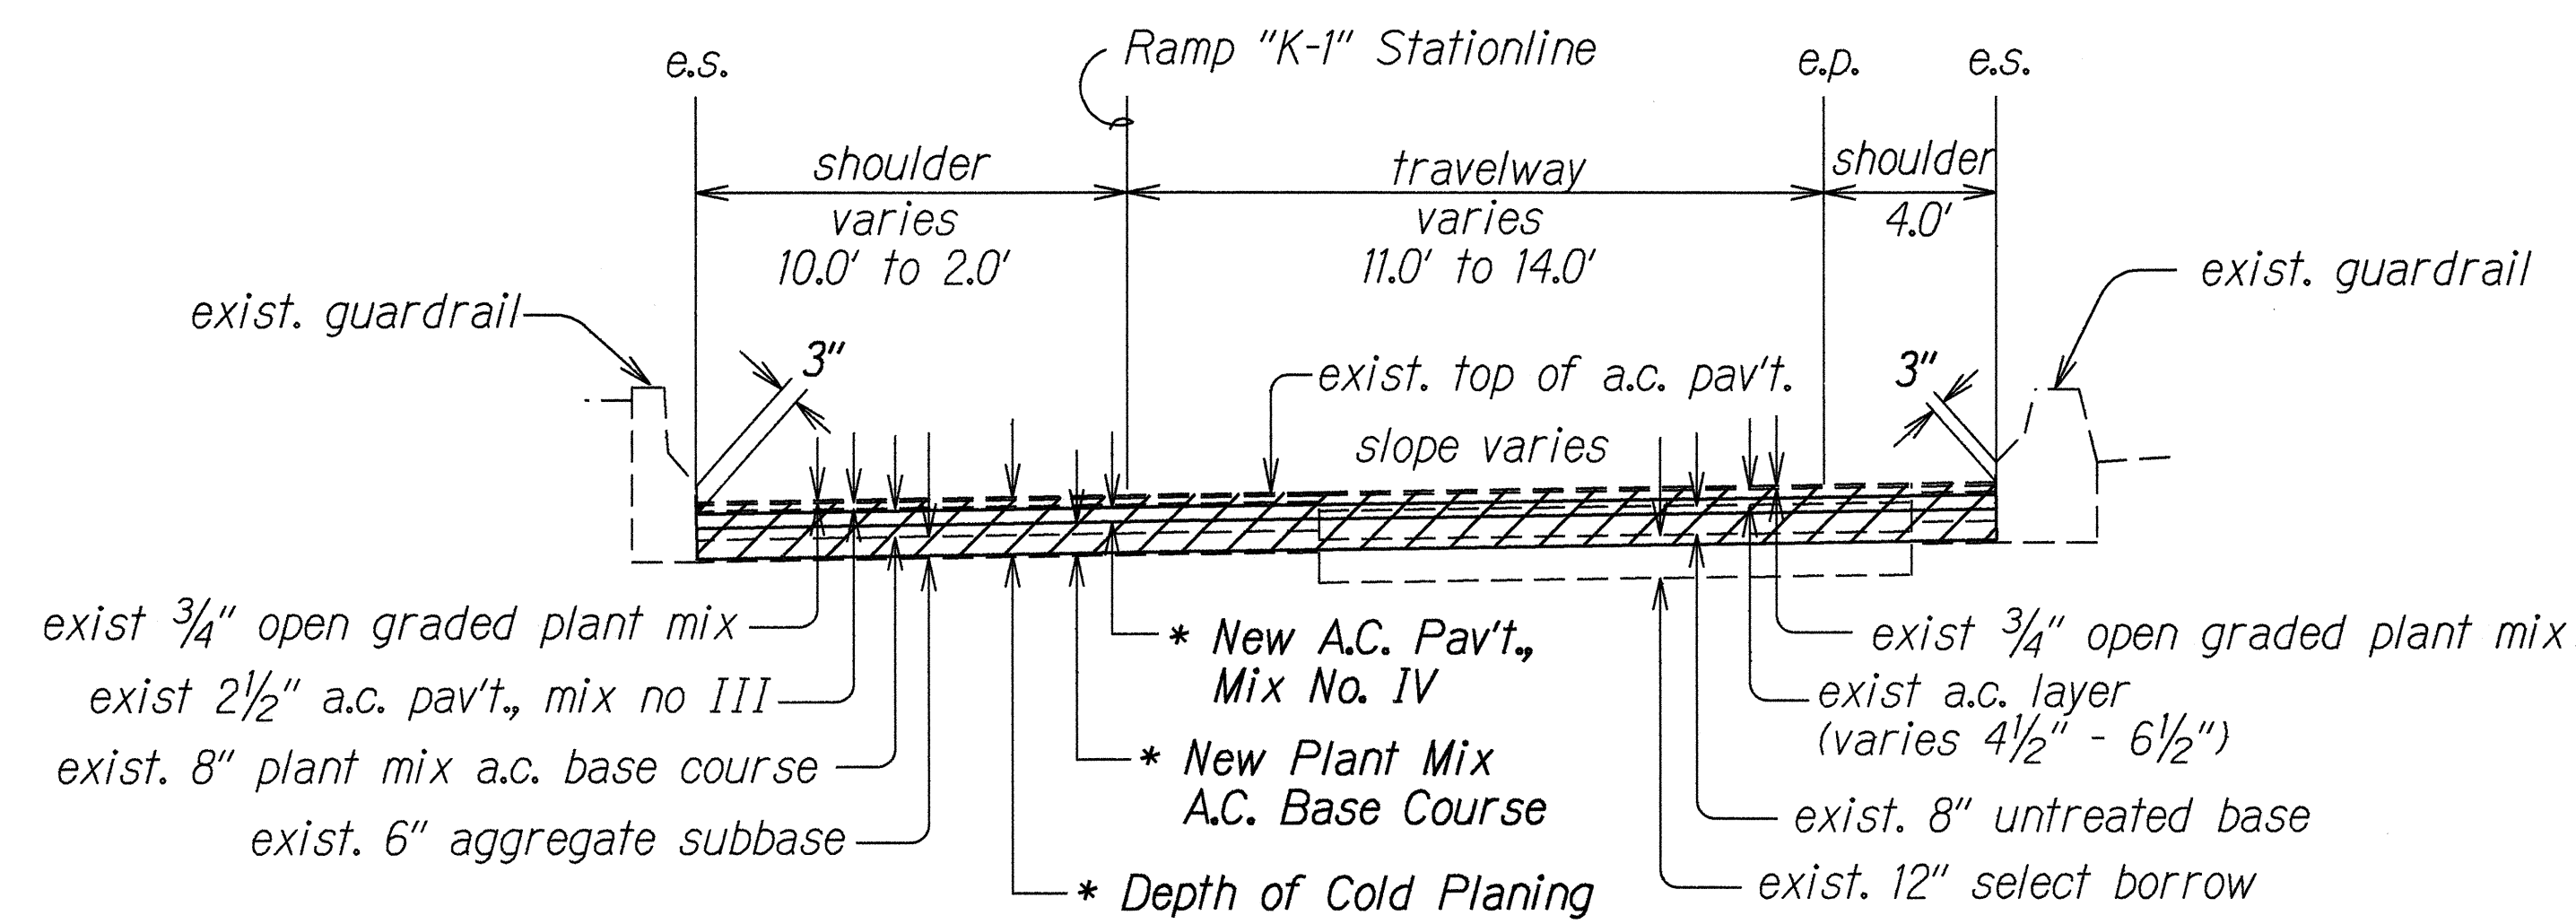


TYPICAL SECTION
Ramp "K-1" - Sta. 4+12± (bk) to Sta. 3+86± (ah)
 Scale: 1/4" = 1'

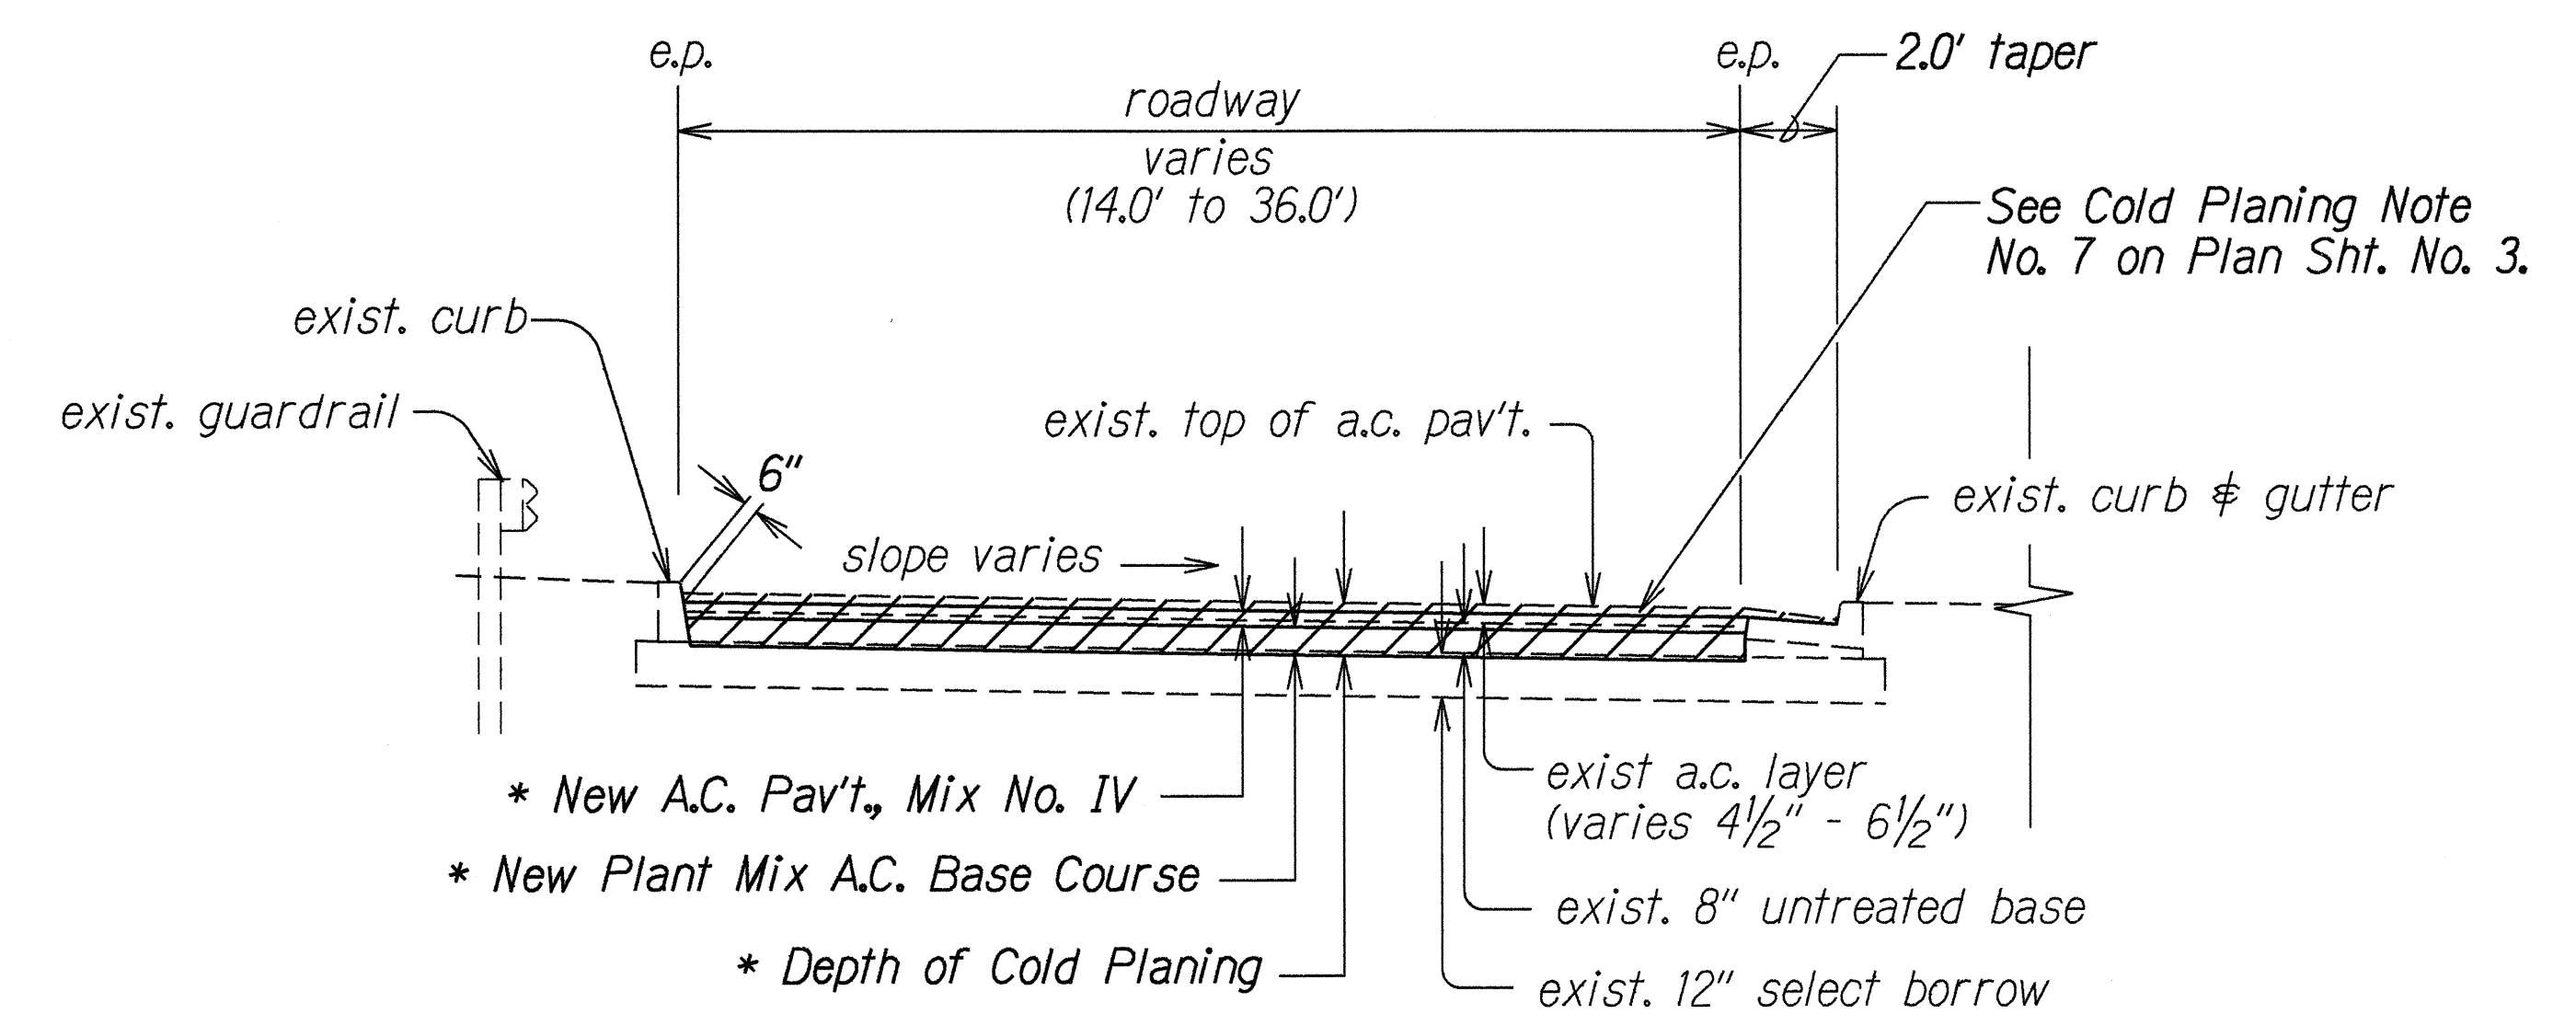

TYPICAL SECTION
Ramps "K-2", "K-1" - Sta. 0+00± (bk) to Sta. 4+12± (bk), and Kalihi Street - Beckley Street to End of Project
 Scale: 1/4" = 1'

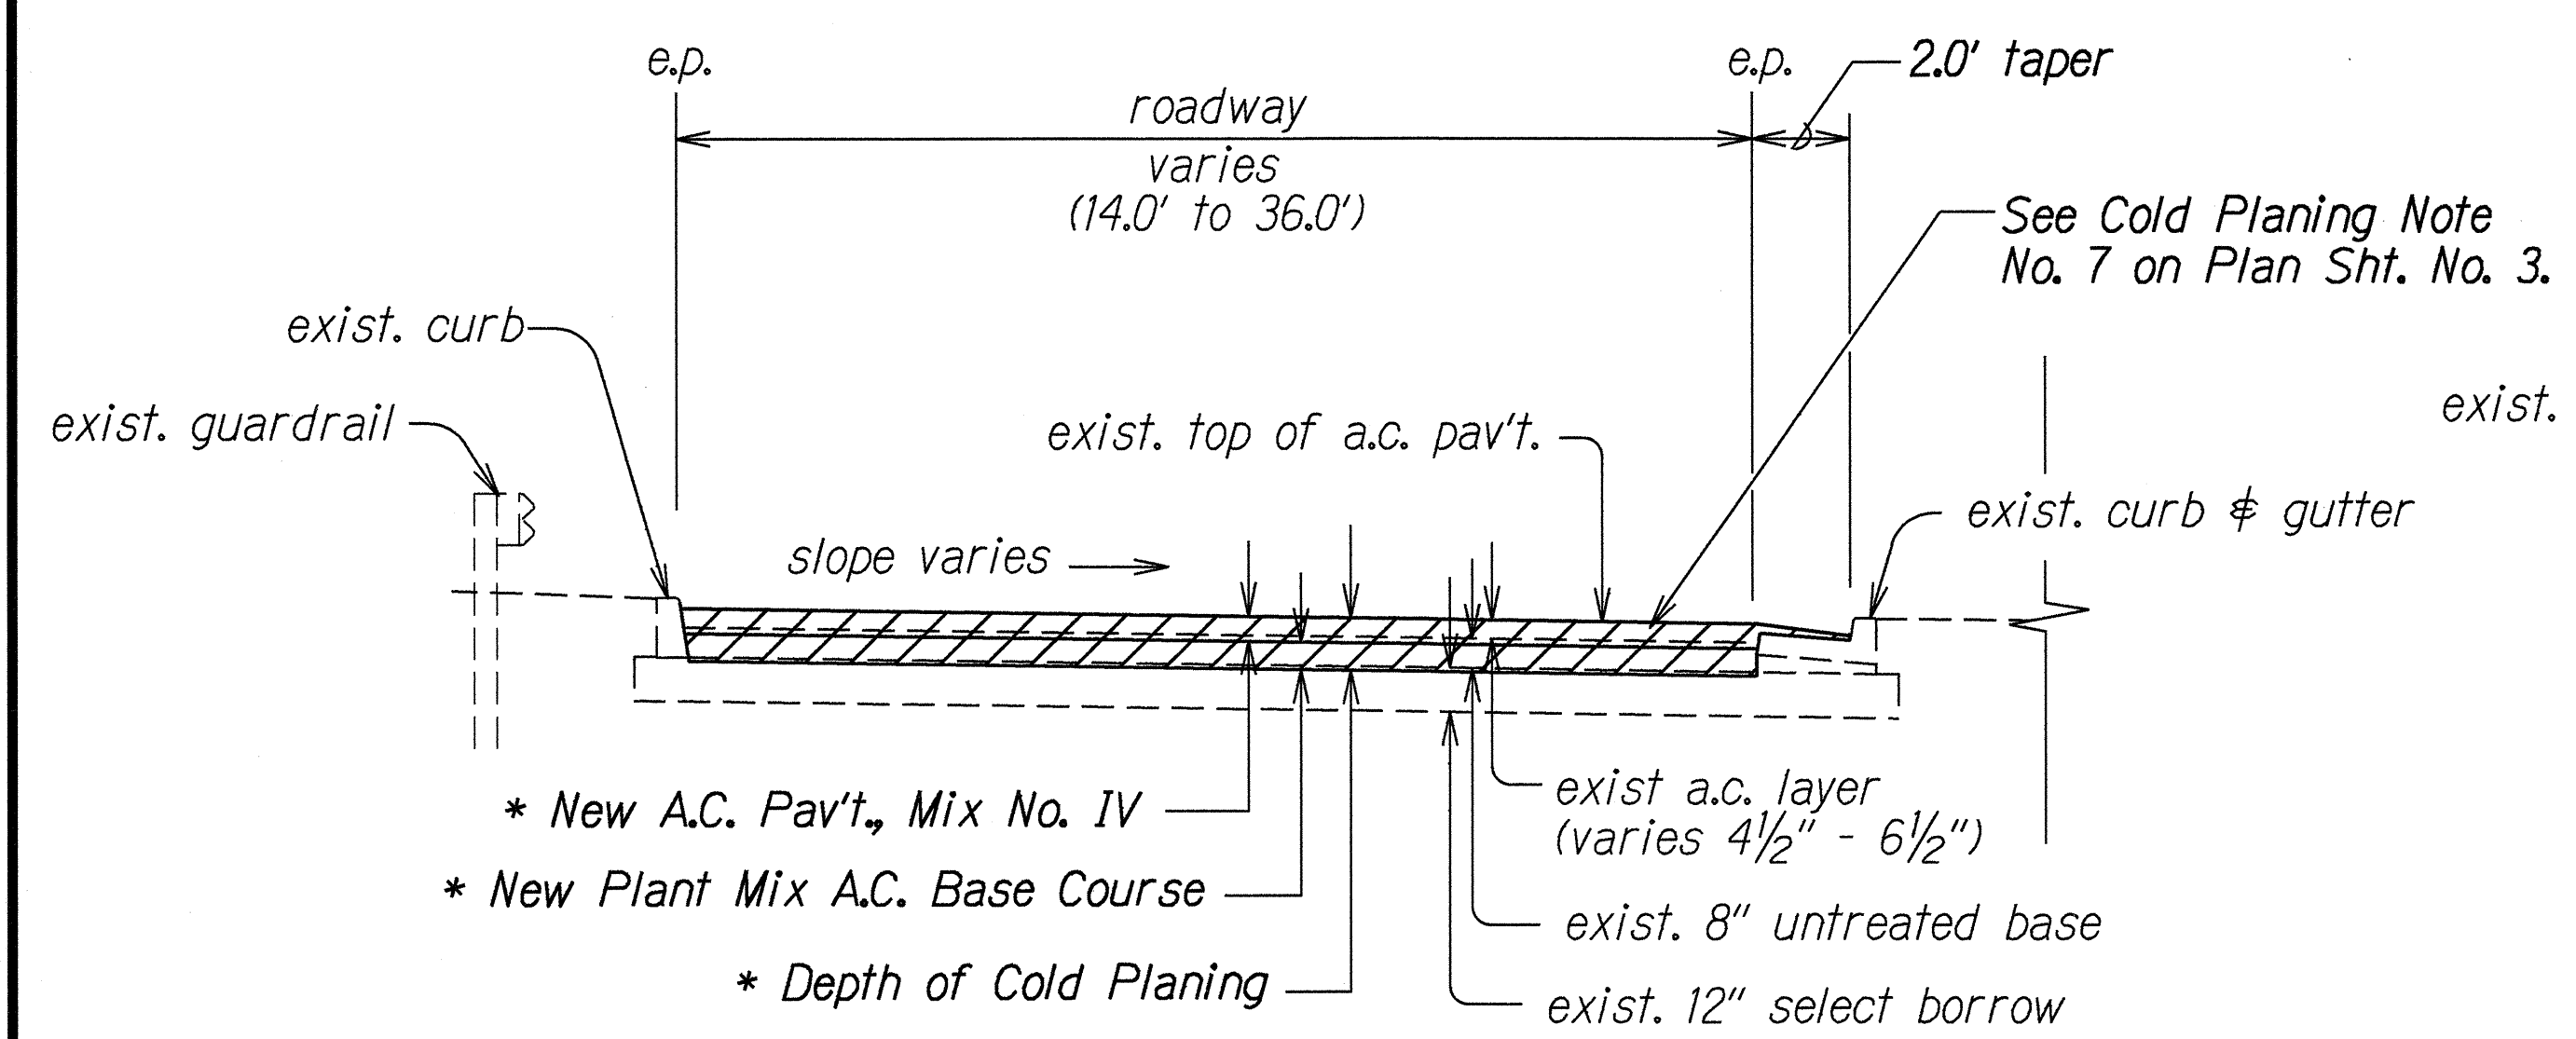

TYPICAL SECTION
Ramp "K-4"
 Scale: 1/4" = 1'

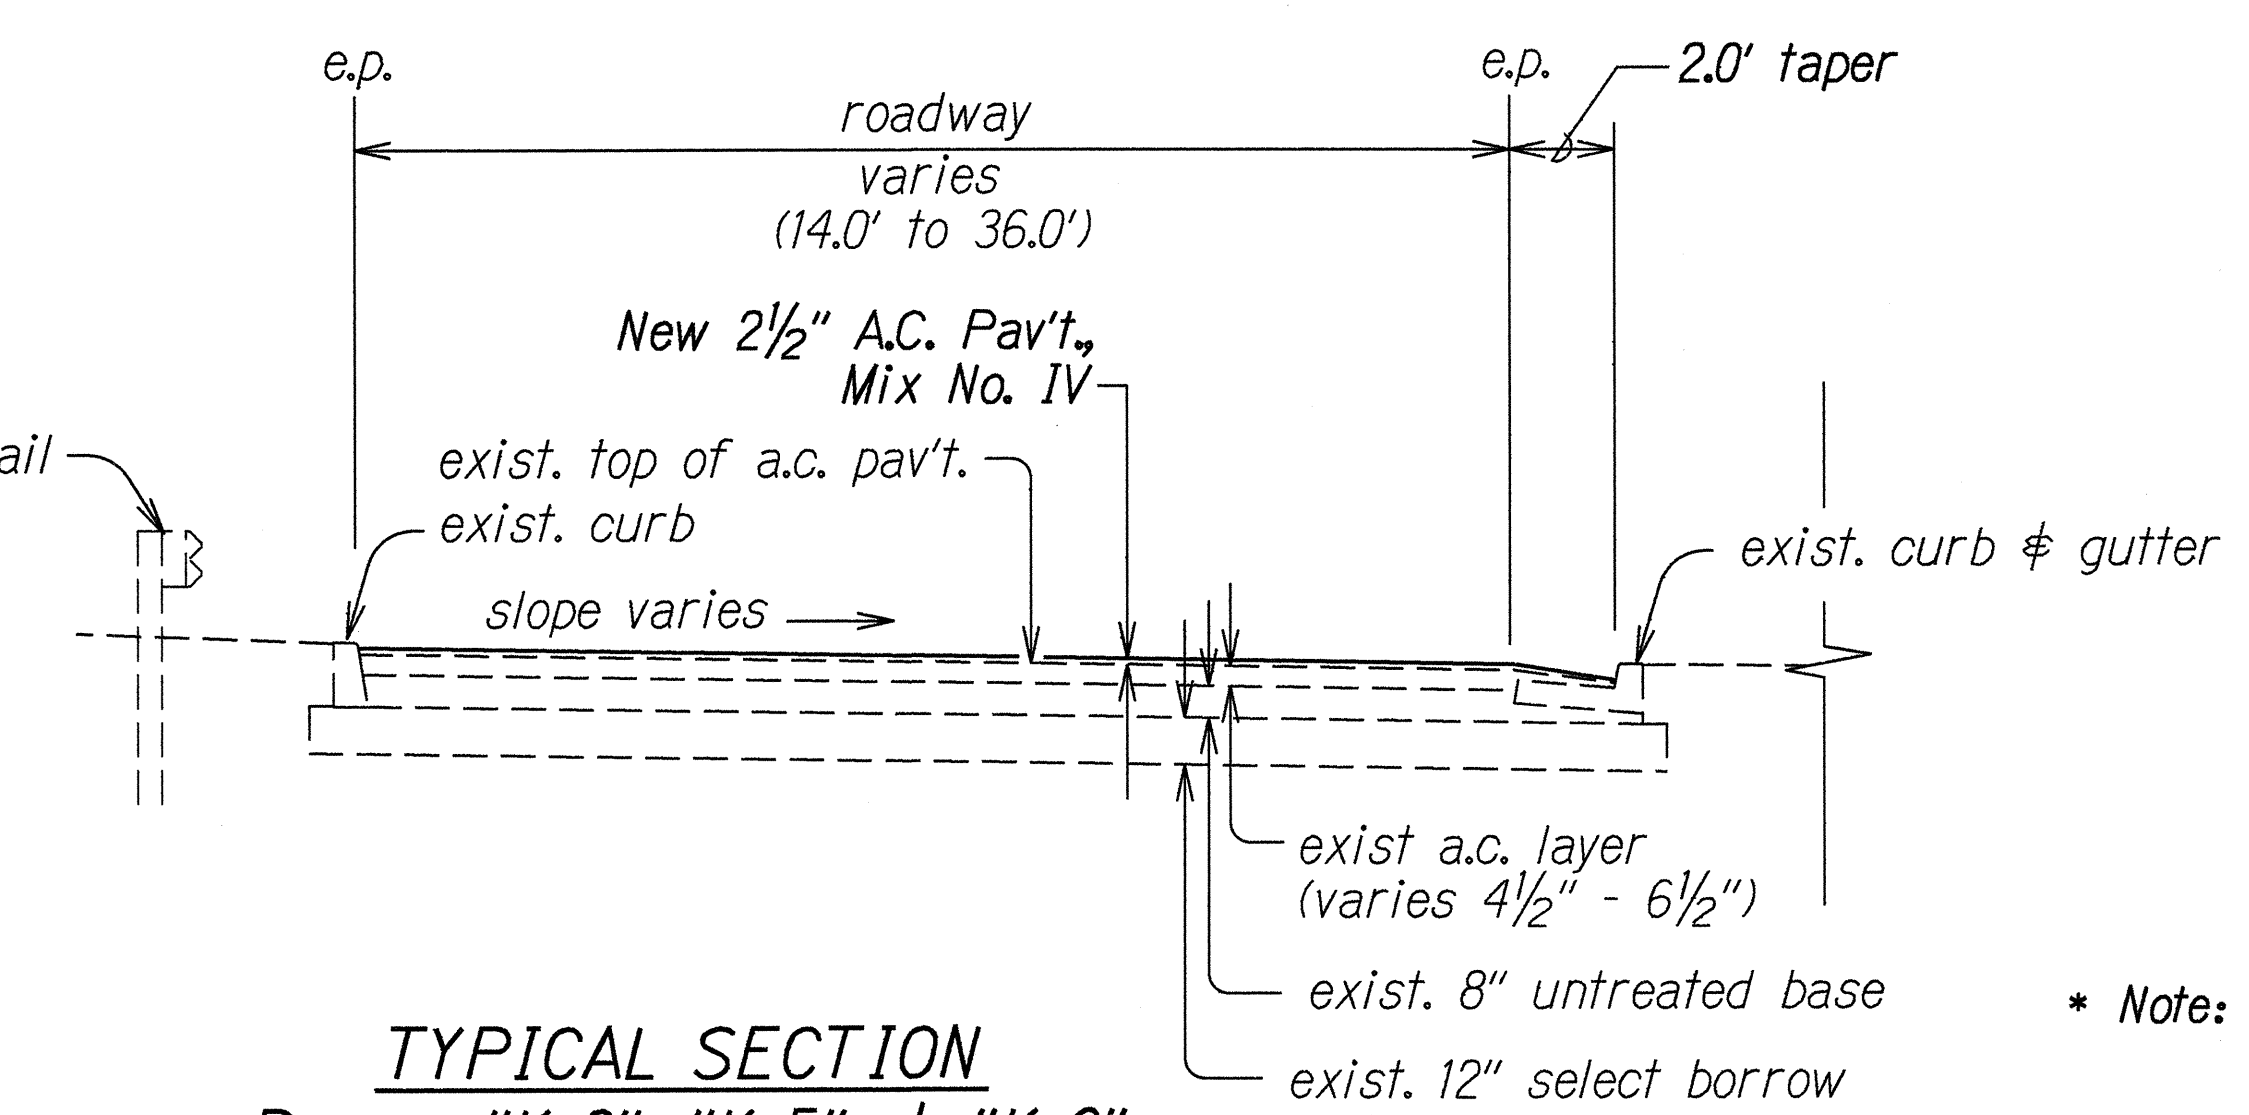

TYPICAL SECTION
Ramps "K-3", "K-5", & "K-6"
 Scale: 1/4" = 1'

* Note: For Thickness, See Schedule on Plan Sht. No. 20

SURVEY PLOTTED BY	DATE
DRAWN BY	5/20/95
TRACED BY	
DESIGNED BY	
CHECKED BY	
NO.	

6/21/95	Revise Upper Right and "K-1" Typical Title, and Add Typical for Ramp "K-4".
DATE	REVISION

STATE OF HAWAII
DEPARTMENT OF TRANSPORTATION
HIGHWAYS DIVISION

TYPICAL SECTIONS
LIKELIKE HIGHWAY RESURFACING
F.A. Project No. NH-063-K(19)
KALIHI STREET RESURFACING
F.A. Project No. STP-063-K(20)
Date: May, 1995

SHEET No. 4 OF 4 SHEETS