


FED. ROAD DIST. NO.	STATE	PROJ. NO.	FISCAL YEAR	SHEET NO.	TOTAL SHEETS
HAWAII	HAW.	63A-02-89	1991	16	23

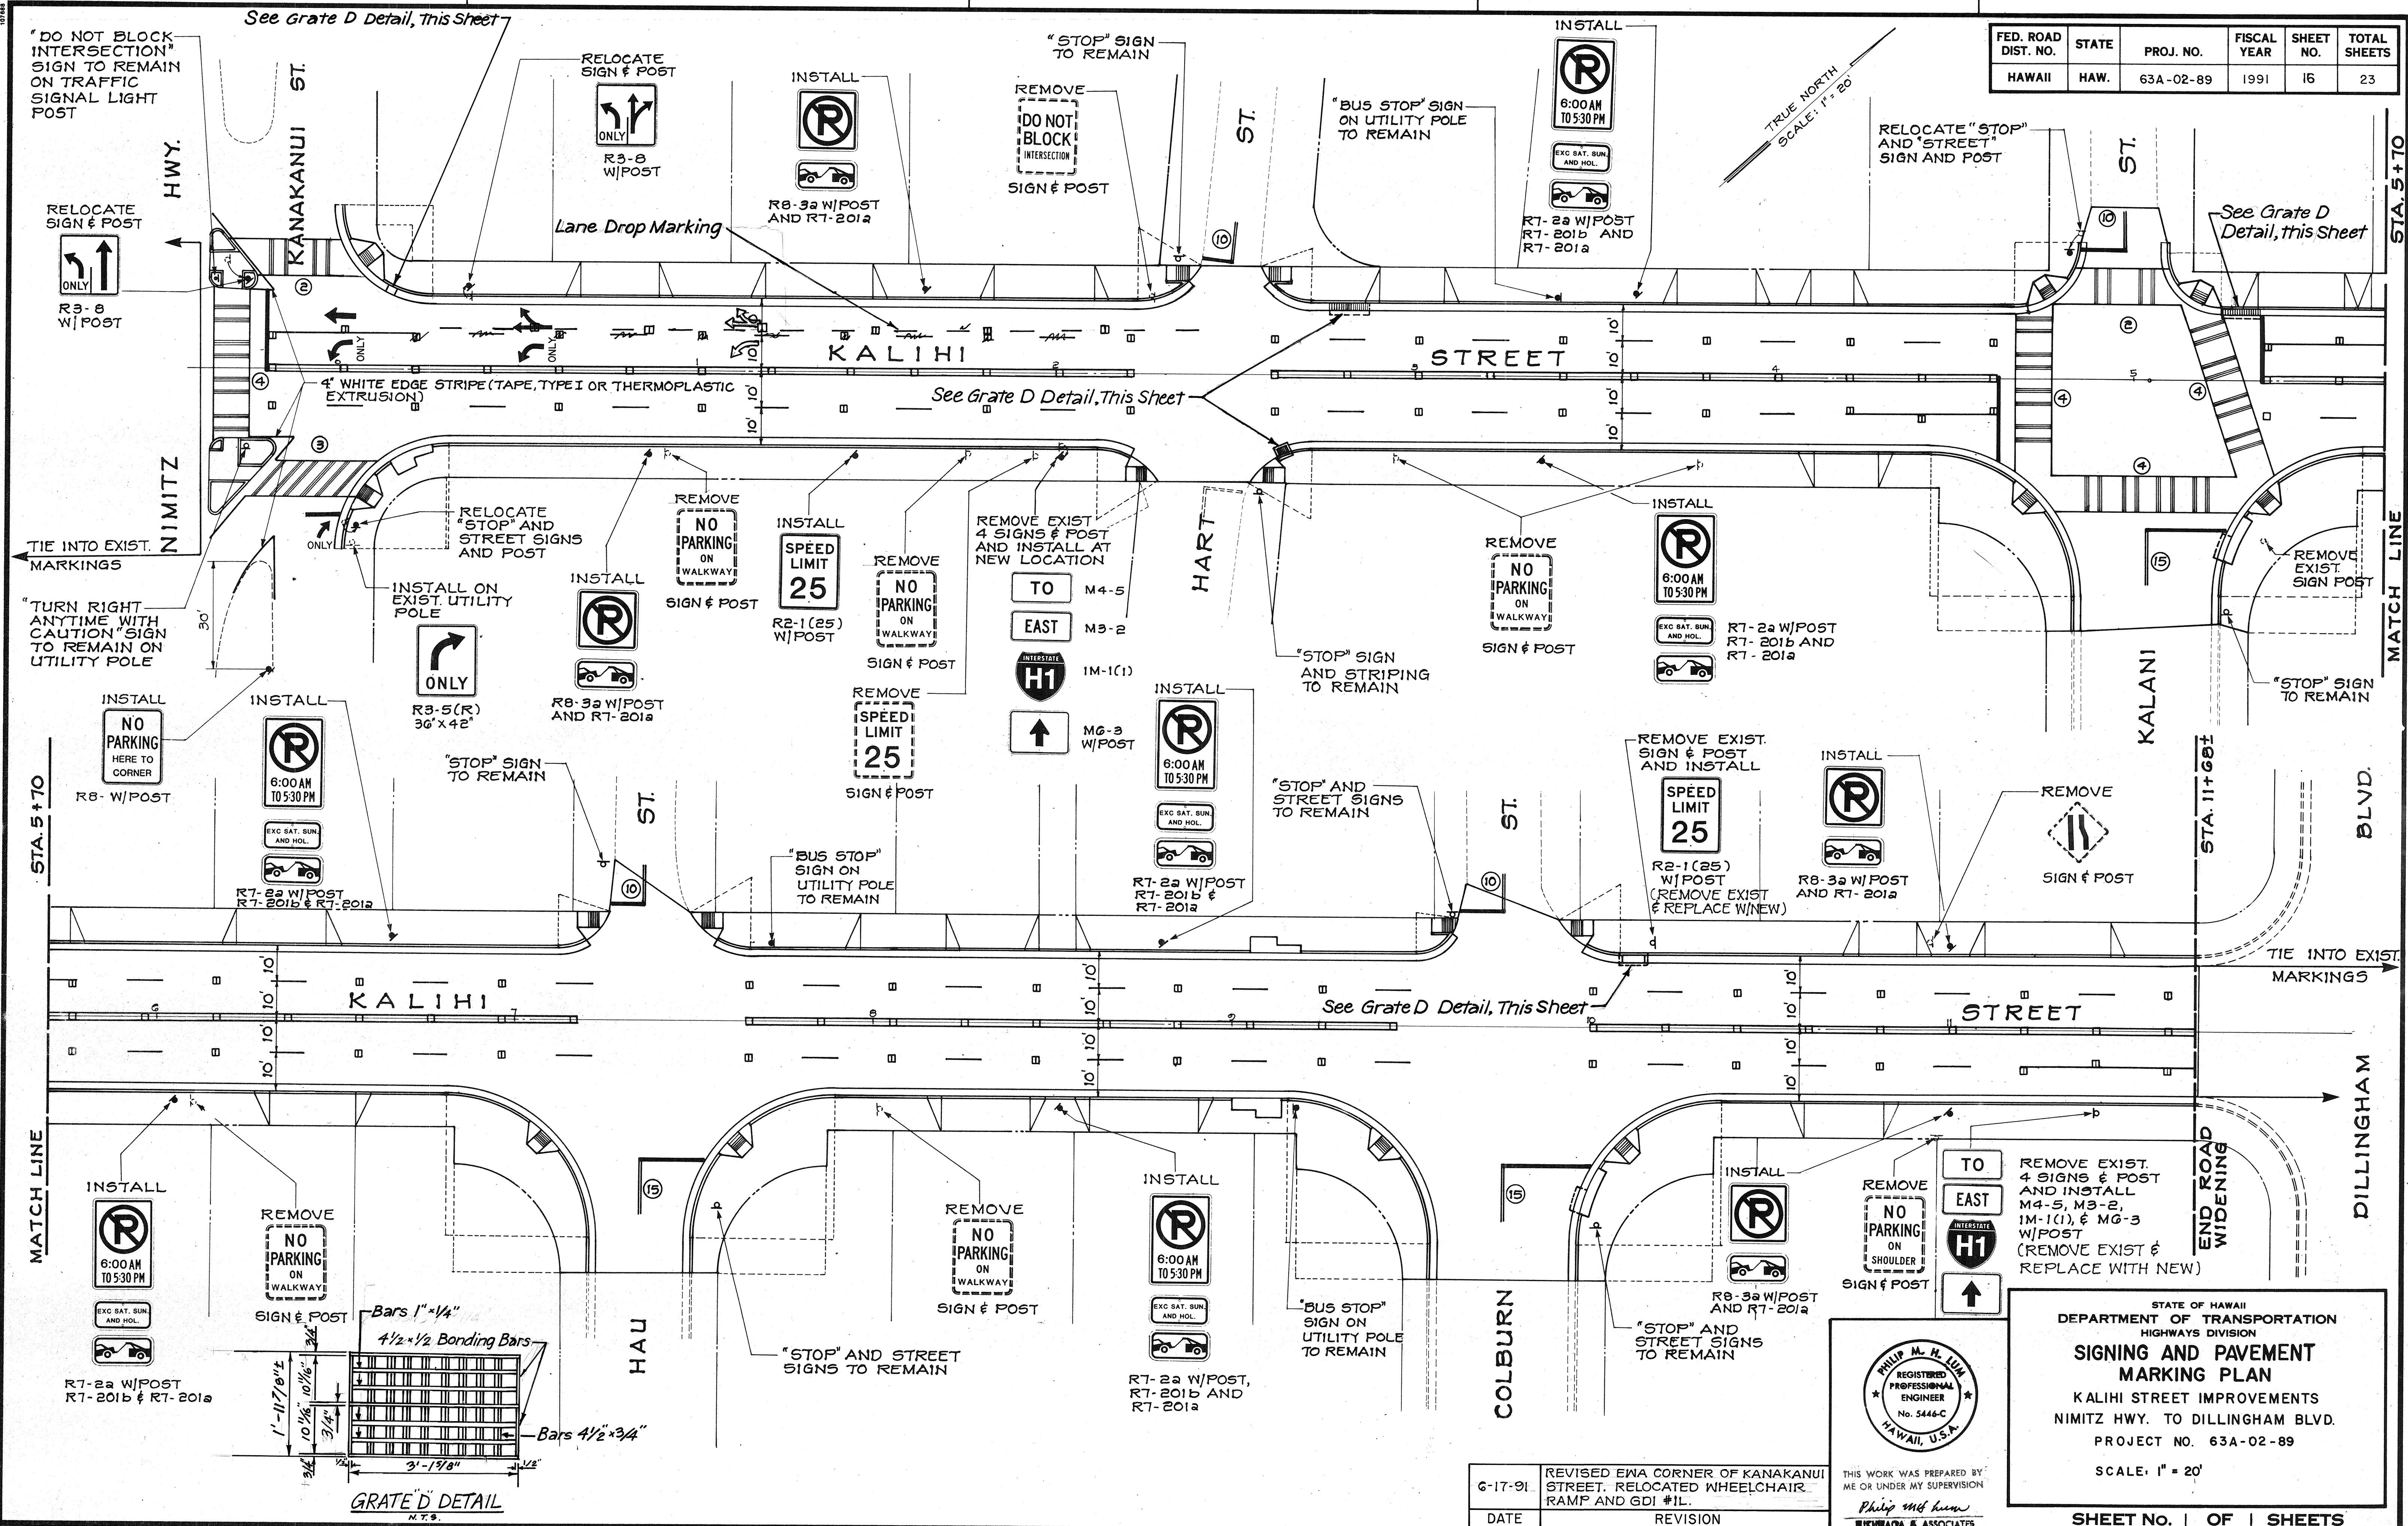

See Grate D Detail, This Sheet

See Grate D Detail, This Sheet


See Grate D Detail, This Sheet

See Grate D Detail, this Sheet

GRATE 'D' DETAIL
N.T.S.

DATE
SURVEY PLOTTED BY
DRAWN BY
DESIGNED BY
QUANTITIES BY
CHECKED BY
NO.

6-17-91	REVISED EWA CORNER OF KANAKANUI STREET, RELOCATED WHEELCHAIR RAMP AND GDI #1L.
DATE	REVISION

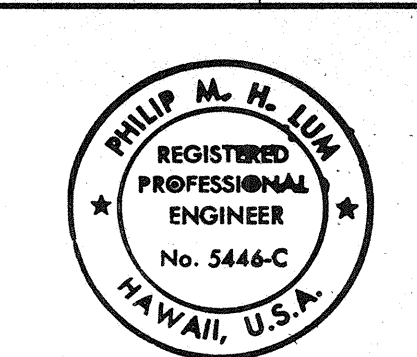

THIS WORK WAS PREPARED BY ME OR UNDER MY SUPERVISION
Philip M. H. Lim
KUKUNAGA & ASSOCIATES

STATE OF HAWAII
DEPARTMENT OF TRANSPORTATION
HIGHWAYS DIVISION
SIGNING AND PAVEMENT MARKING PLAN
KALIHĪ STREET IMPROVEMENTS
NIMITZ HWY. TO DILLINGHAM BLVD.
PROJECT NO. 63A-02-89
SCALE: 1" = 20'
SHEET No. 1 OF 1 SHEETS
C.O. 16