


FED. ROAD DIST. NO.	STATE	PROJ. NO.	FISCAL YEAR	SHEET NO.	TOTAL SHEETS
HAWAII	HAW.	63A-01-96	1996	6	12

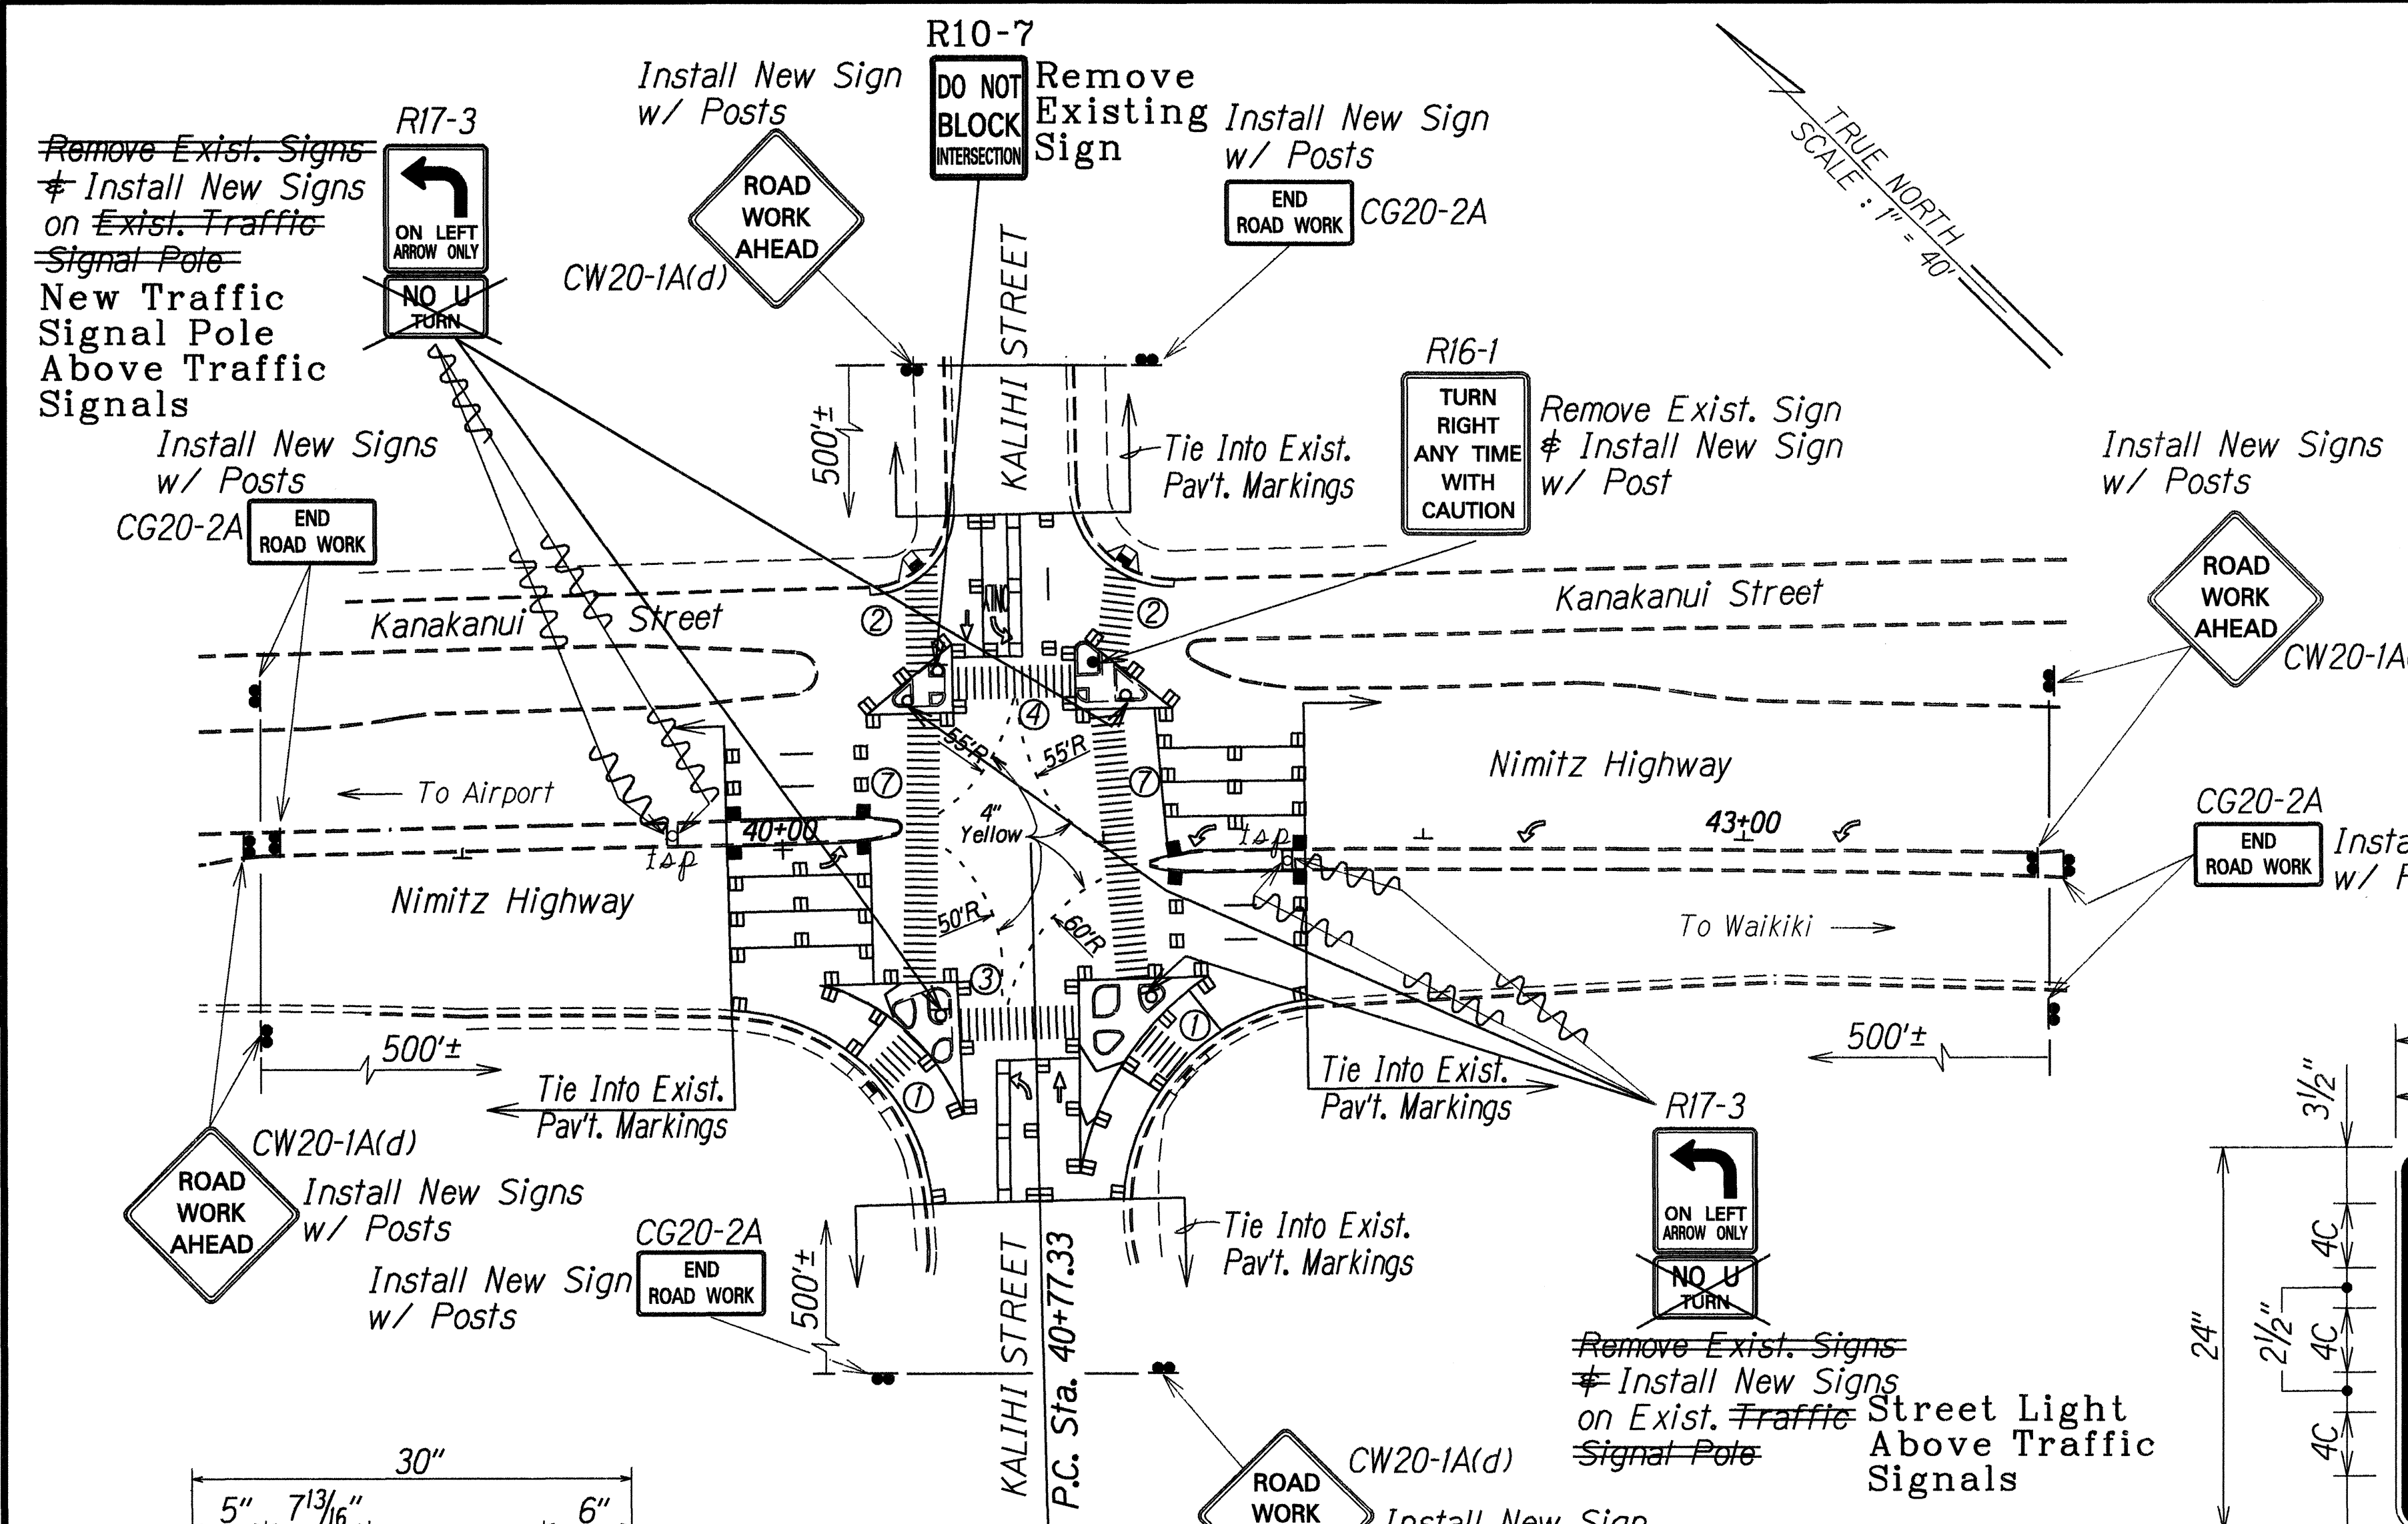

**TRAFFIC SIGN SUMMARY**


SIGN NO.	MESSAGE	QUANTITY			
		10 SQ. FT. OR LESS W/POST	GREATER THAN 10 SQ. FT. W/O POSTS	W/POSTS	W/O POSTS
R17-3	ON LEFT ARROW ONLY NO U TURN				4
W3-3a	CAUTION SIGNALS MODIFIED		8		
R16-2	TURN RIGHT ANYTIME WITH CAUTION	1			
TOTAL		1	8	0	4

**CONSTRUCTION SIGN SUMMARY**


SIGN NO.	MESSAGE	W/POSTS	W/O POST
CG20-2A	END ROAD WORK	6	
CW20-1A(d)	ROAD WORK AHEAD	6	
TOTAL		12	0

**PAVEMENT MARKING SUMMARY**


DESCRIPTION	QUANTITY
<b>PAVEMENT MARKERS</b>	
TYPE A _____	20 EA.
TYPE C _____	80 EA.
TYPE D _____	6 EA.
TYPE H _____	8 EA.
<b>TAPE - TYPE I OR THERMOPLASTIC EXTRUSION</b>	
8-INCH PAVEMENT STRIPE (WHITE) _____	360 L.F.
DOUBLE 4-INCH PAVEMENT STRIPE (YELLOW) _____	90 L.F.
<b>TAPE - TYPE II OR THERMOPLASTIC EXTRUSION</b>	
4-INCH PAVEMENT STRIPE (WHITE) _____	170 L.F.
4-INCH PAVEMENT STRIPE (YELLOW) _____	200 L.F.
8-INCH PAVEMENT STRIPE (WHITE) _____	510 L.F.
12-INCH PAVEMENT STRIPE (WHITE) _____	50 L.F.
<b>TAPE - TYPE III OR THERMOPLASTIC EXTRUSION</b>	
4-INCH PAVEMENT STRIPE (YELLOW) _____	215 L.F.
12-INCH PAVEMENT STRIPE (WHITE) _____	200 L.F.
CROSSWALK MARKINGS _____	27 LANES
PAVEMENT ARROW _____	6 EA.
PAVEMENT WORD _____	1 EA.

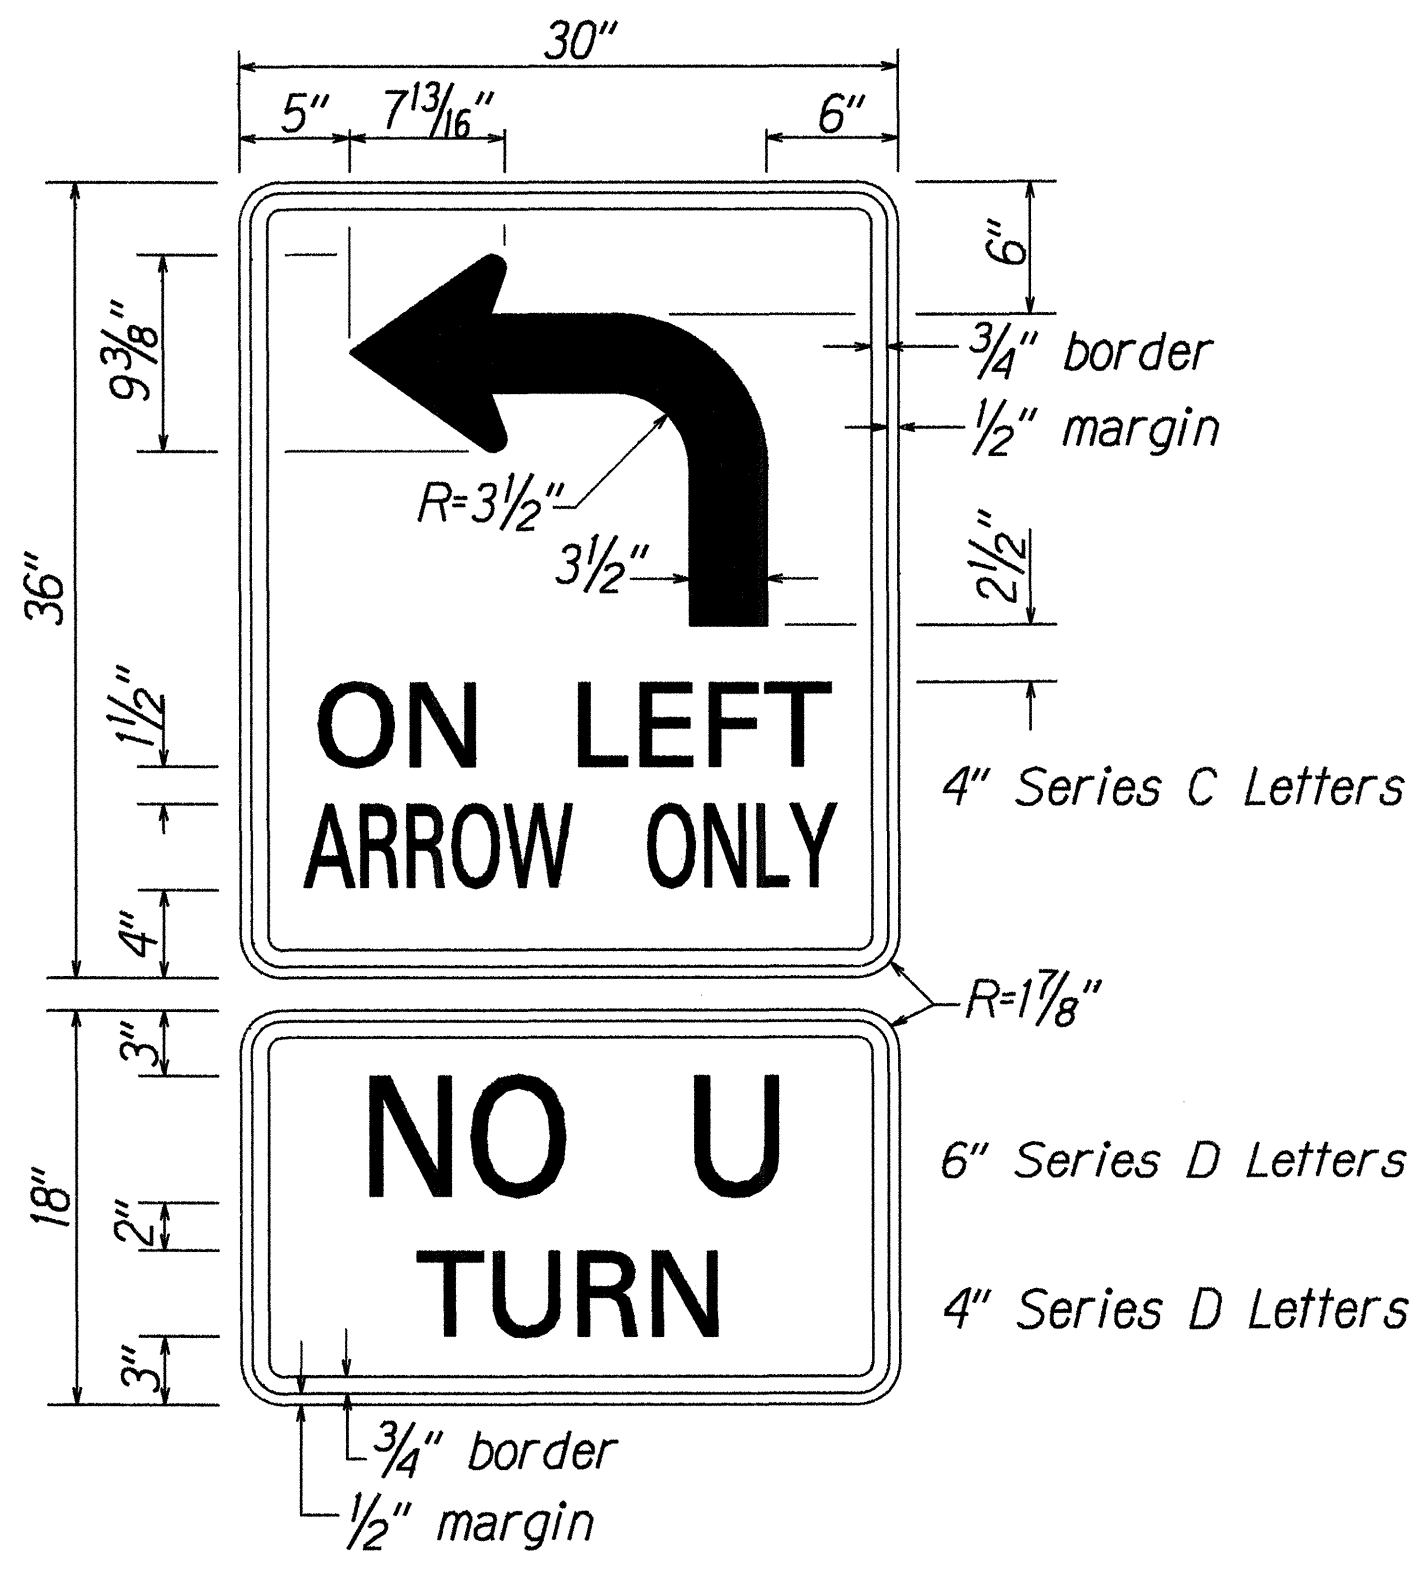


R17-3  
Not to Scale

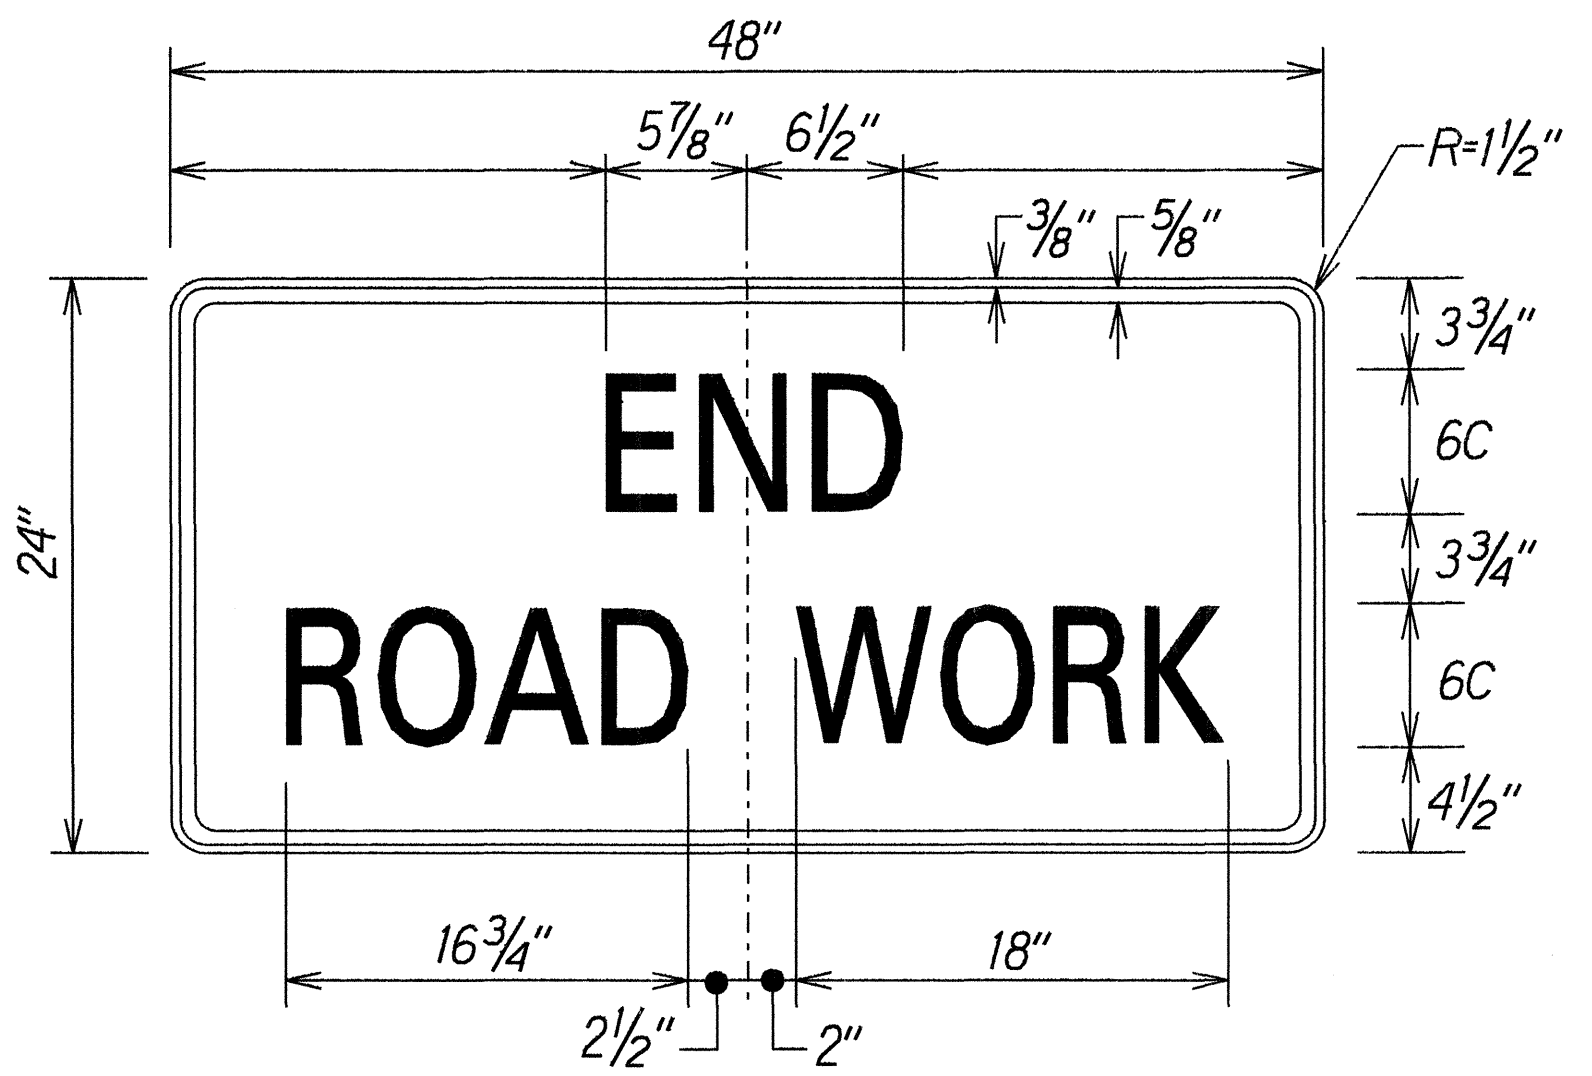

CG20-2A  
Scale: 1/2" = 1'-0"  
Colors:  
Legend: Black (Non Refl)  
Background: Orange

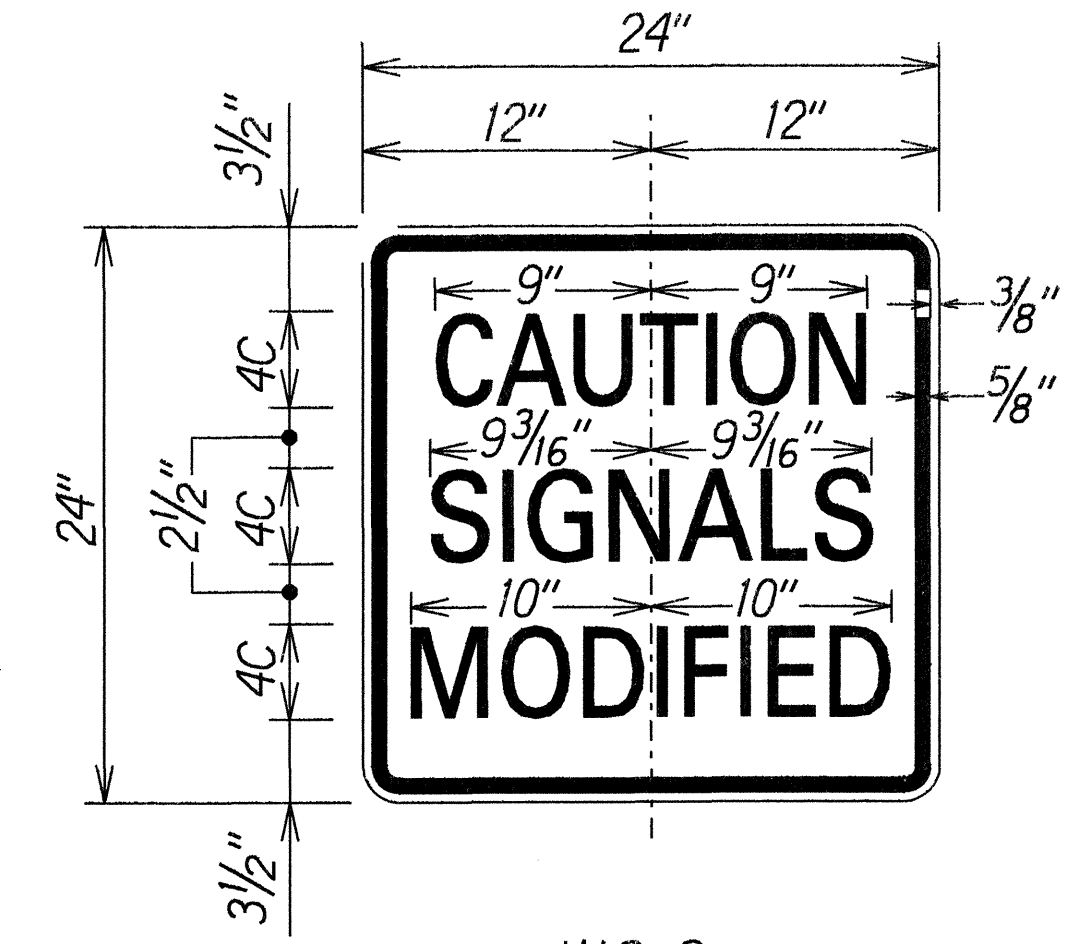

W3-3a  
Not to Scale

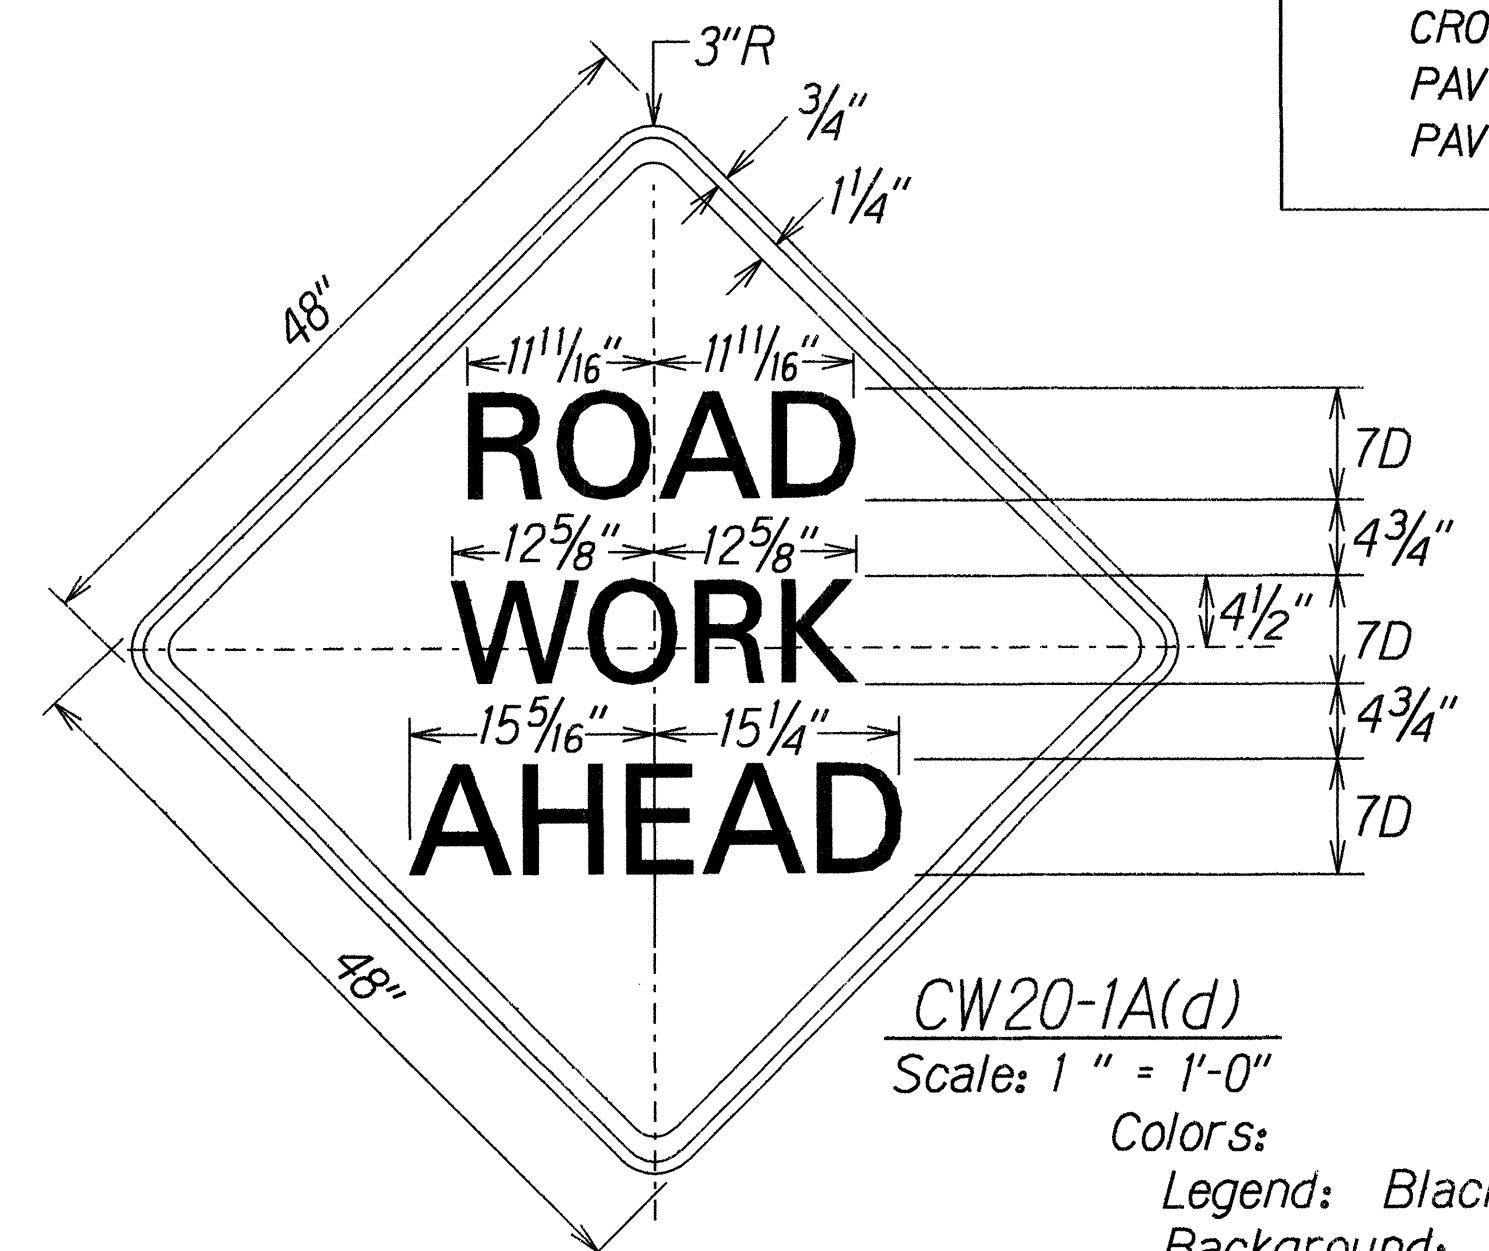

CW20-1A(d)  
Scale: 1" = 1'-0"  
Colors:  
Legend: Black (Non Refl)  
Background: Orange

**LEGEND FOR AS-BUILT POSTINGS**

	Squiggly line for as-built deletion
	Double line for as-built deletion
	Roadway Text for as-built posting

STATE OF HAWAII  
DEPARTMENT OF TRANSPORTATION  
HIGHWAYS DIVISION

**PAVEMENT MARKING  
& SIGNING PLAN**

KALIHĪ STREET  
Intersection Improvements at  
Nimitz Highway  
Project No. 63A-01-96

Scale: As Noted Date: Apr., 1996

SHEET No. 1 OF 1 SHEETS

SURVEY PLANNED BY: \_\_\_\_\_  
 DRAWN BY: \_\_\_\_\_  
 CHECKED BY: \_\_\_\_\_  
 DESIGNED BY: \_\_\_\_\_  
 QUANTITIES BY: \_\_\_\_\_  
 DATE: \_\_\_\_\_  
 ORIGINAL PLAN NO. \_\_\_\_\_  
 DATE: \_\_\_\_\_  
 DESIGNED BY: \_\_\_\_\_  
 QUANTITIES BY: \_\_\_\_\_  
 DATE: \_\_\_\_\_