


FED. ROAD DIS. NO.	STATE	PROJ. NO.	FISCAL YEAR	SHEET NO.	TOTAL SHEETS
HAWAII	HAW.	HWY-0-05-01	1992	14	49

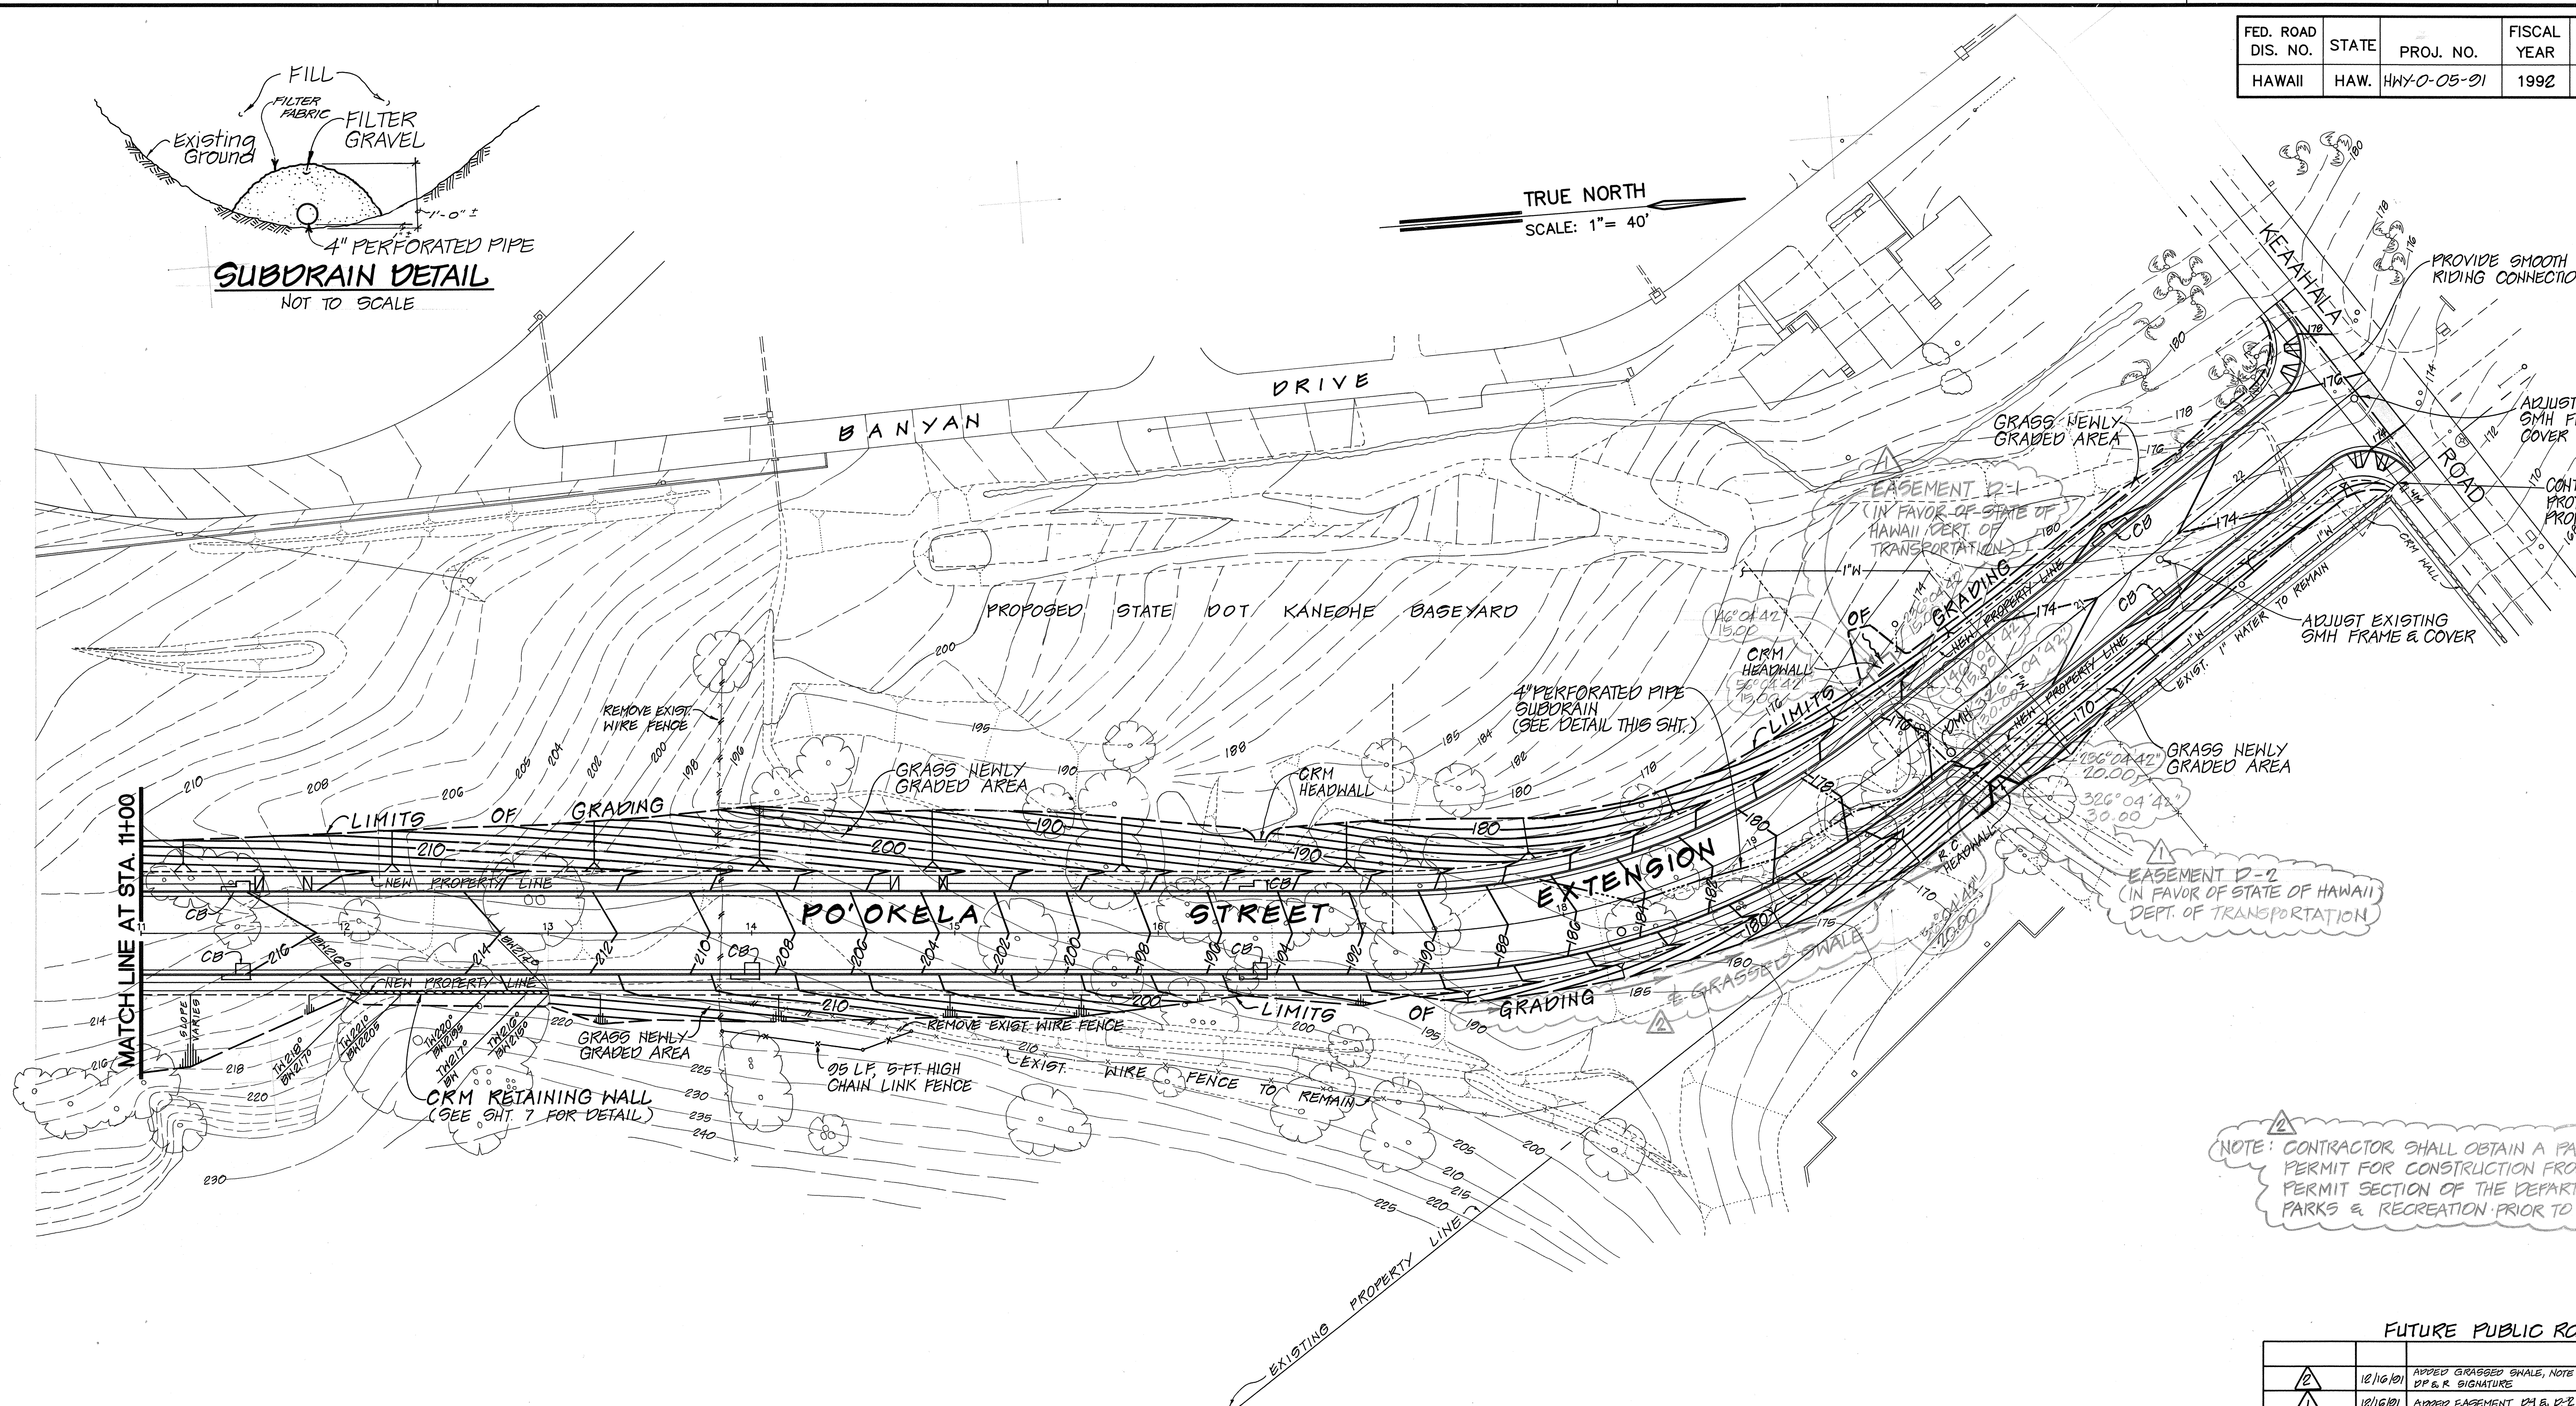

NOTE: CONTRACTOR SHALL OBTAIN A PARK USE PERMIT FOR CONSTRUCTION FROM THE PERMIT SECTION OF THE DEPARTMENT OF PARKS & RECREATION PRIOR TO CONSTRUCTION.

DATE	_____
DESIGNED BY	_____
CHECKED BY	_____
IN CHARGE	_____
APPROVED BY	_____

APPROVED: (FOR GRADING ONLY)
M. F. [Signature] 11/8/91
CHIEF, DIVISION OF ENGINEERING, DPH DATE 11/8/91

CLARENCE K. TANOMAKI
REGISTERED PROFESSIONAL ENGINEER
No. 1464-C
HAWAII, U.S.A.
THIS WORK WAS PREPARED BY ME OR UNDER MY SUPERVISION
[Signature] dpo PARK ENGINEERING

FUTURE PUBLIC ROAD				
REVISION	DATE	BRIEF	BY	APPROVED
1	12/16/91	ADDED GRASSED SHALE, NOTE AND D.P.R. SIGNATURE	DE	4/13/92
2	12/16/91	ADDED EASEMENT D-1 & D-2	DE	12/16/91
STATE OF HAWAII DEPARTMENT OF TRANSPORTATION HIGHWAYS DIVISION GRADING PLAN "B" CASTLE HILLS ACCESS ROAD SCALE: AS SHOWN DATE: AUG, 1990 SHEET No. 2 OF 2 SHEETS C.O. ADD. 14				