



FED. ROAD DIS. NO.	STATE	PROJ. NO.	FISCAL YEAR	SHEET NO.	TOTAL SHEETS
HAWAII	HAW.	HWY-0-05-91	1992	40	49

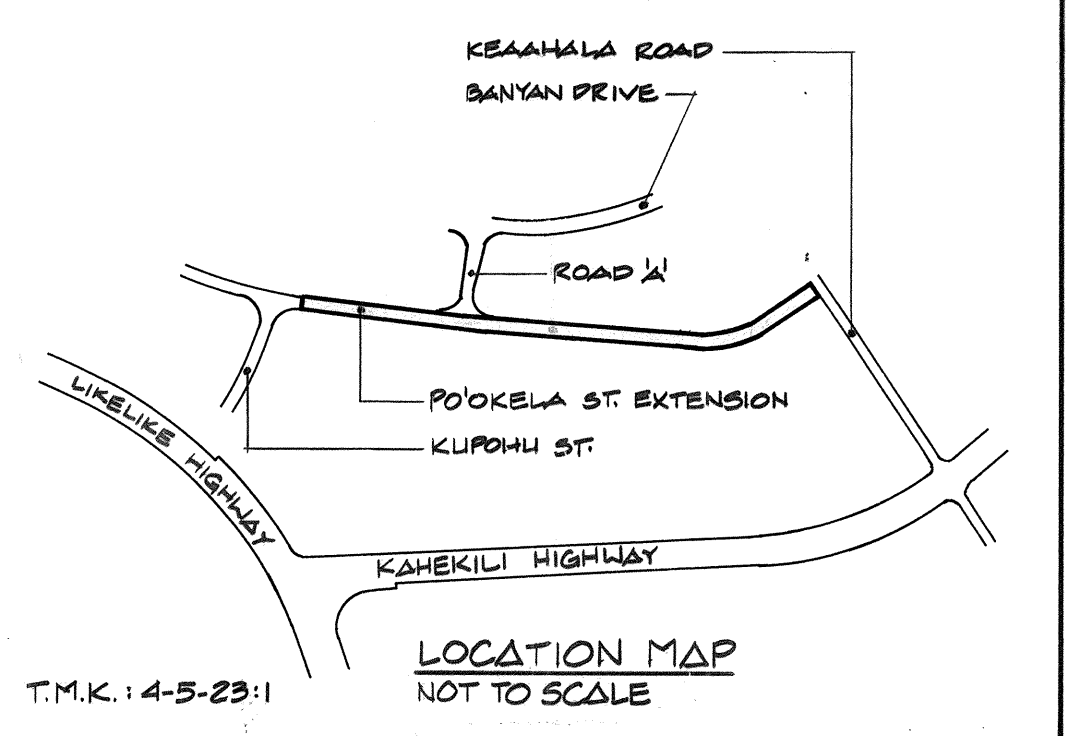

TRUE NORTH
SCALE: 1"= 40'

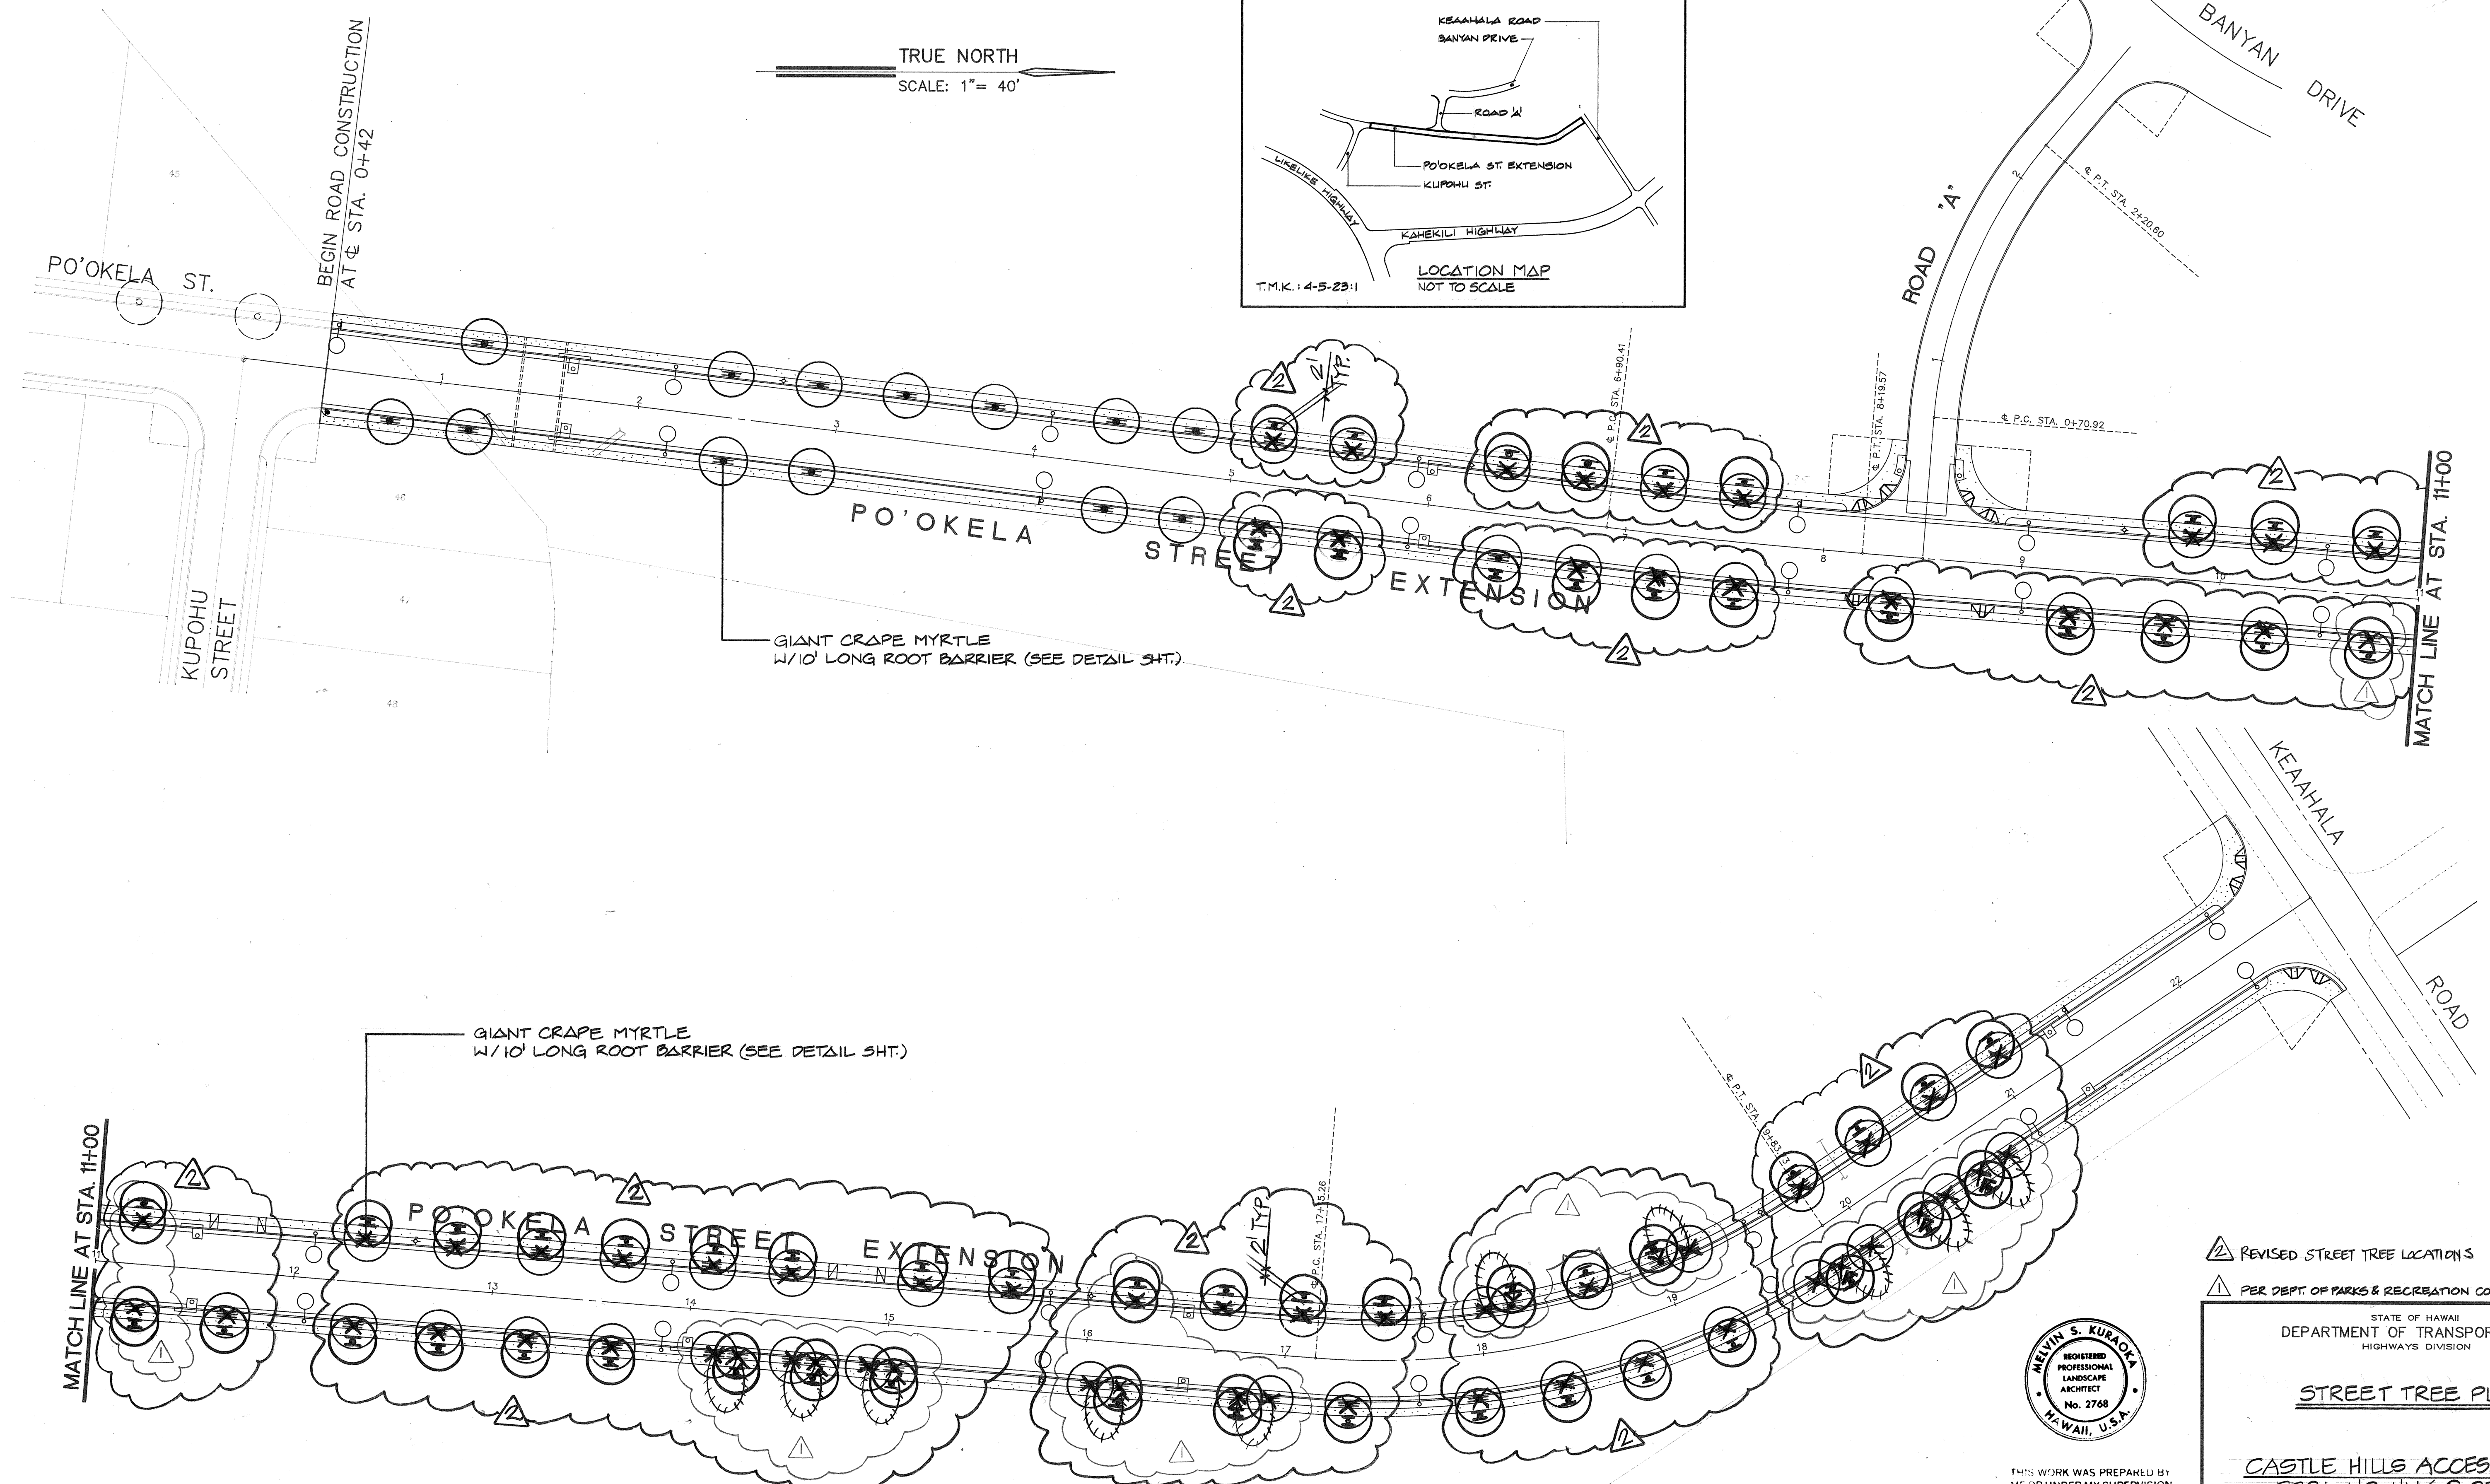


DESIGNED BY	DATE
TRACED BY	
NOTED BY	
CHECKED BY	
NO.	

REAPPROVED BY: *[Signature]* 7/16/93
DIRECTOR, DEPT. OF PARKS AND RECREATION (FOR SHTS. L-1 TO L-2) DATE

APPROVED BY: *[Signature]* 11/1/91
DIRECTOR, DEPT. OF PARKS AND RECREATION DATE

APPROVED BY: *[Signature]* 10/25/91
CHIEF, TRAFFIC ENGINEERING DIVISION, D.T.S. DATE

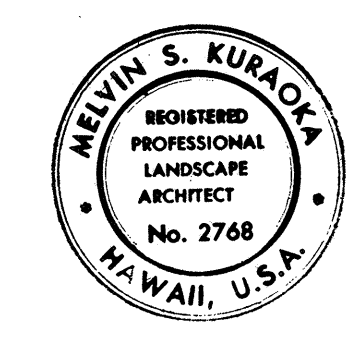

△ REVISED STREET TREE LOCATIONS 6/8/93

△ PER DEPT. OF PARKS & RECREATION COMMENTS 10-29-91


STATE OF HAWAII
DEPARTMENT OF TRANSPORTATION
HIGHWAYS DIVISION

STREET TREE PLAN

CASTLE HILLS ACCESS ROAD
PROJ. NO. HWY-0-05-91

SCALE: AS SHOWN DATE: AUGUST, 1991

SHEET No. L-1 OF 2 SHEETS

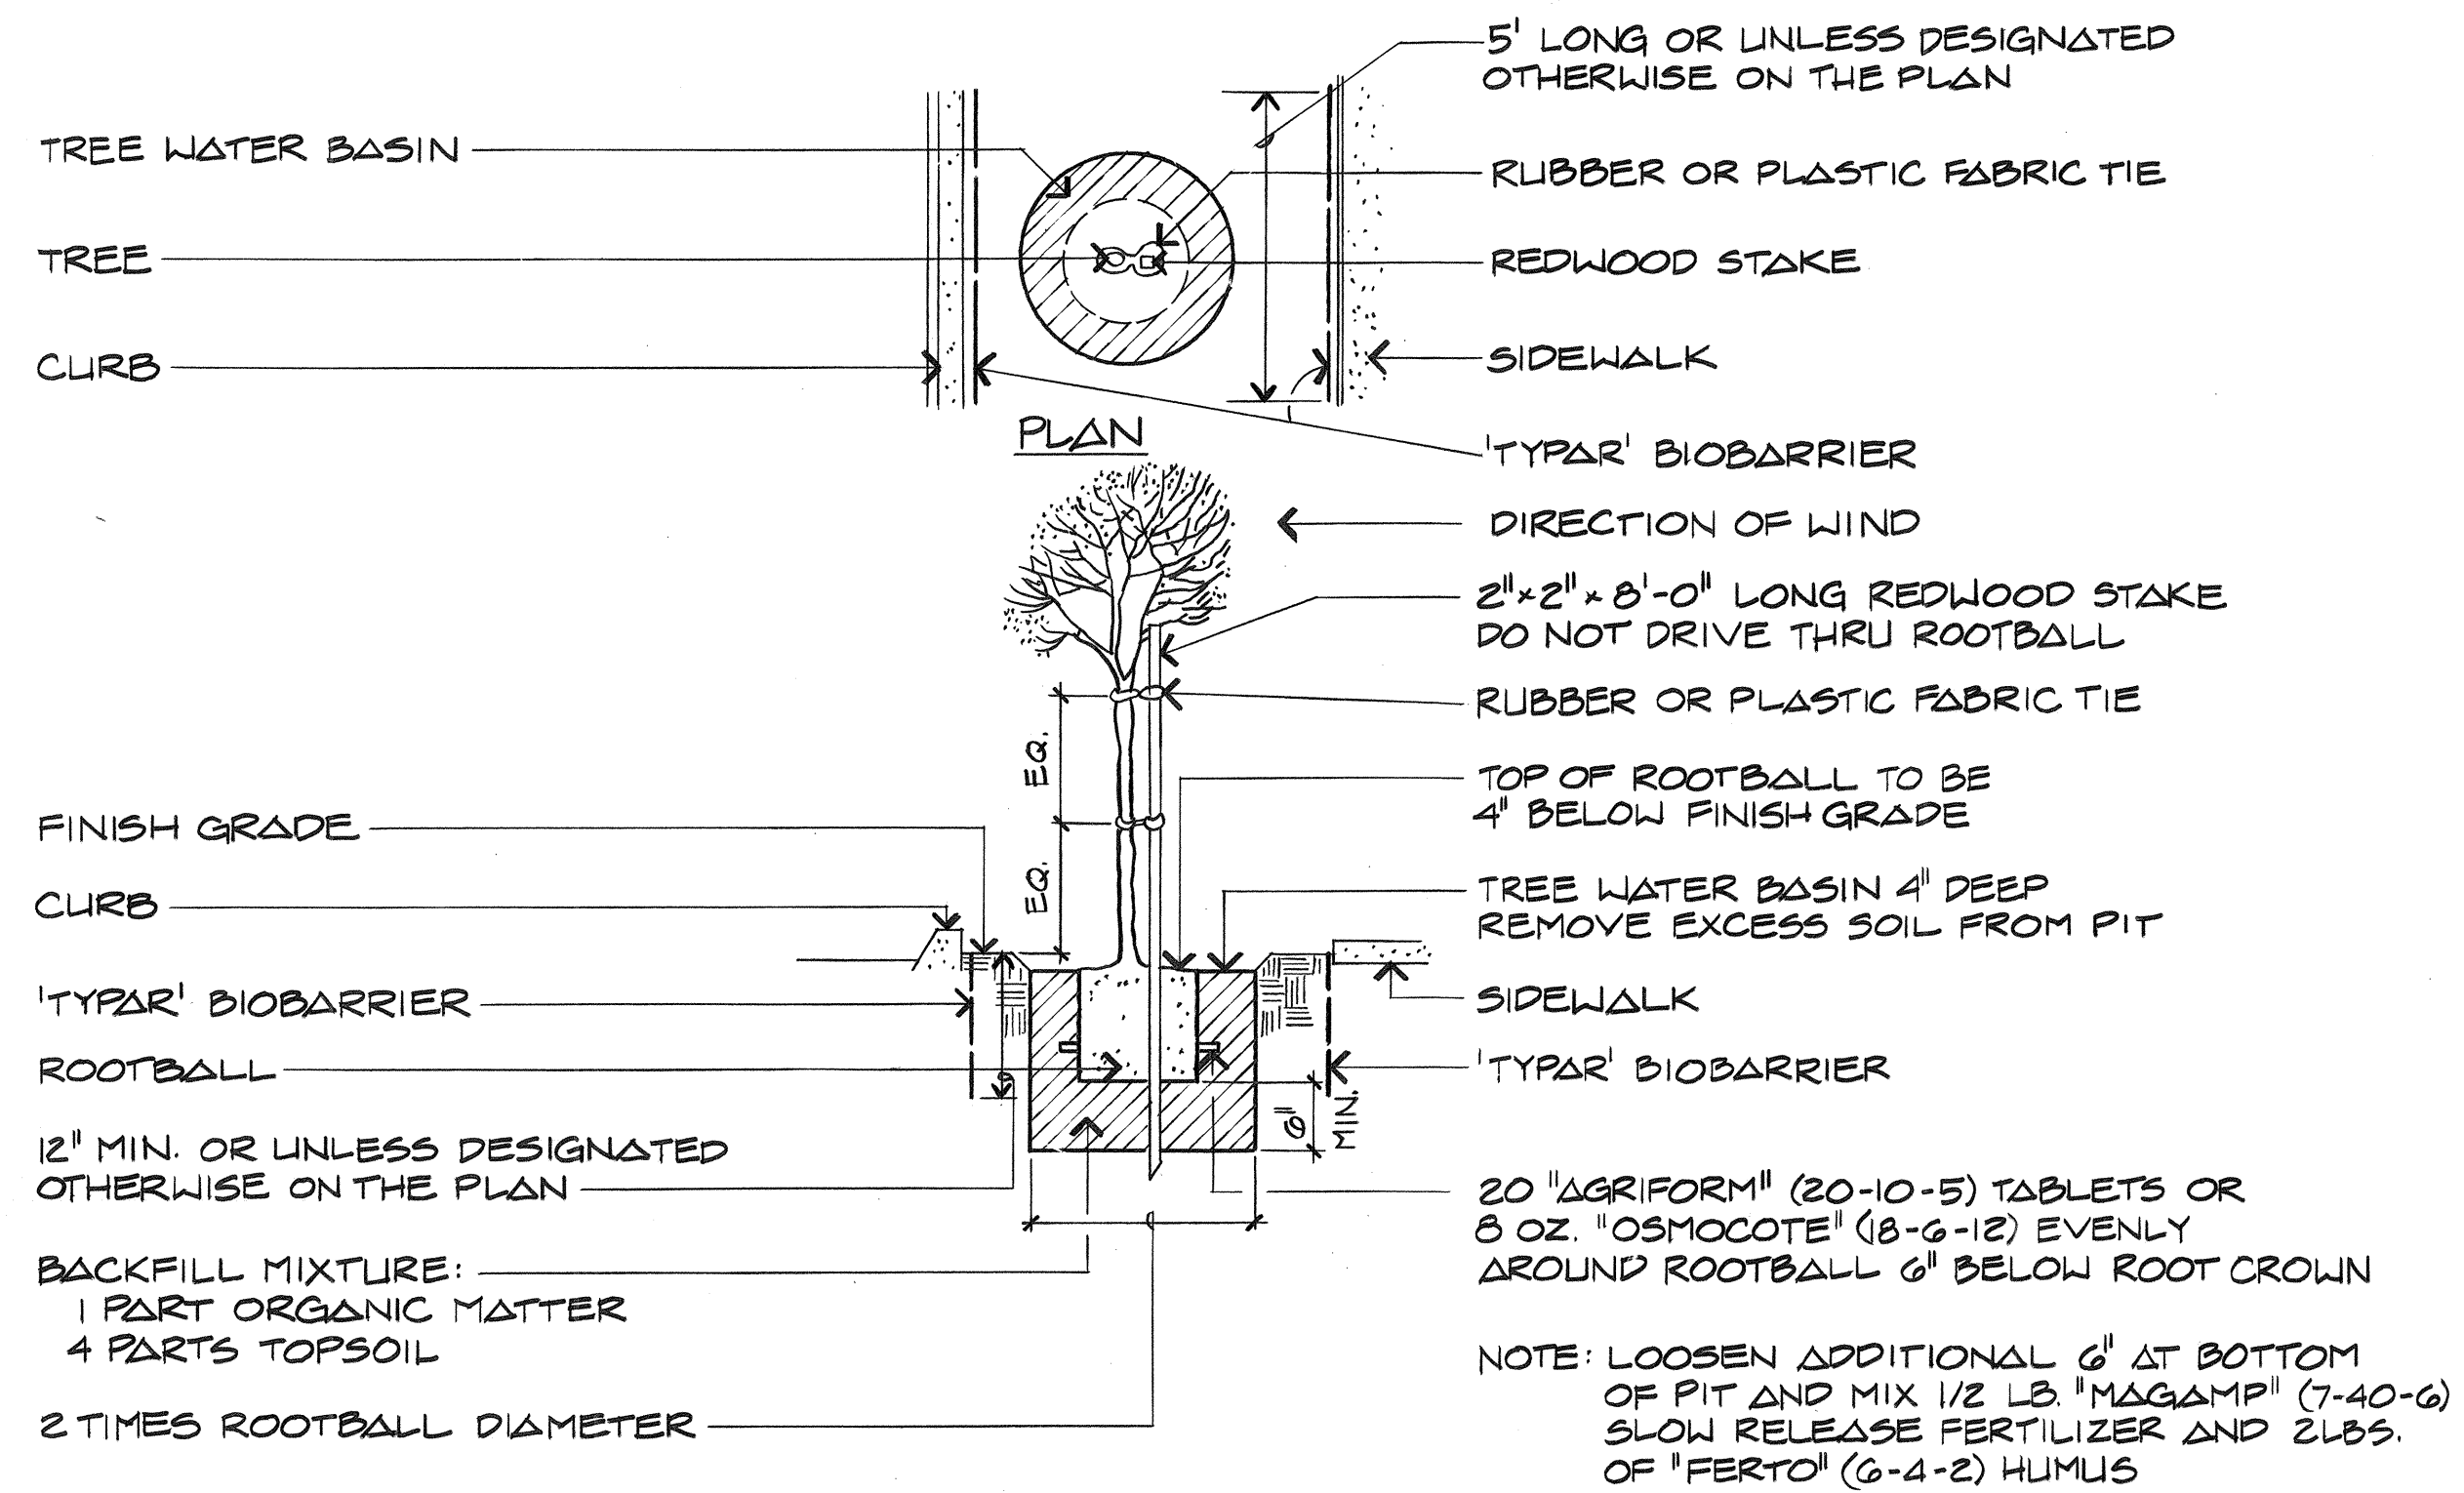

STREET TREE PLANTING DETAIL
NOT TO SCALE

NOTES:

1. THE MAINTENANCE OF STREET TREES SHALL BE FOR A MINIMUM OF SIXTY (60) DAYS OR UNTIL THE ADJUTING OWNERS ASSUMES MAINTENANCE WHICHEVER IS LONGER.
2. THE CONTRACTOR SHALL NOTIFY THE DEPARTMENT OF PARKS & RECREATION'S BEAUTIFICATION ADMINISTRATOR, PH. 971-7151, AT LEAST SEVEN (7) DAYS IN ADVANCE FOR THE PRE-MAINTENANCE AND FINAL INSPECTION.
3. ALL STREET TREES SHALL BE PLANTED IN ACCORDANCE TO THE DEPARTMENT OF PARKS & RECREATION STANDARD LANDSCAPING DETAILS AND SPECIFICATIONS.

NOTE:

STATE OWNED TREES - TO BE MAINTAINED BY THE STATE. CONTRACTOR SHALL NOTIFY STATE DEPT. OF TRANSPORTATION HIGHWAYS MAINTENANCE DIVISION FOR FINAL INSPECTION AND ACCEPTANCE.

4. Street Tree plans that have been revised or haven't started construction within two (2) years of the date of Director's approval will be subject to re-approval.
5. When substitution of tree types are requested by the developer or contractor due to unavailability, the plans shall be revised after notification of tree selection and the plans submitted for re-approval.
6. The street tree Consultant is required to submit reproducibles of As-Built plans provided by the General Contractor to the Department of Parks and Recreation immediately following notice of Acceptance (Project Completion Notice) of the street tree planting. (Attn. Chief, Facilities Development).


APPROVED BY  11/1/91
DIRECTOR, DEPT. OF PARKS AND RECREATION DATE


STREET TREE LIST

QUANTITY	COMMON NAME	BOTANICAL NAME	SIZE	REMARKS
72 50 13	GIANT CREPE MYRTLE (OUTSIDE OF R.O.W.) (WITH-IN-ROAD R.O.W.)	LAGERSTROEMIA INDICA	25 GAL.	7' TRUNK HT, 3' SPREAD, 2" CAL.
1440 L.F. 1440	ROOT BARRIER	'TYPAR' BIOBARRIER	12" WIDTH	1440 L.F. ROOT BARRIERS SHALL BE CONSIDERED INCIDENTAL TO THE PLANTING OF 72 GIANT CREPE MYRTLE

FED. ROAD DIST. NO.	STATE	FED. AID PROJ. NO.	FISCAL YEAR	SHEET NO.	TOTAL SHEETS
HAWAII	HAW.	HWY-0-05-91	1992	41	49

SURVEY PLOTTED BY	DATE
DRAWN BY	
DESIGNED BY	
QUANTITIES BY	
CHECKED BY	
ORIGINAL PLAN	
NOTE BOOK	
No.	

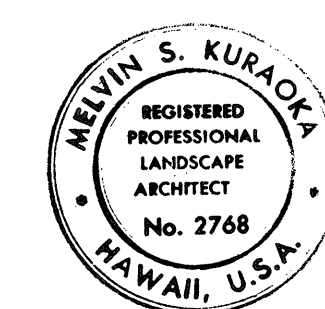

THIS WORK WAS PREPARED BY
ME OR UNDER MY SUPERVISION


REV.	DATE	DESCRIPTION	BY	APPRD.
2	11-4-91	INCIDENTAL WORK	DE	DPR

PER DEPT. OF PARKS & RECREATION COMMENTS 10-29-91 LK

STATE OF HAWAII
DEPARTMENT OF TRANSPORTATION
HIGHWAYS DIVISION

STREET TREE LIST, DETAILS
AND NOTES

CASTLE HILLS ACCESS ROAD
PROJ. NO. HWY-0-05-91

SCALE: NONE DATE: AUGUST, 1991

SHEET NO. 42 OF 2 SHEETS