	IN	DEX TO DRAWINGS
	SHEET NO.	DESCRIPTION
	1	TITLE SHEET
	2	STANDARD PLANS SUMMARY
	3	CONSTRUCTION NOTES
	4-6	ROAD/DEMOLITION PLAN
	7-11	SIGNING & STRIPING PLAN
	12-19	TRAFFIC CONTROL PLAN
	20	CURB RETURNS
	21-24	CURB RAMP DETAIL
	25-27	MISCELLANEOUS DETAILS
- ,	28	PLANTING PLAN
	29	IRRIGATION PLAN
	30	ELECTRICAL SYMBOLS, GENERAL NOTES
	31	DUCT SECTIONS
	32	HIGHWAY LIGHTING PLAN
. %	33	HIGHWAY LIGHTING DIAGRAMS
	34-36	HIGHWAY LIGHTING DETAILS
	37-39	STREET LIGHT DETAILS
	40	TRAFFIC SIGNAL DEMOLITION PLAN
	41-43	TRAFFIC SIGNAL PLAN
	44	TRAFFIC SIGNAL ONE—LINE DIAGRAM, SERVICE EQUIPMENT DETAILS
	45-51	TRAFFIC SIGNAL DETAILS
~	52	TRAFFIC SIGNAL NOTES
25 25 25 1	Щ	

STATE OF HAWAII

DEPARTMENT OF TRANSPORTATION

HIGHWAYS DIVISION HONOLULU, HAWAII "AS-BUILT"

PLANS FOR

LIKELIKE HIGHWAY TRAFFIC IMPROVEMENTS VALLEY VIEW DRIVE TO H-1


PROJECT NO. 63A-01-97

DISTRICT OF HONOLULU ISLAND OF OAHU

LIMITS OF PROJECTS— (AREA 2)

TO KANEOHE

VALLEY VIEW DR.

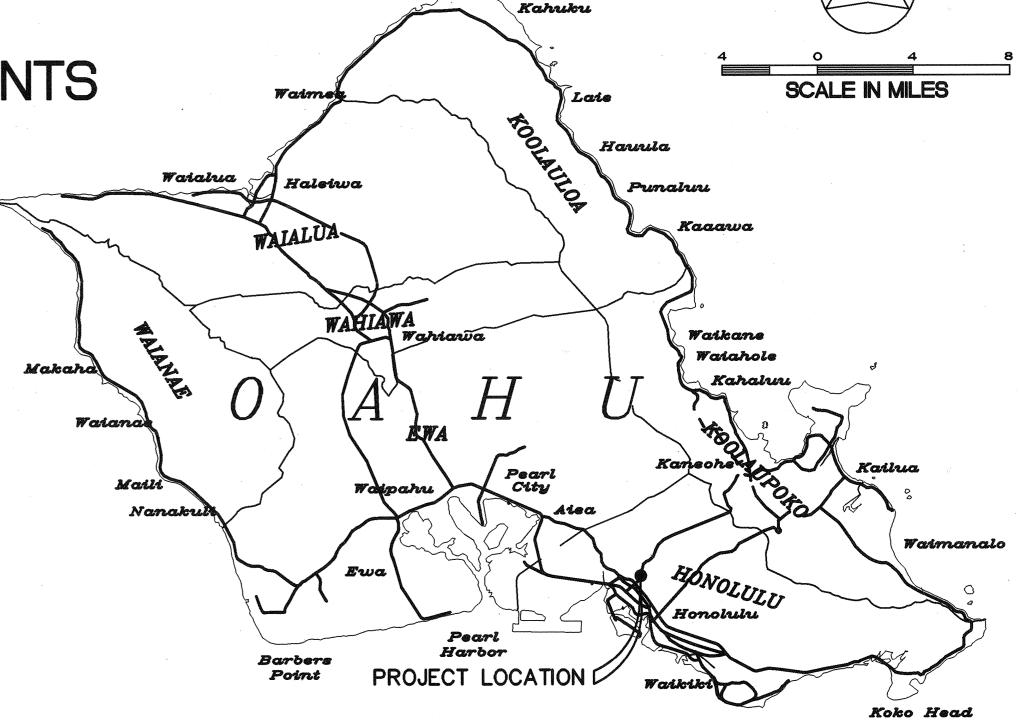

ISLAND OF OAHU

MILE POST 1.15 TO MILE POST 1.42 MILE POST 2.83 TO MILE POST 2.93

> CHANGES MADE DURING CONSTRUCTION HAVE BEEN INCORPORATED ON THESE PLANS EXCEPT CHANGES IN THE ORIGINAL THEORETICAL QUANTITIES. FOR ACTUAL QUANTITIES, REFER TO PROJECT LEDGER AND/OR COMPUTATION BOOK.

HAW. 63A-01-97 1998

STATE OF HAWAII

RESIDENT ÉNGINEER

DEPARTMENT OF TRANSPORTATION STATE OF HAWAII

DIR. OF TRANSPORTATION

DATE