


PROJECT NO. HWY-0-21-98M

DISTRICTS OF HONOLULU AND KO'OLAUPOKO ISLAND OF OAHU

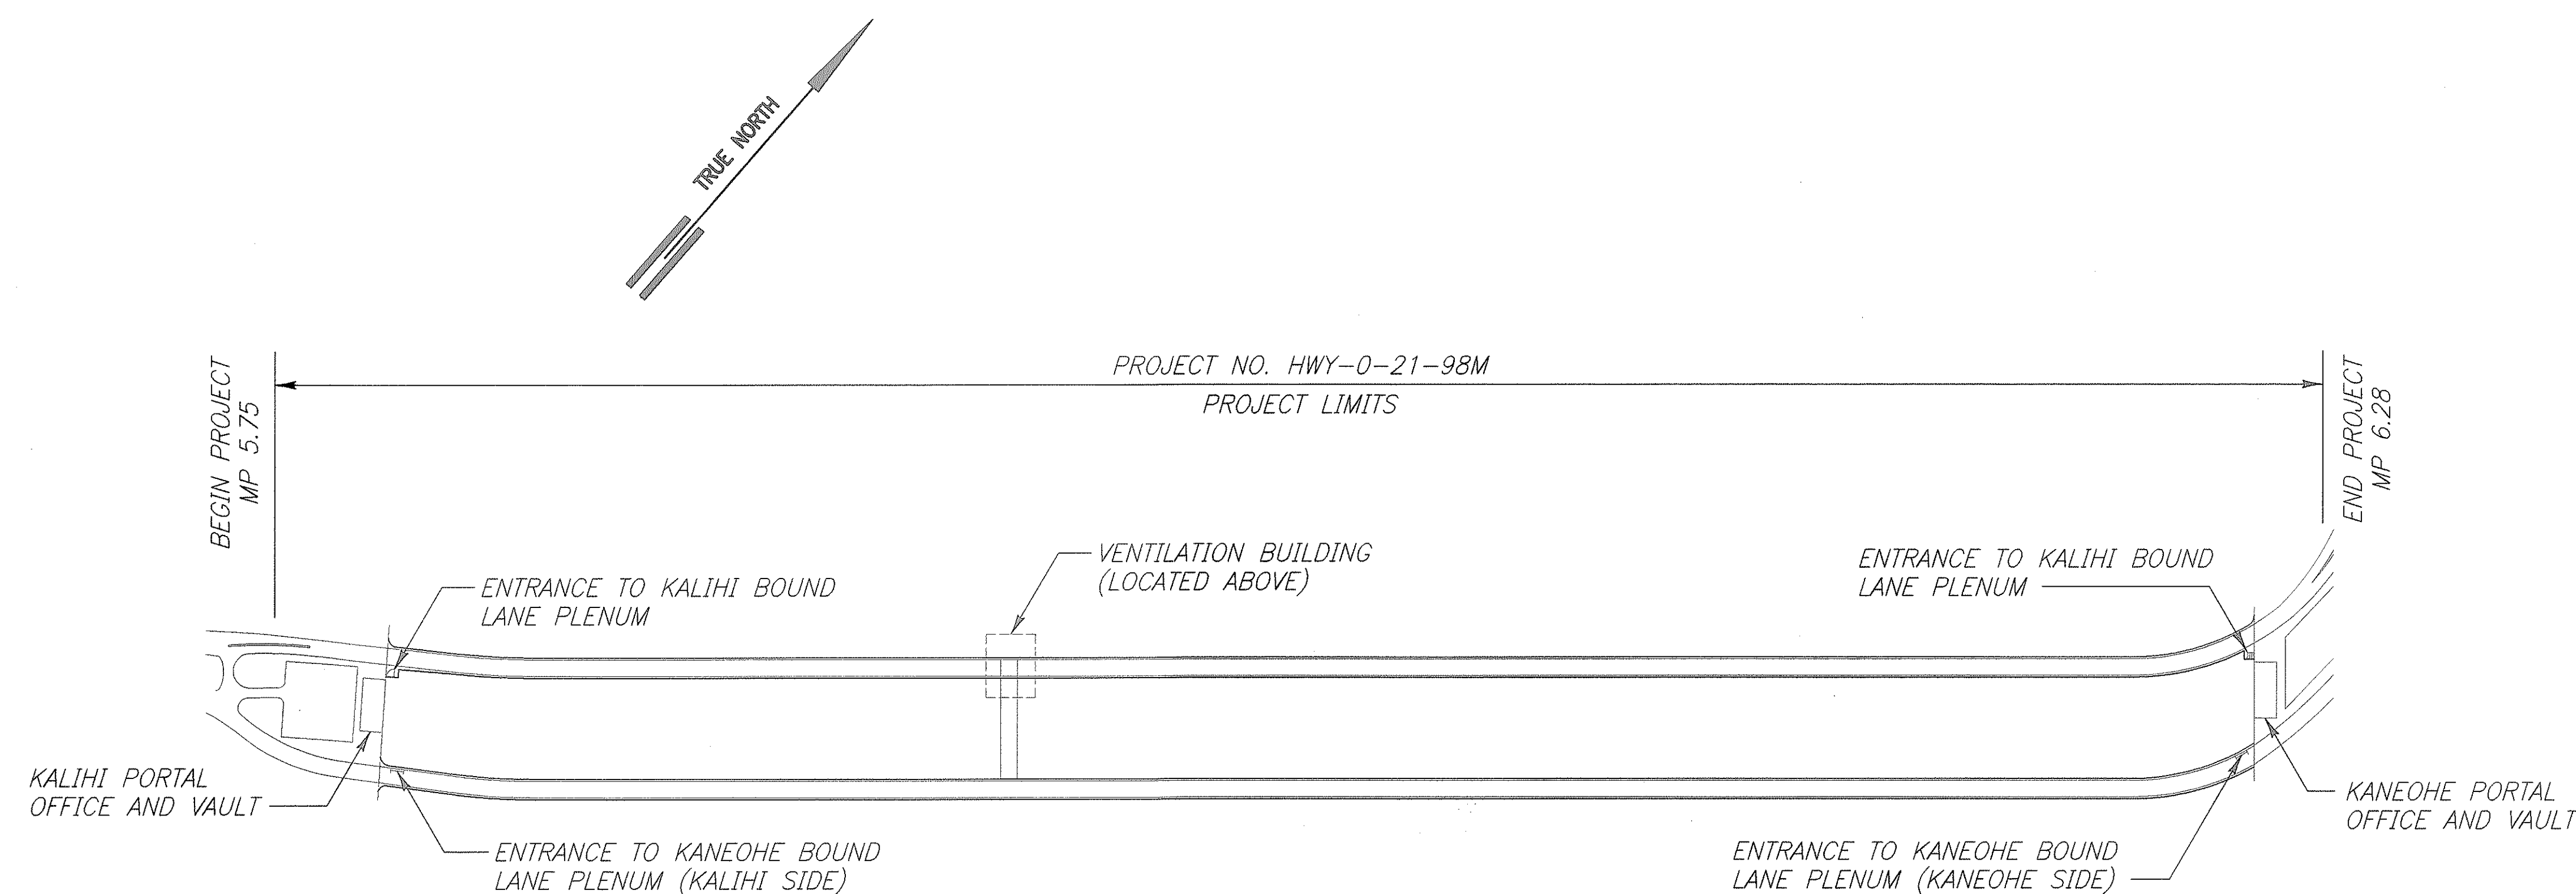

PROJECT SITE PLAN
NOT TO SCALE

CHANGES MADE DURING CONSTRUCTION HAVE BEEN INCORPORATED ON THESE PLANS EXCEPT CHANGES IN THE ORIGINAL THEORETICAL QUANTITIES. FOR ACTUAL QUANTITIES, REFER TO PROJECT LEDGER AND/OR COMPUTATION BOOK.

RESIDENT ENGINEER

DEPARTMENT OF TRANSPORTATION
STATE OF HAWAII

APPROVED: *[Signature]* 11-9-00
DIR. OF TRANSPORTATION DATE