

HIGHWAY LIGHTING NOTES

1. The Contractor Shall Notify Electrical Maintenance Section, Department Of Transportation, State Highway Division, 72 Hours In Advance Before Commencing Installation Of Highway Lighting System. Phone: 837-8056.
2. All Luminaires Shall Be High Pressure Sodium Type With Wattage And I.E.S. Type Light Distribution As Shown On The Approved Plans.
3. The Contractor Shall Have One Set Of Approved Plans At Job Site At All Times During The Construction Work And Record All Changes Occur On Construction Of Highway Lighting System.
4. The Contractor To Stencil Date Of Installation At The Bottom Of Photocell.
5. Final Acceptance And Inspection Will Be Undertaken Only After All Work Has Been Completed.
6. The Contractor Shall Measure And Record Ground Resistance At Each Standard And Submit Recorded Ground Resistance To Traffic Section, And Oahu District Maintenance Section, Department Of Transportation, State Highway. The Contractor's Electrical Engineer Shall Certify All Electrical Tests, Including But Not Limited To: Continuity Test And The Ground Rod Resistant Test Prior To Submission To The Engineer.
7. Trim Tree Branches To Clear Removal Or Installation Of Street Light Standards, At No Additional Cost To The State.
8. Construction Work Shall Be Scheduled In Such A Manner That Street Lighting Is Provided During All Hours Of Darkness Either With New Or Existing Luminaires Or A Combination Thereof. Temporary Connections Shall Be Made To Accomplish This End. The Continuity Of Street Lighting Circuits Shall Be Maintained Until The Existing Street Lighting System Are Ready For Removal. Partially Completed Work in Highway Shall Be Paved (Steel Plates Not Allowed). All Removal And Replacement of Temporary Paving Shall Be Incidental To Ductline Work. Special Condition-Only in Low Speed Traffic Areas May Steel Plates Be Used To Protect Partially Completed Work., With Approval of Engineer. Maintaining existing street lighting system or provide temporary lighting to support night construction activities and coordinate all requirements with General Contractor, including additional floodlights on portable generators.
9. Where Existing Highway Lighting Luminaires On Metal Standards Are Indicated To Be Removed The Luminaire, Pole and Pull Box Shall Be Removed And Disposed Of By The Contractor. The Foundation Shall Be Demolished To 36" Below Grade And The Surfaces Affected Shall Be Restored To Match The Surroundings.
10. New Pole Locations Shall Be Staked And Approval Of Locations Shall Be Obtained From The Engineer Before Pole Locations In The Field Will Be Required To Clear Underground And Aerial Utility Lines, And Guard Rails.
11. The Contractor Shall At His Expense Keep The Project And Surrounding Area Free From Dust Nuisance And Shall Be Responsible For Cleaning And Removal Of All Silt And Debris Generated By The Excavation Work And Deposited And Accumulated Within Downstream Waterways, Ditches, Drain Pipes And On Public Roadways. Any Citations (Fines) Received By The State For The Contractor's Noncompliance Of Any Department Of Health Regulations Shall Be Deducted From The Progress Payment.
12. The Contractor Shall Locate Existing Buried Utility Lines In The Vicinity Of The Excavation Work Prior To Commencing Excavation, As A Minimum An Electronic Magnetic Device For Detection Of Buried Lines Shall Be Utilized Prior To Excavation. Trenches Shall Be Excavated With Care. The Contractor Shall Be Responsible For Damages To Existing Utilities Resulting From His Negligence And Shall Bear Cost Of Repairs To The Utilities. Method Of Repair Shall Be Determined By The Affected Utility Company And U.S. Army Signal Corps.

13. The Contractor Shall Reconnect Electrical Power To All Existing Sign Lighting System And Underpass Lighting Fixtures. The Contractor Shall Provide Additional Wiring And Conduit As Required For An Operational System, At No Additional Cost To The State.
14. After The Exact Location Of The Lighting Pole Base Is Determined, Place 2" x 2" x 18" Hubs At These Locations To Inform The Contracting Officer For Final Location Approval Prior To Construction Of Light Bases. Actual Field Conditions May Differ From That Shown On These Drawings. Use Extreme Caution When Excavating For New Ductlines.
15. Provide Conduit Expansion Fitting To Accommodate Expansion And Deflection Where Conduits Cross Seismic Control And Expansion Joints Of Bridge Structures. Expansion Fittings Shall Be:
- Weathertight Construction
 - Insulator Bushing On End Of Movable Conduit.
 - Factory-Formed Copper Braid Ring Allowing Conduit Expansion And Contraction.
 - End Fitting Of Feraloy
 - Steel Conduit Body
 - Zinc Electroplate And Aluminum Cellulose Lacquer Finish
 - 8" Maximum Conduit Movement
 - Crouse-Hinds XJ Series Or Approved Equal
16. The Electrical Contractor Shall Have Personnel On The Project That Comply With The Following Qualifications:
- One (1) Registered Master Electrician In The Company.
 - Certified Journeyman Electrician At Each Construction Location To Perform Splicing Of Cables And All Required Wiring Work.

17. To Install Ductline In Existing Conditions, Saw Cut Existing Pavement, Curbs, Sidewalks And Repair To The Satisfaction Of The Engineer.

For Ductlines Affecting Traffic, Excavation, Ductline Including Concrete Jacket, Backfill, Compaction, And Final Traffic Bearing Pavement Shall Be Completed And Ready For Traffic Each Day. During The Course Of The Work, Maintain A Minimum Of One (10-Foot Wide) Traffic Lane At All Times.

Ductline Shall Be Constructed With Low Strength Fast Curing Concrete And A Minimum Cover Of 36-Inches Or 2500 Psi Precast Concrete Ducts With 4500 Psi Epoxy Joint Collar And A Minimum Cover Of 24-Inches. Backfill Shall Include Appropriate Road Base And Sub-Base Courses To Match Existing Condition And Compaction To Standard Specifications Requirements.

18. For Non-Pavement Areas, Appropriate Finish Surface Shall Be Restored (Grass, Sidewalk, Or Shoulder Pavement). At Sidewalks, Replace The Entire Modular Section Of Sidewalk (From Construction Joint To Construction Joint). Trench Width Patches In Sidewalks Shall Not Be Accepted.
19. Ductline Crossing Highway Shall Be Constructed In Sections To Allow One Lane Traffic Flow During Work Periods, With A Minimum Of Two Sections For Each Direction Of Traffic Flow. Joints Shall Be Made With High Strength Concrete. Steel Plates Covering Temporary Work Shall Not Be Allowed.

20. Installation of the New Ductline Adjacent to Existing Ductlines Is Allowed. When Necessary, Dive Under Existing Ductline Or Utilities For Crossover.

Existing Ductline Shall Remain Active Until New Street Light System Completed.


21. Relocate All Direct Buried Signal Corps Cable Markers, Off Set To Behind Guard Rail And Provide Instructions For Locating Cable. Obtain Army Corps of Engineers Requirements And Approval. Install Adjacent To Guard Rails. Handholes Shall Be A Minimum Of 2x4.

FED. ROAD DIST. NO.	STATE	PROJ. NO.	FISCAL YEAR	SHEET NO.	TOTAL SHEETS
HAWAII	HAW.	CM-STP-063-1(21)	2002	155	187

HIGHWAY LIGHTING SYMBOLS

- New Double-Arm Aluminum Pole, 250W HPS w/ Transformer Base
- New Single-Arm Aluminum Pole, 250W HPS w/ Transformer Base
- New Single-Arm Aluminum Pole, 150W HPS w/ Transformer Base
- Existing Double-Arm Steel Pole
- Existing Single-Arm Steel Pole
- New Pullbox, Highway Lighting
- Existing Pullbox, Highway Lighting
- New Underground Raceway, Street Lighting
- Existing Underground Raceway, Street Lighting
- Saw Cut Existing Pavement, Excavate, Install New Underground Raceway with 36-Inches Cover, and Patch Pavement
- Duct Section Indicator, See Sheet 175 for Duct Sections

Contract No.	1	6	Pole No.
Luminaire	1-N250 (55V)	II	Type Distribution
Circuit No.	2	A,B	Phase
Station	Sta. 101+40	15'	Arm Length
	480V		Voltage

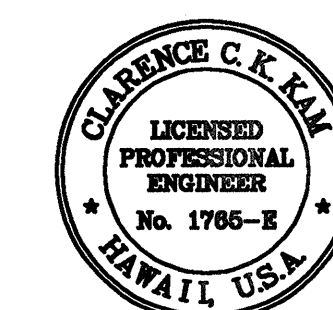

THIS WORK WAS PREPARED BY ME
OR UNDER MY SUPERVISION.

C. Kim

STATE OF HAWAII
DEPARTMENT OF TRANSPORTATION
HIGHWAYS DIVISION
HIGHWAY LIGHTING NOTES

LIKELIKE HIGHWAY RESURFACING
Emmeline Place to the Wilson Tunnel
F. A. Project No. CM-STP-063-1(21)
Scale: None Date: December, 2001
SHEET No. 1 OF 28 SHEETS

HIGHWAY LIGHTING NOTES (CONT.):

FED. ROAD DIST. NO.	STATE	PROJ. NO.	FISCAL YEAR	SHEET NO.	TOTAL SHEETS
HAWAII	HAW.	CM-STP-063-1(21)	2002	156	187

22. Adjust Pole Shaft Length For Down Hill Condition. Street Light Foundations Installed On Slope Vary According To The Grade. Street Light Pole Shaft (Long) To Provide 30-Foot Between Pavement And Bottom Of Luminaire.

23. New Ductline Installed In The Close Vicinity Of Existing Signal Corps Cable: Locate Signal Corps Cable Before Initiating Work. Obtain Army Corps of Engineers Requirements And Approval.

24. At Movable Barriers, Stub 2"C From Street Light Junction Box To Movable Barrier Service Section. Provide Feeders And Connect To Movable Barrier Power Terminals And Grounding Lug. Stub Second 2"C To Movable Barrier Sub-Service Section.

Stub 2"C from Movable Barrier Service Section to Sub-Service Section and Provide Feeders and Connect to Equipment. Connect Grounding Wire to Equipment Grounding Lug.

Provide Grounded Weatherproof Duplex 20A, 125 Volts Receptacle for General Power. Provide 1.0 KVA, 240/480V - 120V Dry Type Transformer, Marine Grade Type Transformer Mounted On Concrete Blocks To Elevate From Grade. Blocks Shall Be Anchored To Ground With No. 4 Reinforcing Rods.


25. New Telephone Handhole, 3x5: Install As Close To Guard Rail As Possible. Obtain Requirements And Approval From Verizon Hawaii (GTE-HTCO) And Oceanic Cable. Arrange For Verizon Hawaii (GTE-HTCO) And Oceanic Cable To Relocate Existing Fiber Optics And Telephone Cables To New Ductline Before Initiation Of The Median Barrier Demolition and Construction.

26. Excavation And Ductline Including Concrete Jacket, Backfill, Compaction, And Final Backfill Shall Be Completed And Ready For Acceptance On Same Day As Initiation. Partially Completed Work In Highway Shall Be Paved (Steel Plates Not Allowed). All Removal And Replacement Of Temporary Paving Shall Be Incidental To Ductline Work.

27. For Work In Non-Travel Ways (Shoulders) Adjacent To Travel Ways, Close Trench Same Day As Opening. For Grassed Area, Re-sod, Maintain (Water And Fertilizer Minimum 30-Days), And Establish Growth. Trees And Shrubs Encounters Shall Be Avoided By Shifting Ductline Route. Adjust Ductline Route To Avoid Obstructions Both Above And Below Grade.


28. Existing Ductline Where New Barrier Is To Be Constructed: Adjust Location of Barrier To Clear Existing Active Verizon Hawaii (GTE-HTCO) Ductline Unless New By-Pass Facilities Have Been Completed And Existing Verizon Hawaii (GTE-HTCO) and Oceanic Cable Facilities Have Been Relocated. When Existing Verizon Hawaii (GTE-HTCO) Ductline Is Abandoned, Remove Ductlines And Handholes (Manholes) To Accommodate The Barrier Installation Work.

29. Complete All Ductlines For Hawaiian Telephone Company, Oceanic Cablevision Company And Army Corps Of Engineers A Minimum Of 90 Days Before Scheduled Demolition Of Medians Or Roadway Reconstruction Work.

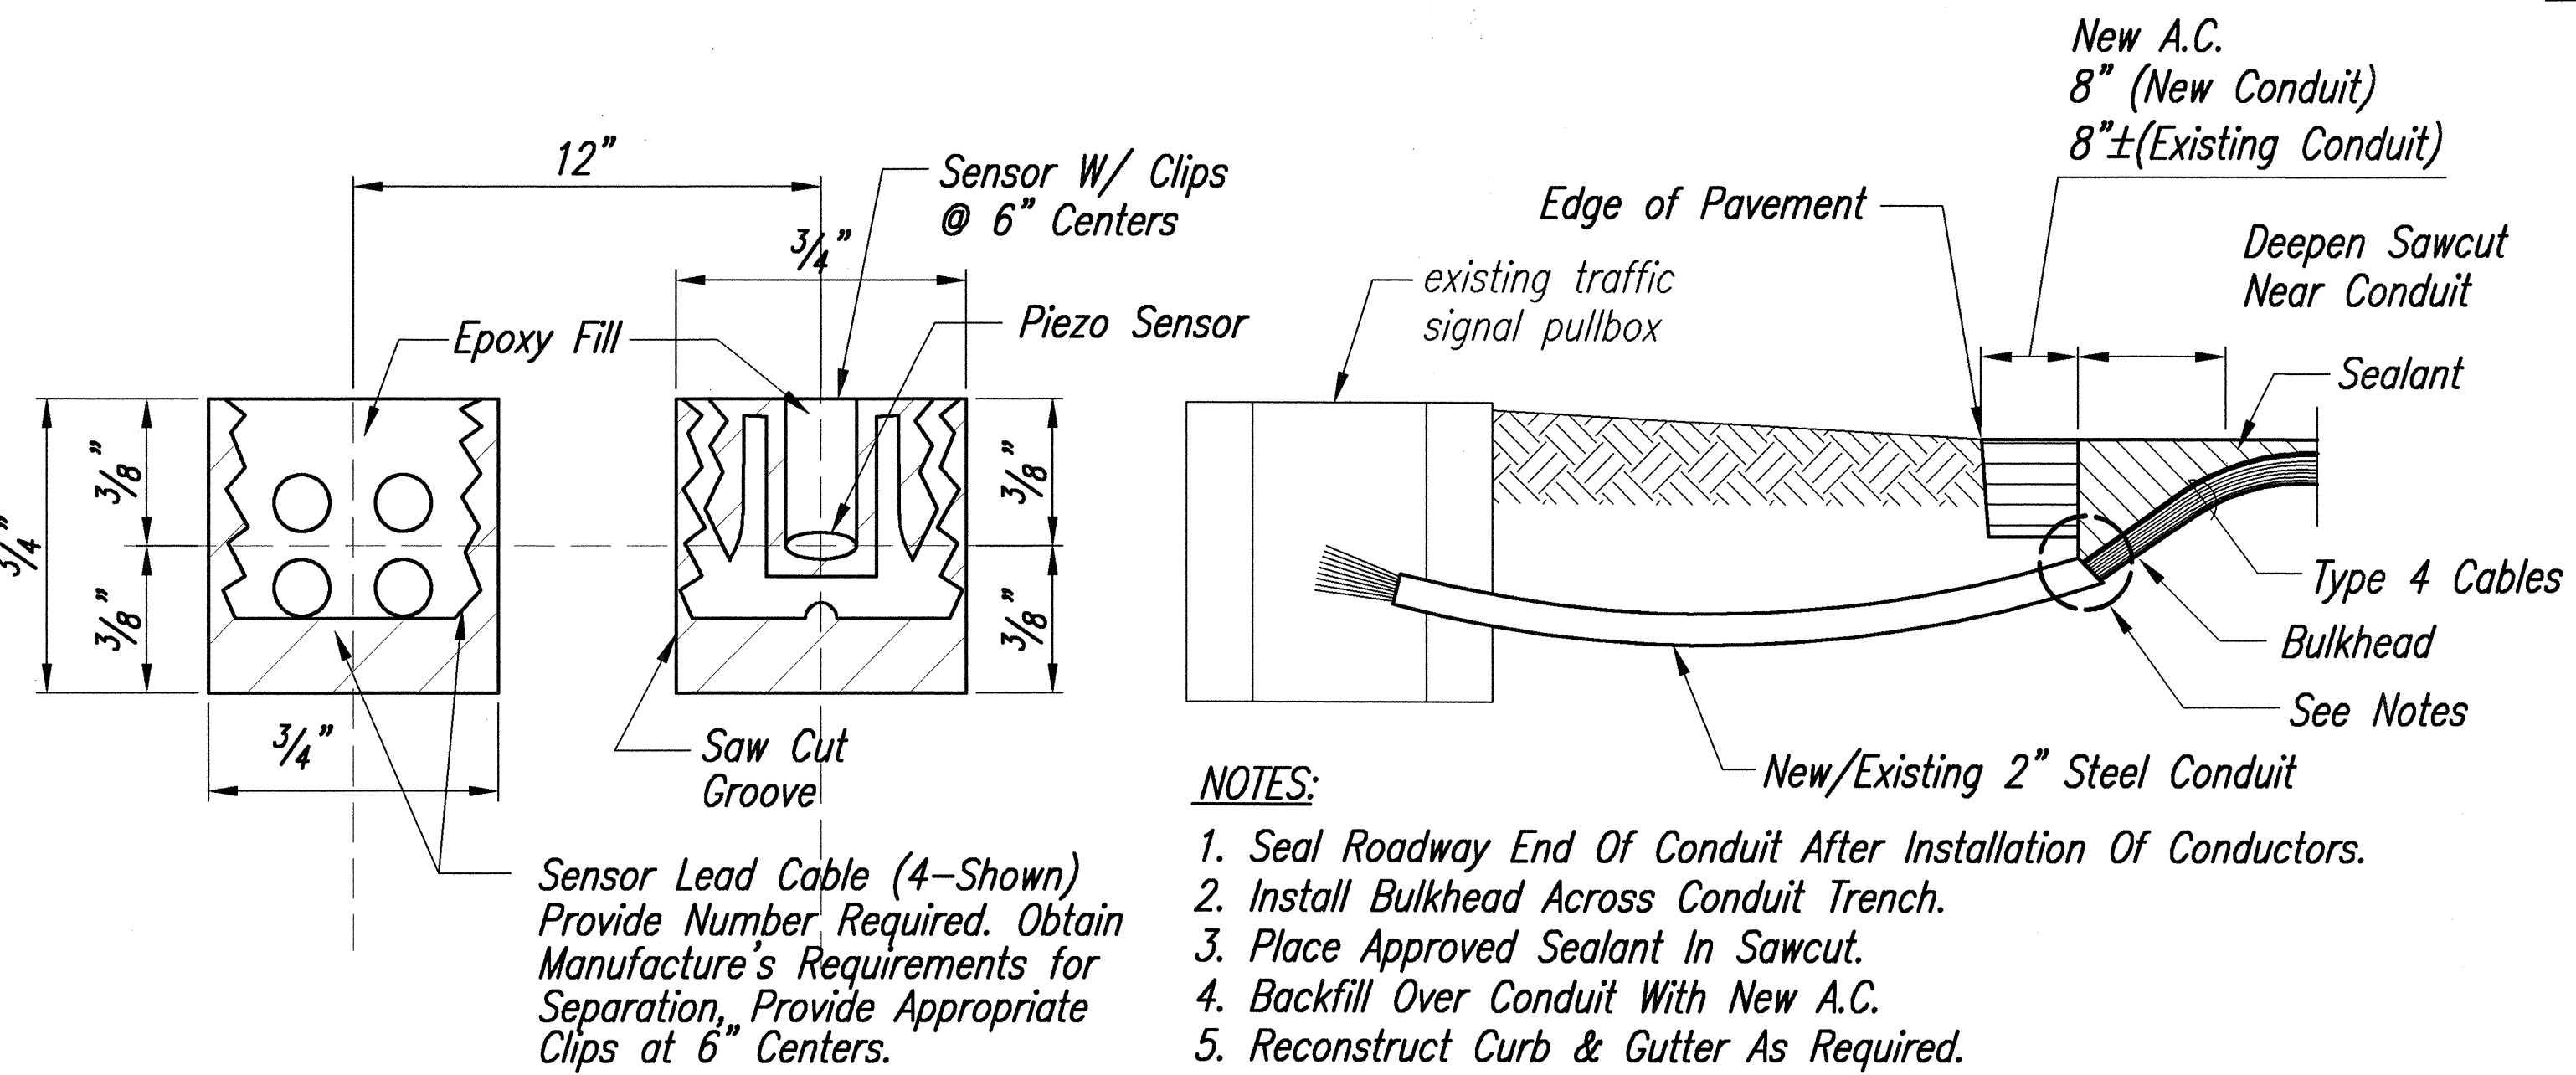


PIEZO SENSOR AND LEAD
INSTALLATION DETAIL
Not to Scale


SENSOR LOOP INSTALLATION AT
EDGE OF ROADWAY
Not to Scale

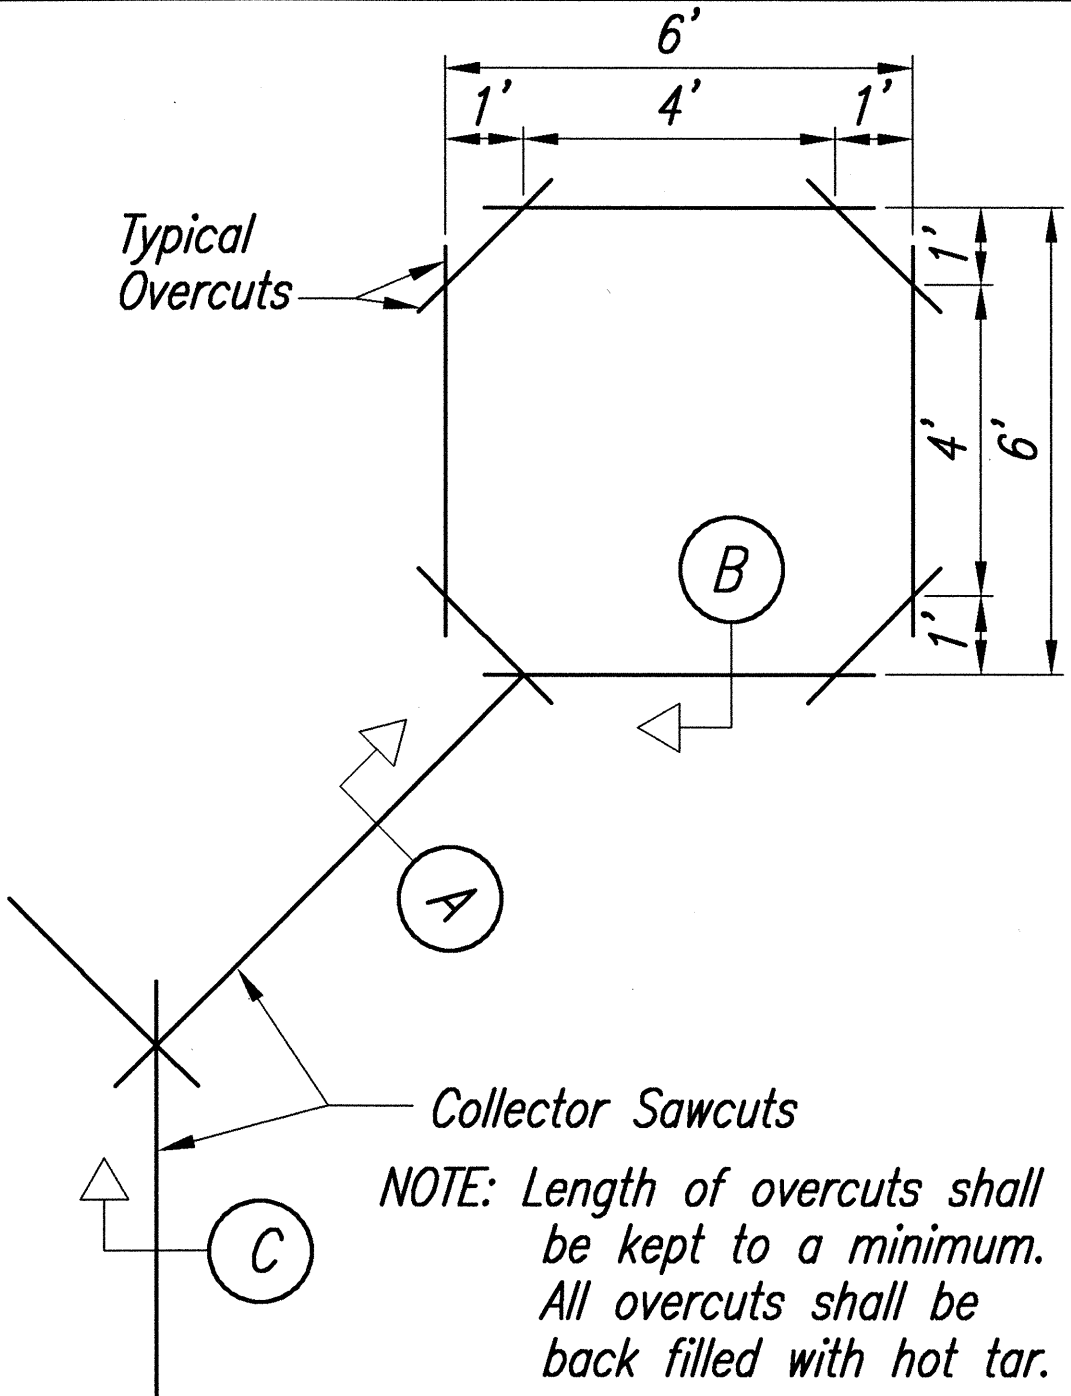


TYPICAL SENSOR LOOP SAWCUT DETAIL
Not to Scale

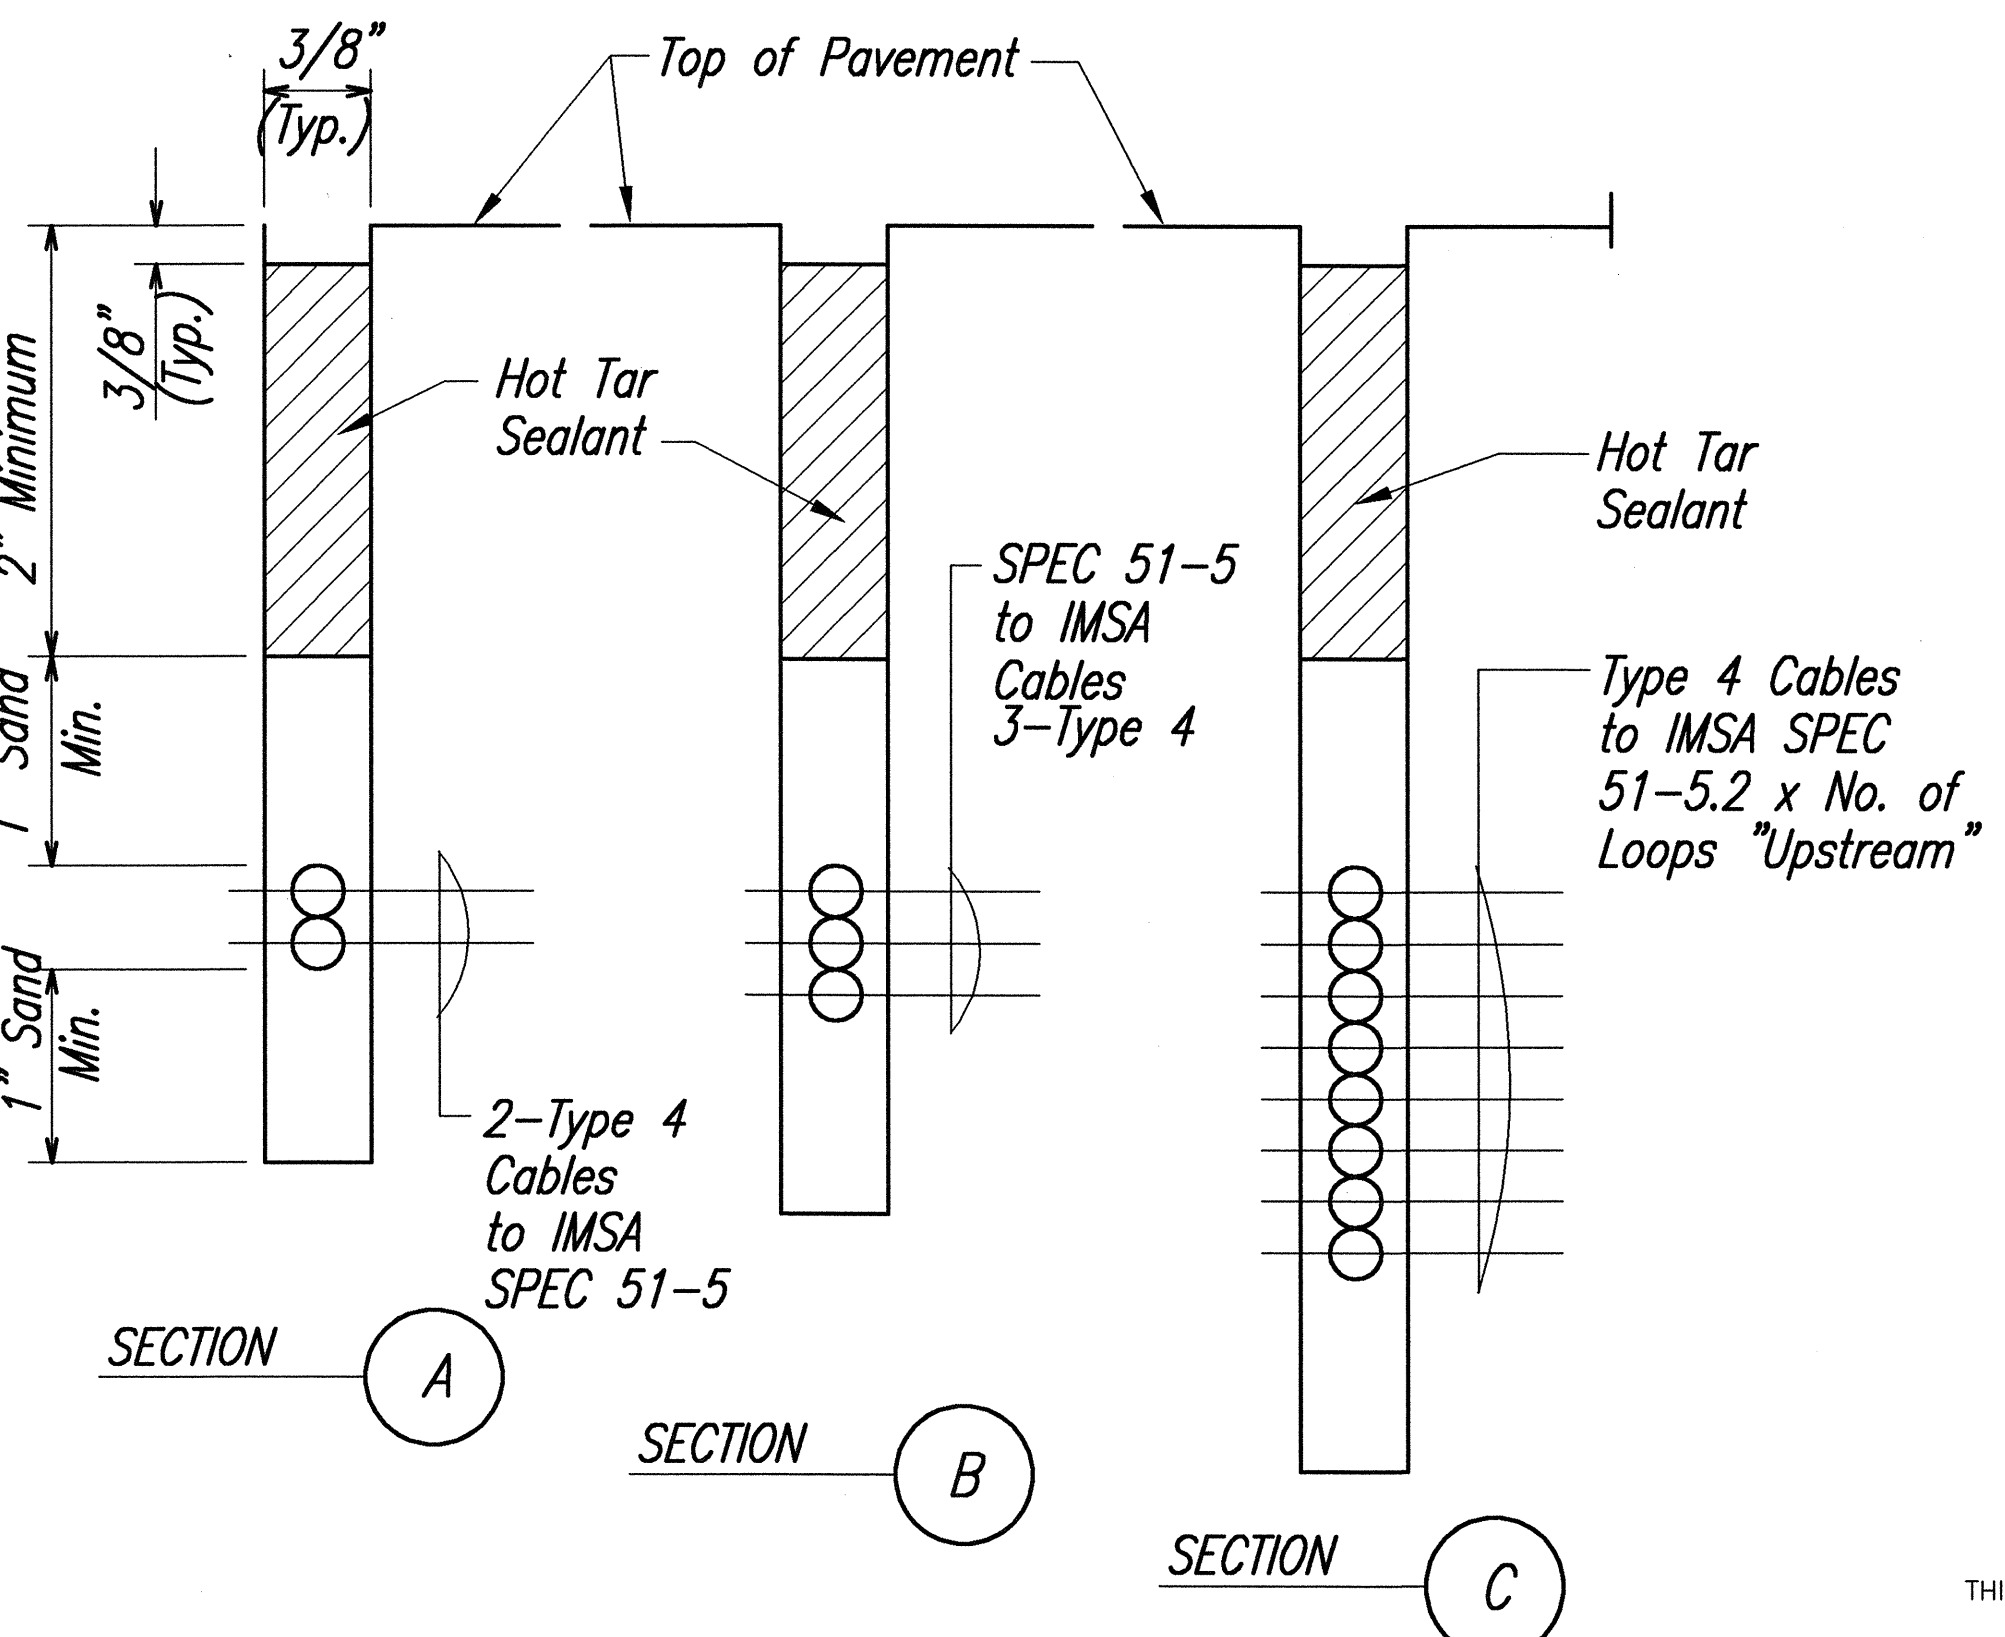

TYPICAL SECTION THROUGH SENSOR LOOP
Not to Scale

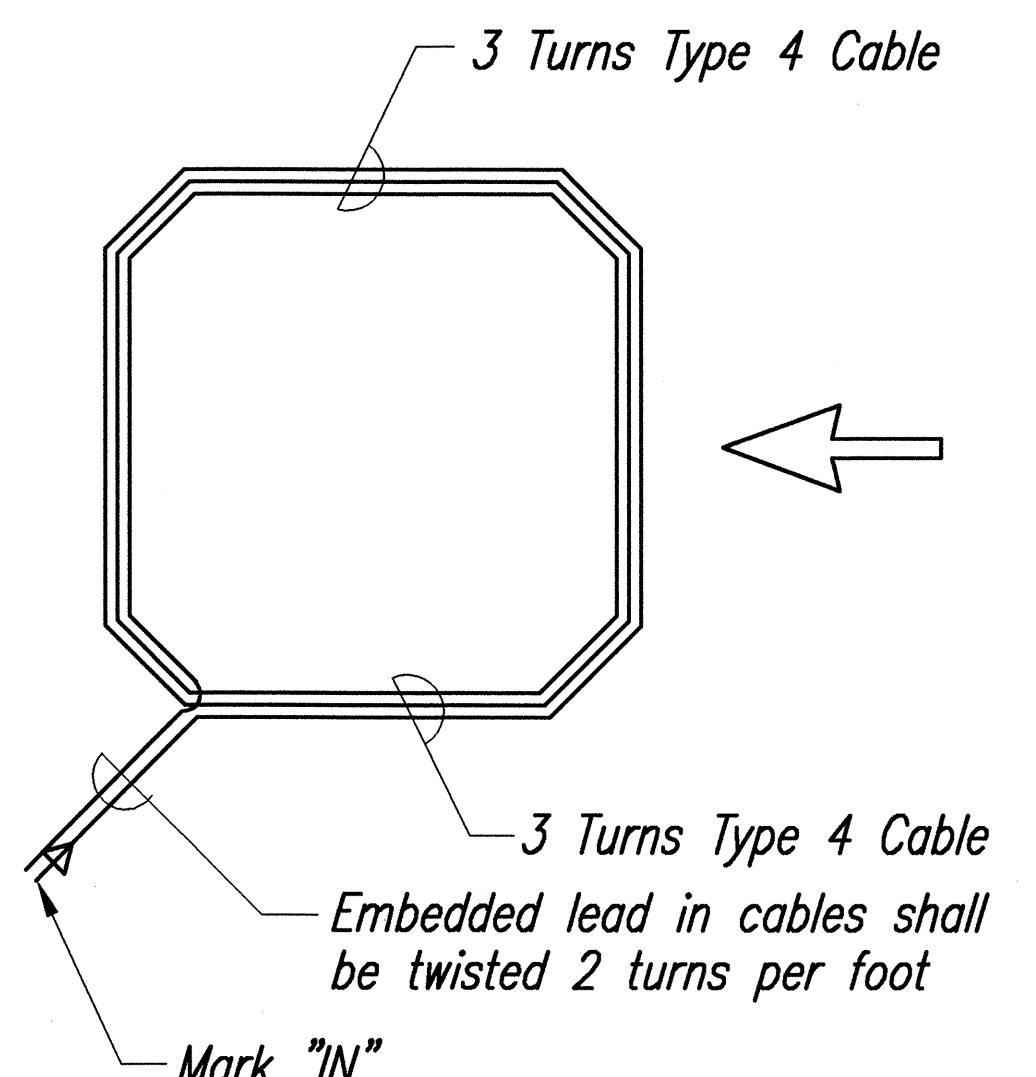

TYPICAL SENSOR LOOP WIRING DIAGRAM
Not to Scale

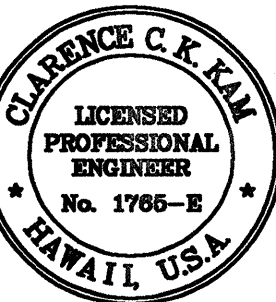


THIS WORK WAS PREPARED BY ME
OR UNDER MY SUPERVISION.



C. Kim

STATE OF HAWAII
DEPARTMENT OF TRANSPORTATION
HIGHWAYS DIVISION
**HIGHWAY LIGHTING NOTES AND
TRAFFIC SIGNAL DETAILS**
LIKELIKE HIGHWAY RESURFACING
Emmeline Place to the Wilson Tunnel
F. A. Project No. CM-STP-063-1(21)
Scale: None Date: December, 2001
SHEET No. 2 OF 28 SHEETS

FED. ROAD DIST. NO.	STATE	PROJ. NO.	FISCAL YEAR	SHEET NO.	TOTAL SHEETS
HAWAII	HAW.	CM-STP-063-1(21)	2002	157	187

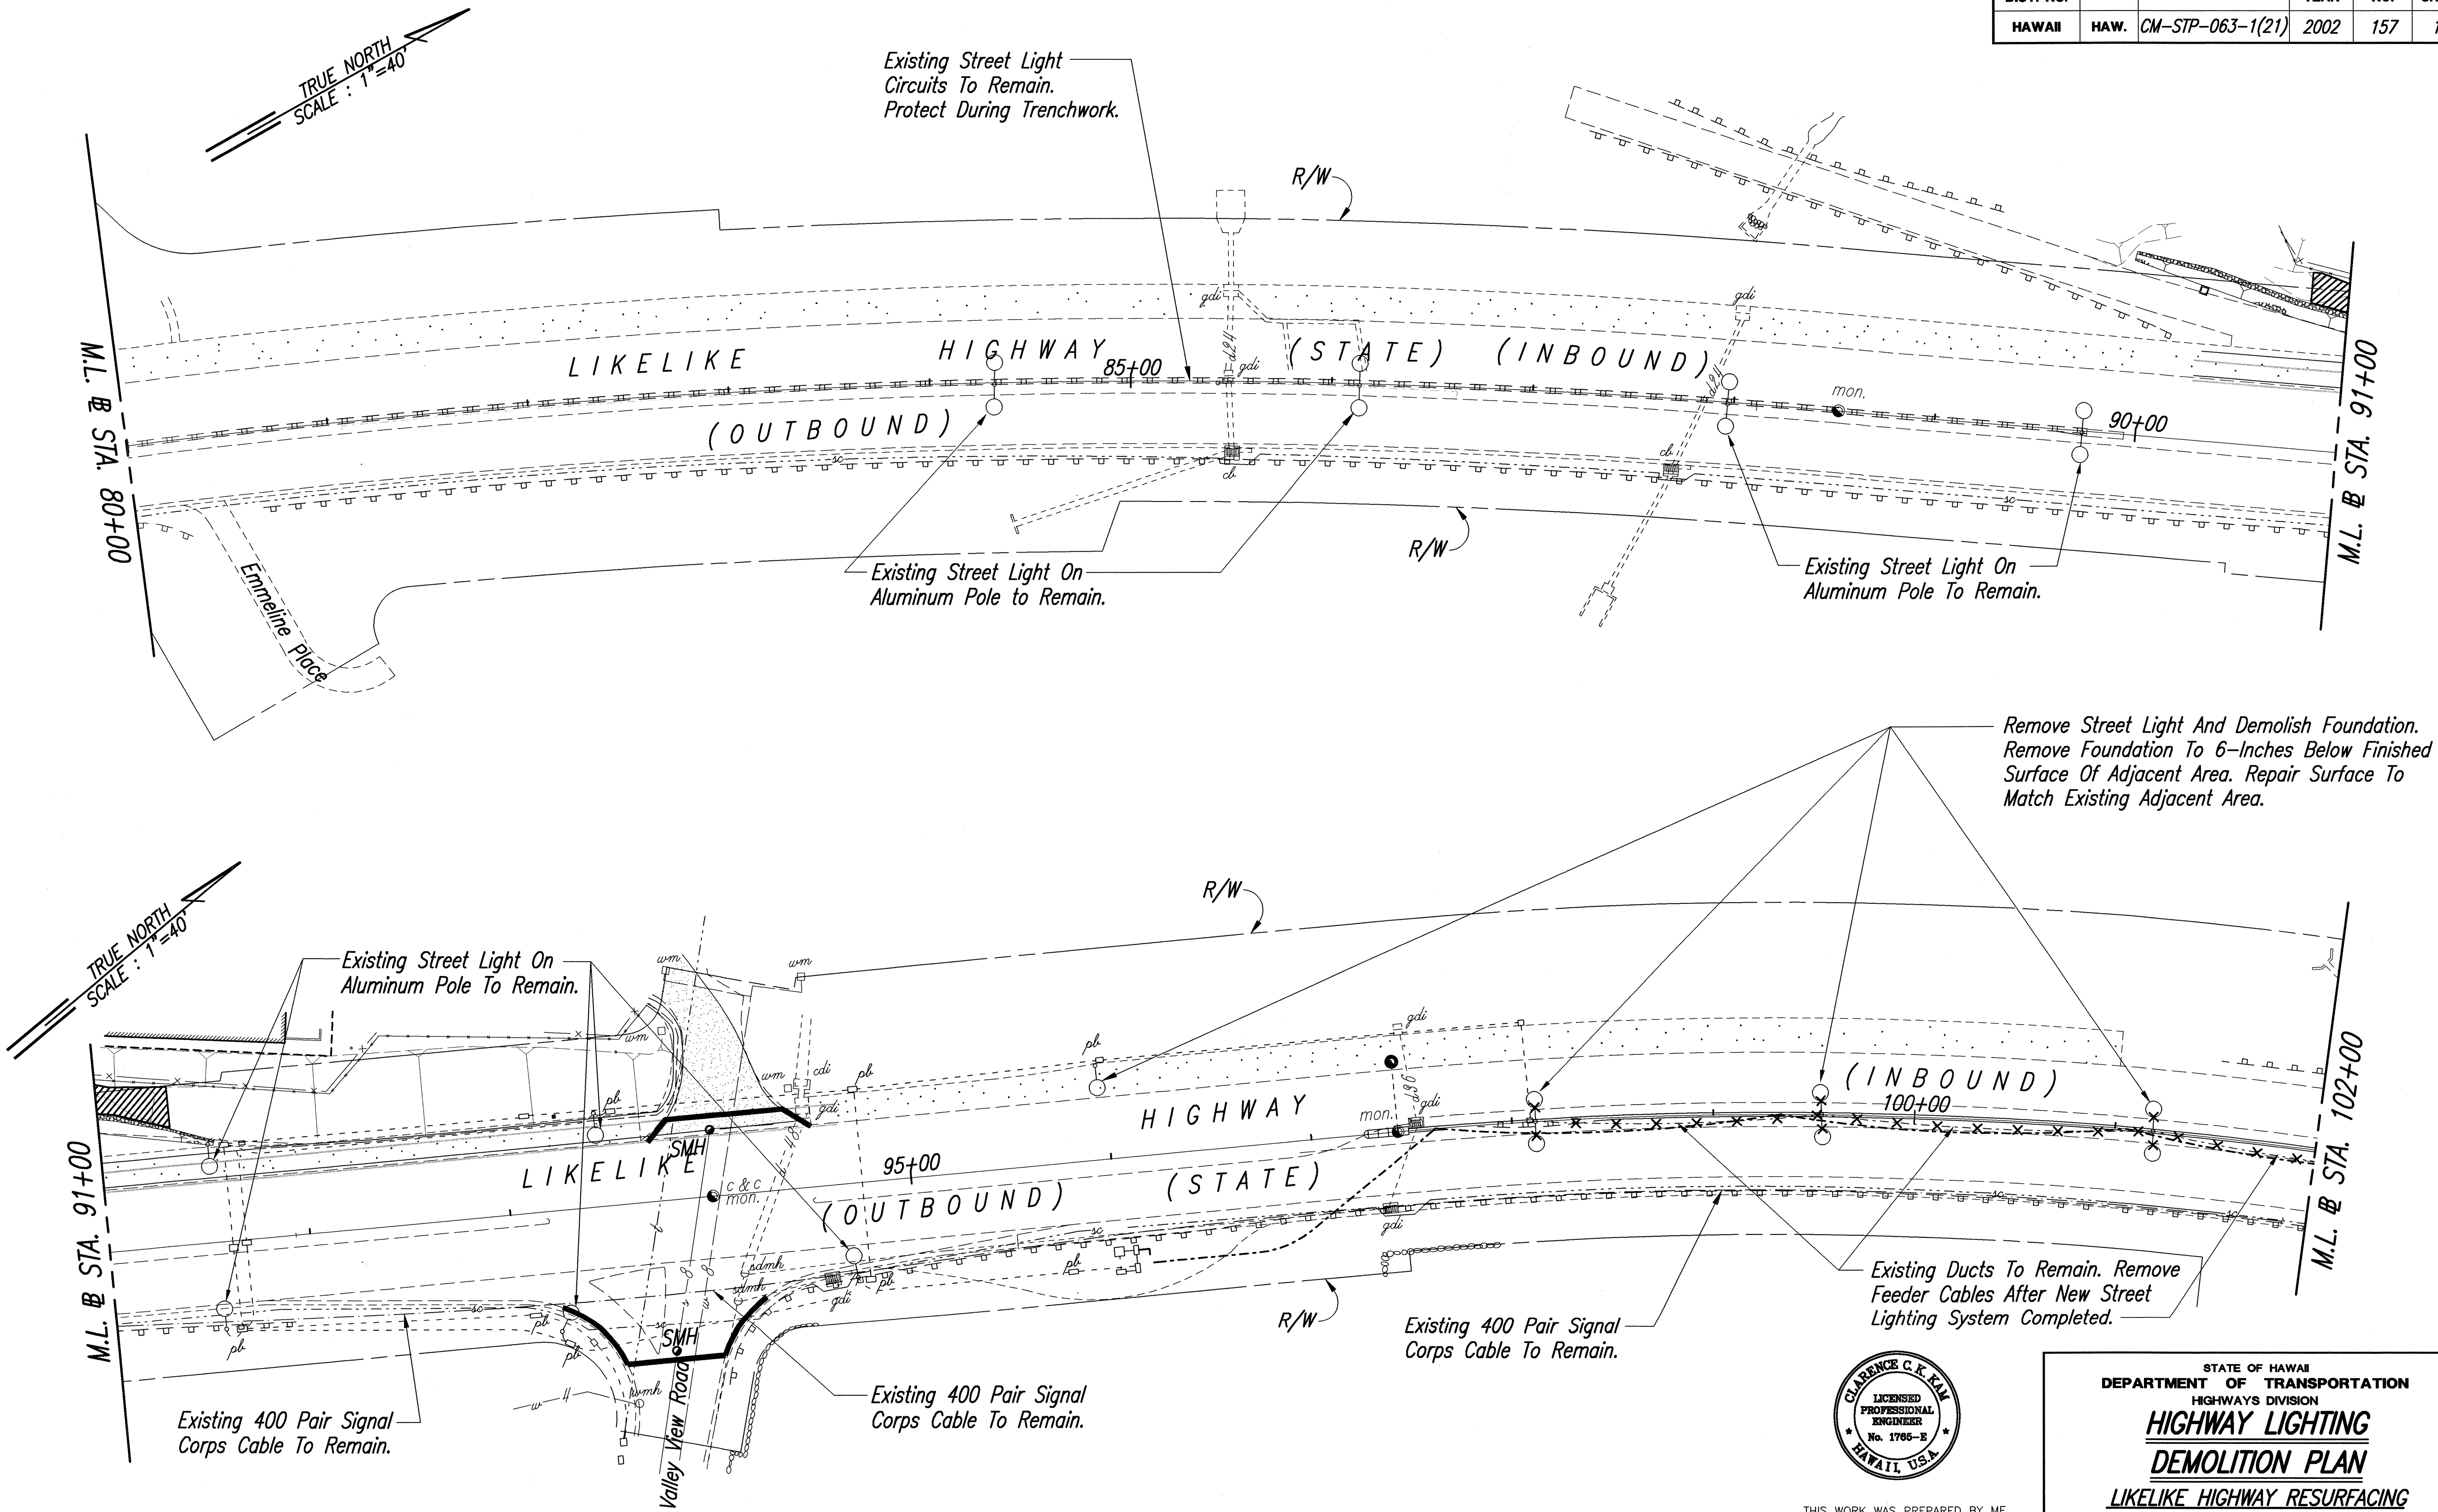

ORIGINAL PLAN	SURVEY PLOTTED BY	DATE
NOTE BOOK	DRAWN BY	
	DESIGNED BY	
	QUANTITIES BY	
	CHECKED BY	
	No.	

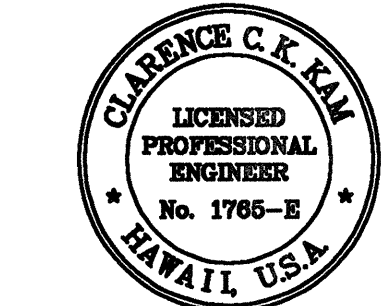
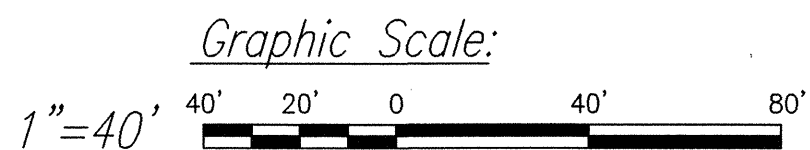


THIS WORK WAS PREPARED BY ME
OR UNDER MY SUPERVISION.



C. Kim

STATE OF HAWAII
DEPARTMENT OF TRANSPORTATION
HIGHWAYS DIVISION
HIGHWAY LIGHTING
DEMOLITION PLAN
LIKELIKE HIGHWAY RESURFACING
Emmeline Place to the Wilson Tunnel
F. A. Project No. CM-STP-063-1(21)
Scale: 1"=40' Date: December, 2001
SHEET No. 3 OF 28 SHEETS

FED. ROAD DIST. NO.	STATE	PROJ. NO.	FISCAL YEAR	SHEET NO.	TOTAL SHEETS
HAWAII	HAW.	CM-STP-063-1(21)	2002	158	187

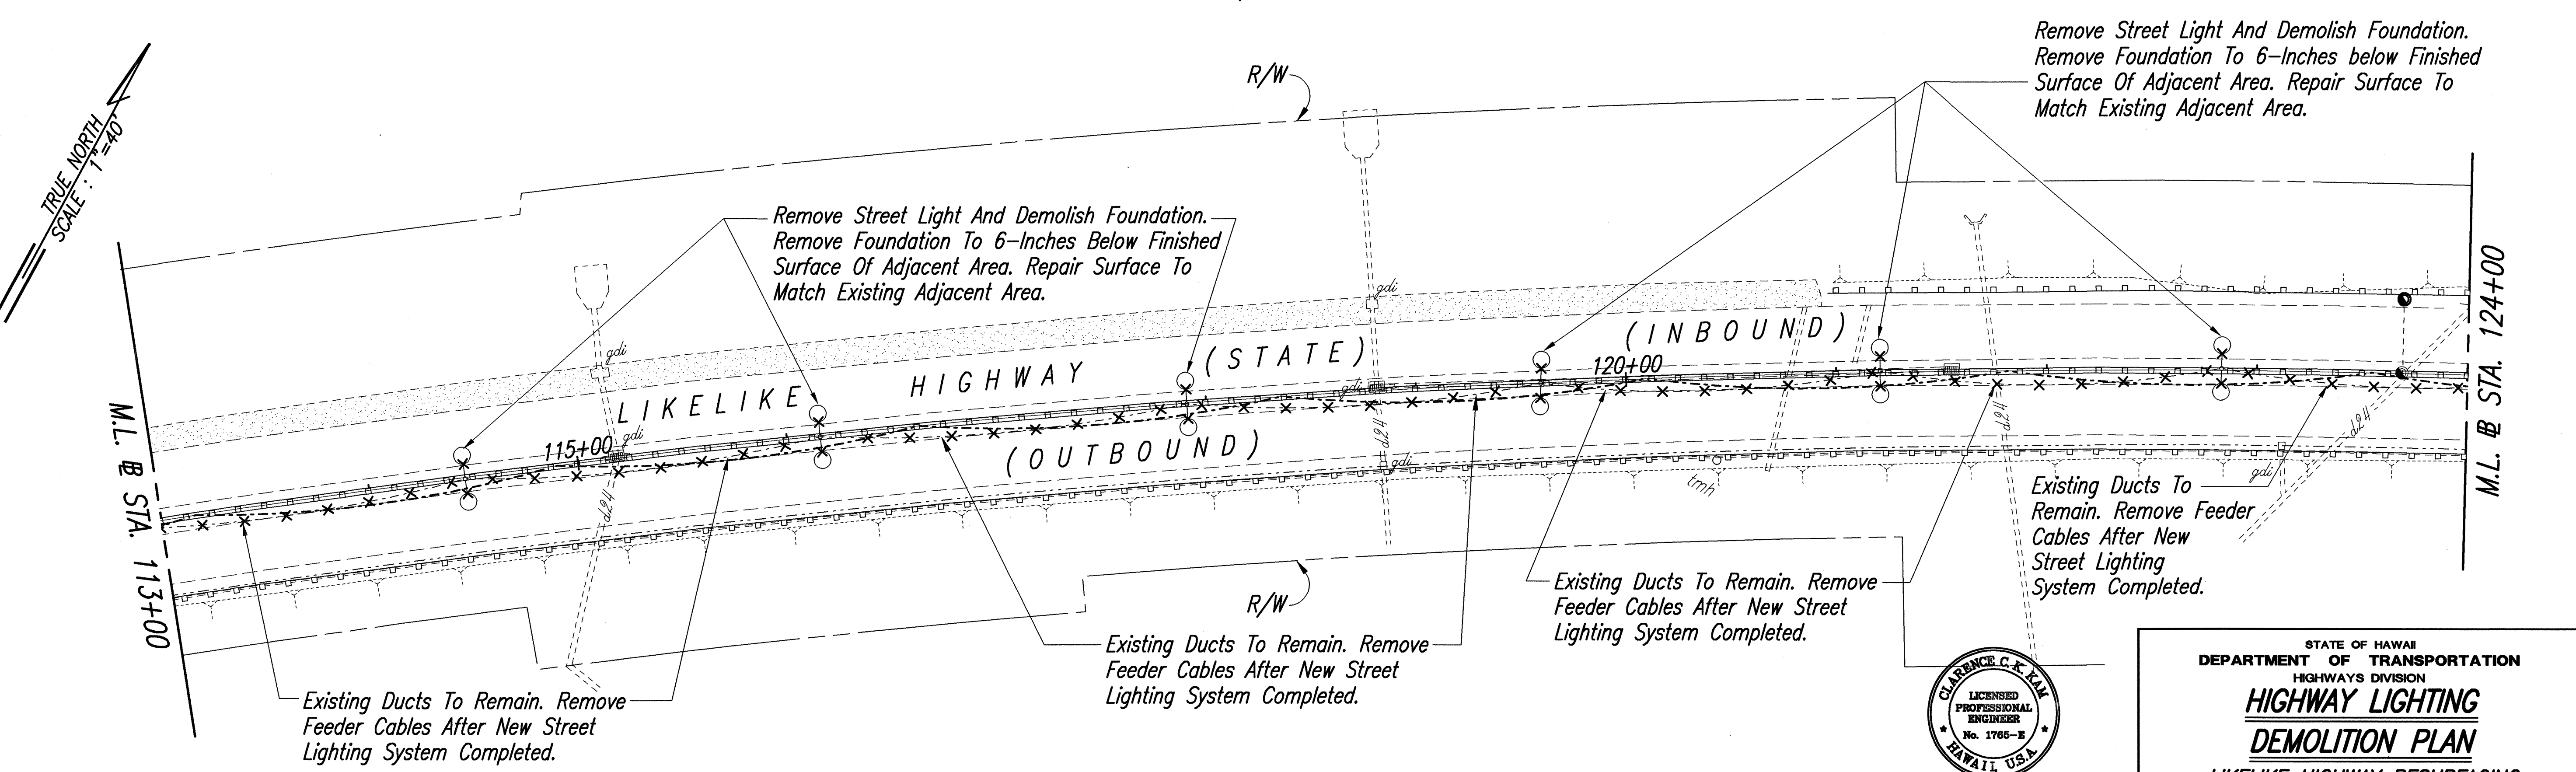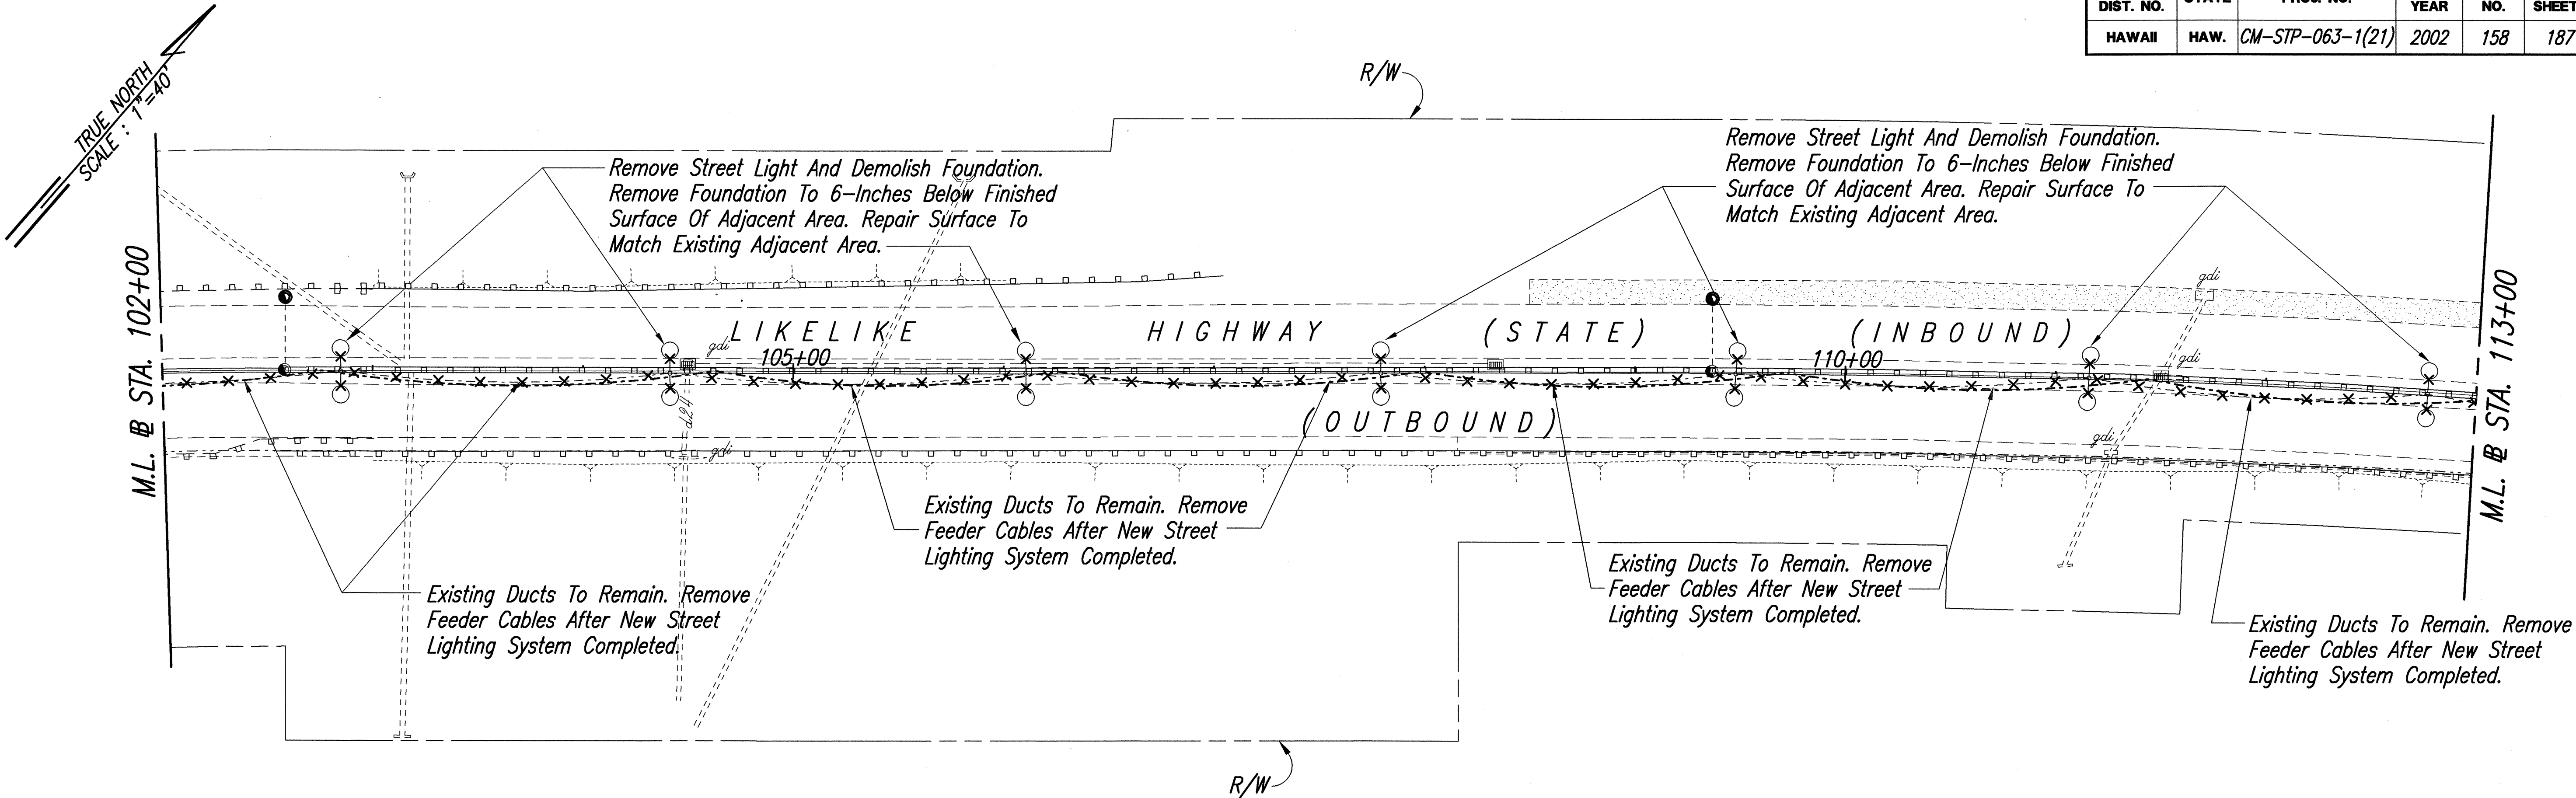

ORIGINAL PLAN	SURVEY PLOTTED BY	DATE
NOTE BOOK	DRAWN BY	
	DESIGNED BY	
	CHECKED BY	
	NO.	

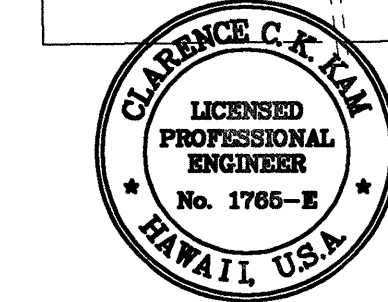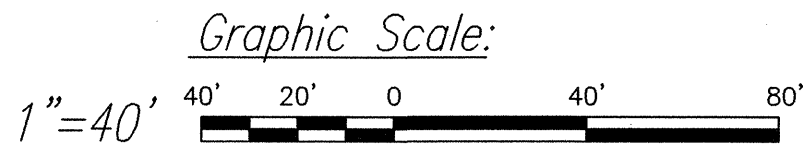

THIS WORK WAS PREPARED BY ME
OR UNDER MY SUPERVISION.

C. Kim

STATE OF HAWAII
DEPARTMENT OF TRANSPORTATION
HIGHWAYS DIVISION



**HIGHWAY LIGHTING
DEMOLITION PLAN**

LIKELIKE HIGHWAY RESURFACING
Emmeline Place to the Wilson Tunnel
F. A. Project No. CM-STP-063-1(21)


Scale: 1"=40' Date: December, 2001

SHEET No. 4 OF 28 SHEETS

FED. ROAD DIST. NO.	STATE	PROJ. NO.	FISCAL YEAR	SHEET NO.	TOTAL SHEETS
HAWAII	HAW.	CM-STP-063-1(21)	2002	159	187

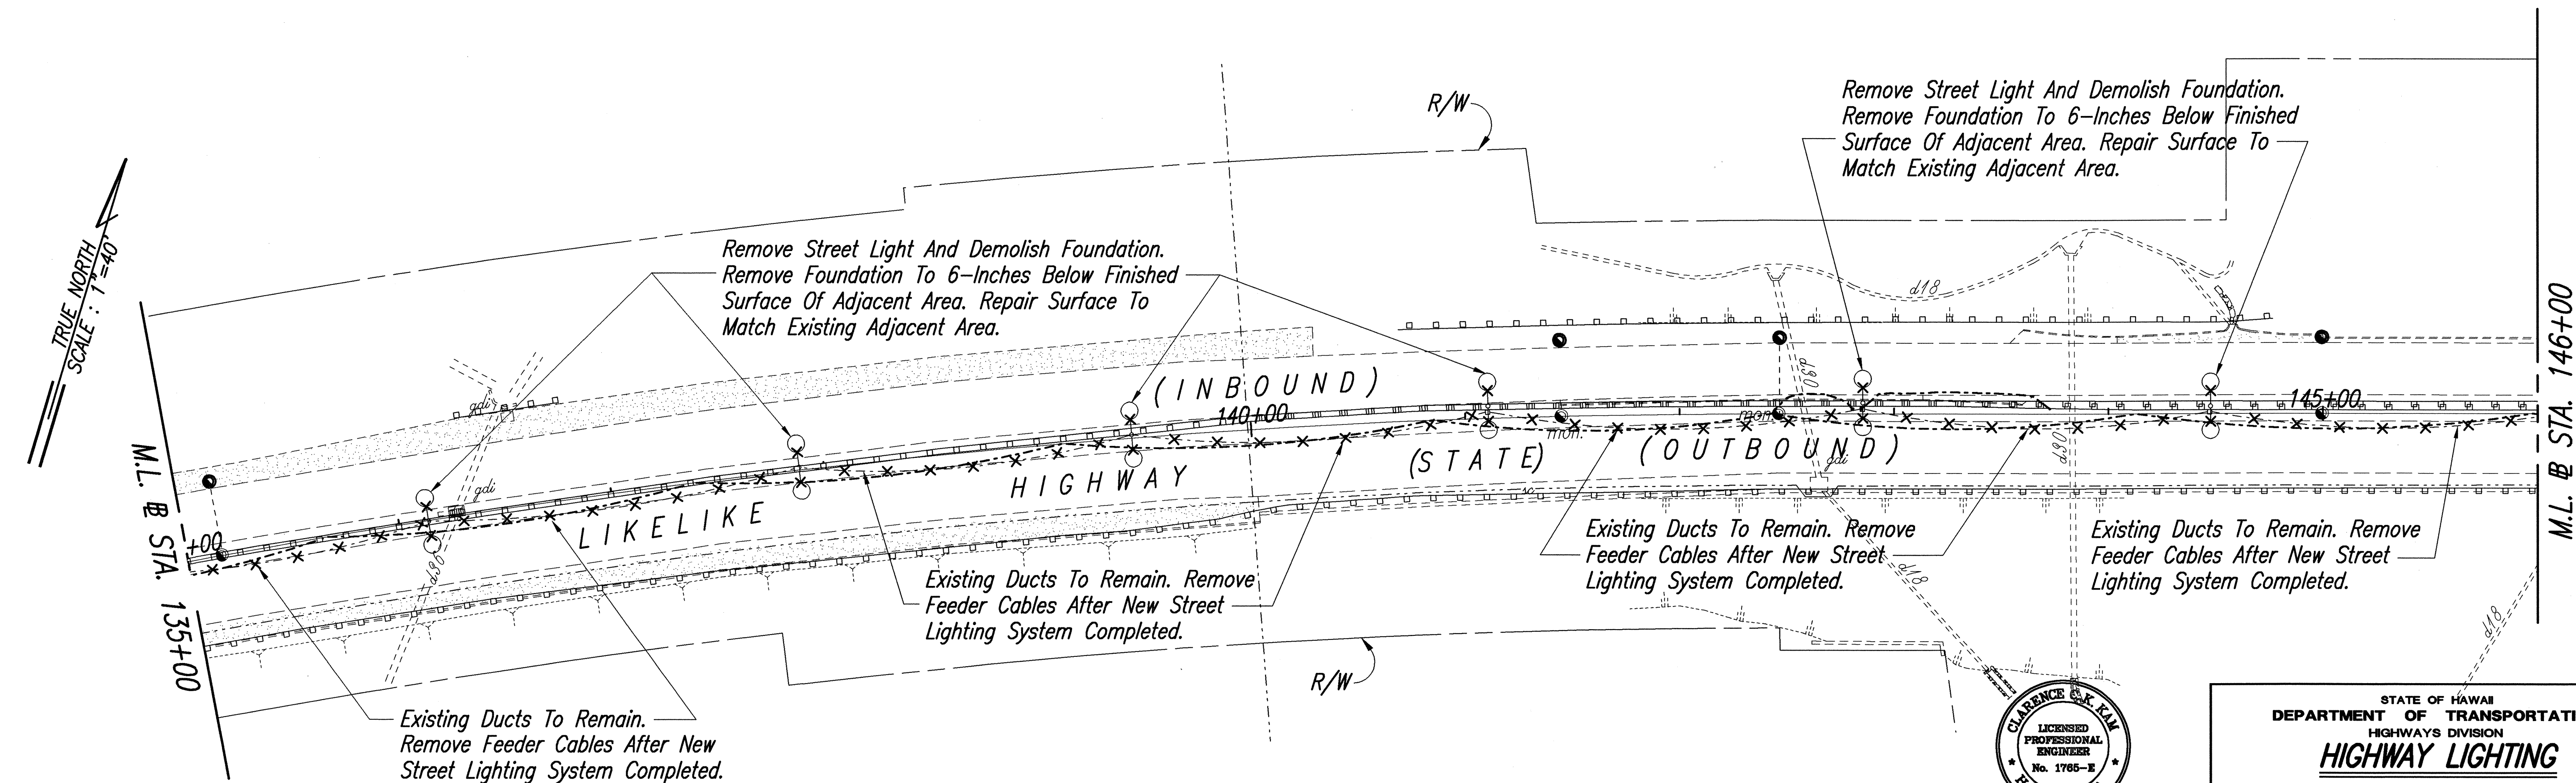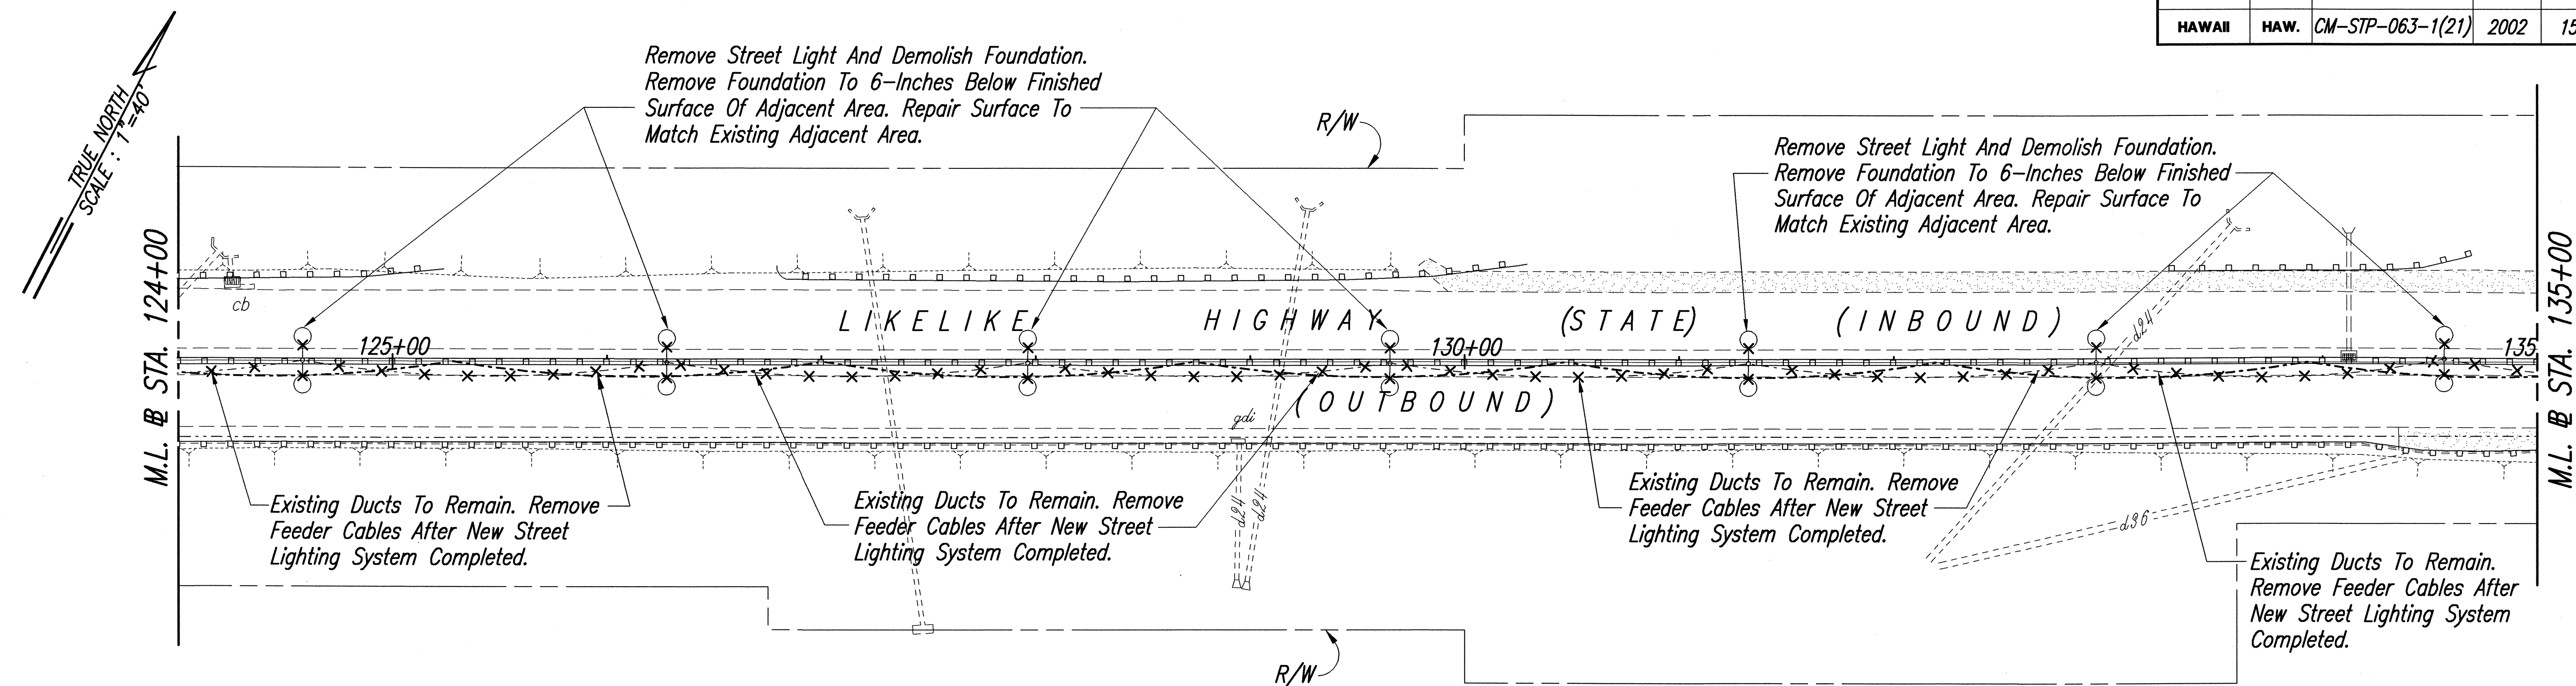

ORIGINAL PLAN	SURVEY PLOTTED BY	DATE
NOTE BOOK	DRAWN BY	
	DESIGNED BY	
	CHECKED BY	
	NO.	


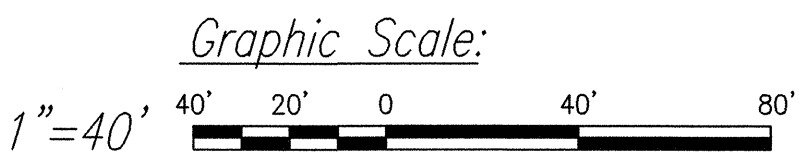


THIS WORK WAS PREPARED BY ME OR UNDER MY SUPERVISION.

C. Kim

STATE OF HAWAII
DEPARTMENT OF TRANSPORTATION
HIGHWAYS DIVISION
**HIKELIKE HIGHWAY LIGHTING
DEMOLITION PLAN**
**LIKELIKE HIGHWAY RESURFACING
Emmeline Place to the Wilson Tunnel
F. A. Project No. CM-STP-063-1(21)**
Scale: 1"=40' Date: December, 2001
SHEET No. 5 OF 28 SHEETS

FED. ROAD DIST. NO.	STATE	PROJ. NO.	FISCAL YEAR	SHEET NO.	TOTAL SHEETS
HAWAII	HAW.	CM-STP-063-1(21)	2002	160	187

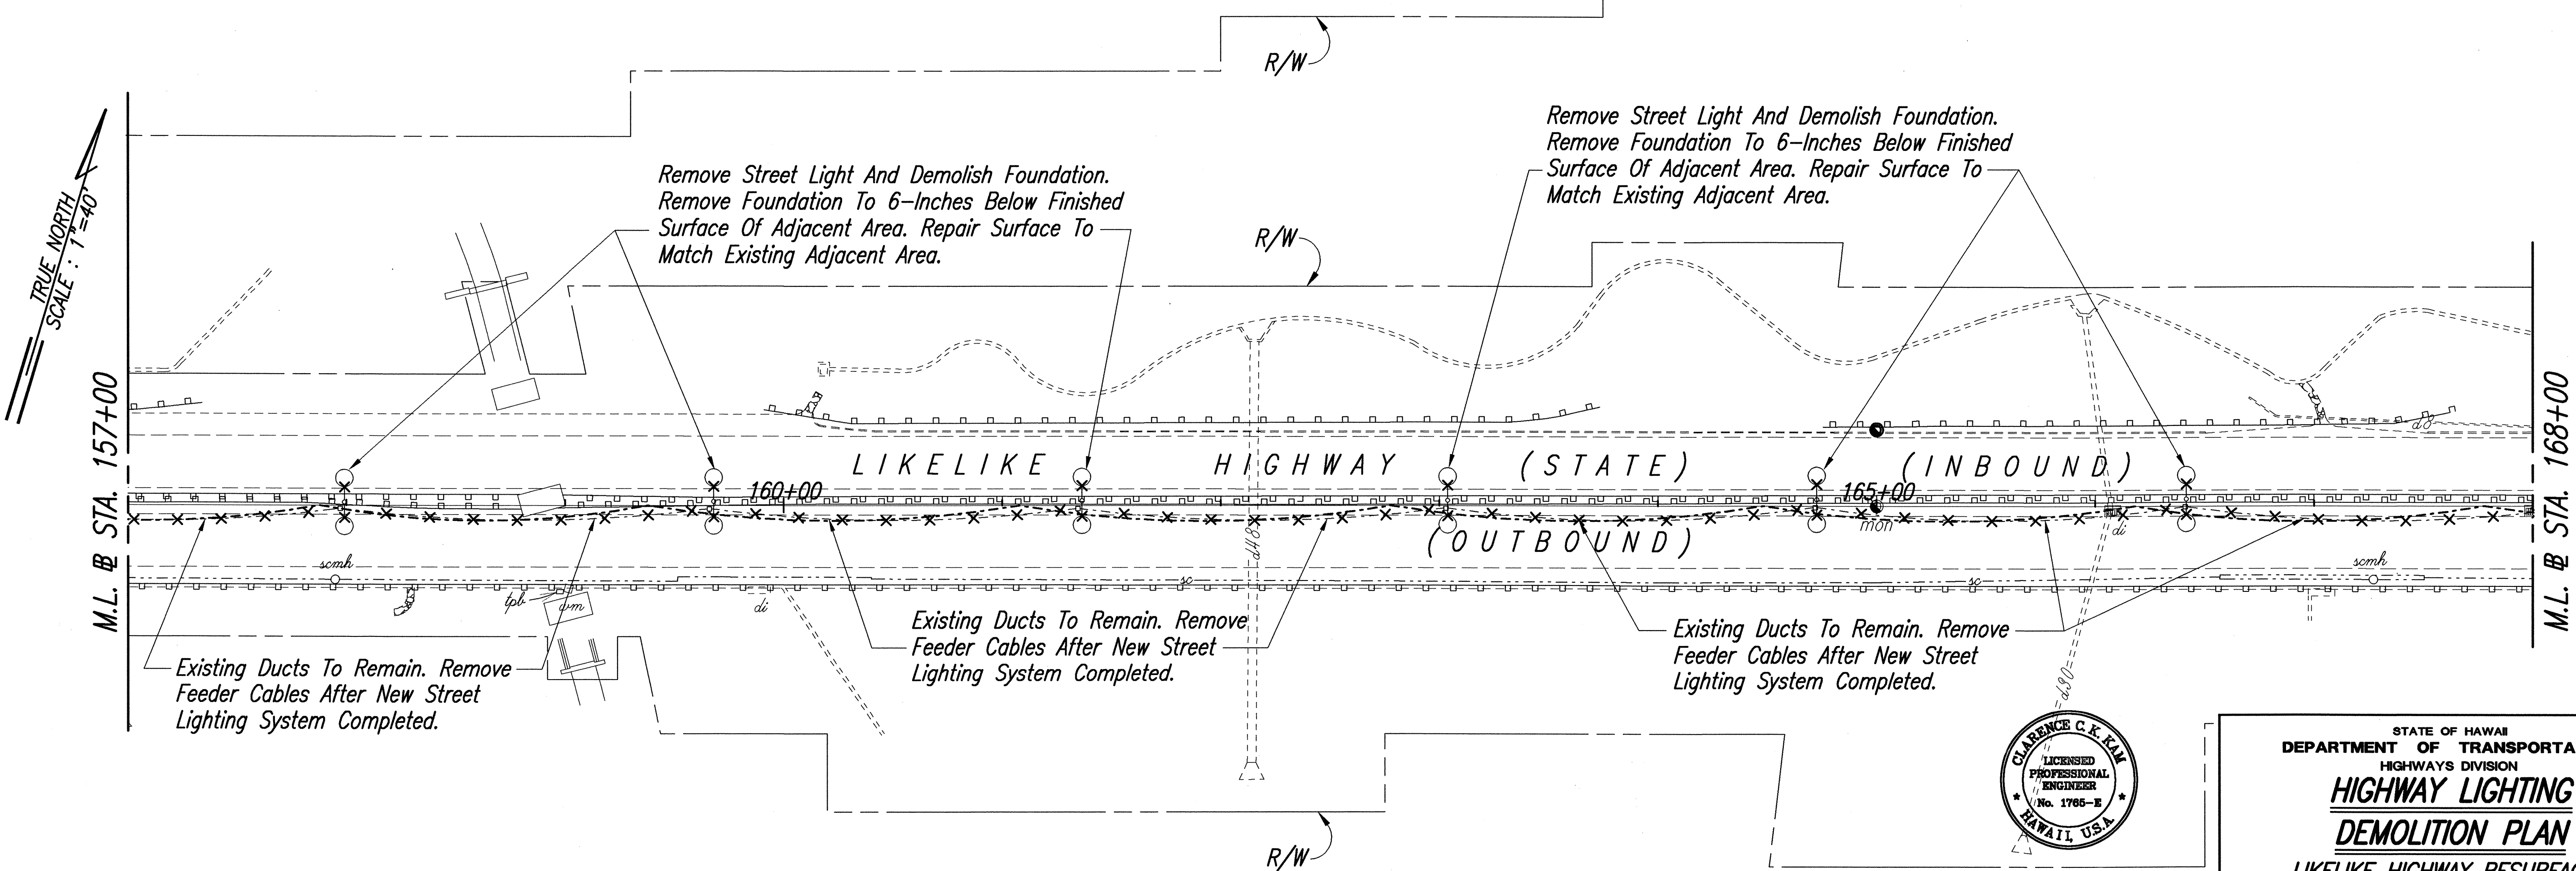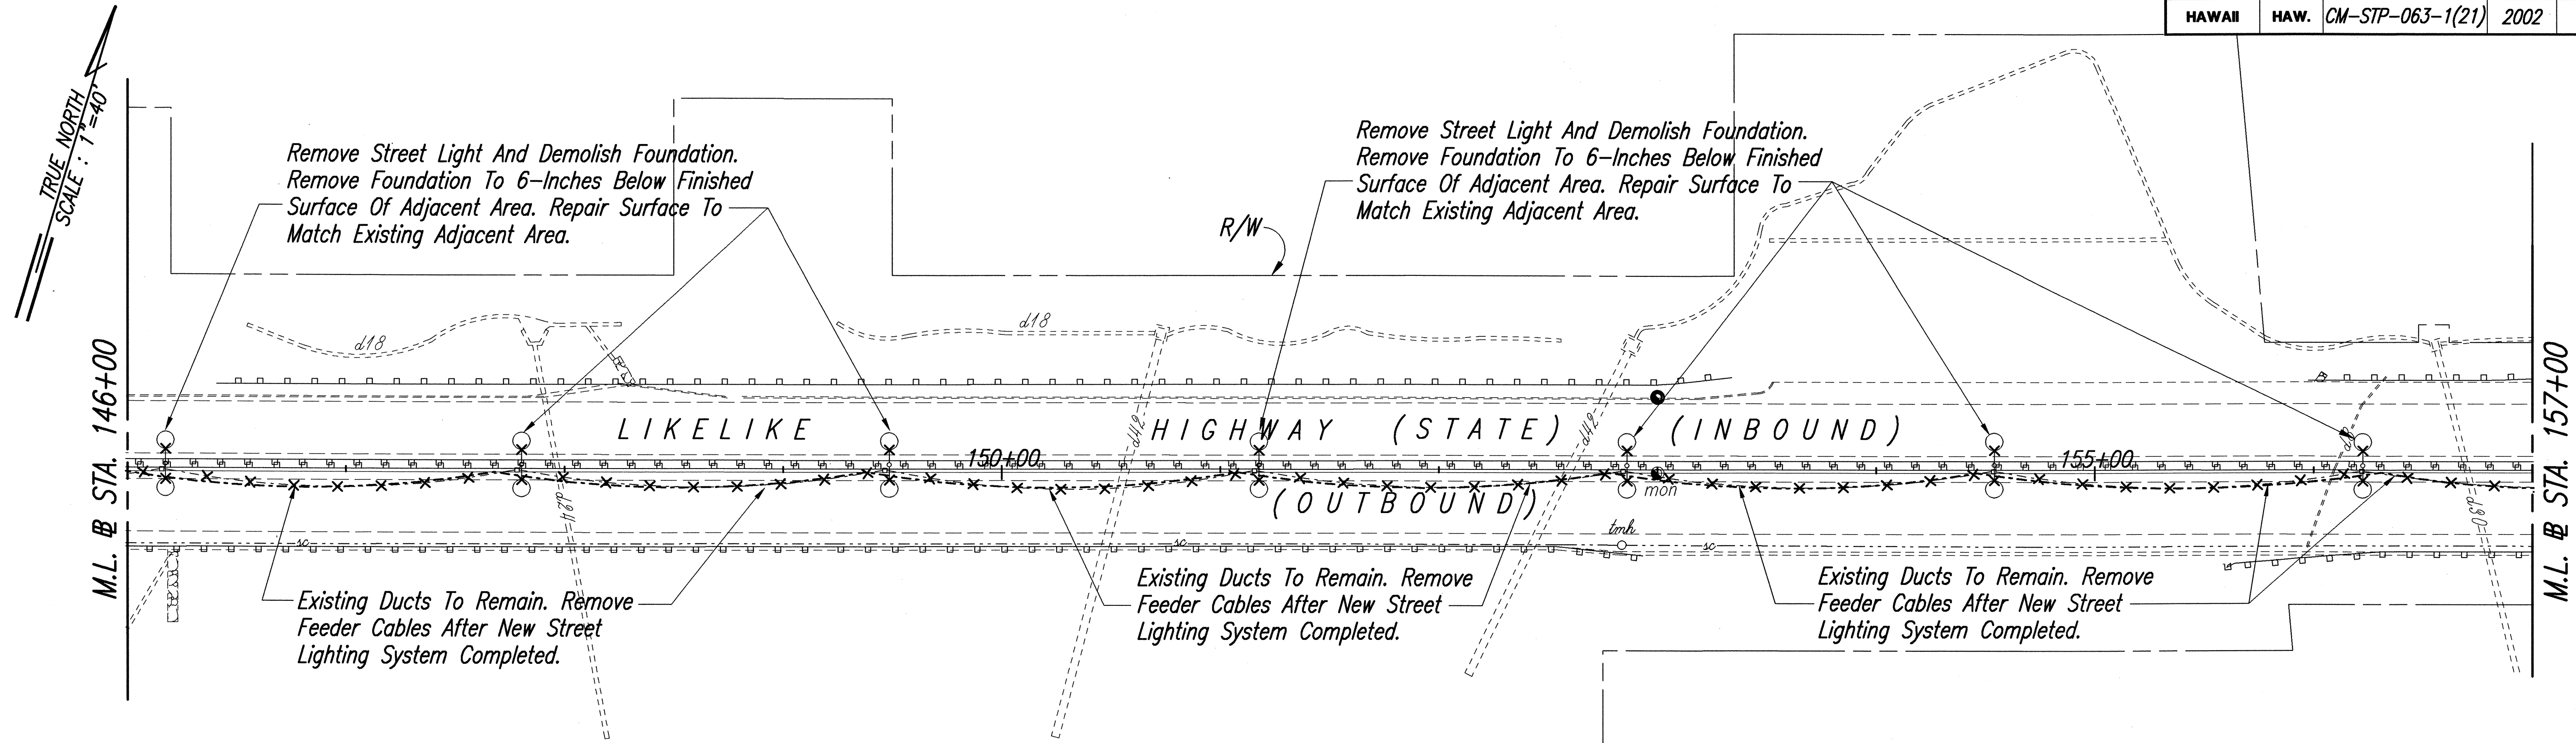


ORIGINAL PLAN	SURVEY PLOTTED BY	DATE
NOTE BOOK	DRAWN BY	
	DESIGNED BY	
	CHECKED BY	
	NO.	



THIS WORK WAS PREPARED BY ME OR UNDER MY SUPERVISION.

C. Kim

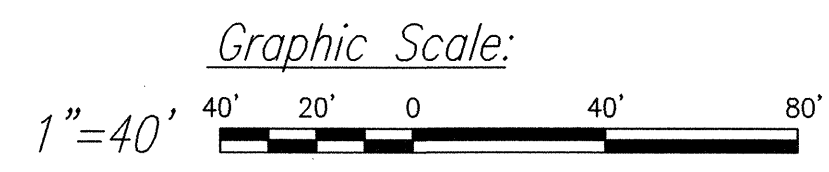

STATE OF HAWAII
DEPARTMENT OF TRANSPORTATION
HIGHWAYS DIVISION
HIGHWAY LIGHTING
DEMOLITION PLAN
LIKELIKE HIGHWAY RESURFACING
Emmeline Place to the Wilson Tunnel
F. A. Project No. CM-STP-063-1(21)
Scale: 1"=40' Date: December, 2001
SHEET No. 6 OF 28 SHEETS

FED. ROAD DIST. NO.	STATE	PROJ. NO.	FISCAL YEAR	SHEET NO.	TOTAL SHEETS
HAWAII	HAW.	CM-STP-063-1(21)	2002	161	187

TRUE NORTH
SCALE: 1"=40'

M.L. @ STA. 168+00

Remove Street Light And Demolish Foundation.
Remove Foundation To 6-Inches Below Finished
Surface Of Adjacent Area. Repair Surface To
Match Existing Adjacent Area.

R/W

Remove Street Light And Demolish Foundation.
Remove Foundation To 6-Inches Below Finished
Surface Of Adjacent Area. Repair Surface To
Match Existing Adjacent Area.

M.L. @ STA. 179+00

TRUE NORTH
SCALE: 1"=40'

M.L. @ STA. 179+00

Remove Street Light And Demolish Foundation.
Remove Foundation To 6-Inches Below Finished
Surface Of Adjacent Area. Repair Surface
To Match Existing Adjacent Area.

R/W

Remove Street Light And Demolish Foundation.
Remove Foundation To 6-Inches Below Finished
Surface Of Adjacent Area. Repair Surface To
Match Existing Adjacent Area.

M.L. @ STA. 190+00

ORIGINAL PLAN	SURVEY PLOTTED BY	DATE
NOTE BOOK	DRAWN BY	" "
	DESIGNED BY	" "
	CHECKED BY	" "
No.		

Existing Ducts To Remain. Remove
Feeder Cables After New Street
Lighting System Completed.

Existing Ducts To Remain. Remove
Feeder Cables After New Street
Lighting System Completed.

Existing Ducts To Remain. Remove
Feeder Cables After New Street
Lighting System Completed.


Existing Ducts To Remain.
Remove Feeder Cables After New
Street Lighting System Completed.



THIS WORK WAS PREPARED BY ME
OR UNDER MY SUPERVISION.

C. Kim

Graphic Scale:

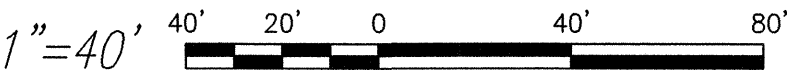

STATE OF HAWAII
DEPARTMENT OF TRANSPORTATION
HIGHWAYS DIVISION



HIGHWAY LIGHTING
DEMOLITION PLAN

LIKELIKE HIGHWAY RESURFACING
Emmeline Place to the Wilson Tunnel
F. A. Project No. CM-STP-063-1(21)

Scale: 1"=40'
Date: December, 2001

SHEET No. 7 OF 28 SHEETS

FED. ROAD DIST. NO.	STATE	PROJ. NO.	FISCAL YEAR	SHEET NO.	TOTAL SHEETS
HAWAII	HAW.	CM-STP-063-1(21)	2002	162	187

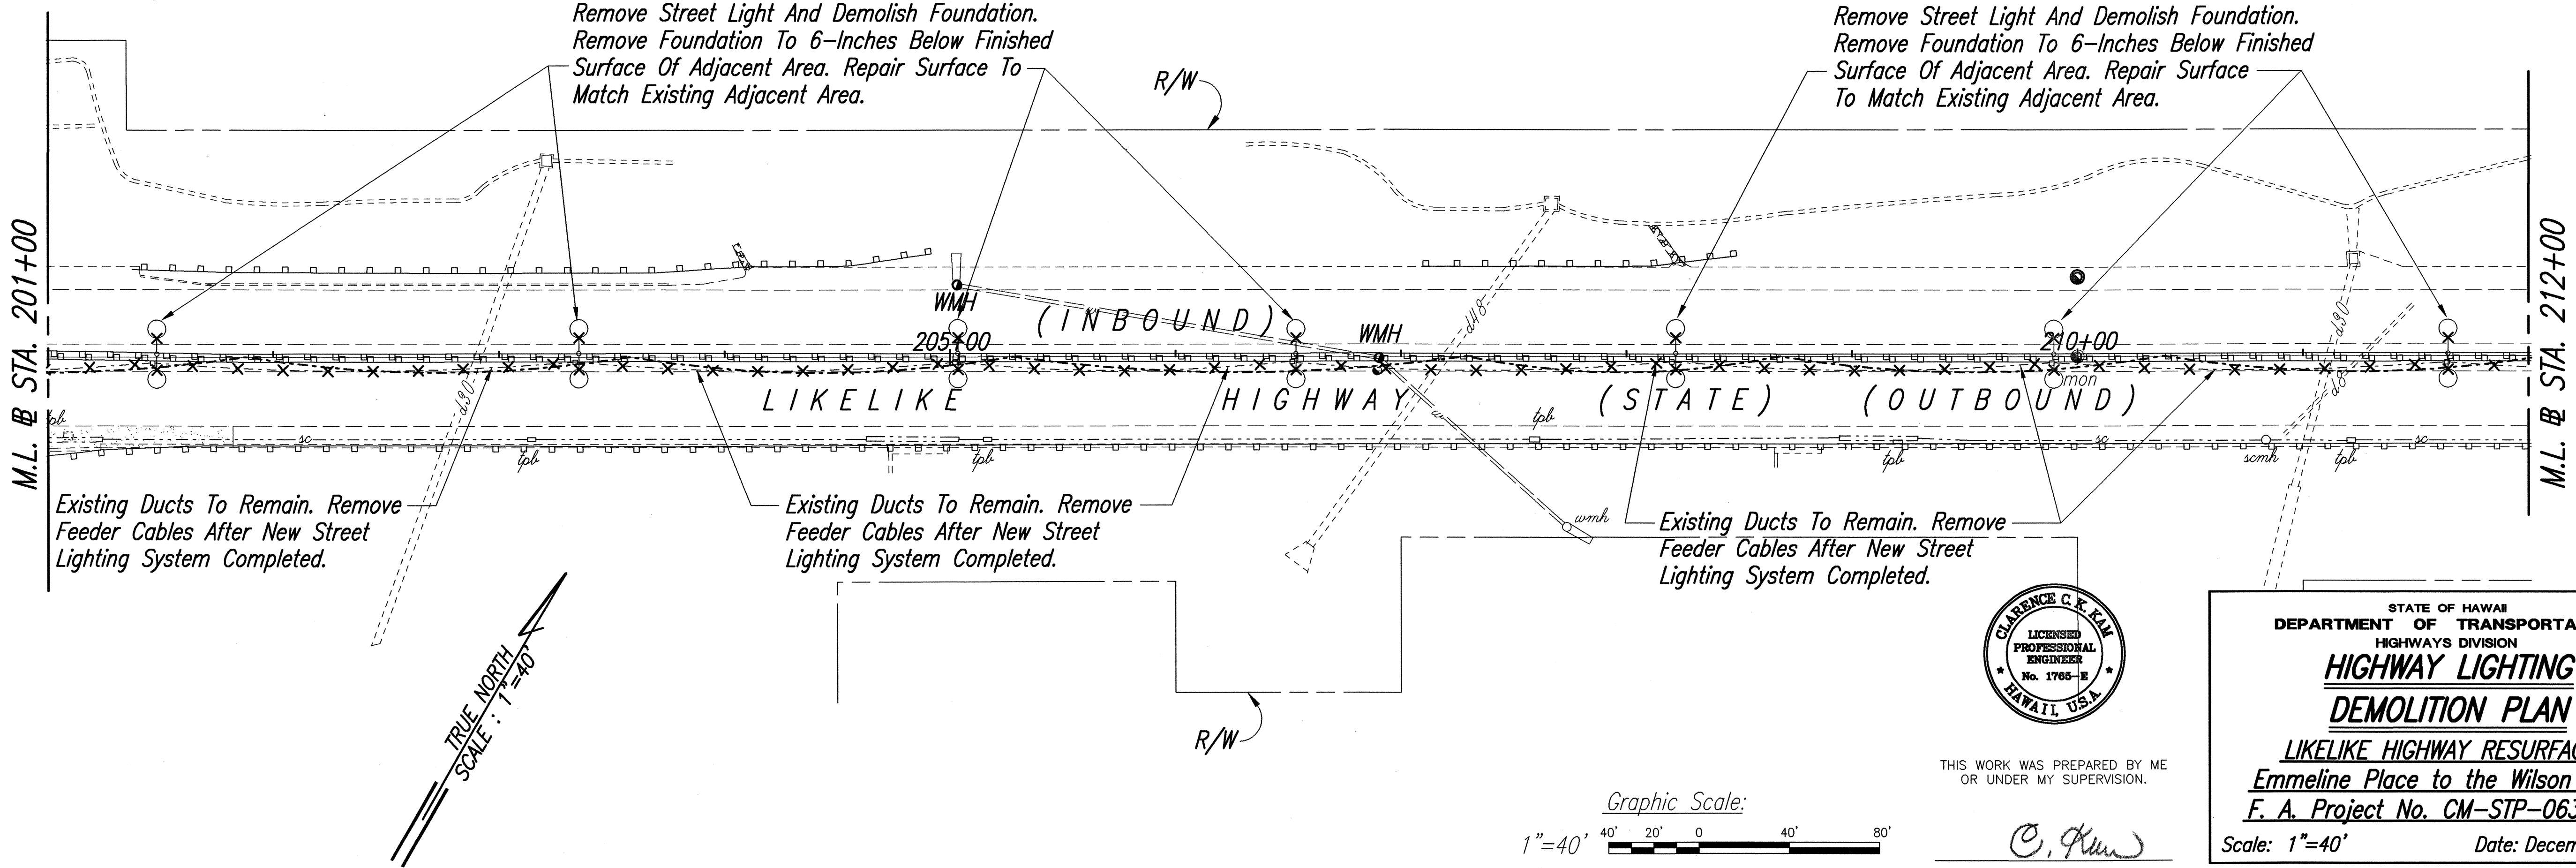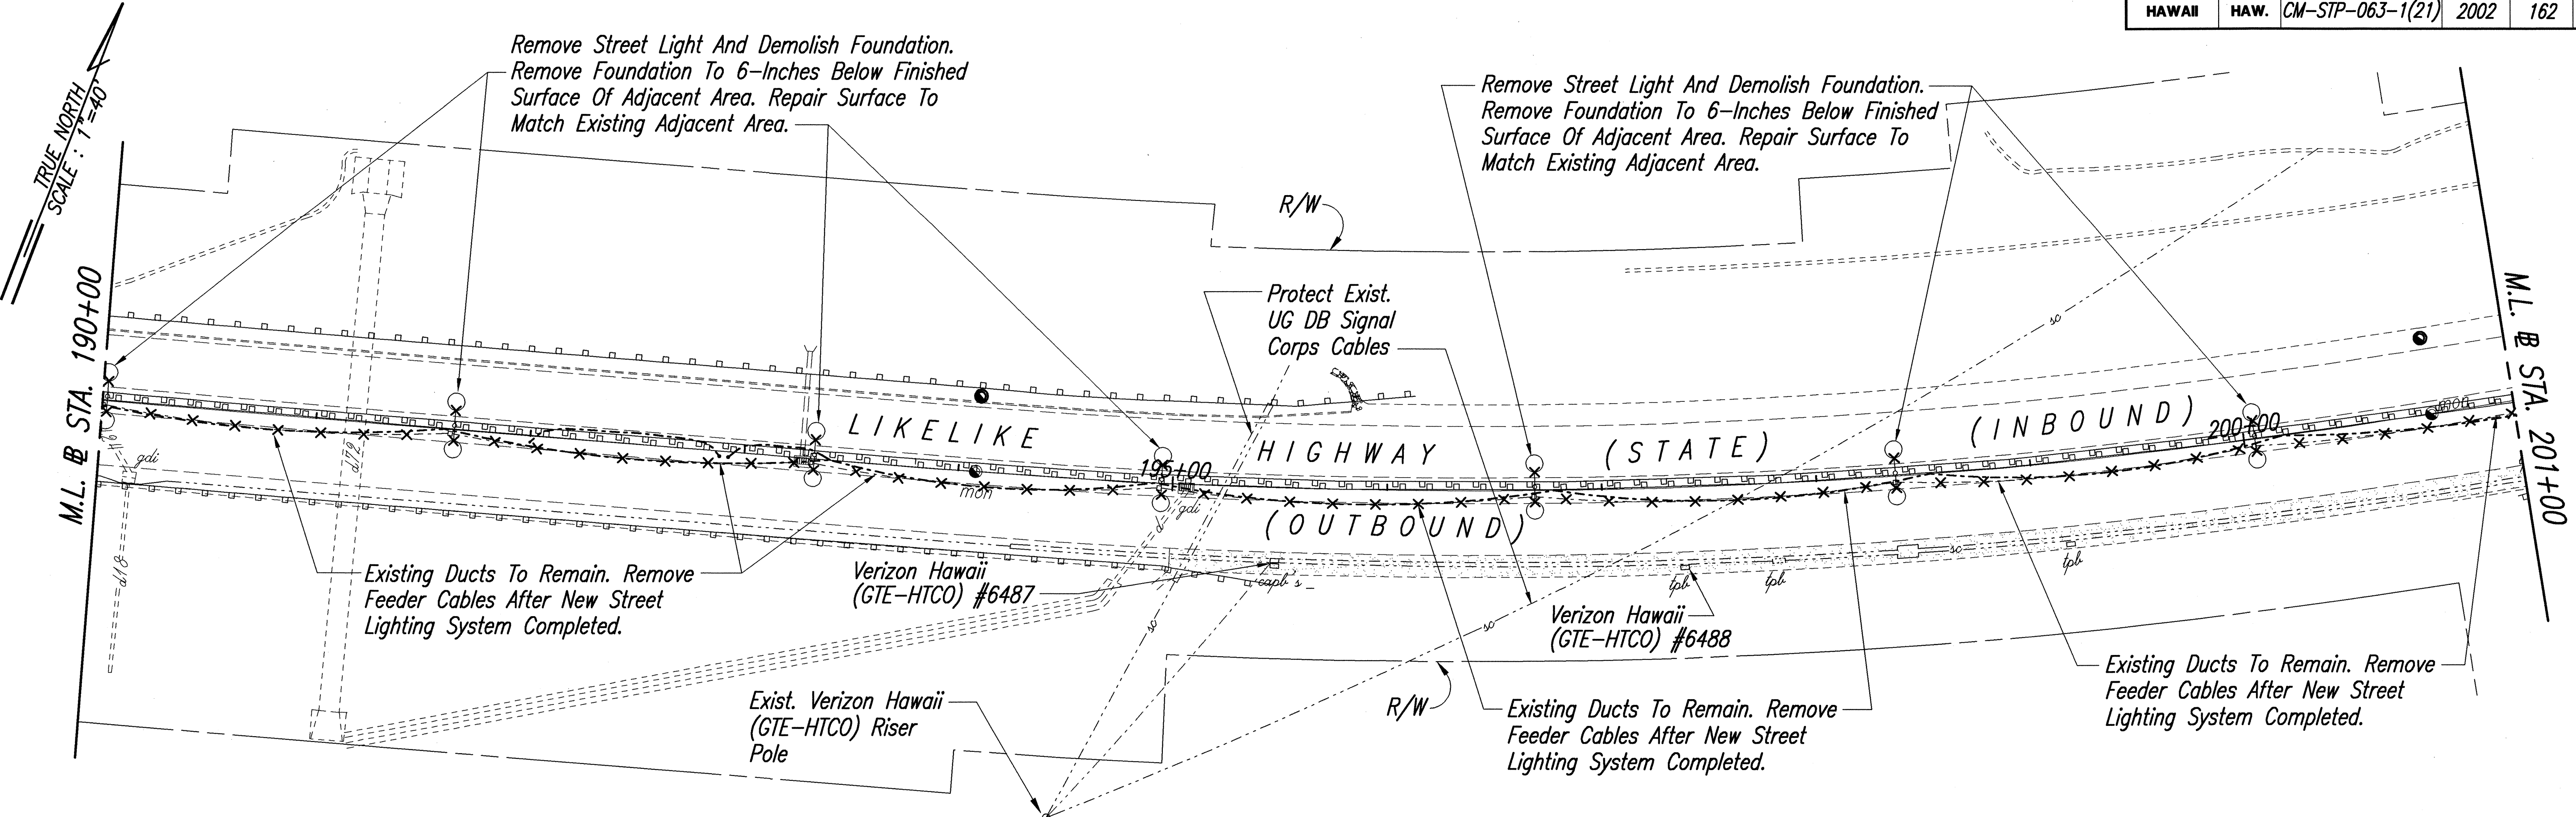


ORIGINAL PLAN	SURVEY PLOTTED BY	DATE
NOTE BOOK	DRAWN BY	
	DESIGNED BY	
	QUANTITIES BY	
	CHECKED BY	
	No.	



THIS WORK WAS PREPARED BY ME
OR UNDER MY SUPERVISION.

C. Kim

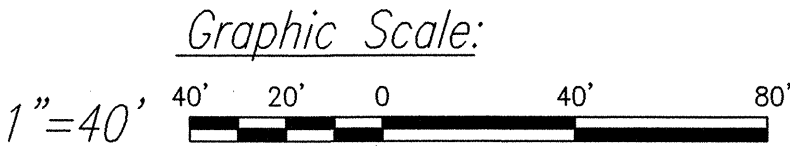

STATE OF HAWAII
DEPARTMENT OF TRANSPORTATION
HIGHWAYS DIVISION
**HIGHWAY LIGHTING
DEMOLITION PLAN**
**LIKELIKE HIGHWAY RESURFACING
Emmeline Place to the Wilson Tunnel
F. A. Project No. CM-STP-063-1(21)**
Scale: 1"=40' Date: December, 2001
SHEET No. 8 OF 28 SHEETS

FED. ROAD DIST. NO.	STATE	PROJ. NO.	FISCAL YEAR	SHEET NO.	TOTAL SHEETS
HAWAII	HAW.	CM-STP-063-1(21)	2002	ADD164	187

Notes:

- New Type C Traffic Signal Pullbox.
 - If In-Bound Lanes are Constructed Before Out-Bound Lanes, Pull in Detector Loops and Piezo Sensor Lead Cables From In-Bound Lanes and Coil/Protect Cables Outside of the New Pullbox. Test Cables Prior to Completion of Road Work. Replace all Defective or Cables with Unacceptable Test Results Immediately. Upon Completion of Testing, Place Cables in Water-Tight Protective Wrapping.
 - Upon Completion of Out-Bound Lanes, Pull Cables Into Highway Crossing Sleeve, Including Pulling Through New 3"C to Existing Controller.
 - If Out-Bound Lanes are Constructed Before In-Bound Lanes, Upon Completion of Highway Crossing Sleeve, Pull In-Bound Lanes Cables Through Highway Crossing Sleeve and Install the In-Bound Lanes Detector Loops and Piezo Sensor Lead, Including Completion of Detector Loops and Piezo Sensors After Completion of Out-Bound Lanes.
- Existing Traffic Signal Pullbox.
 - If In-Bound Lanes are Constructed Before Out-Bound Lanes, Upon Completion of Out-Bound Lanes, Pull Through Detector Loops and Piezo Sensor Leads for In-Bound Lanes (Through Highway Crossing Sleeve). Complete the Out-Bound Lanes Detector Loops and Piezo Sensors.
 - If the Out-Bound Lanes are Constructed Before In-Bound Lanes, Pull In-Bound Lanes Detector Loops and Piezo Sensor Lead Cables into Handhole from Controller, Coil and Protect Outside of the Handhole Until Completion of the Highway Crossing Sleeve. Test all Cables and Sensors, Replace all Defective or Cables with Unacceptable Test Results Immediately. Pull Out-Bound Lanes Detector Loops and Piezo Sensor Cables and Install Detector Loops and Sensors in Roadway.
- Highway Crossing Sleeve (3"C) will Not be Ready for Service Until Completion of Both In-Bound and Out-Bound Lanes. Connect New Sleeve to Existing and New Traffic Signal Pullboxes.
 - Highway Crossing Sleeve Shall be Provided with 36" Cover.
 - Upon Completion of Sleeve, Pull in In-Bound Lanes Detector Loops Cable and Piezo Sensor Cables. Cables Shall be Tested for Acceptance Before and After Installation into Sleeve.
- New 1-3"C With TS Cables. Duct "G".

1/11/02	Add Loop I in Turning Lane
DATE	REVISION

STATE OF HAWAII

DEPARTMENT OF TRANSPORTATION

HIGHWAYS DIVISION

HIGHWAY LIGHTING

DEMOLITION PLAN

LIKELIKE HIGHWAY RESURFACING

Emmeline Place to the Wilson Tunnel


F. A. Project No. CM-STP-063-1(21)

Scale: 1"=40'

Date: December, 2001

SHEET No. 10 OF 28 SHEETS

ADD 164

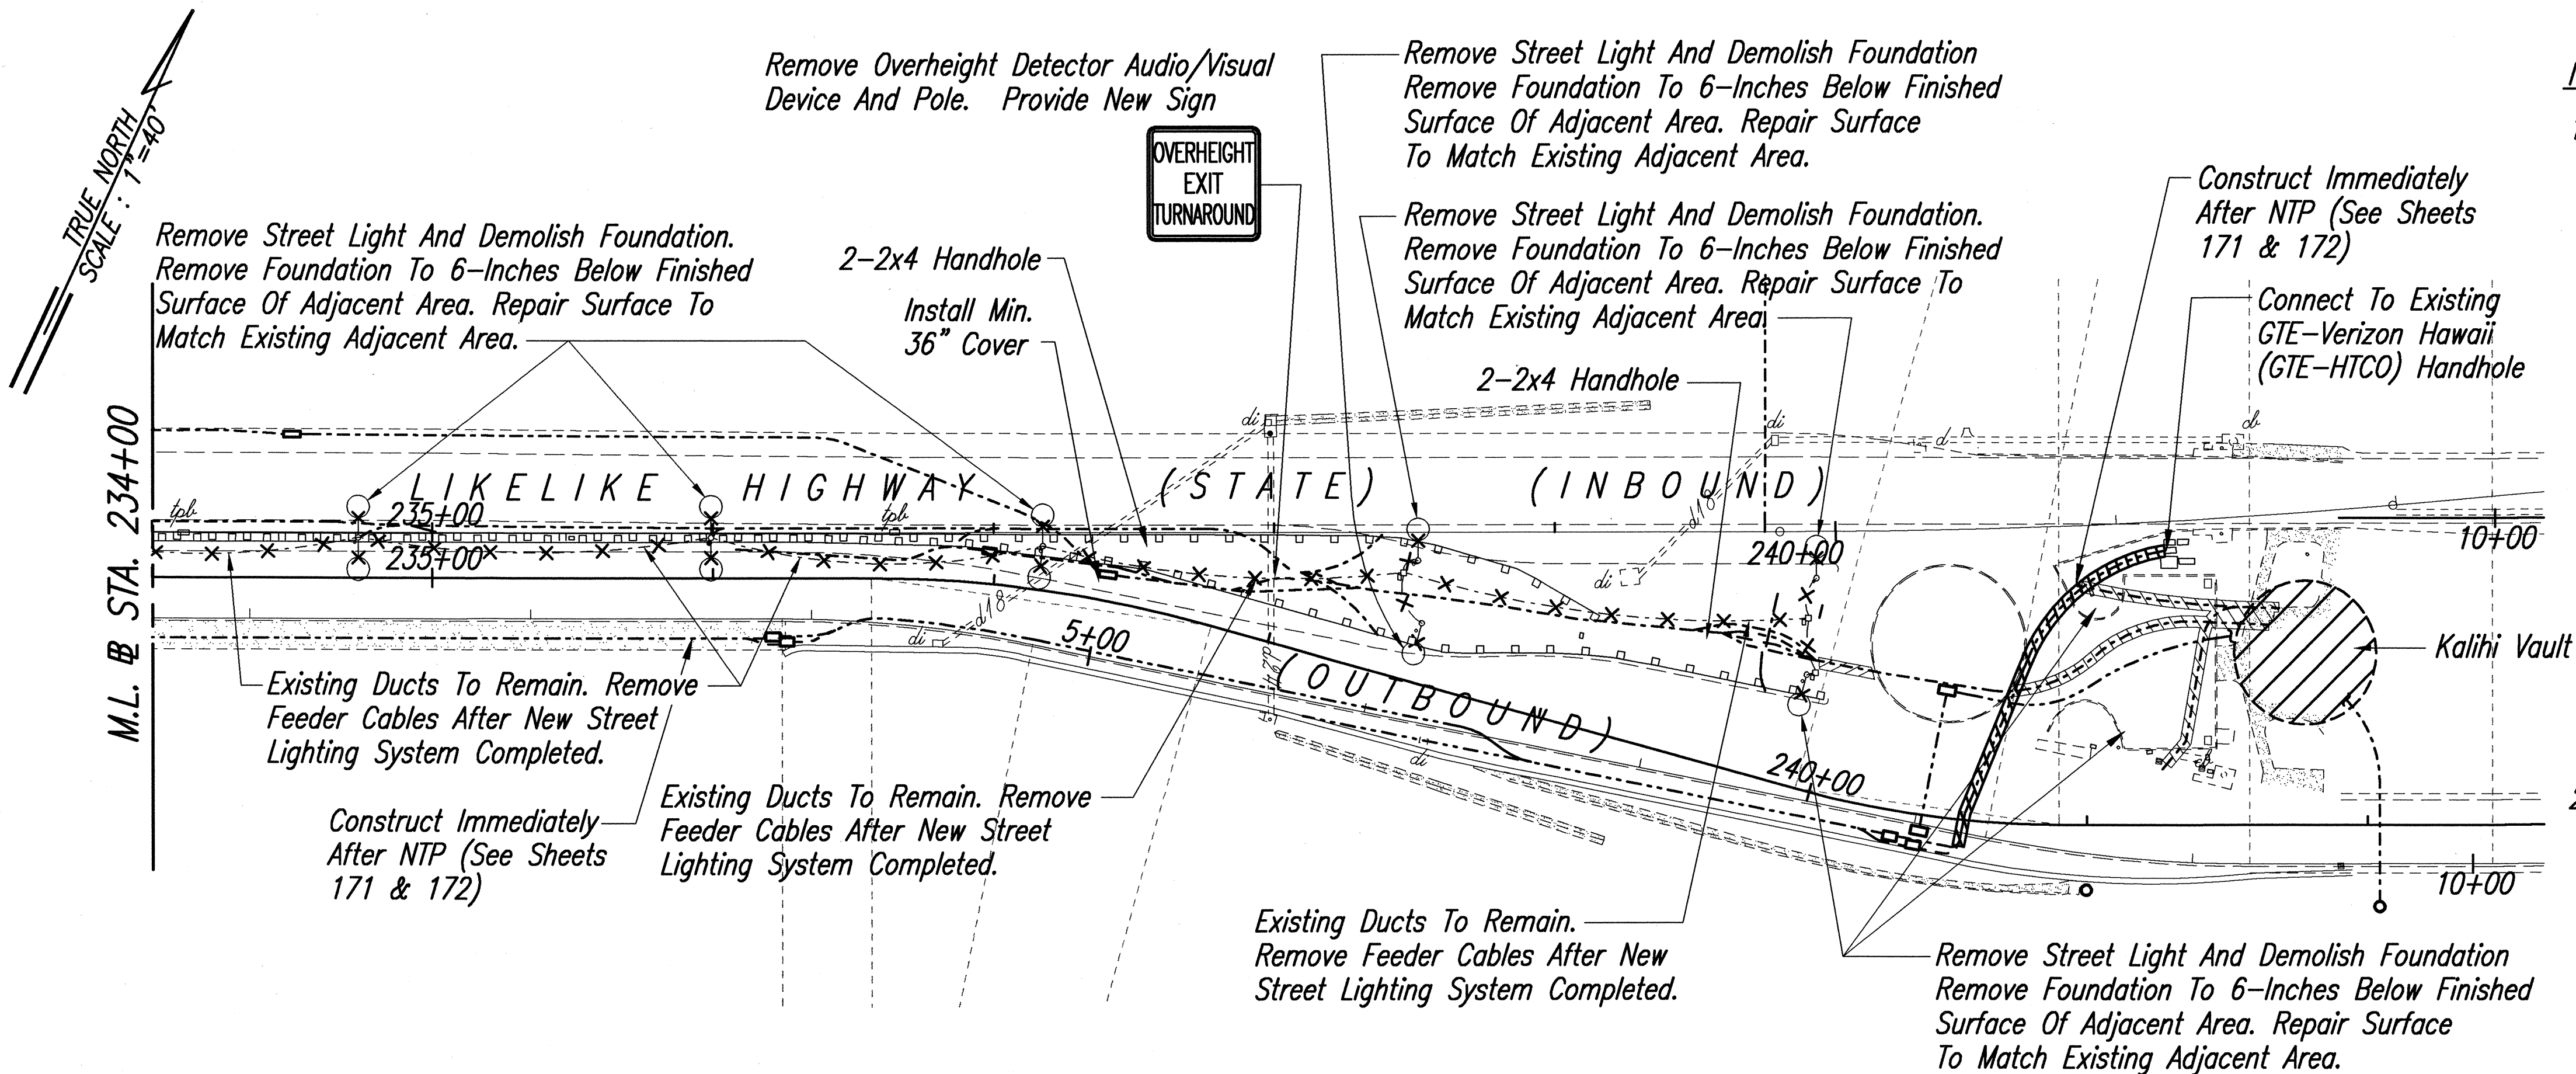

New Traffic Signal Pullbox
See Note 1

Thru-In #1

Thru-In #2

Turn

Median

Thru-Out #1

Thru-Out #2

See Note 5*

See Note 6*

Typical 12' Class I Sensor

New Traffic Detector Loops

3"C W/ 4-Piezo Lead Cables;
4-2/C#14 Detector Loop Cables, Duct Section "G"

See Note 6* See Note 3.

12" Typ.

See Note 5

APPROVED:

Verizon Hawaii, Inc. (GTE-HTCO)

Date

Oceanic Cable Company



Date



THIS WORK WAS PREPARED BY ME OR UNDER MY SUPERVISION.

C. Kim

Graphic Scale:

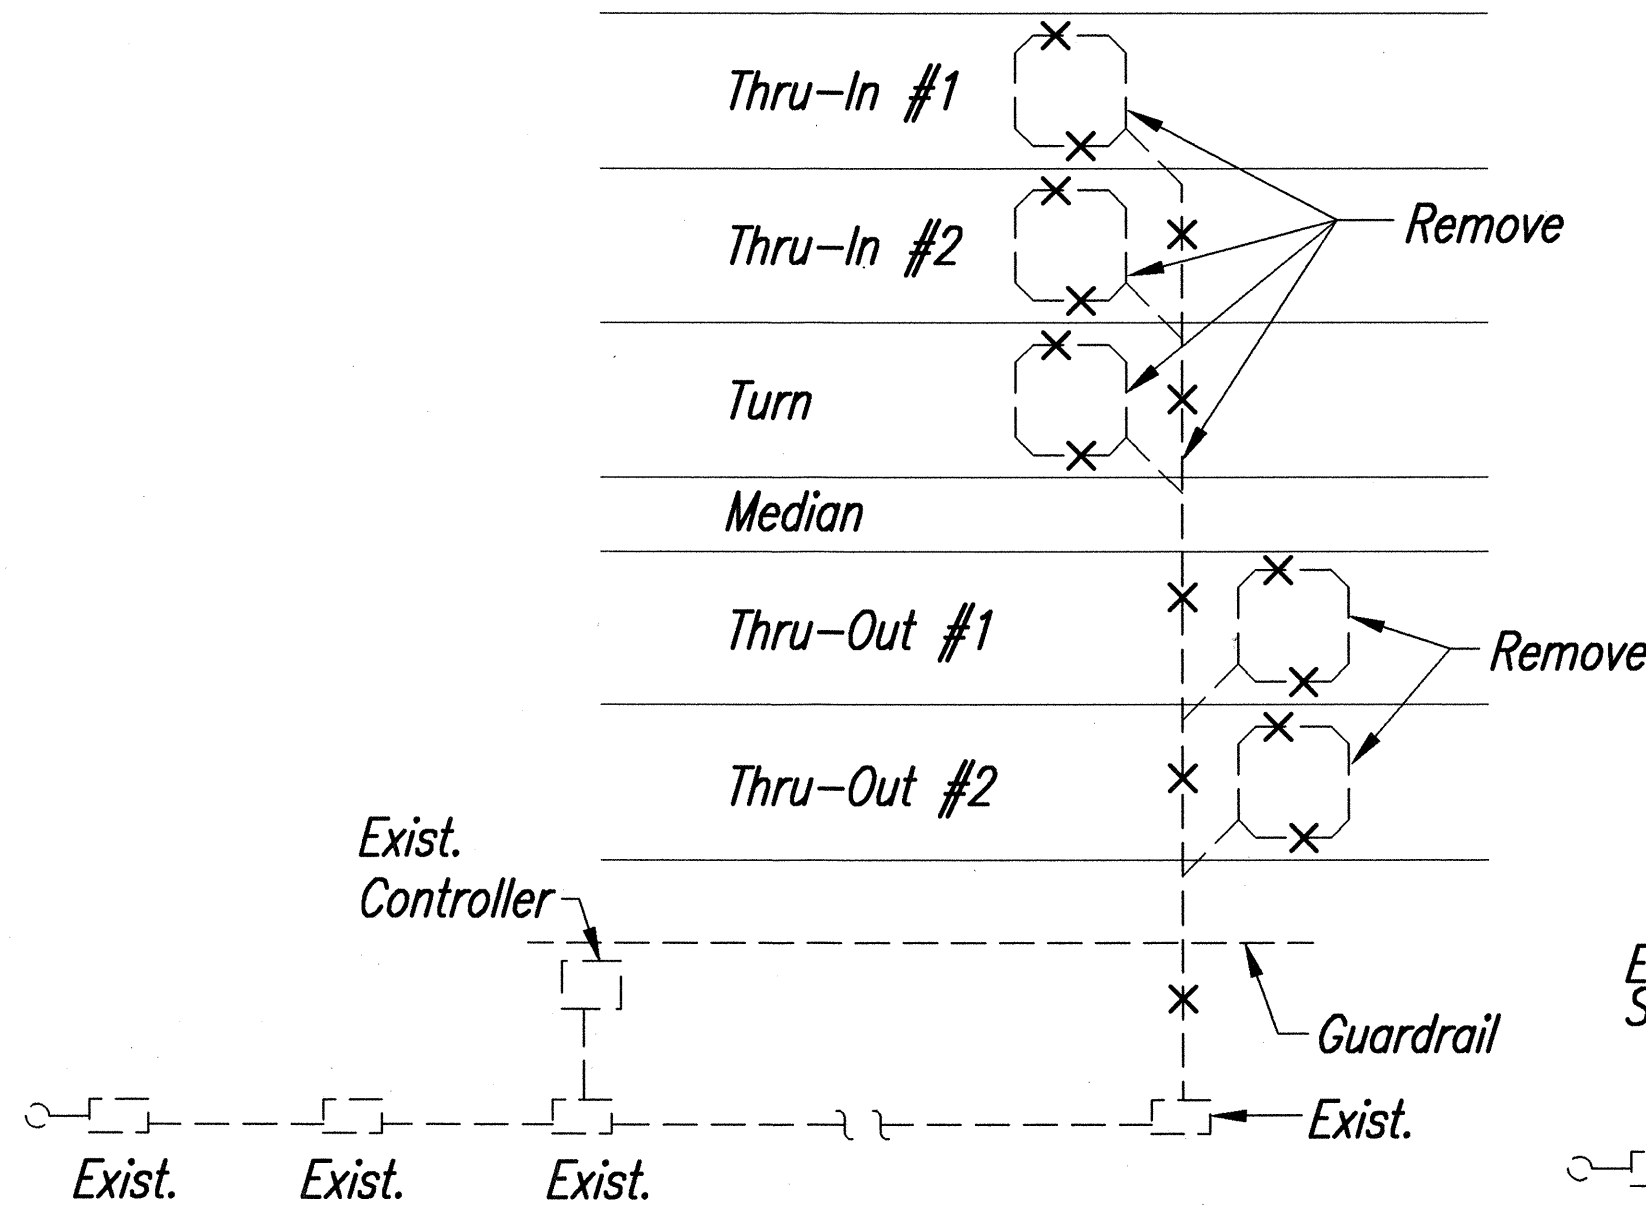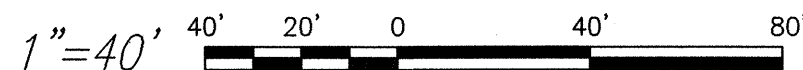


EXISTING

TRAFFIC LOOPS
NOT TO SCALE

NEW PULLBOX, TYPE "C" W/ 2"C CONNECTED
TO EXISTING TS PULLBOX

SURVEY PLOTTED BY	DATE
DRAWN BY	
DESIGNED BY	
CHECKED BY	
ORIGINAL PLAN	
NOTE BOOK	
No.	

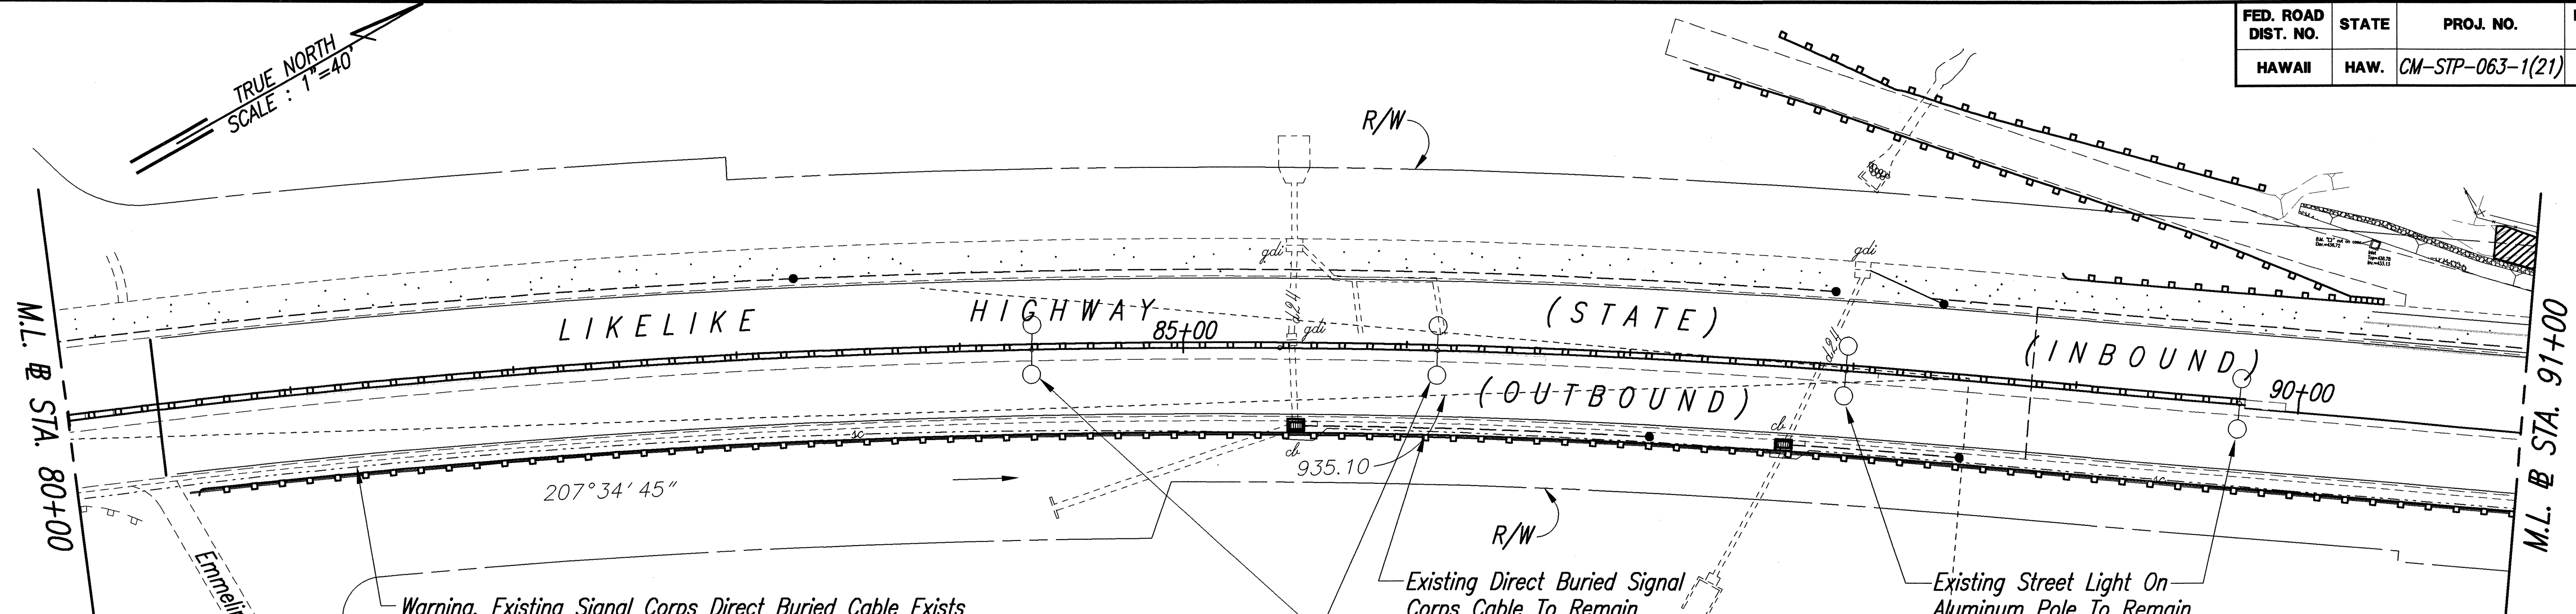

Warning, Existing Signal Corps Direct Buried Cable Exists From Beginning of Project to Wilson Tunnel. Notify Signal Corps To Tone The Location of The Cable Before Initiating Work. Work In The Near Vicinity Of The Cable Shall Be With Minimum Impact Pressure To Ground. Cable Is Old Direct Buried Communications Cable. Relocate All Markers Clear Of The Shoulder With Identification Of Off-set Distance. Where No Markers Exist, Provide Markers Every 200-Ft On Center


Existing Street Light On Aluminum Pole To Remain.

1	90
1-N250	II
1	C,A
Sta. 95+97	15'
O/S 50' LEFT	
480V	

1	1
2-N250	II
2	B,C
Sta. 97+62	8'
480V	

1	2
2-N250	II
1	C,A
Sta. 99+33	8'
480V	

1	3
2-N250	II
2	C,A
Sta. 101+06	8'
480V	

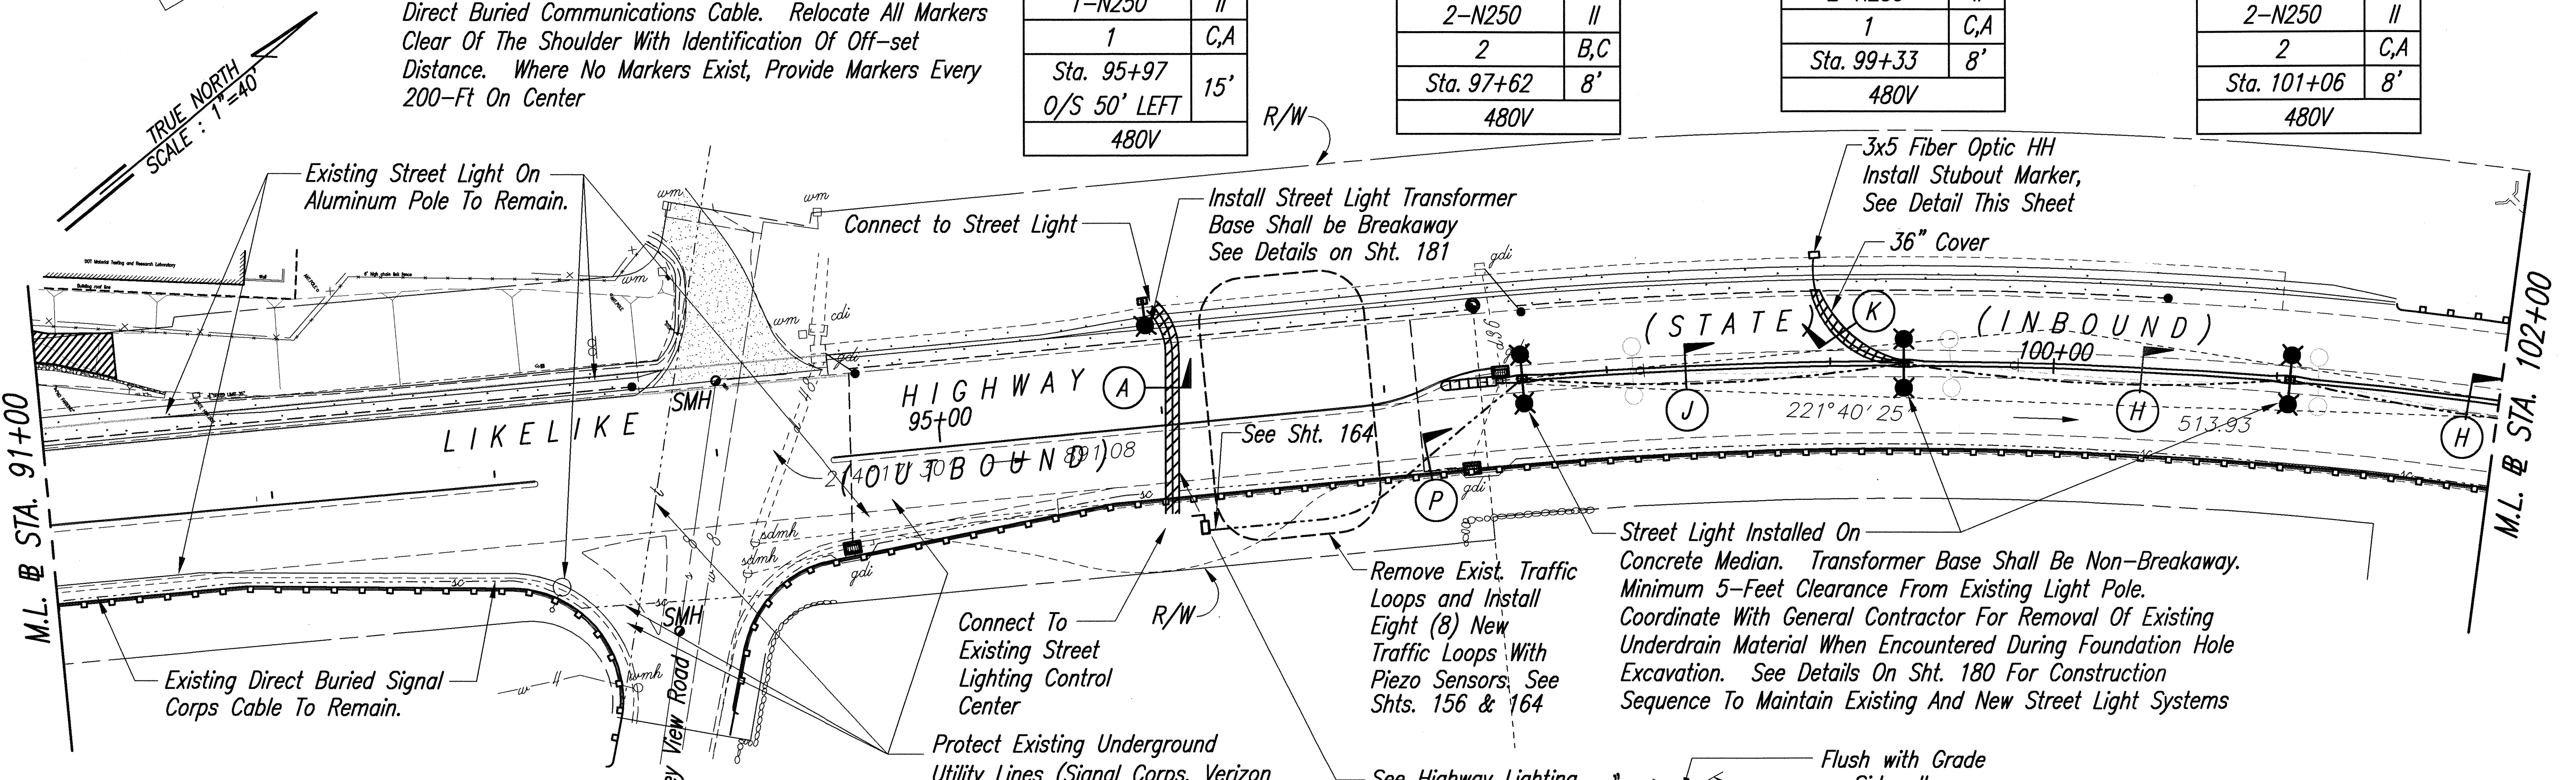

Existing Street Light On Aluminum Pole To Remain.

Connect to Street Light

Install Street Light Transformer Base Shall be Breakaway See Details on Sht. 181

3x5 Fiber Optic HH Install Stubout Marker, See Detail This Sheet
36" Cover


Street Light Installed On Concrete Median. Transformer Base Shall Be Non-Breakaway. Minimum 5-Foot Clearance From Existing Light Pole. Coordinate With General Contractor For Removal Of Existing Underdrain Material When Encountered During Foundation Hole Excavation. See Details On Sht. 180 For Construction Sequence To Maintain Existing And New Street Light Systems

Connect To Existing Street Lighting Control Center

Protect Existing Underground Utility Lines (Signal Corps, Verizon Hawaii, Street Lighting, And Electrical) In The Highway Resurfacing Area. These Facilities Are Active And To Remain In Service

See Highway Lighting Notes For Ductlines.

"E" = Electric
"L" = Light
"S" = Traffic Signal

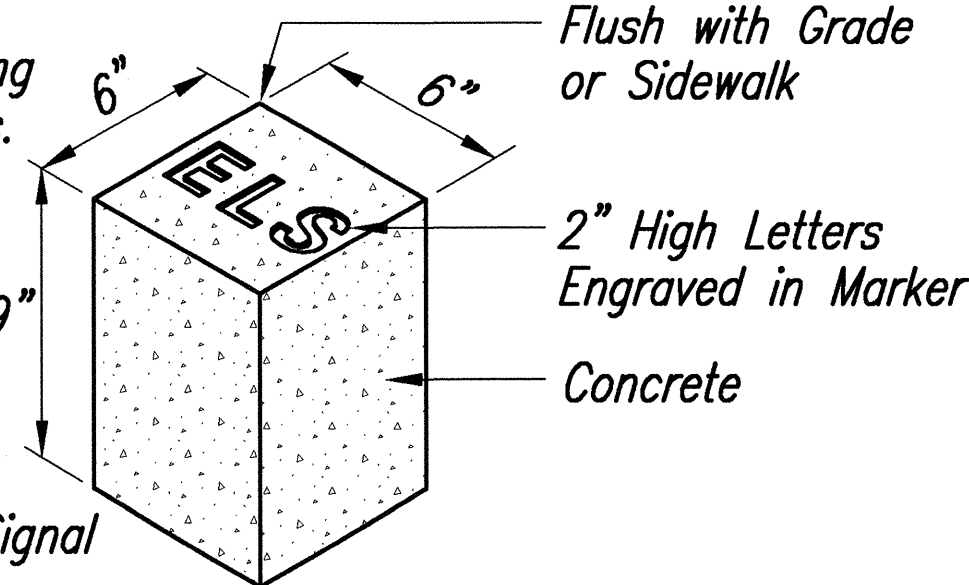

CONDUIT STUB-OUT MARKER
Not to Scale

THIS WORK WAS PREPARED BY ME OR UNDER MY SUPERVISION.




STATE OF HAWAII
DEPARTMENT OF TRANSPORTATION
HIGHWAYS DIVISION
HIGHWAY LIGHTING PLAN


LIKELIKE HIGHWAY RESURFACING
Emmeline Place to the Wilson Tunnel
F. A. Project No. CM-STP-063-1(21)

Scale: 1"=40' Date: December, 2001



ORIGINAL PLAN	SURVEY PLOTTED BY	DATE
NOTE BOOK	DRAWN BY	
	DESIGNED BY	
	QUANTITIES BY	
	CHECKED BY	
No.		

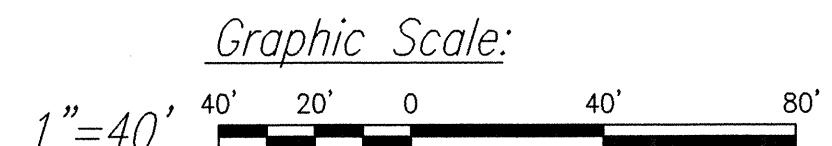

FED. ROAD DIST. NO.	STATE	PROJ. NO.	FISCAL YEAR	SHEET NO.	TOTAL SHEETS
HAWAII	HAW.	CM-STP-063-1(21)	2002	166	187

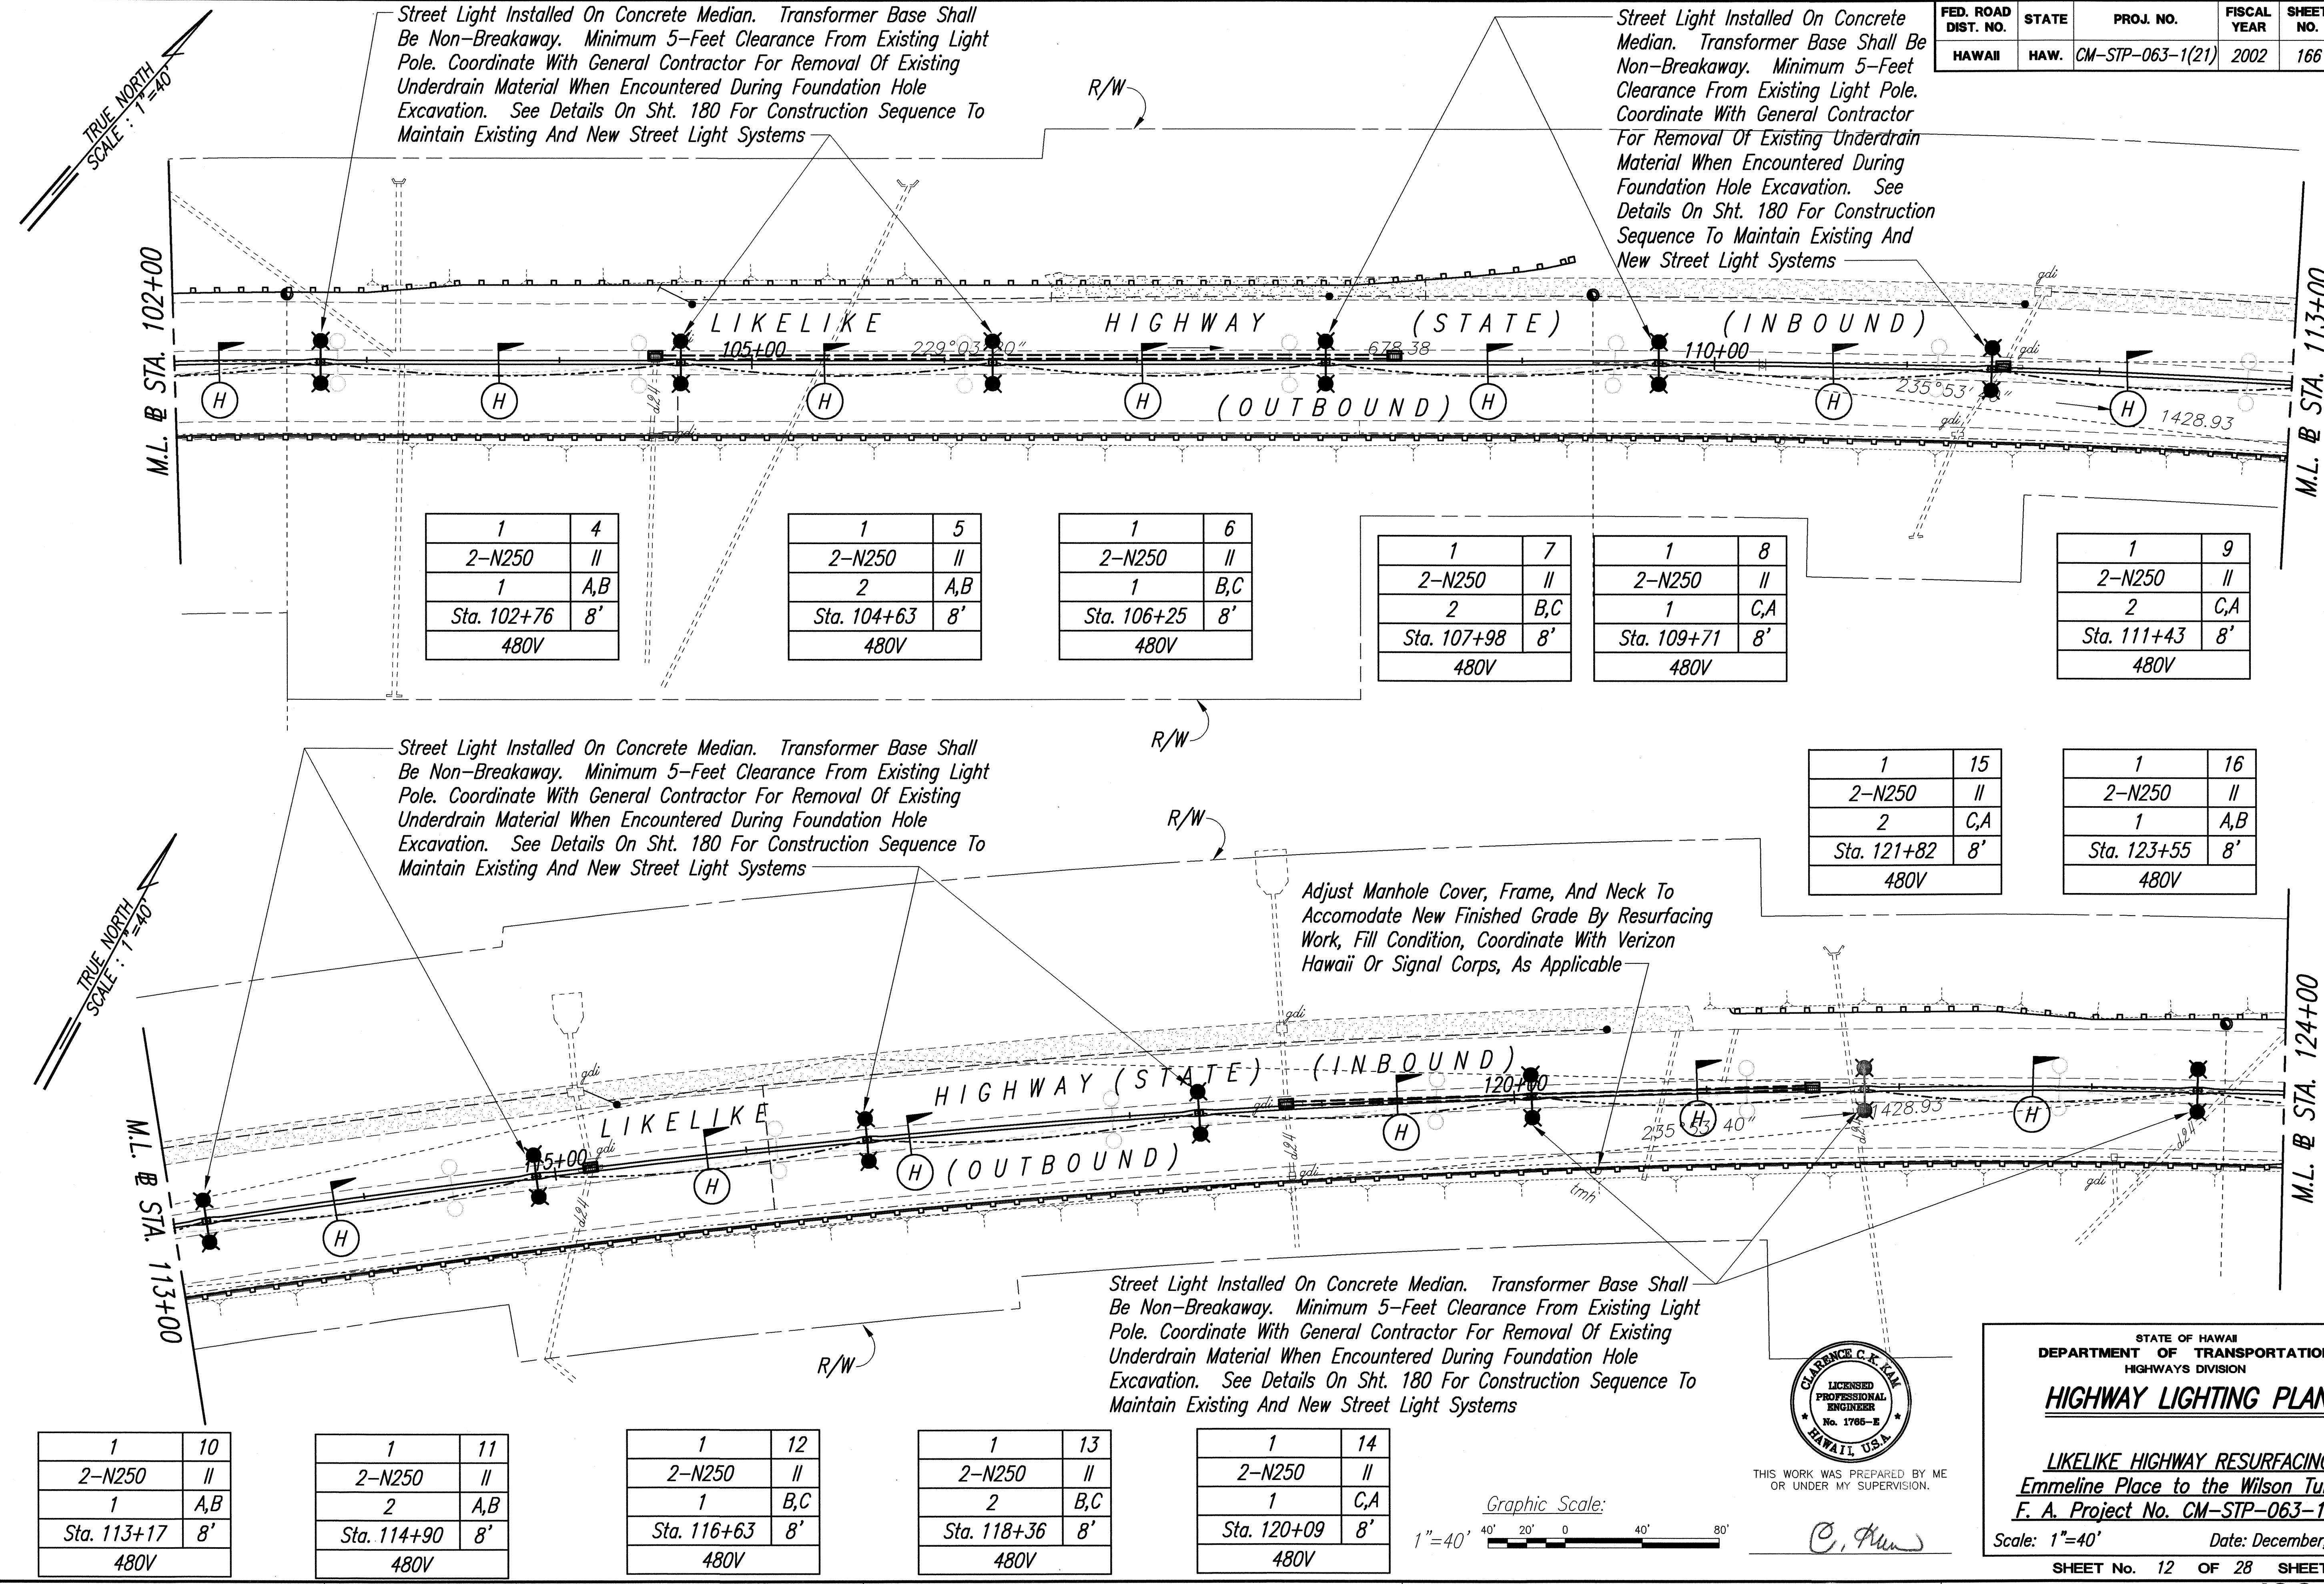

ORIGINAL PLAN	DATE
SURVEY PLOTTED BY	
DRAWN BY	
DESIGNED BY	
QUANTITIES BY	
CHECKED BY	
No.	

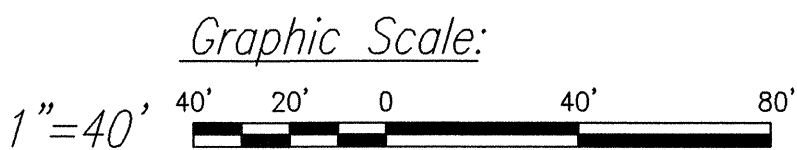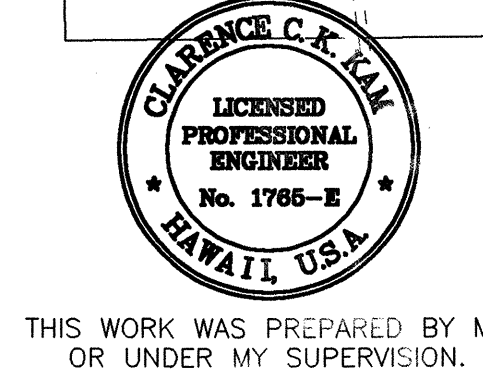


STATE OF HAWAII
DEPARTMENT OF TRANSPORTATION
HIGHWAYS DIVISION

HIGHWAY LIGHTING PLAN

LIKELIKE HIGHWAY RESURFACING
Emmeline Place to the Wilson Tunnel
F. A. Project No. CM-STP-063-1(21)
Scale: 1"=40' Date: December, 2001

SHEET No. 12 OF 28 SHEETS

FED. ROAD DIST. NO.	STATE	PROJ. NO.	FISCAL YEAR	SHEET NO.	TOTAL SHEETS
HAWAII	HAW.	CM-STP-063-1(21)	2002	168	187

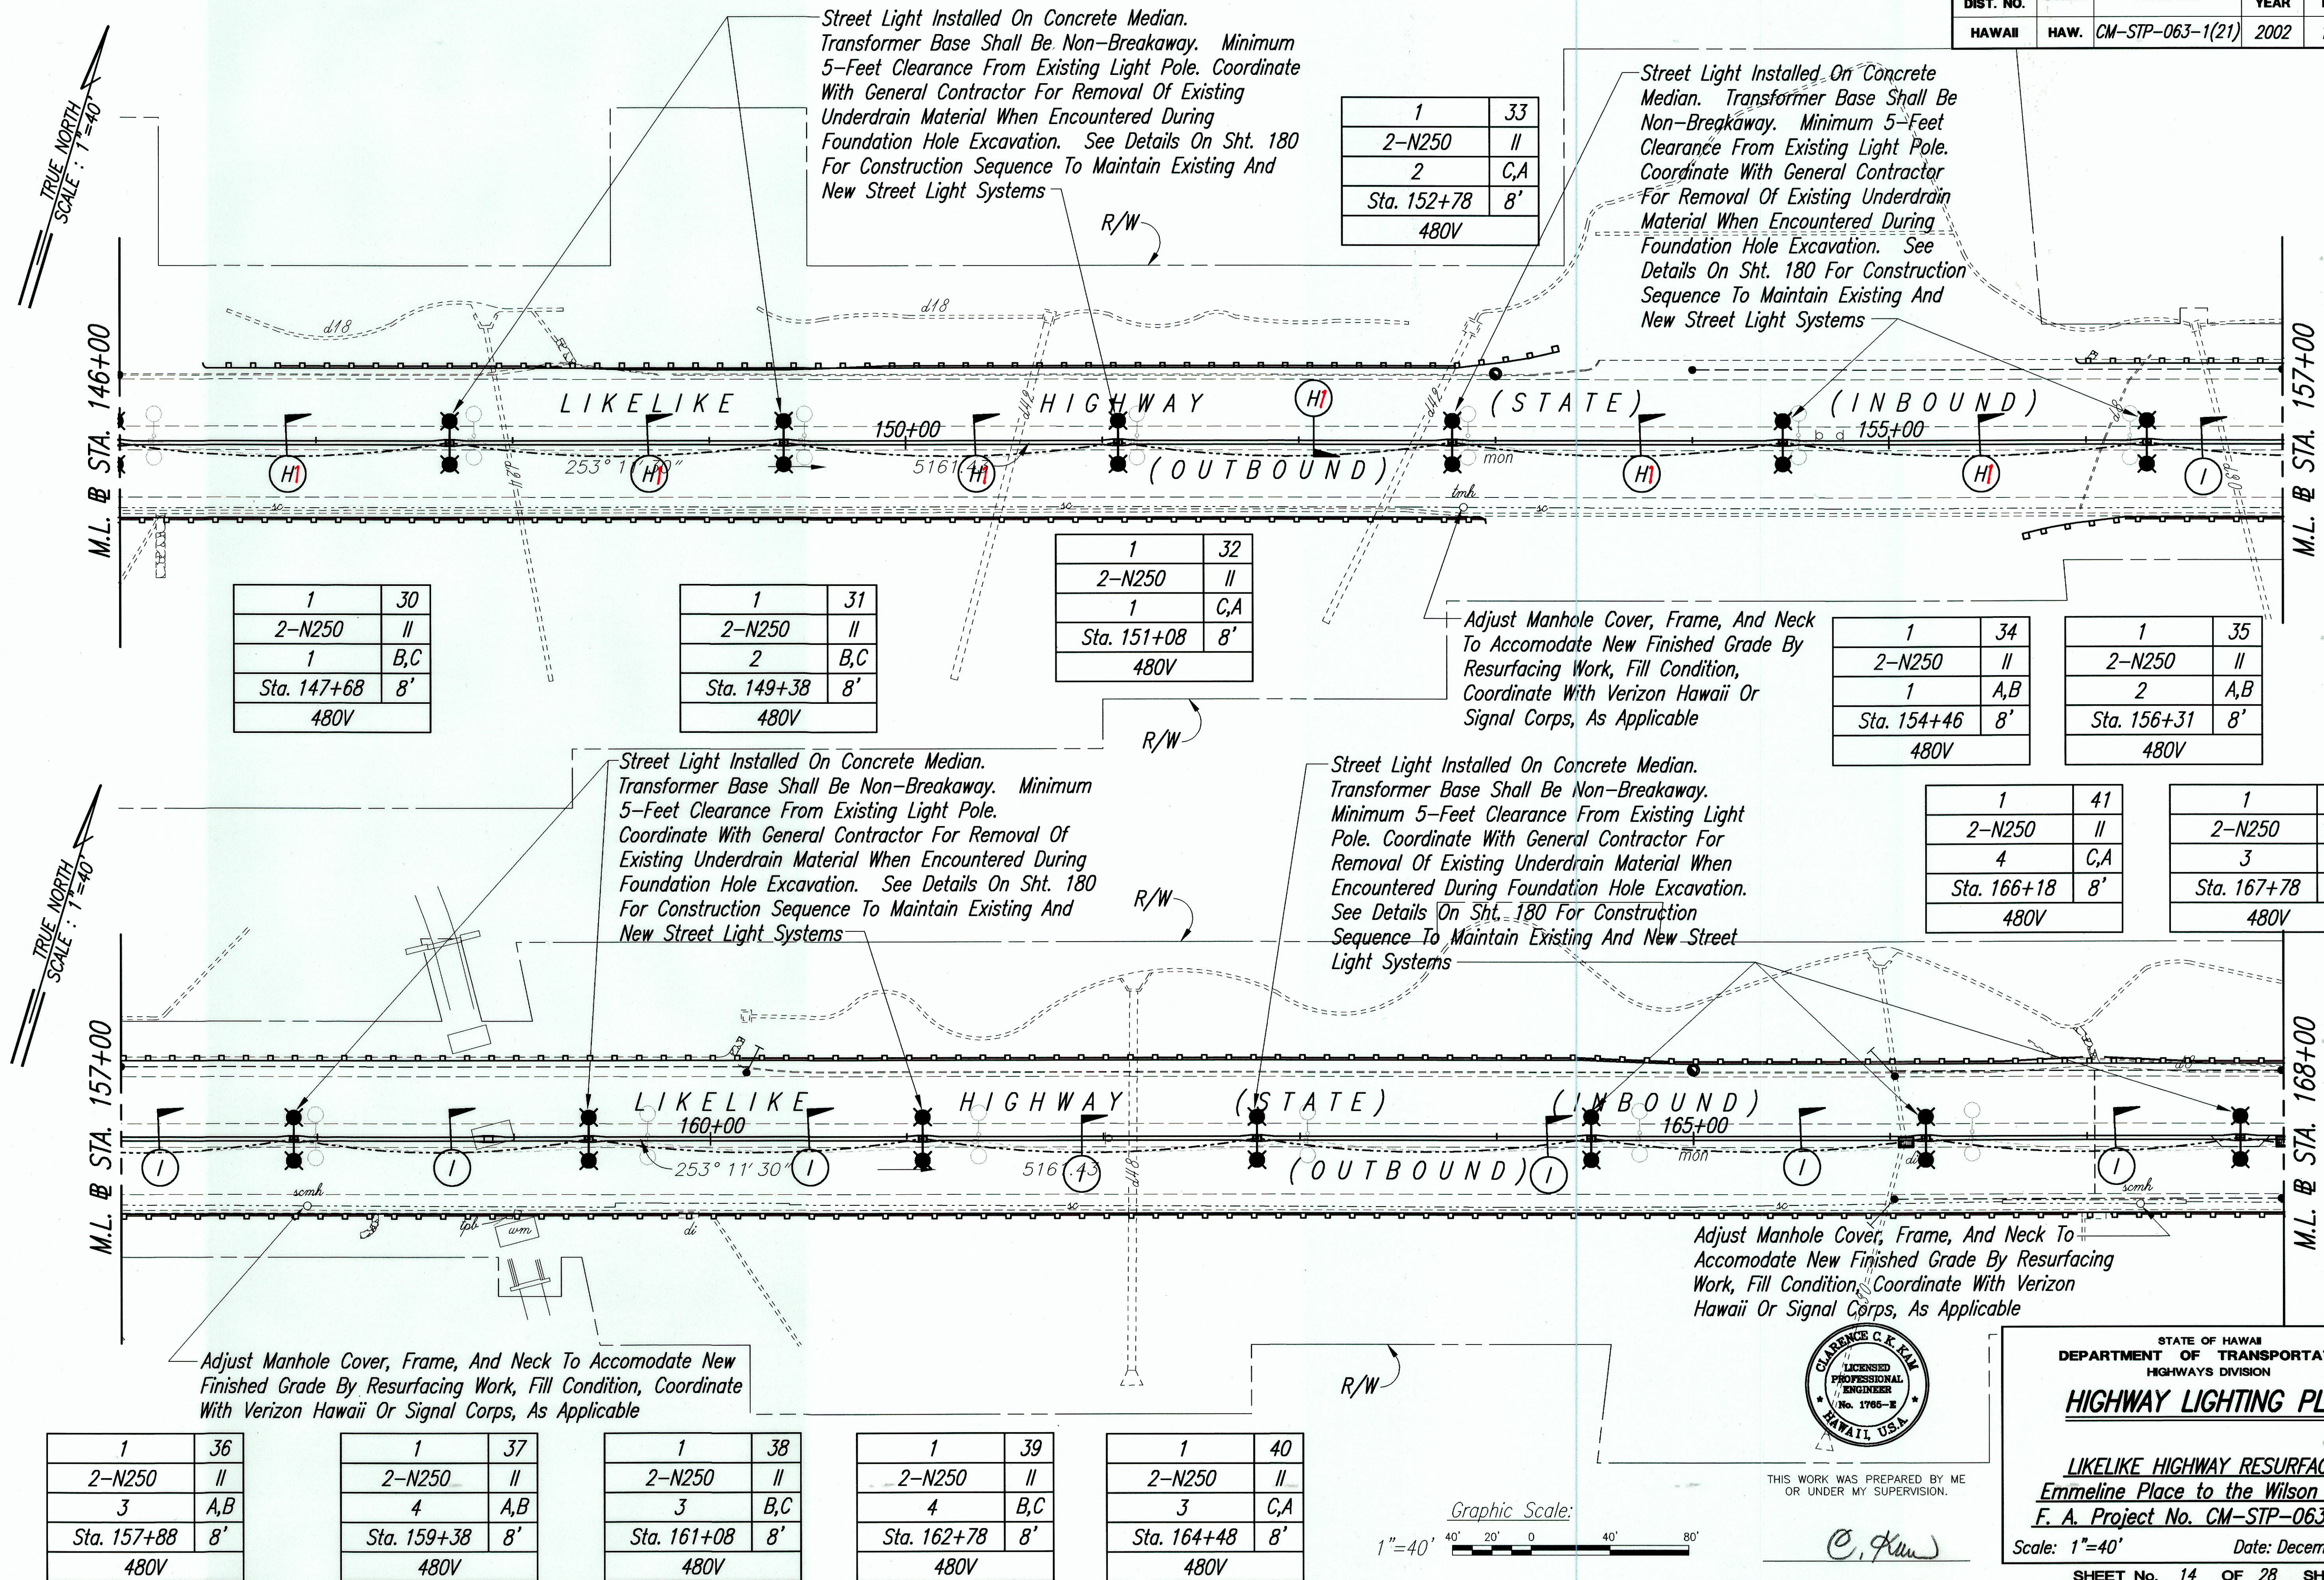

Street Light Installed On Concrete Median. Transformer Base Shall Be Non-Breakaway. Minimum 5-Feet Clearance From Existing Light Pole. Coordinate With General Contractor For Removal Of Existing Underdrain Material When Encountered During Foundation Hole Excavation. See Details On Sht. 180 For Construction Sequence To Maintain Existing And New Street Light Systems

1	31
2-N250	11
2	B,C
Sta. 149+38	8'
480V	

1	32
2-N250	11
1	C,A
Sta. 151+08	8'
480V	

Adjust Manhole Cover, Frame, And Neck
To Accomodate New Finished Grade By
Resurfacing Work, Fill Condition,
Coordinate With Verizon Hawaii Or
Signal Corps, As Applicable

1	35
2-N250	II
2	A, E
Sta. 156+31	8'
480V	

1	4
2-N250	11
4	C ₁
Sta. 166+18	8
480V	

1	42
2-N250	11
3	A, E
Sta. 167+78	8'
480V	

*Adjust Manhole Cover, Frame, And Neck To Accomodate New
Finished Grade By Resurfacing Work, Fill Condition, Coordinate
With Verizon Hawaii Or Signal Corps, As Applicable*


1	37
2-N250	11
4	A,B
Sta. 159+38	8'
480V	

1	38
2-N250	11
3	B,C
Sta. 161+08	8'
480V	

1	39
2-N250	11
4	B,C
Sta. 162+78	8'
480V	

1	40
2-N250	11
3	C, A
Sta. 164+48	8'
480V	

Graphic Scale:



STATE OF HAWAII
DEPARTMENT OF TRANSPORTATION
HIGHWAYS DIVISION

HIGHWAY LIGHTING PLAN

LIKELIKE HIGHWAY RESURFACING
Emmeline Place to the Wilson Tunnel
F. A. Project No. CM-STP-063-1(21)


Scale: 1"=40' Date: December, 2001

SHEET No. 14 OF 28 SHEETS


"AS-BUILT"

168

FED. ROAD DIST. NO.	STATE	PROJ. NO.	FISCAL YEAR	SHEET NO.	TOTAL SHEETS
HAWAII	HAW.	CM-STP-063-1(21)	2002	169	187

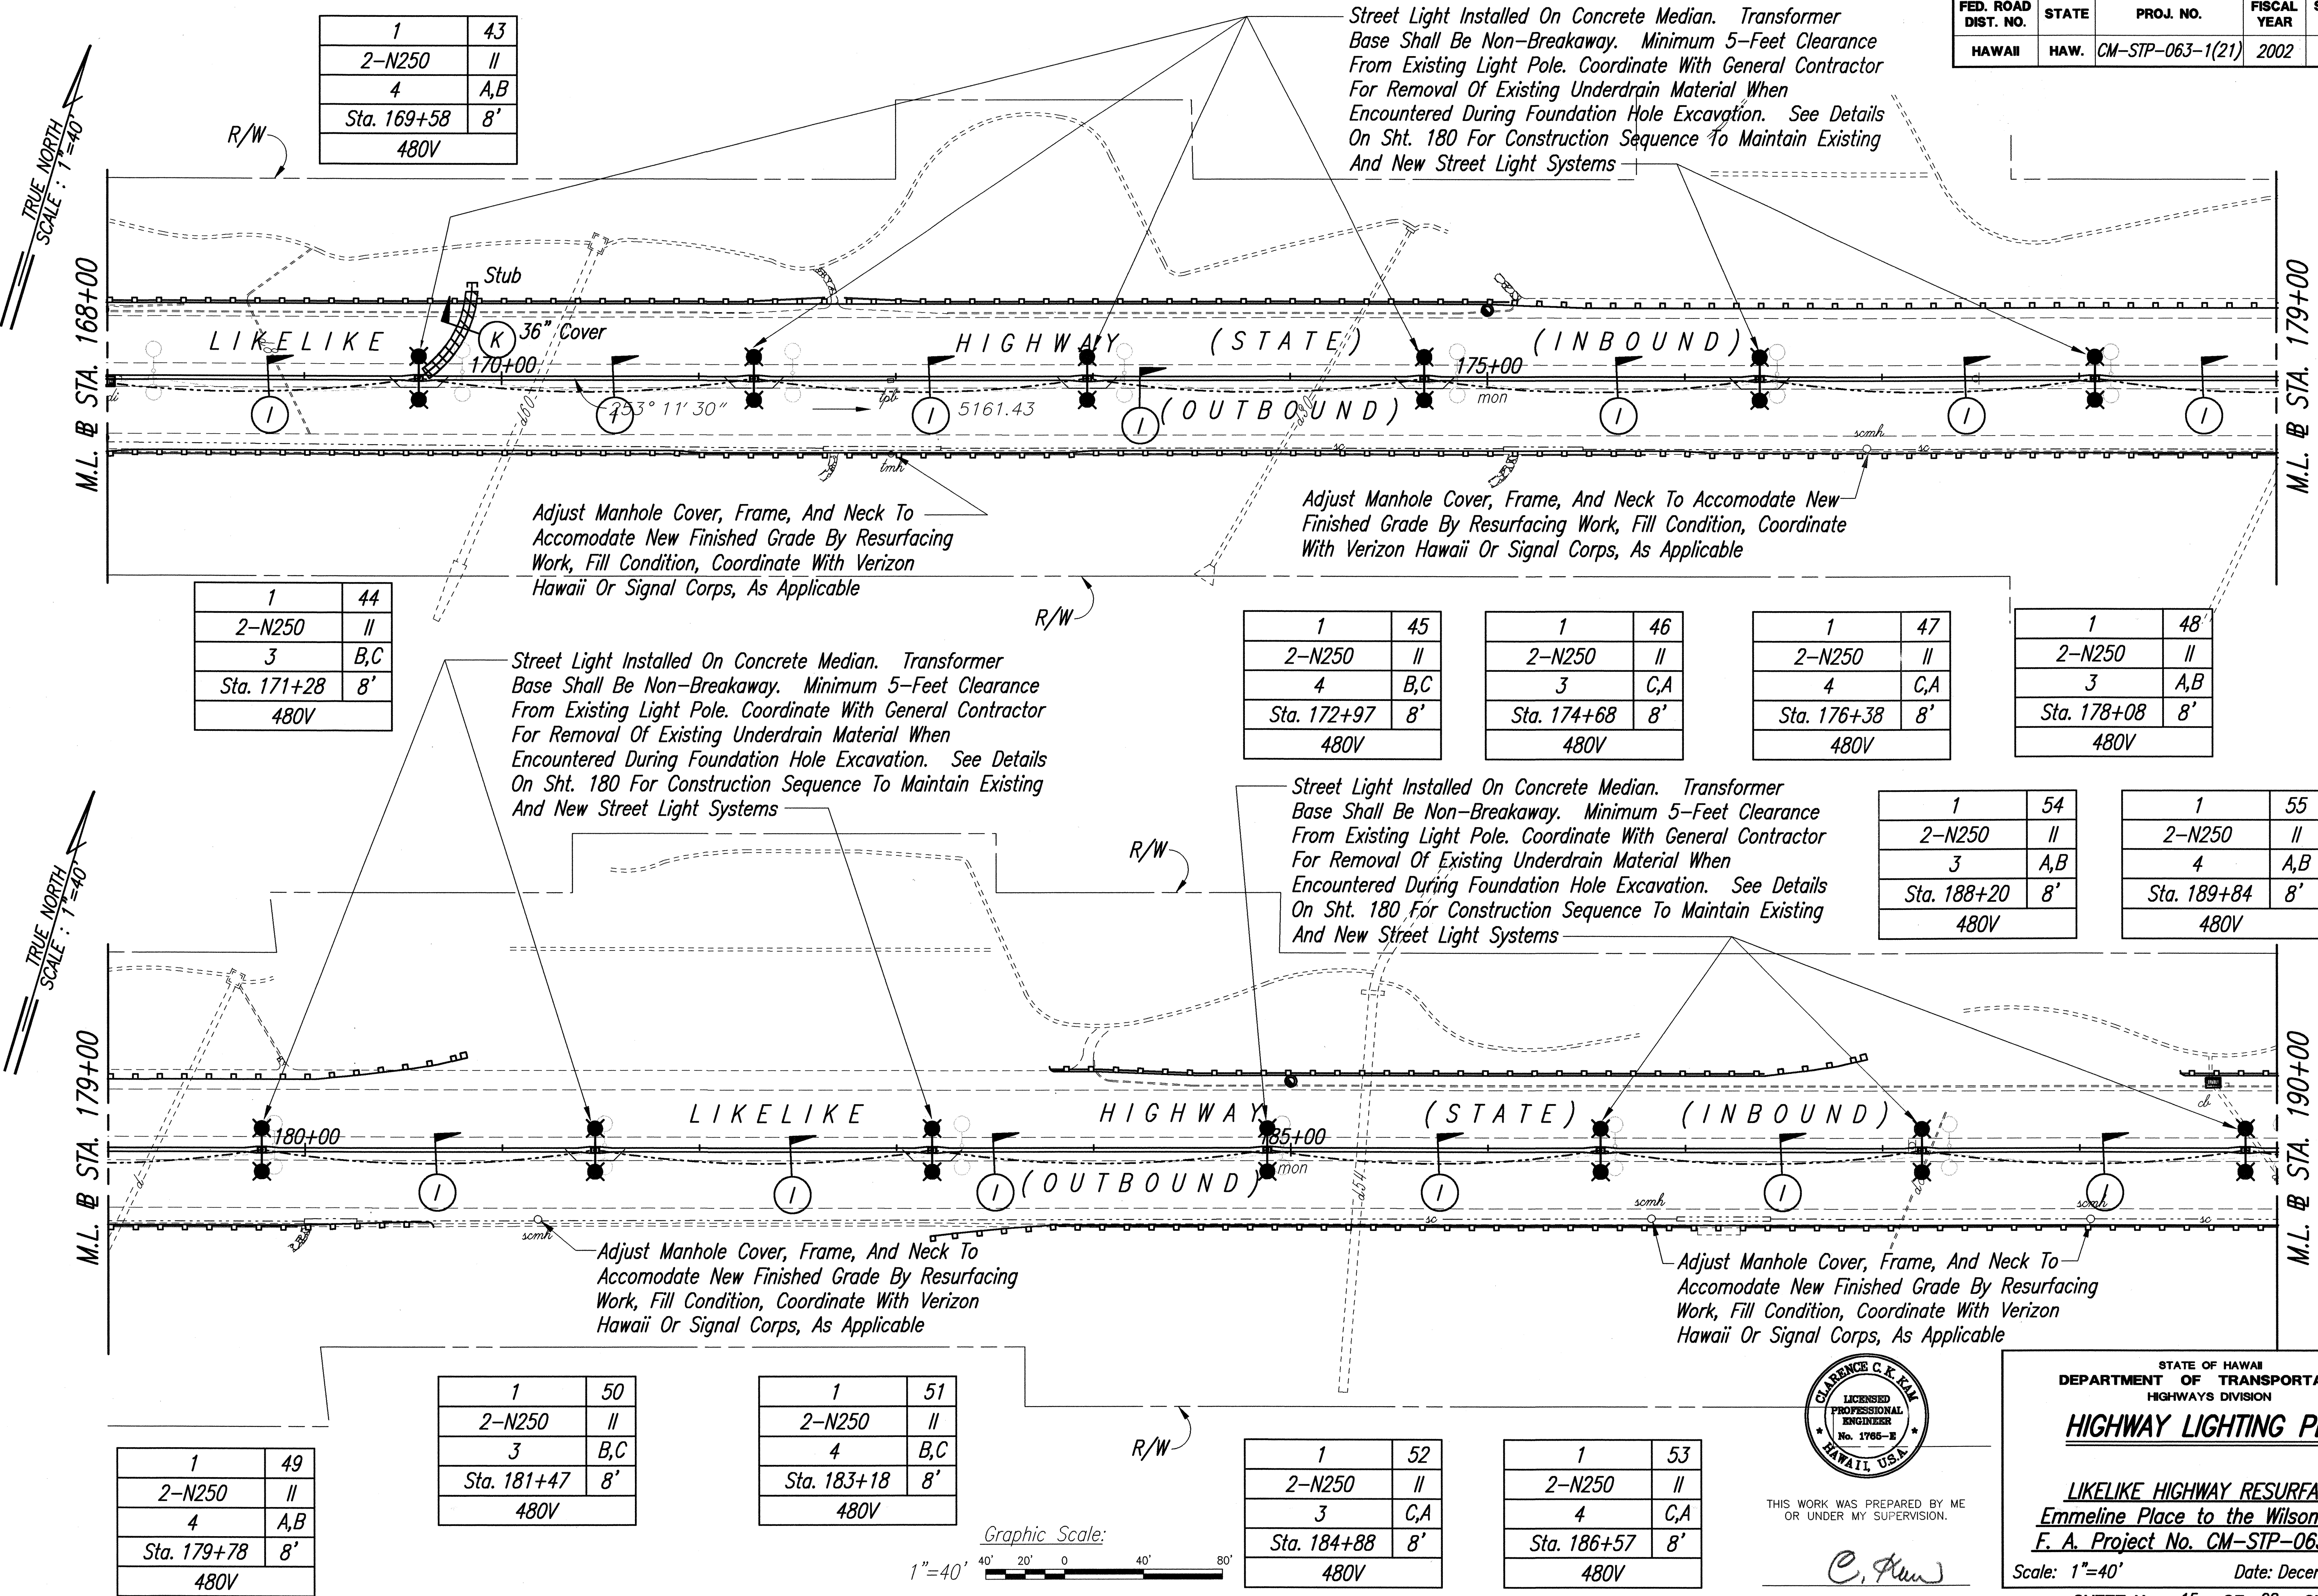

ORIGINAL PLAN	SURVEY PLOTTED BY	DATE
NOTE BOOK	DRAWN BY	"
	DESIGNED BY	"
	QUANTITIES BY	"
	CHECKED BY	"
No.		

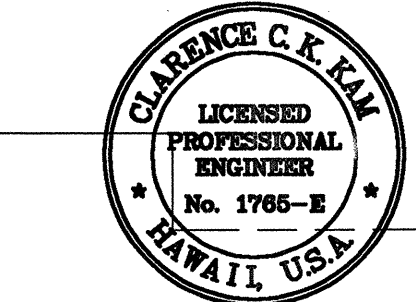

THIS WORK WAS PREPARED BY ME
OR UNDER MY SUPERVISION.

C. Kim

STATE OF HAWAII
DEPARTMENT OF TRANSPORTATION
HIGHWAYS DIVISION


HIGHWAY LIGHTING PLAN

LIKELIKE HIGHWAY RESURFACING
Emmeline Place to the Wilson Tunnel
F. A. Project No. CM-STP-063-1(21)
Scale: 1"=40' Date: December, 2001

SHEET No. 15 OF 28 SHEETS

FED. ROAD DIST. NO.	STATE	PROJ. NO.	FISCAL YEAR	SHEET NO.	TOTAL SHEETS
HAWAII	HAW.	CM-STP-063-1(21)	2001	171	187

1	68	1	69	1	70	1	71	1	72	1	73	1	74
2-N250	II	2-N250	II	2-N250	II	2-N250	II	2-N250	II	2-N250	II	2-N250	II
5	B,C	6	B,C	5	C,A	6	C,A	5	A,B	6	A,B	5	B,C
Sta. 212+08	8'	Sta. 213+78	8'	Sta. 215+48	8'	Sta. 217+18	8'	Sta. 218+81	8'	Sta. 220+58	8'	Sta. 222+28	8'
480V		480V		480V		480V		480V		480V		480V	

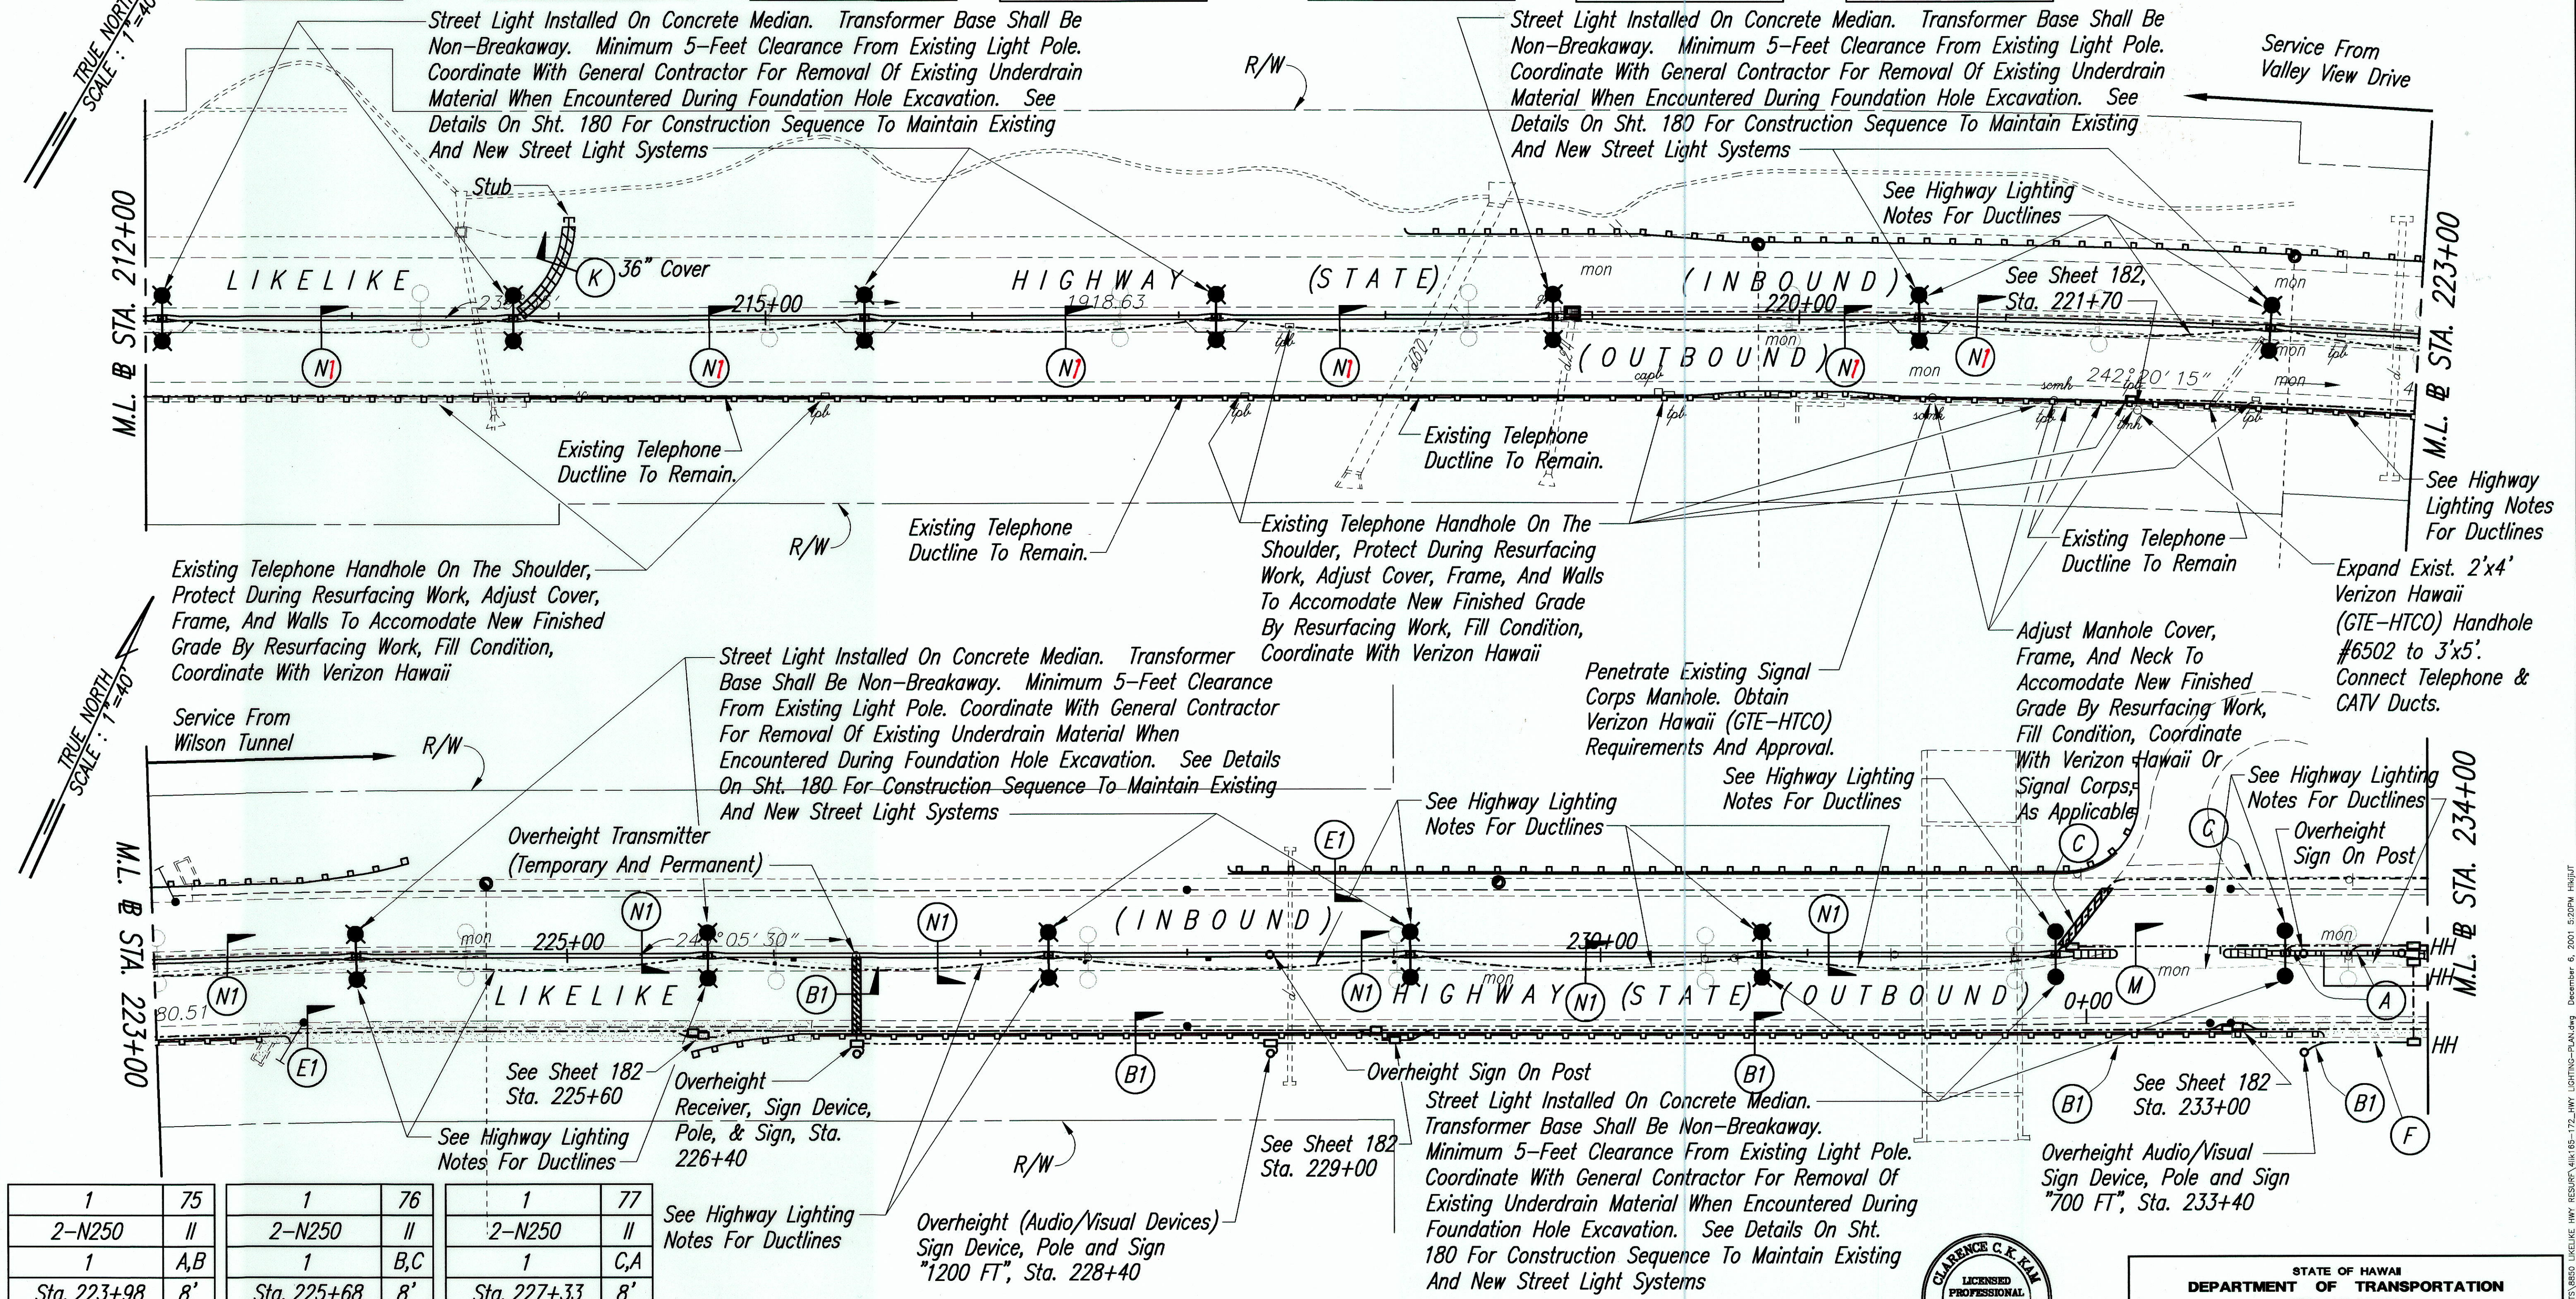

1	75	1	76	1	77
2-N250	II	2-N250	II	2-N250	II
1	A,B	1	B,C	1	C,A
Sta. 223+98	8'	Sta. 225+68	8'	Sta. 227+33	8'
240V		240V		240V	

1	78	1	79
2-N250	II	2-N250	II
1	A,B	1	B,C
Sta. 229+08	8'	Sta. 230+78	8'
240V		240V	

1	80	1	81
2-N250	II	2-N250	II
1	C,A	1	A,B
Sta. 232+20	8'	Sta. 233+31	8'
240V		240V	

APPROVED:


[Signature] Date *12/10/01*

Verizon Hawaii, Inc. (GTE-HTCO)

[Signature] Date *12/12/01*

Oceanic Cablevision Co.

Note:
See Sheet 187 for Verizon/CATV ductline profile.

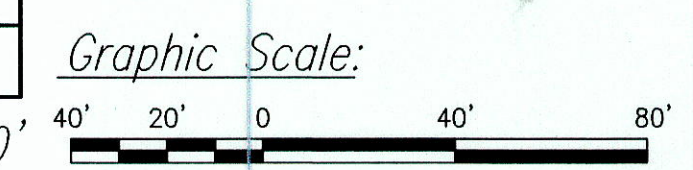

THIS WORK WAS PREPARED BY ME OR UNDER MY SUPERVISION.

STATE OF HAWAII
DEPARTMENT OF TRANSPORTATION
HIGHWAYS DIVISION

HIGHWAY LIGHTING PLAN

LIKELIKE HIGHWAY RESURFACING
Emmeline Place to the Wilson Tunnel
F. A. Project No. CM-STP-063-1(21)





Scale: 1"=40' Date: December, 2001

SHEET No. 17 OF 28 SHEETS

DATE	12/10/01
SURVEY PLOTTED BY	
ORIGINAL PLAN	
DESIGNED BY	
QUANTITIES BY	
CHECKED BY	
No.	

"AS-BUILT"

FED. ROAD DIST. NO.	STATE	PROJ. NO.	FISCAL YEAR	SHEET NO.	TOTAL SHEETS
HAWAII	HAW.	CM-STP-063-1(21)	2002	174	187

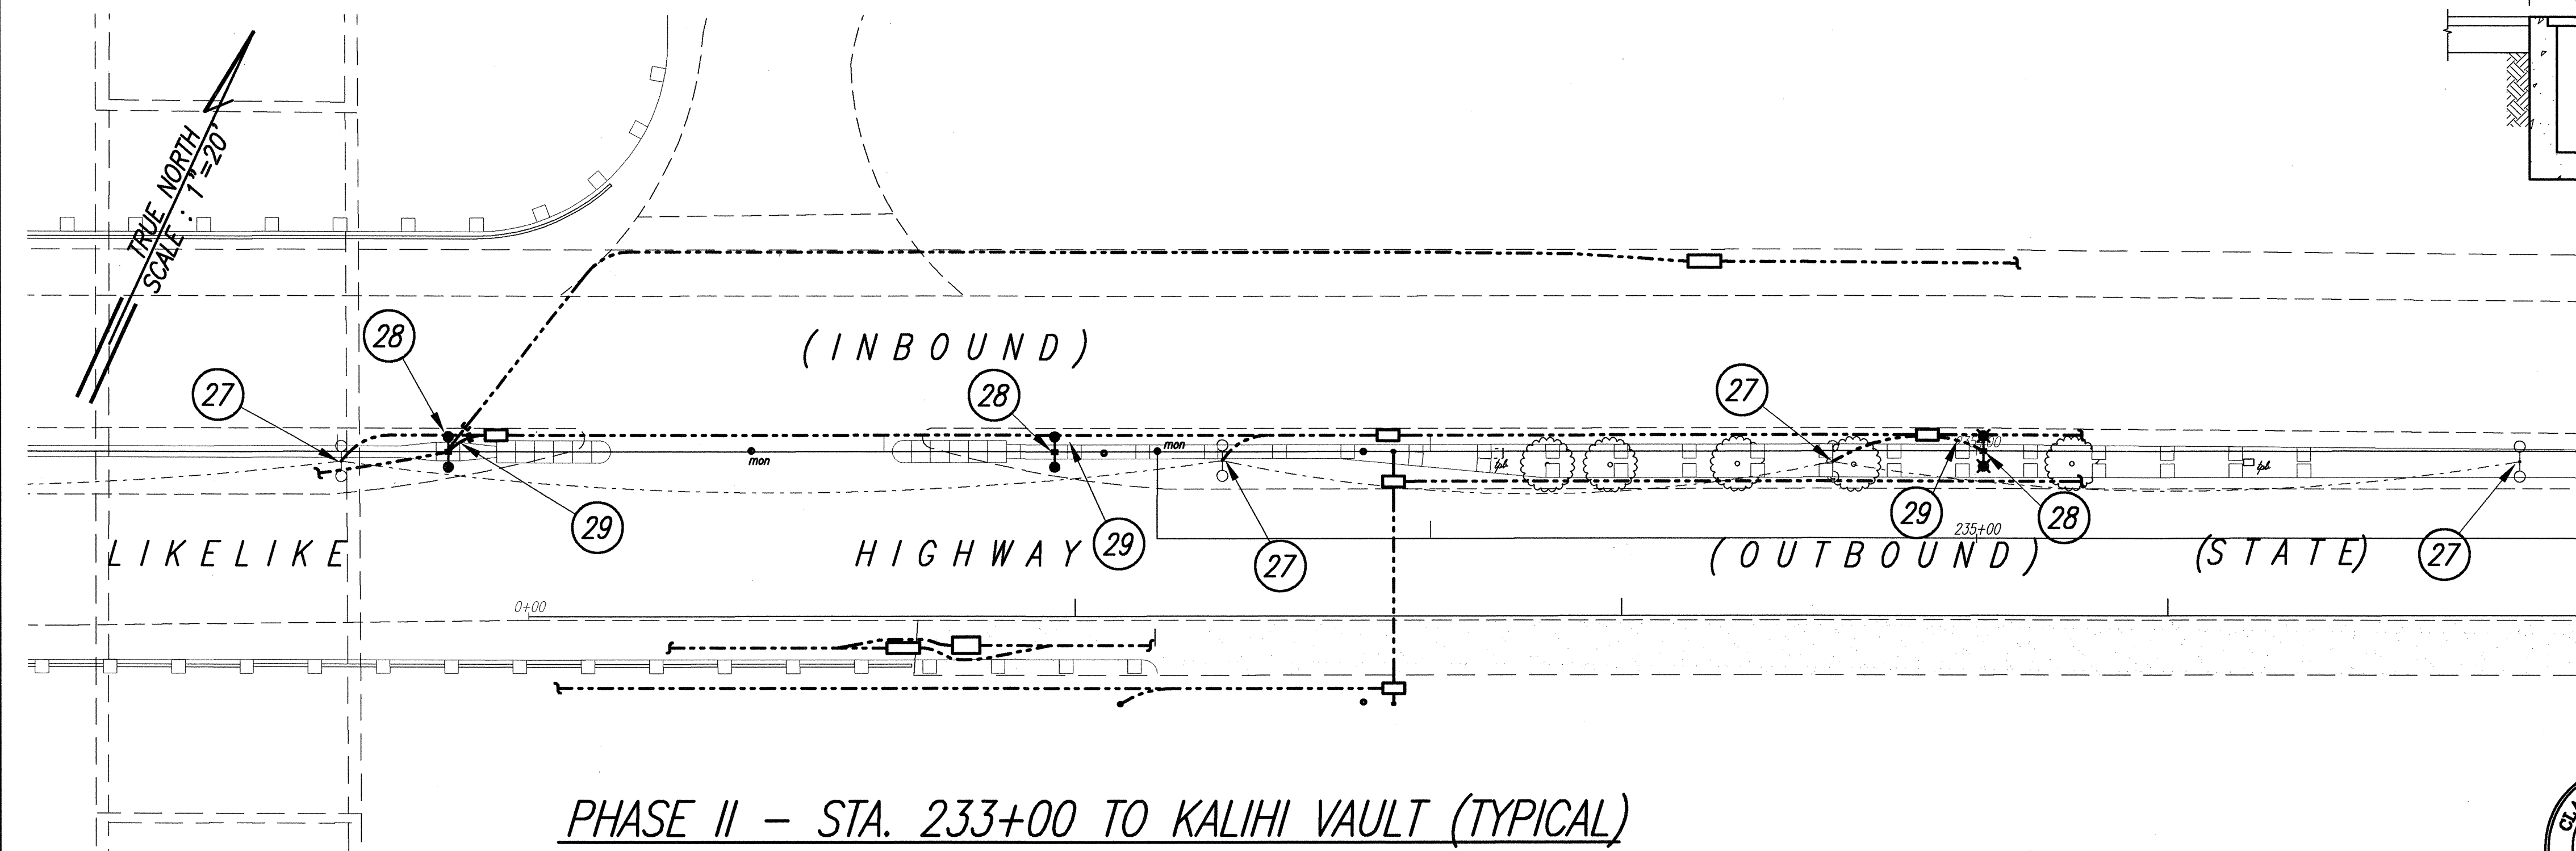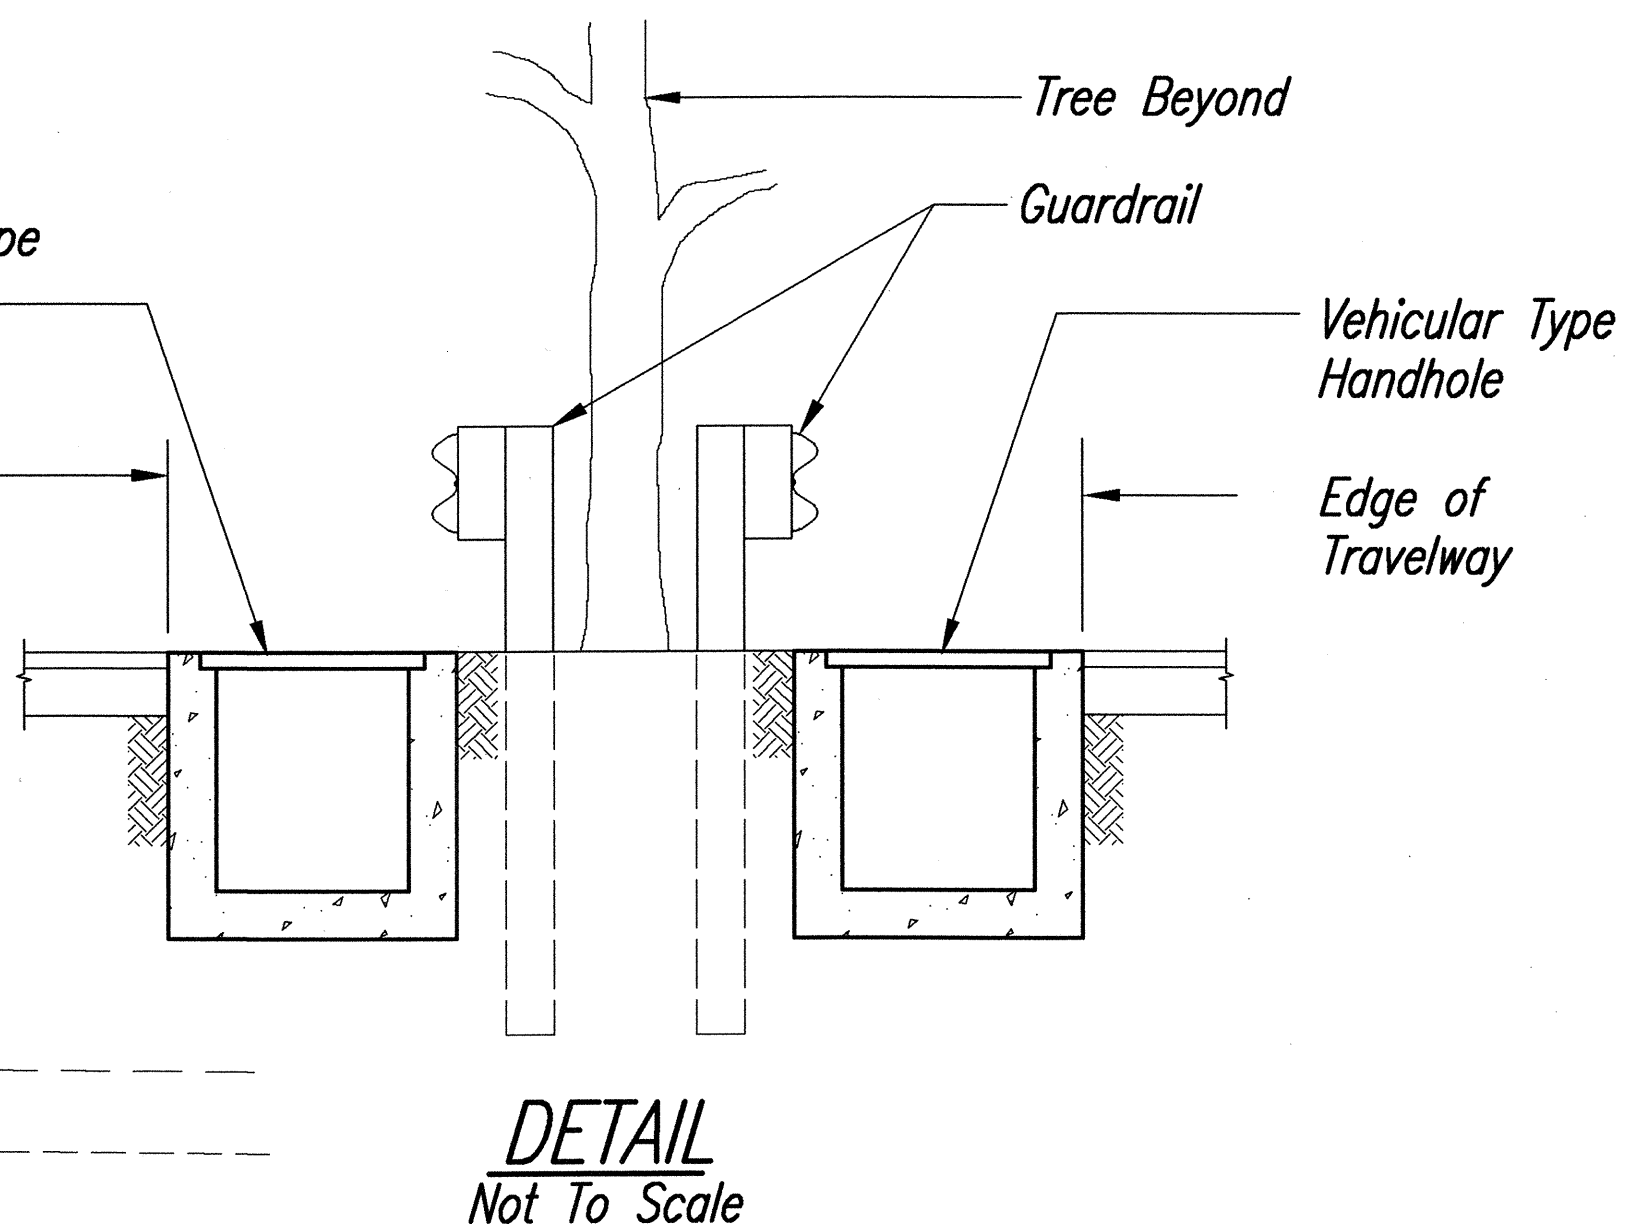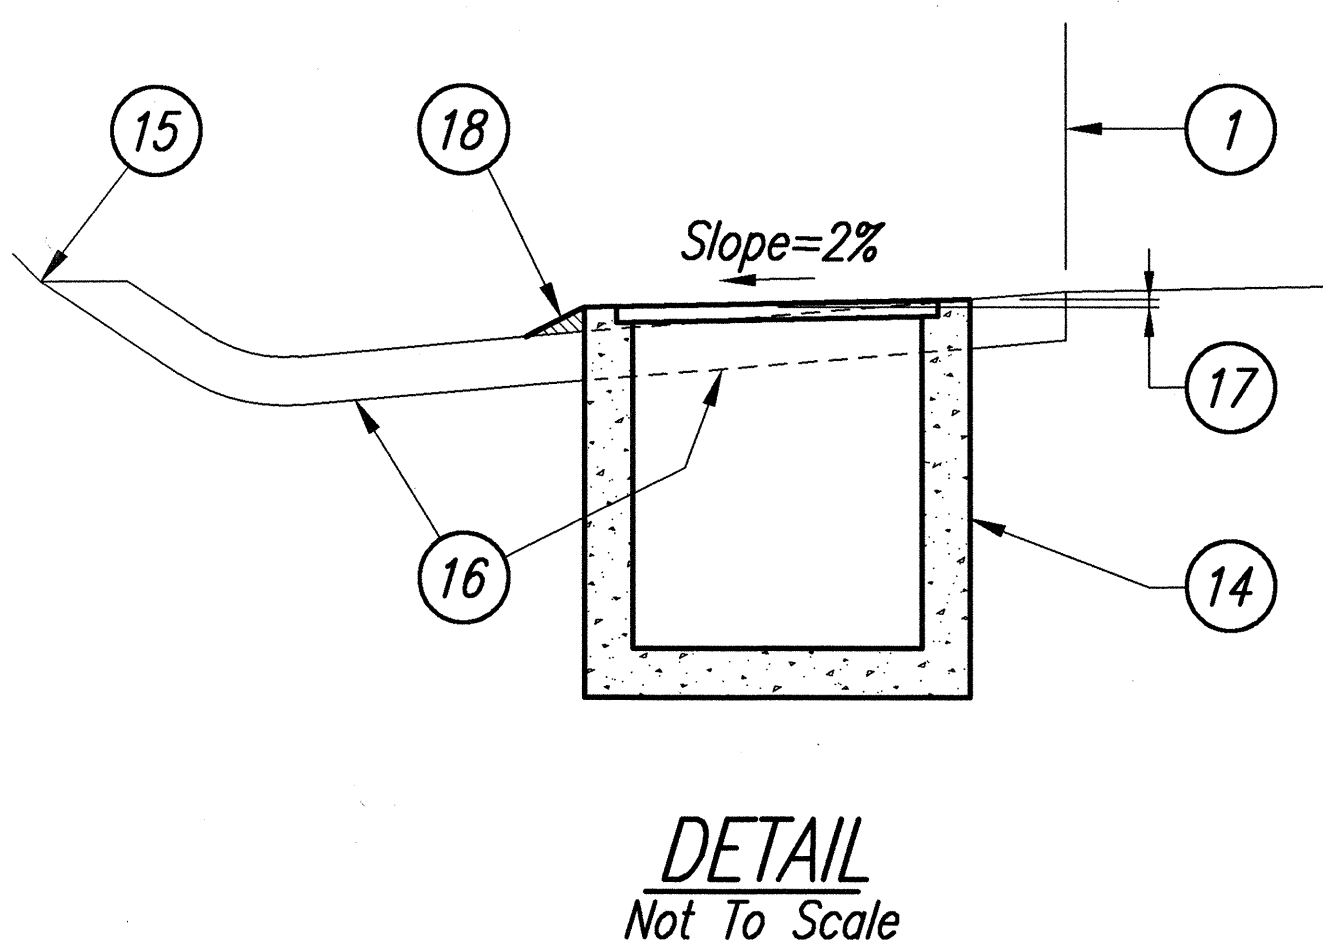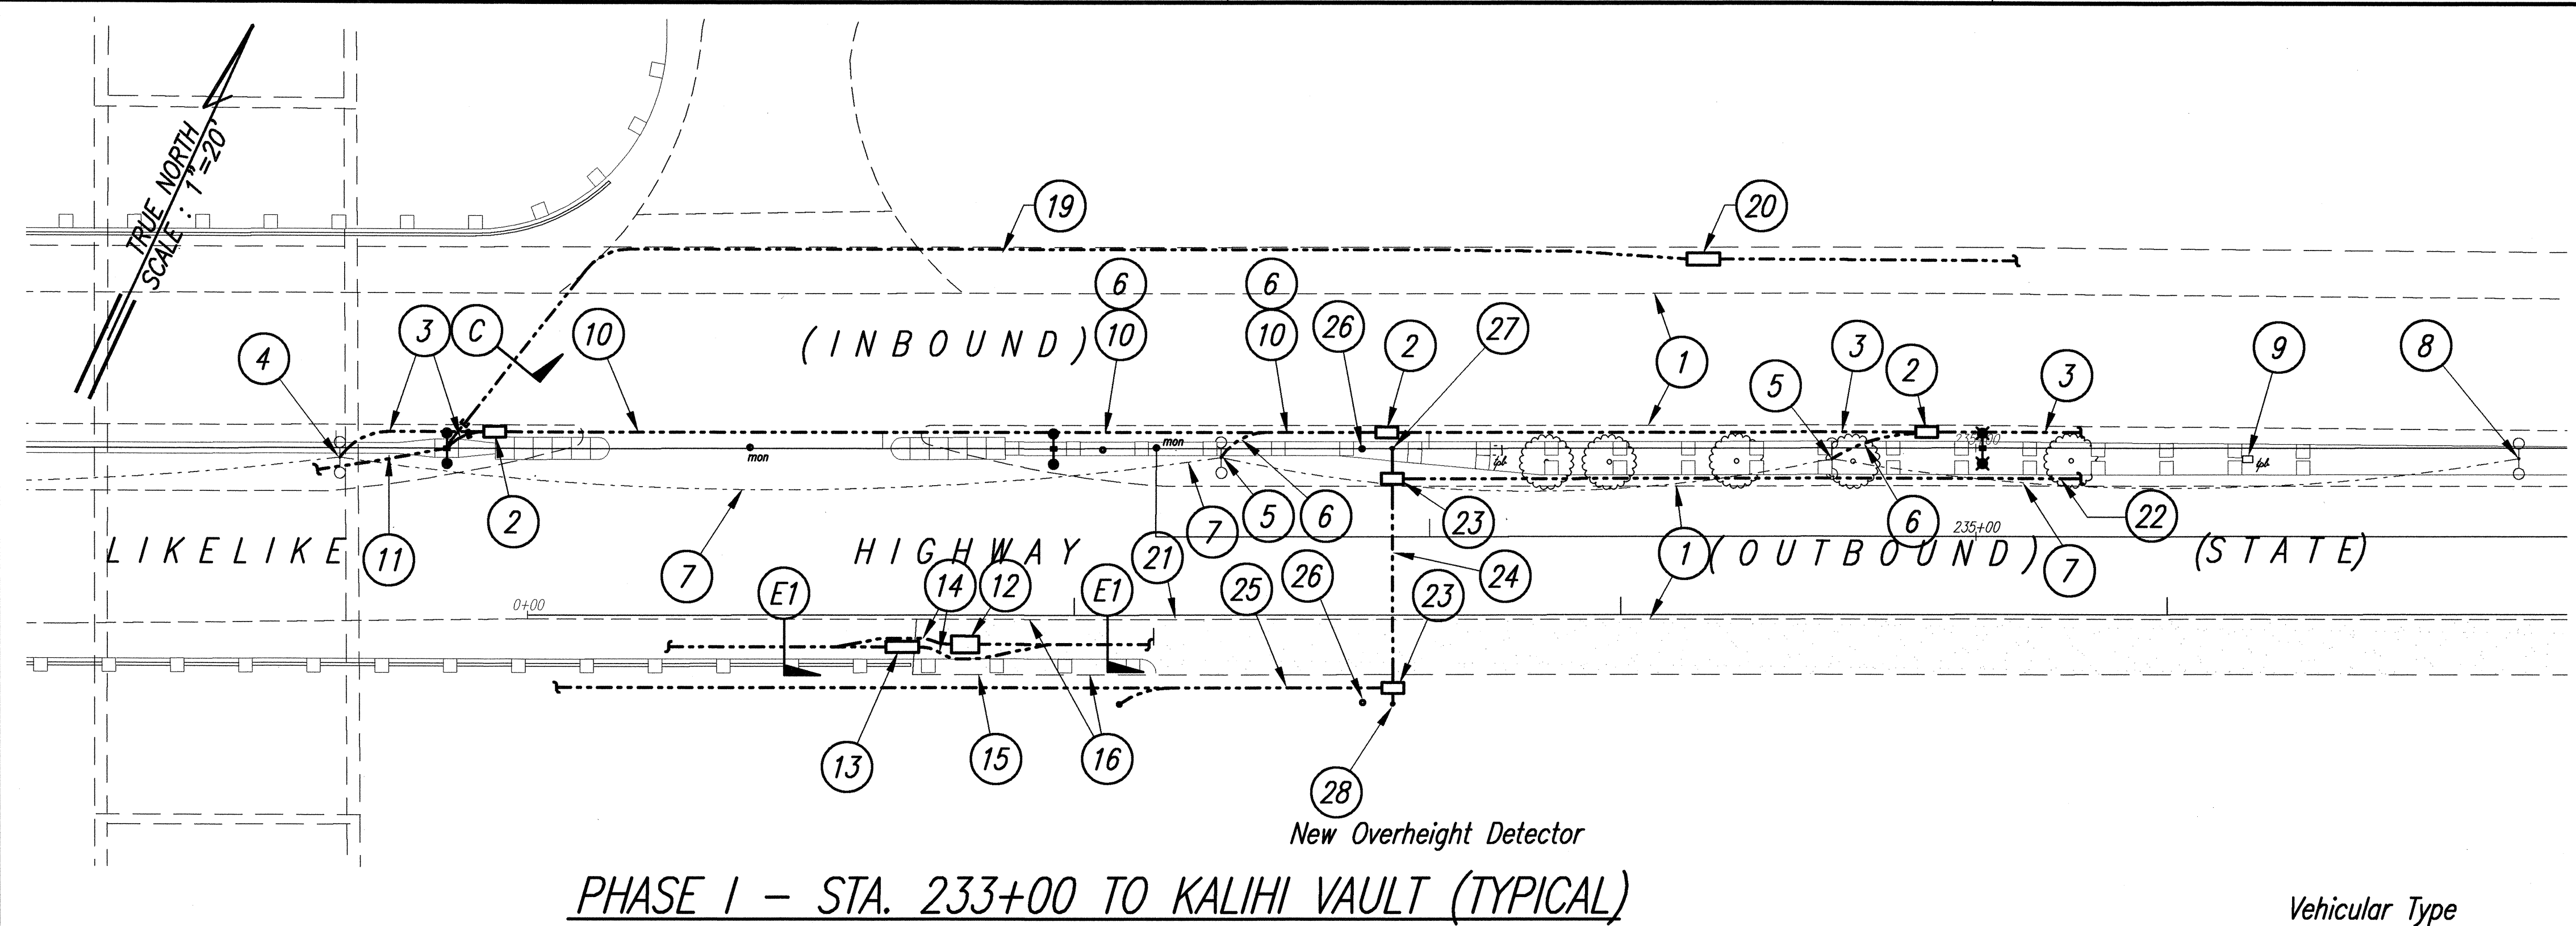

NOTES:
1. See sheet 173 for reference



THIS WORK WAS PREPARED BY ME
OR UNDER MY SUPERVISION.

C. K. M.

STATE OF HAWAII
DEPARTMENT OF TRANSPORTATION
HIGHWAYS DIVISION




MEDIAN BARRIER TRANSITION TO UNDERGROUND II
LIKELIKE HIGHWAY RESURFACING
Emmeline Place to the Wilson Tunnel
F. A. Project No. CM-STP-063-1(21)

Scale: NTS
Date: December, 2001


SHEET NO. 20 OF 28 SHEETS

ORIGINAL PLAN	DATE
SURVEY PLOTTED BY	
DRAWN BY	
DESIGNED BY	
QUANTITIES BY	
CHECKED BY	
No.	

FED. ROAD DIST. NO.	STATE	PROJ. NO.	FISCAL YEAR	SHEET NO.	TOTAL SHEETS
HAWAII	HAW.	CM-STP-063-1(21)	2002	176	187

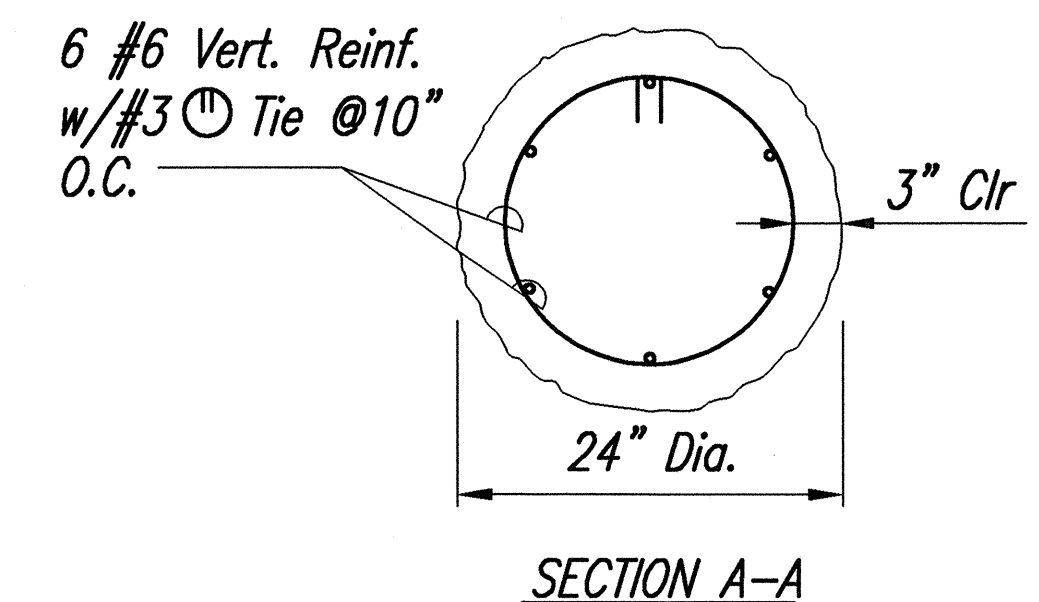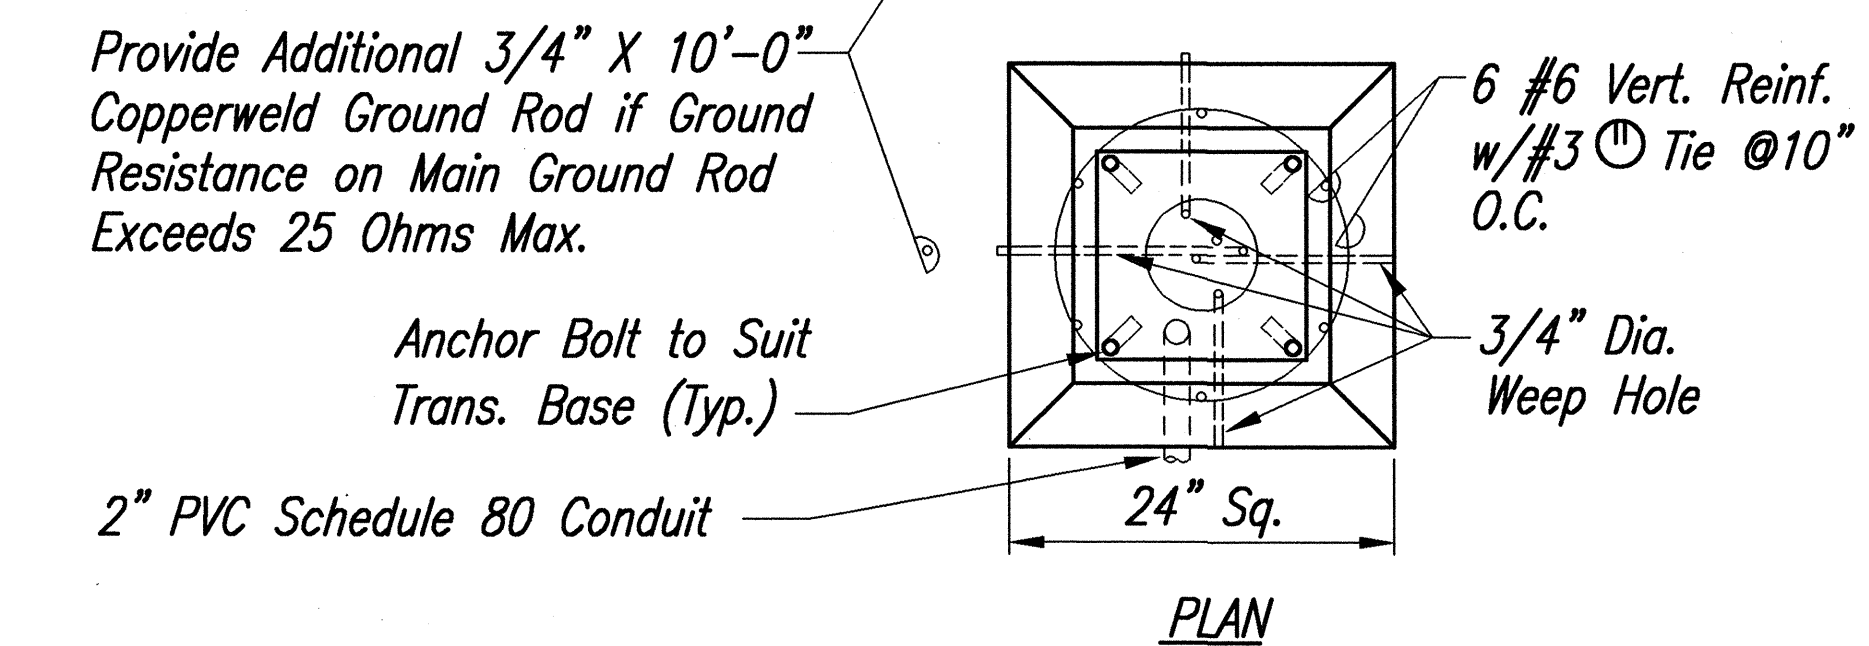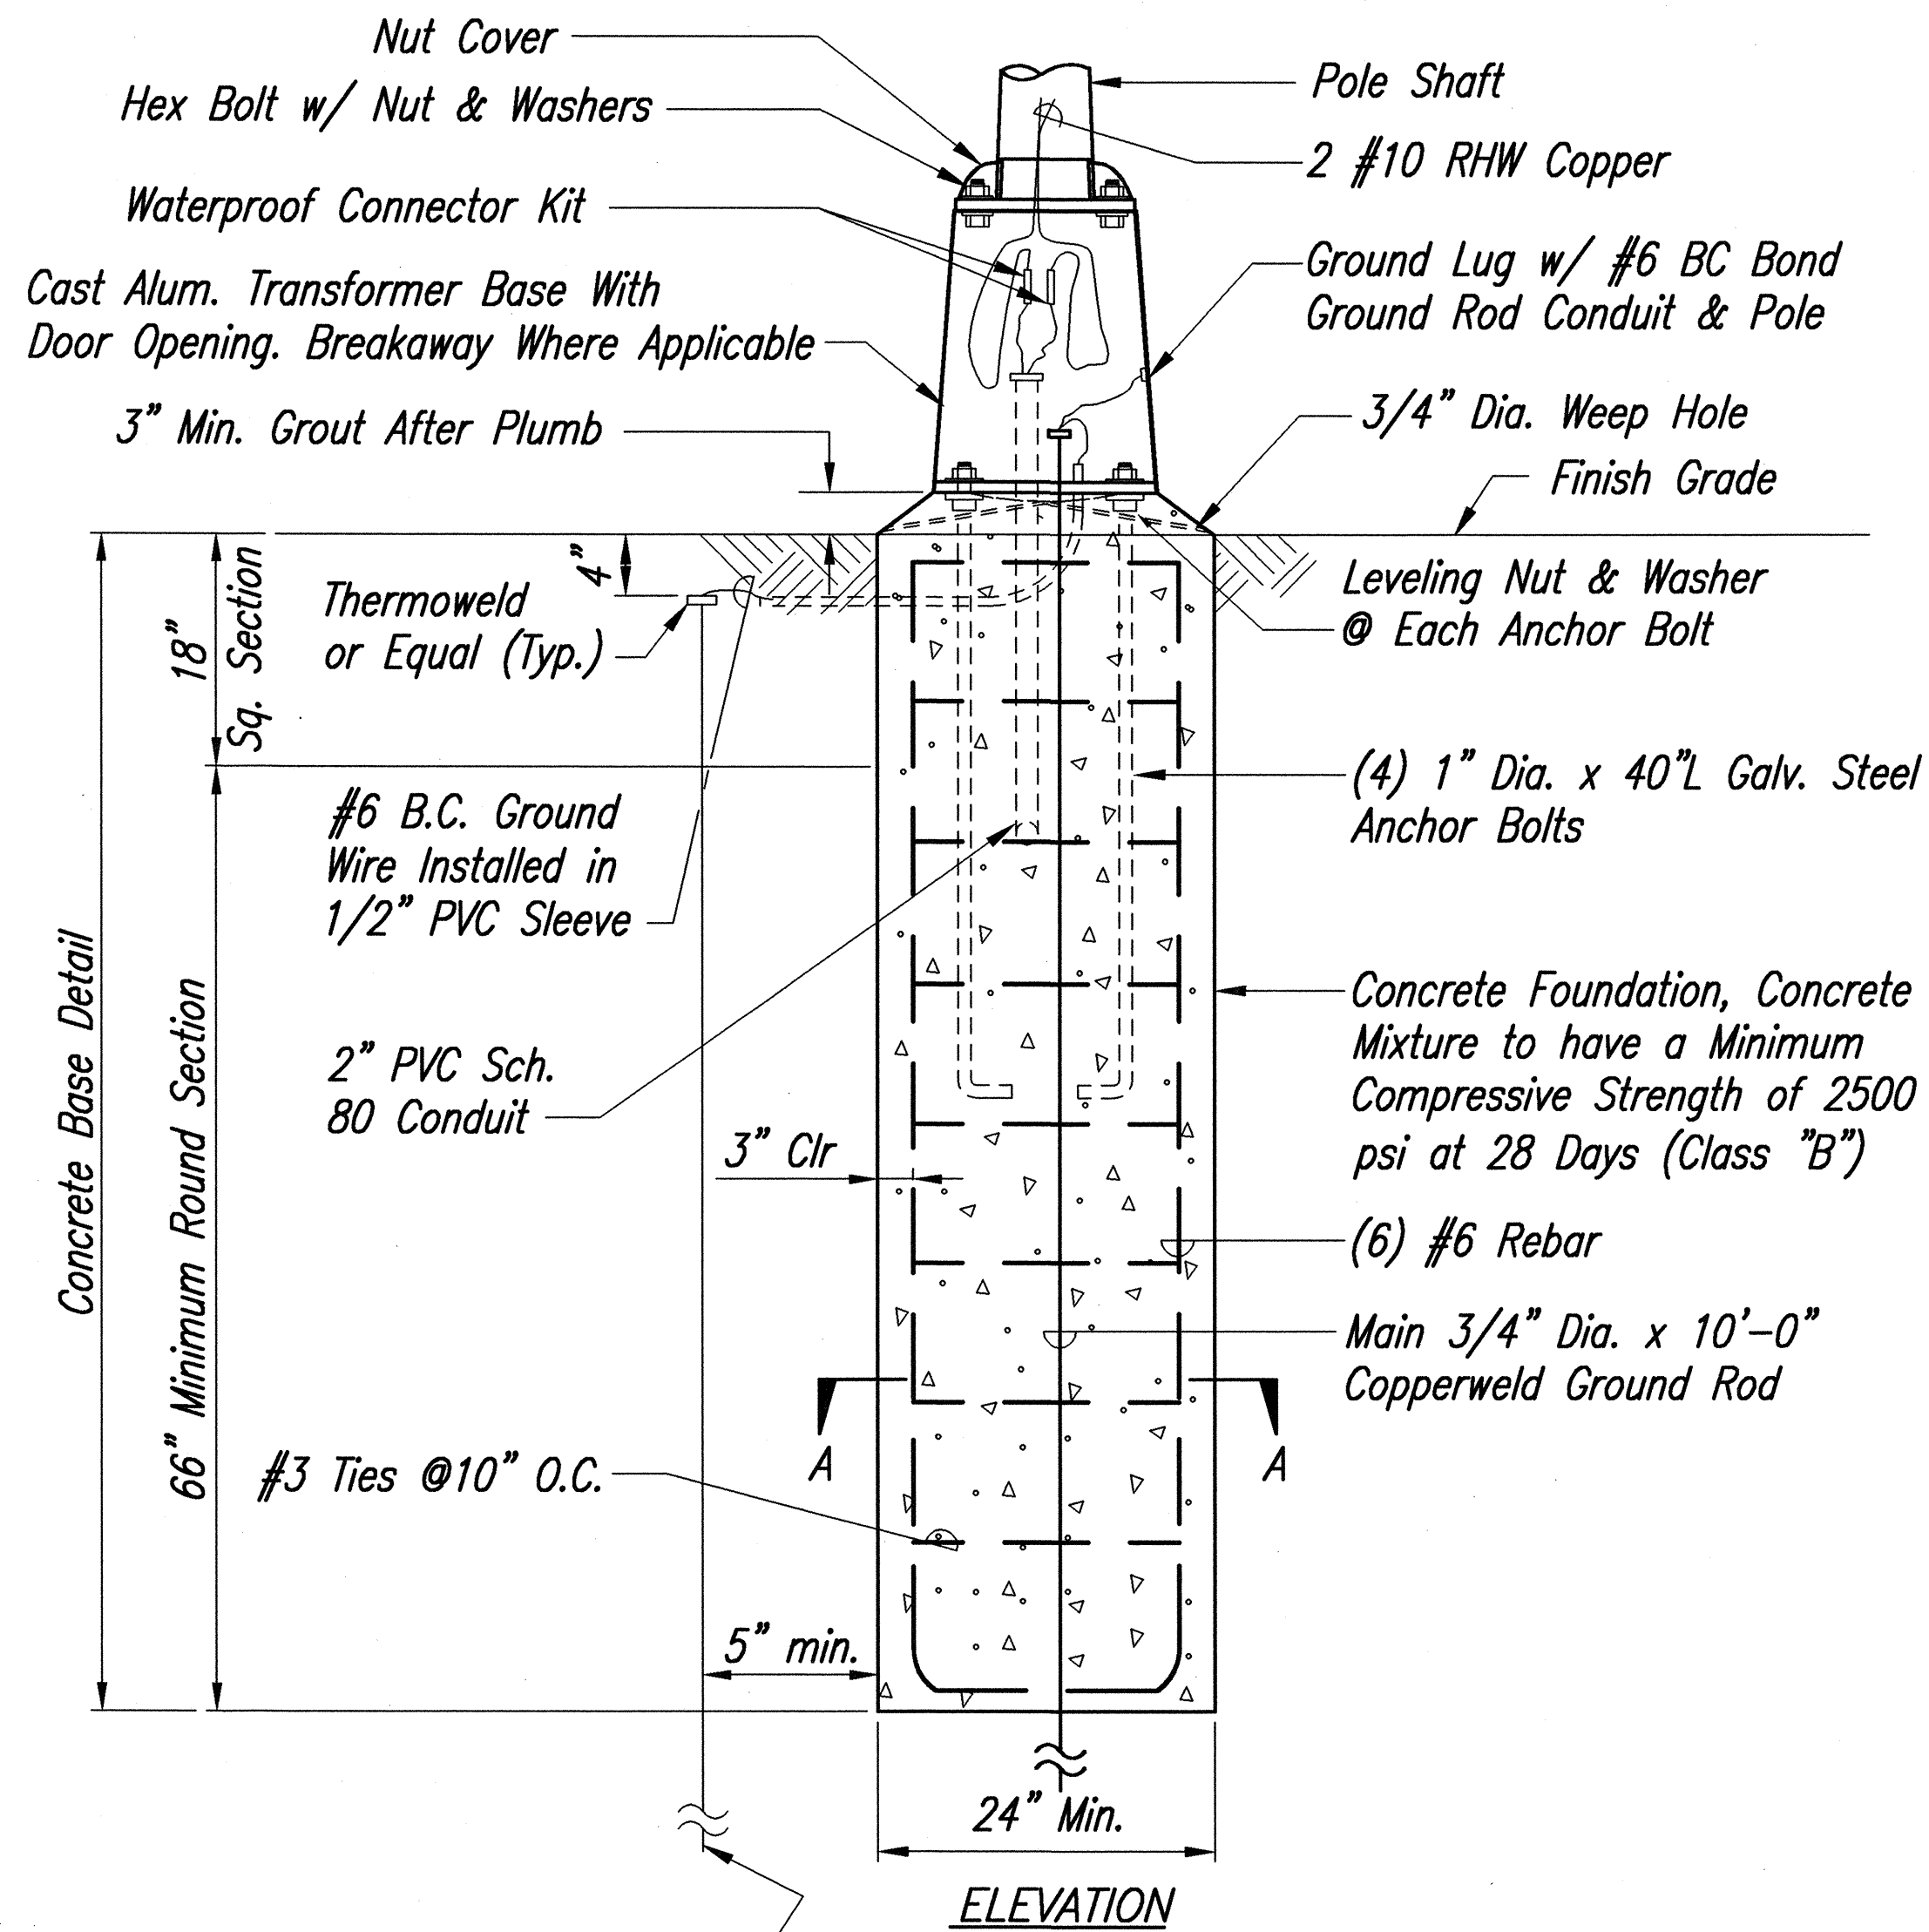


TYPICAL CONCRETE FOUNDATION AND TRANSFORMER BASE DETAIL
NOT TO SCALE

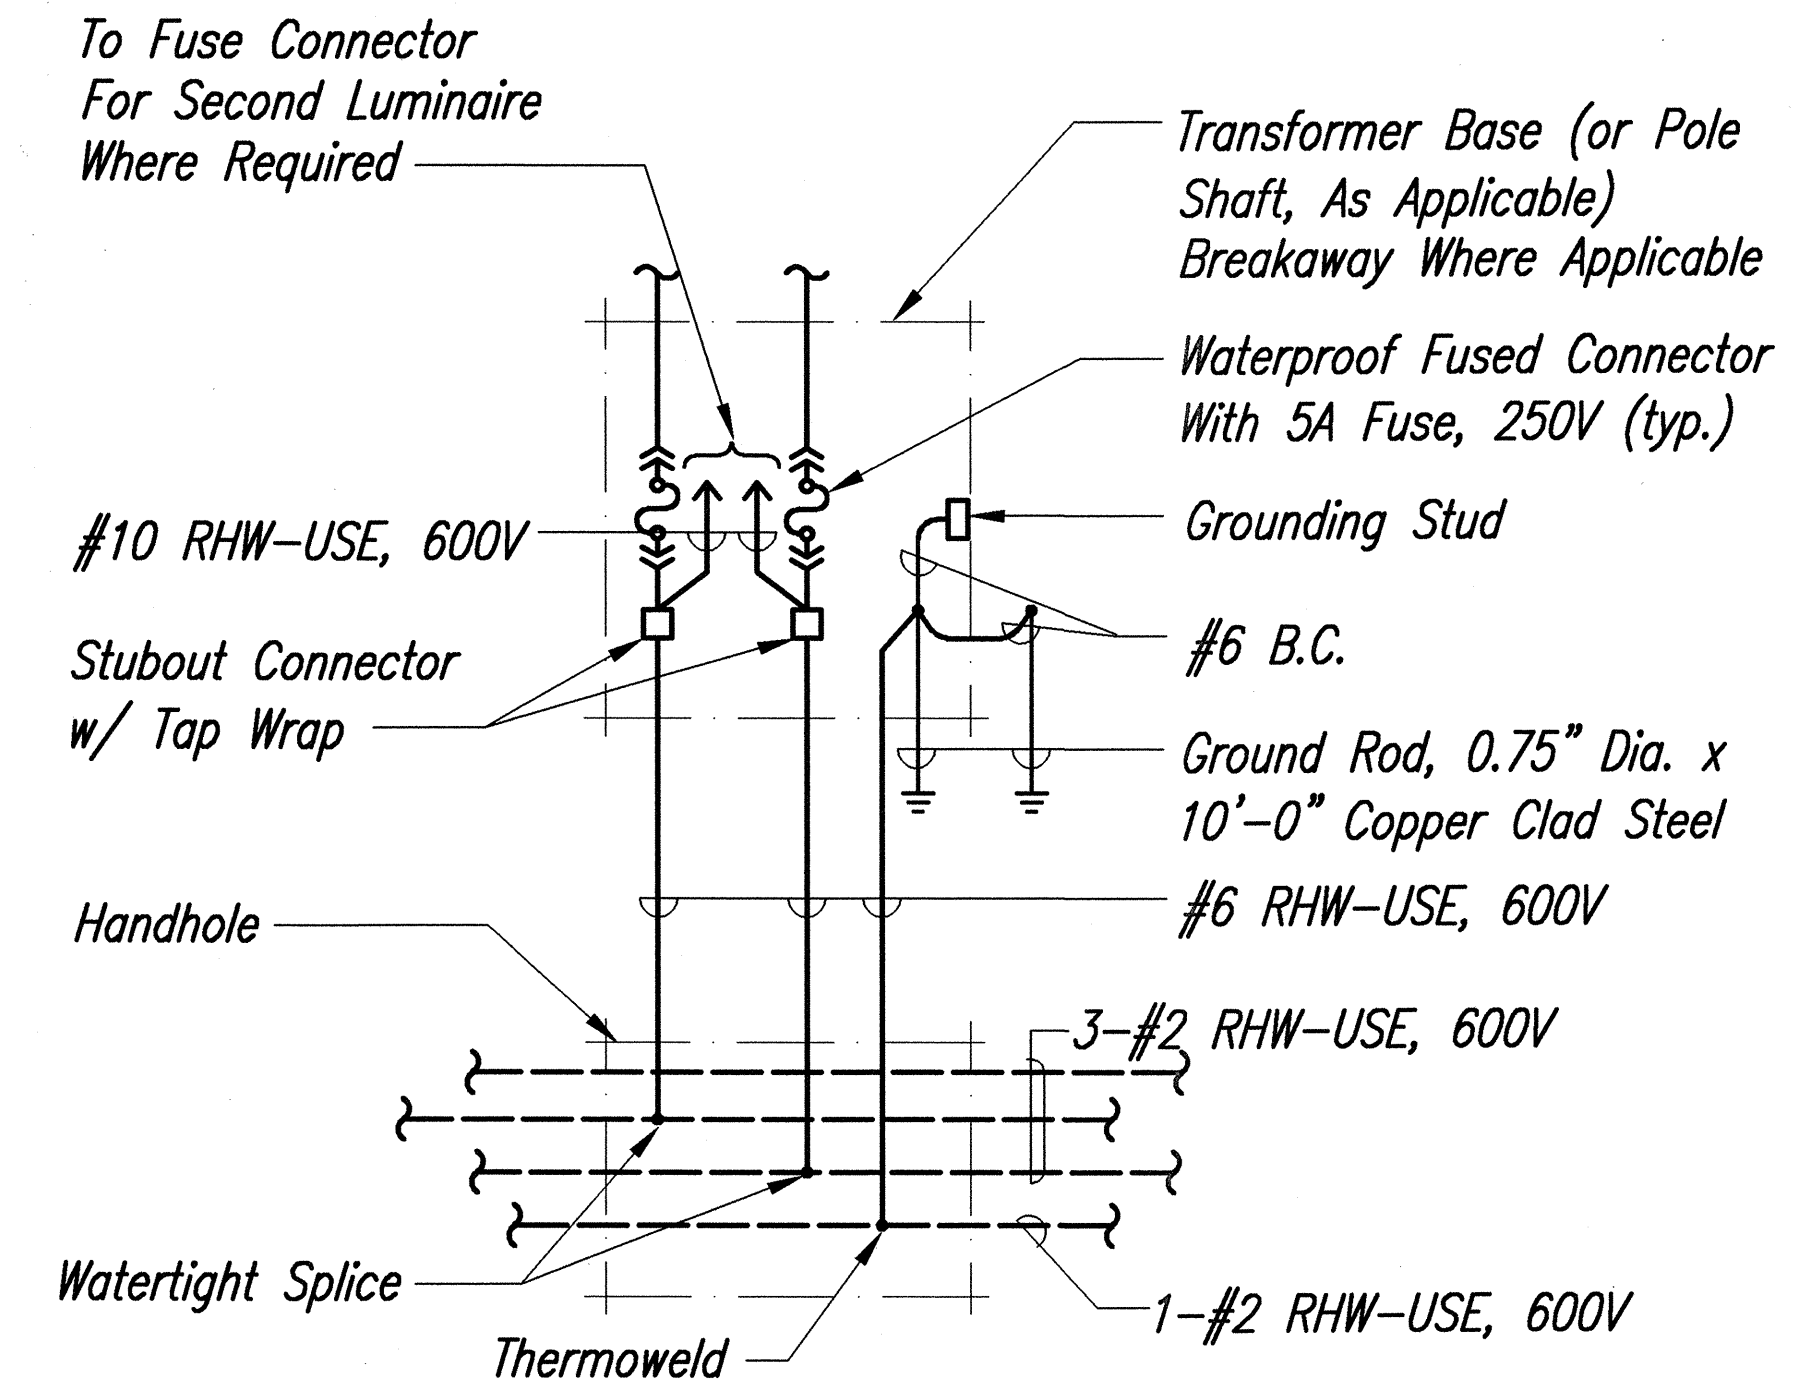

TYPICAL POLE WIRING CONNECTION DIAGRAM

NOTES:

1. Use 3 Ply Laminated Flexible Plastic Black-White-Black. Thickness: Black Cap Sheet-0.010", White Base Sheet-0.052", Black Base Sheet-0.010".
2. Light Pole Number Size Shall Be 1" High and Engraved 1/8" Wide, White in Color (Number as Required).
3. Nomenclature Size Shall Be 5/16" High and Engraved 1/32" Wide, White in Color (Meter Number, Circuit Number, Line Voltage, Lamp Data and Refractor Data As Required).
4. For Street Lights Served From Valley View Drive, Service Voltage Will Be 480V. For Street Lights Served From Wilson Tunnel, Service Voltage Will Be 240V.

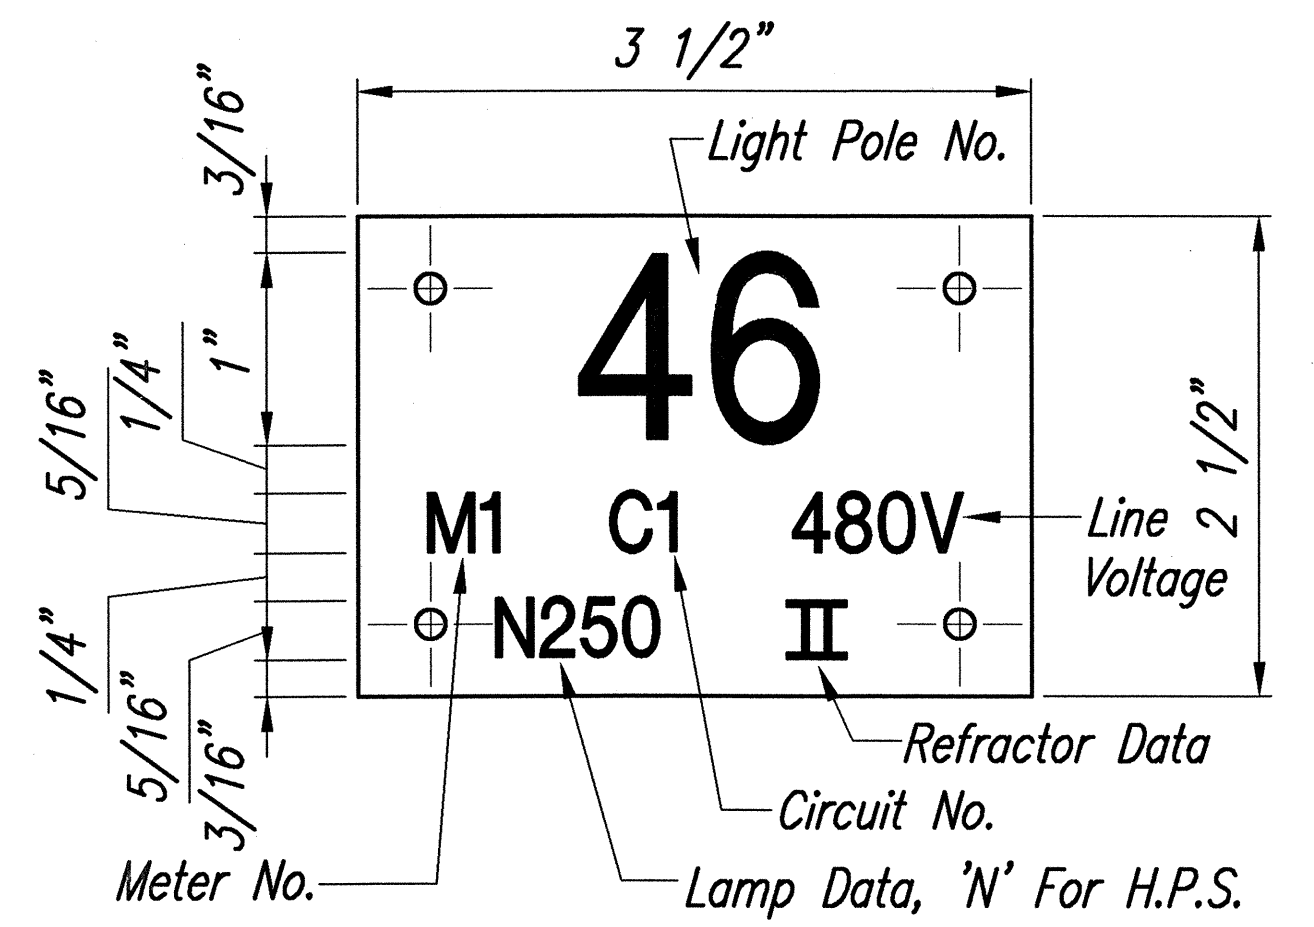

HIGHWAY LIGHT I.D. TAG DETAIL - METERED SYSTEM
NOT TO SCALE

ORIGINAL PLAN	SURVEY PLOTTED BY	DATE
NOTE BOOK	DRAWN BY	
	DESIGNED BY	
	QUANTITIES BY	
	CHECKED BY	







THIS WORK WAS PREPARED BY ME OR UNDER MY SUPERVISION.

THIS WORK WAS PREPARED BY ME OR UNDER MY SUPERVISION.

STATE OF HAWAII
DEPARTMENT OF TRANSPORTATION
HIGHWAYS DIVISION
HIGHWAY LIGHTING DETAILS

LIKELIKE HIGHWAY RESURFACING
Emmeline Place to the Wilson Tunnel
F. A. Project No. CM-STP-063-1(21)
Scale: As Shown Date: December, 2001
SHEET No. 22 OF 28 SHEETS

FED. ROAD DIST. NO.	STATE	PROJ. NO.	FISCAL YEAR	SHEET NO.	TOTAL SHEETS
HAWAII	HAW.	CM-STP-063-1(21)	2002	177	187

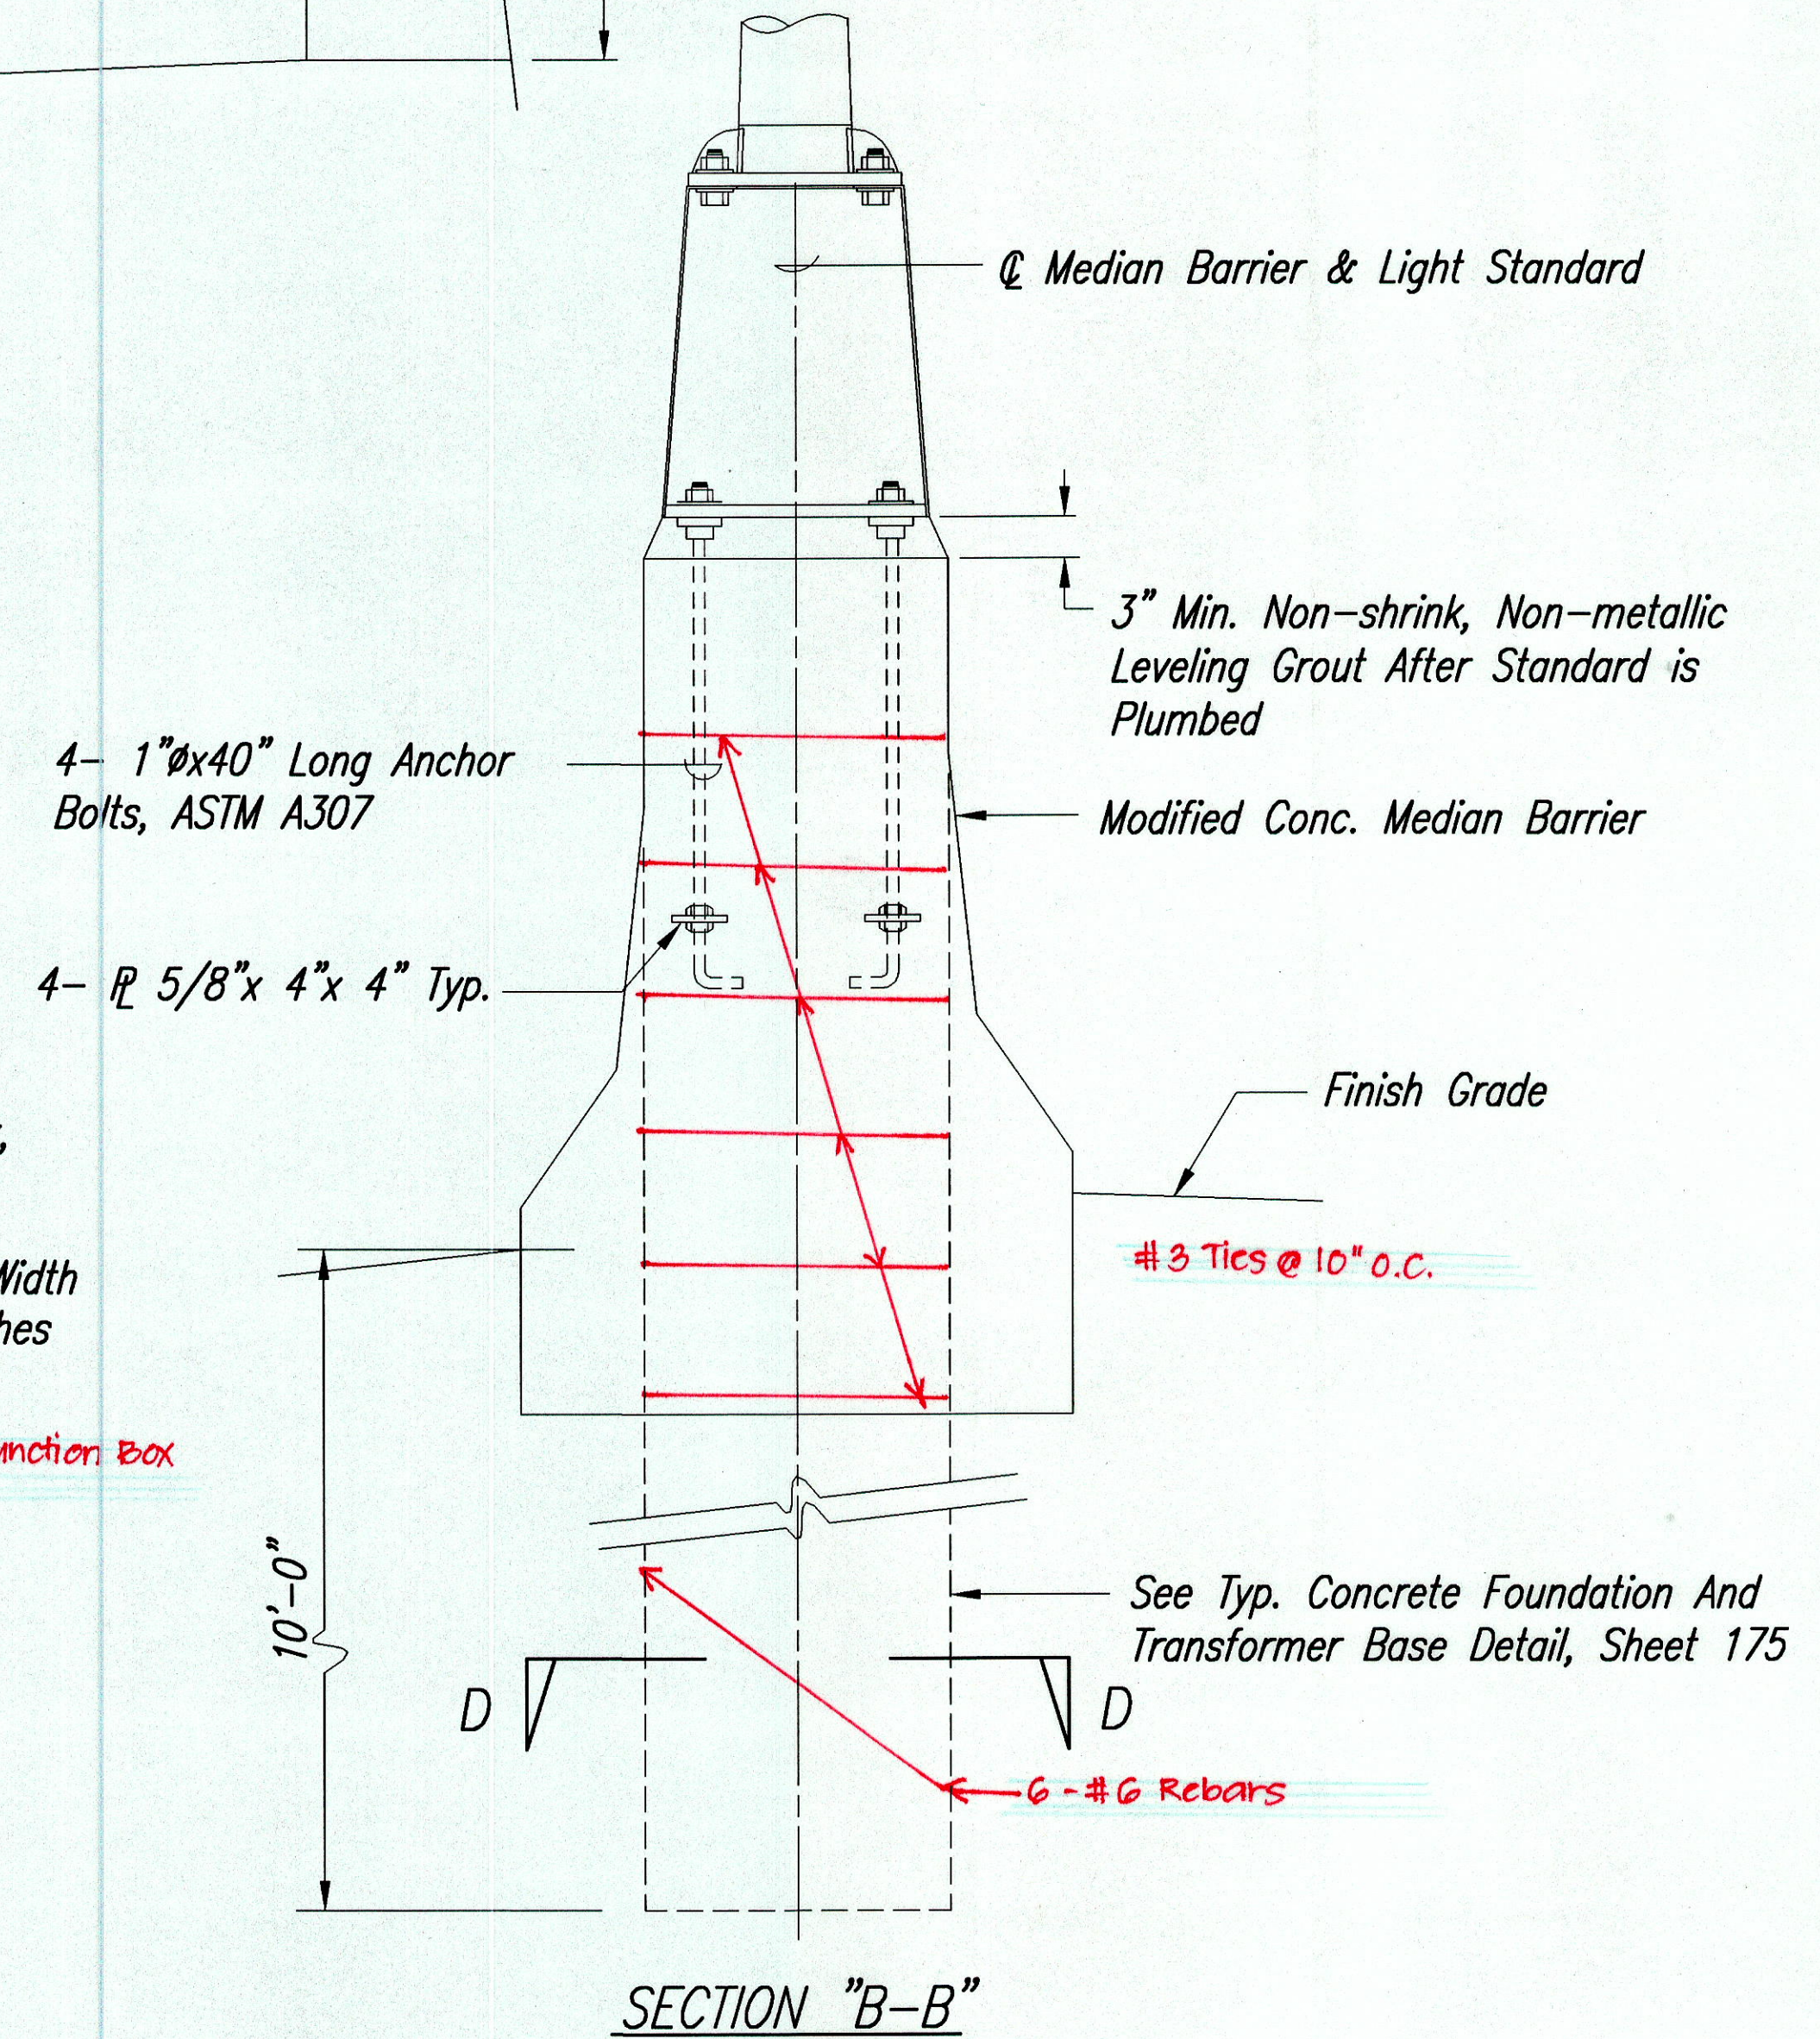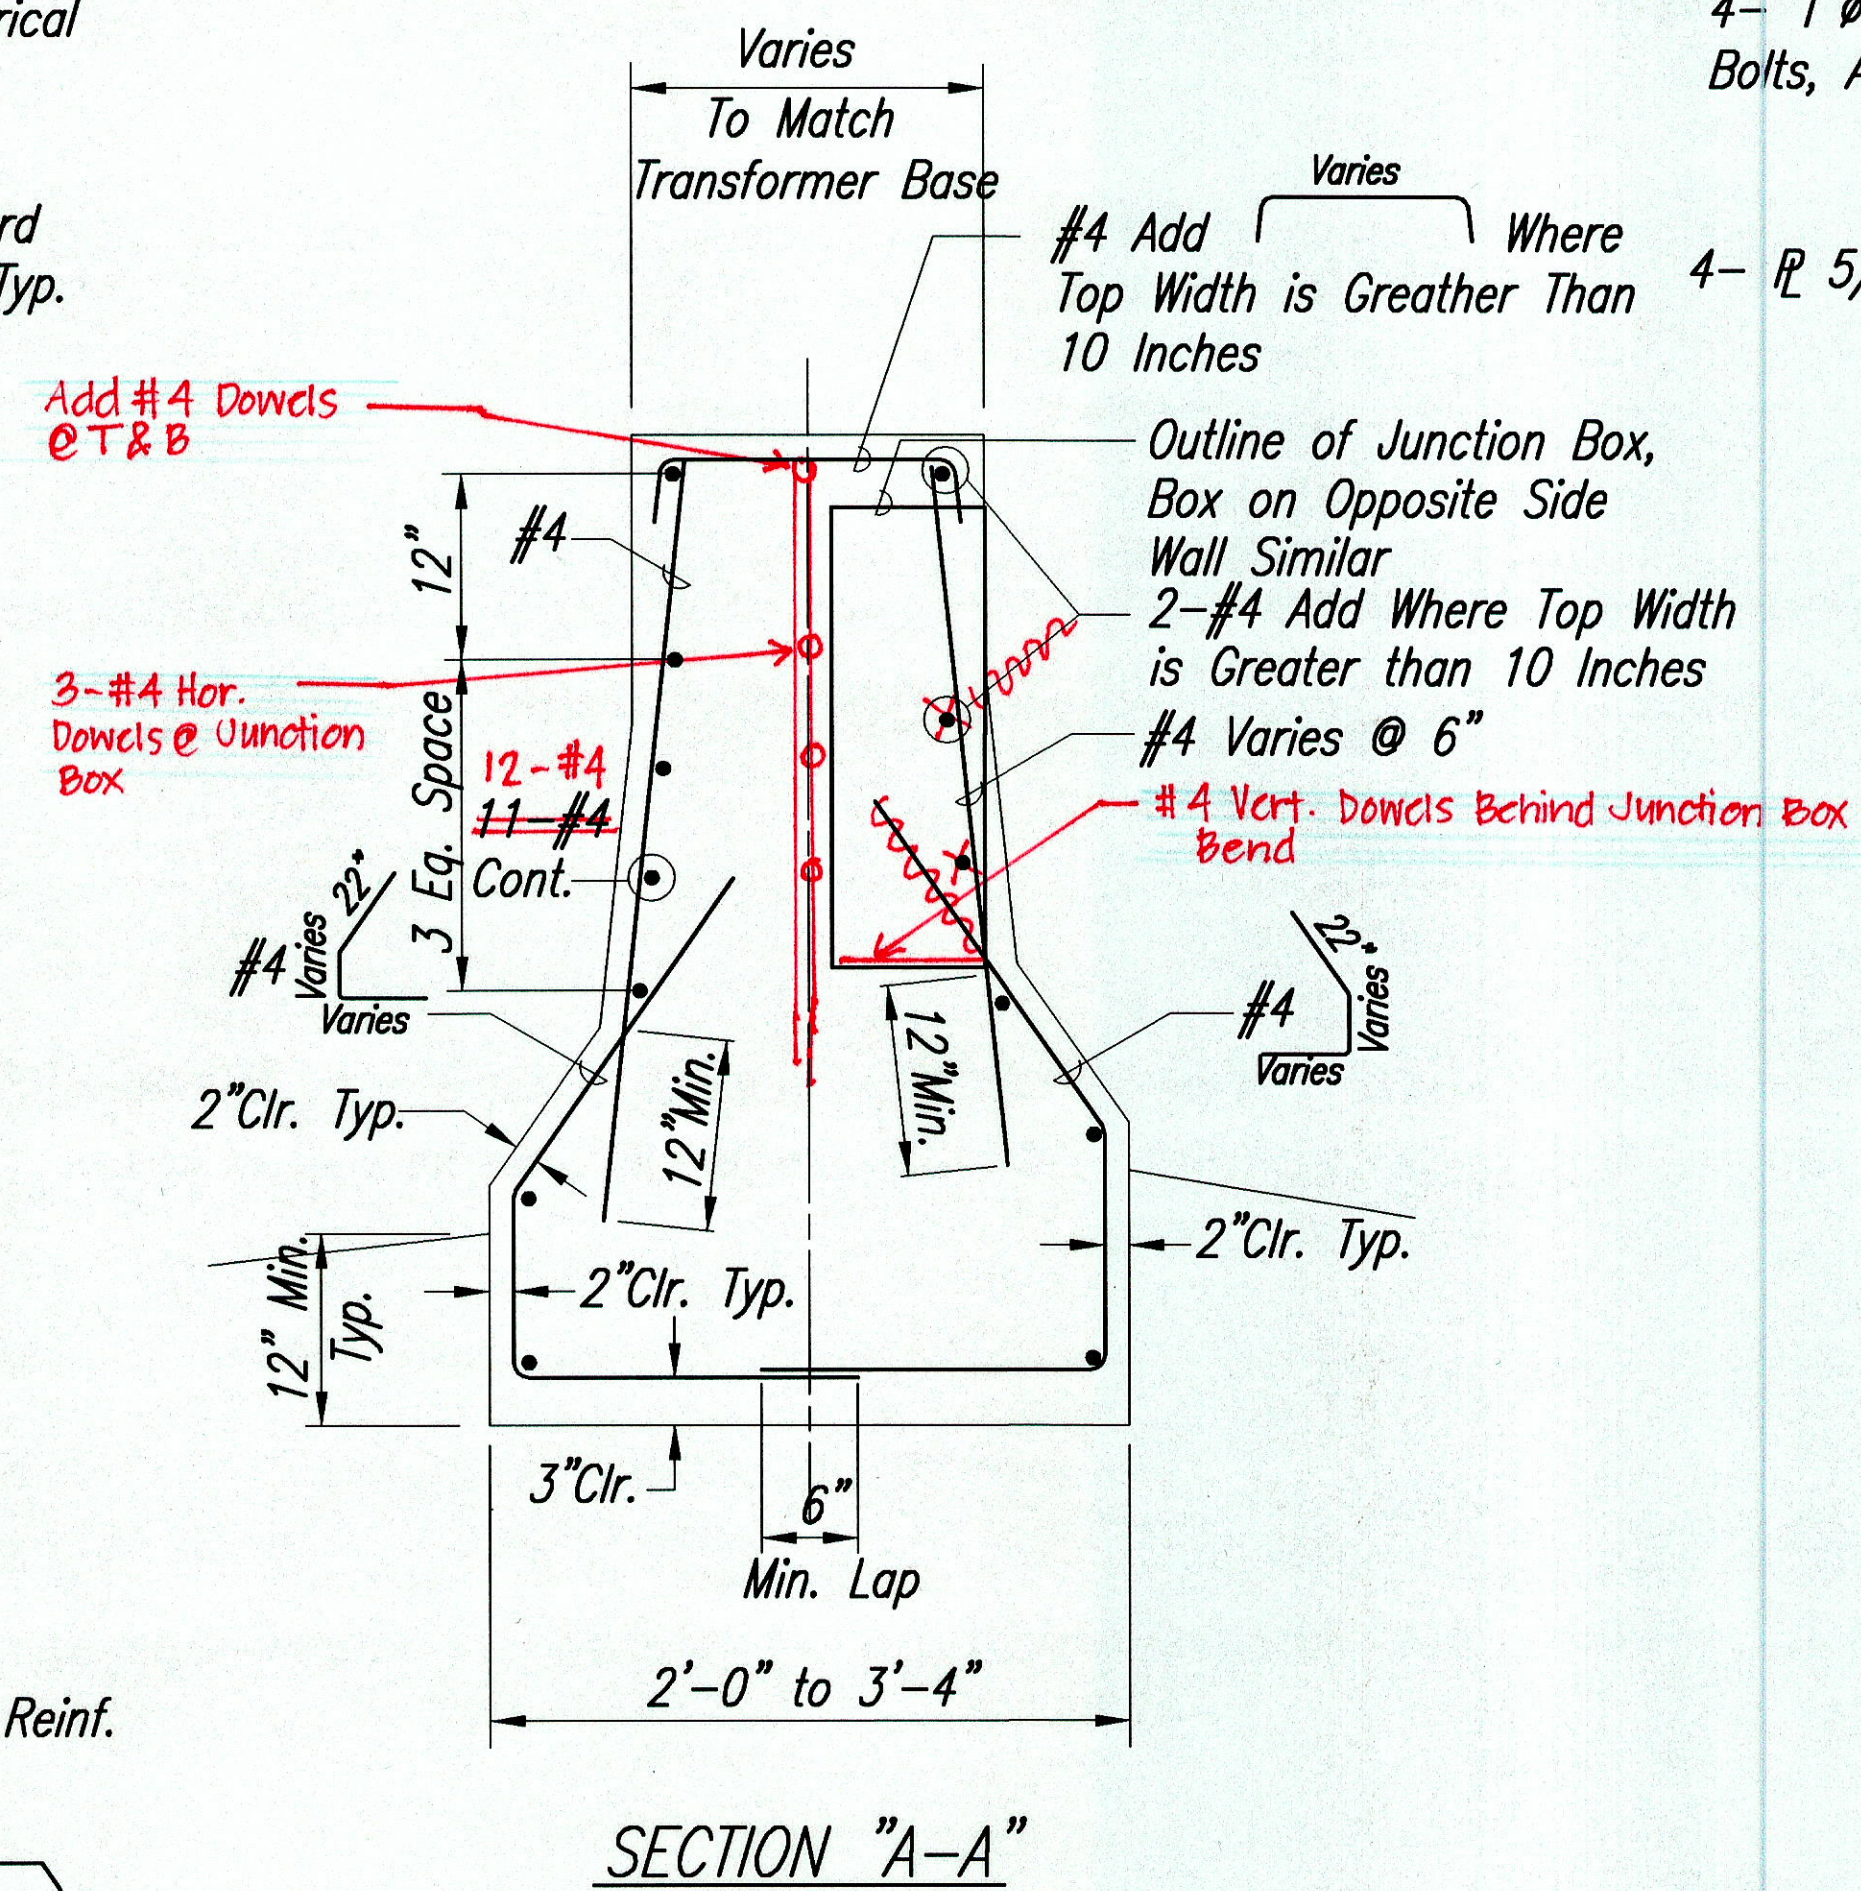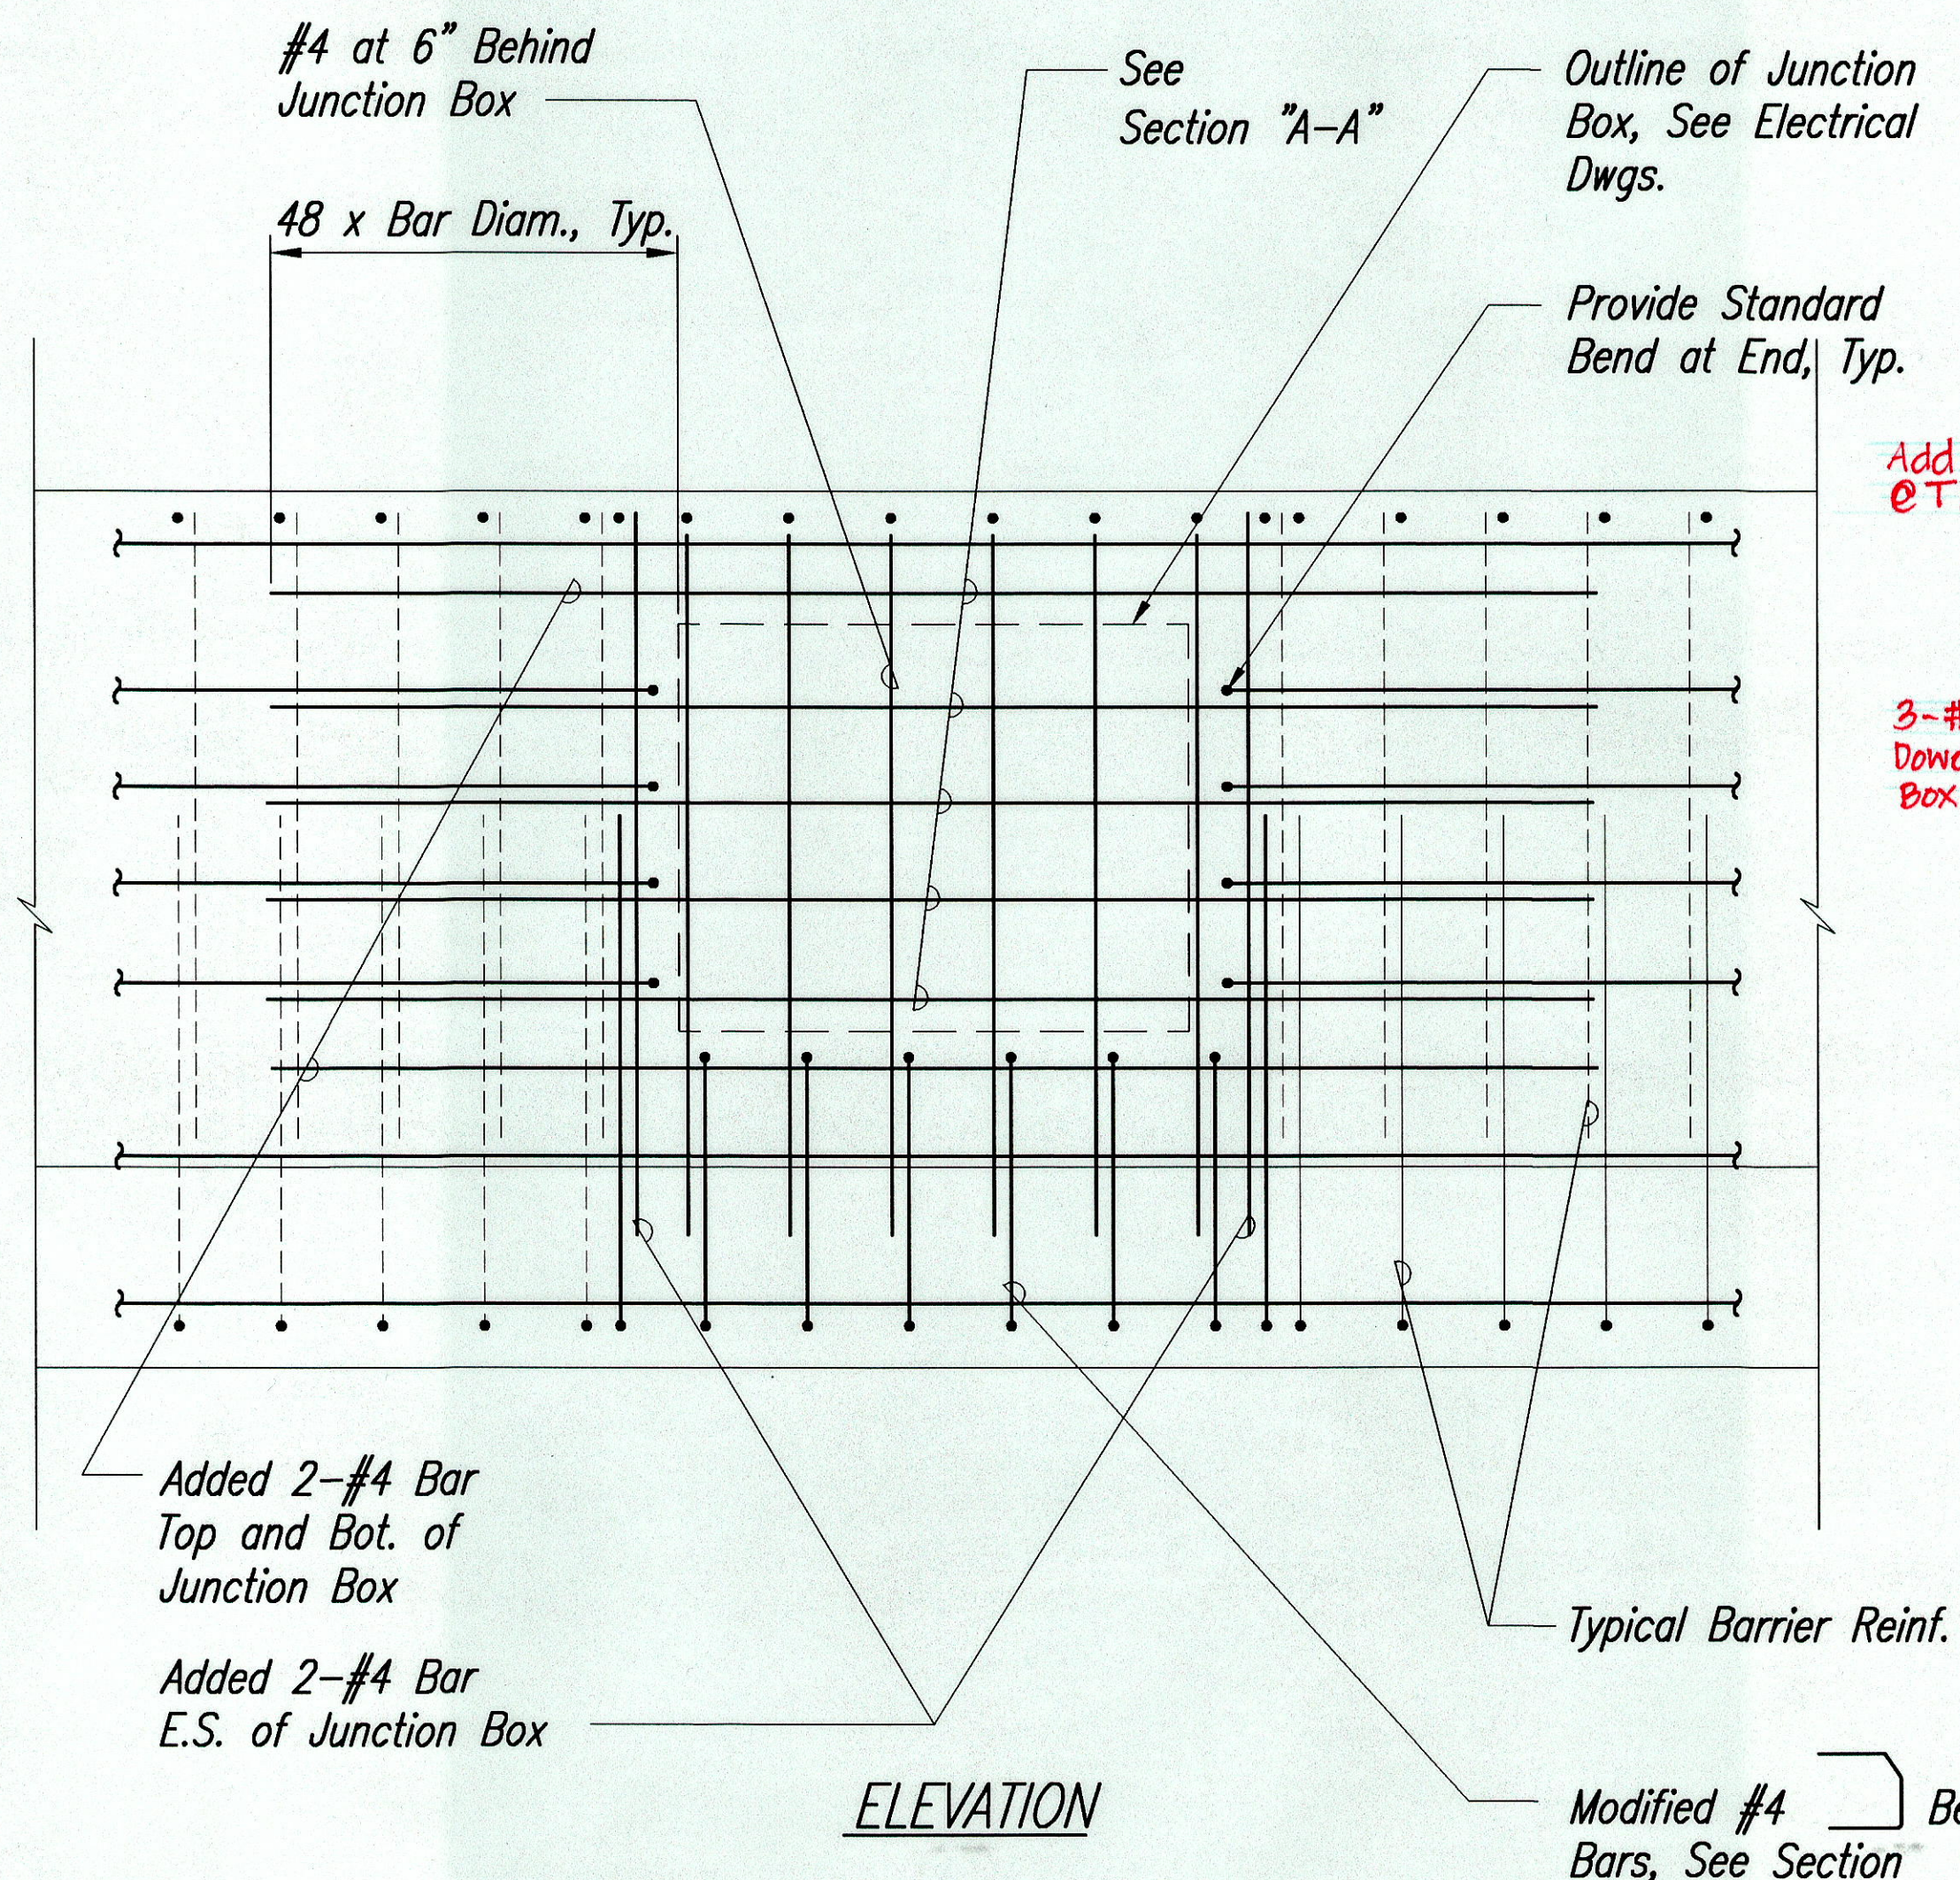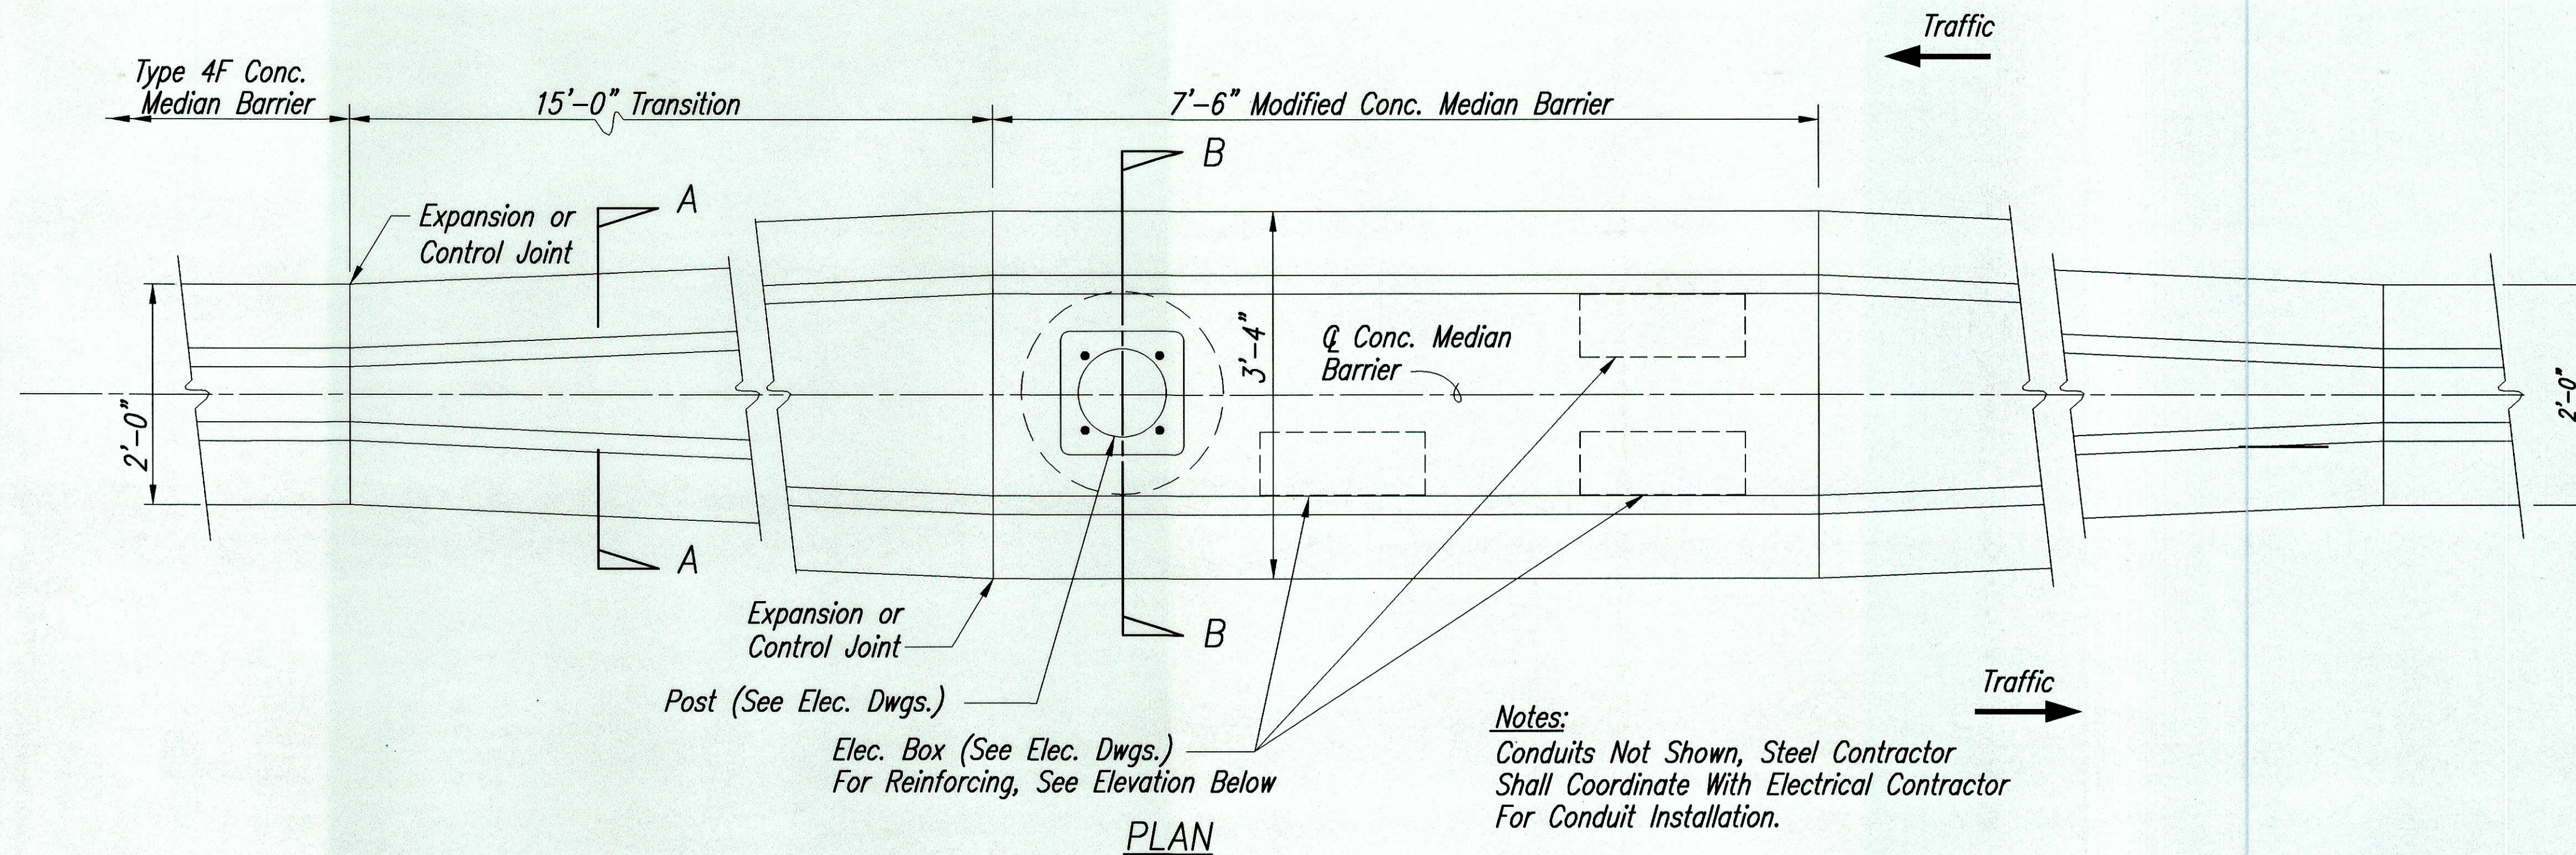

THIS WORK WAS PREPARED BY ME OR UNDER MY SUPERVISION.

C. Kim

STATE OF HAWAII
DEPARTMENT OF TRANSPORTATION
HIGHWAYS DIVISION

**MEDIAN BARRIER MODIFICATION
AT LIGHT POLE**

LIKELIKE HIGHWAY RESURFACING
Emmeline Place to the Wilson Tunnel
F. A. Project No. CM-STP-063-1(21)

Scale: As Noted Date: December, 2001


SHEET No. 23 OF 28 SHEETS

LIGHT STANDARD CONCRETE MEDIAN BARRIER MODIFICATION
Scale: 1"=1'-0"

"AS-BUILT"

ORIGINAL PLAN	DATE
SURVEY PLOTTED BY	
DRAWN BY	
DESIGNED BY	
QUANTITIES BY	
CHECKED BY	
No.	

FED. ROAD DIST. NO.	STATE	PROJ. NO.	FISCAL YEAR	SHEET NO.	TOTAL SHEETS
HAWAII	HAW.	CM-STP-063-1(21)	2002	178	187

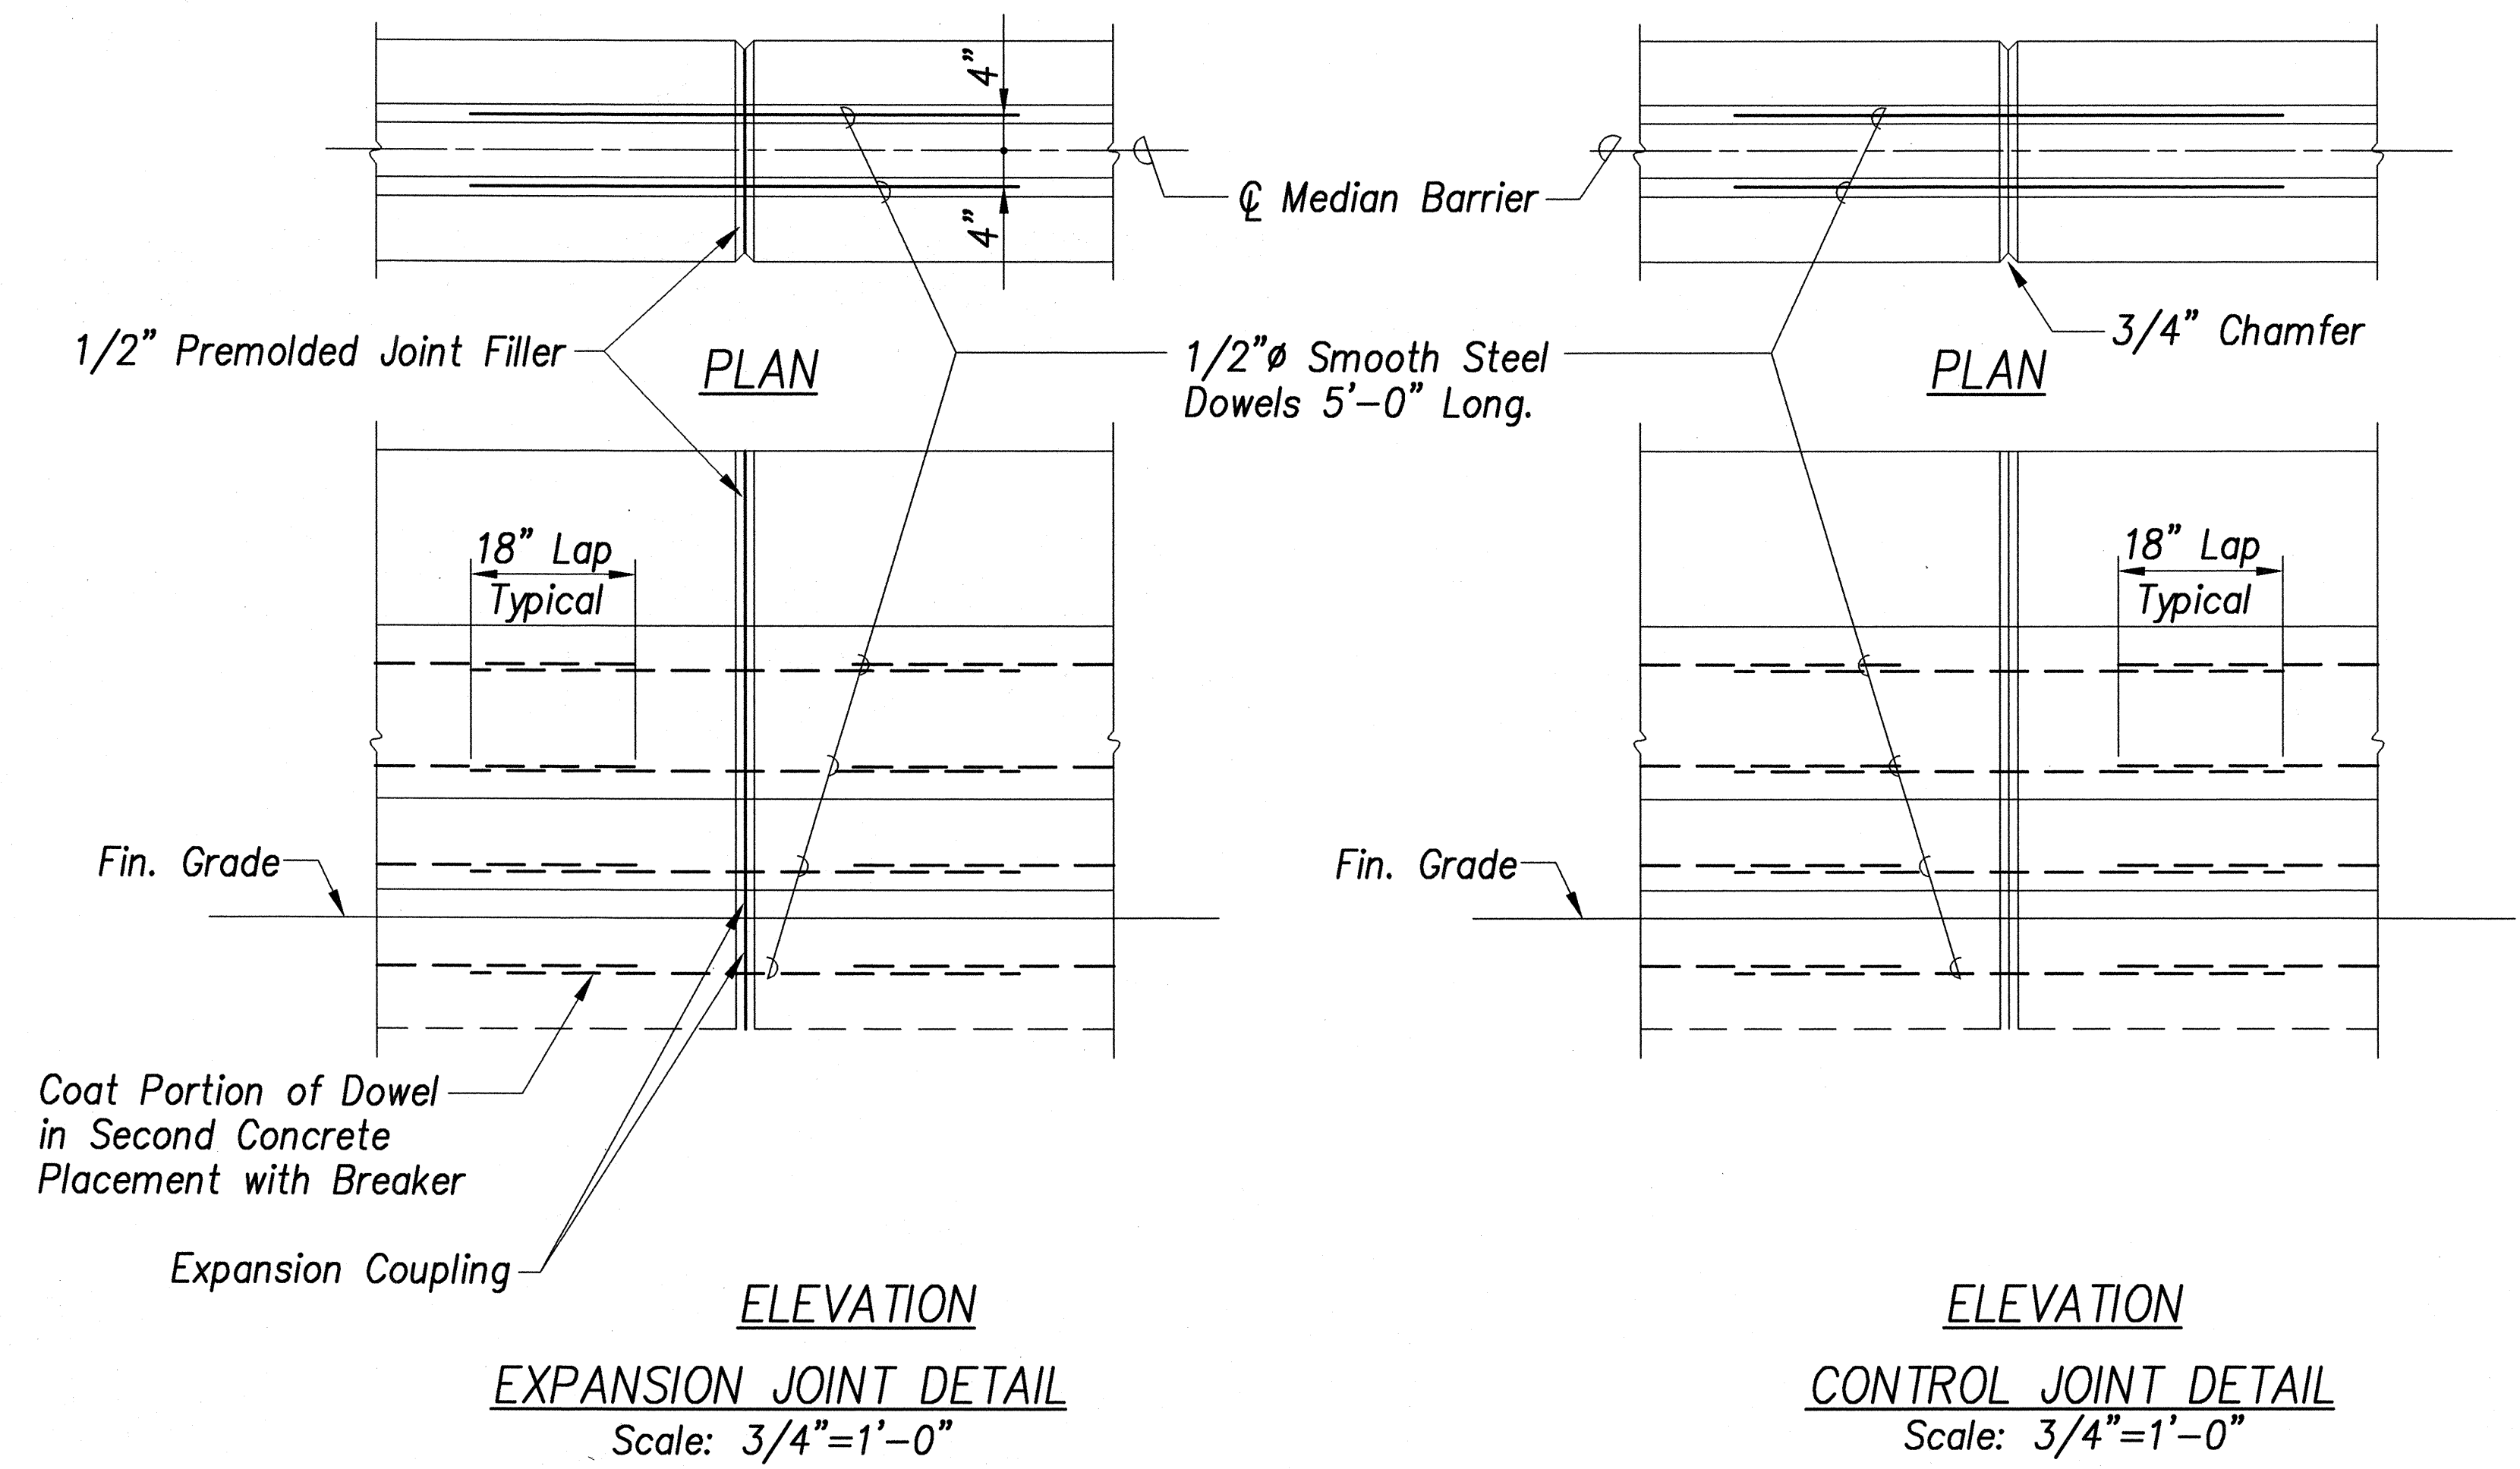

Note: See Notes On Sheet 177.

CONCRETE MEDIAN BARRIER MODIFICATION DETAILS AND NOTES
Scale: As Shown

ORIGINAL PLAN	SURVEY PLOTTED BY	DATE
NOTE BOOK	DRAWN BY	" "
No.	DESIGNED BY	" "
	CHECKED BY	" "




THIS WORK WAS PREPARED BY ME
OR UNDER MY SUPERVISION.


C. Kim

STATE OF HAWAII
DEPARTMENT OF TRANSPORTATION
HIGHWAYS DIVISION
MEDIAN BARRIER MODIFICATION
AT LIGHT POLE
LIKELIKE HIGHWAY RESURFACING
Emmeline Place to the Wilson Tunnel
F. A. Project No. CM-STP-063-1(21)
Scale: As Noted Date: December, 2001
SHEET No. 24 OF 28 SHEETS

FED. ROAD DIST. NO.	STATE	PROJ. NO.	FISCAL YEAR	SHEET NO.	TOTAL SHEETS
HAWAII	HAW.	CM-STP-063-1(21)	2001	182	187

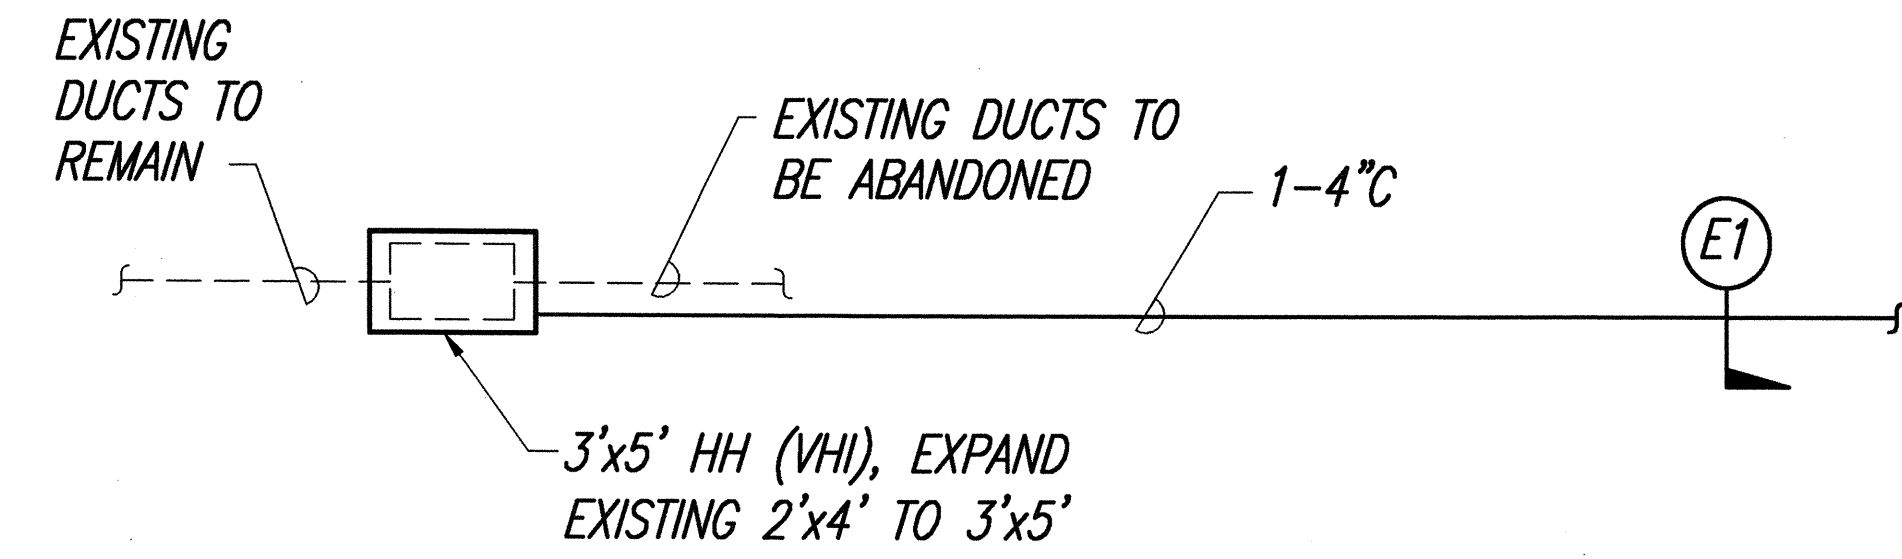


STA. 221+70

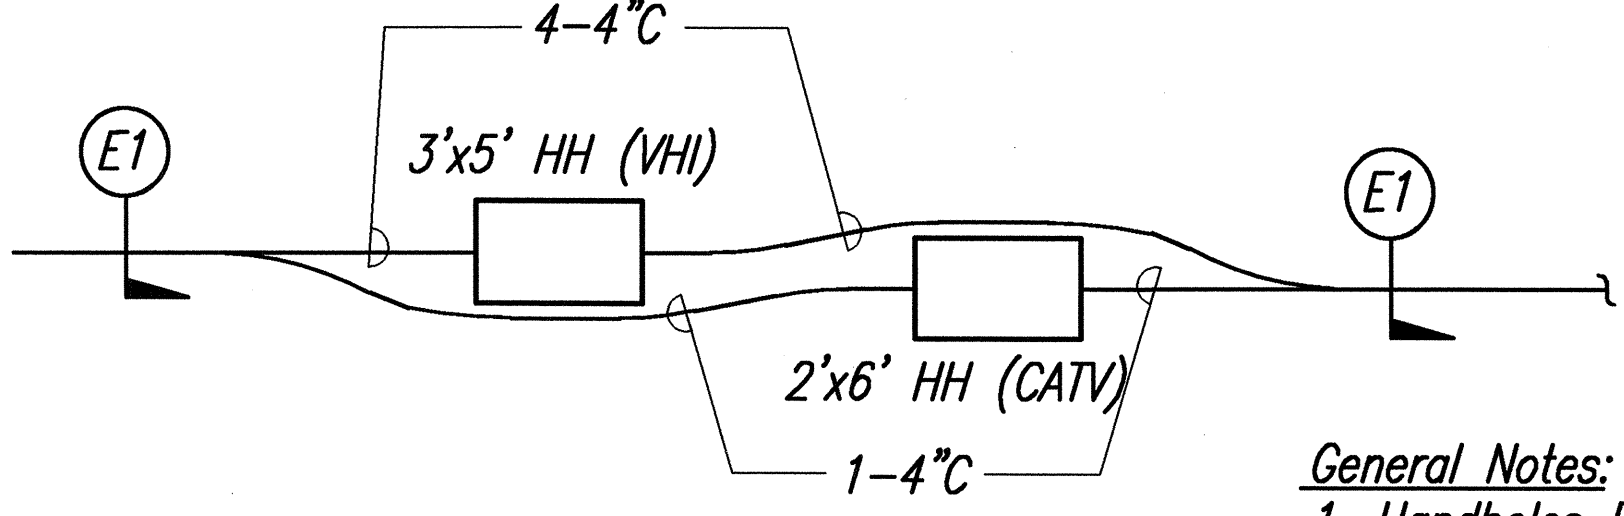


Note:
See Sta. 195+60.

STA. 229+00


General Notes:
1. Handholes For Verizon Hawaii And Oceanic Cable Shall Be 3'x5' and For Oceanic Cable Shall be 2'x6', With Traffic Bearing Cover And Spaced Approximately 500-Ft. On Center.

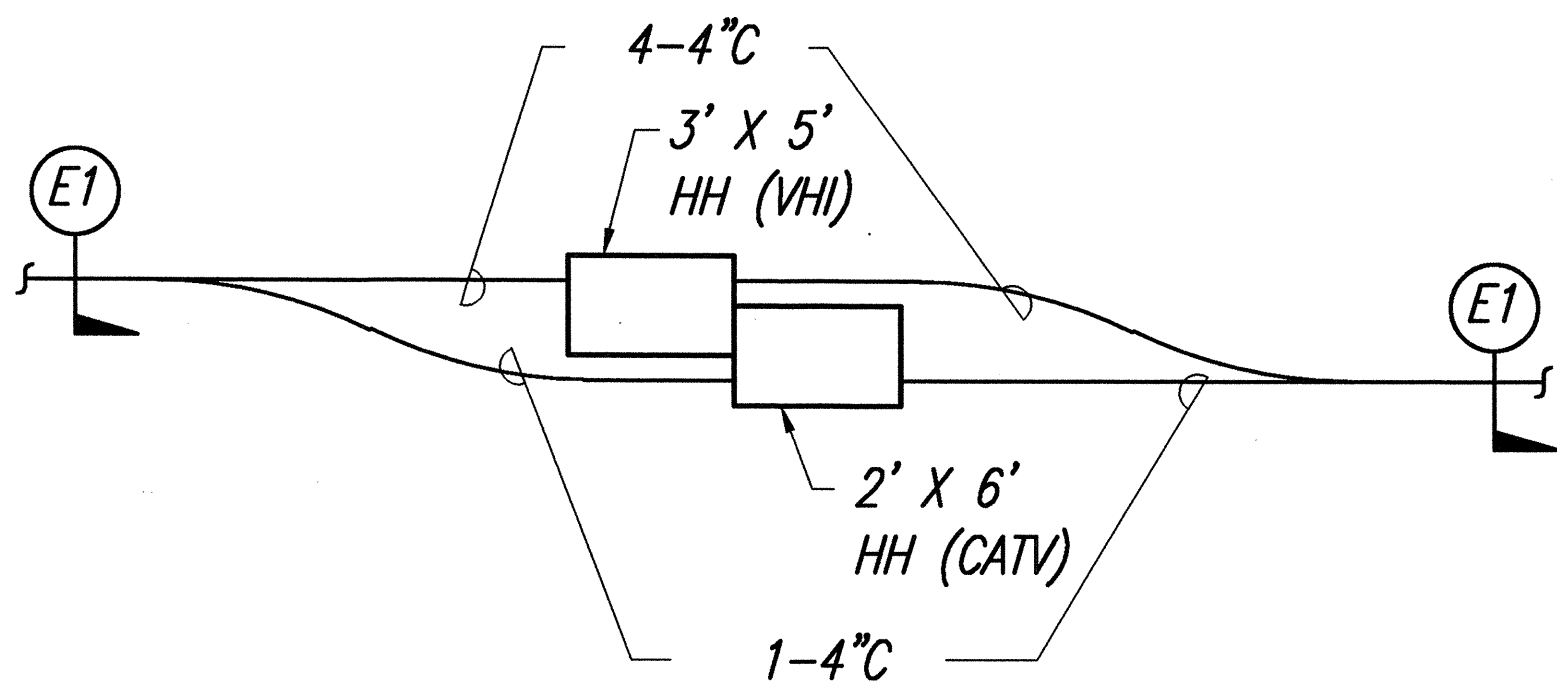


STA. 225+60
STA. 233+00± SIMILAR
STA. 236+20± SIMILAR

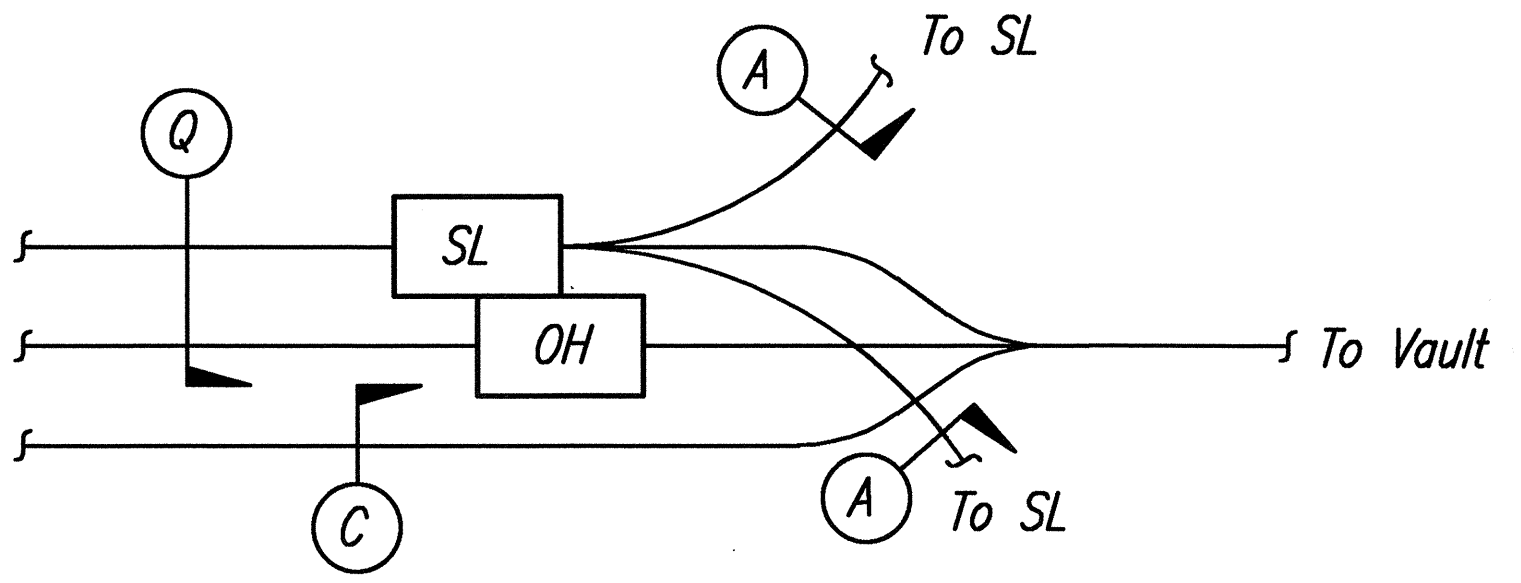

STA. 238+25

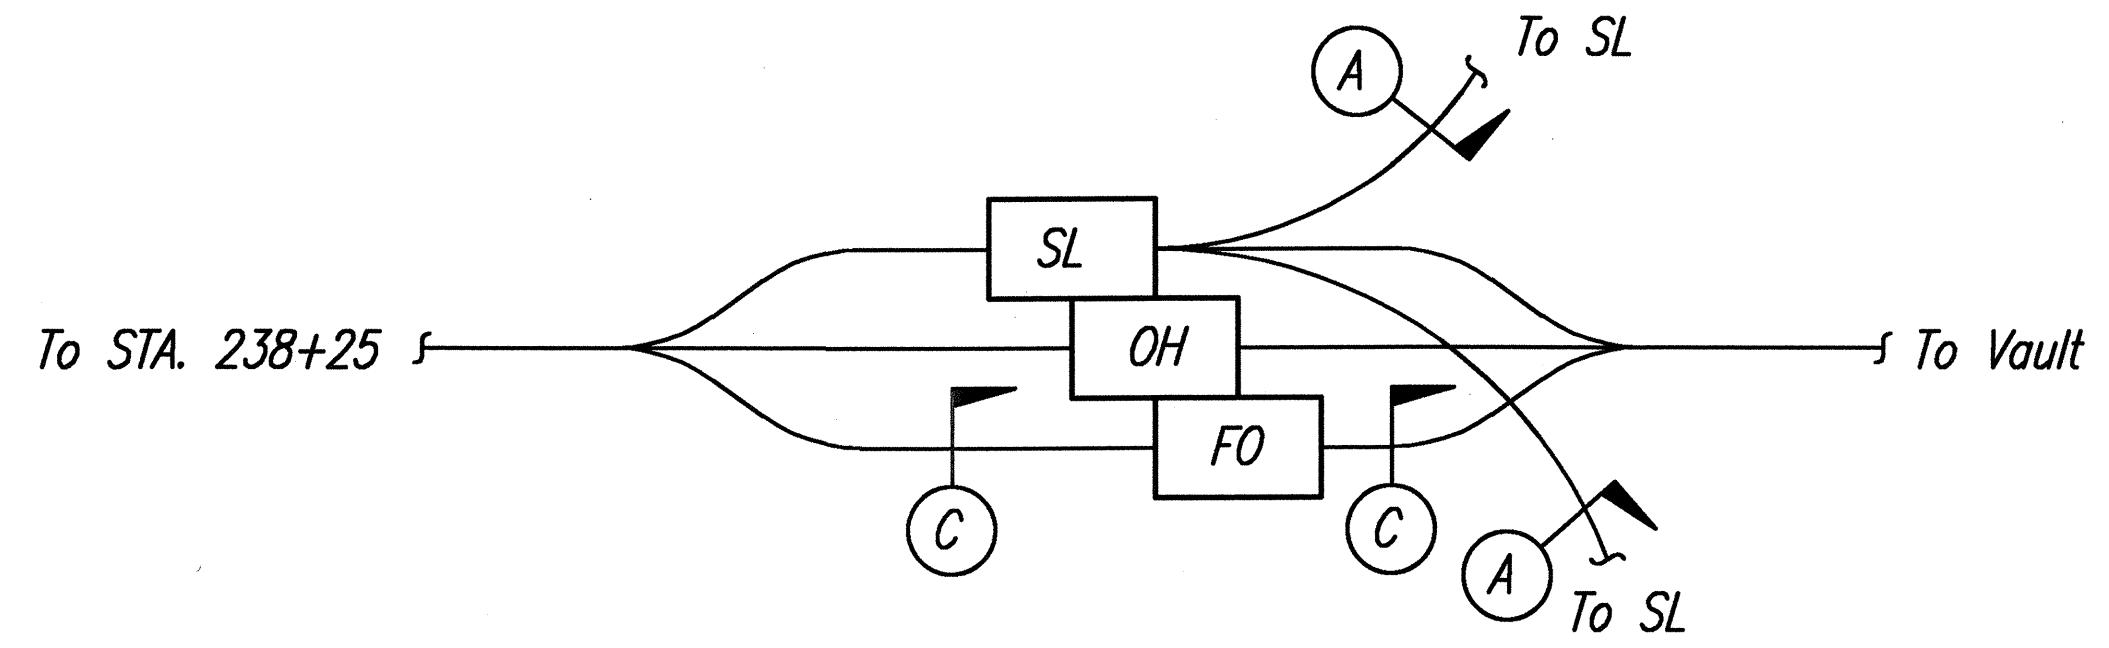

STA. 240+00

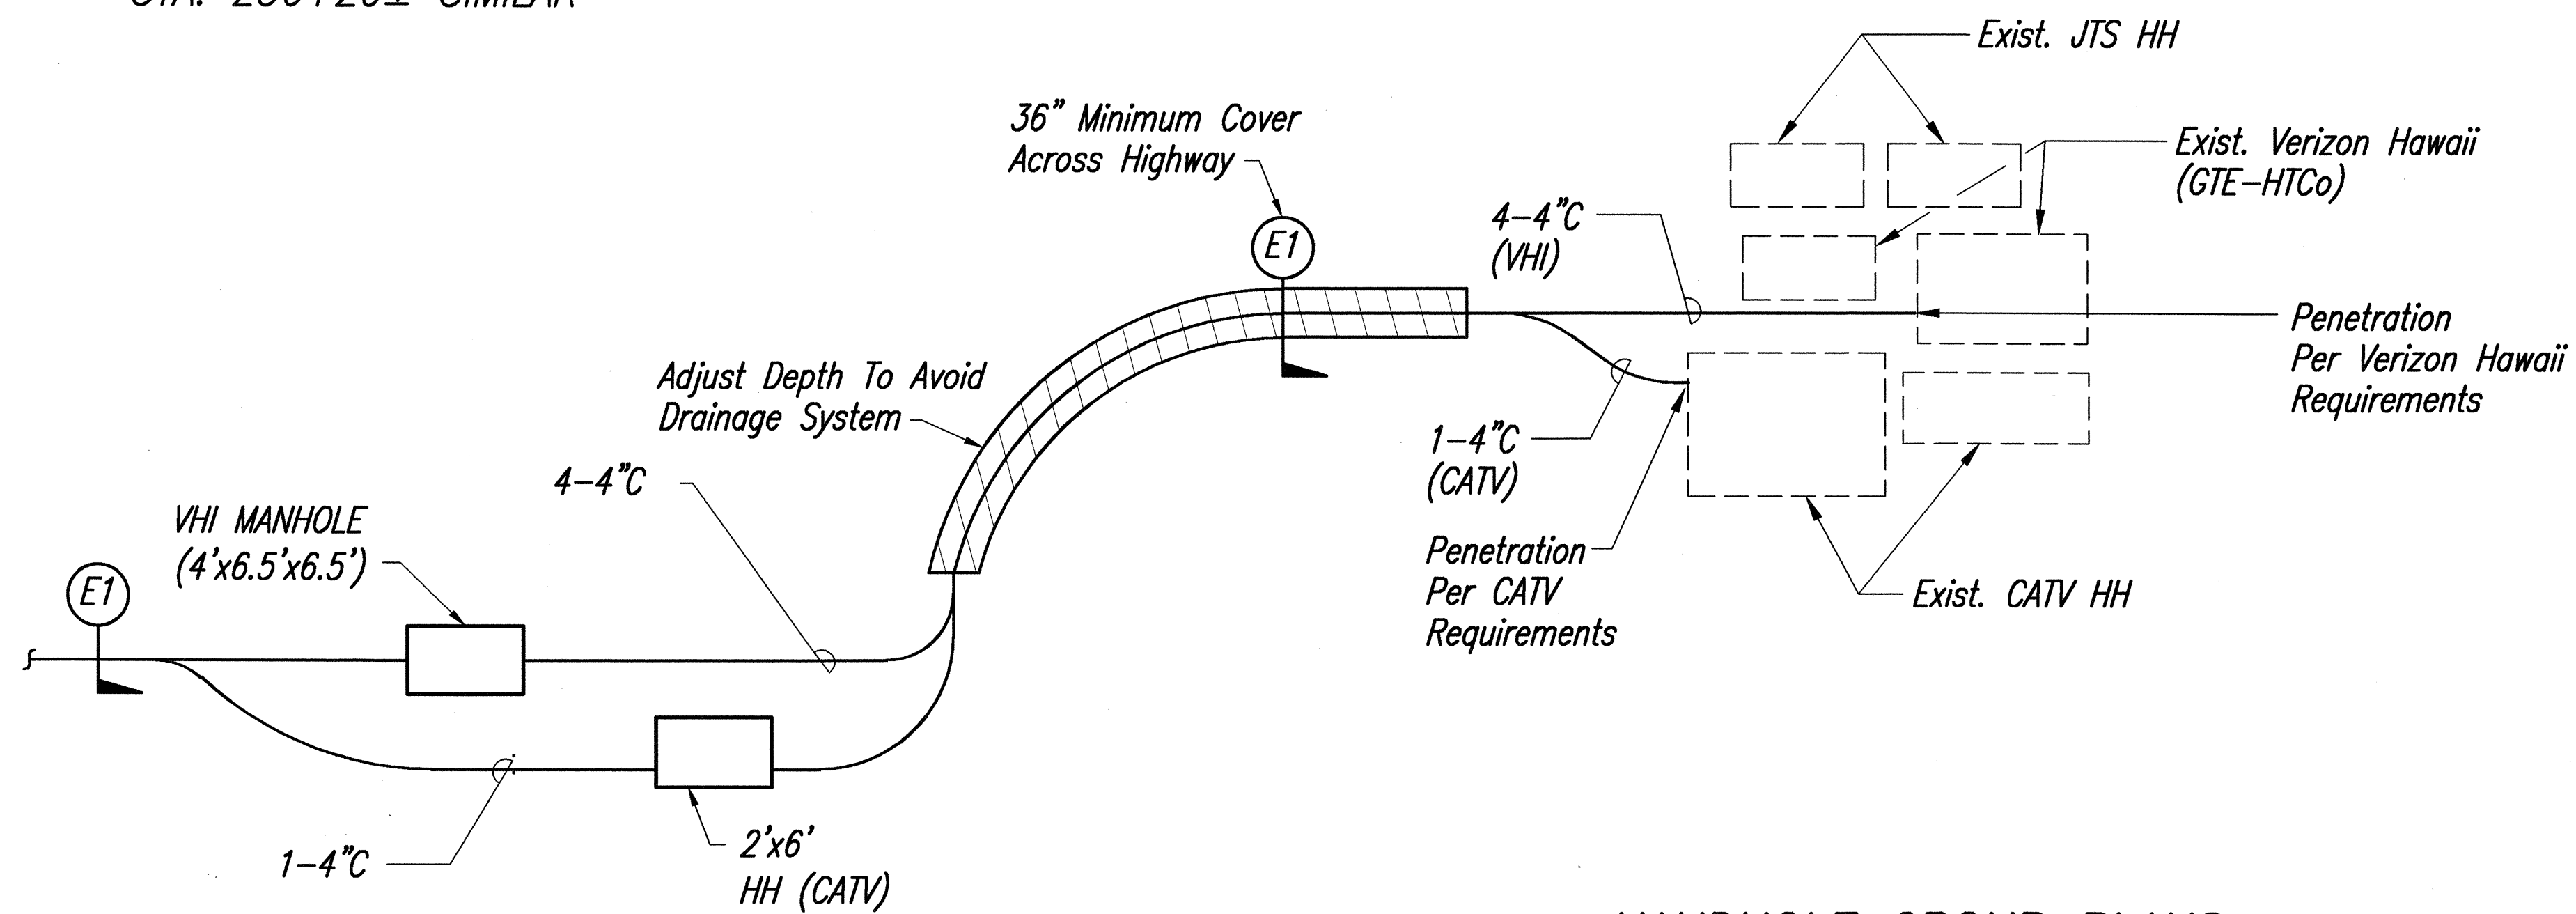

HANDHOLE GROUP PLANS
Not to Scale

STA. 240+50±

APPROVED:

[Signature] 12/10/01
 Verizon Hawaii, Inc. (GTE-HTCO) Date

[Signature] 12/12/01
 Oceanic Cable Date



THIS WORK WAS PREPARED BY ME OR UNDER MY SUPERVISION.

[Signature]

STATE OF HAWAII
 DEPARTMENT OF TRANSPORTATION
 HIGHWAYS DIVISION
HIGHWAY LIGHTING DETAILS
 LIKELIKE HIGHWAY RESURFACING
 Emmeline Place to the Wilson Tunnel
 F. A. Project No. CM-STP-063-1(21)
 Scale: As Shown Date: December, 2001
 SHEET No. 28 OF 28 SHEETS

182

ORIGINAL PLAN	SURVEY PLOTTED BY	DATE
NOTE BOOK	DRAWN BY	
	DESIGNED BY	
	QUANTITIES BY	
	CHECKED BY	