
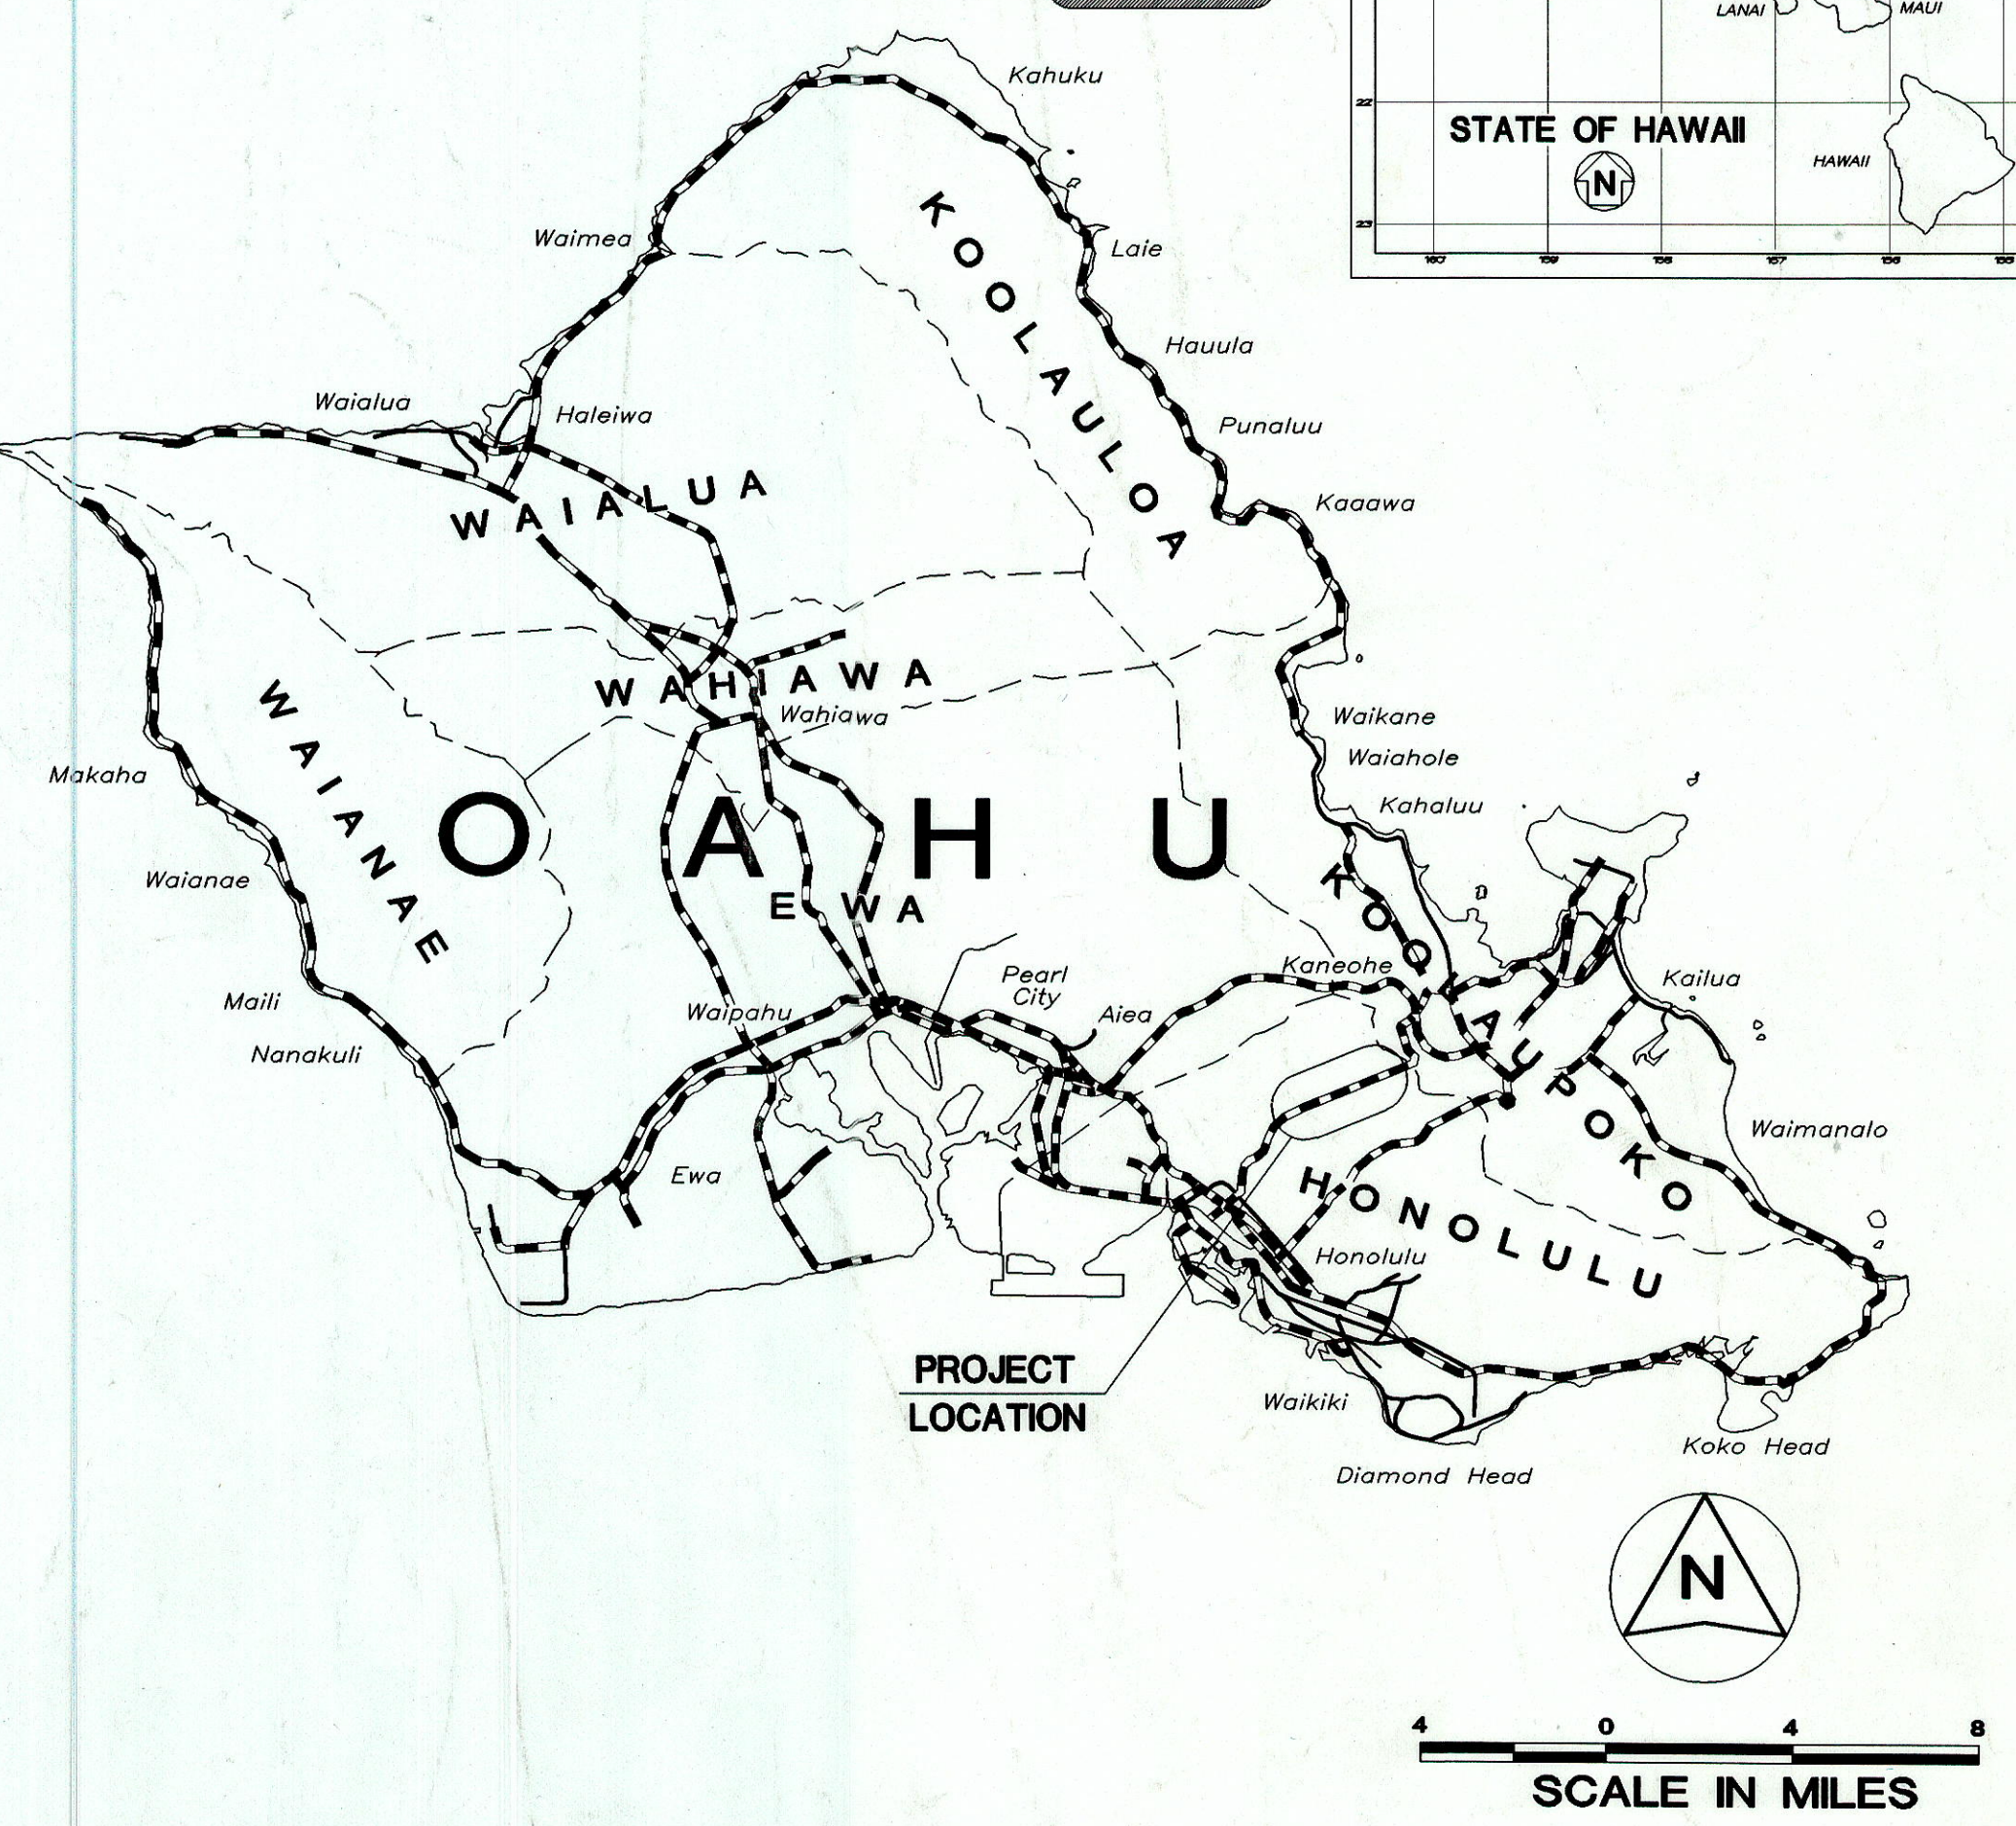
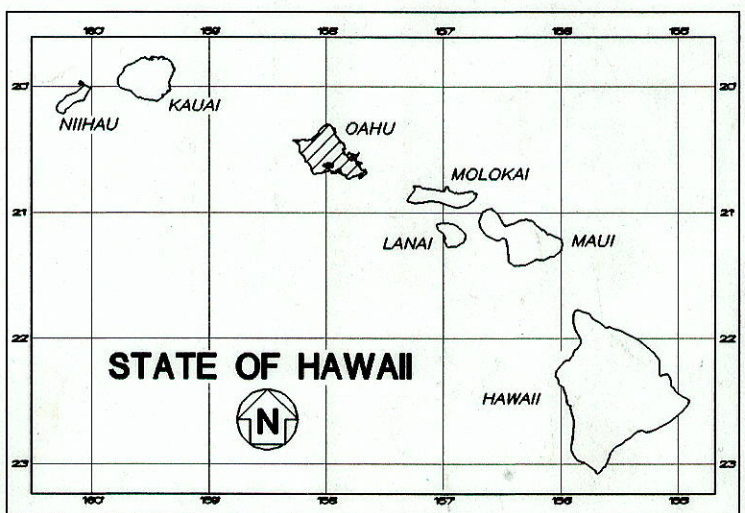



INDEX TO DRAWINGS	
SHEET NO.	DESCRIPTION
1	TITLE SHEET
2	STANDARD PLANS SUMMARY
3 - 5	GENERAL NOTES AND LEGEND
6 - 14	TYPICAL SECTIONS & DETAILS
15 - 22	DRAINAGE & GUARDRAIL DEMOLITION PLANS
23 - 37	ROADWAY PLAN & INBOUND PROFILES
38 - 45	OUTBOUND PROFILES
46 - 48	SUPERELEVATION DIAGRAMS
49 - 69	ROADWAY CROSS SECTIONS
70 - 71	SLOPE STABILIZATION
72 - 79	DRAINAGE PLANS & DETAILS
80	DRAINLINE PLAN & PROFILE
81 - 85	DRAINAGE DETAILS
86 - 95	UNDERDRAIN PLANS & DETAILS
96 - 114	GUARDRAIL DETAILS
115 - 123	RETAINING WALL NOTES, PLANS, & DETAILS
124 - 125	BORING LOGS
126 - 128	CONSTRUCTION PHASING PLANS
129 - 136	TRAFFIC CONTROL PLANS
137 - 149	SIGNAGE & PAVEMENT MARKING LEGEND, NOTES, SUMMARY, PLANS & DETAILS
150 - 153	EMERGENCY CALL BOX GRADING PLAN & DETAILS
154	GENERAL ELECTRICAL AND UTILITY NOTES
155 - 182	HIGHWAY LIGHTING NOTES, PLANS & DETAILS
183	SINGLE LINE DIAGRAMS
184 - 185	OVERHEIGHT DETECTOR DETAILS
186	PULLBOX AND COVER DETAILS
187	VERIZON/CATV DUCTLINE PROFILE

STATE OF HAWAII
DEPARTMENT OF TRANSPORTATION
HIGHWAYS DIVISION
HONOLULU, HAWAII
"AS-BUILT"
PLANS FOR
**LIKELIKE HIGHWAY
RESURFACING**
EMMELINE PLACE TO
WILSON TUNNEL
FED. AID PROJECT NO. CM-STP-063-1(21)
DISTRICT OF HONOLULU
ISLAND OF OAHU
TMK: 1-4-07, 08, 13, 17, 18, 19, 20, 22, & 24

FED. ROAD DIST. NO.	STATE	PROJ. NO.	FISCAL YEAR	SHEET NO.	TOTAL SHEETS
HAWAII	HAW.	CM-STP-063-1(21)	2002	1	187

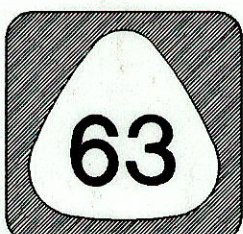

M & E Pacific, Inc. DESIGNED BY
Sue Lynn Chong P. S. & E. BY
587-2624 PHONE
December, 2001 DATE

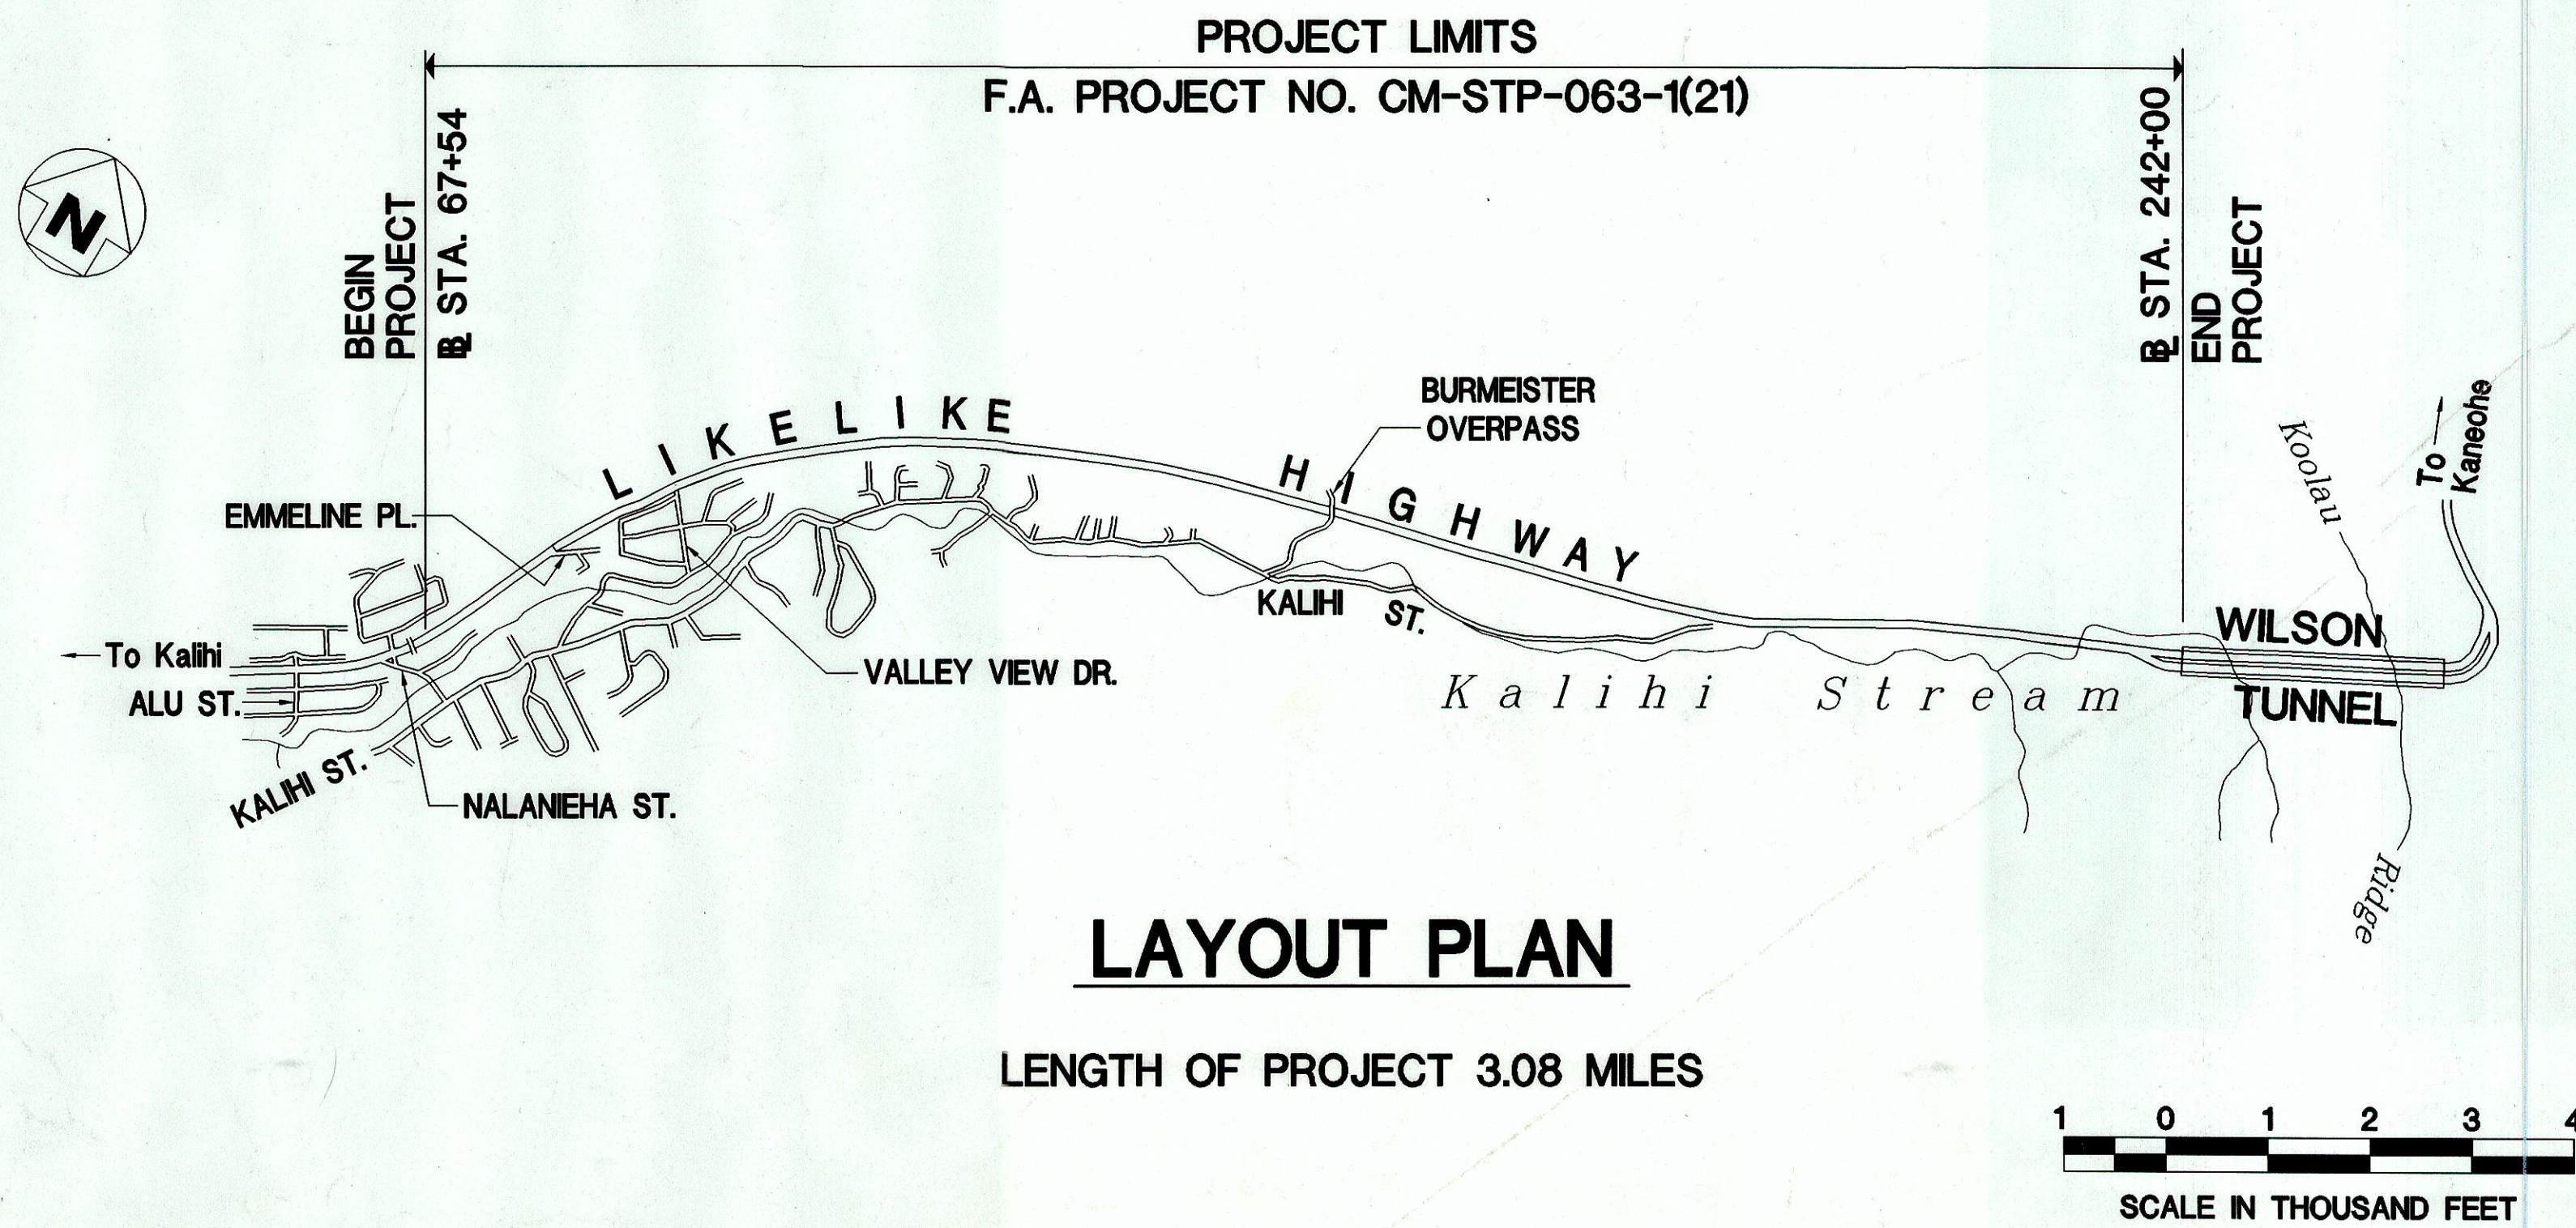

----- FEDERAL AID PROJECTS PREVIOUSLY CONSTRUCTED
OR UNDER CONSTRUCTION

MILE POST 2.67 TO MILE POST 5.75

DESIGN DESIGNATION

ADT (1999)	29,000
ADT (2009)	31,000
DHV	2,650
K DES	8.5
D DES	80/20
T DES	3.5
T 24	3.5
V	55/45/35 MPH

CHANGES MADE DURING CONSTRUCTION HAVE BEEN
INCORPORATED ON THESE PLANS EXCEPT CHANGES
IN THE ORIGINAL THEORETICAL QUANTITIES. FOR
ACTUAL QUANTITIES, REFER TO PROJECT LEDGER
AND/OR COMPUTATION BOOK.
Samuel M. [Signature] 4/23/14
RESIDENT ENGINEER DATE

DEPARTMENT OF TRANSPORTATION
STATE OF HAWAII
APPROVED:
[Signature] 12-13-01
DIR. OF TRANSPORTATION DATE