
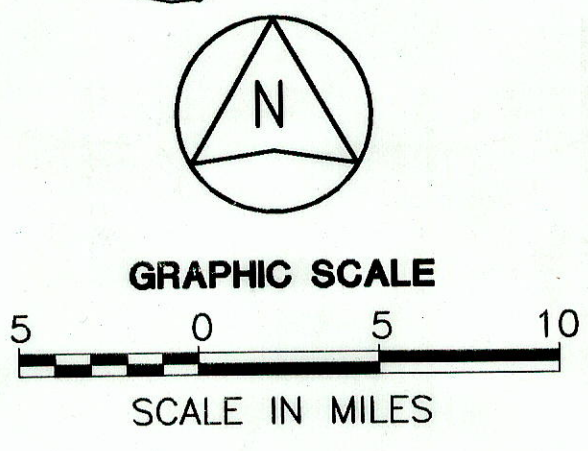
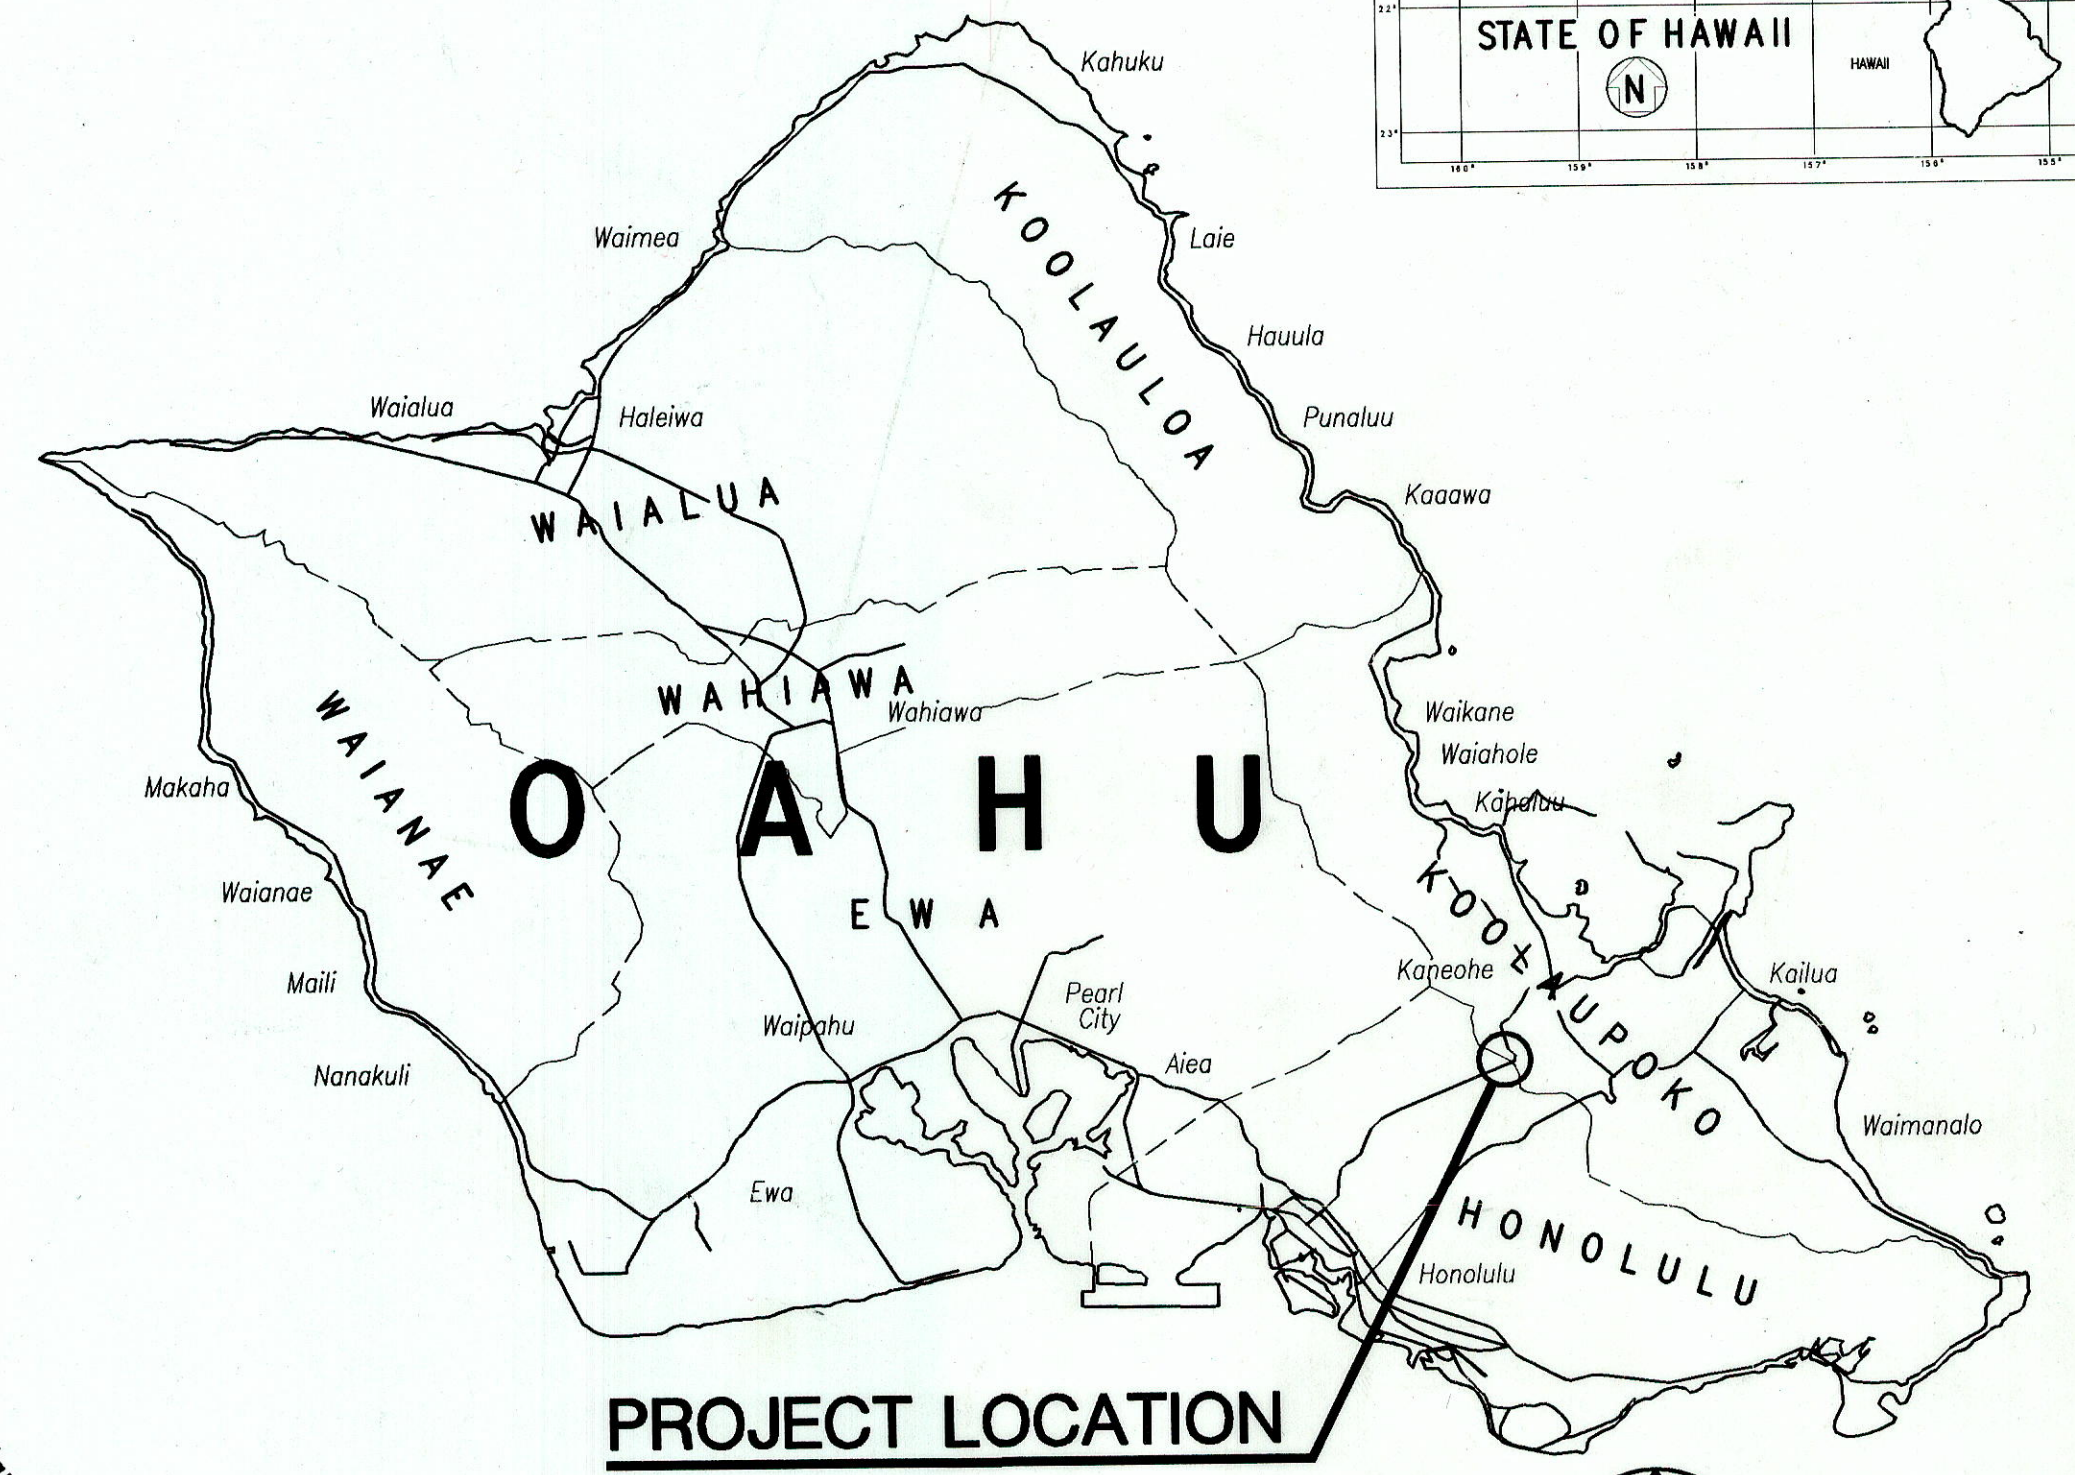
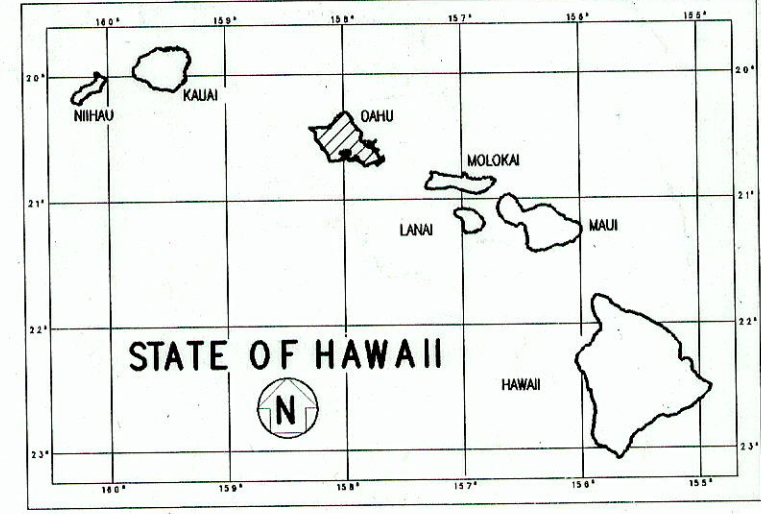


FED. ROAD DIST. NO.	STATE	FED. AID PROJ. NO.	FISCAL YEAR	SHEET NO.	TOTAL SHEETS
HAWAII	HAW.	STP-063-1(22)	2003	1	69

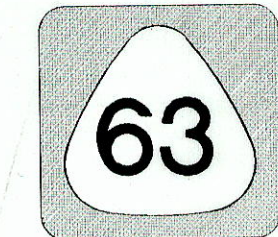

FEDERAL AID INTERSTATE PROJECTS PREVIOUSLY CONSTRUCTED OR UNDER CONSTRUCTION
MILE POST 5.75 TO MILE POST 6.28

DESIGN DESIGNATION

ADT (2002)	31,100
DESIGN ADT (2022)	35,500
DHV	3,550
D (DESIGN)	85/15
T (DESIGN)	1.5%
T24	2.0%
V	40 MPH


CHANGES MADE DURING CONSTRUCTION HAVE BEEN INCORPORATED ON THESE PLANS EXCEPT CHANGES IN THE ORIGINAL THEORETICAL QUANTITIES. FOR ACTUAL QUANTITIES, REFER TO PROJECT LEDGER AND/OR COMPUTATION BOOK.
Kelly Lee
RESIDENT ENGINEER
5/12/11
DATE

DEPARTMENT OF TRANSPORTATION
STATE OF HAWAII
APPROVED: *[Signature]* 4-28-03
DIR. OF TRANSPORTATION DATE



STATE OF HAWAII
DEPARTMENT OF TRANSPORTATION
HIGHWAYS DIVISION
HONOLULU, HAWAII
AS-BUILT
PLANS FOR
LIKELIKE HIGHWAY
WILSON TUNNEL IMPROVEMENTS
LEAK AND CRACK REMEDIATION
FEDERAL AID PROJECT NO. STP-063-1(22)
DISTRICTS OF HONOLULU AND KOOLAUPOKO
ISLAND OF OAHU

INDEX TO DRAWINGS	
SHEET NO.	DESCRIPTION
1	TITLE SHEET
2	STANDARD PLANS SUMMARY
3-7	NOTES, LEGEND AND ABBREVIATIONS
8	GENERAL PLAN
9	TYPICAL SECTIONS
10-16 (a)	PLANS
17-23	DETAILS
24-25 (d)	SIGNING AND STRIPING PLAN
26-27	EROSION CONTROL MEASURES
28-30	TRAFFIC CONTROL PLANS
31-34	KANEOHE TUNNEL ELEVATIONS
35-38	KALIHI TUNNEL ELEVATIONS
39	SECTIONS
40-42	DETAILED ELEVATIONS
43	DETAILS
44	MECHANICAL LEGEND, ABBREVIATION, EQUIPMENT SCHEDULE, AND NOTES
45	MECHANICAL DEMOLITION PLAN
46	MECHANICAL PLAN
47	MECHANICAL SECTION
48	GENERAL ELECTRICAL NOTES & ELECTRICAL SYMBOLS
49	STREET LIGHT NOTES
50-52	ELECTRICAL DEMOLITION PLAN
53-55	ELECTRICAL PLAN
56	EXISTING ELECTRICAL EQUIPMENT ELEVATIONS
57-58	DEMOLITION ONE-LINE DIAGRAM
59-60	ONE-LINE DIAGRAM
61	STREET LIGHT POLE DETAILS
62	STREET LIGHT CONNECTION DIAGRAMS
63-64 (b)	TRAFFIC SIGNAL DETAILS
65-69 (c)	STRUCTURAL DETAILS

PLAN SHEET NOS.
(a) C.O. 16S-1, **(b)** C.O. 64S-1 to C.O. 64S-5,
(c) C.O. 69S-1 to C.O. 69S-6, and
(d) C.O. 25S-1 to C.O. 25S-2
Are Supplemental Plan Sheets to this Project.
Total Sheet Count After AS-BUILT Posting is 83 Sheets.

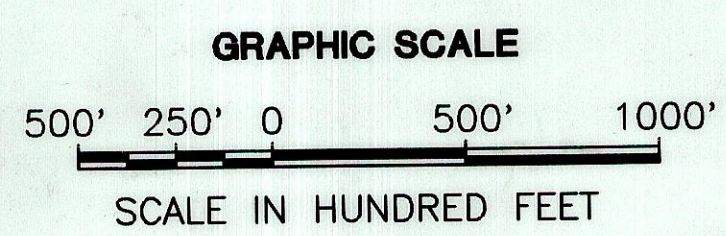

LAYOUT PLAN
Scale: 1"=500'
NET LENGTH OF PROJECT - 0.66 MILES
GROSS LENGTH OF PROJECT - 0.66 MILES

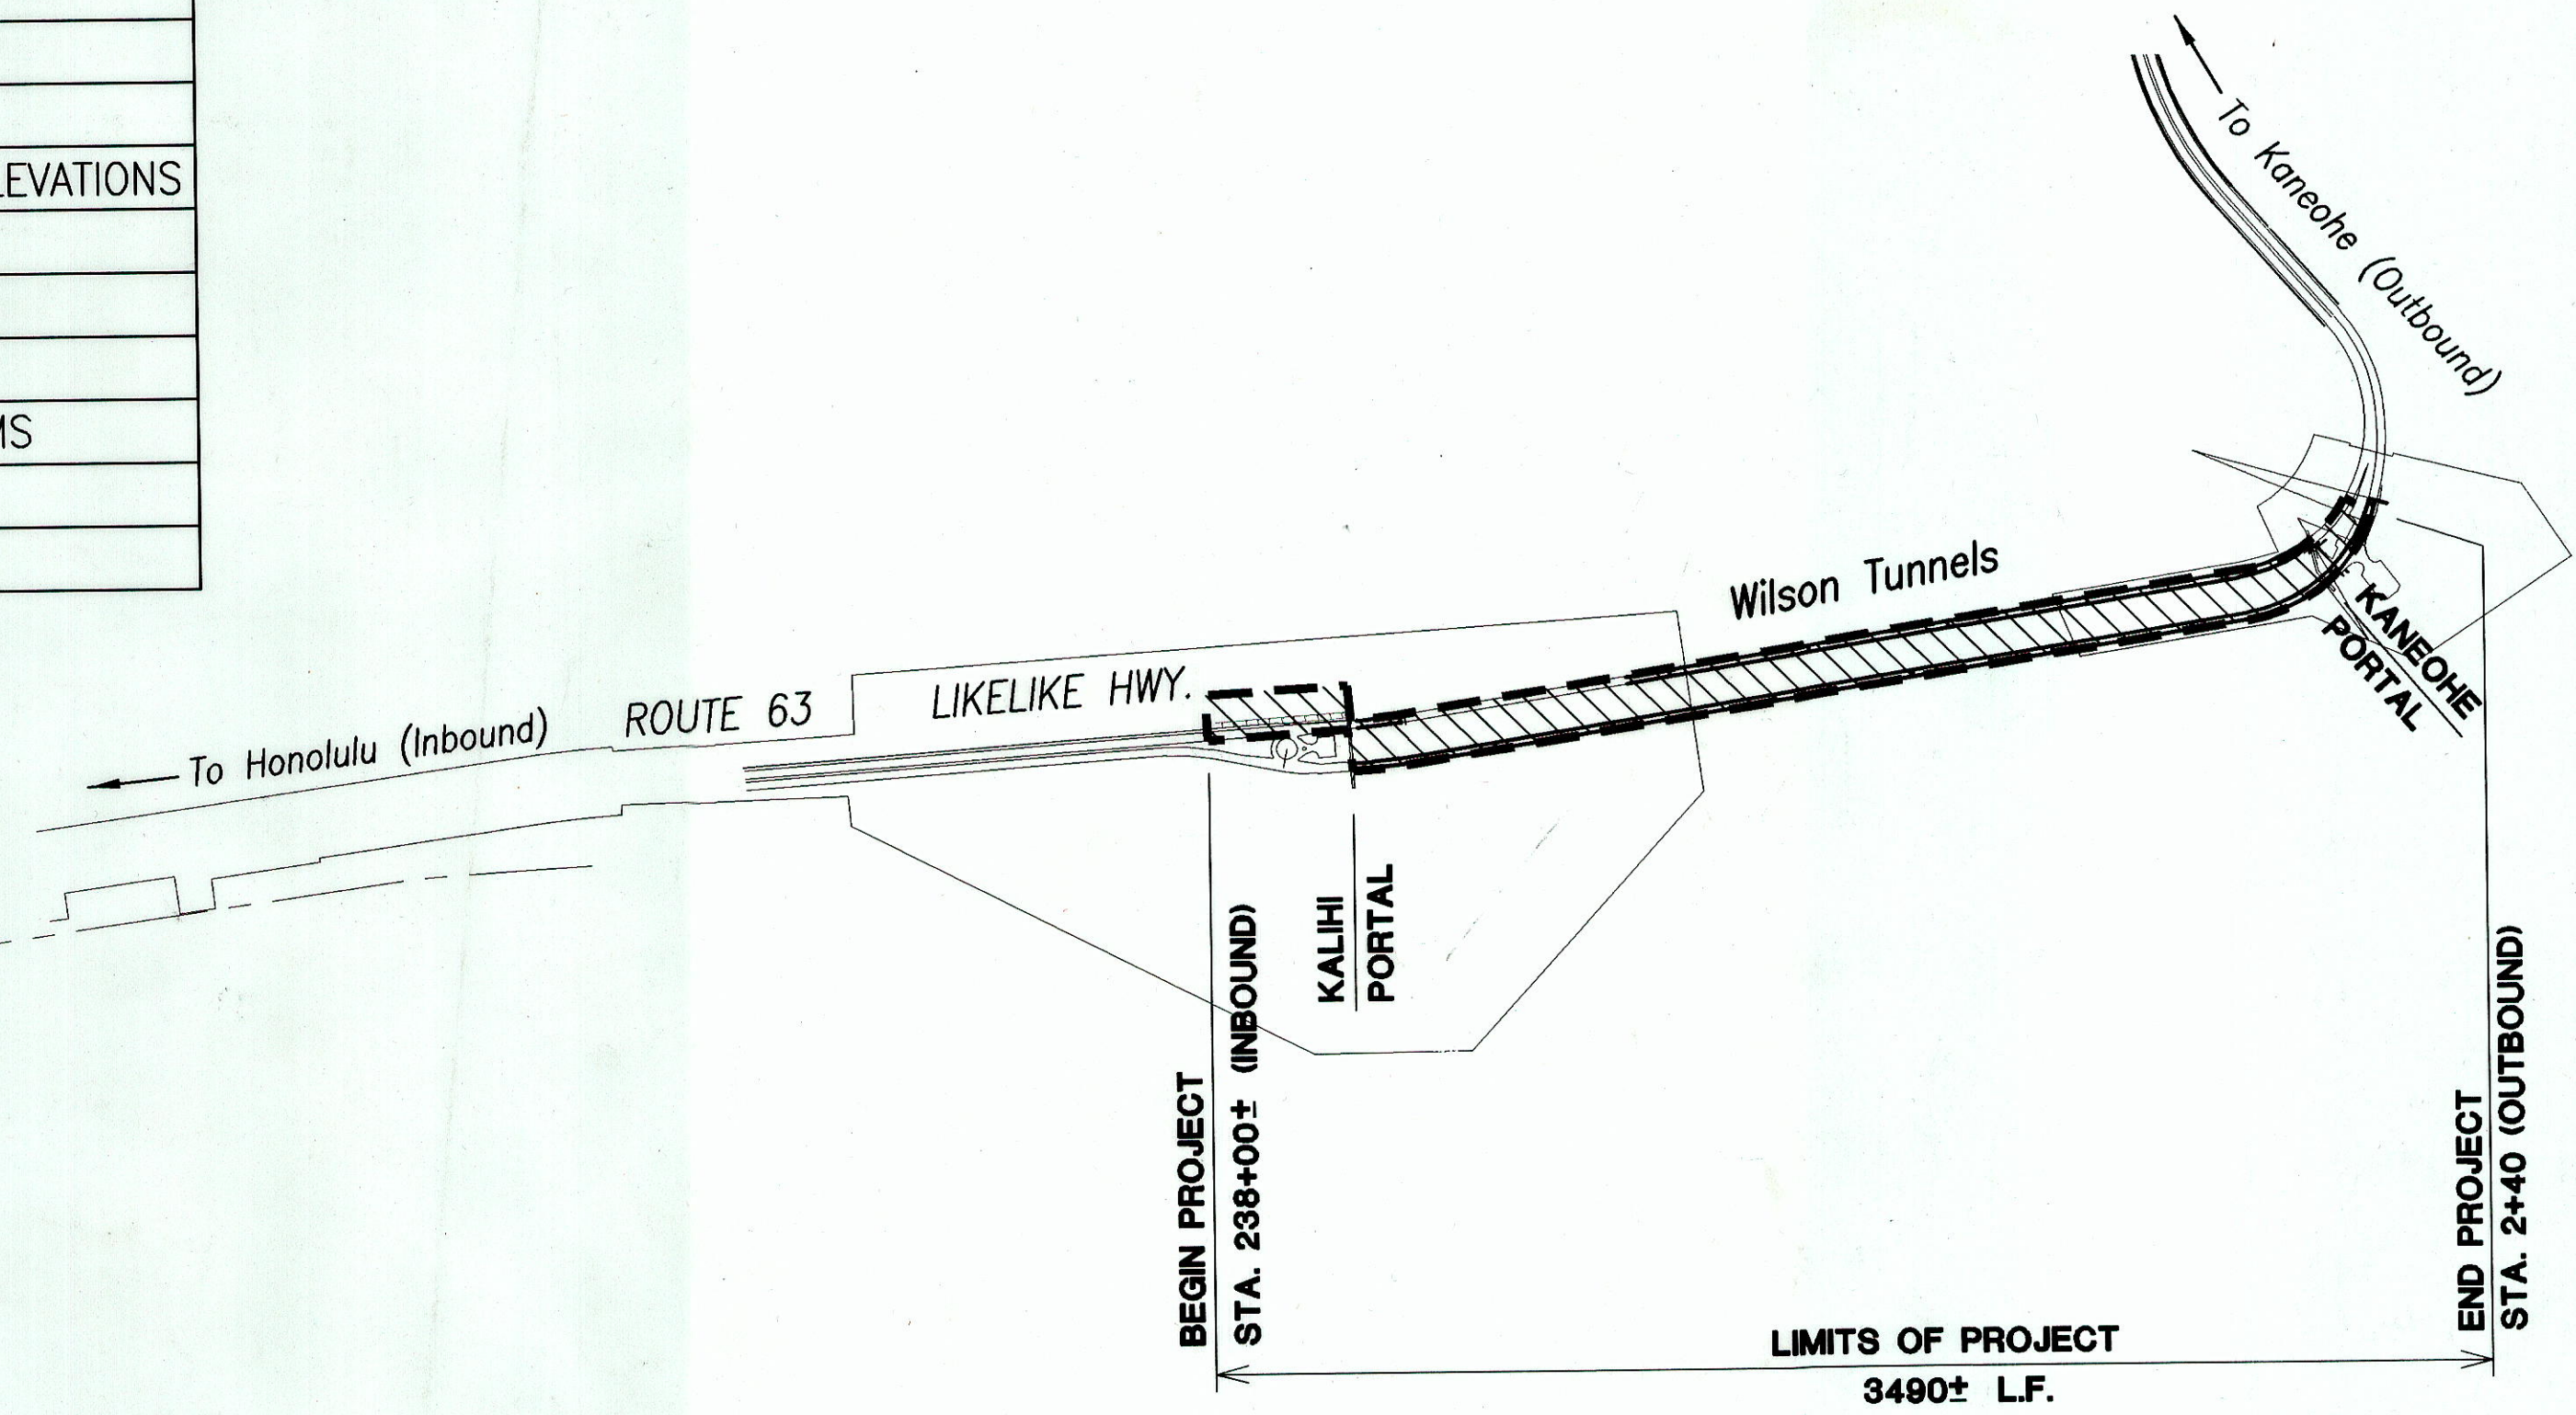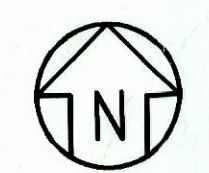

SURVEY PLOTTED BY: _____
DATE: _____
DRAWN BY: _____
NOTED BY: _____
DESIGNED BY: _____
CHECKED BY: _____
No. _____

APRIL 2003
DATE
692-7572
PHONE
HWY-DD
MANAGED BY
DESIGNED BY
R.M. TOWILL CORPORATION