


FED. ROAD DIST. NO.	STATE	FED. AID PROJ. NO.	FISCAL YEAR	SHEET NO.	TOTAL SHEETS
HAWAII	HAW.	STP-063-1(22)	2003	10	69

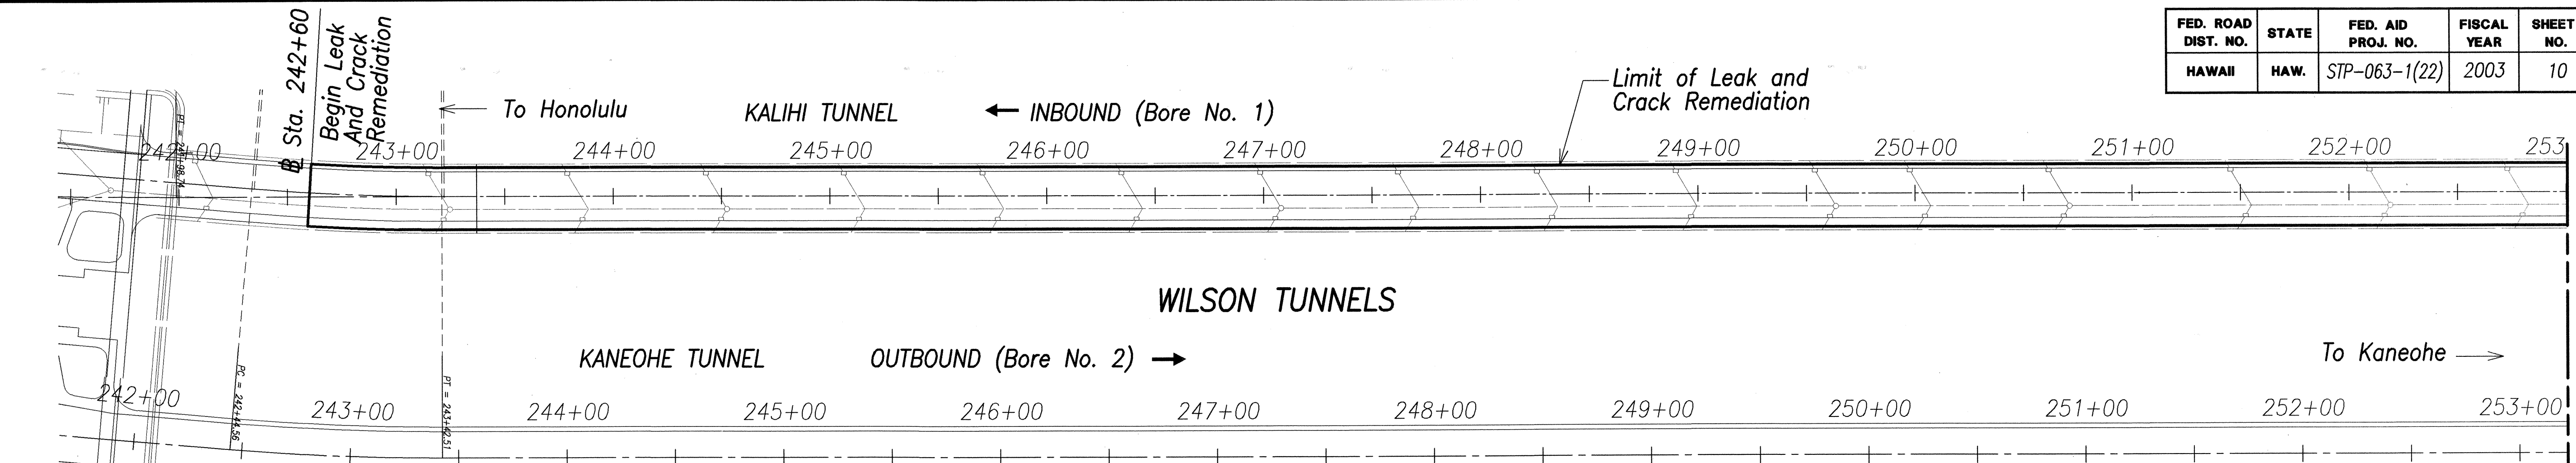

PATCH/SPALL REPAIR		
Station	Type of Defect	Location
242+60	Patch Failure	North Wall
242+95	Patch Failure	South Wall
243+20	Spall	South Sidewalk
243+24	Spall	South Wall
243+27	Spall	South Wall
243+37	Patch Failure	North Wall
245+27	Spall	Plenum Underside
245+60	Spall	South Sidewalk
248+12	Spall	South Sidewalk
248+48	Spall	Plenum Underside
248+50	Spall	South Sidewalk
250+08	Hollow Area	South Wall
250+66	Spall	North Wall
250+75	Patch Failure	North Wall
250+97	Spall	South Sidewalk
251+68	Spall	South Wall
252+30	Patch Failure	North Wall
252+30	Patch Failure	South Wall

PATCH/SPALL REPAIR		
Station	Type of Defect	Location
253+20	Patch Failure	Tunnel Arch
253+43	Spall	South Sidewalk
*254+55	Spall	South Wall
255+20	Spall	South Wall
256+45	Spall	South Wall
257+11	Spall	South Wall
257+42	Spall	South Wall

PLENUM TUNNEL DRAIN PIPE (NORTH AND SOUTH WALLS)	
Station	
244+55	
244+78	
245+15	
248+86	
250+20	
250+65	
252+21	
253+32	


REMOVAL OF 2 1/2" ϕ TUNNEL DRAIN	
Station	Location
244+24 $\pm$	North Wall
245+88 $\pm$	North Wall
246+50 $\pm$	North Wall
249+84 $\pm$	North Wall
250+66 $\pm$	North Wall
243+34 $\pm$	South Wall
243+98 $\pm$	South Wall
245+90 $\pm$	South Wall
249+36 $\pm$	South Wall
250+32 $\pm$	South Wall
250+79 $\pm$	South Wall
250+80 $\pm$	South Wall

POLYURETHANE GROUT LEAK SEALING	
Sta.	Location
244+56	Plenum Underside
245+25	Plenum Underside
247+61	Plenum Underside
249+32	In Plenum
249+66	Plenum Underside


HDPE PANNING AND DRAINAGE TROUGH	
Station	
242+69 to 250+65	
251+94 to 253+32	

Notes:

- Contractor shall flush and clean all drain inlets and drain pipes that exist within the tunnel. Drain inlets and drain manholes require removal of tack welds to access drain inlet. Contractor shall tack weld grate upon completion of maintenance work.
- See Sht. C-16 & C-17 for leak and crack remediation details.
- Location of patch/spall repair and leak sealing are approximate, Contractor to verify exact location.
- Contractor shall verify that steel pipe is abandoned prior to concrete repair. Remove or fill pipe with grout, as directed by the Engineer.
- See Sht. C-16 for tunnel drain demolition details.

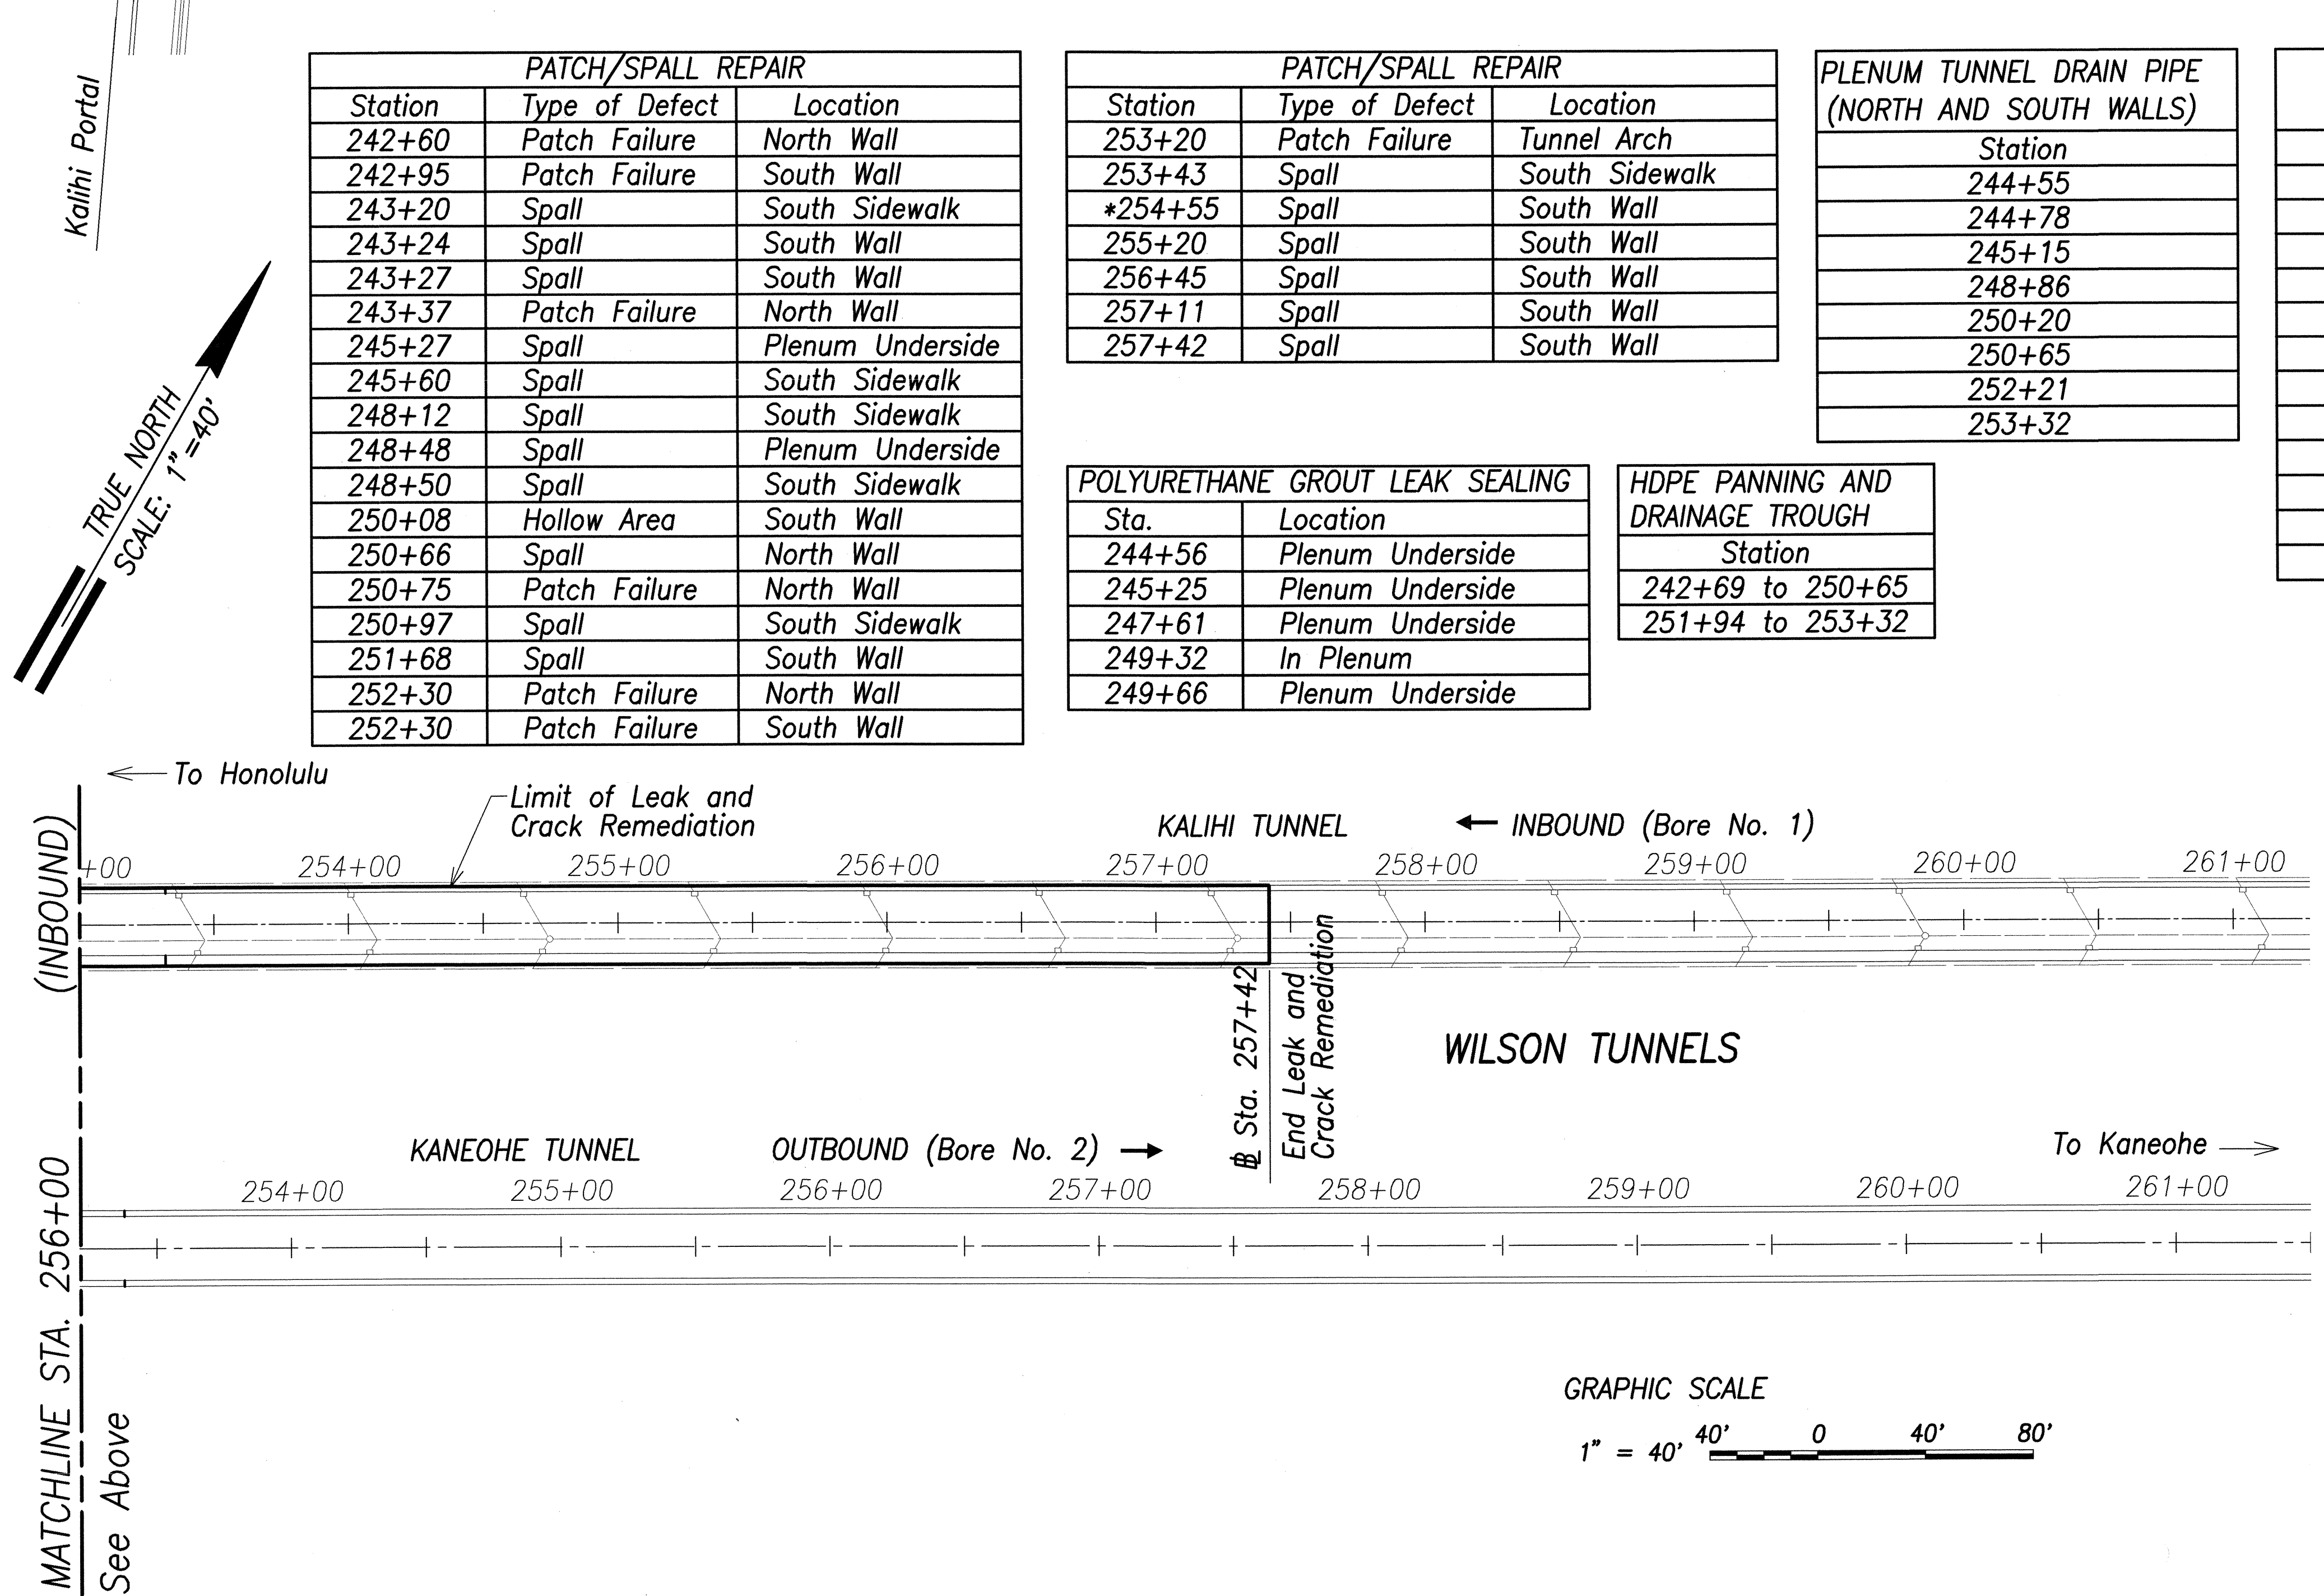

ORIGINAL PLAN	DATE
DRAWN BY	
DESIGNED BY	
CHECKED BY	
NO.	

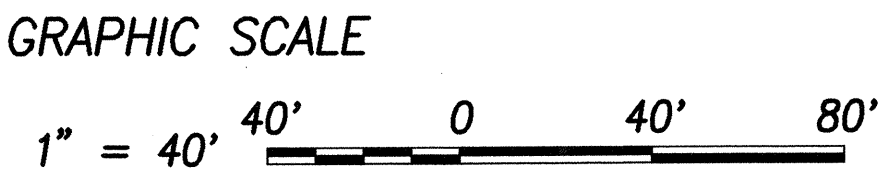

CRAIG W. L. LUK
LICENSED PROFESSIONAL ENGINEER
No. 8935-C
HAWAII, U.S.A.

THIS WORK WAS PREPARED BY ME OR UNDER MY SUPERVISION AND CONSTRUCTION OF THIS PROJECT WILL BE UNDER MY OBSERVATION.


Signature: [Signature]
April 30, 2004
EXPIRATION DATE OF THE LICENSE

6/20/03
DATE
ADDED EXIST. DRAINAGE SYSTEM
REVISION

STATE OF HAWAII
DEPARTMENT OF TRANSPORTATION
HIGHWAYS DIVISION
KALIHU INBOUND TUNNEL AIR PLENUM AND DRAINAGE PLAN
LIKELIKE HIGHWAY
Wilson Tunnel Improvements
Leak and Crack Remediation
F. A. Project No. STP-063-1(22)
Scale: 1"=40' Date: April 24, 2003

SHEET No. C-9 OF 30 SHEETS

FED. ROAD DIST. NO.	STATE	FED. AID PROJ. NO.	FISCAL YEAR	SHEET NO.	TOTAL SHEETS
HAWAII	HAW.	STP-063-1(22)	2003	11	69

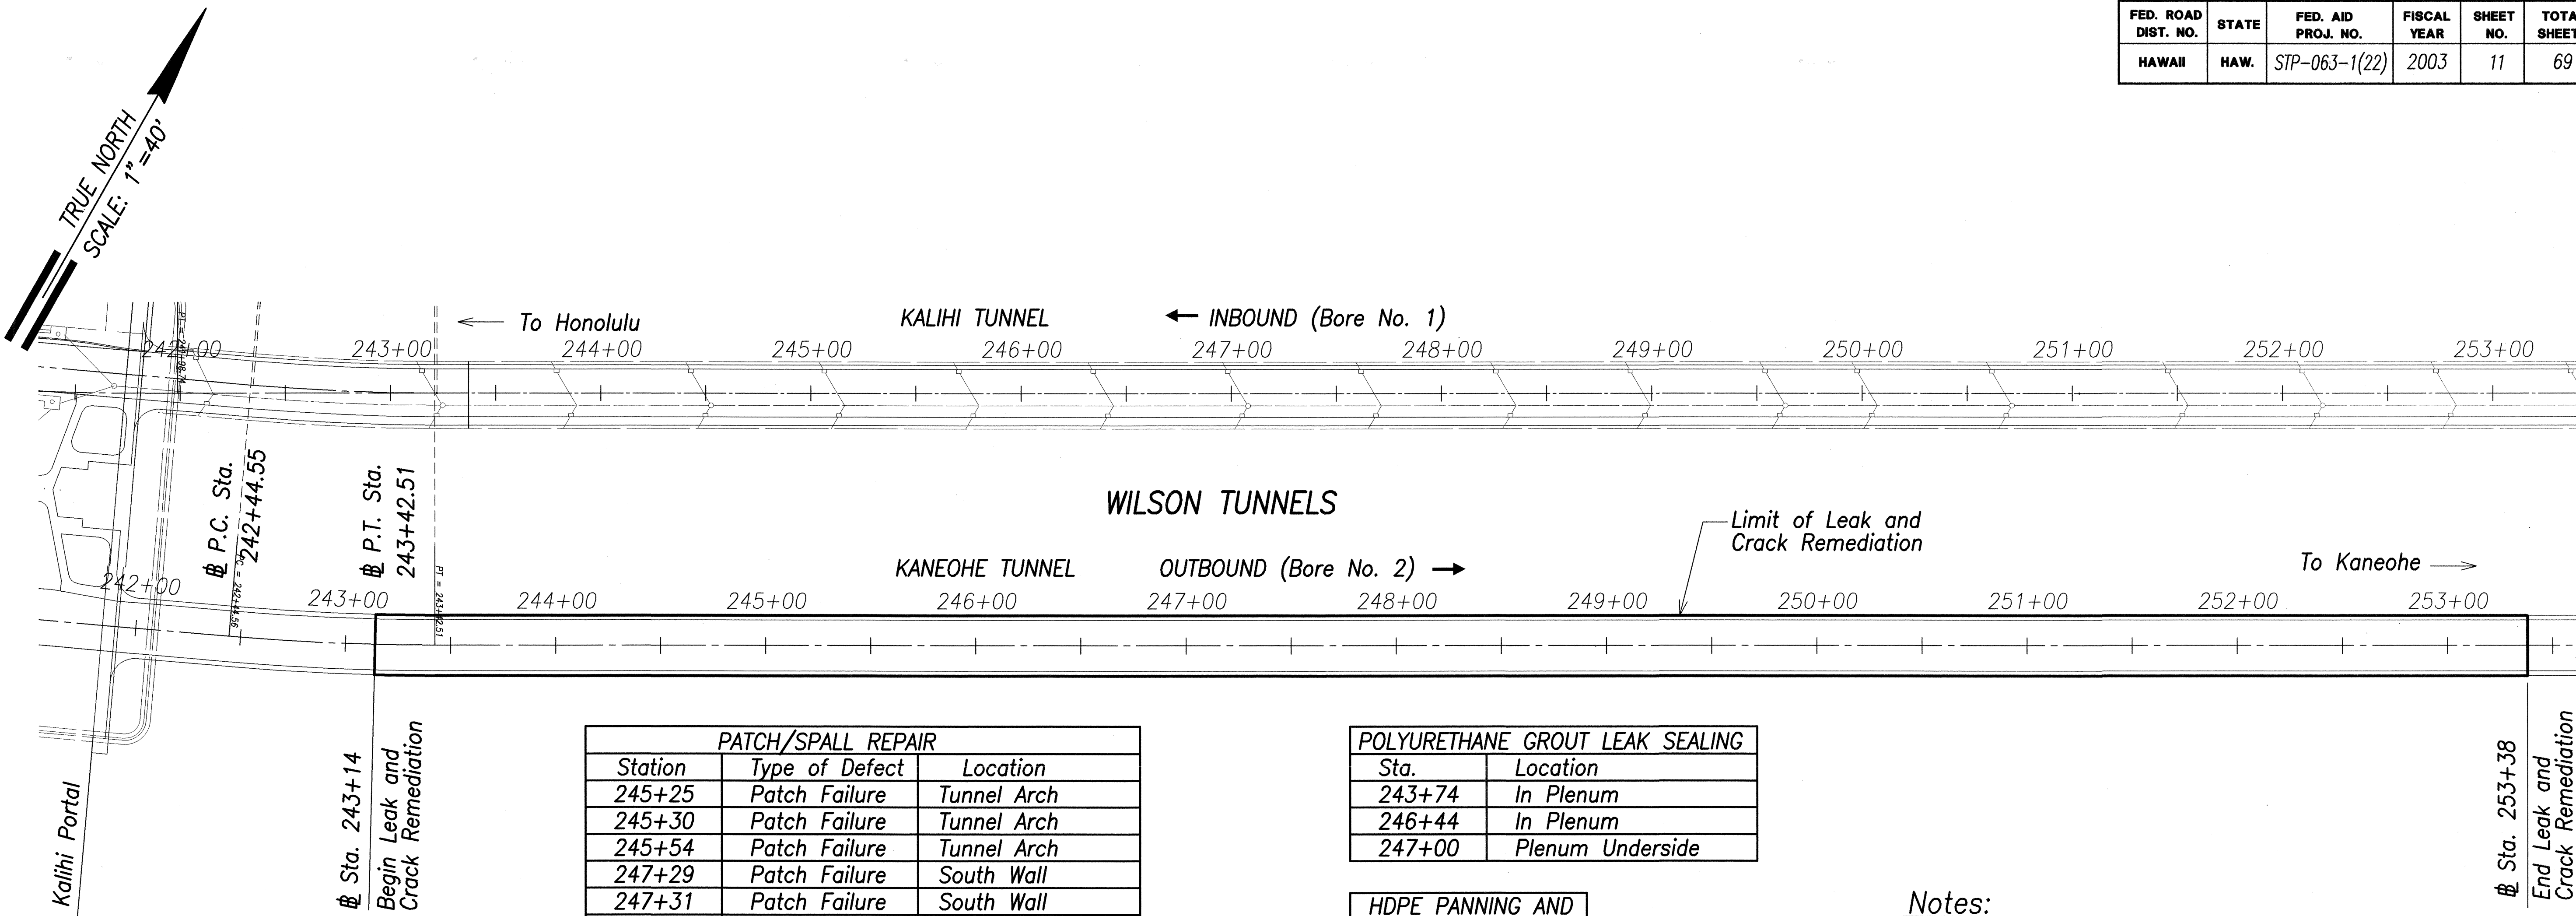

REMOVAL OF 2 1/2" ϕ TUNNEL DRAIN	
Station	Location
247+04 $\pm$	North Wall
243+72 $\pm$	South Wall
244+58 $\pm$	South Wall
245+16 $\pm$	South Wall
247+62 $\pm$	South Wall
248+20 $\pm$	South Wall
248+80 $\pm$	South Wall
249+44 $\pm$	South Wall
250+98 $\pm$	South Wall


PATCH/SPALL REPAIR		
Station	Type of Defect	Location
245+25	Patch Failure	Tunnel Arch
245+30	Patch Failure	Tunnel Arch
245+54	Patch Failure	Tunnel Arch
247+29	Patch Failure	South Wall
247+31	Patch Failure	South Wall
247+34	Patch Failure	North Wall
247+64	Patch Failure	North Wall
247+64	Patch Failure	South Wall
248+33	Patch Failure	Tunnel Arch
249+43	Spall	Plenum Underside
250+32	Patch Failure	Tunnel Arch
250+45	Patch Failure	Tunnel Arch
250+47	Patch Failure	North Wall
250+52	Patch Failure	Tunnel Arch
250+93	Patch Failure	South Wall
252+11	Patch Failure	South Wall
252+43	Patch Failure	South Wall
252+77	Patch Failure	Tunnel Arch

POLYURETHANE GROUT LEAK SEALING	
Sta.	Location
243+74	In Plenum
246+44	In Plenum
247+00	Plenum Underside

HDPE PANNING AND DRAINAGE TROUGH	
Station	
243+14 to 250+89	
251+48 to 251+58	
252+47 to 253+38	


PLENUM TUNNEL DRAIN PIPE (NORTH AND SOUTH WALLS)	
Station	
243+38	
244+78	
245+60	
246+31	
246+95	
250+89	
251+58	
253+38	

- Notes:
- Contractor shall flush and clean all drain inlets and drain pipes that exist within the tunnel. Catch basin and drain manholes require removal of tack welds to access drainage structures. Contractor shall tack weld grate upon completion of maintenance work.
 - Catch basins are located 30' o.c. (left and right) through entire tunnel.
 - See Sht. C-16 & C-17 for leak and crack remediation details.
 - Location of patch/spall repair and leak sealing are approximate. Contractor to verify exact location.
 - See Sht. C-16 for tunnel drain demolition details.

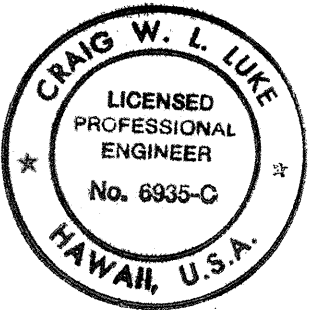

THIS WORK WAS PREPARED BY ME OR UNDER MY SUPERVISION AND CONSTRUCTION OF THIS PROJECT WILL BE UNDER MY OBSERVATION.


Signature: [Signature] April 30, 2004
EXPIRATION DATE OF THE LICENSE

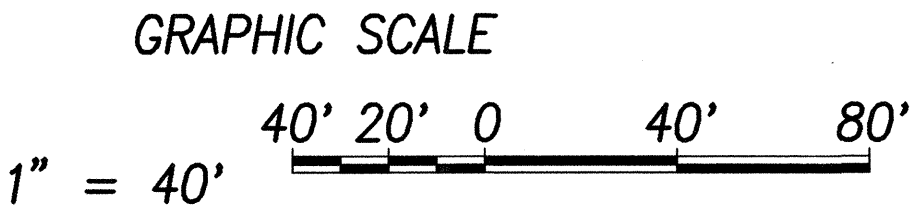


STATE OF HAWAII
DEPARTMENT OF TRANSPORTATION
HIGHWAYS DIVISION
KANEOHE OUTBOUND TUNNEL AIR
PLENUM AND DRAINAGE PLAN
Likeli Highway
Wilson Tunnel Improvements
Leak and Crack Remediation
F. A. Project No. STP-063-1(22)
Scale: 1"=40' Date: April 24, 2003
SHEET No. C-10 OF 30 SHEETS

SURVEY PLOTTED BY	DATE
DRAWN BY	
DESIGNED BY	
QUANTITIES BY	
CHECKED BY	
ORIGINAL PLAN	
NOTE BOOK	
No.	

FED. ROAD DIST. NO.	STATE	FED. AID PROJ. NO.	FISCAL YEAR	SHEET NO.	TOTAL SHEETS
HAWAII	HAW.	STP-063-1(22)	2003	12	69

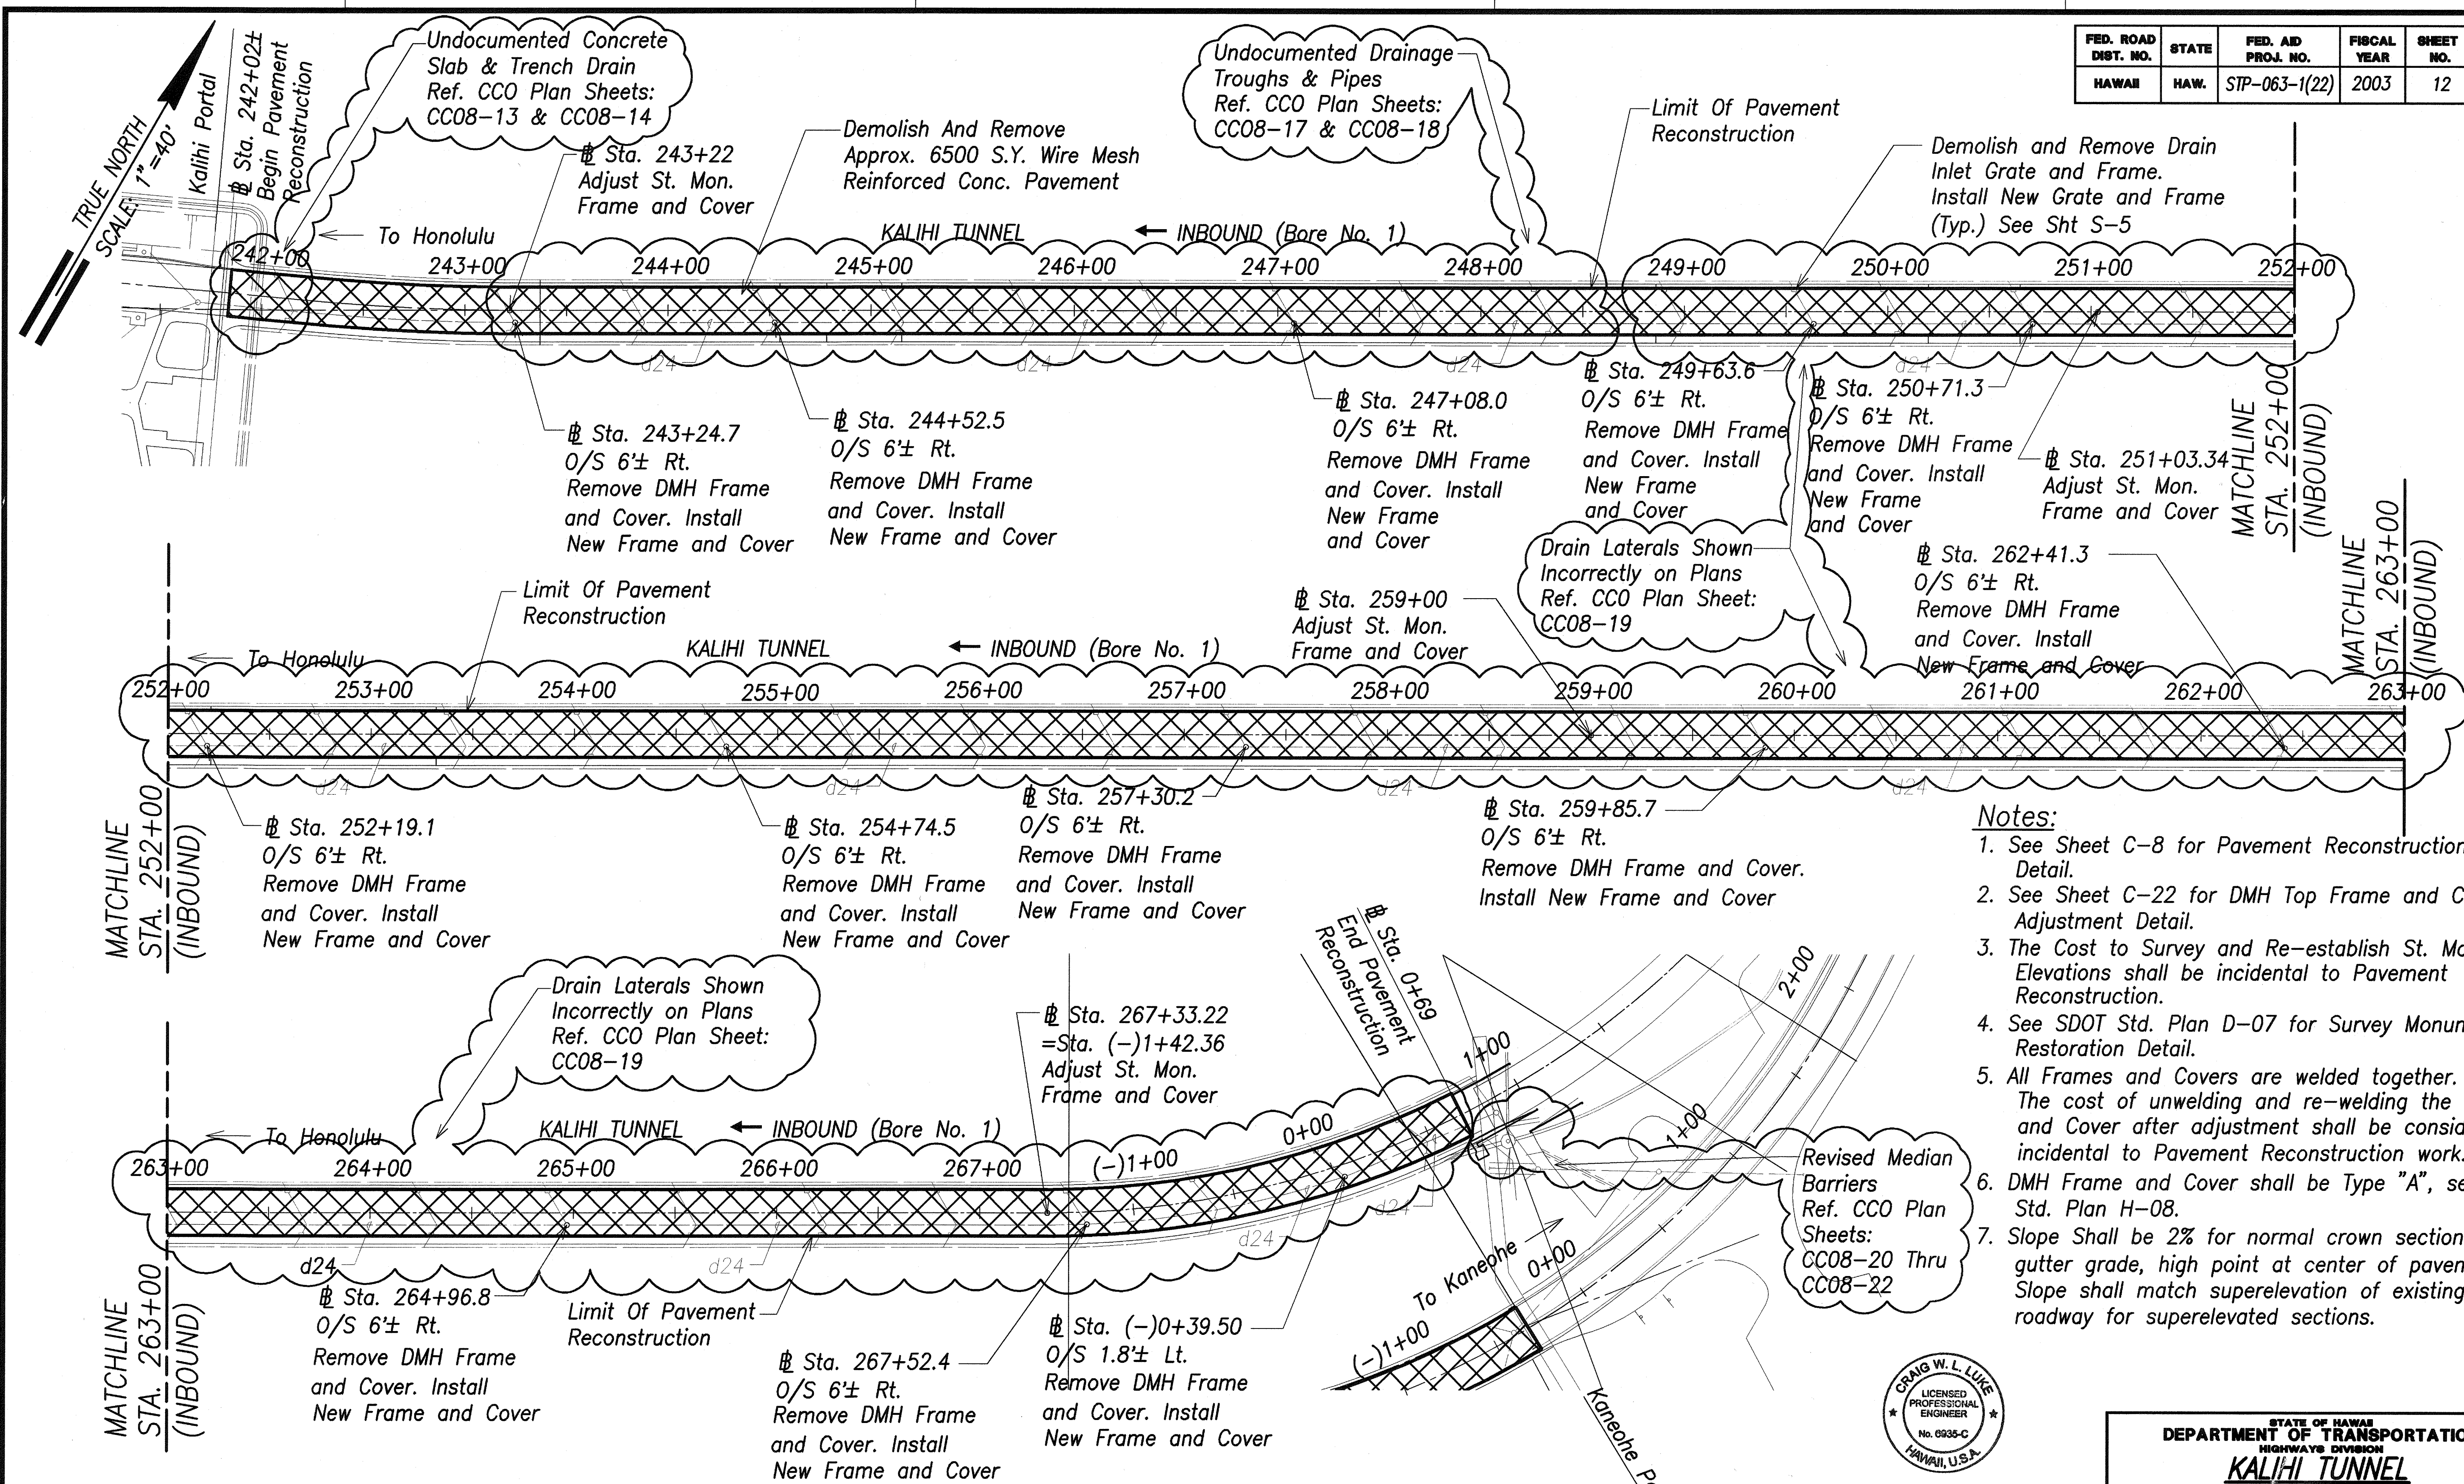


- Notes:**
1. See Sheet C-8 for Pavement Reconstruction Detail.
 2. See Sheet C-22 for DMH Top Frame and Cover Adjustment Detail.
 3. The Cost to Survey and Re-establish St. Mon. Elevations shall be incidental to Pavement Reconstruction.
 4. See SDOT Std. Plan D-07 for Survey Monument Restoration Detail.
 5. All Frames and Covers are welded together. The cost of unwelding and re-welding the Frame and Cover after adjustment shall be considered incidental to Pavement Reconstruction work.
 6. DMH Frame and Cover shall be Type "A", see SDOT Std. Plan H-08.
 7. Slope Shall be 2% for normal crown sections (hold gutter grade, high point at center of pavement). Slope shall match superelevation of existing roadway for superelevated sections.

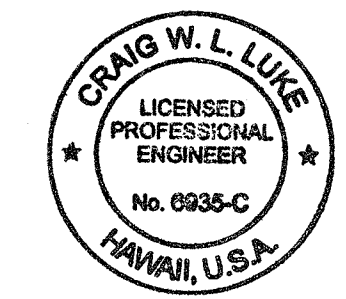

THIS WORK WAS PREPARED BY ME OR UNDER MY SUPERVISION AND CONSTRUCTION OF THIS PROJECT WILL BE UNDER MY OBSERVATION.

Signature: *[Signature]* April 30, 2004
 EXPIRATION DATE OF THE LICENSE

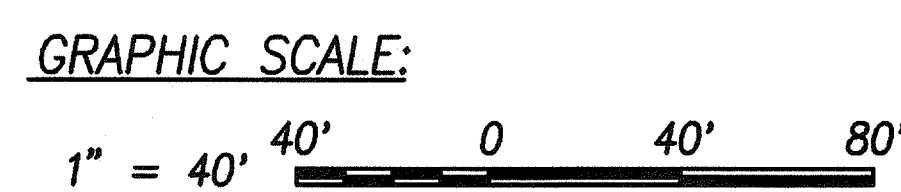

SURVEY PLANNED BY	DATE
DESIGNED BY	
TRACED BY	
NOTED BY	
CHECKED BY	
ORIGINAL PLAN	
NOTE BOOK	
No.	


STATE OF HAWAII
 DEPARTMENT OF TRANSPORTATION
 HIGHWAYS DIVISION

KALIHI TUNNEL
PAVEMENT RECONSTRUCTION
 LIKELIKE HIGHWAY

Wilson Tunnel Improvements
 Leak and Crack Remediation
 F. A. Project No. STP-063-1(22)
 Scale: 1"=40' Date: April 24, 2003

SHEET No. C-11 OF 30 SHEETS

FED. ROAD DIST. NO.	STATE	FED. AID PROJ. NO.	FISCAL YEAR	SHEET NO.	TOTAL SHEETS
HAWAII	HAW.	STP-063-1(22)	2003	13	69

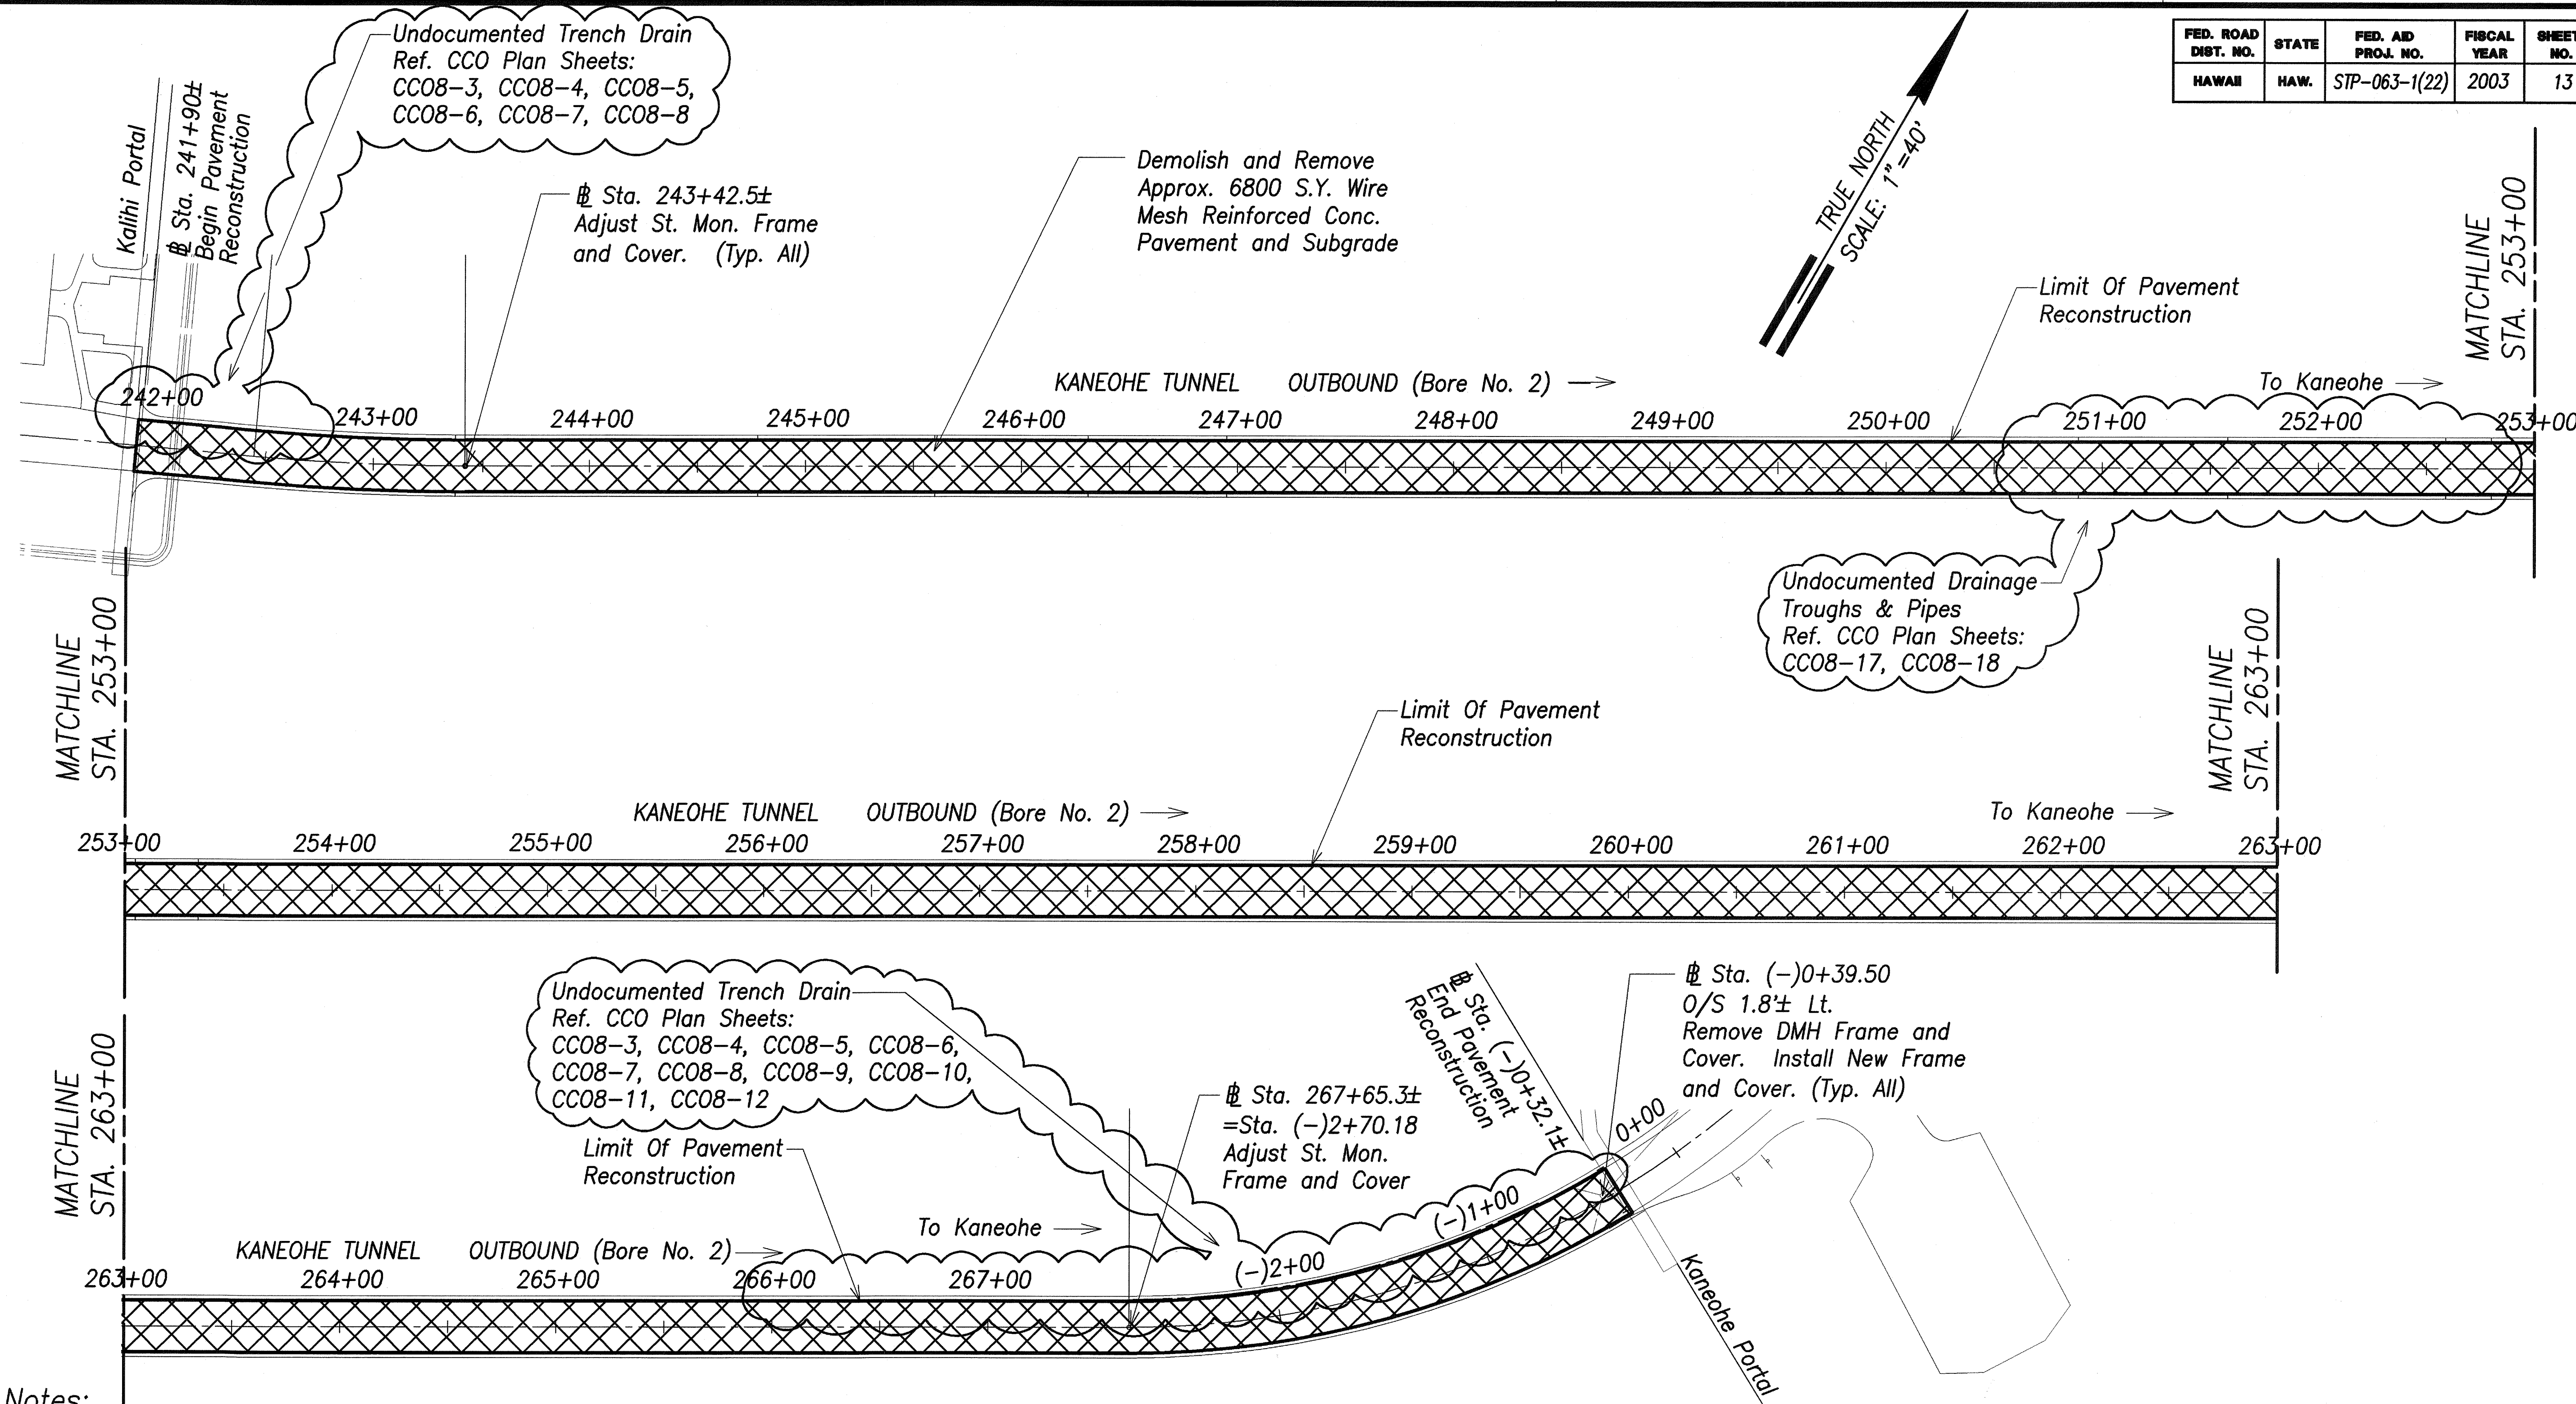


Notes:

- See sheet C-8 for pavement reconstruction detail.
- Contractor shall verify and record the locations of st. mon. prior to pavement reconstruction.
- See SDOT Std. Plan D-07 for survey monument restoration detail. The cost to survey and re-establish st. mon. elevations shall be incidental to pavement reconstruction work.
- All frames and covers are welded together. The cost of unwelding and re-welding the frame and cover after adjustment shall be considered incidental to pavement reconstruction work.
- DMH frame and cover shall be Type "A", see SDOT Std. Plan H-08.
- Slope shall be 2% for normal crown sections (hold gutter grade, high point at center of pavement). Slopes shall match superelevation of existing roadway for superelevated sections.
- Demolish and remove catch basin grate and frame. Install new grate and frame (Typ.) see Sht. S-5.
- See Sht. C-22 for DMH top Frame and Cover Adjustment Detail.
- Contractor shall submit Concrete Pavement Jointing Pattern shop drawing at least 12 weeks prior to concrete pavement work and shall not proceed until written approval from the Engineer is granted.

GRAPHIC SCALE

1" = 40' 40' 0 40' 80'

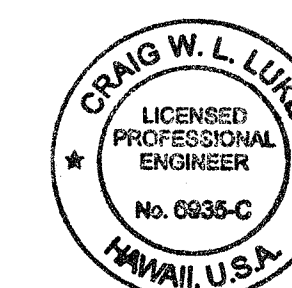

THIS WORK WAS PREPARED BY ME OR UNDER MY SUPERVISION AND CONSTRUCTION OF THIS PROJECT WILL BE UNDER MY OBSERVATION.


SIGNATURE: [Signature] EXPIRATION DATE OF THE LICENSE: April 30, 2004

STATE OF HAWAII
DEPARTMENT OF TRANSPORTATION
HIGHWAYS DIVISION
KANEOHE TUNNEL
PAVEMENT RECONSTRUCTION
LIKELIKE HIGHWAY
Wilson Tunnel Improvements
Leak and Crack Remediation
F. A. Project No. STP-063-1(22)
Scale: 1"=40' Date: April 24, 2003

SHEET No. C-12 OF 30 SHEETS

"AS-BUILT" 13

FED. ROAD DIST. NO.	STATE	FED. AID PROJ. NO.	FISCAL YEAR	SHEET NO.	TOTAL SHEETS
HAWAII	HAW.	STP-063-1(22)	2003	14	69


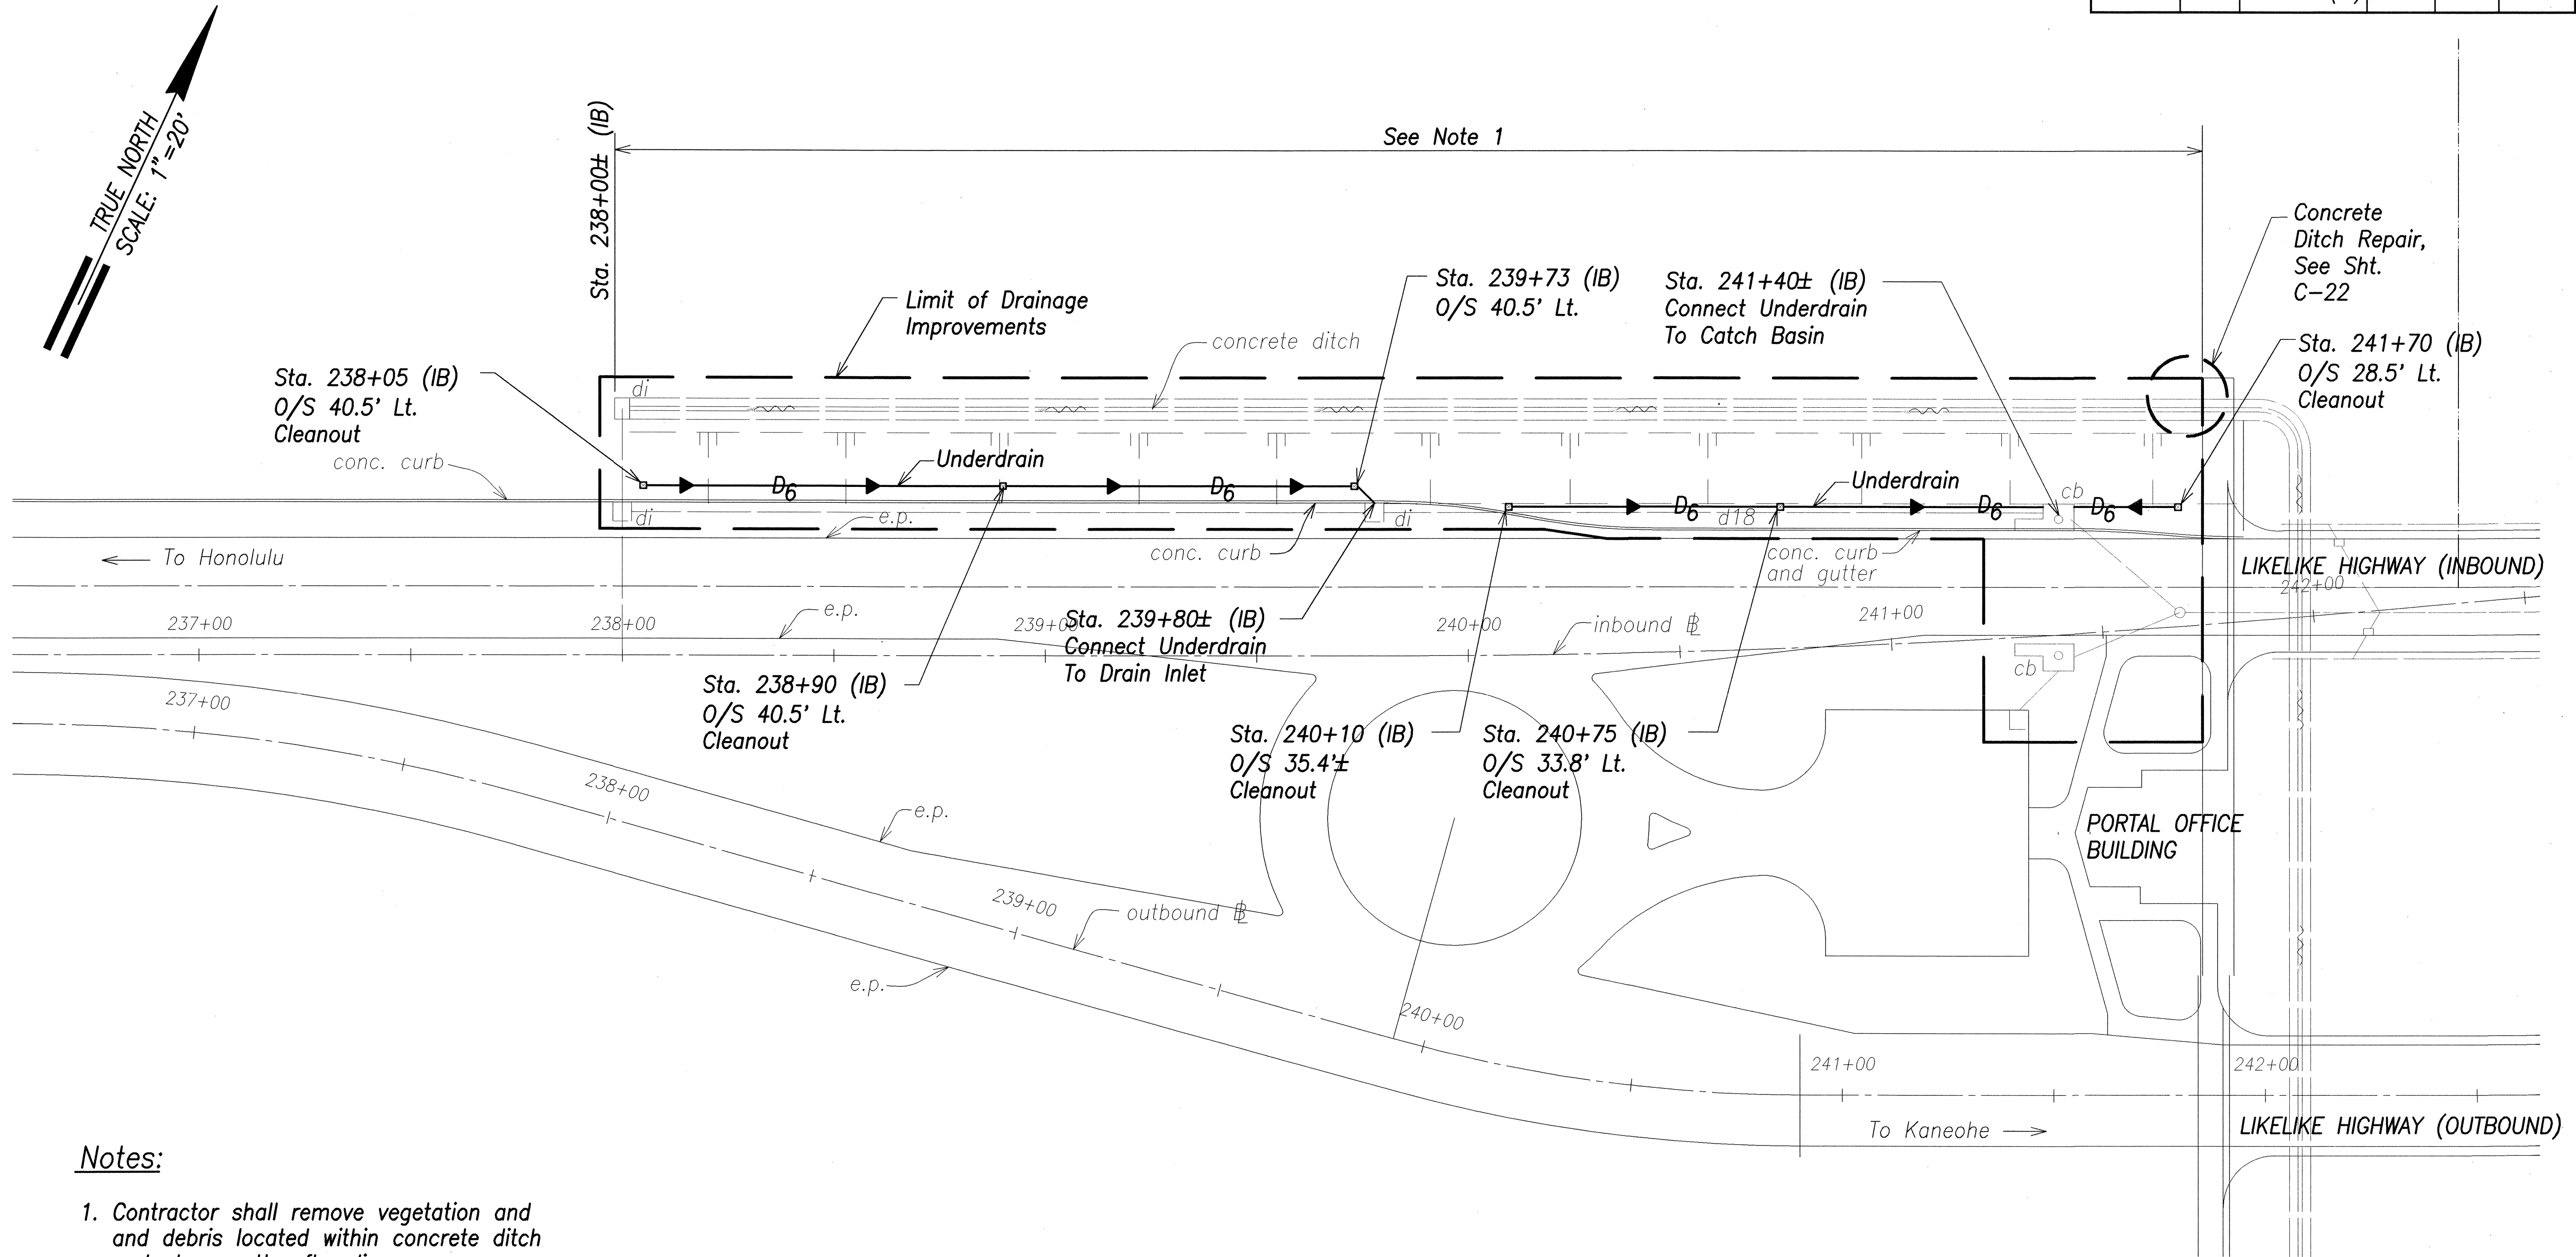


Notes:

- Contractor shall remove vegetation and debris located within concrete ditch and along gutter flow line.
- See sheet C-19 for underdrain details.
- Contractor shall flush and clean all drain inlets, catch basin, and drain pipes within Limit of Drainage Improvement.

SURVEY PLOTTED BY	DATE
DRAWN BY	
DESIGNED BY	
QUANTITIES BY	
CHECKED BY	
ORIGINAL PLAN	
NOTE BOOK	
No.	

**KALIHI PORTAL –
DRAINAGE PLAN**
SCALE: 1"=20'

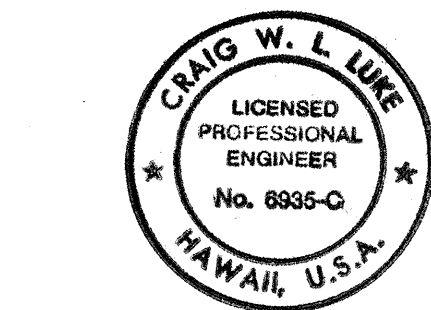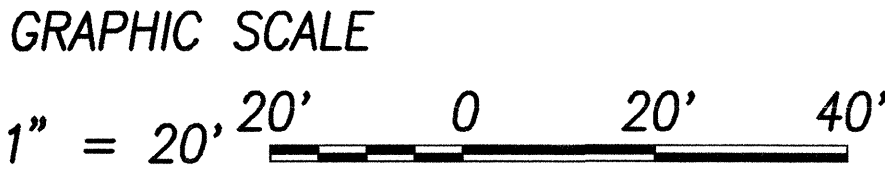

THIS WORK WAS PREPARED BY ME OR UNDER MY SUPERVISION AND CONSTRUCTION OF THIS PROJECT WILL BE UNDER MY OBSERVATION.

Signature: *[Signature]*
April 30, 2004
EXPIRATION DATE OF THE LICENSE

STATE OF HAWAII
DEPARTMENT OF TRANSPORTATION
HIGHWAYS DIVISION

**KALIHI PORTAL –
DRAINAGE PLAN**
LIKELIKE HIGHWAY

*Wilson Tunnel Improvements
Leak and Crack Remediation*

F. A. Project No. STP-063-1(22)
Scale: 1" = 20' Date: April 24, 2003

SHEET No. C-13 OF 30 SHEETS


FED. ROAD DIST. NO.	STATE	FED. AID PROJ. NO.	FISCAL YEAR	SHEET NO.	TOTAL SHEETS
HAWAII	HAW.	STP-063-1(22)	2003	16	69

Note:

Contractor shall submit Concrete Pavement Jointing Pattern Shop Drawing at least 12 weeks prior to concrete pavement work and shall not proceed until written approval from the Engineer is granted.

Note:

1. Hydromulch Seeding Shall Be Incidental To Various Contract Items.

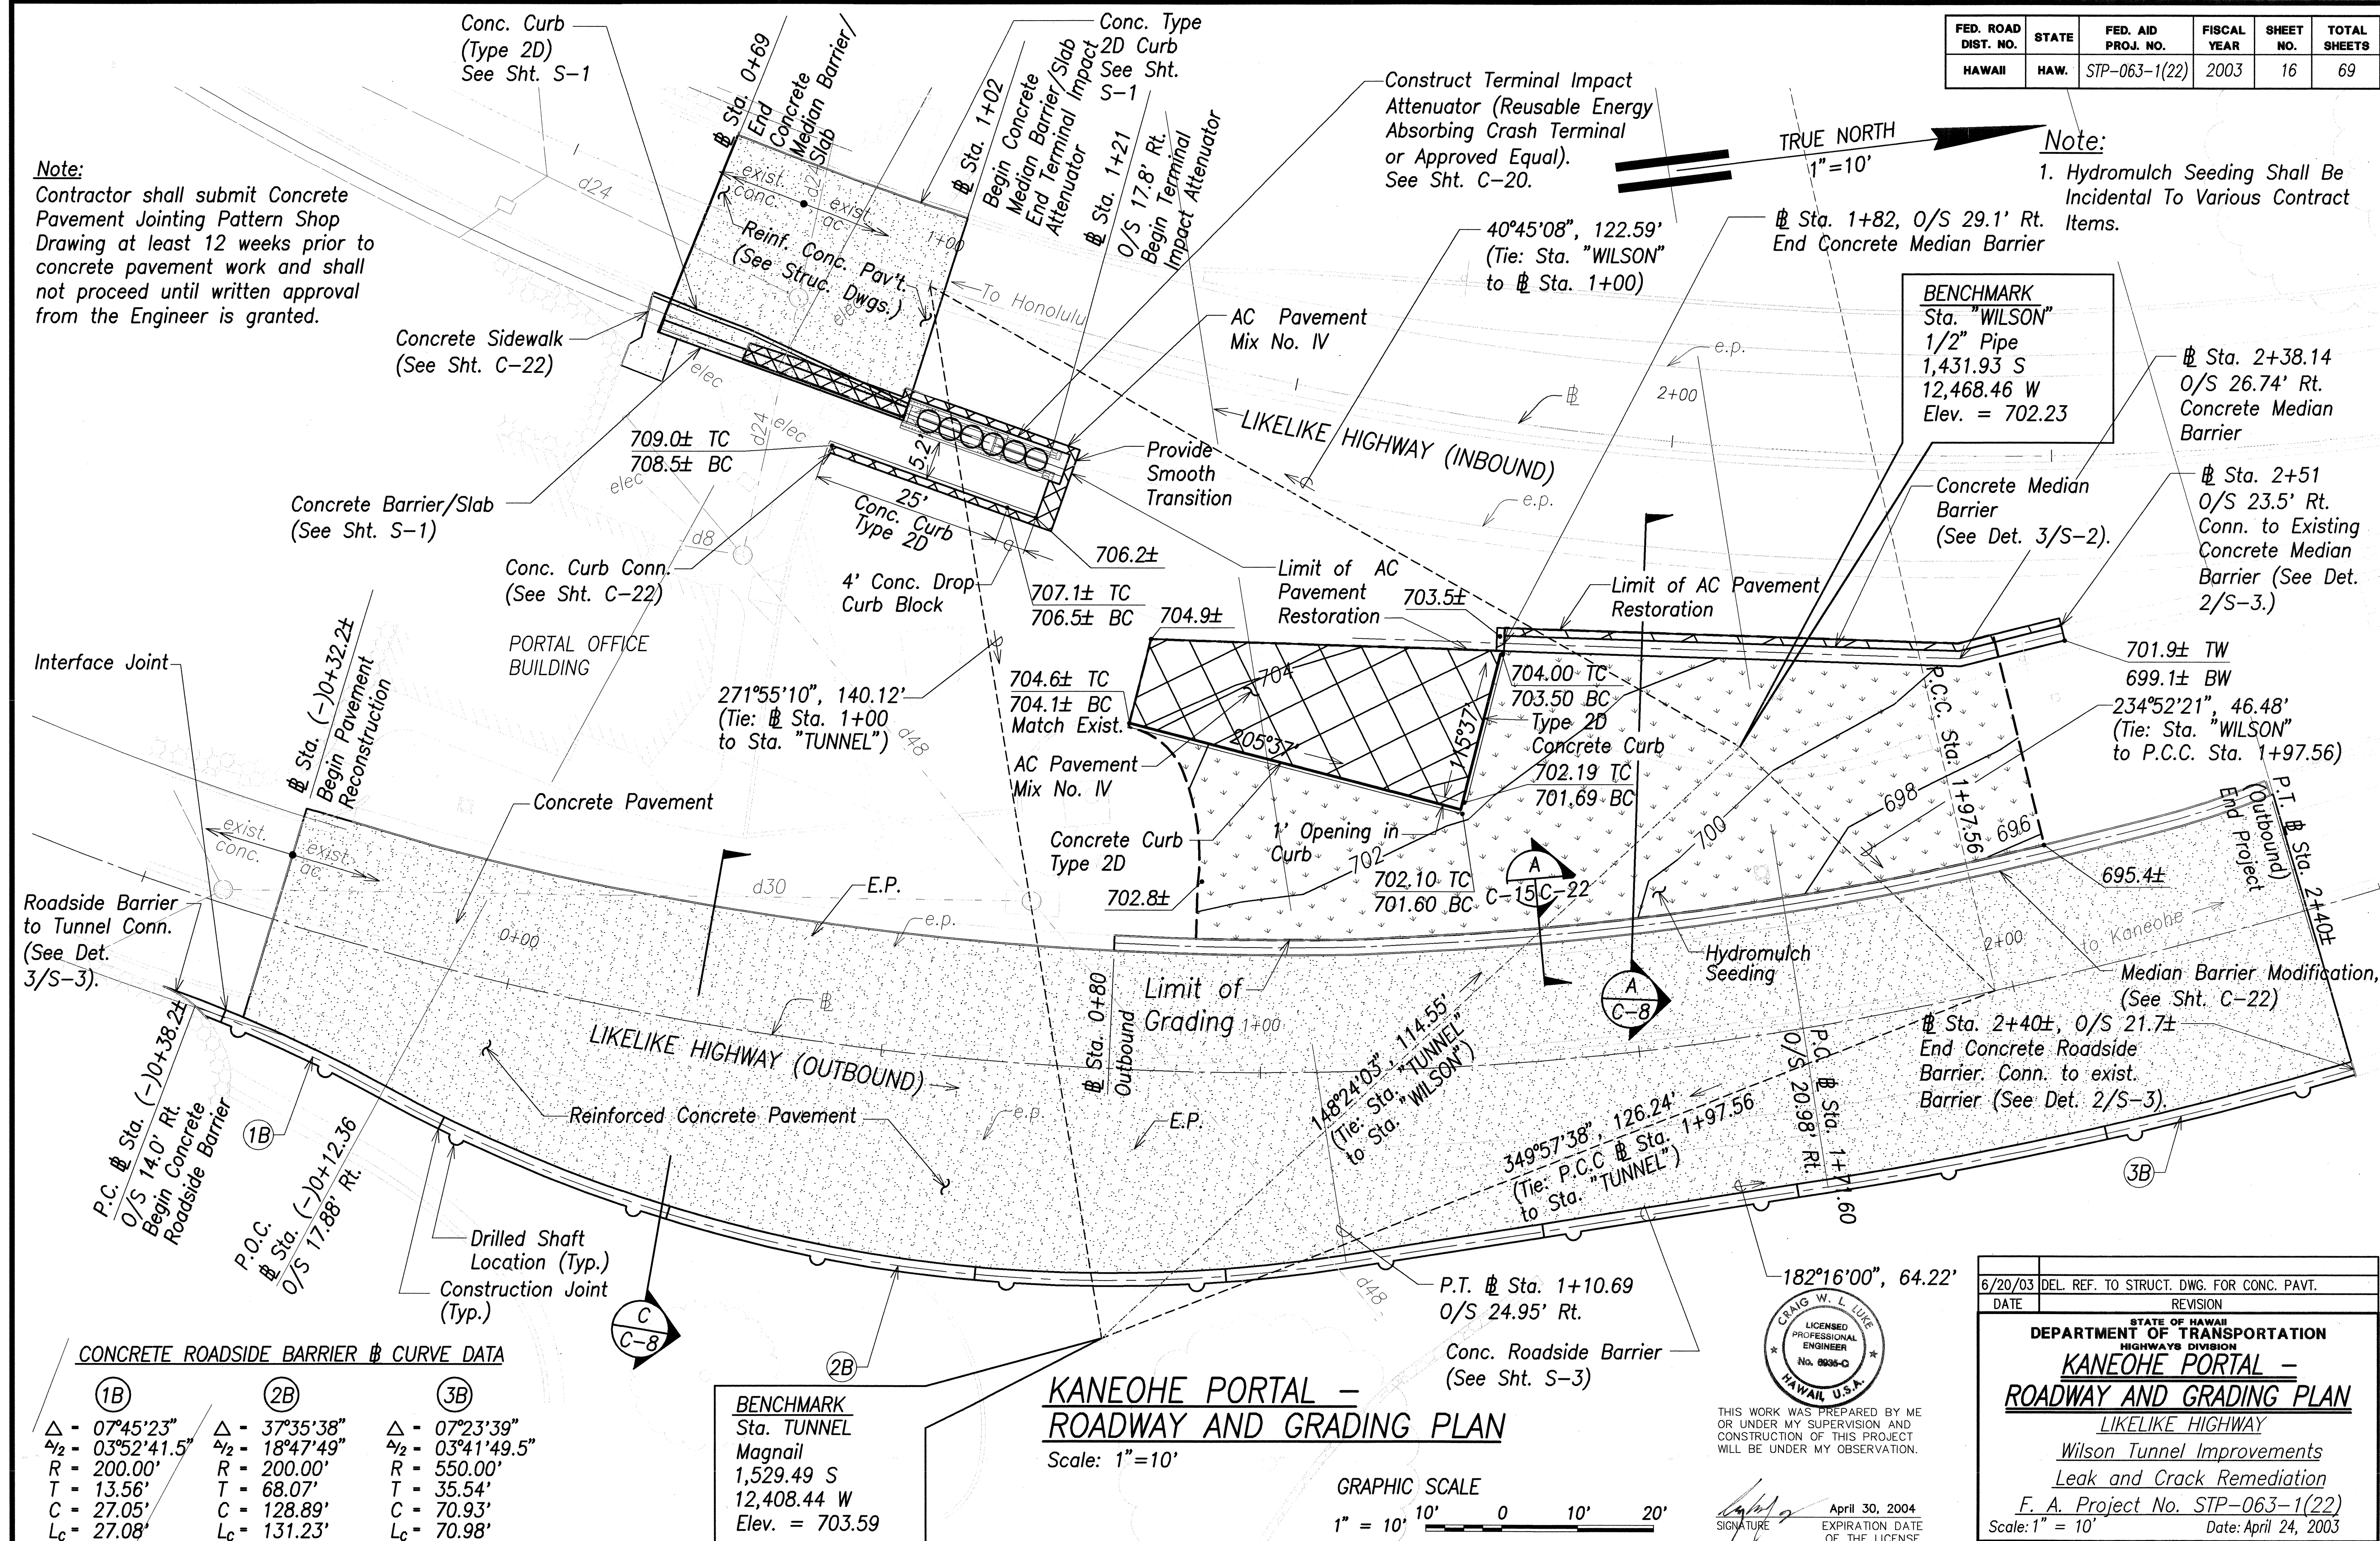


CONCRETE ROADSIDE BARRIER & CURVE DATA

(1B)	(2B)	(3B)
$\Delta = 07^{\circ}45'23''$	$\Delta = 37^{\circ}35'38''$	$\Delta = 07^{\circ}23'39''$
$\Delta_2 = 03^{\circ}52'41.5''$	$\Delta_2 = 18^{\circ}47'49''$	$\Delta_2 = 03^{\circ}41'49.5''$
$R = 200.00'$	$R = 200.00'$	$R = 550.00'$
$T = 13.56'$	$T = 68.07'$	$T = 35.54'$
$C = 27.05'$	$C = 128.89'$	$C = 70.93'$
$L_c = 27.08'$	$L_c = 131.23'$	$L_c = 70.98'$

BENCHMARK
Sta. TUNNEL
Magnail
1,529.49 S
12,408.44 W
Elev. = 703.59

**KANEOHE PORTAL -
ROADWAY AND GRADING PLAN**

Scale: 1" = 10'

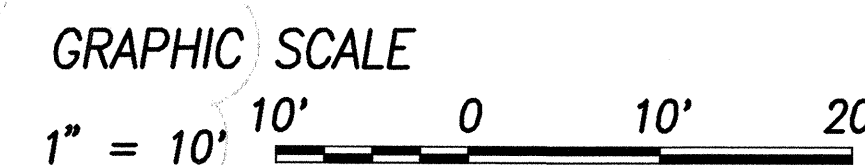

THIS WORK WAS PREPARED BY ME
OR UNDER MY SUPERVISION AND
CONSTRUCTION OF THIS PROJECT
WILL BE UNDER MY OBSERVATION.

April 30, 2004
EXPIRATION DATE
OF THE LICENSE

6/20/03	DEL. REF. TO STRUCT. DWG. FOR CONC. PAVT.
DATE	REVISION
STATE OF HAWAII DEPARTMENT OF TRANSPORTATION HIGHWAYS DIVISION	
KANEOHE PORTAL - ROADWAY AND GRADING PLAN	
LIKELIKE HIGHWAY	
Wilson Tunnel Improvements	
Leak and Crack Remediation	
F. A. Project No. STP-063-1(22)	
Scale: 1" = 10'	Date: April 24, 2003
SHEET No. C-15 OF 30 SHEETS	