


FED. ROAD DIST. NO.	STATE	FED. AID PROJ. NO.	FISCAL YEAR	SHEET NO.	TOTAL SHEETS
HAWAII	HAW.	STP-063-1(22)	2003	65	69

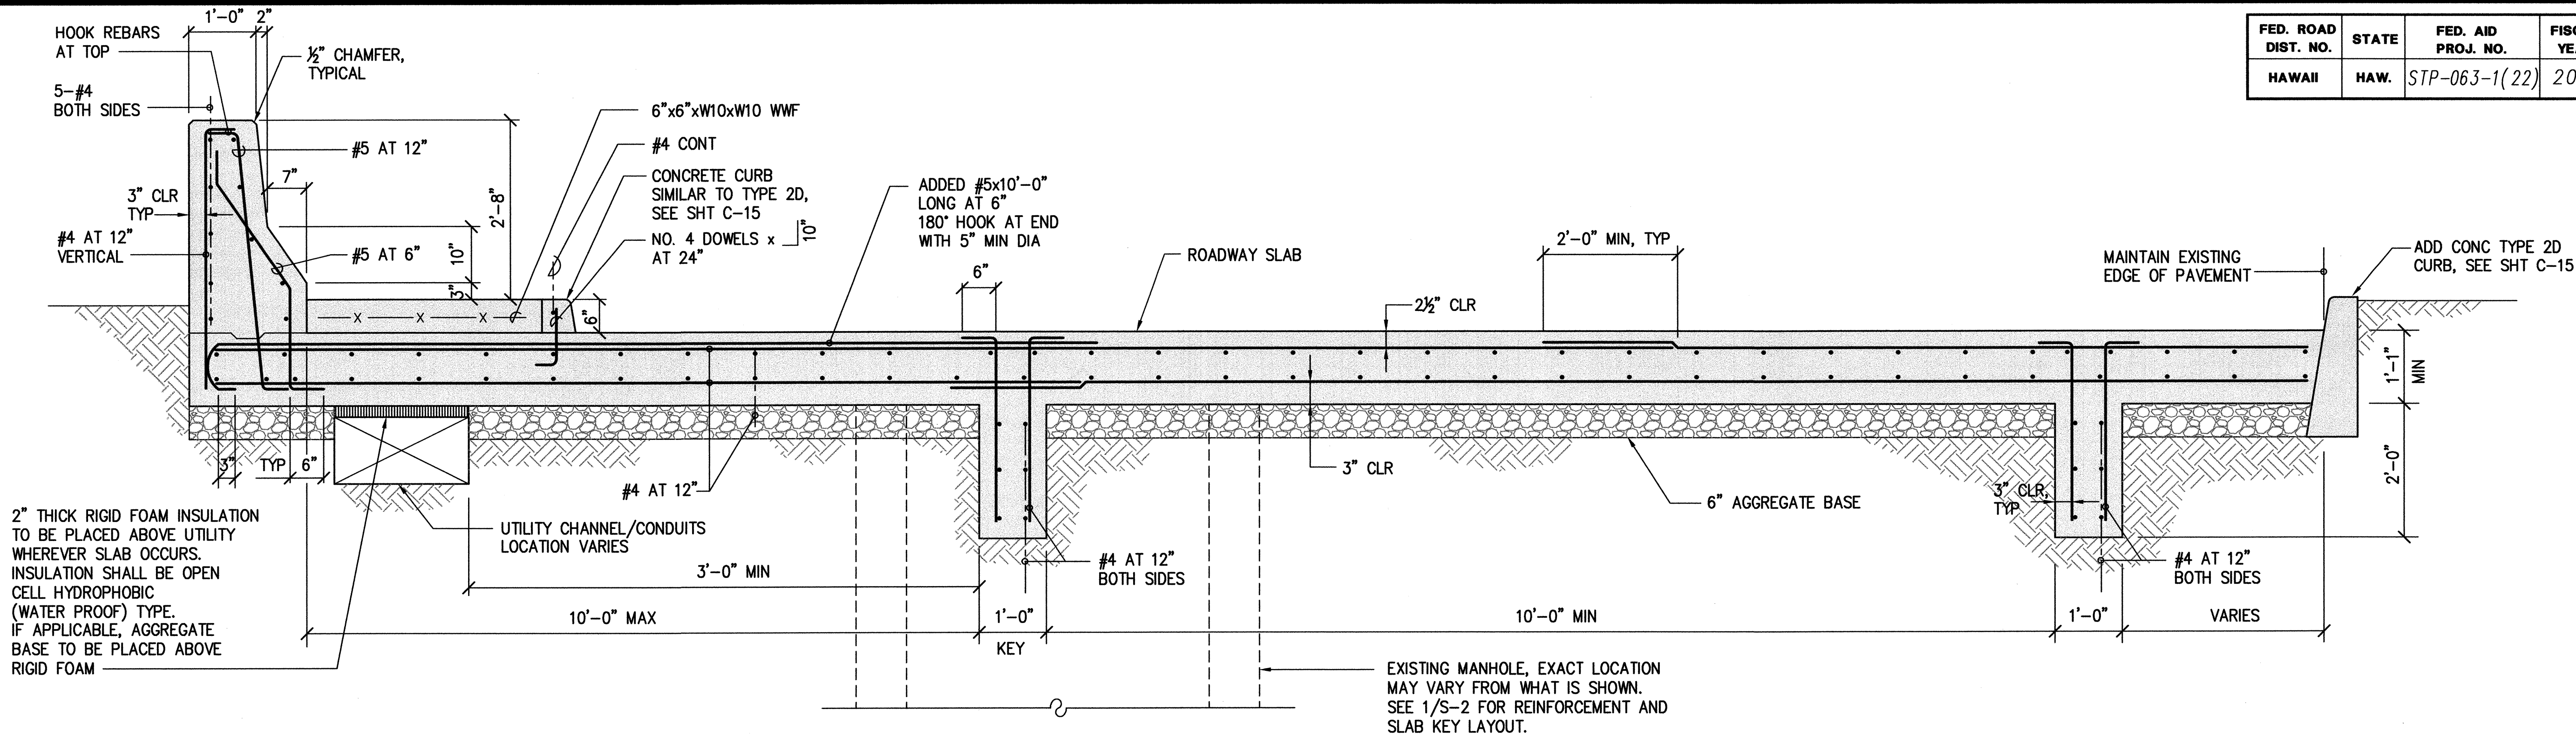

1 CONCRETE BARRIER/SLAB DETAIL
C-15/S-1 SCALE: 3/4" = 1'-0"

GENERAL:

- THE CONTRACTOR SHALL COMPARE ALL THE CONTRACT DOCUMENTS WITH EACH OTHER AND REPORT IN WRITING TO THE ENGINEER, ALL INCONSISTENCIES AND OMISSIONS.
- THE CONTRACTOR SHALL TAKE FIELD MEASUREMENTS AND VERIFY FIELD CONDITIONS AND SHALL COMPARE SUCH FIELD MEASUREMENTS AND CONDITIONS WITH THE DRAWINGS BEFORE COMMENCING WORK. REPORT IN WRITING TO THE ENGINEER, ALL INCONSISTENCIES AND OMISSIONS.
- THE CONTRACTOR SHALL BE RESPONSIBLE FOR COORDINATING THE WORK OF ALL TRADES.
- THE CONTRACTOR SHALL BE RESPONSIBLE FOR METHODS OF CONSTRUCTION, WORKMANSHIP AND JOB SAFETY. THE CONTRACTOR SHALL PROVIDE TEMPORARY SHORING AND BRACING AS REQUIRED FOR STABILITY OF STRUCTURAL MEMBERS AND SYSTEMS.
- THE CONTRACTOR SHALL PROVIDE TEMPORARY BARRIER WALL PROTECTION DURING CONSTRUCTION.
- THE CONTRACTOR SHALL BE RESPONSIBLE FOR PROTECTION OF THE ADJACENT PROPERTIES, STRUCTURES, STREETS AND UTILITIES DURING THE CONSTRUCTION PERIOD.
- DETAILS NOTED AS TYPICAL ON THE STRUCTURAL DRAWINGS SHALL APPLY IN ALL CONDITIONS, UNLESS SPECIFICALLY SHOWN OR NOTED.

FOUNDATION:

- FOUNDATION DESIGN IS BASED ON GEOTECHNICAL REPORT (ONE PAGE FACSIMILE TRANSMITTAL) DATED NOVEMBER 14, 2002.
- CONTRACTOR SHALL PROVIDE FOR DE-WATERING OF EXCAVATION FROM SURFACE WATER, GROUND WATER OR SEEPAGE.
- CONTRACTOR SHALL PROVIDE FOR DESIGN AND INSTALLATION OF ALL CRIBBING, SHEETING AND SHORING NECESSARY TO PRESERVE EXCAVATIONS AND EARTH BANKS.
- FOOTINGS AND BARRIER WALLS SHALL BEAR ON UNDISTURBED, IN-SITU FIRM SOILS. IF SOFT AND/OR LOOSE MATERIALS ARE ENCOUNTERED AT THE BOTTOM OF EXCAVATIONS, THEY SHALL BE OVER-EXCAVATED TO EXPOSE THE UNDERLYING FIRM MATERIALS. ALL STRUCTURAL BACKFILL SHALL BE COMPACTED TO A MINIMUM OF 95% RELATIVE COMPACTION.

CONCRETE:

- CONCRETE CONSTRUCTION SHALL CONFORM TO AMERICAN CONCRETE INSTITUTE ACI 318R-95.
- CONCRETE SHALL BE REGULAR WEIGHT HARD ROCK CONCRETE AND SHALL HAVE THE FOLLOWING MINIMUM 28 DAY COMPRESSIVE STRENGTHS:
 - BARRIER WALLS 4,000 PSI
 - DRILLED SHAFTS 4,000 PSI
 - LIGHT POLE FOUNDATION 4,000 PSI
- CONCRETE DELIVERY TICKETS SHALL RECORD ALL FREE WATER IN THE MIX: AT BATCHING BY PLANT, FOR CONSISTENCY BY DRIVER AND ANY ADDITIONAL REQUEST BY CONTRACTOR IF PERMITTED BY THE MIX DESIGN.
- REINFORCING BARS, ANCHOR RODS, INSERTS AND OTHER ITEMS TO BE CAST IN THE CONCRETE SHALL BE SECURED IN POSITION PRIOR TO PLACEMENT OF CONCRETE.
- NON-SHRINK GROUTS SHALL BE PREMIXED COMPOUND CONSISTING OF NON-METALLIC AGGREGATE AND NON-STANDING TYPES, CEMENT, WATER REDUCING AND PLASTICIZING AGENTS CAPABLE OF DEVELOPING MINIMUM COMPRESSIVE STRENGTH OF 4,000 PSI IN 3 DAYS AND 7,000 PSI IN 28 DAYS.
- CHAMFER ALL BARRIER WALL EDGES 1".

REINFORCING STEEL:


- REINFORCING STEEL SHALL BE DEFORMED BARS CONFORMING TO ASTM A615, GRADE 60.
- CLEAR CONCRETE COVER FOR REINFORCING BARS SHALL BE AS FOLLOWS, UNLESS OTHERWISE NOTED:
 - FOOTINGS, SLABS, ETC. CAST AGAINST EARTH 3"
 - WALLS
 - FACES EXPOSED TO WEATHER 2"
- REINFORCING STEEL SHALL BE SPLICED WHERE INDICATED ON PLANS. PROVIDE LAP SPLICE LENGTH PER TYPICAL DETAILS AND SCHEDULE, UNLESS OTHERWISE NOTED.
- BAR BENDS AND HOOKS SHALL BE "STANDARD HOOKS" IN ACCORDANCE WITH ACI 318-95.

SOIL PROPERTIES:


- ALLOWABLE BEARING CAPACITY 3000 psf
- COEFFICIENT OF FRICTION 0.40
- PASSIVE PRESSURE 300 pcf

DESIGN CRITERIA:

- CONCRETE BARRIERS AASHTO TL-4

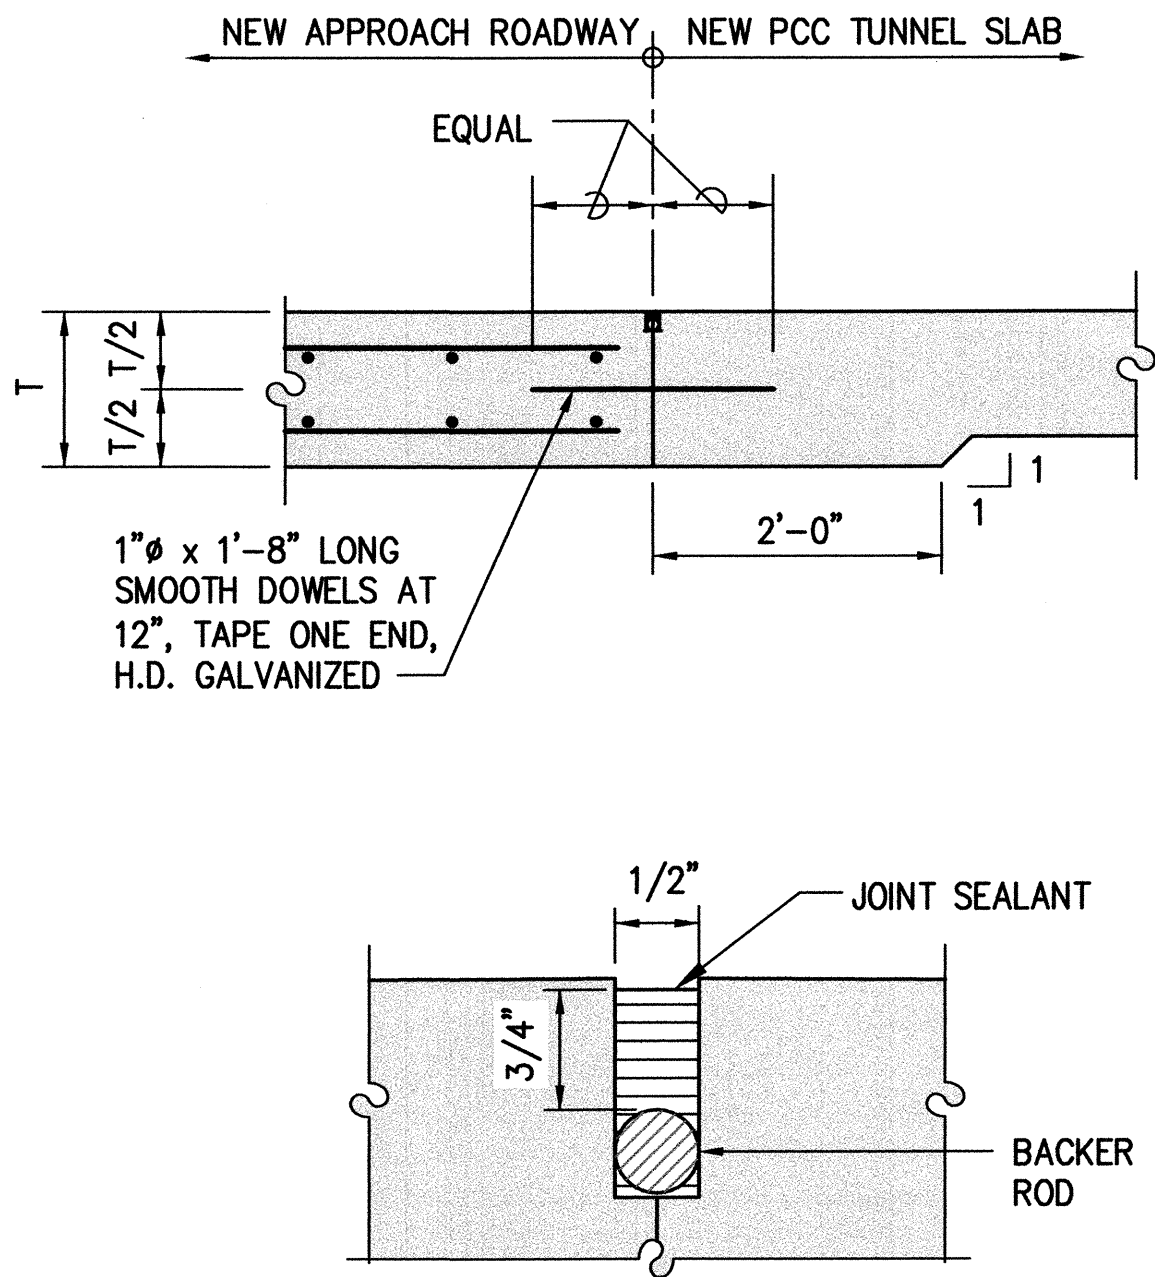

2 SLAB JOINT DETAIL AT TUNNEL ENTRANCE
S-1/S-1 NOT TO SCALE

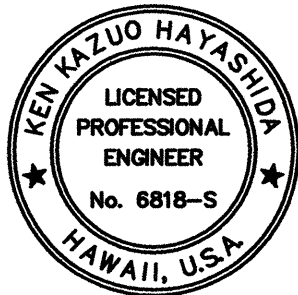

THIS WORK WAS PREPARED BY ME OR UNDER MY SUPERVISION AND CONSTRUCTION OF THIS PROJECT WILL BE UNDER MY OBSERVATION.

SIGNATURE
EXPIRATION DATE OF THE LICENSE

STATE OF HAWAII

DEPARTMENT OF TRANSPORTATION

HIGHWAYS DIVISION

CONC BARRIER DETAILS

LIKELIKE HIGHWAY

Wilson Tunnel Improvements

Leak and Crack Remediation

F. A. Project No. STP-063-1(22)

Scale: As Shown


Date: April 24, 2003

SHEET No. S-1 OF 5


SHEETS

ORIGINAL PLAN	SURVEY PLOTTED BY	DATE
TRACED BY	DRAWN BY	
DESIGNED BY	NOTED BY	
CHECKED BY	NO.	

FED. ROAD DIST. NO.	STATE	FED. AID PROJ. NO.	FISCAL YEAR	SHEET NO.	TOTAL SHEETS
HAWAII	HAW.	STP-063-1(22)	2003		69

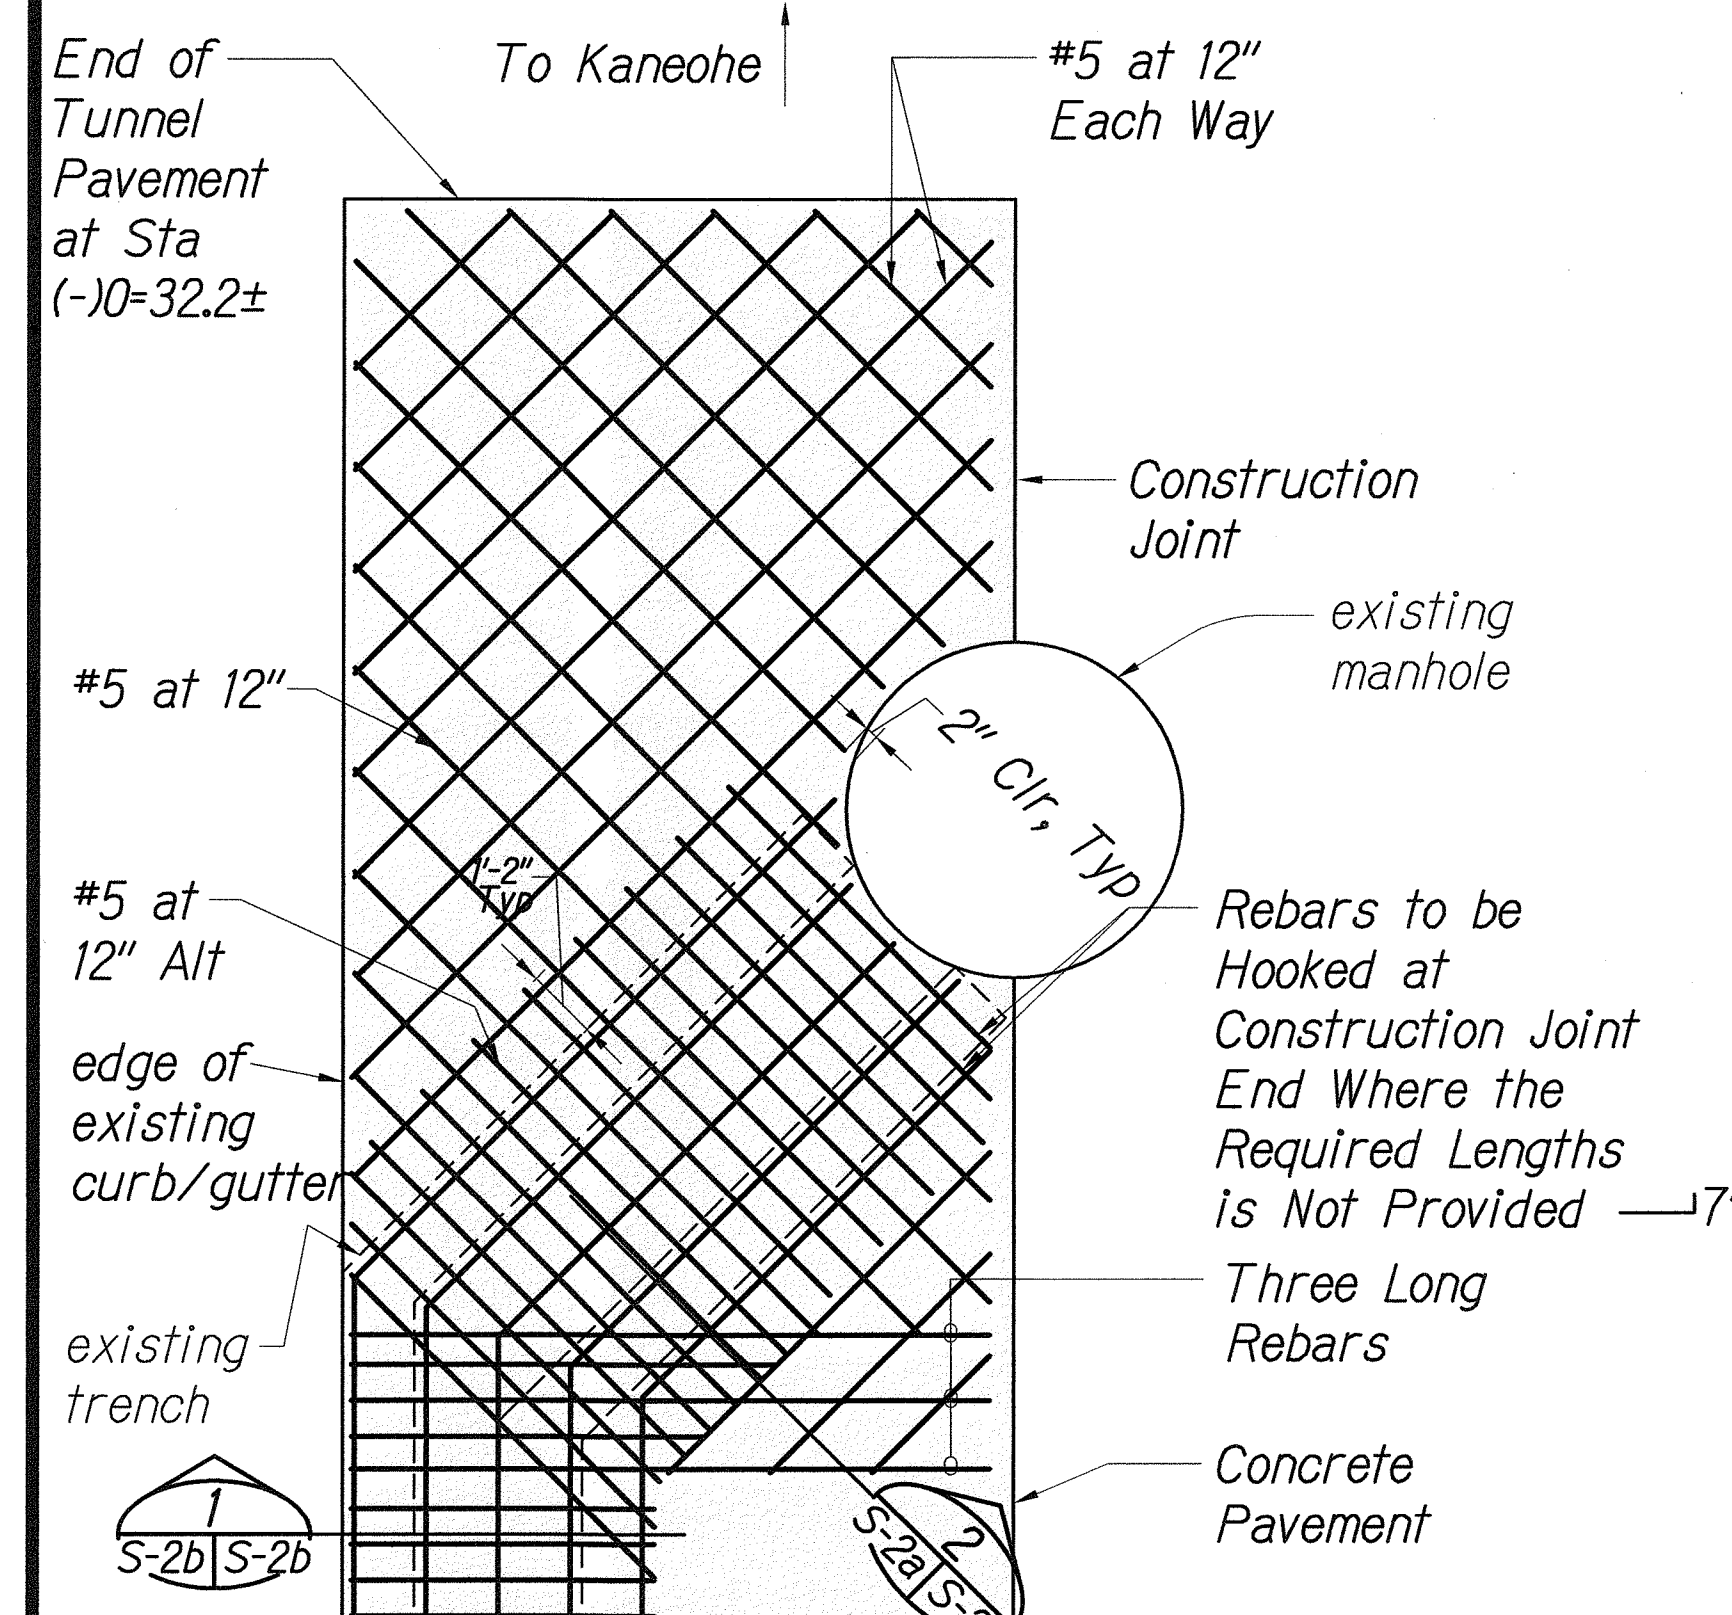


SLAB REINF AT DRAIN MANHOLE 1
Not To Scale S-2a S-2a

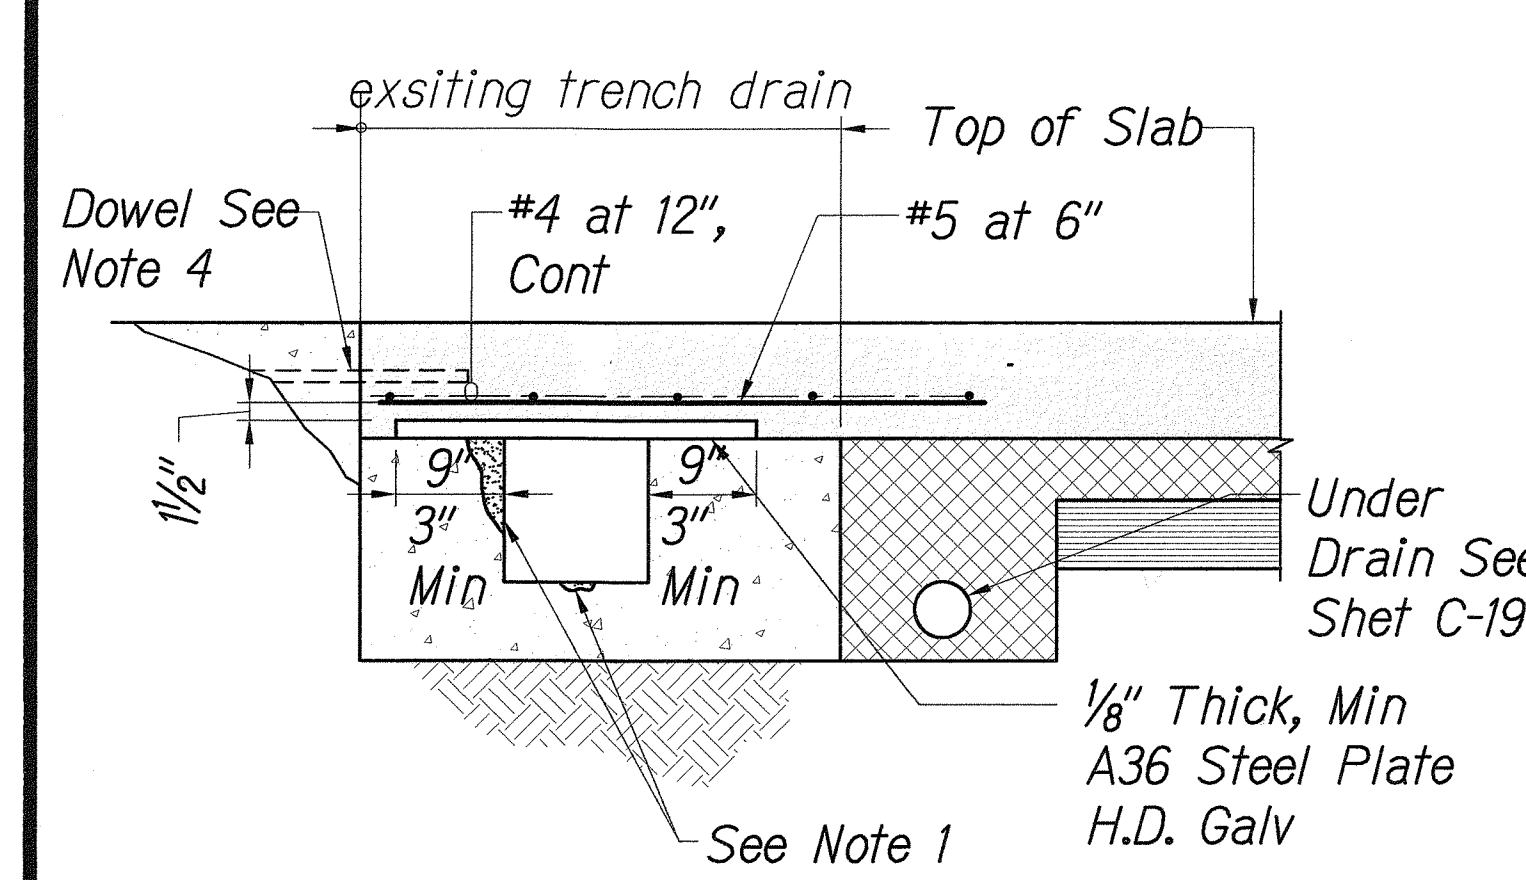



- Notes:**
- Contractor shall patch the trench wall or invert if they are damaged during the demolition of existing slab for detail see 3 and 4 S-2b S-2b and S-2b S-2b
 - Existing roadway rebar embedded into the trench wall shall be cut as shown in detail 2 S-2b S-2b
 - For steel plate support width less than 3" see 5 S-2b S-2b
 - For dowels detail and spacing see sht C-21.
 - Contractor shall remove concrete on top of trench wall to provide the slab min thickness as shown in detail.

TRENCH COVER SLAB DETAIL 4
Not To Scale S-2a S-2a

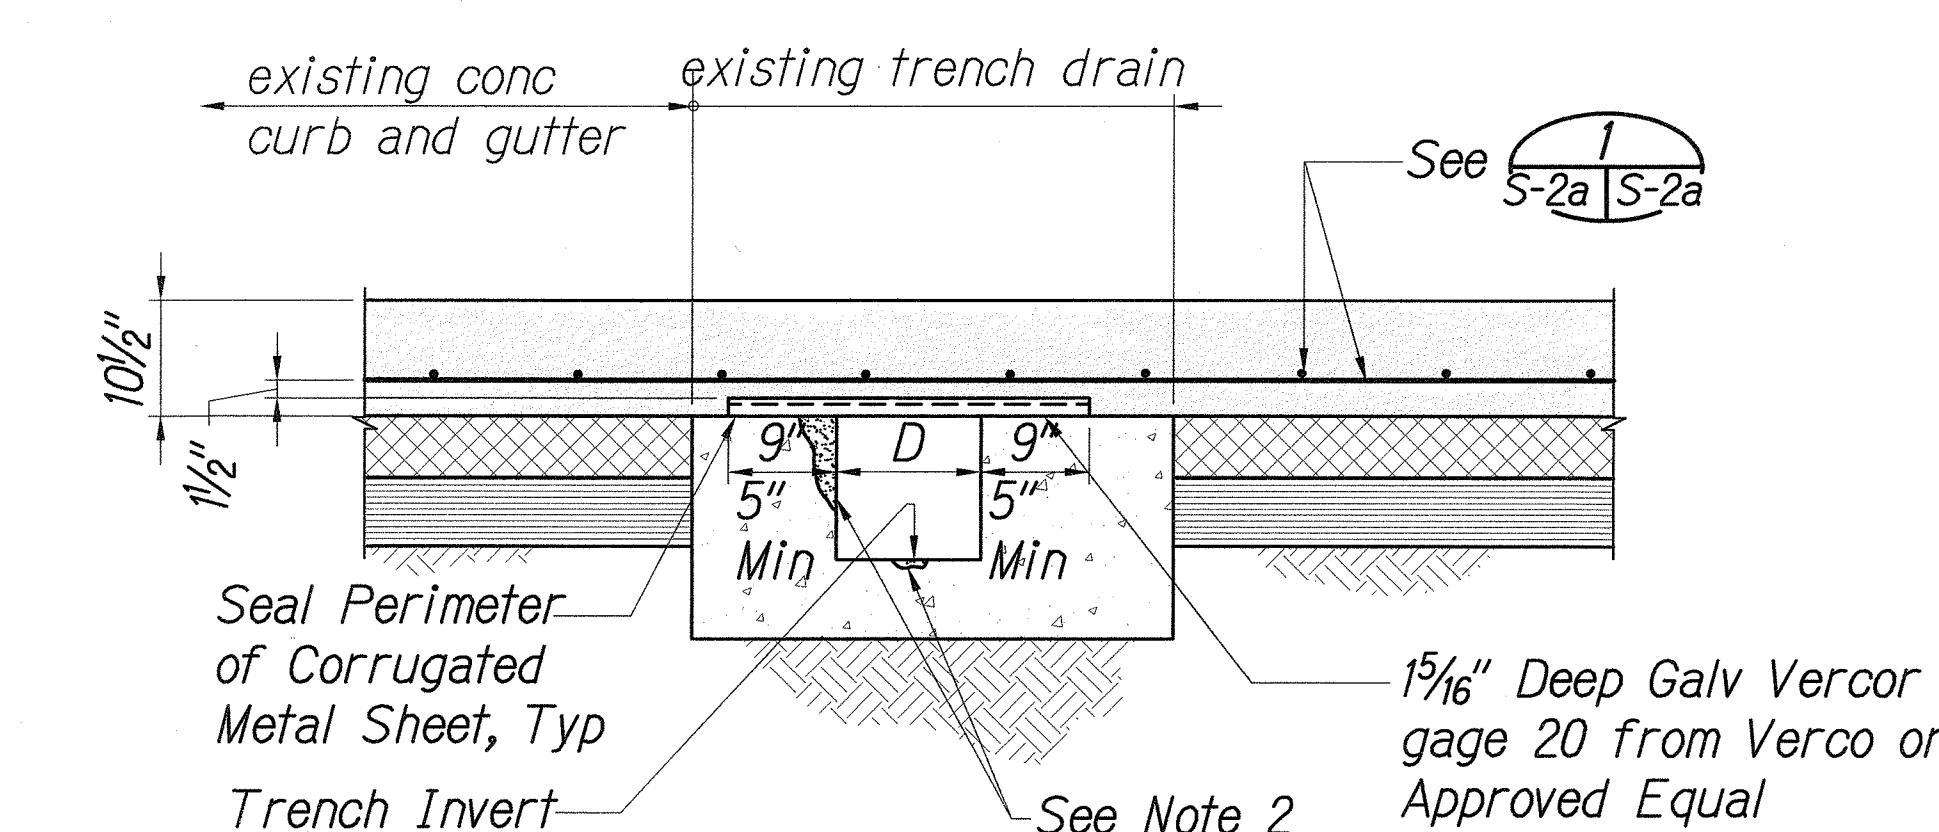


- Notes:**
- Contractor shall secure the corrugated metal sheet prior to pouring concrete.
 - Contractor shall patch the trench wall or invert if they are damaged during the demolition of existing slab for detail see 3 and 4 S-2b S-2b and S-2b S-2b
 - Existing roadway rebar embedded into the trench wall shall be cut as shown 2 S-2b S-2b
 - Contractor shall remove concrete on top of trench wall to provide the slab min thickness as shown in detail.


TRENCH COVER SLAB DETAIL AT KANEOHE SIDE 2
Not To Scale S-2a S-2a

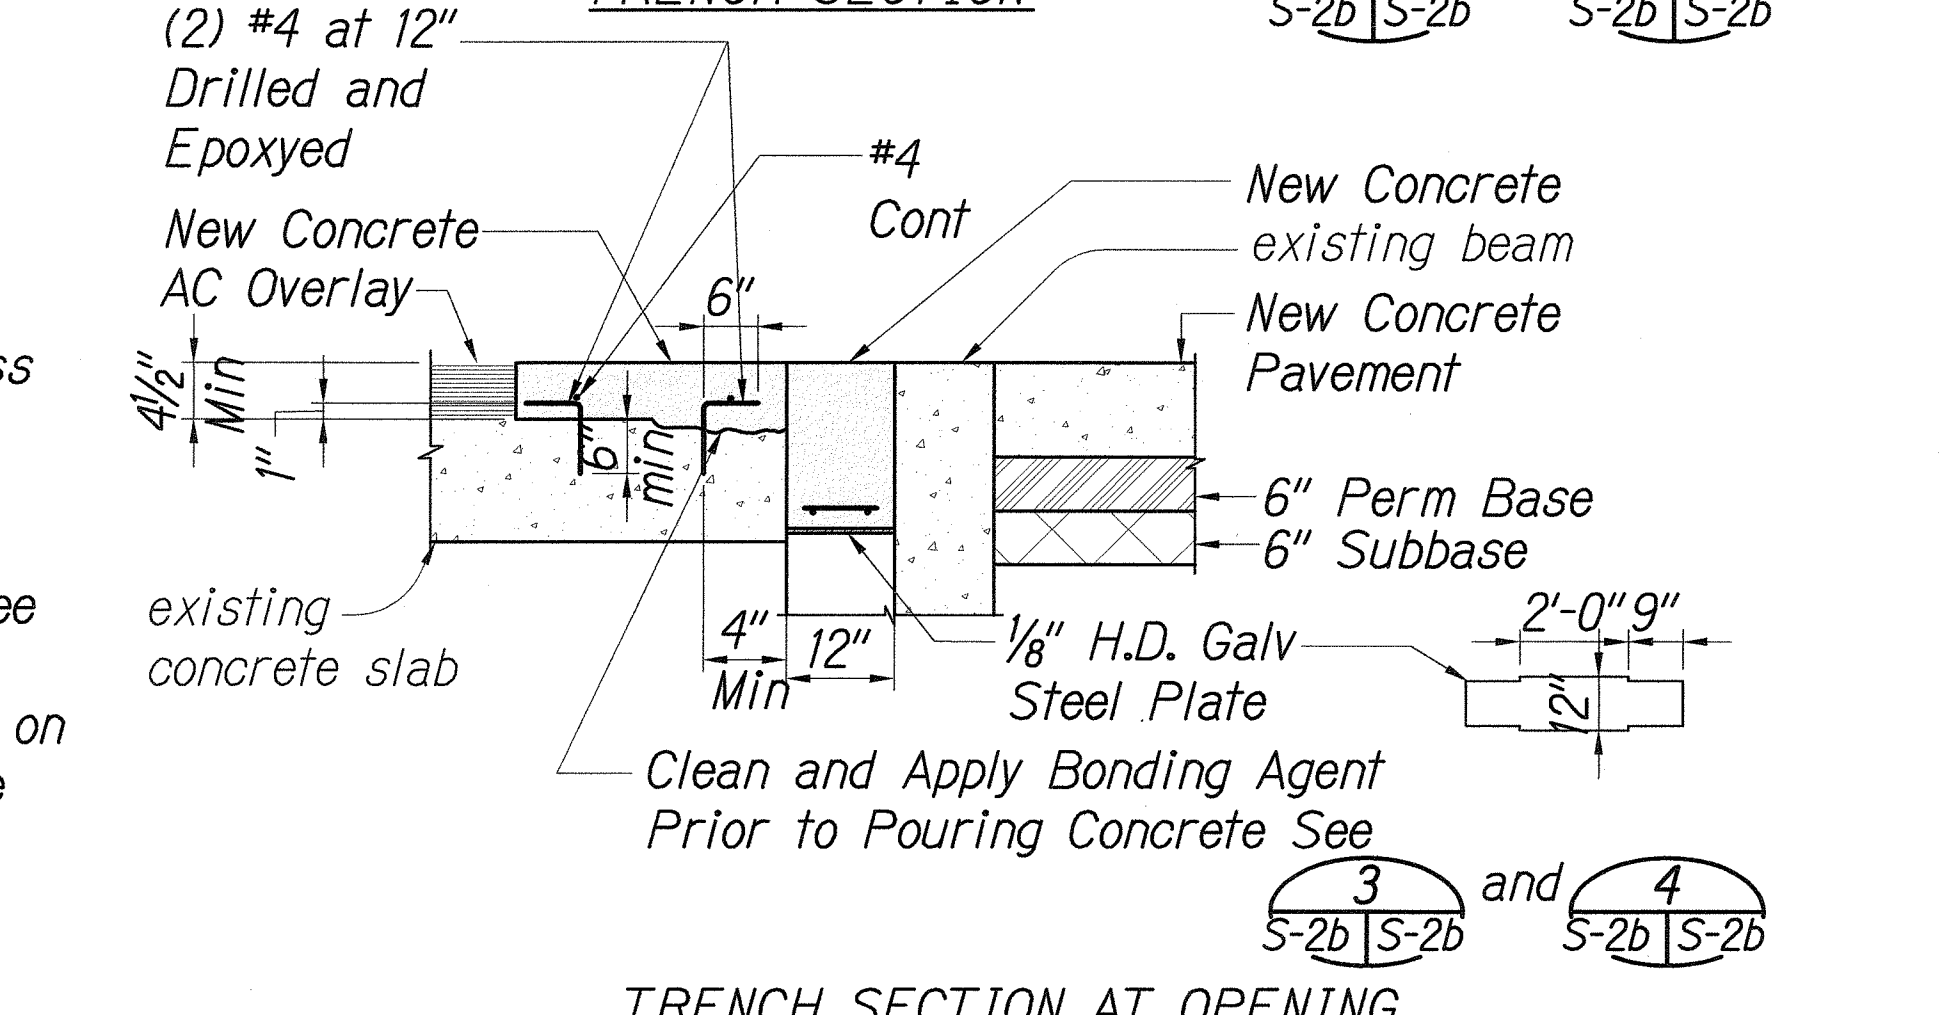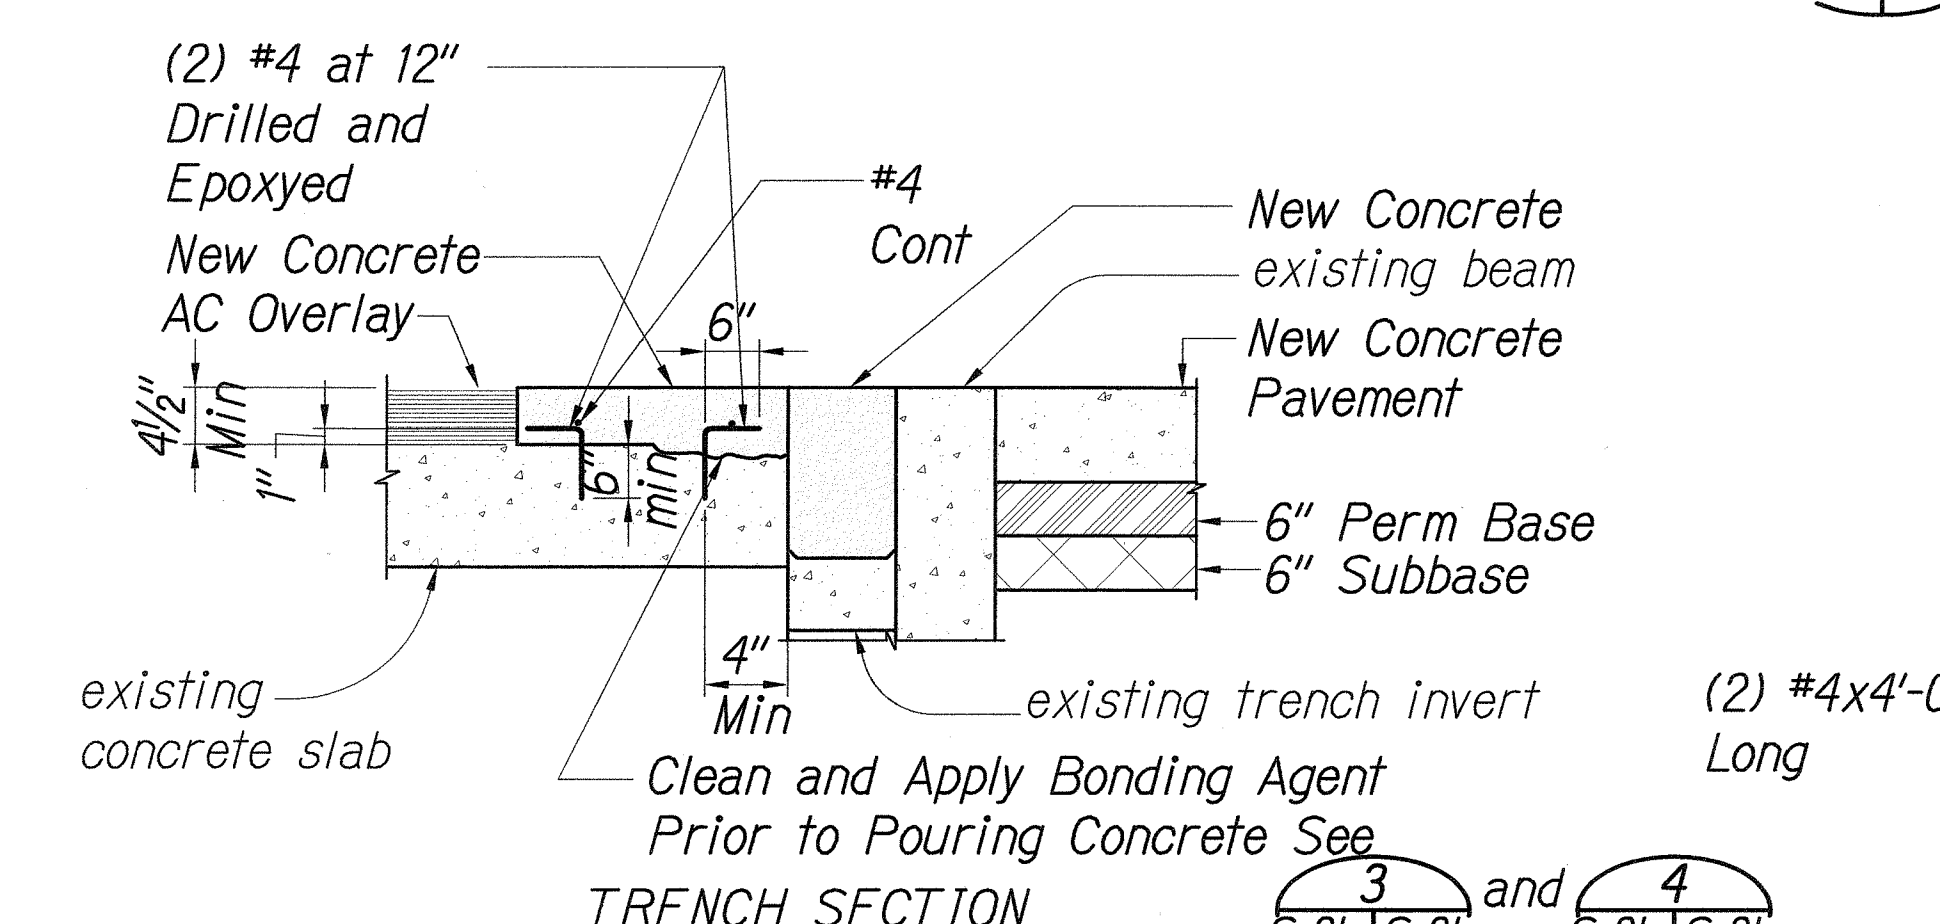



TRENCH FILLING DETAIL AT STA. 242+00 5
Not To Scale S-2a S-2a

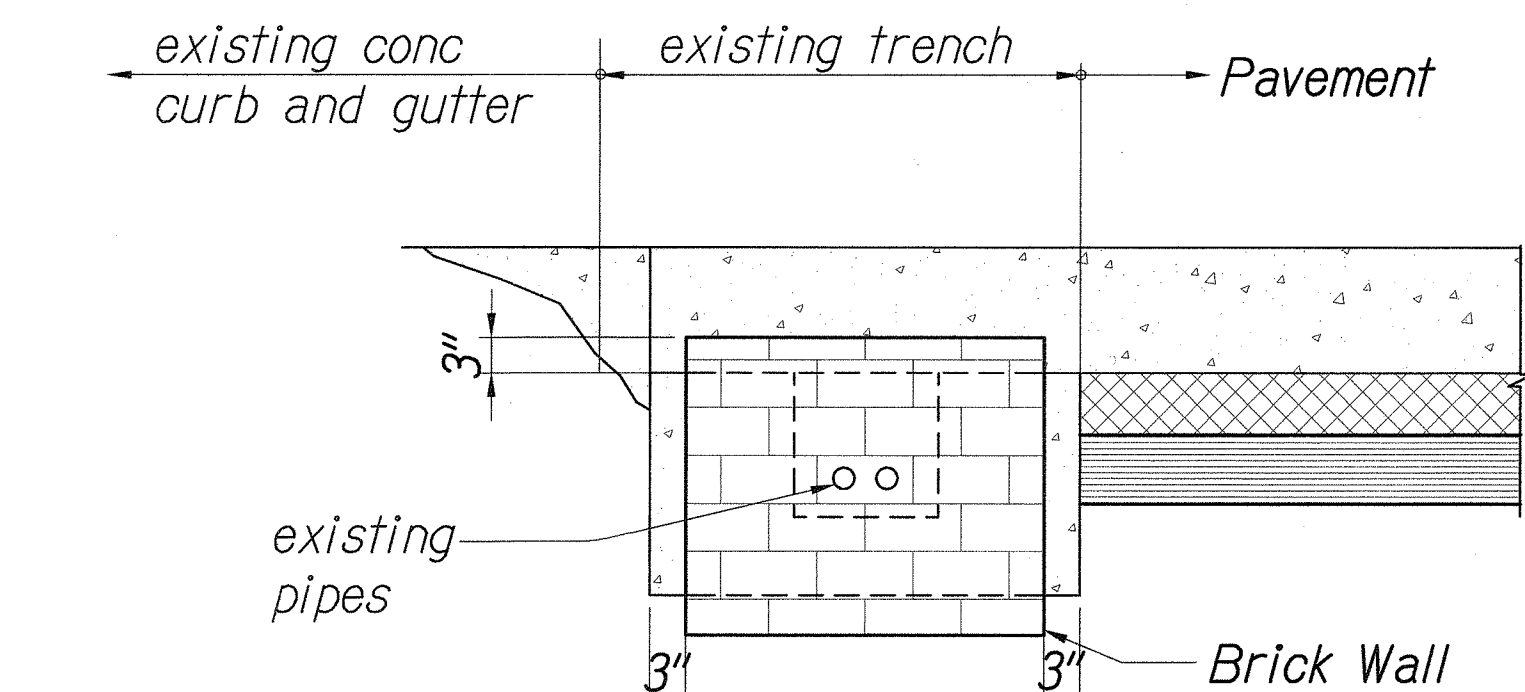

TRENCH INLET CAP DETAIL 3
Not To Scale S-2a S-2a

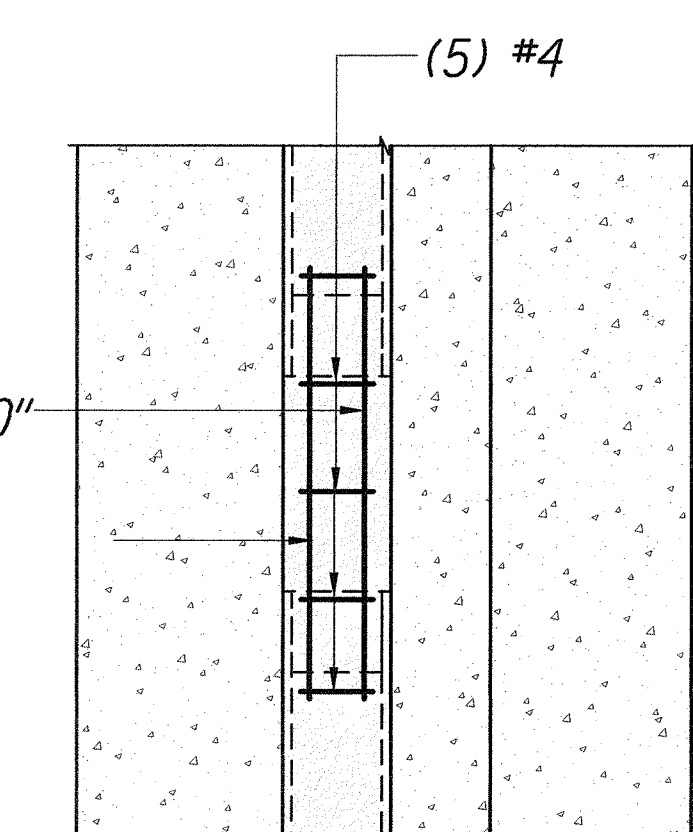

TRENCH FILLING DETAIL AT STA. 242+00 6
Not To Scale S-2a S-2a

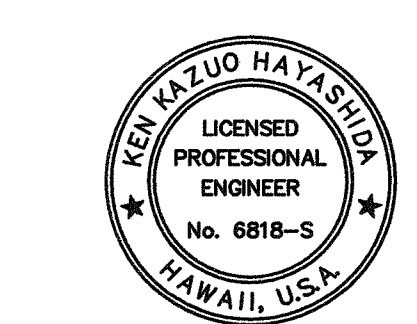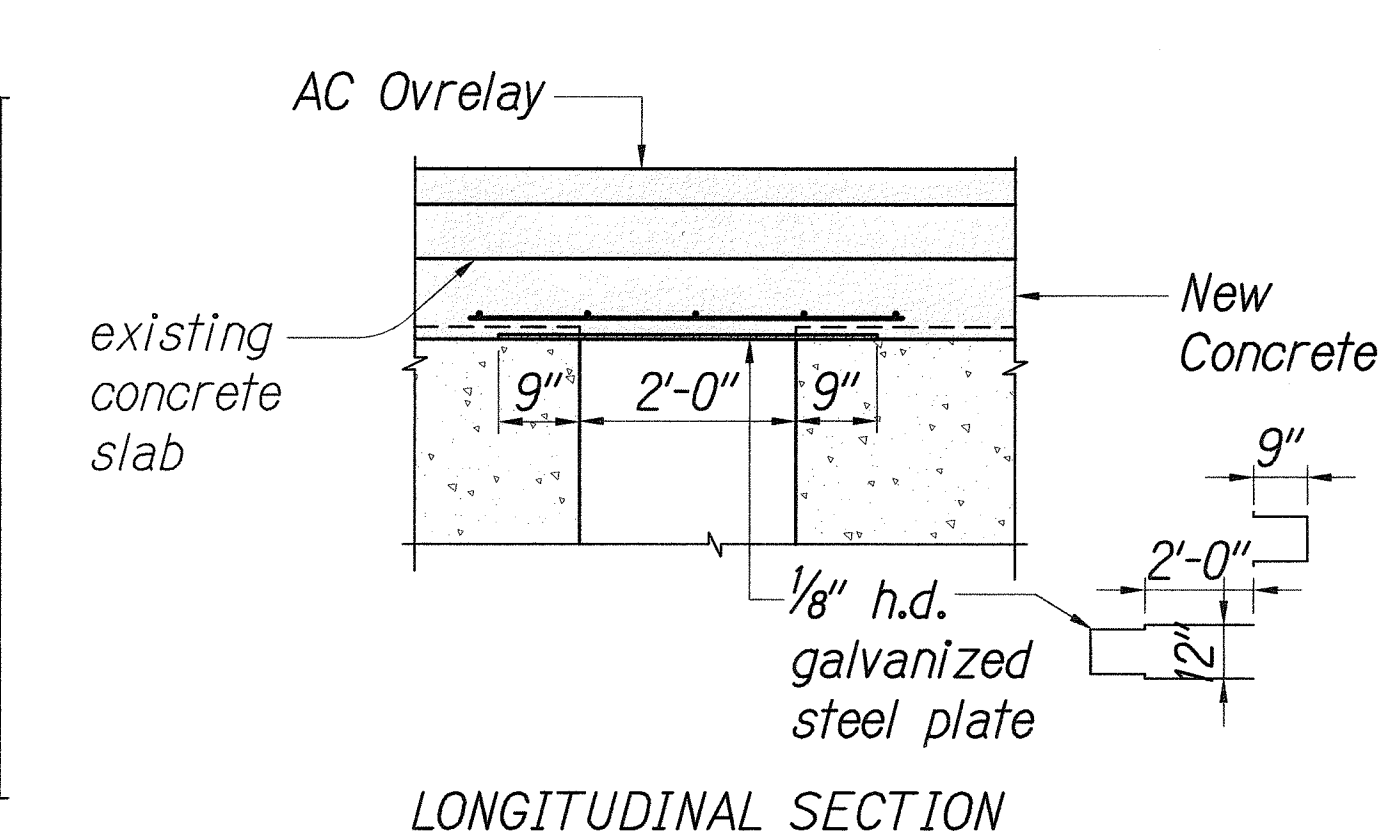

THIS WORK WAS PREPARED BY ME OR UNDER MY SUPERVISION AND CONSTRUCTION OF THIS PROJECT WILL BE UNDER MY OBSERVATION.

April 30, 2004
EXPIRATION DATE OF THE LICENSE
SIGNATURE

STATE OF HAWAII
DEPARTMENT OF TRANSPORTATION
HIGHWAYS DIVISION


CONC BARRIER DETAILS

LIKELIKE HIGHWAY
Wilson Tunnel Improvements
Leak and Crack Remediation
F. A. Project No. STP-063-1(22)

Scale: As Shown Date: April 24, 2003

SHEET No. S-2a OF 9 SHEETS


FED. ROAD DIST. NO.	STATE	FED. AID PROJ. NO.	FISCAL YEAR	SHEET NO.	TOTAL SHEETS
HAWAII	HAW.	STP-063-1(22)	2003		69

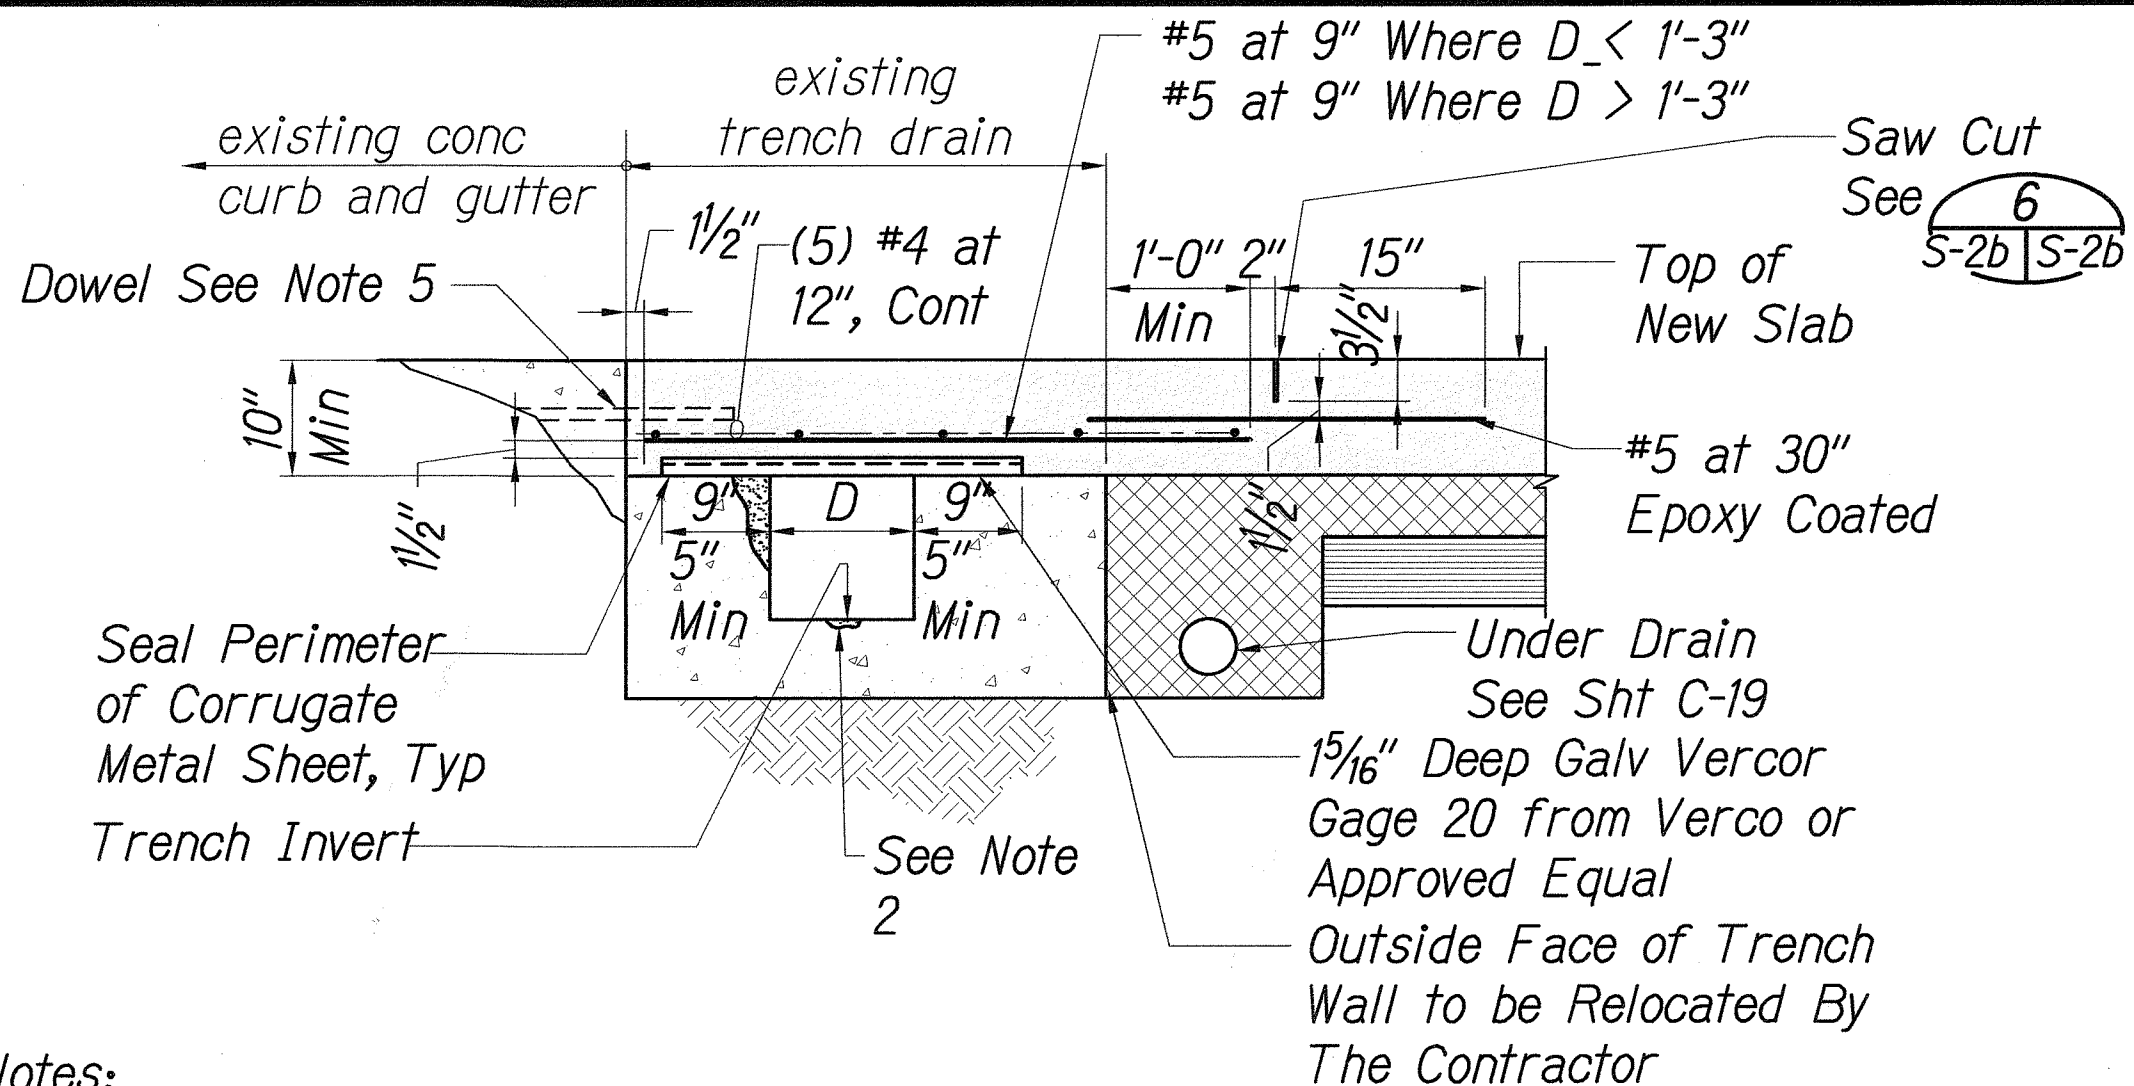

Notes:

- Contractor shall secure the corrugated metal sheet prior to pouring concrete.
- Contractor shall patch the trench wall or invert if they are damaged during the demolition of existing slab for detail see 3 and 4 S-2b S-2b
- Existing roadway rebars embedded into the trench wall shall be cut as shown 2 S-2b S-2b
- For corrugated metal support width less than see 5 S-2b S-2b
- For dowels detail and spacing see sht C-21.
- Contractor shall remove concrete on top of trench wall to provide the slab min thickness as shown in detail.


TRENCH COVER SLAB DETAIL 1
Not To Scale S-2b S-2b

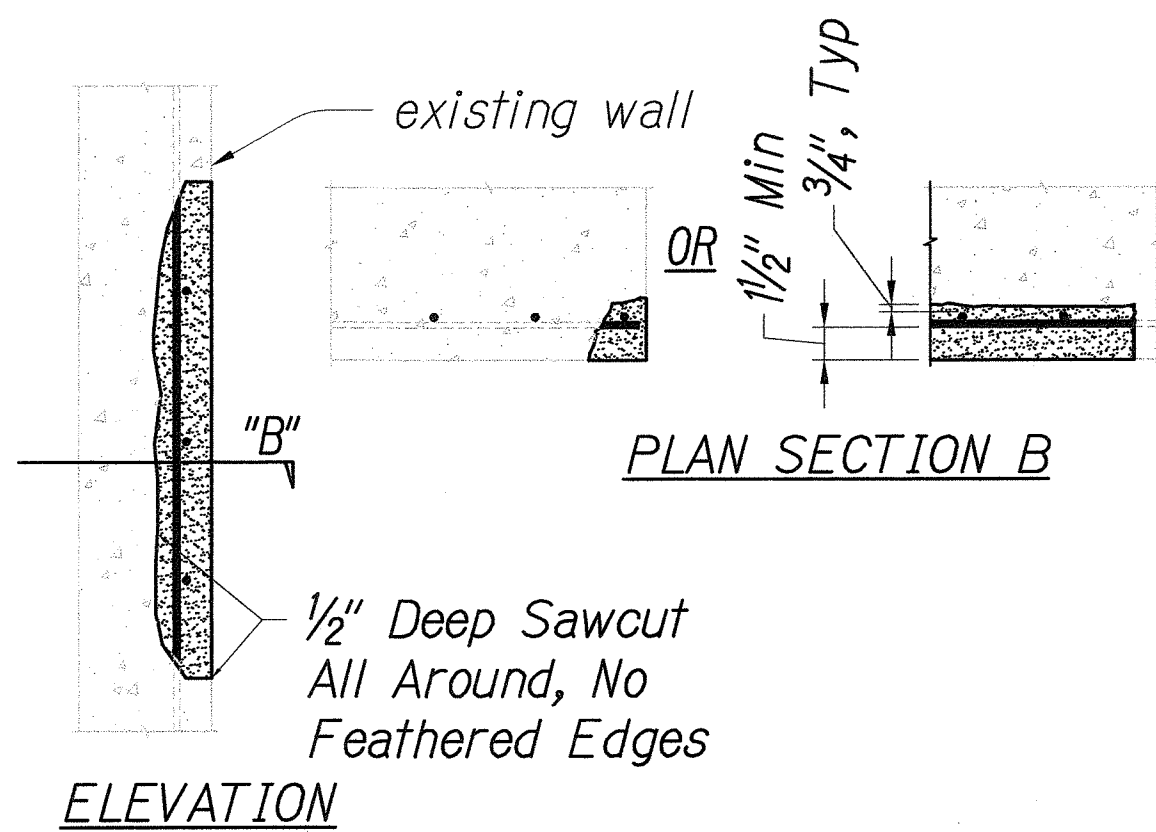

Type II Spall Repair Notes:

- clean and prepare concrete according to the surface preparation notes.
- Clean any exposed reinforcement by sand-blasting or with a wire brush, removing all corrosion, oil, dirt corrosion, dirt and all other bond-inhibiting agents.
- Substrate shall be saturated surface dry (SSD) with no standing water.
- Apply corrosion inhibiting bonding agent to all surface to be patched, including reinforcing steel.
- Apply polymer modified patching mortar as recommended by manufacturer to repair areas to original finish lines, or until a minimum of 1/2 inch of cover over reinforcing steel is obtained.


PATCHING DETAIL TYPE II 4
Not To Scale S-2b S-2b

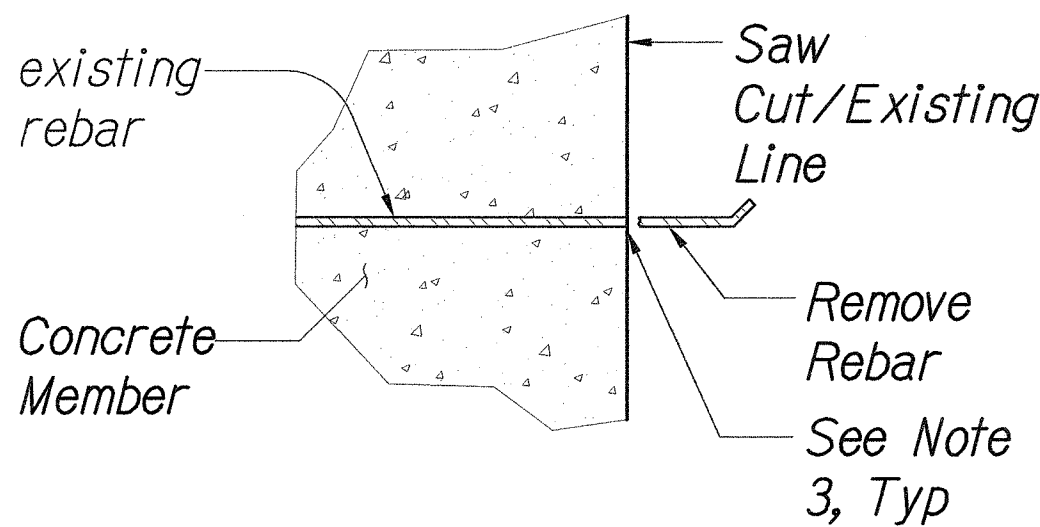

Notes:

- Cut off existing rebar flush with wall surface.
- Clean cavity of all loose concrete, dust, and all other bond inhibiting material.
- Apply rust inhibitor coating over the exposed rebars before placing corrugated metal sheet concrete slab.
- Rust inhibitor coating shall be a coat of rust-cleum 9369 epoxy primer and a coat of rust-cleum 9400 system rust-o-thane coating. Contractor may use equal rust inhibitor coating upon the approval of the engineer.

EXISTING REBAR CUTTING DETAIL 2
Not To Scale S-2b S-2b

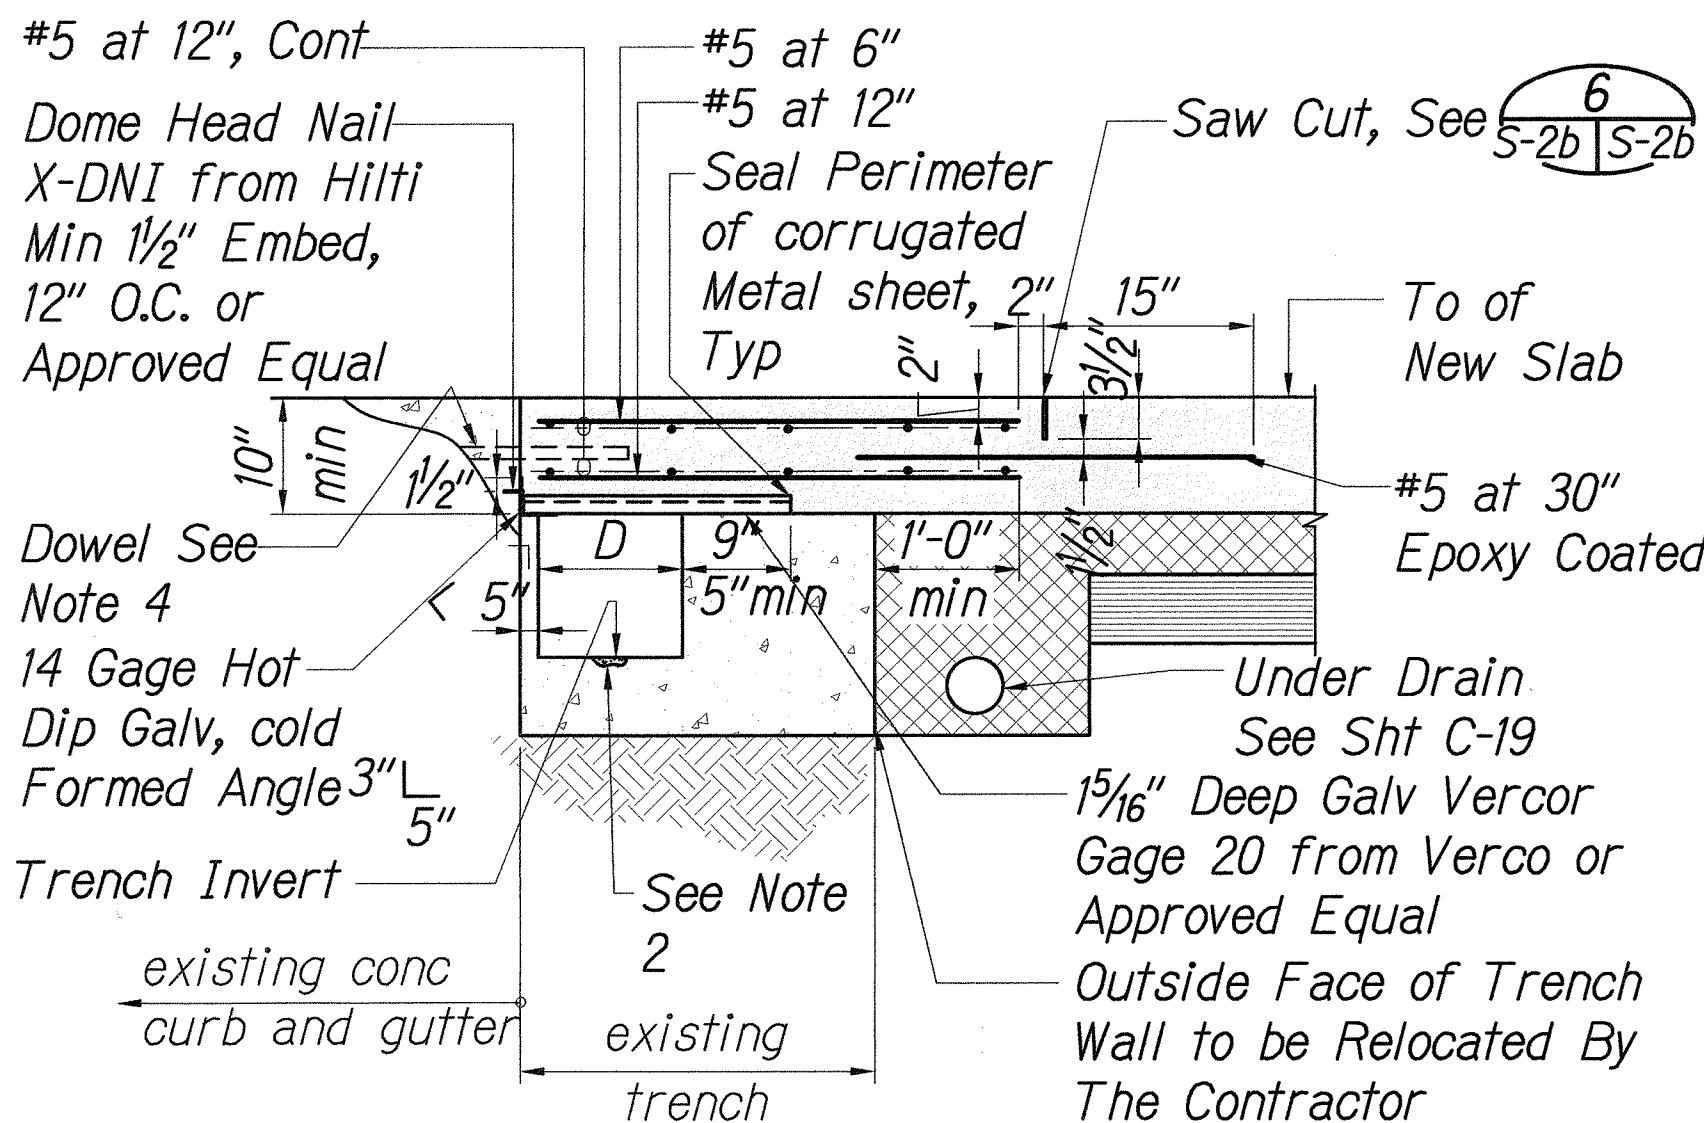


Notes:

- Contractor shall secure the corrugated metal sheet prior to pouring concrete.
- Contractor shall patch the trench wall or invert if they are damaged during the demolition of existing slab for detail see 3 and 4 S-2b S-2b
- Existing roadway rebars embedded into the trench wall shall be cut as shown 2 S-2b S-2b
- For dowels detail and spacing see sht C-21.
- Contractor shall remove concrete on top of trench wall to provide the slab min thickness as shown in detail.

TRENCH COVER SLAB DETAIL 5
Not To Scale S-2b S-2b

Surface Preparation Notes for Spall Repairs:

- Deteriorated concrete shall be removed down to sound substrate, or to the specified depth as noted in the spall repair details. Sawcut all edges 1/2 inch min, no feathering of patching material is allowed. Avoid cutting any reinforcing steel when sawcutting. the exposed concrete shall be roughened to a 1/8 inch min amplitude and shall be cleaned and free of laitance, dust, and other bond inhibiting materials.
- A means of collecting spoils from the chipping of concrete shall be instituted to avoid any debris or construction materials from falling into the drainage system. If the contractor elects to use hydro-scarification equipment, he/she shall be responsible for collecting and properly disposing of the runoff water generated. Run off water will not be allowed to enter into the drainage system, or to constitute a hazard to adjacent drainage areas nor be allowed to erode existing slopes.
- All reinforcing steel damaged due to the contractor's operations shall be repaired by the contractor at his/her expense.

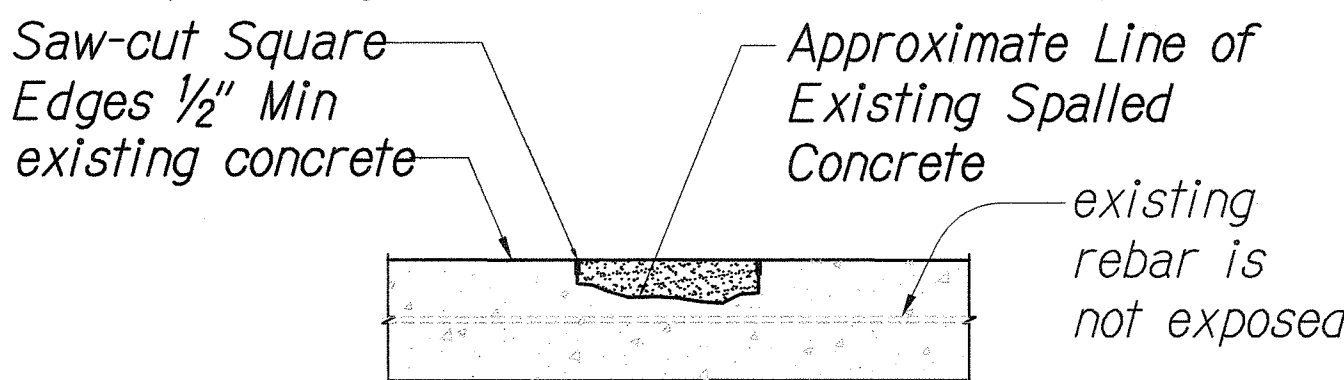


Notes:

- Clean and prepare concrete according to the surface perparation notes.
- Substrate shall be saturated dry (SSD) with no standing water.
- Apply corrosion inhibiting bonding agent to all surfaces to be patched.
- Apply polymer modified patching mortar as recommended by manufacturer to repair areas to original finish lines, or until a minimum of 1/2 inch of cover over reinforcing steel is obtained.

PATCHING DETAIL TYPE I 3
Not To Scale S-2b S-2b

LEGEND FOR AS-BUILT POSTINGS	
	Squiggly line for as-built deletion
	Double line for as-built deletion
Roadway	Text for as-built posting

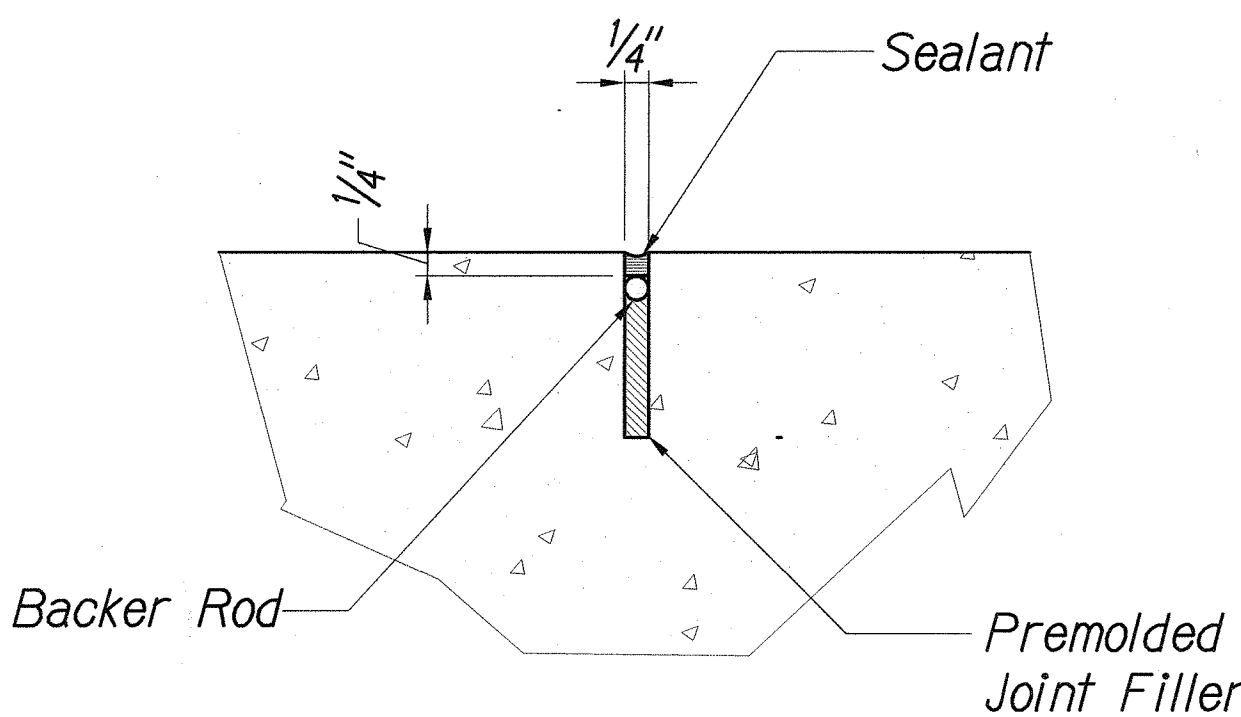

SAW CUTTING DETAIL 6
Not To Scale S-2b S-2b



THIS WORK WAS PREPARED BY ME OR UNDER MY SUPERVISION AND CONSTRUCTION OF THIS PROJECT WILL BE UNDER MY OBSERVATION.

SIGNATURE April 30, 2004 EXPIRATION DATE OF THE LICENSE

STATE OF HAWAII
DEPARTMENT OF TRANSPORTATION
HIGHWAYS DIVISION

CONC BARRIER DETAILS
LIKELIKE HIGHWAY
Wilson Tunnel Improvements
Leak and Crack Remediation
F. A. Project No. STP-063-1(22)
Scale: As Shown Date: April 24, 2003


SHEET No. S-2b OF 9 SHEETS

DATE	_____
SURVEY PLOTTED BY	_____
DRAWN BY	_____
DESIGNED BY	_____
QUANTITIES BY	_____
CHECKED BY	_____
ORIGINAL PLAN	_____
NOTE BOOK	_____
No.	_____

"AS-BUILT"


C.O. 65 S-2

FED. ROAD DIST. NO.	STATE	FED. AID PROJ. NO.	FISCAL YEAR	SHEET NO.	TOTAL SHEETS
HAWAII	HAW.	STP-063-1(22)	2003	66	69

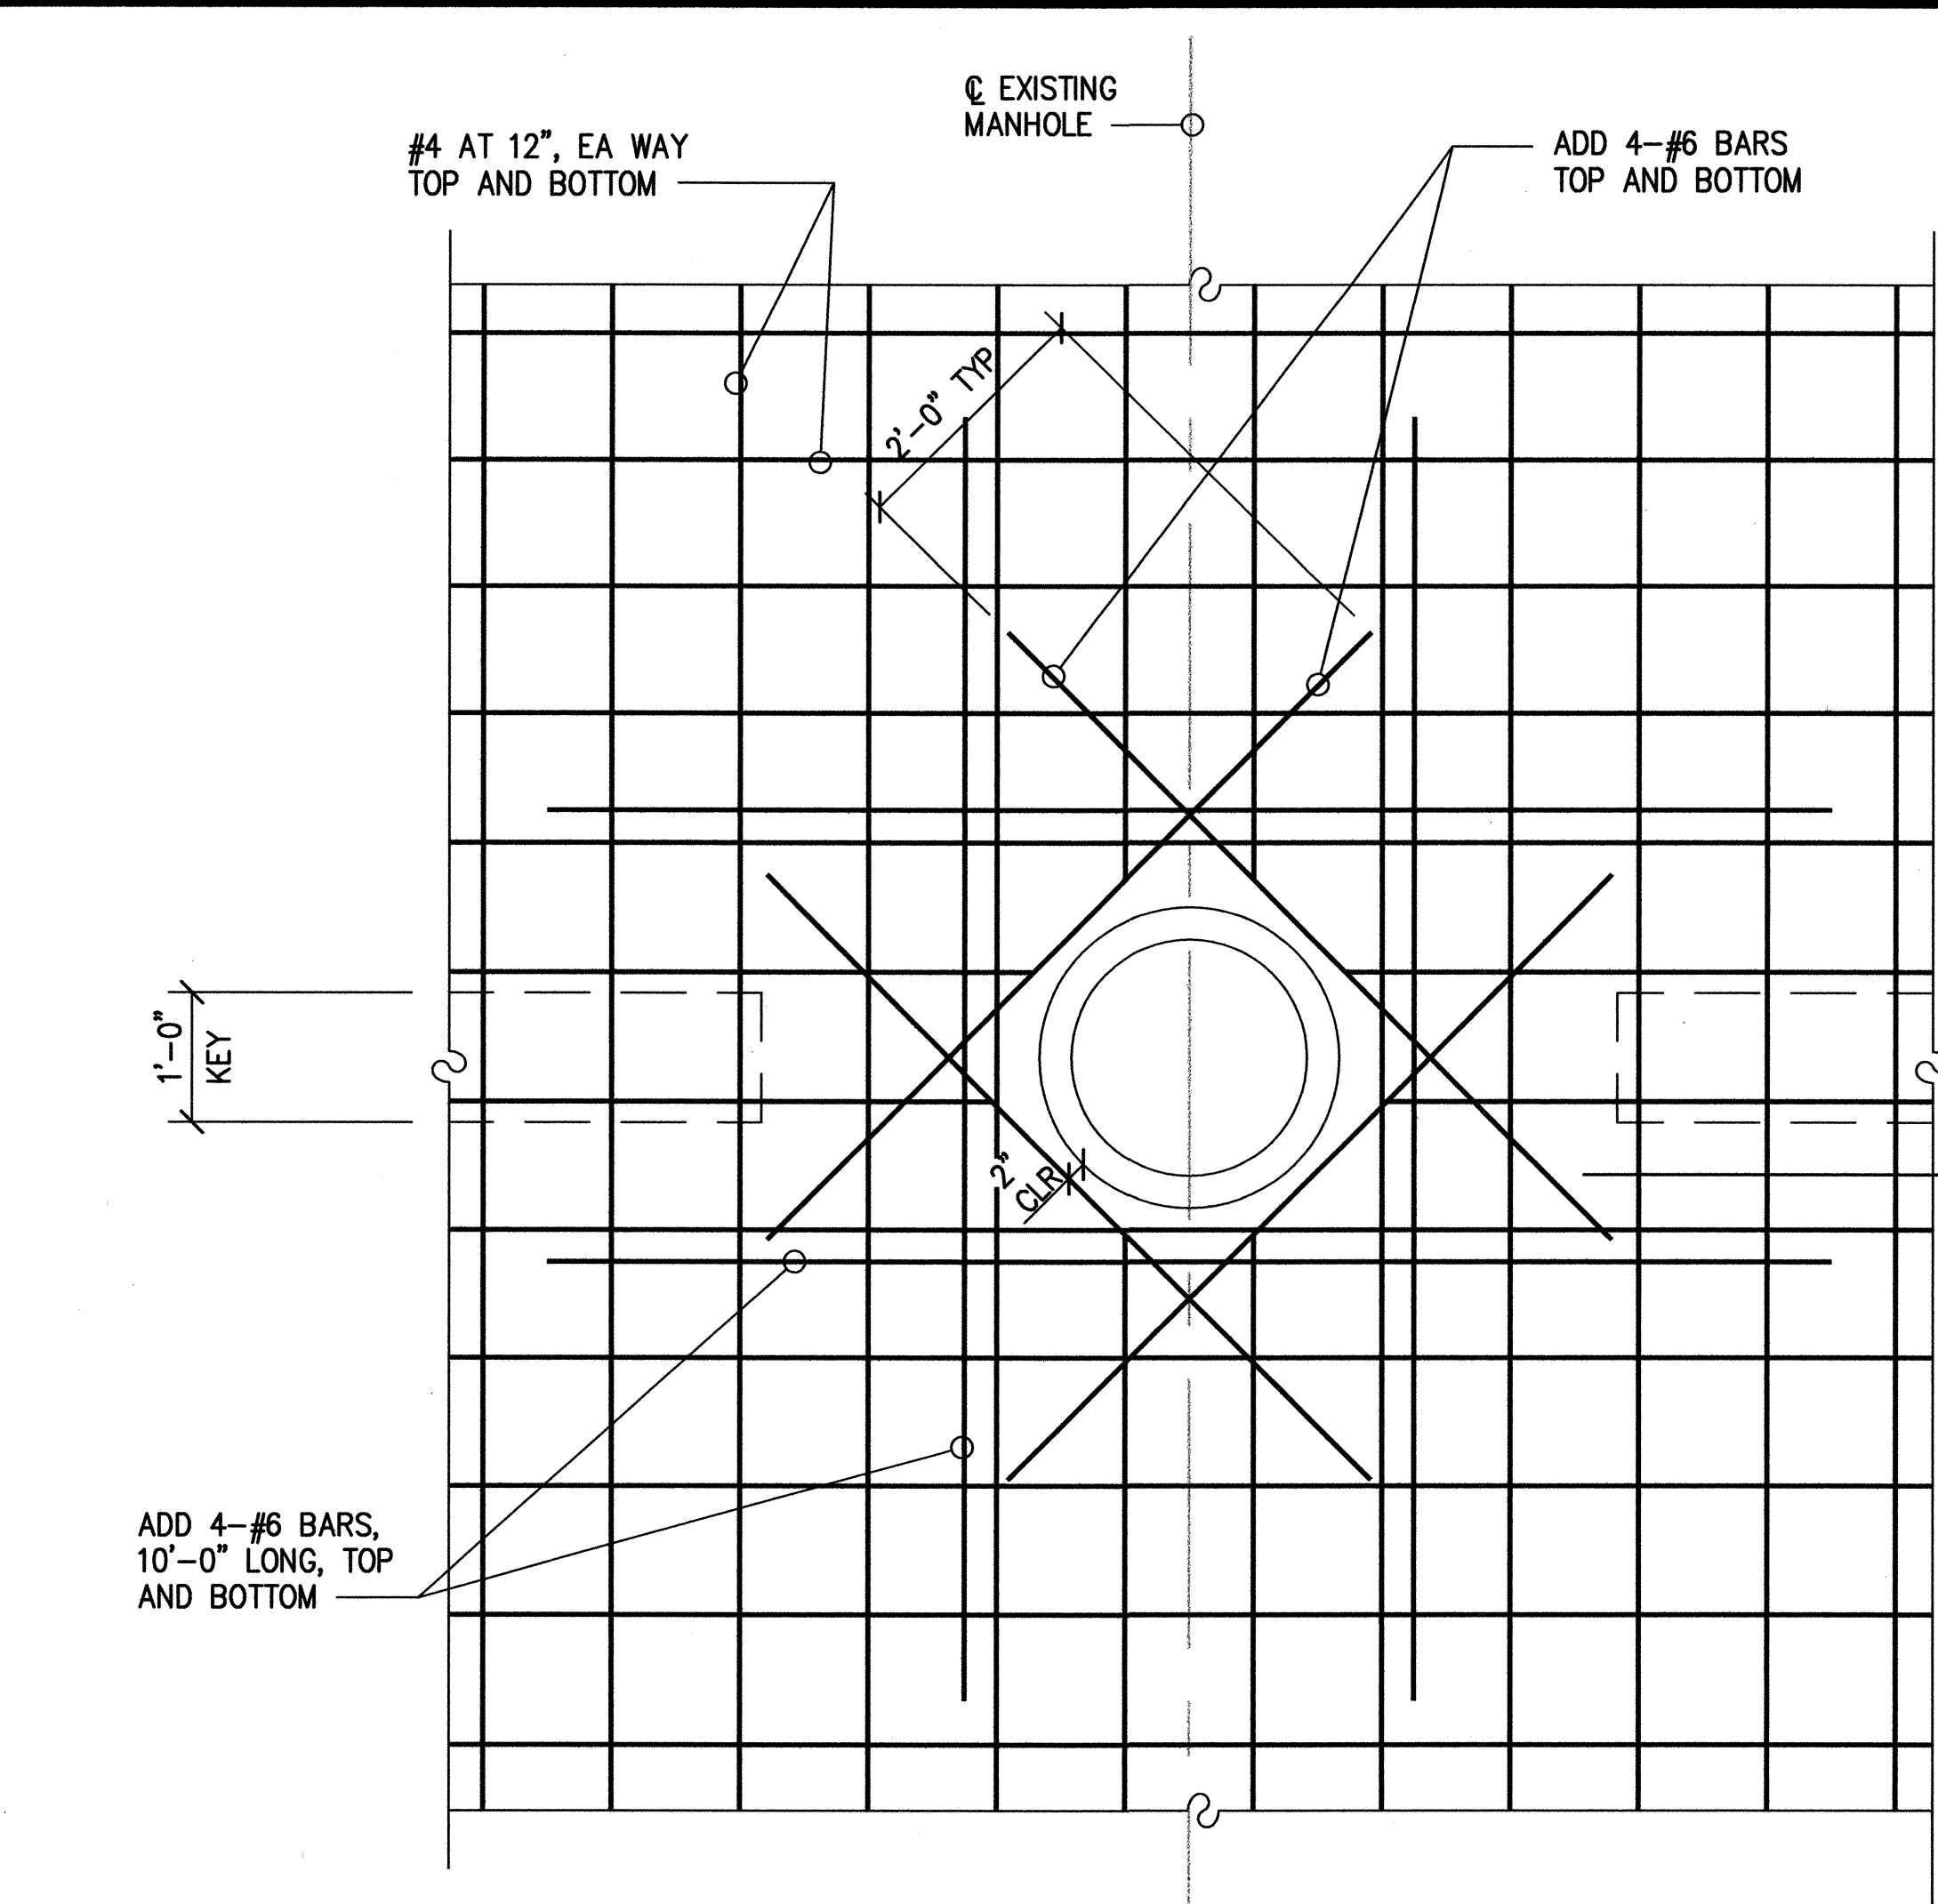


1
S-2|S-2 SCALE: 3/4" = 1'-0"

REINFORCEMENT LAYOUT AROUND MANHOLE

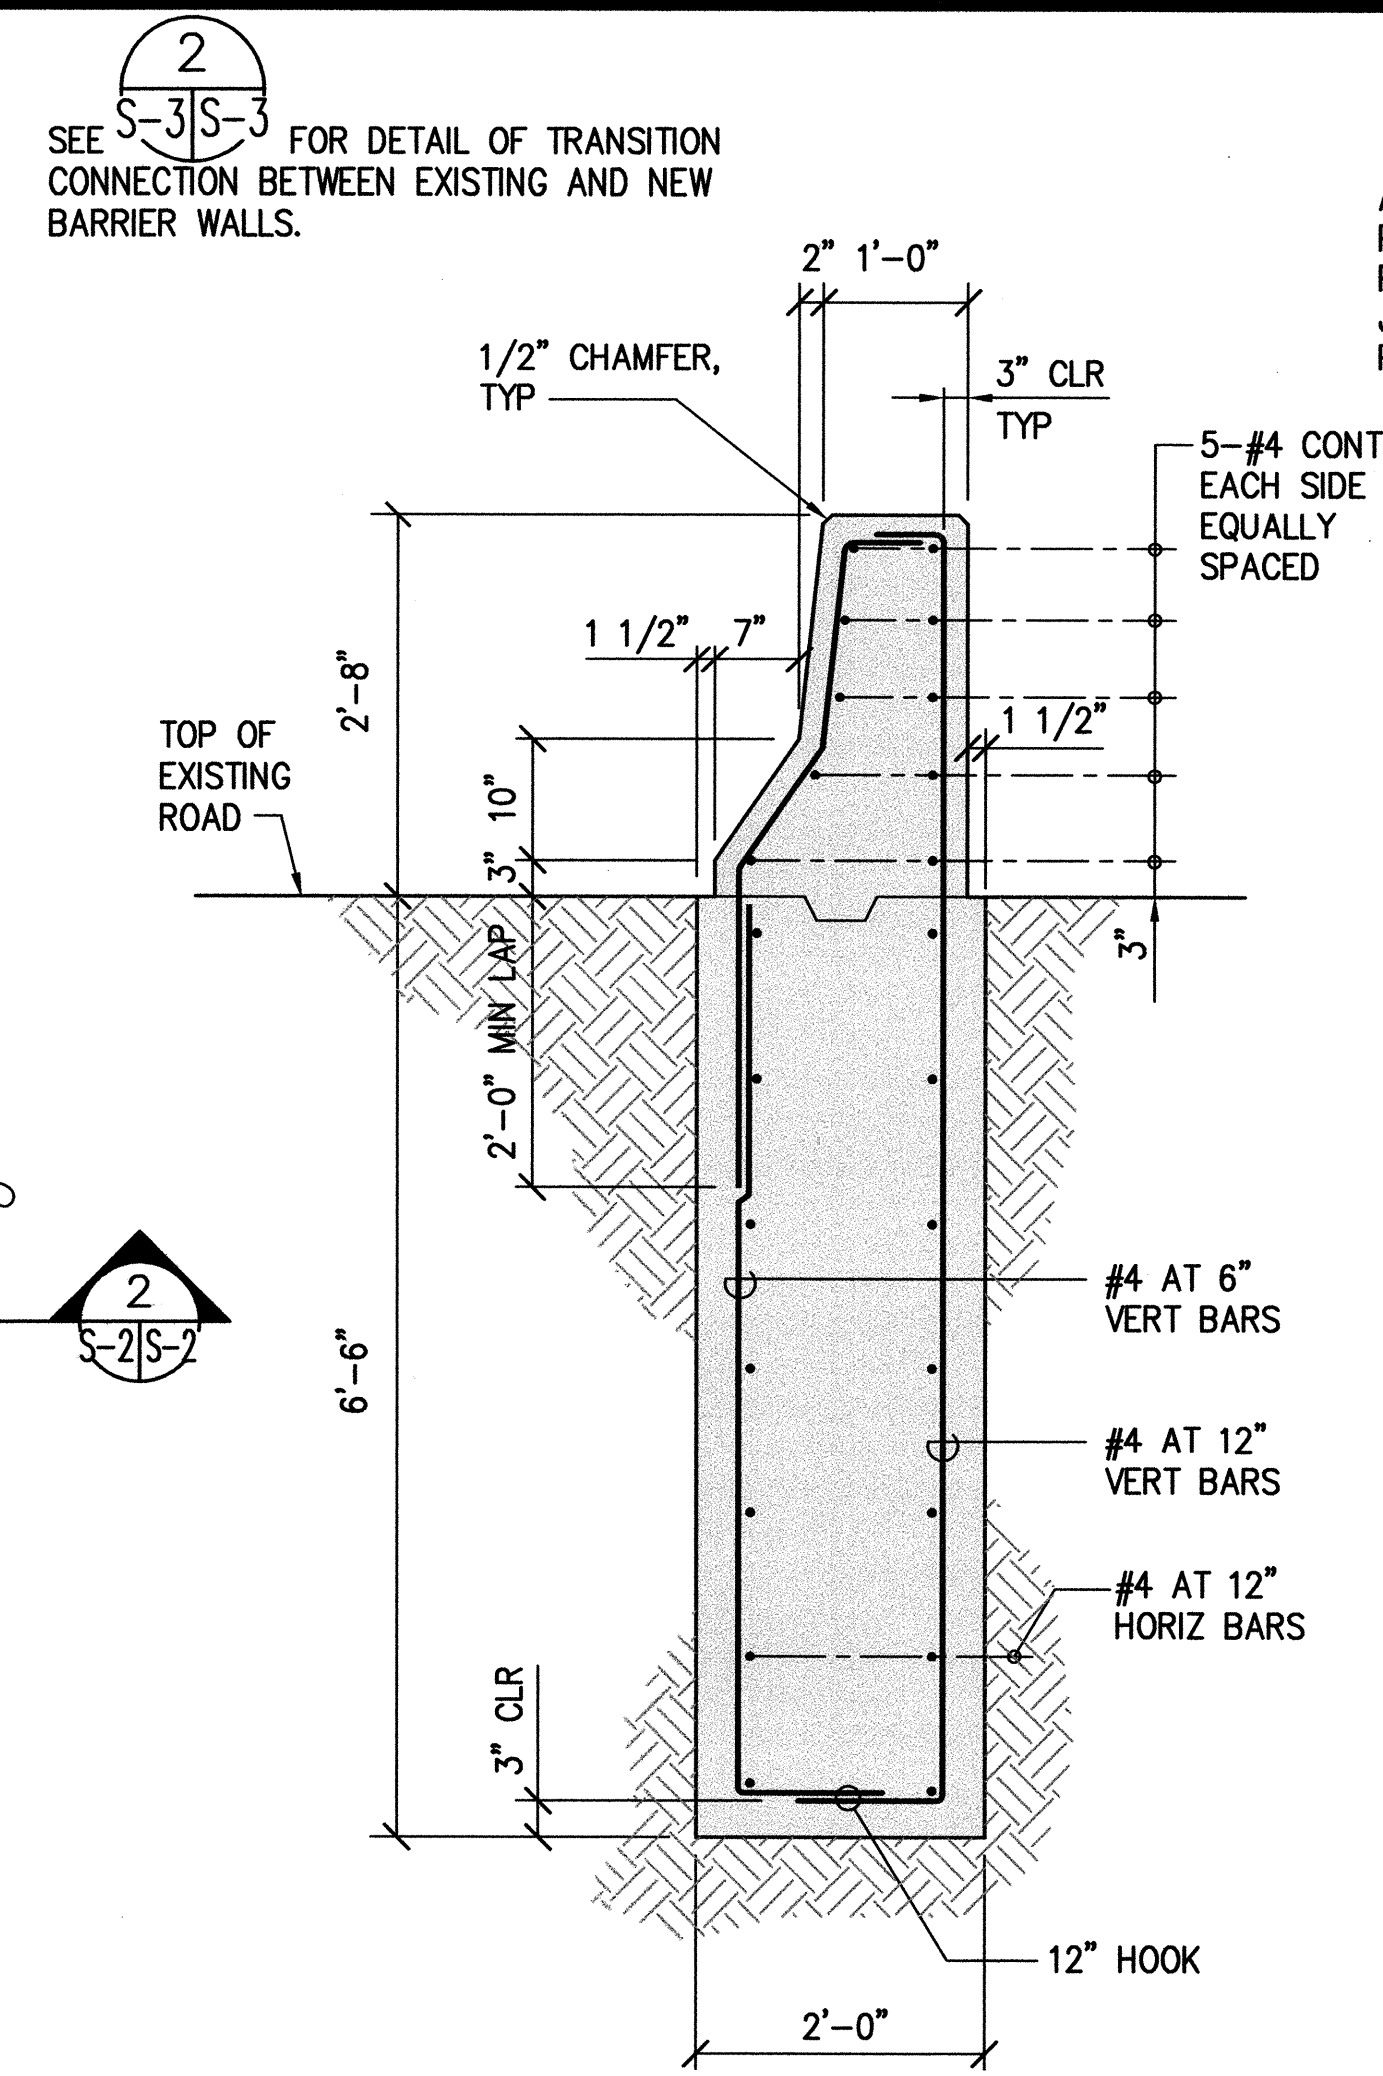


2
C-15|S-2 SCALE: 3/4" = 1'-0"

CONCRETE MEDIAN BARRIER

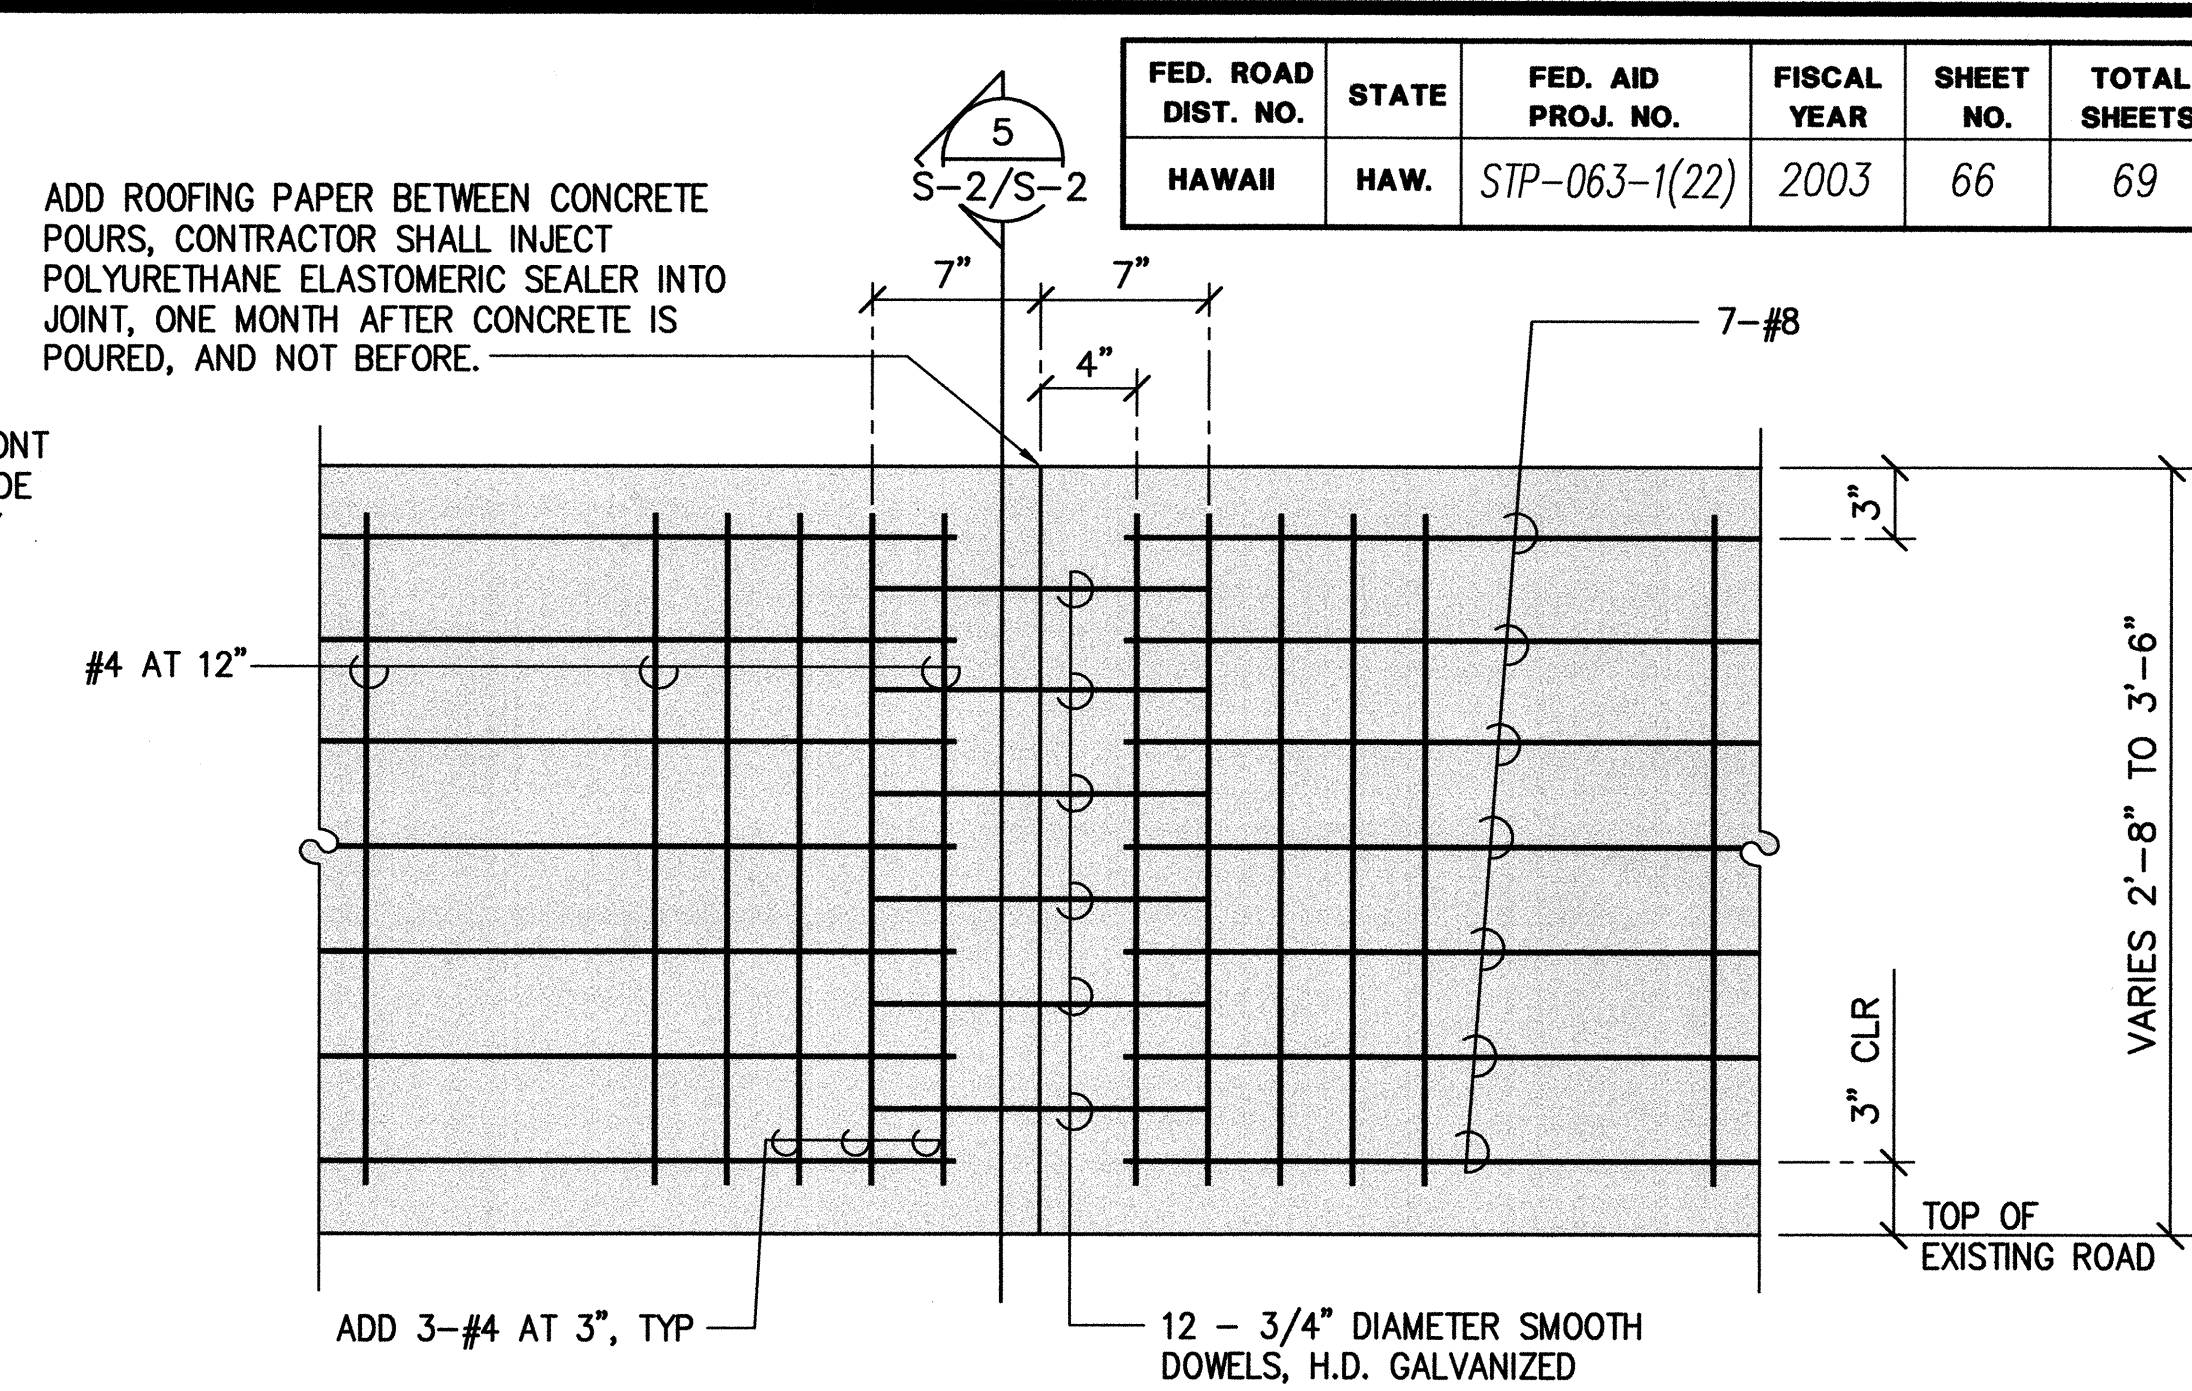


3
S-2|S-2 SCALE: 1 1/2" = 1'-0"

TYPICAL CONCRETE BARRIER CONSTRUCTION JOINT DETAIL

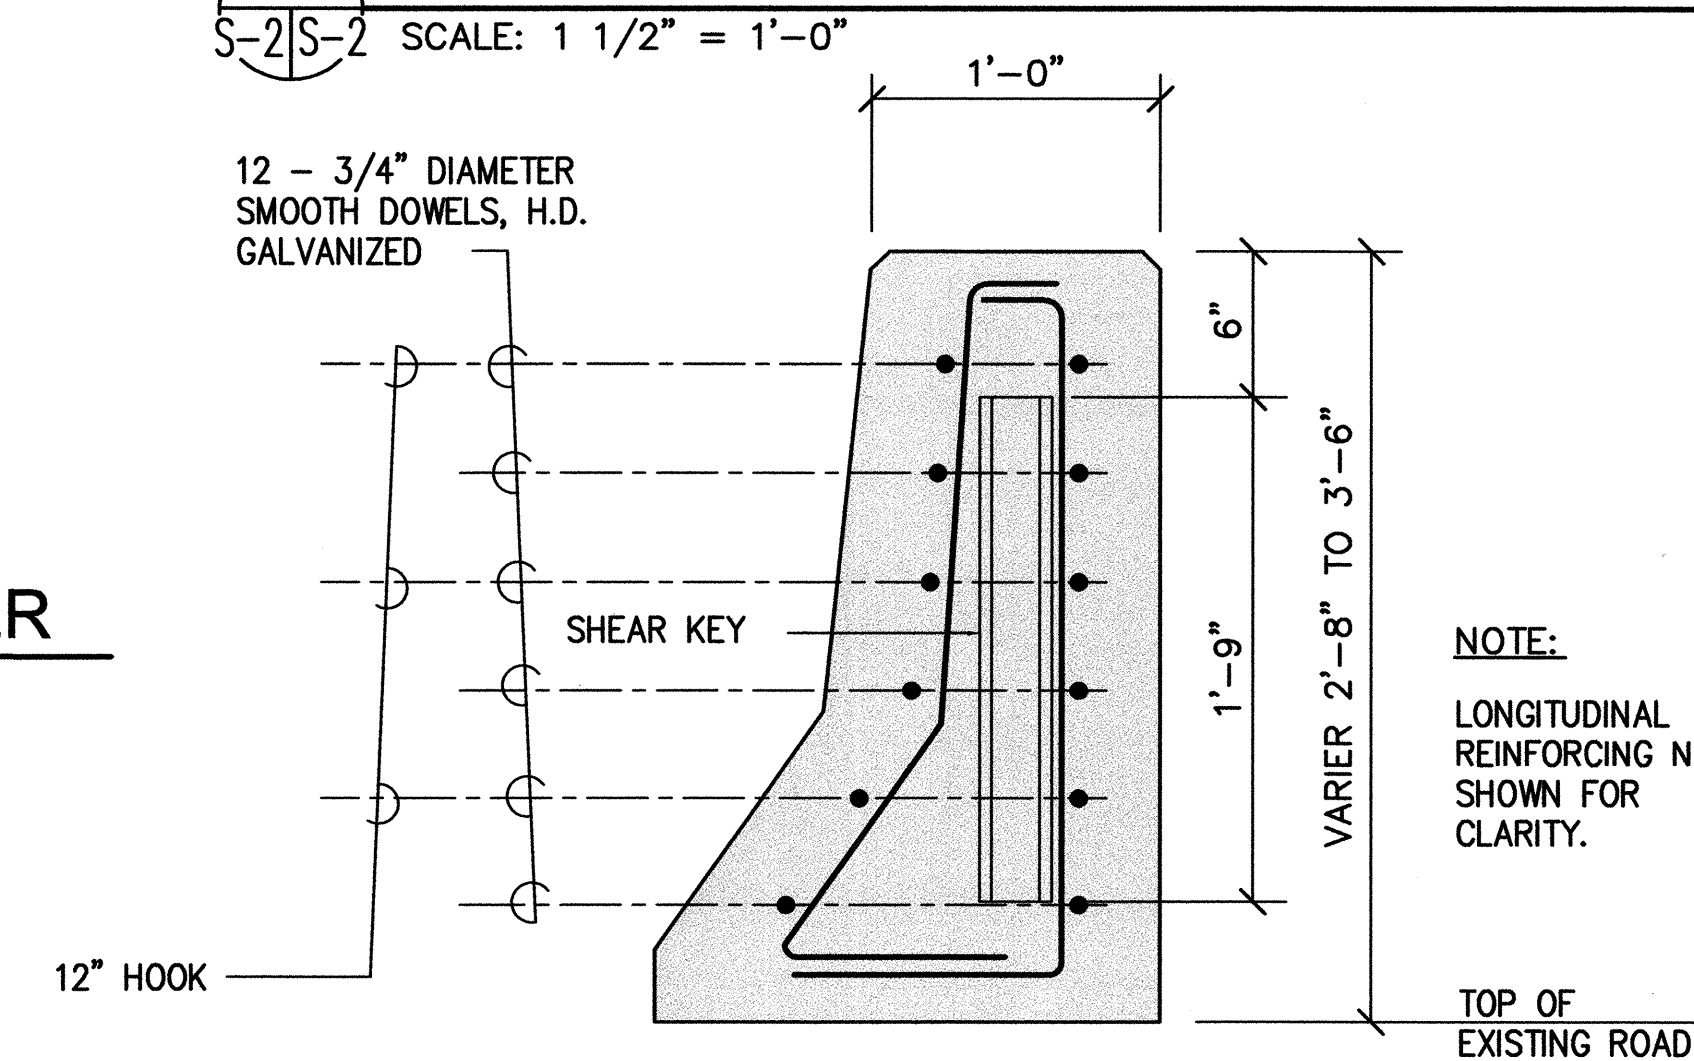


4
S-2|S-2 SCALE: 1 1/2" = 1'-0"

SECTION-LOCATION OF DOWELS

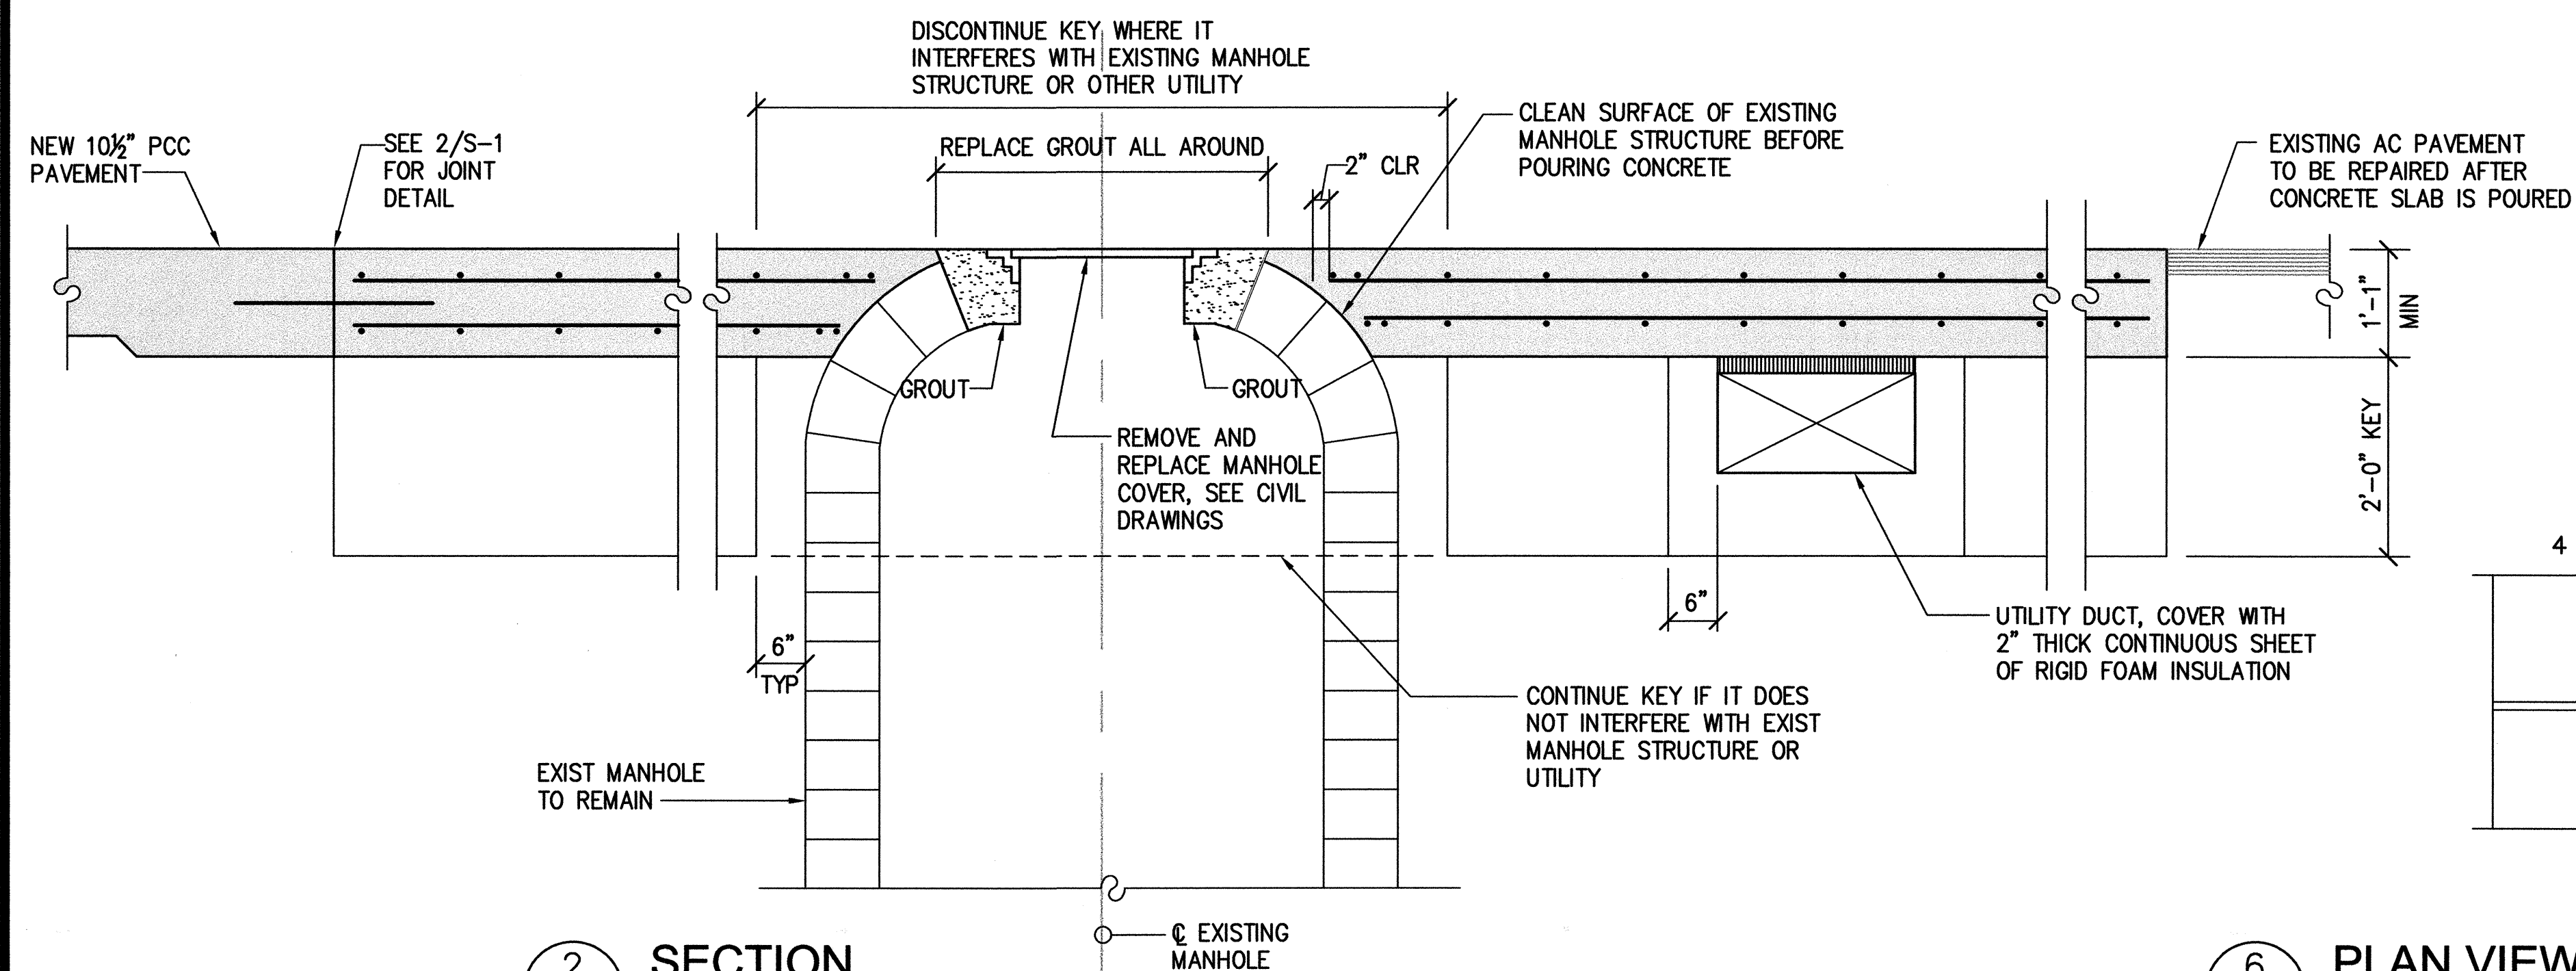


5
S-2|S-2 SCALE: 3/4" = 1'-0"

SECTION

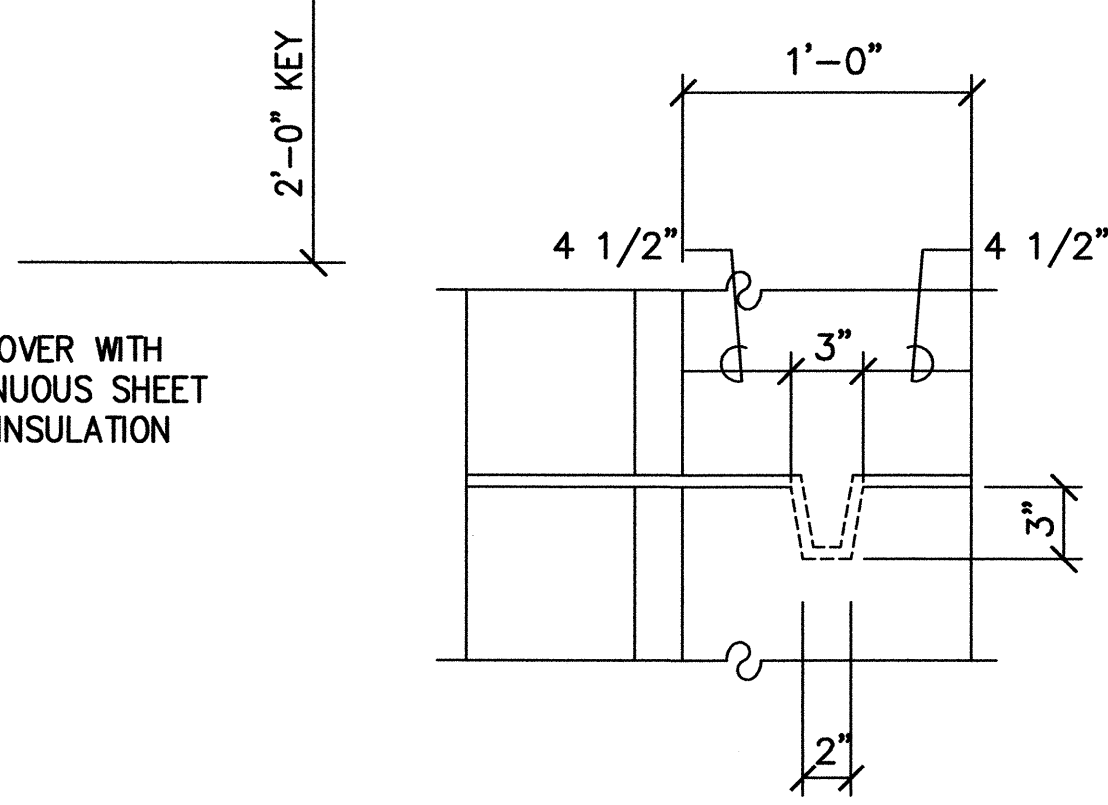

6
S-2|S-2 SCALE: 1 1/2" = 1'-0"

PLAN VIEW OF SHEAR KEY

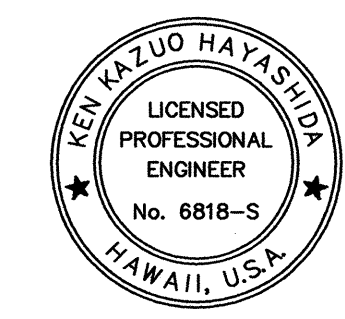

THIS WORK WAS PREPARED BY ME OR UNDER MY SUPERVISION AND CONSTRUCTION OF THIS PROJECT WILL BE UNDER MY OBSERVATION.

SIGNATURE: *[Signature]* EXPIRATION DATE OF THE LICENSE: APR 30, 2004

STATE OF HAWAII

DEPARTMENT OF TRANSPORTATION

HIGHWAYS DIVISION

CONCRETE BARRIER DETAILS

LIKELIKE HIGHWAY

Wilson Tunnel Improvements

Leak and Crack Remediation

F. A. Project No. STP-063-1(22)


Scale: As Shown Date: April 24, 2003

SHEET No. S-2 OF 5 SHEETS

66


SURVEY PLOTTED BY	DATE
DRAWN BY	
DESIGNED BY	
CHECKED BY	
ORIGINAL PLAN	
NOTE BOOK	
No.	

FED. ROAD DIST. NO.	STATE	FED. AID PROJ. NO.	FISCAL YEAR	SHEET NO.	TOTAL SHEETS
HAWAII	HAW.	STP-063-1(22)	2003	67	69

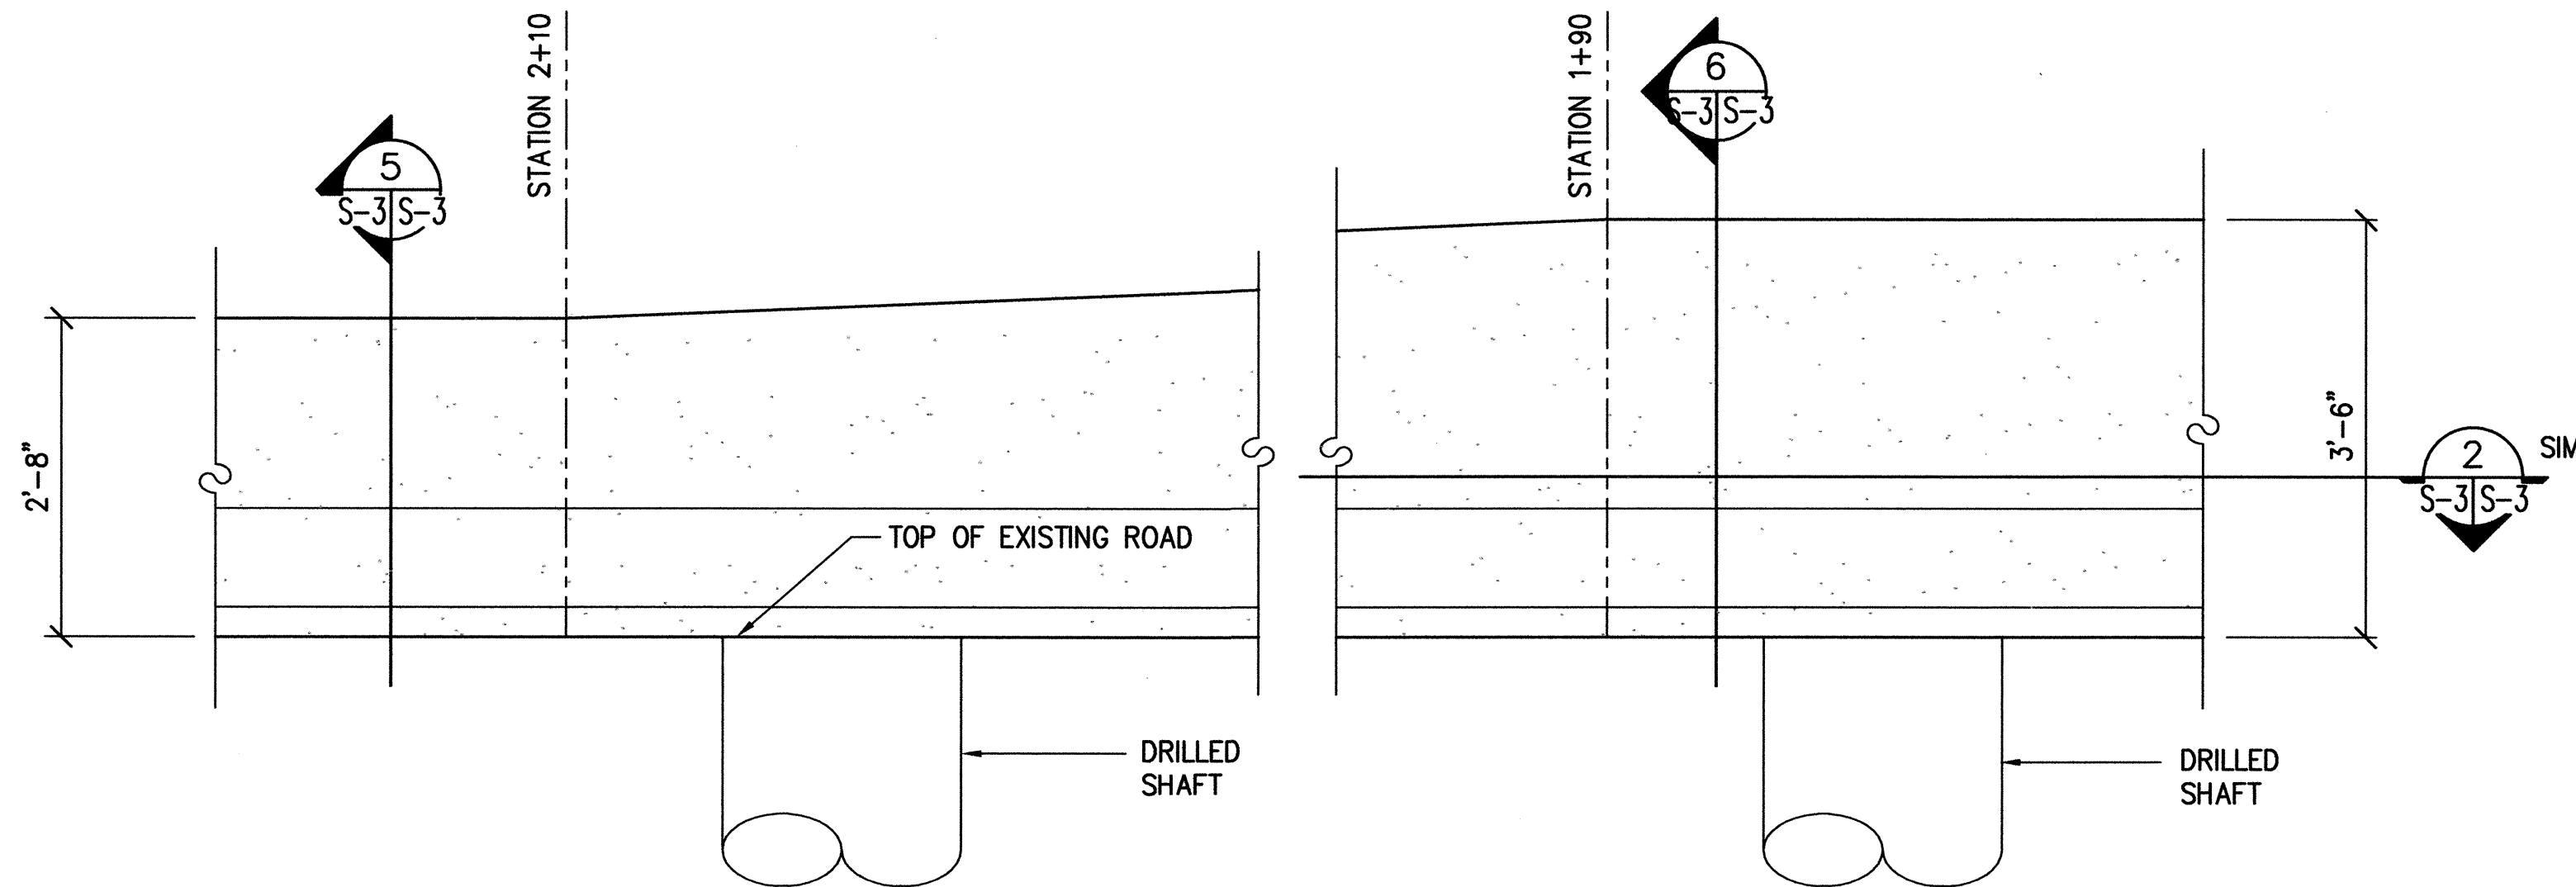


NOTE:
REBARS TO FOLLOW THE SAME TRANSITION PATTERN AS THE BARRIER WALL.


1 CONCRETE ROADSIDE BARRIER DETAIL AT HEIGHT TRANSITION
SCALE: 3/4" = 1'-0"

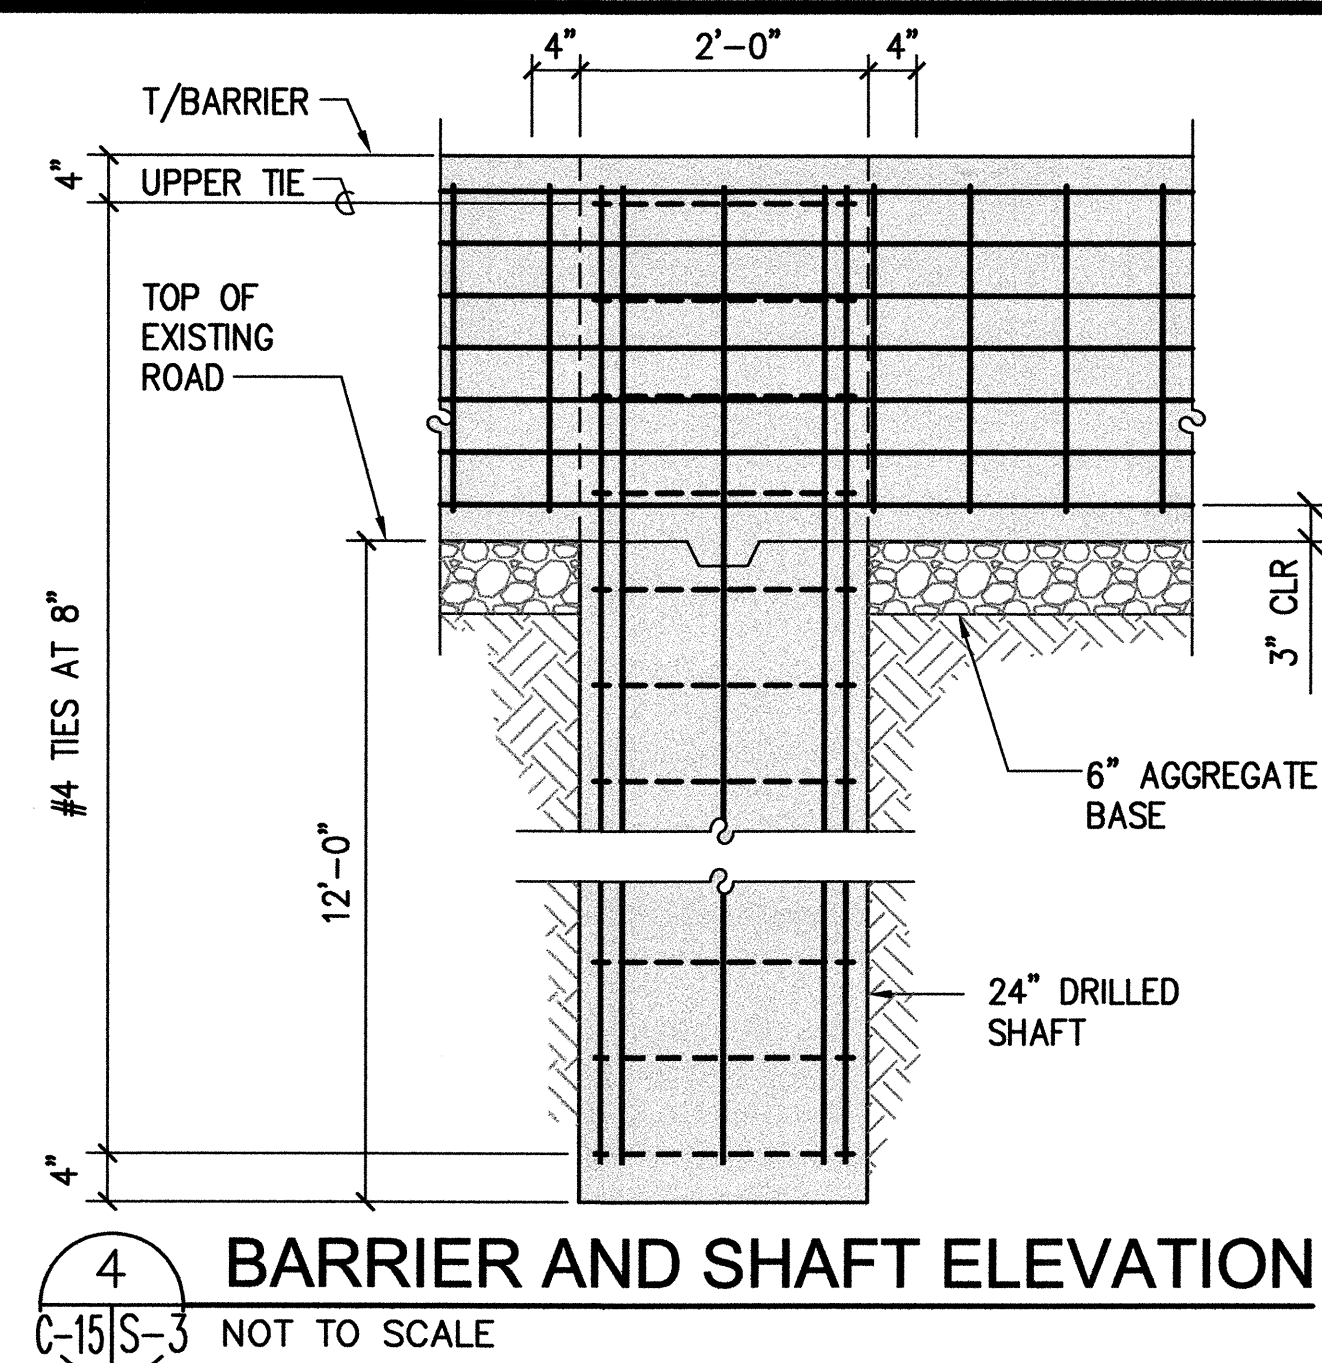


4 BARRIER AND SHAFT ELEVATION
NOT TO SCALE

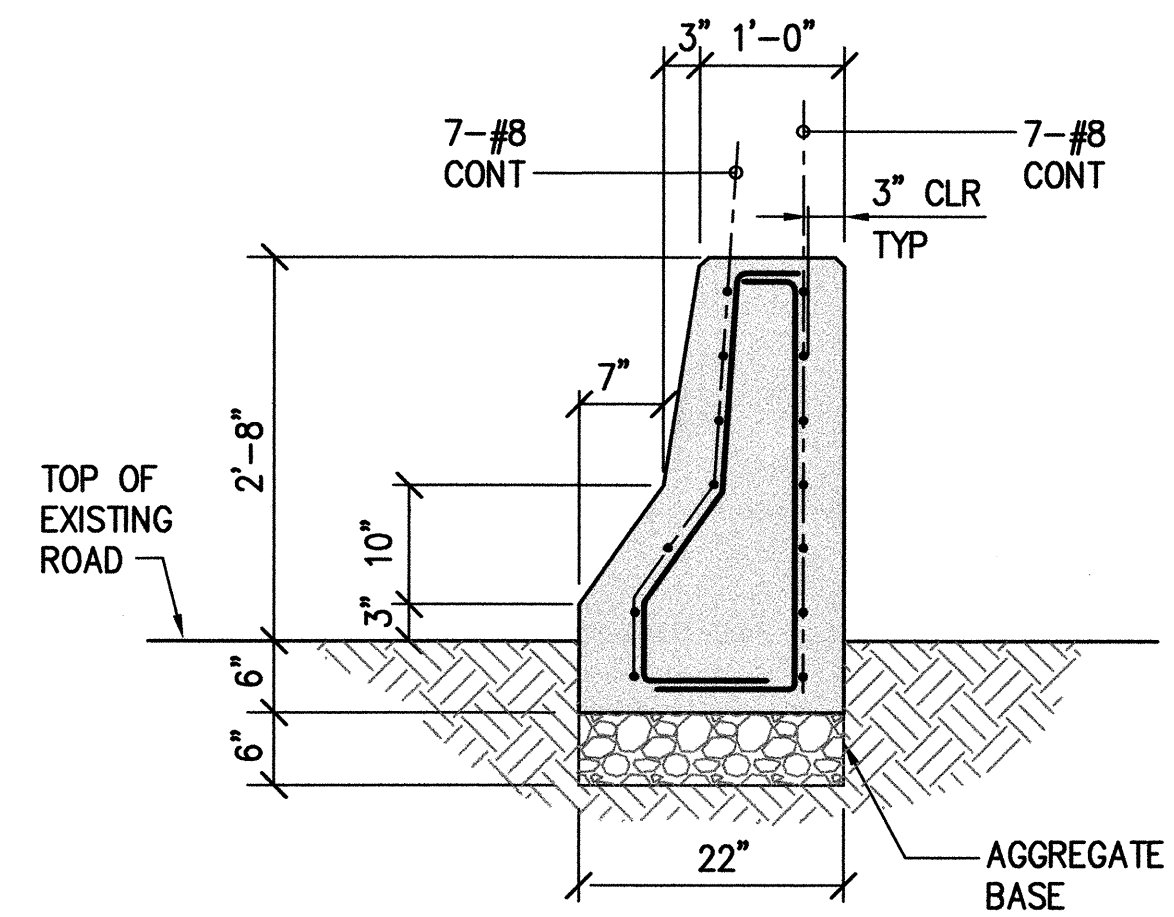


5 SECTION
SCALE: 3/4" = 1'-0"

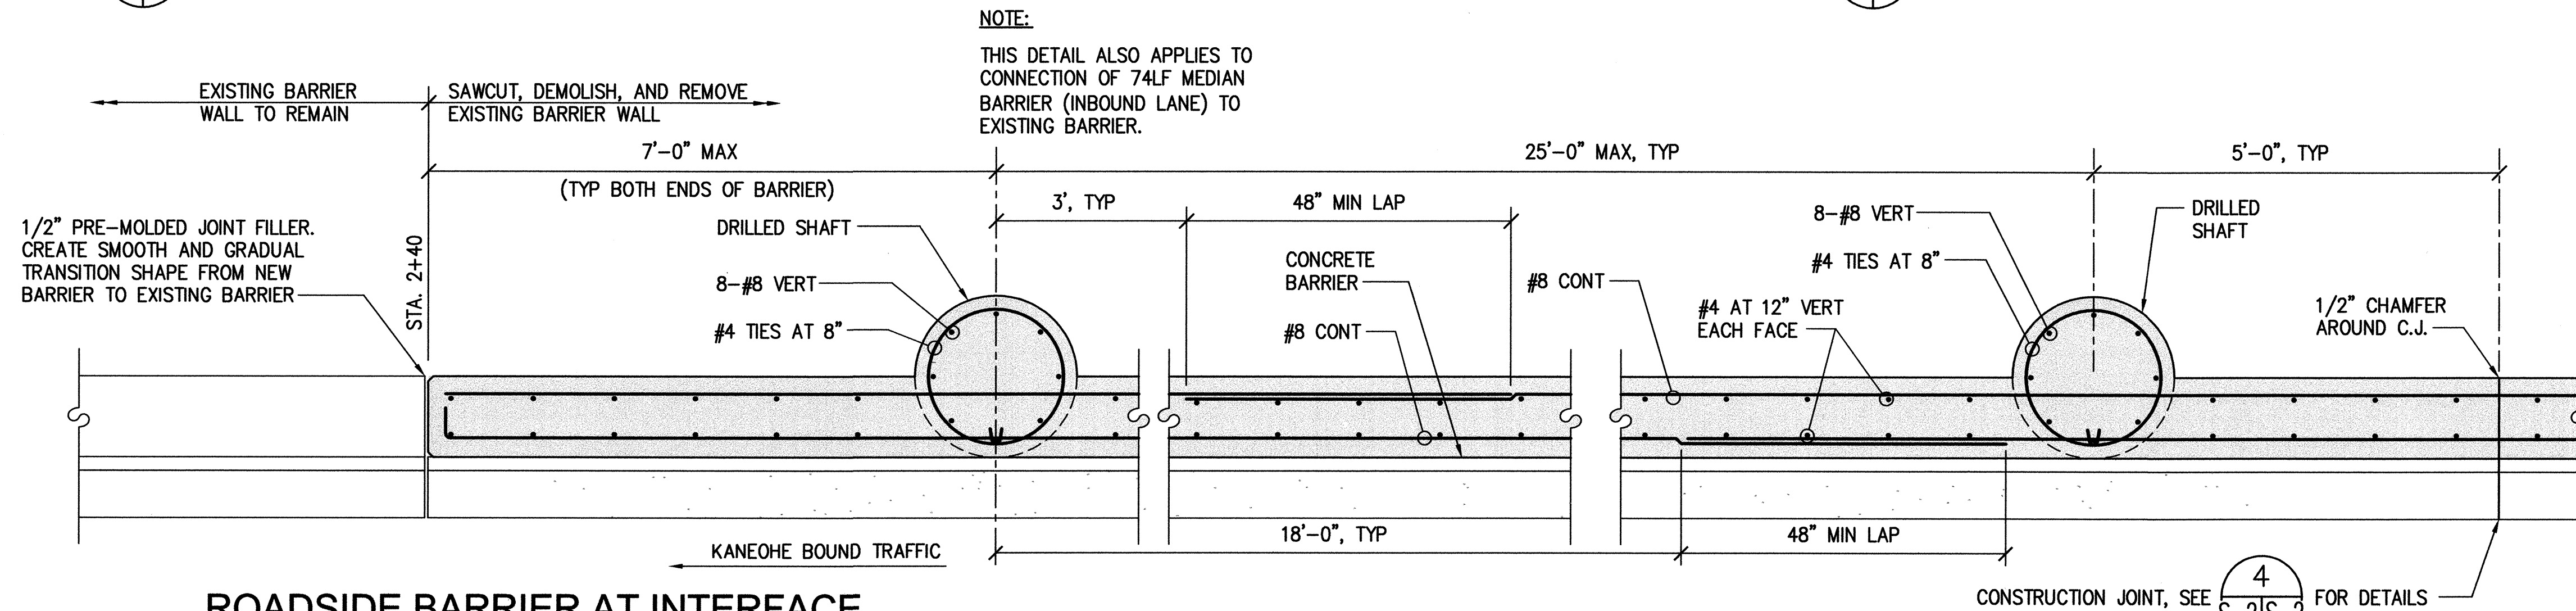

2 ROADSIDE BARRIER AT INTERFACE WITH EXISTING BARRIER-SECTION
SCALE: 3/4" = 1'-0"

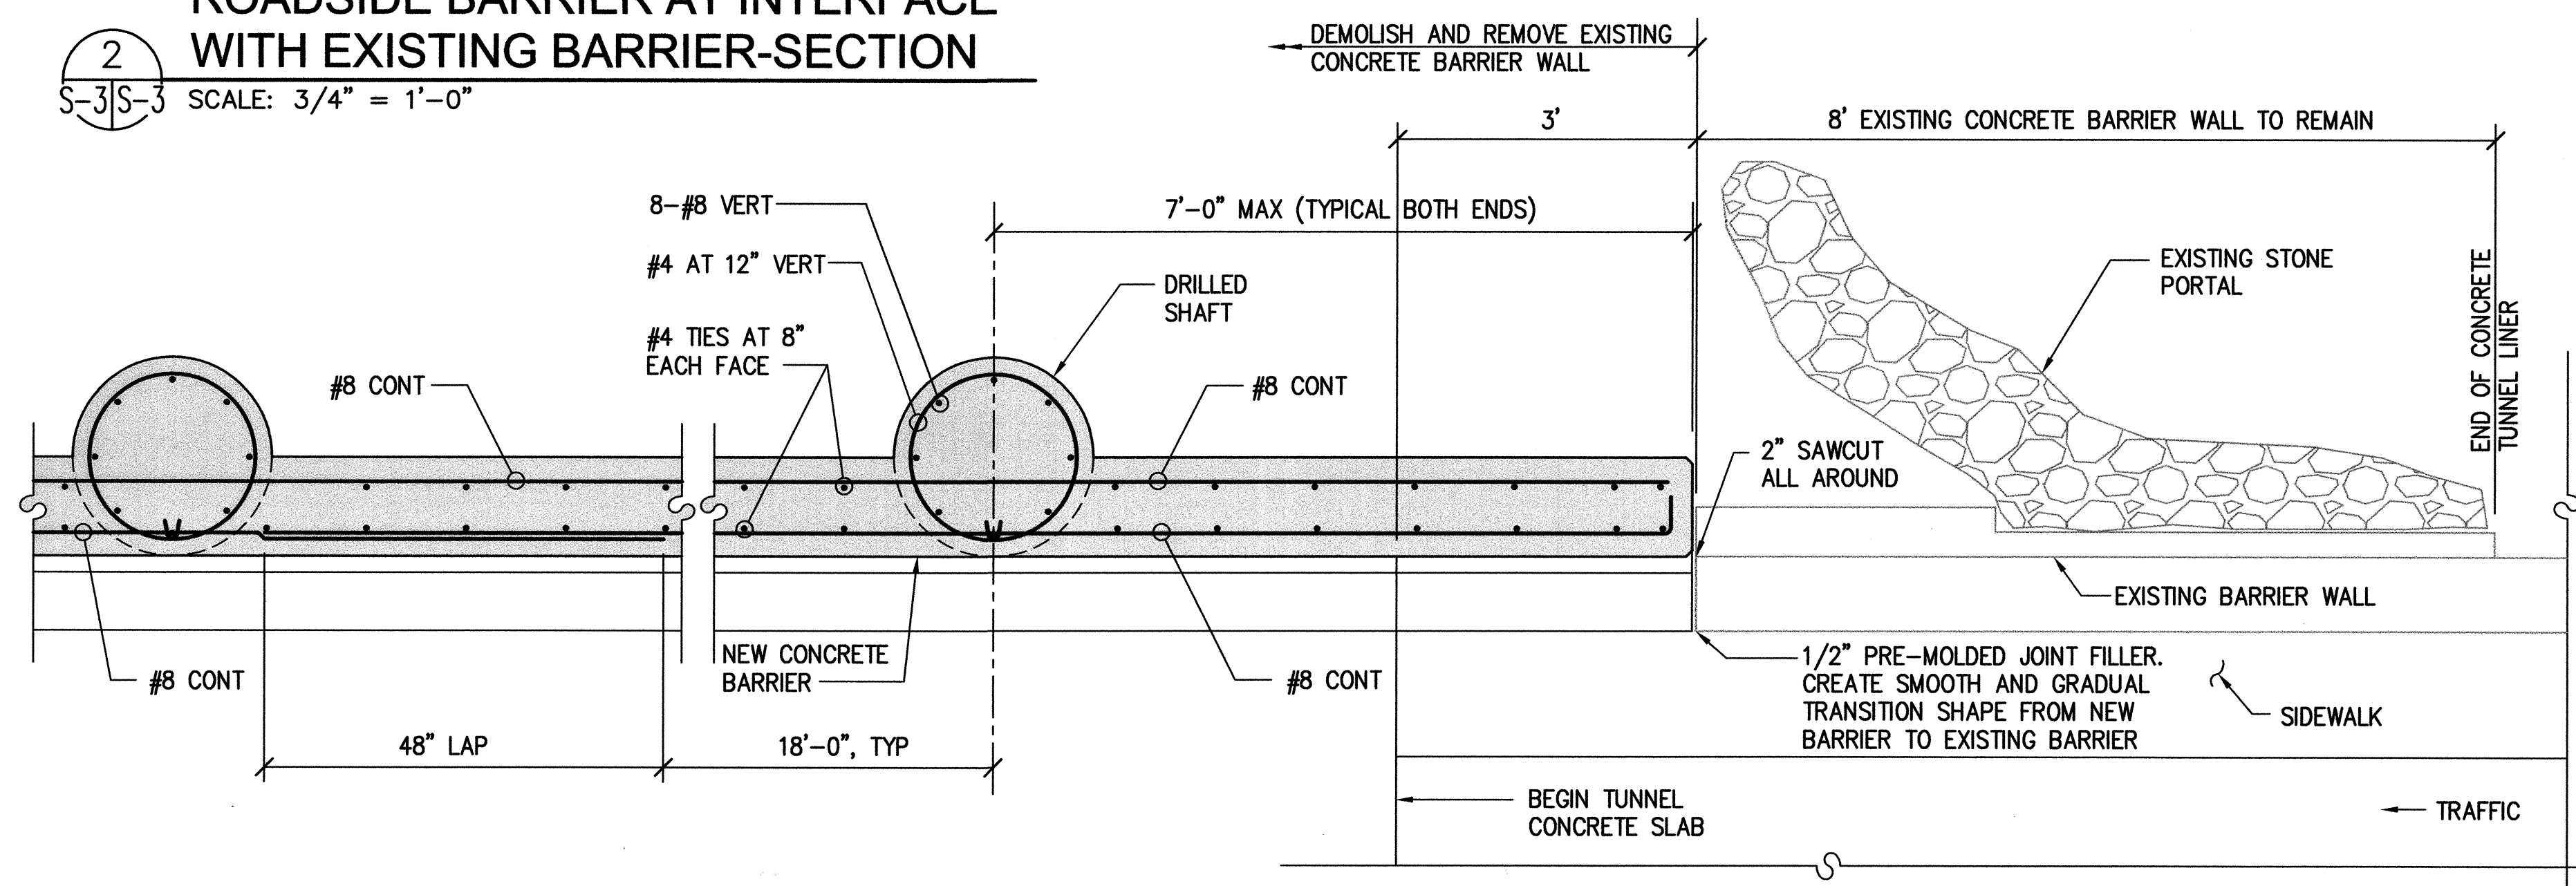


3 ROADSIDE BARRIER AT TUNNEL ENTRANCE-SECTION
SCALE: 3/4" = 1'-0"

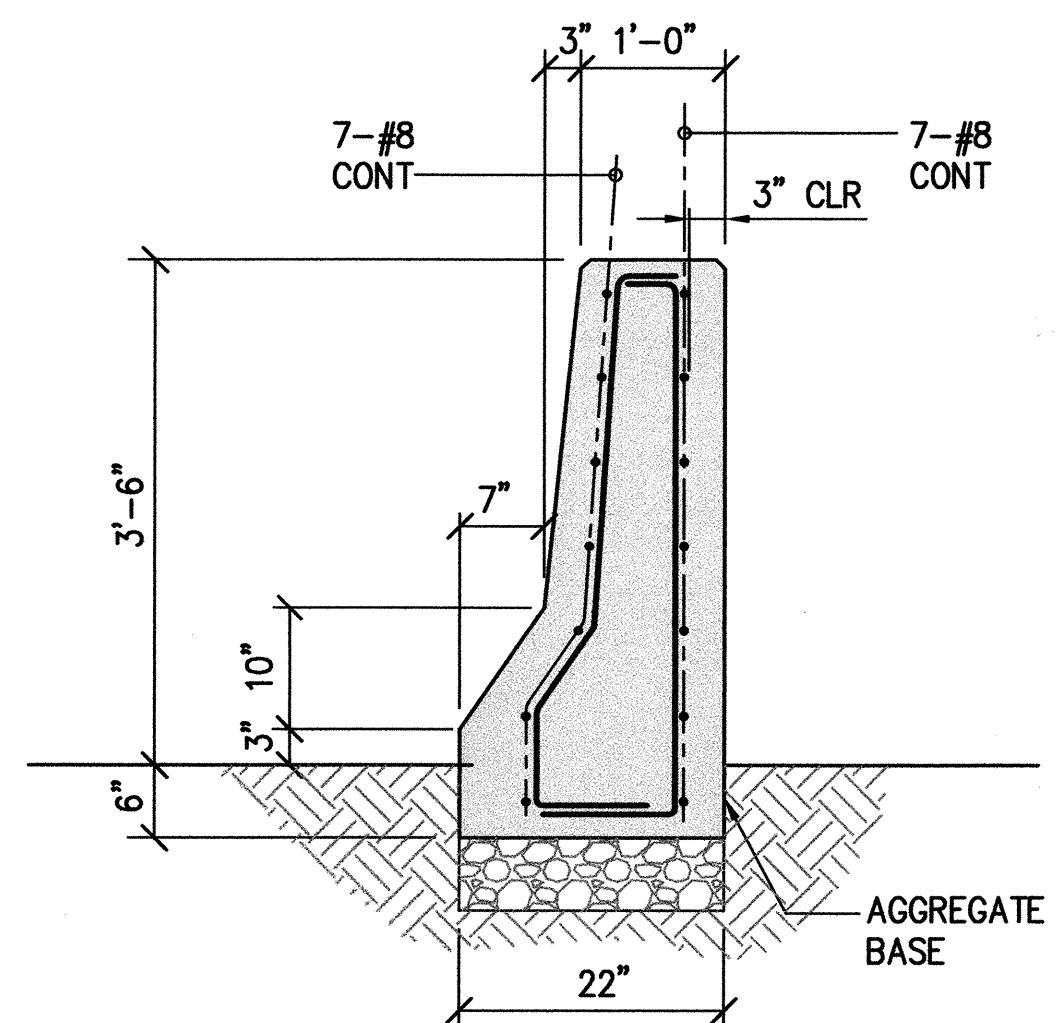

6 SECTION
SCALE: 3/4" = 1'-0"

NOTE:
SEE TYPICAL BARRIER CONSTRUCTION JOINT DETAIL, SHEET S-2.

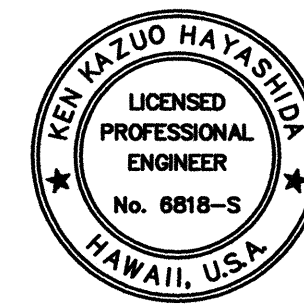

THIS WORK WAS PREPARED BY ME OR UNDER MY SUPERVISION AND CONSTRUCTION OF THIS PROJECT WILL BE UNDER MY OBSERVATION.

SIGNATURE: *[Signature]*
EXPIRATION DATE OF THE LICENSE: April 30, 2004

STATE OF HAWAII
DEPARTMENT OF TRANSPORTATION
HIGHWAYS DIVISION

CONC BARRIER DETAILS


LIKELIKE HIGHWAY
Wilson Tunnel Improvements
Leak and Crack Remediation
F. A. Project No. STP-063-1(22)

Scale: As Shown Date: April 24, 2003


SHEET No. S-3 OF 5 SHEETS

SURVEY PLOTTED BY	DATE
DRAWN BY	
DESIGNED BY	
CHECKED BY	
ORIGINAL PLAN	
NOTE BOOK	
No.	


FED. ROAD DIST. NO.	STATE	FED. AID PROJ. NO.	FISCAL YEAR	SHEET NO.	TOTAL SHEETS
HAWAII	HAW.	STP-063-1(22)	2003	ADD. 68	69

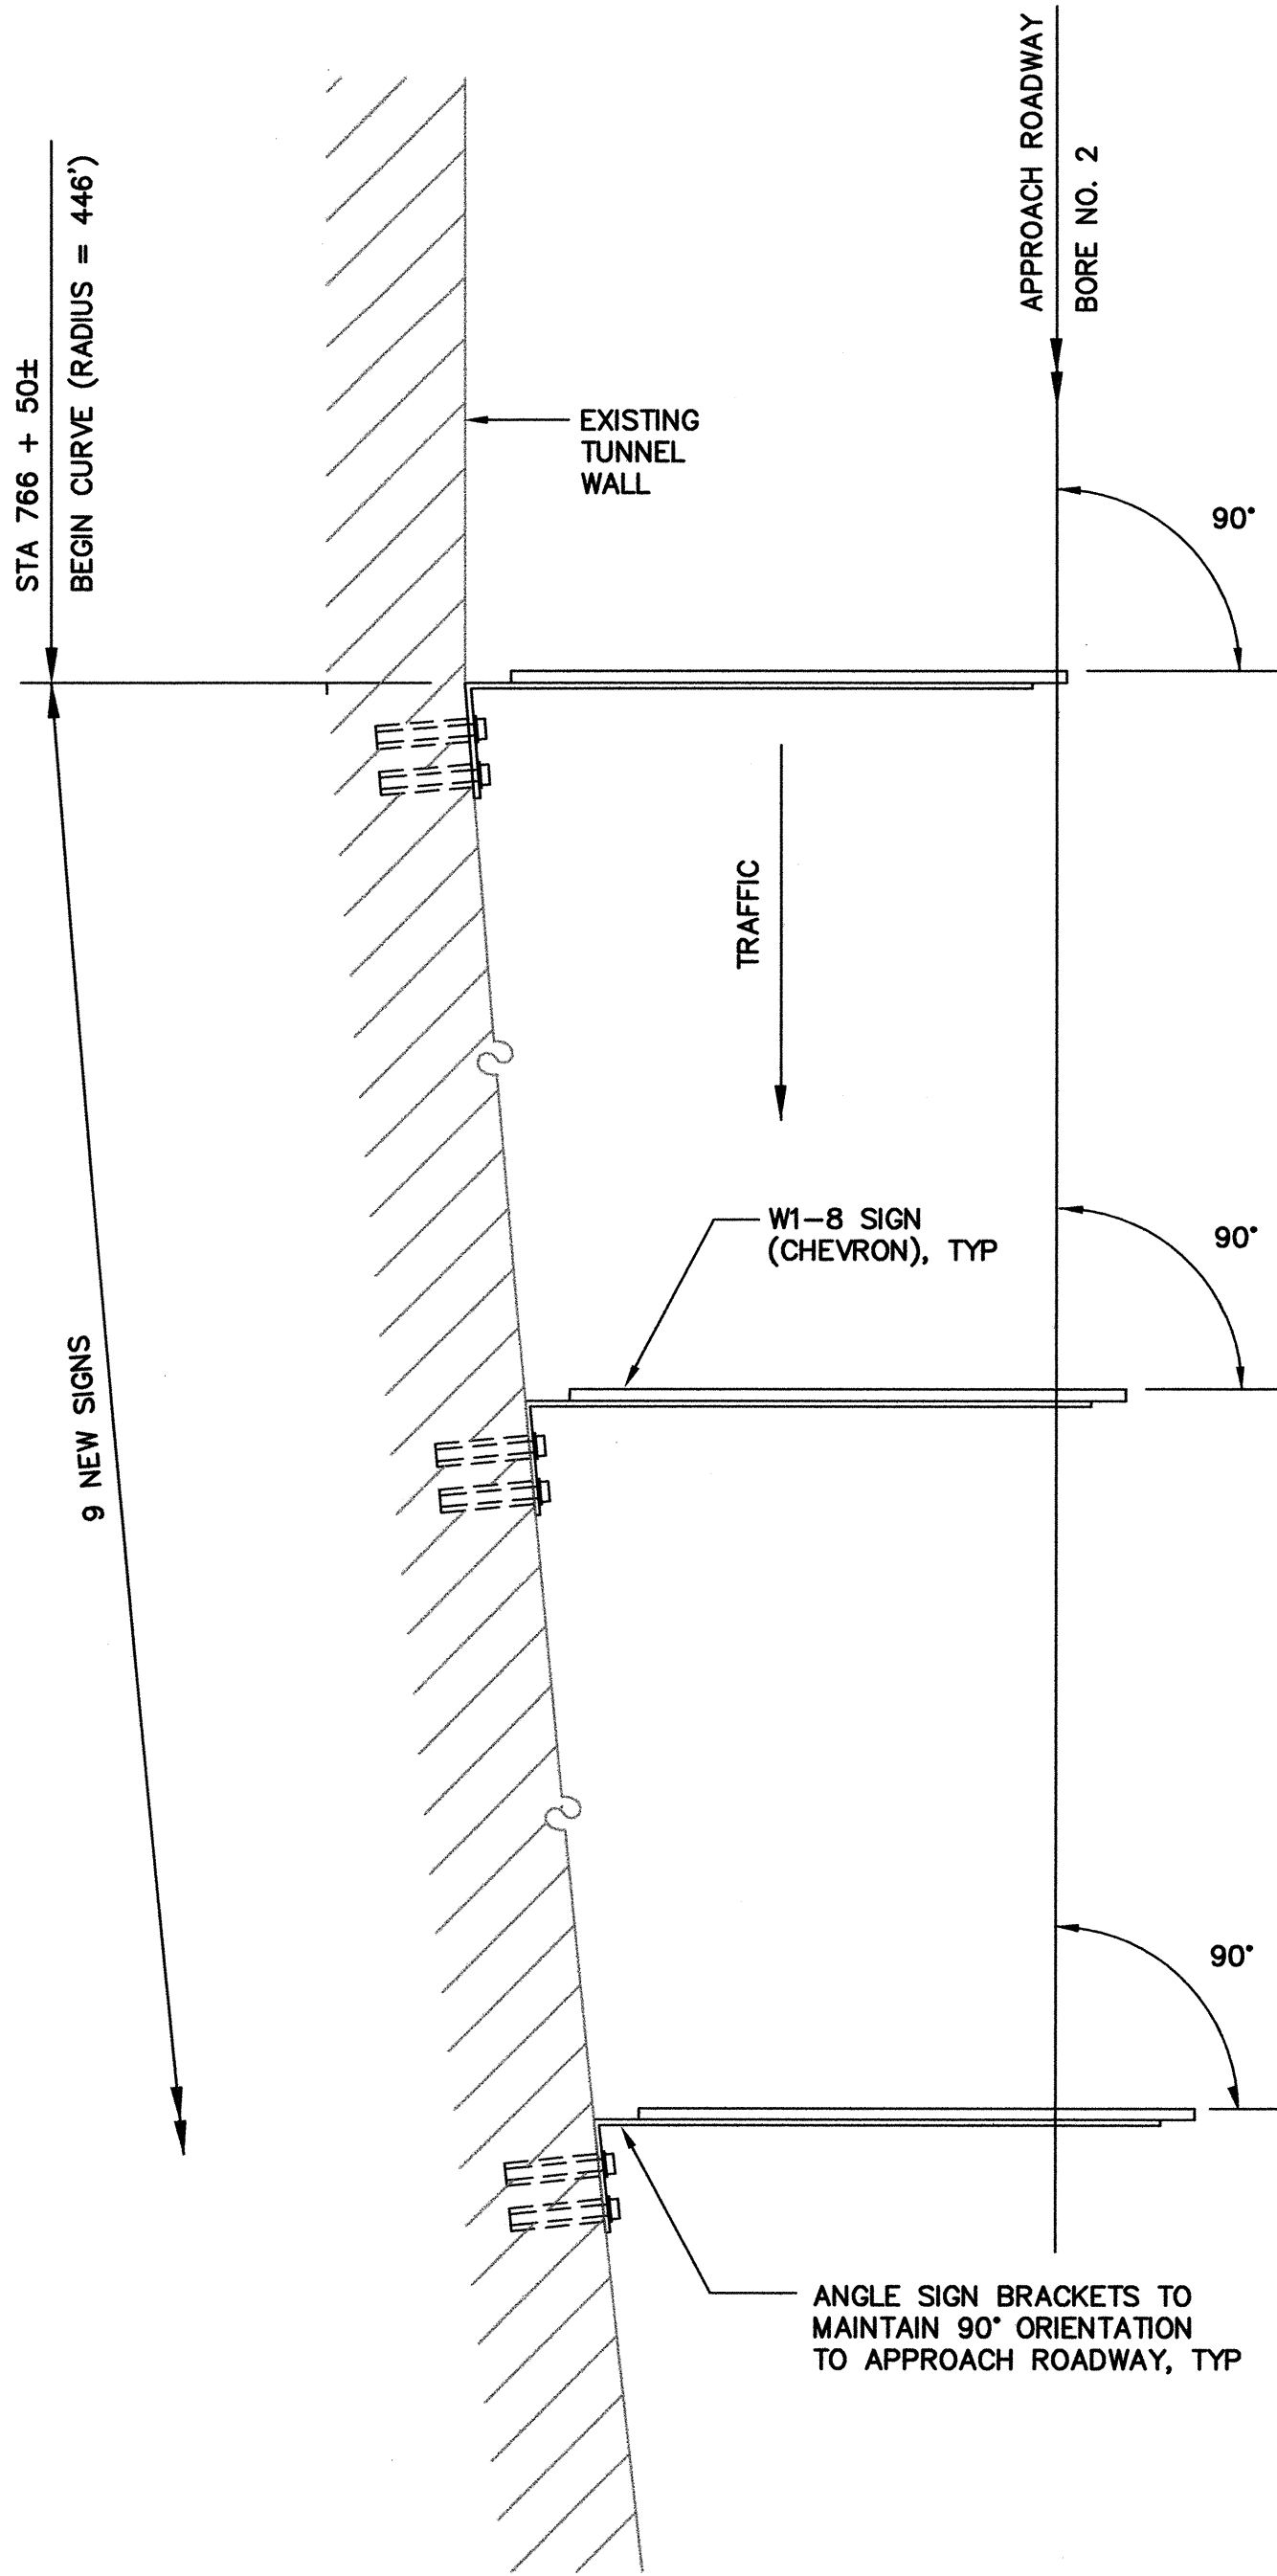


PLAN SECTION B
SCALE: 1 1/2" = 1'-0"

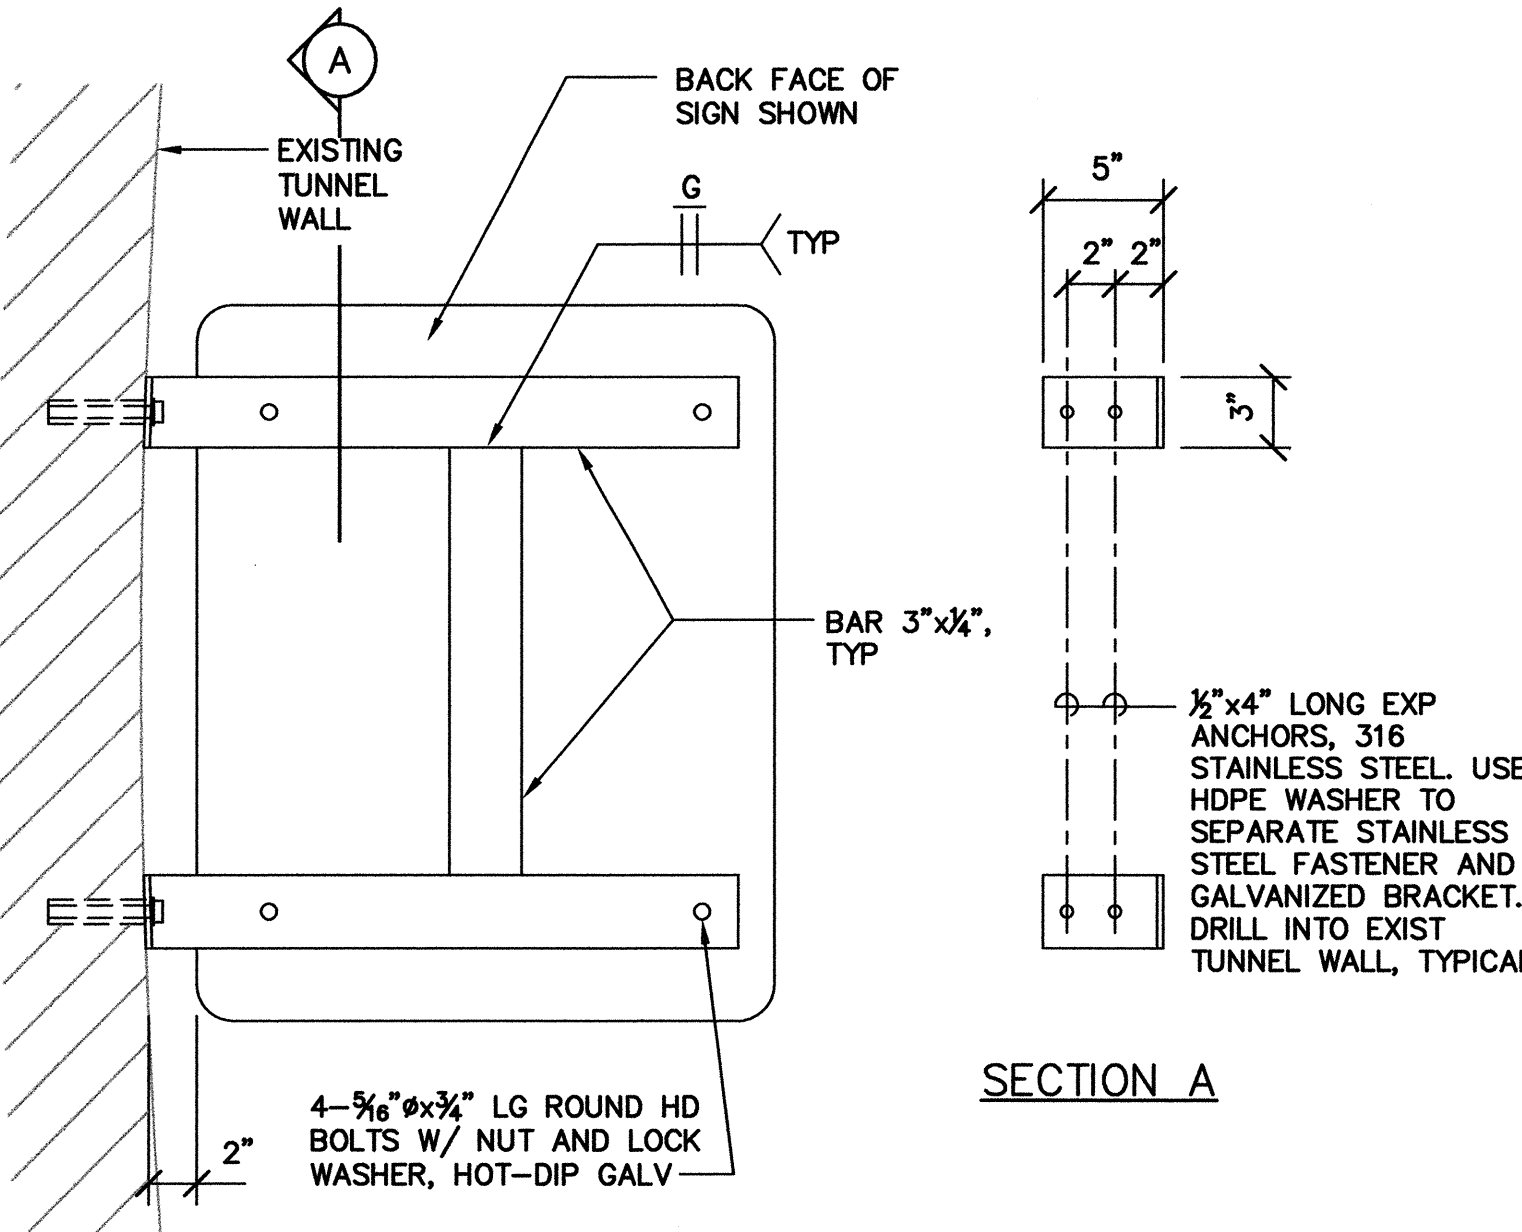


(R2-5A AND R2-1 SIGNS)
REGULATORY/WARNING
SIGN MOUNTING DETAIL
SCALE: 1 1/2" = 1'-0"

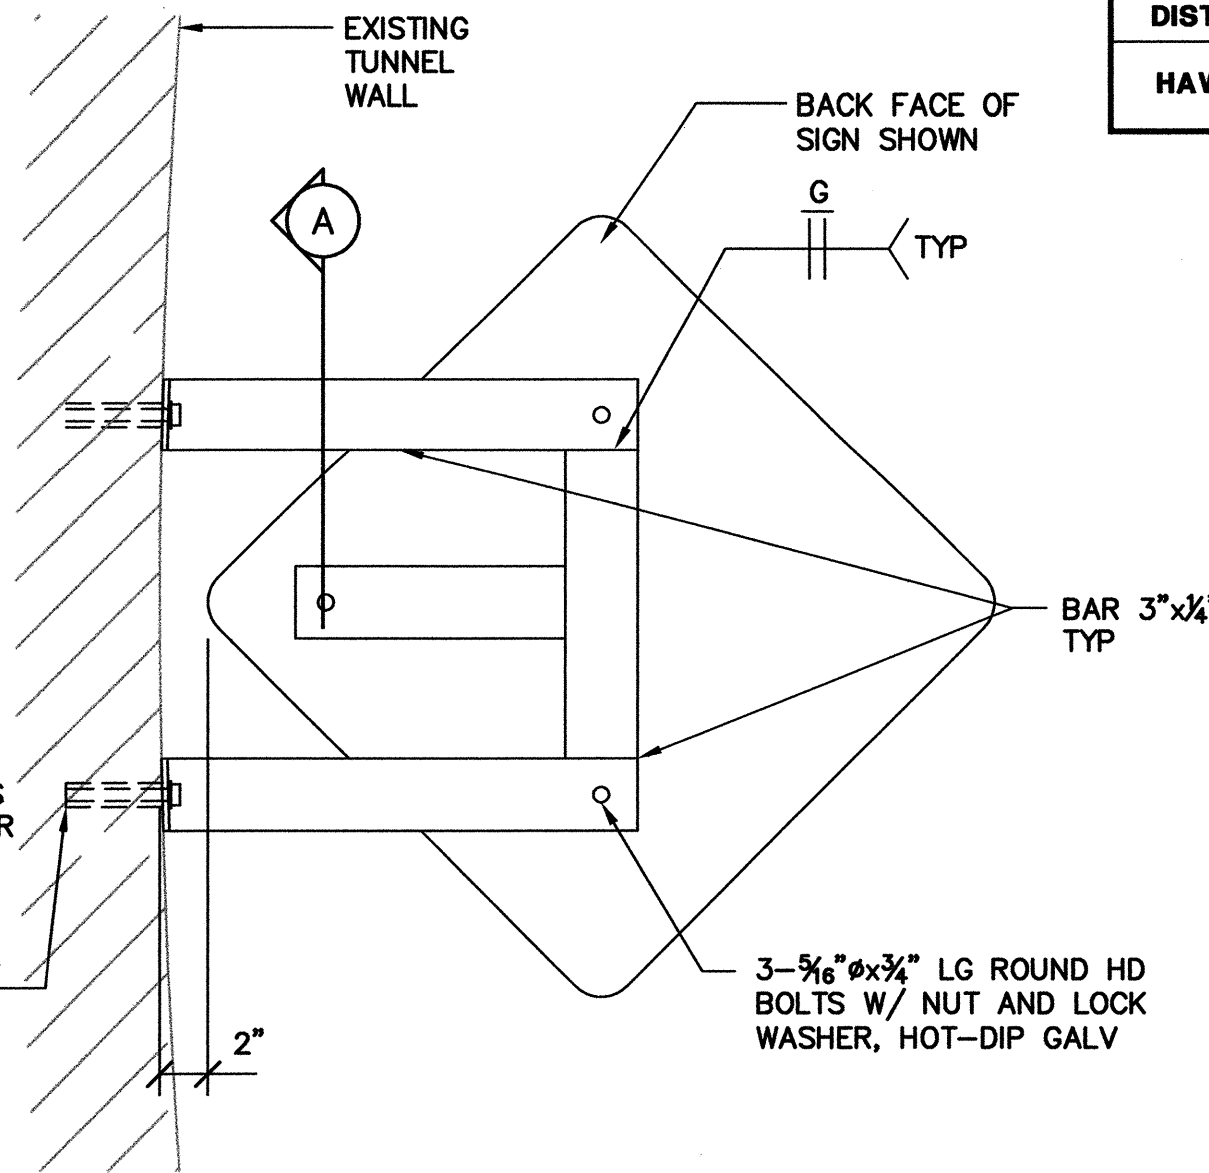


(W1-2 SIGN)
WARNING SIGN MOUNTING DETAIL
SCALE: 1 1/2" = 1'-0"

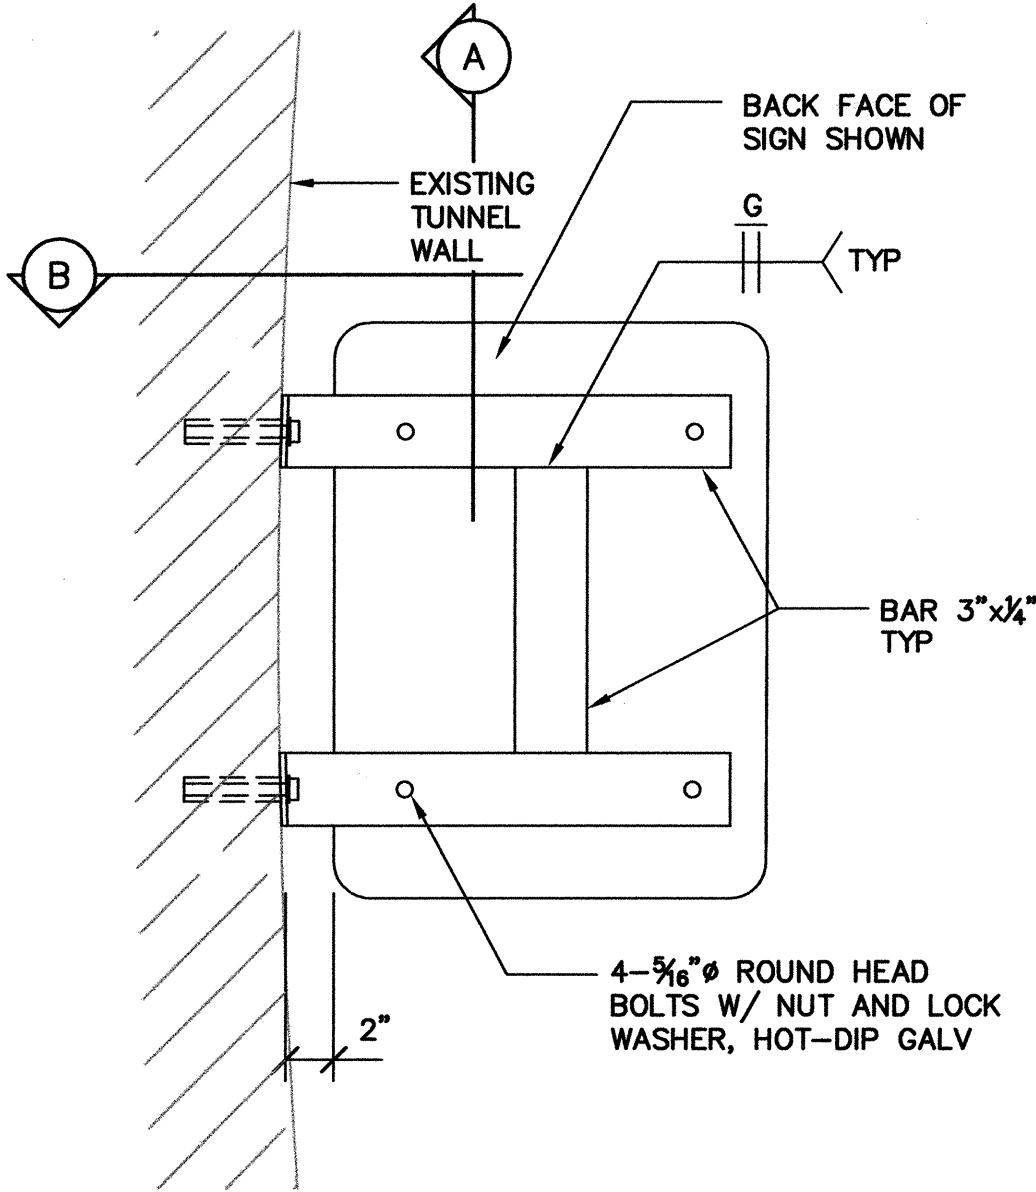

(W1-8 SIGNS)
WARNING SIGN DETAIL
SCALE: 1 1/2" = 1'-0"

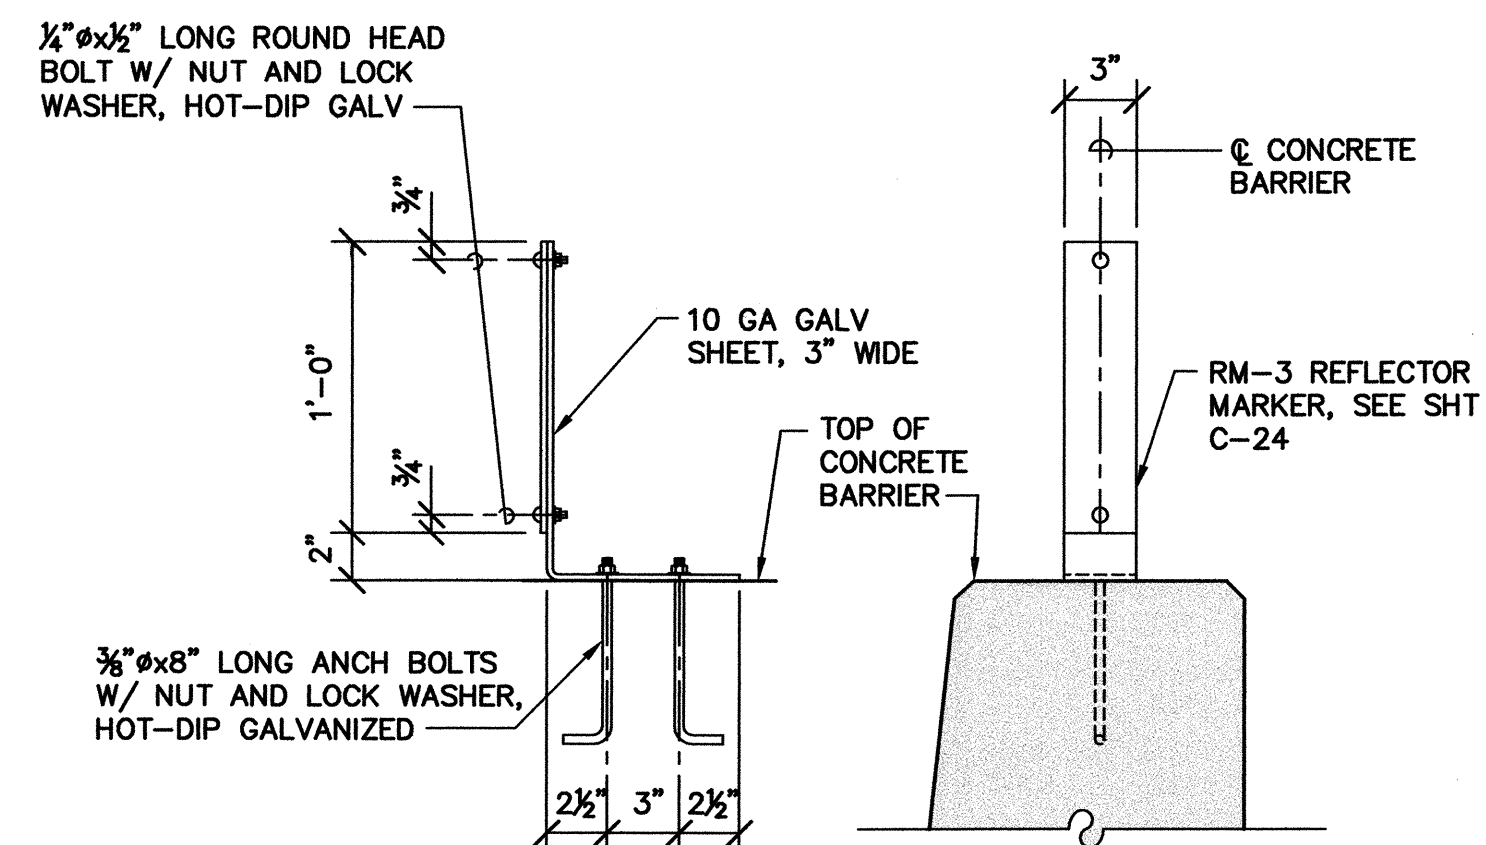


SIDE VIEW FRONT VIEW
RM-3 REFLECTOR MARKER
BARRIER WALL MOUNTING DETAIL
SCALE: 1 1/2" = 1'-0"

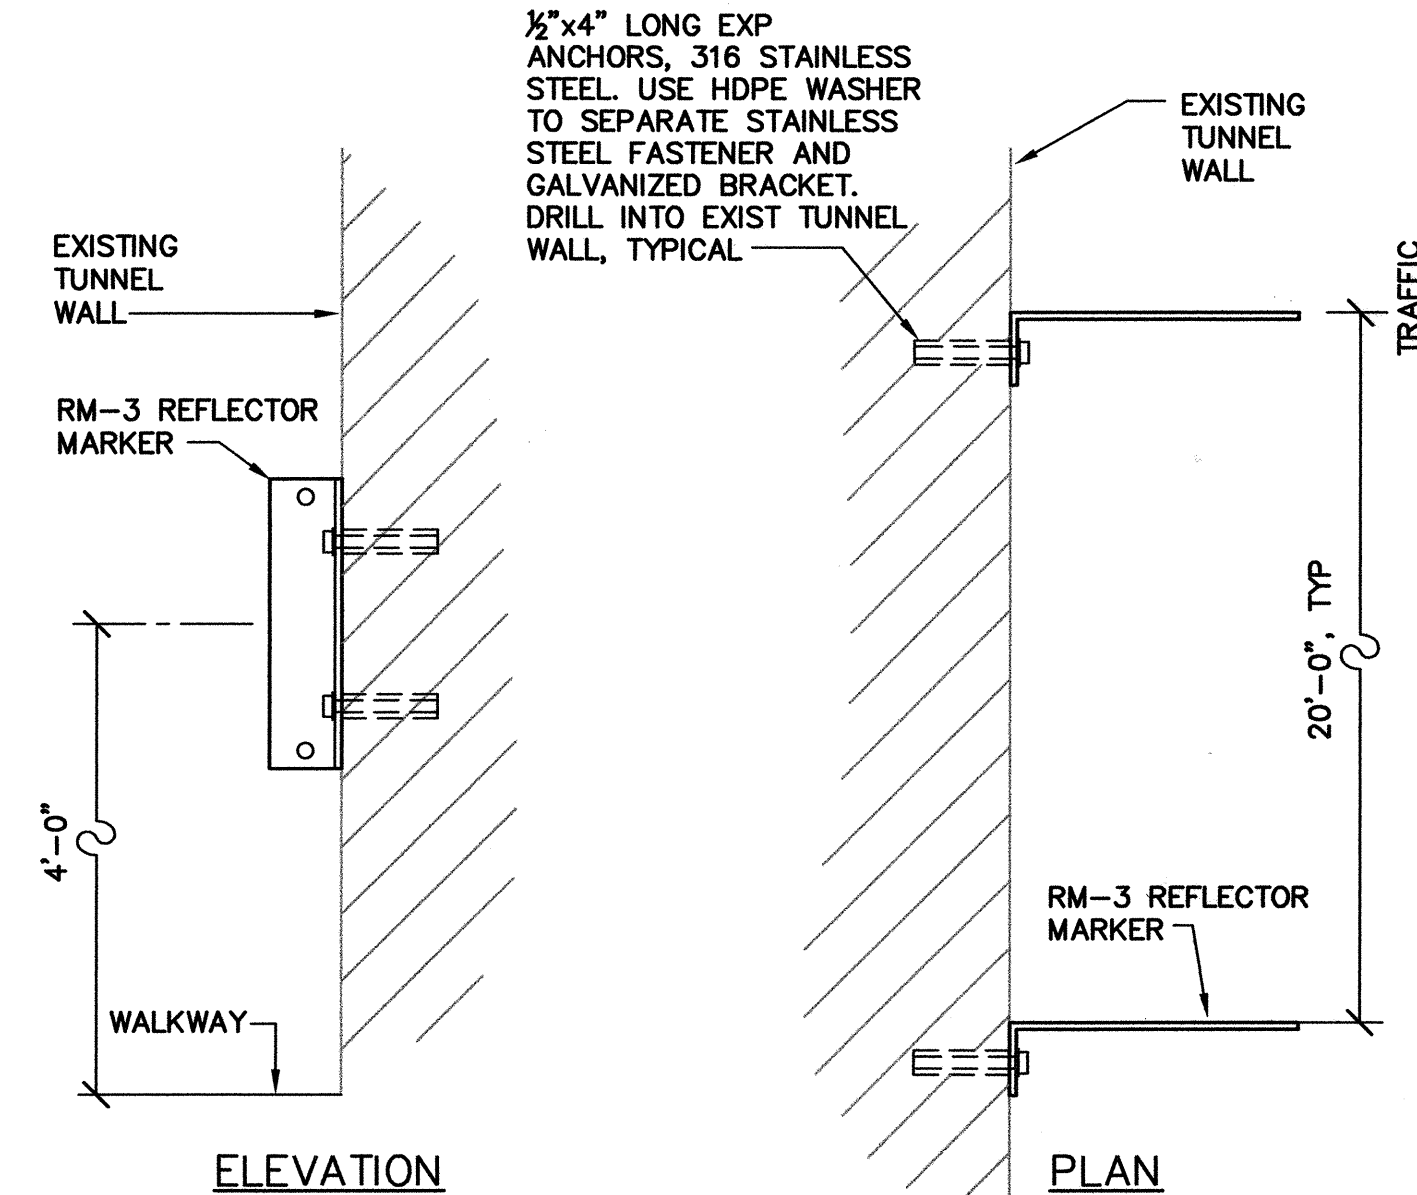

ELEVATION PLAN
RM-3 REFLECTOR MARKER
TUNNEL WALL MOUNTING DETAIL
SCALE: 1 1/2" = 1'-0"

- NOTES:
- SIGN MOUNTING BRACKETS TO BE H.D. GALV AFTER FABRICATION.
 - SIGNS TO BE MOUNTED PERPENDICULAR WITH LANE OF TRAFFIC, EXCEPT AS SHOWN IN PLAN SECTION B.
 - SIGN PLACEMENT SHALL CONFORM TO THE LATEST EDITIONS OF FHWA PUBLICATION "MANUAL OF UNIFORM TRAFFIC CONTROL DEVICES FOR STREETS AND HIGHWAYS."

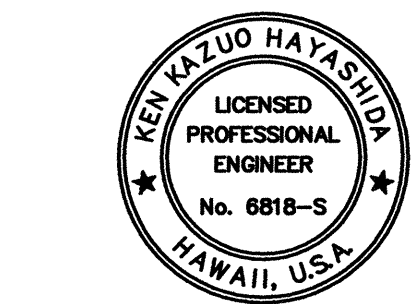


THIS WORK WAS PREPARED BY ME OR UNDER MY SUPERVISION AND CONSTRUCTION OF THIS PROJECT WILL BE UNDER MY OBSERVATION.

SIGNATURE: *[Signature]* EXPIRATION DATE OF THE LICENSE: April 30, 2004


6/20/03	Added RM-3 Detail Changed Anchor Material
Date	Revision
STATE OF HAWAII DEPARTMENT OF TRANSPORTATION HIGHWAYS DIVISION SIGN MOUNTING DETAILS <i>LIKELIKE HIGHWAY</i> <i>Wilson Tunnel Improvements</i> <i>Leak and Crack Remediation</i> <i>F. A. Project No. STP-063-1(22)</i>	
Scale: As Shown	Date: April 24, 2003
SHEET No. S-4 OF 5 SHEETS	

SURVEY PLOTTED BY	DATE
DRAWN BY	
NOTED BY	
CHECKED BY	
ORIGINAL PLAN	
NOTE BOOK	
QUANTITIES BY	
CHECKED BY	
No.	


FED. ROAD DIST. NO.	STATE	FED. AID PROJ. NO.	FISCAL YEAR	SHEET NO.	TOTAL SHEETS
HAWAII	HAW.	STP-063-1(22)	2003	ADD. 69	69

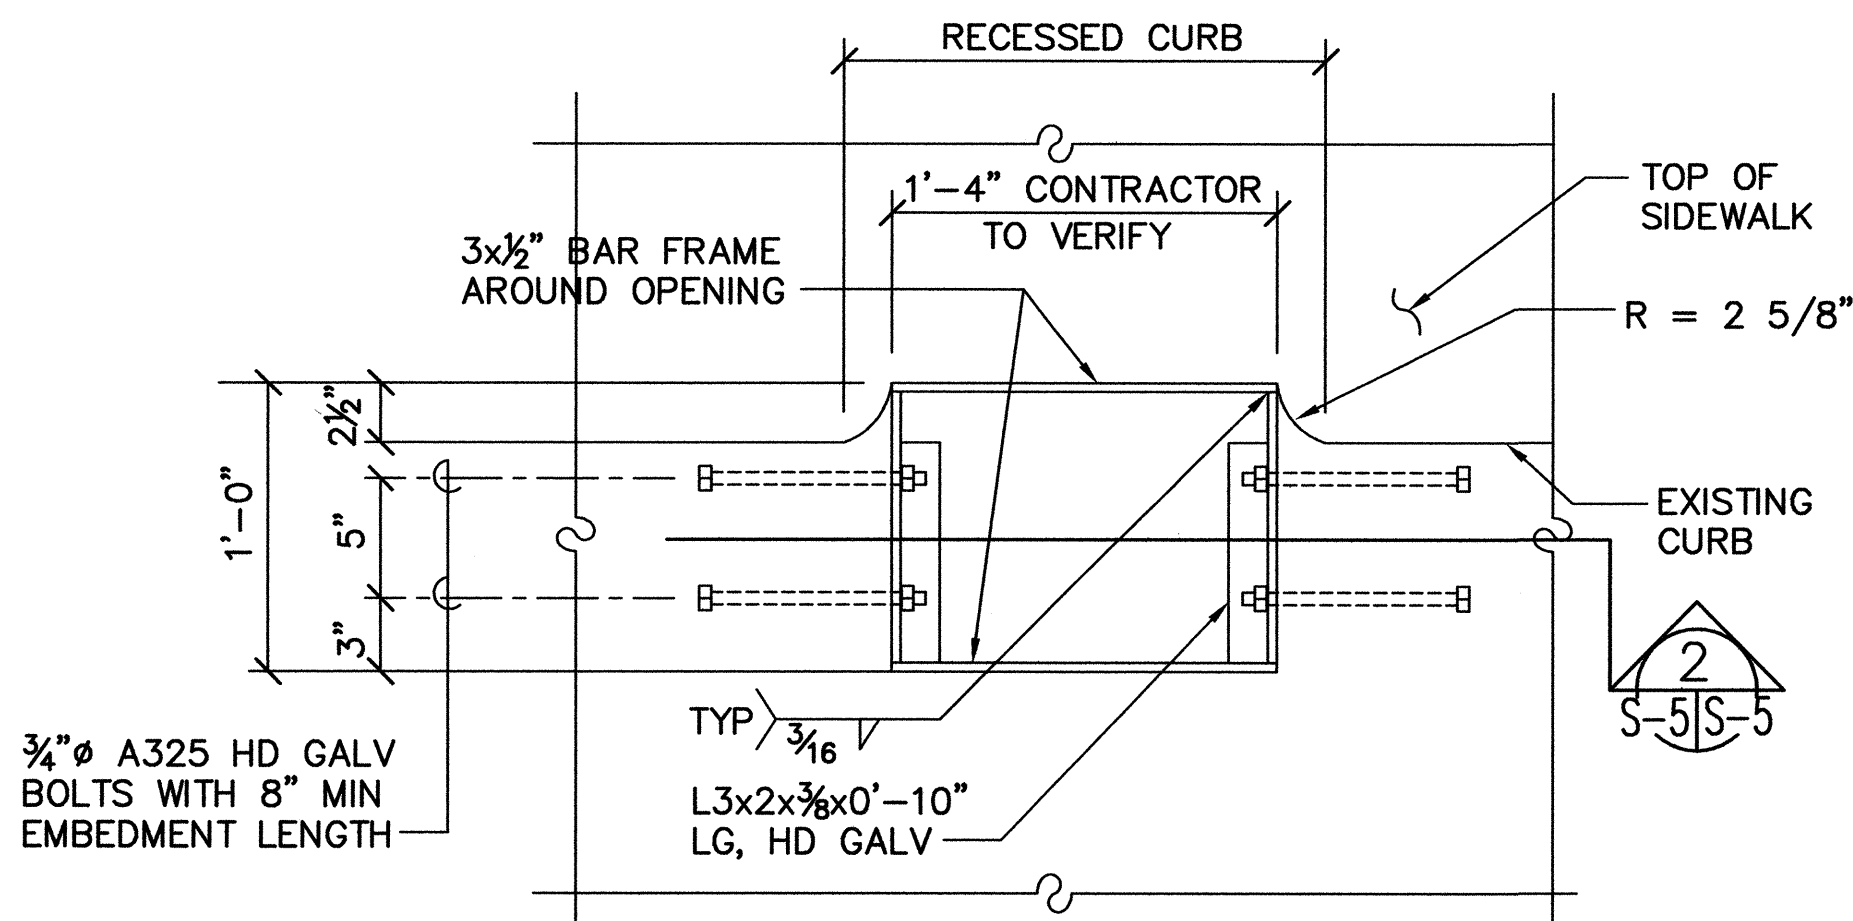


1 PLAN VIEW OF TYPICAL DRAIN INLET AND GRATE
SCALE: 1 1/2" = 1'-0"

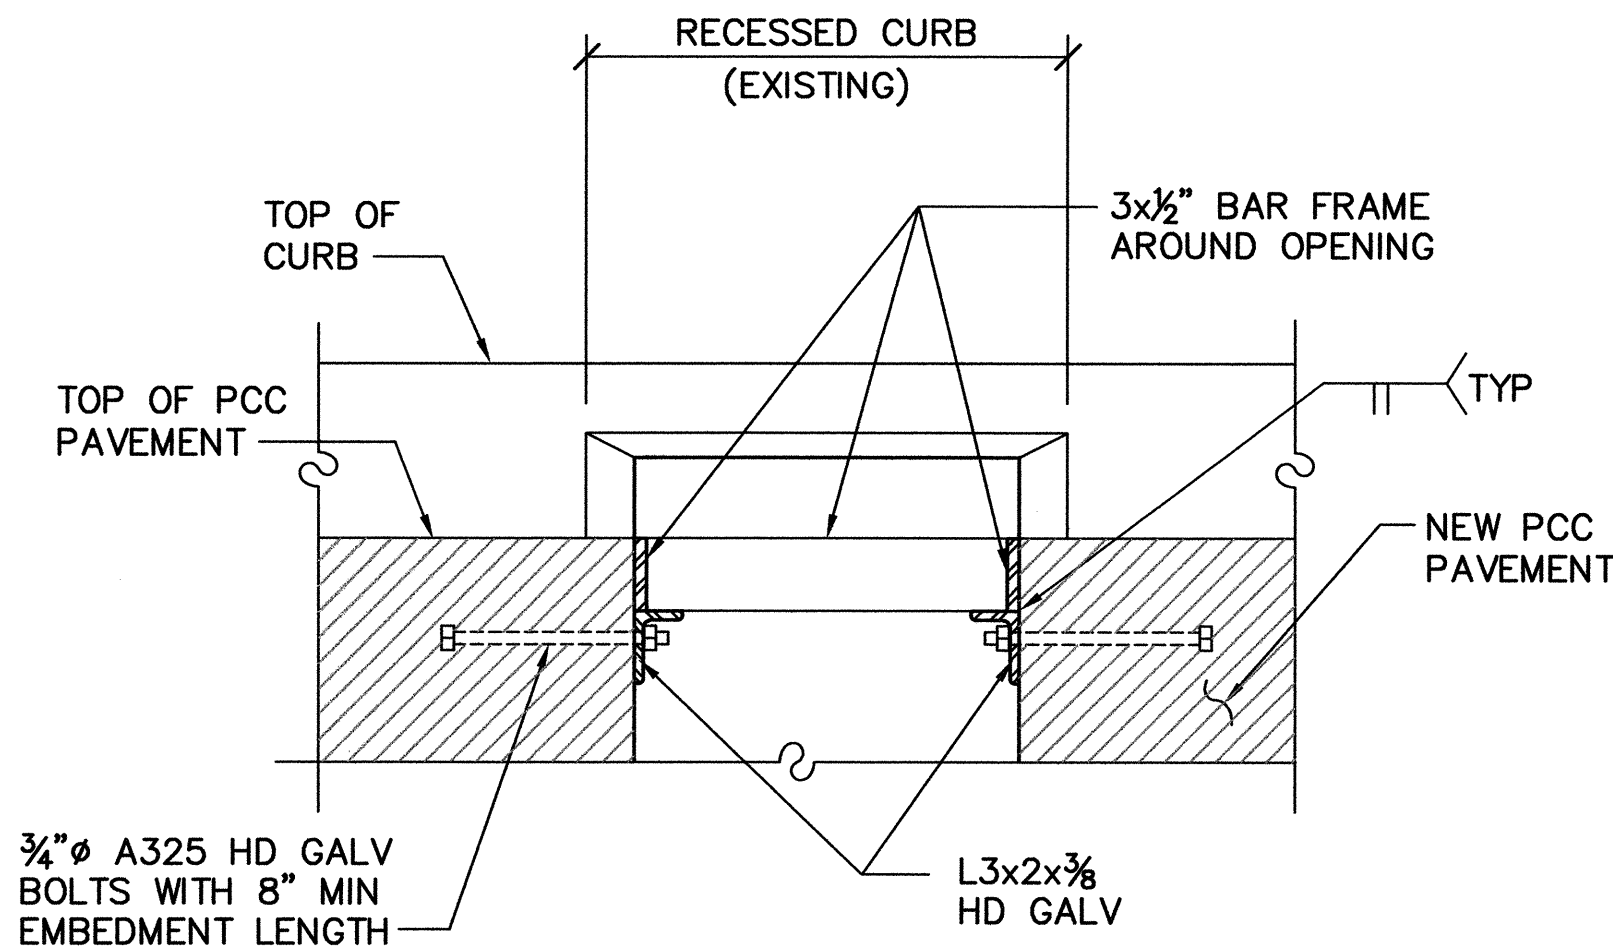


2 CROSS SECTION THRU FRAME AND GRATE
SCALE: 1 1/2" = 1'-0"

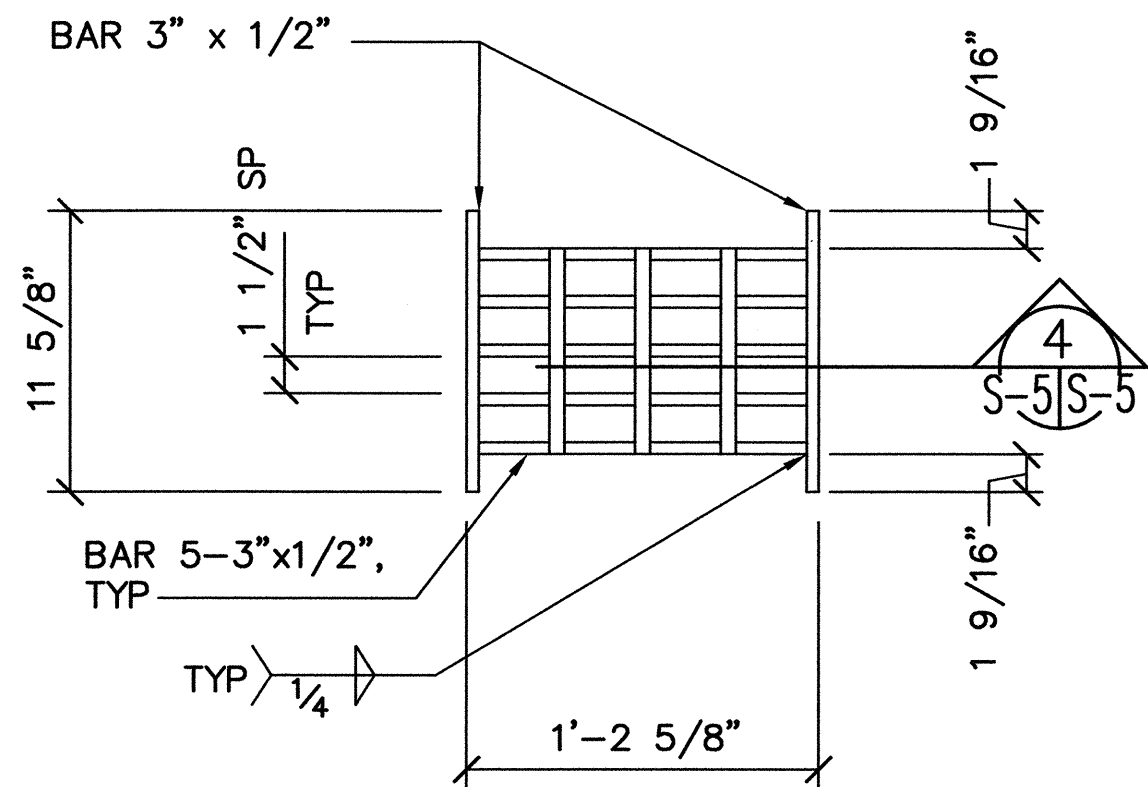


3 STEEL GRATE DETAIL
SCALE: 1 1/2" = 1'-0"

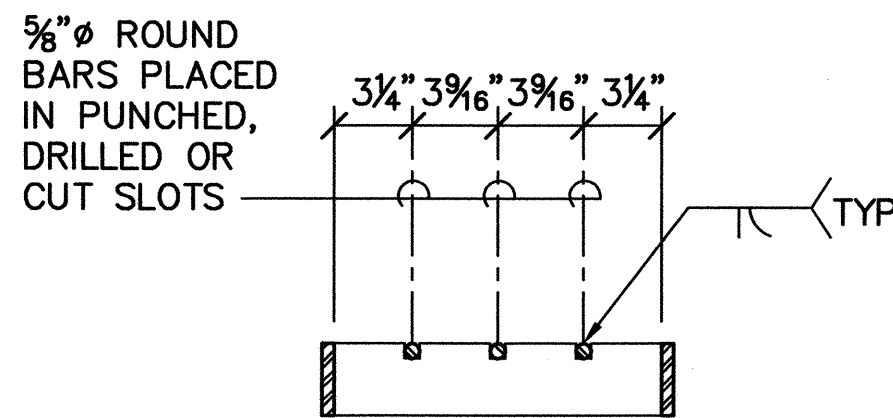


4 SECTION
SCALE: 1 1/2" = 1'-0"

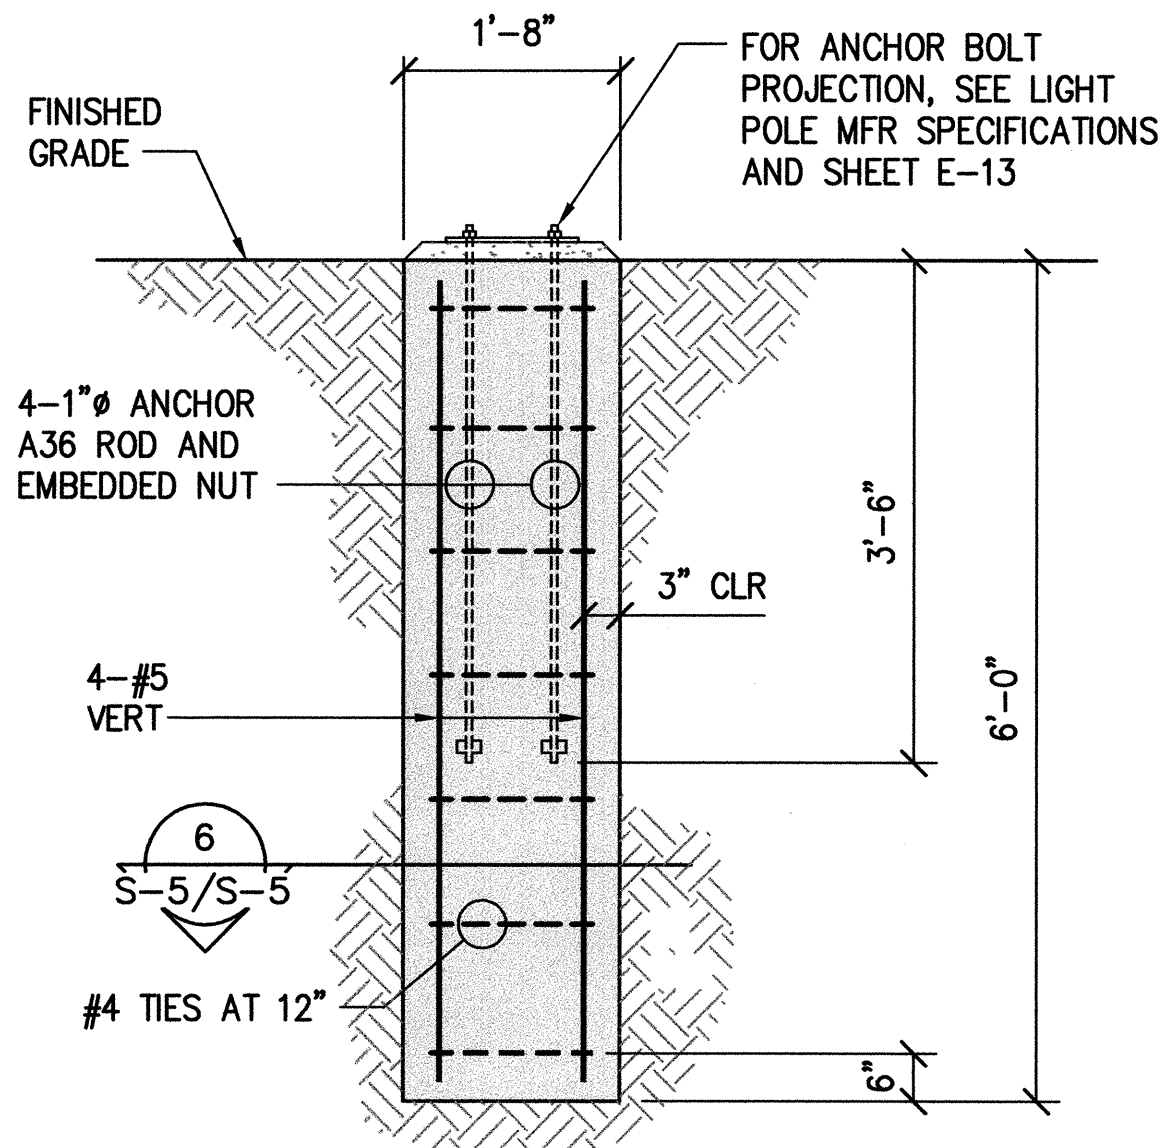

5 ELEVATION LIGHT POLE FOUNDATION
SCALE: 3/4" = 1'-0"

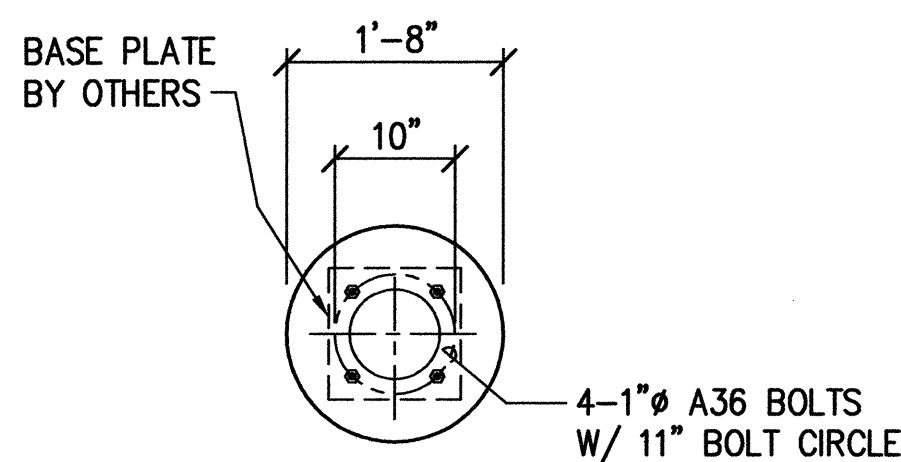

6 PLAN VIEW OF POLE FOUNDATION
SCALE: 3/4" = 1'-0"

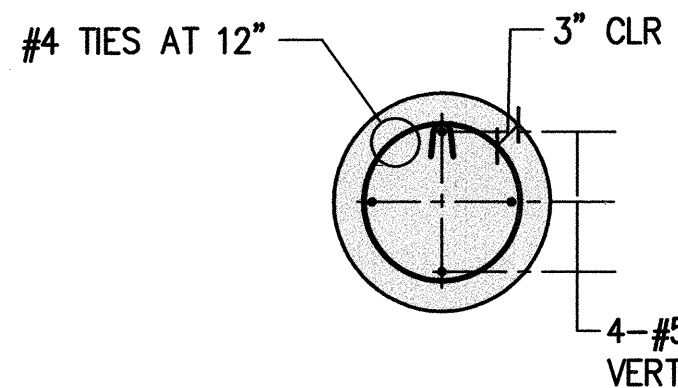

6 SECTION
SCALE: 3/4" = 1'-0"

NOTE:
1. ALL STEEL MEMBERS SHALL BE HOT DIP GALVANIZED AFTER FABRICATION.




THIS WORK WAS PREPARED BY ME OR UNDER MY SUPERVISION AND CONSTRUCTION OF THIS PROJECT WILL BE UNDER MY OBSERVATION.

SIGNATURE: *[Signature]*
EXPIRATION DATE OF THE LICENSE: April 30, 2004


6/20/03	Modified Details 1 and 2
Date	Revision

STATE OF HAWAII DEPARTMENT OF TRANSPORTATION HIGHWAYS DIVISION
MISCELLANEOUS DETAILS
LIKELIKE HIGHWAY
Wilson Tunnel Improvements
Leak and Crack Remediation
F. A. Project No. STP-063-1(22)
Scale: As Shown Date: June 20, 2003
SHEET No. S-5 OF 5 SHEETS

FED. ROAD DIST. NO.	STATE	FED. AID PROJ. NO.	FISCAL YEAR	SHEET NO.	TOTAL SHEETS
HAWAII	HAW.	STP-063-1(22)	2003	70	83

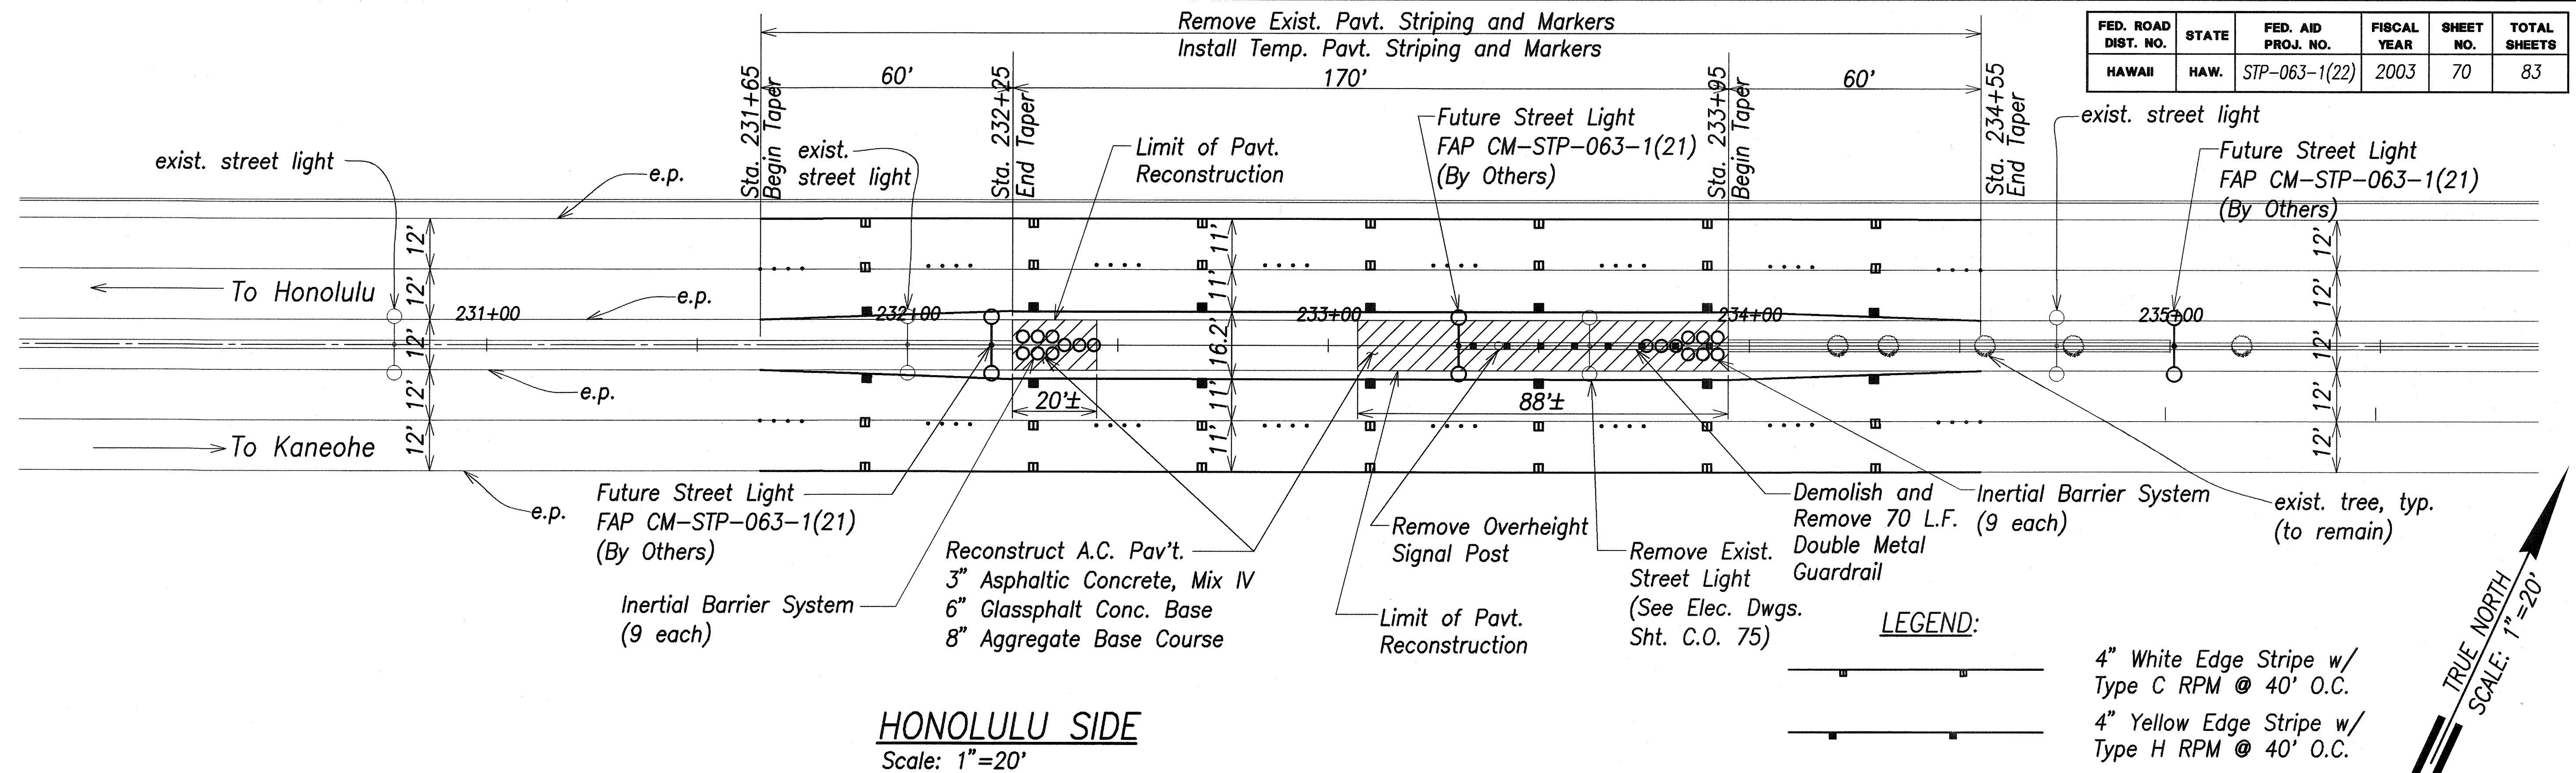



HONOLULU SIDE
Scale: 1"=20'

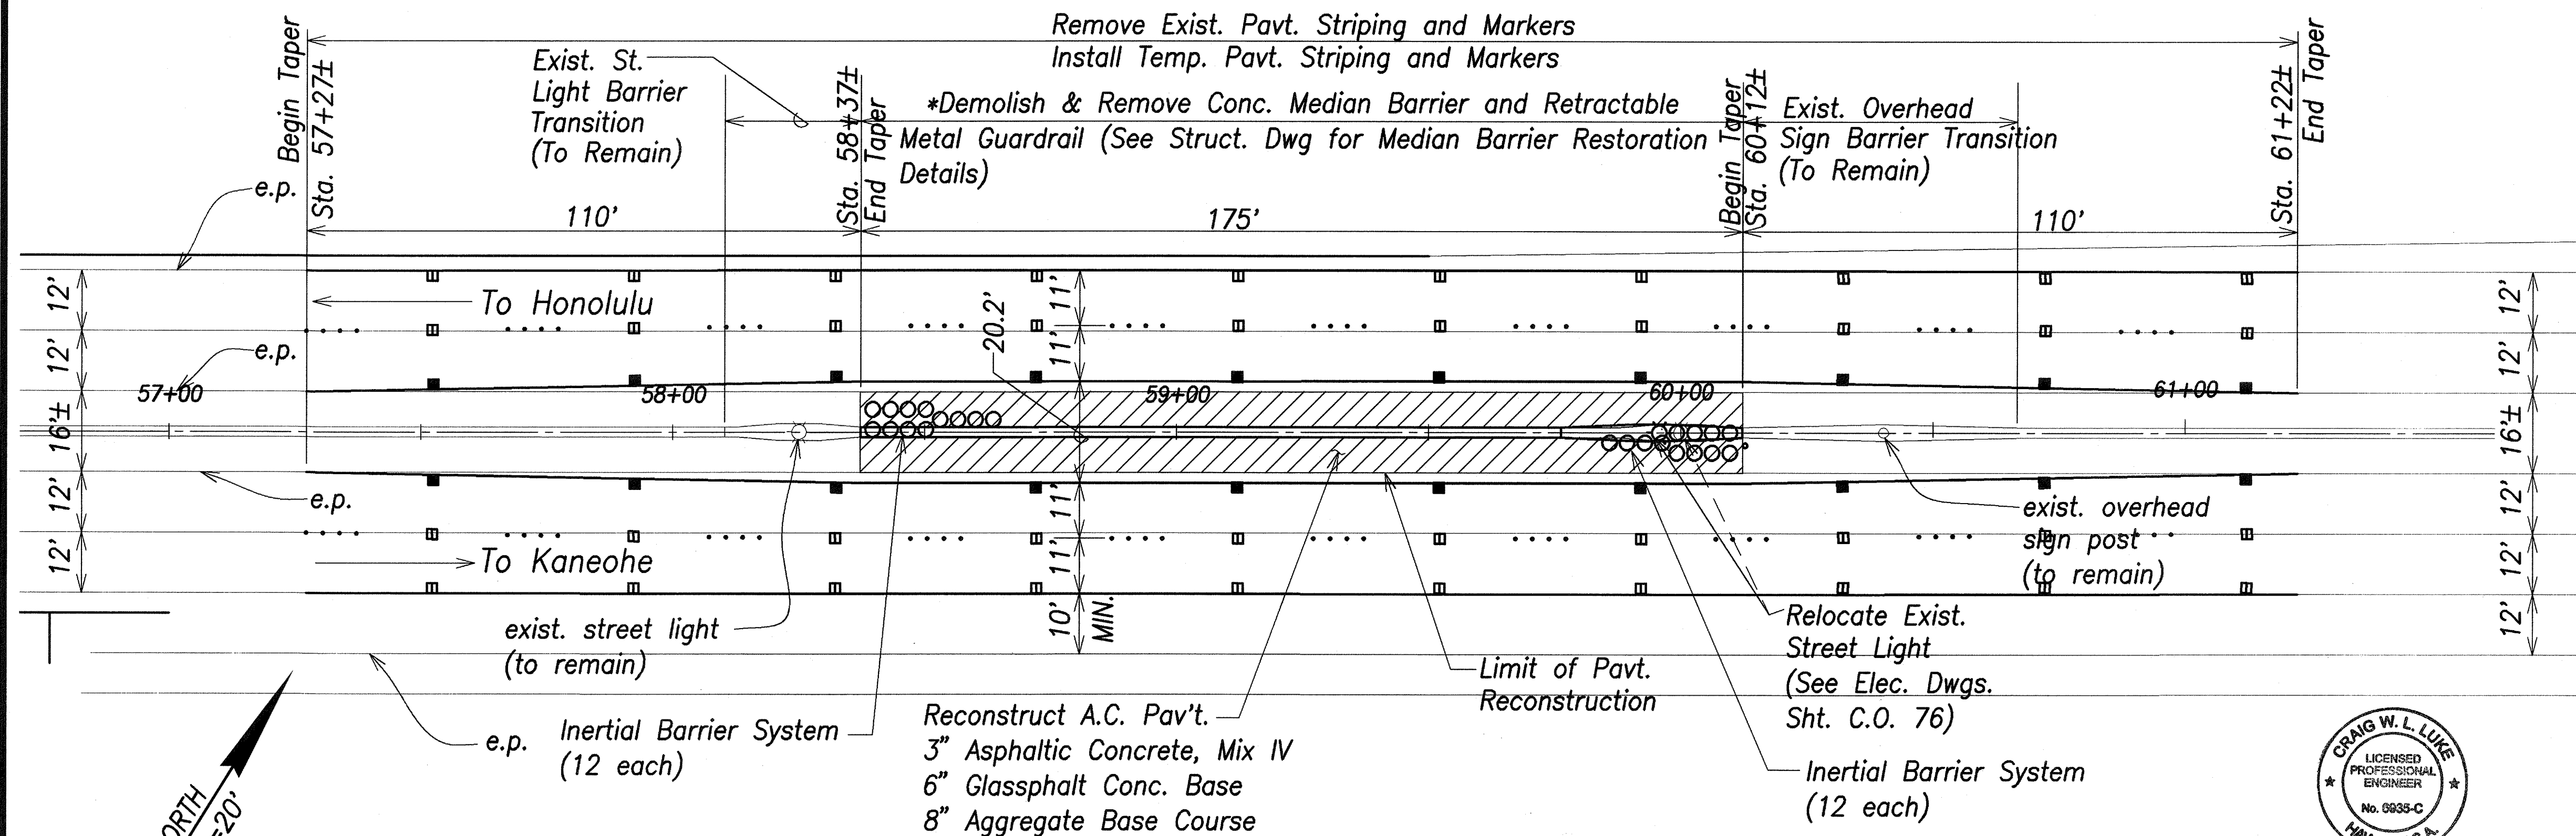

KANEOHE SIDE (AT H-3 OVERPASS)
Scale: 1"=20'

ROADWAY PLAN

NOTE:
For Street Light Relocation See Elec. Dwgs.

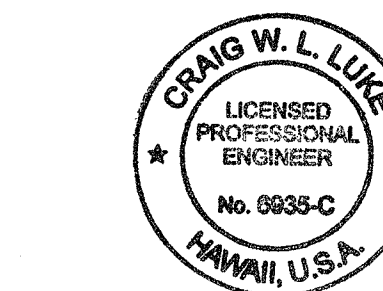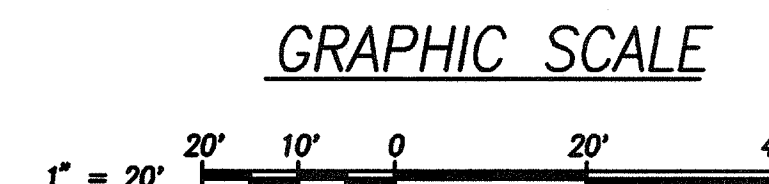

THIS WORK WAS PREPARED BY ME OR UNDER MY SUPERVISION AND CONSTRUCTION OF THIS PROJECT WILL BE UNDER MY OBSERVATION.

SIGNATURE: *[Signature]* April 30, 2004 EXPIRATION DATE OF THE LICENSE

- NOTES:**
- For Street Light and Overheight Post Removal See Elec. Dwgs.
 - Contractor Shall Protect Exist. Pullboxes and Handholes with Steel Plates.
 - Contractor Shall Restore Pavt. Striping and Markers to Full, 12' Travelway Widths Upon Completion of Crossover Traffic Control.
 - *Contractor Shall Verify Location of Removable Metal Guardrail, Barrier Transitions, Street Lights, and Signs at Kaneohe Side Prior to Construction.

STATE OF HAWAII
DEPARTMENT OF TRANSPORTATION
HIGHWAYS DIVISION

ROADWAY PLAN

LIKELIKE HIGHWAY

Wilson Tunnel Improvements


Leak and Crack Remediation

F. A. Project No. STP-063-1(22)
Scale: 1"=20' Date: December 23, 2004

SHEET No. C-1 OF 14 SHEETS

"AS-BUILT" C.O. 70

FED. ROAD DIST. NO.	STATE	FED. AID PROJ. NO.	FISCAL YEAR	SHEET NO.	TOTAL SHEETS
HAWAII	HAW.	STP-063-1(22)	2003	75	83

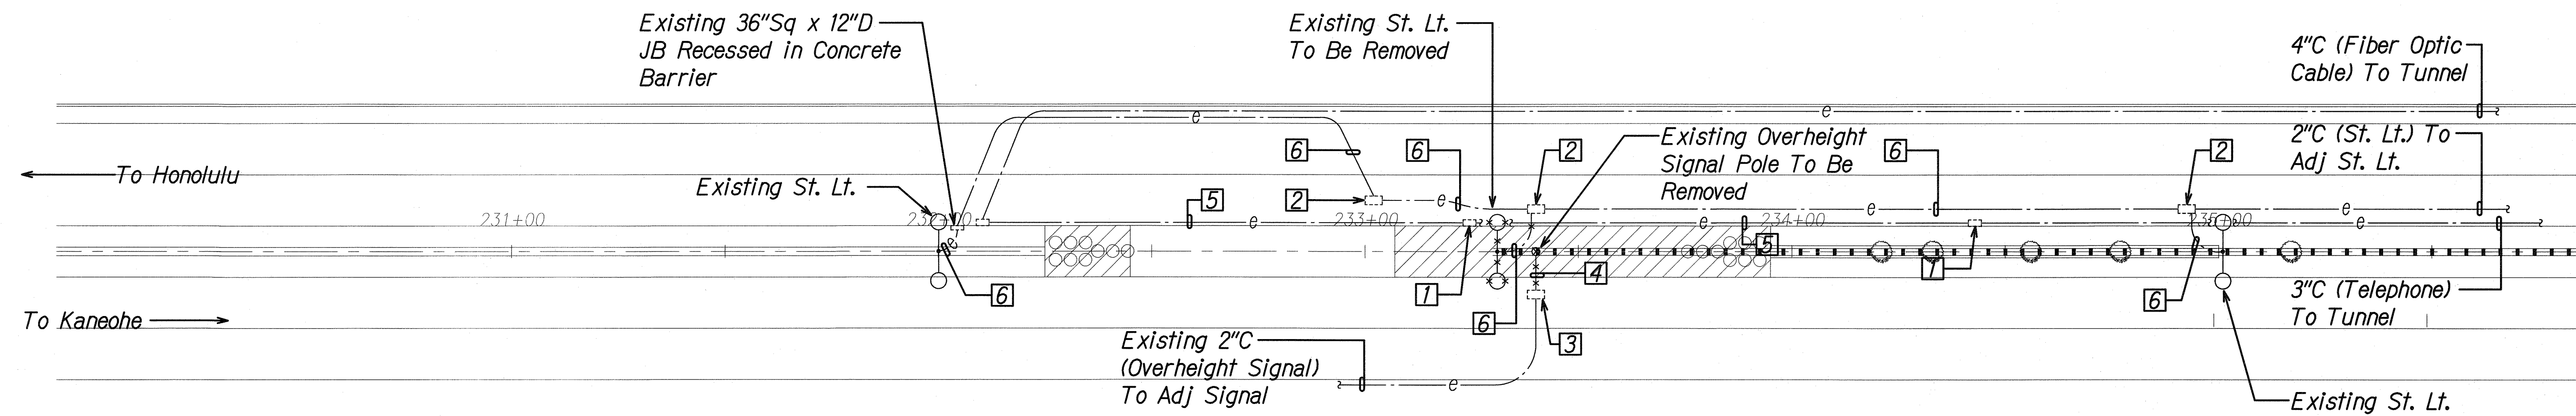

NOTES:

1. Dashed Line Symbol Denotes "Existing Item". Solid Line Symbol Denotes "New Item".

2. "X" Thru Item Denotes "Existing Item To Be Removed".

3. Contractor Shall Provide Temporary Street Lighting Until Installation of the New Street Light Poles Is Complete. New Street Light Poles to be Installed By Others.
4. 1 Existing 18" x 36" Telephone Pullbox.

2 Existing 2' x 4' St. Lt. Pullbox.

3 Existing 2' x 4' Overheight Signal Pullbox.

4 Existing 2" C (Overheight Signal).

5 Existing 3" C (Telephone).

6 Existing 2" C (St. Lt.).




ROADWAY ELECTRICAL PLAN - HONOLULU SIDE
SCALE: 1"=20'

LEGEND FOR AS-BUILT POSTINGS	
	Squiggly line for as-built deletion
	Double line for as-built deletion
	Text for as-built posting


ORIGINAL PLAN	SURVEY PLOTTED BY	DATE
NOTE BOOK	DRAWN BY	
No.	DESIGNED BY	
	QUANTITIES BY	
	CHECKED BY	

LAST SAVE: 12/27/04 @ 10:28:13 PM
Z:\MAD\PROJECTS\22055\Micro Station\0275_E-01_22055-plant.dwg (REV) L-R-BASE

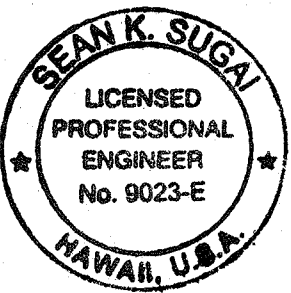

THIS WORK WAS PREPARED BY ME OR UNDER MY SUPERVISION AND CONSTRUCTION OF THIS PROJECT WILL BE UNDER MY OBSERVATION.


SIGNATURE: *Sean K. Sugai*
April 30, 2006
EXPIRATION DATE OF THE LICENSE

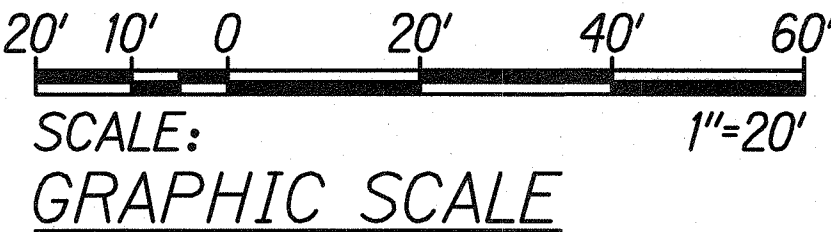

STATE OF HAWAII
DEPARTMENT OF TRANSPORTATION
HIGHWAYS DIVISION
ELECTRICAL ROADWAY PLAN - HONOLULU SIDE
LIKIE HIGHWAY
Wilson Tunnel Improvements
Leak and Crack Remediation
F. A. Project No. STP-063-1(22)

Scale: 1"=20'
Date: Dec 23, 2004
SHEET No. **E-1** OF **14** SHEETS

FED. ROAD DIST. NO.	STATE	FED. AID PROJ. NO.	FISCAL YEAR	SHEET NO.	TOTAL SHEETS
HAWAII	HAW.	STP-063-K(22)	2003	76	83

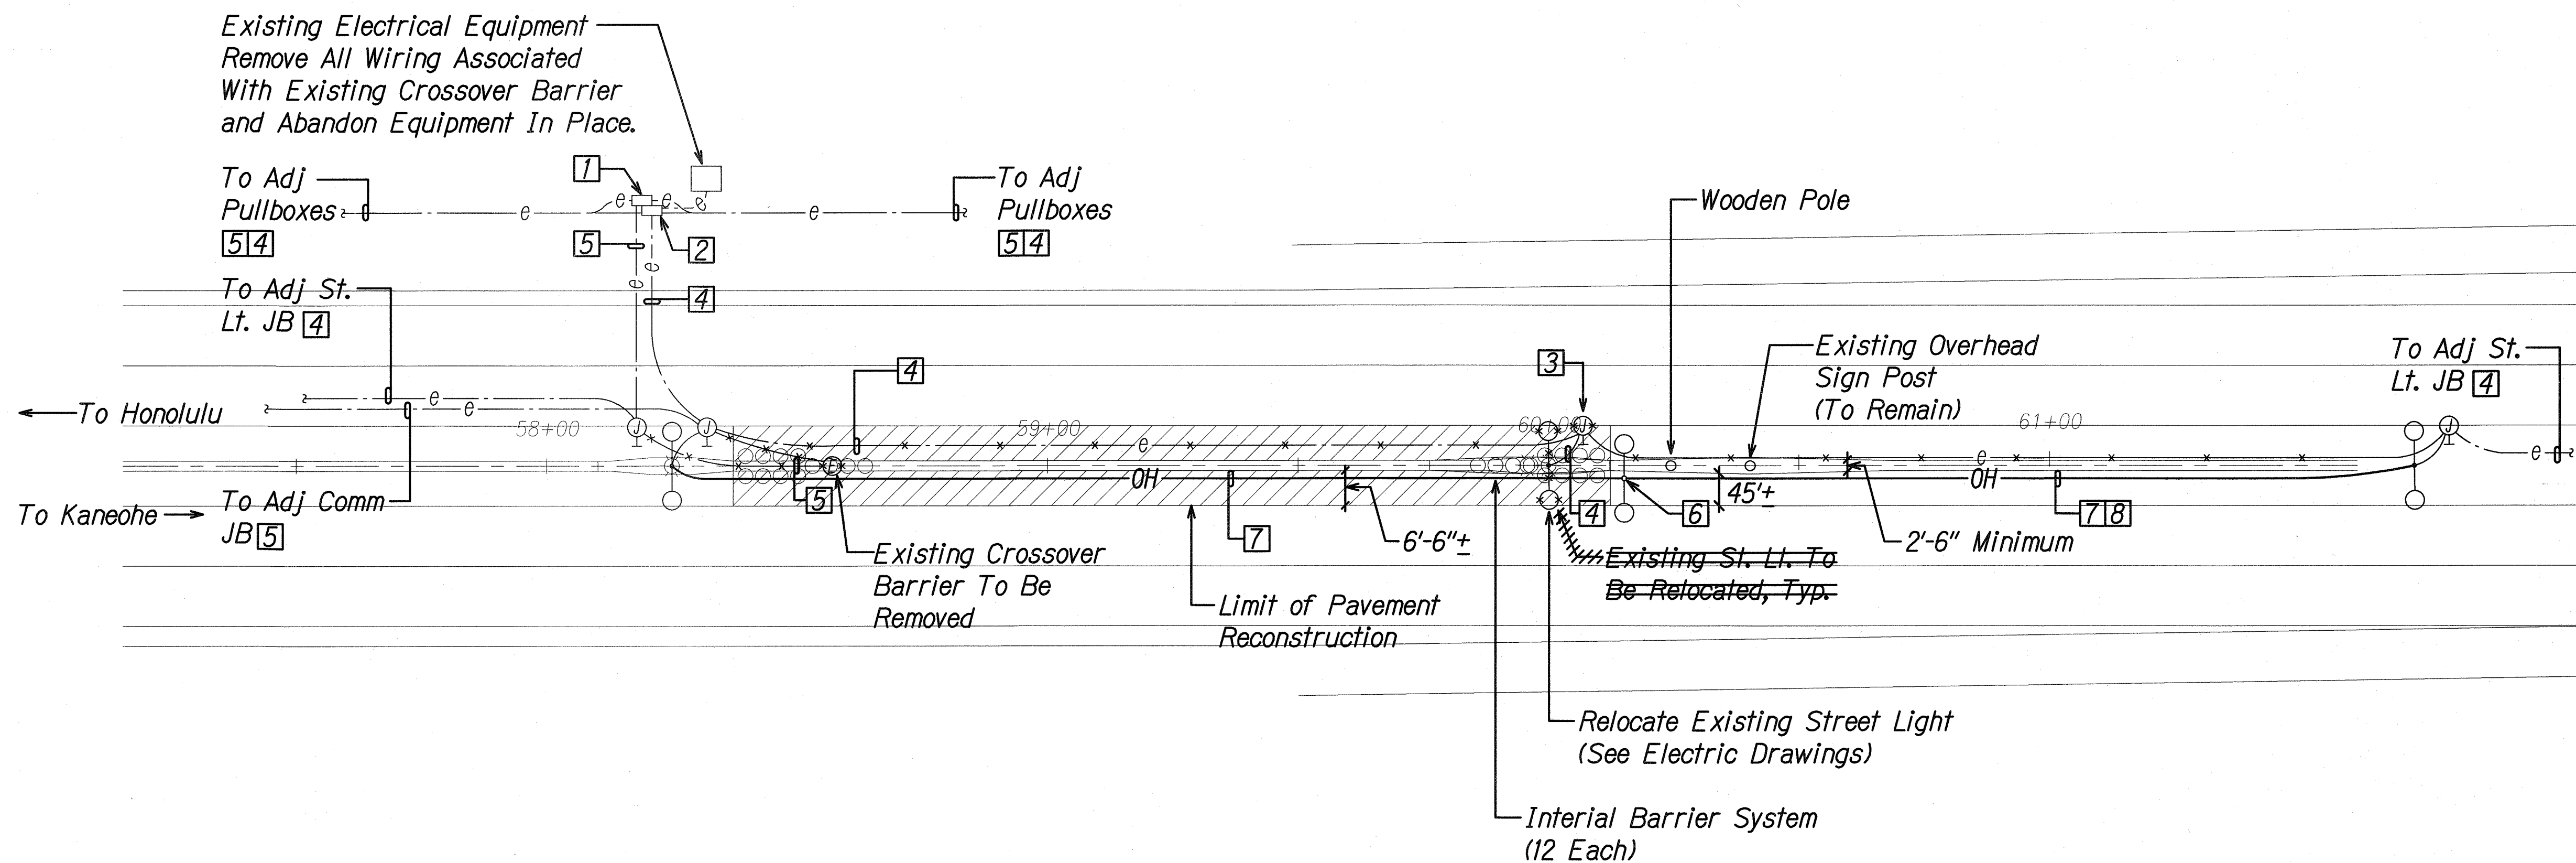

NOTES:

- All Items Shown Are Existing Unless Otherwise Noted.
- "X" Thru Item Denotes "Existing Item To Be Removed".
- Contractor Shall Provide Temporary Street Lighting Until Installation of the New Street Light Poles Is Complete.
- 1 Existing 18" x 36" Telephone Pullbox.
- 2 Existing 2' x 4' St. Lt. Pullbox.
- 3 Existing JB Recessed In Concrete Barrier.
- 4 Existing St. Lt. Conduit.
- 5 Existing Comm Conduit.
- 6 New Temporary Wood Light Pole. See Detail A/E-5.
- 7 New Temporary Overhead St. Lt Conductors.
- 8 Secure Temporary Conductors to Overhead Sign Post As Required to Maintain a Minimum Height of 18' Above Grade. Provide Messenger Wire to Minimize Conductor Sag.

LEGEND FOR AS-BUILT POSTINGS	
	Squiggly line for as-built deletion
	Double line for as-built deletion
	Text for as-built posting


SURVEY PLOTTED BY	DATE
DRAWN BY	
DESIGNED BY	
QUANTITIES BY	
CHECKED BY	
No.	

LAST SAVE: 12/20/04 @ 10:33:42 PM: 80 PLOT SET 1-20
 C:\AD\PROJECTS\2003\Wilson Tunnel\Drawings\AS-BUILT\AS-BUILT.DWG




ROADWAY ELECTRICAL DEMOLITION PLAN - KANEOHE SIDE (AT H-3 OVERPASS)

SCALE: 1"=20'

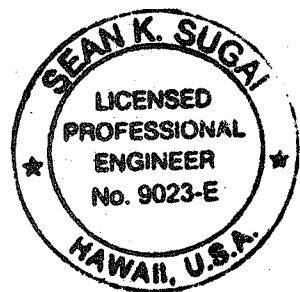

THIS WORK WAS PREPARED BY ME OR UNDER MY SUPERVISION AND CONSTRUCTION OF THIS PROJECT WILL BE UNDER MY OBSERVATION.

SIGNATURE: *Sean K. Sugai*
 April 30, 2006
 EXPIRATION DATE OF THE LICENSE

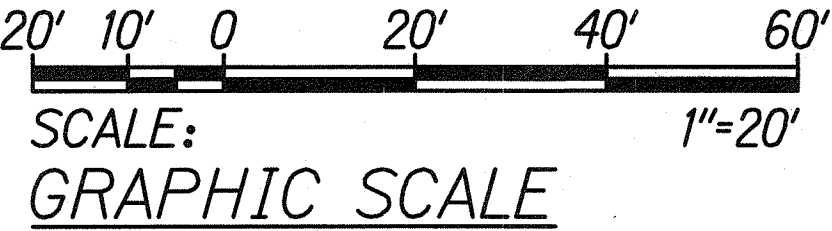

STATE OF HAWAII

DEPARTMENT OF TRANSPORTATION

ROADWAY ELECTRICAL DEMOLITION

PLAN - KANEOHE SIDE

LIKELIKE HIGHWAY

Wilson Tunnel Improvements

Leak and Crack Remediation

E. A. Project No. STP-063-K(22)

Scale: 1"=20'


Date: Dec 23, 2004

SHEET No. **E-2** OF **14** SHEETS

C.O. 76

"AS-BUILT"

FED. ROAD DIST. NO.	STATE	FED. AID PROJ. NO.	FISCAL YEAR	SHEET NO.	TOTAL SHEETS
HAWAII	HAW.	STP-063-K(22)	2003	77	83

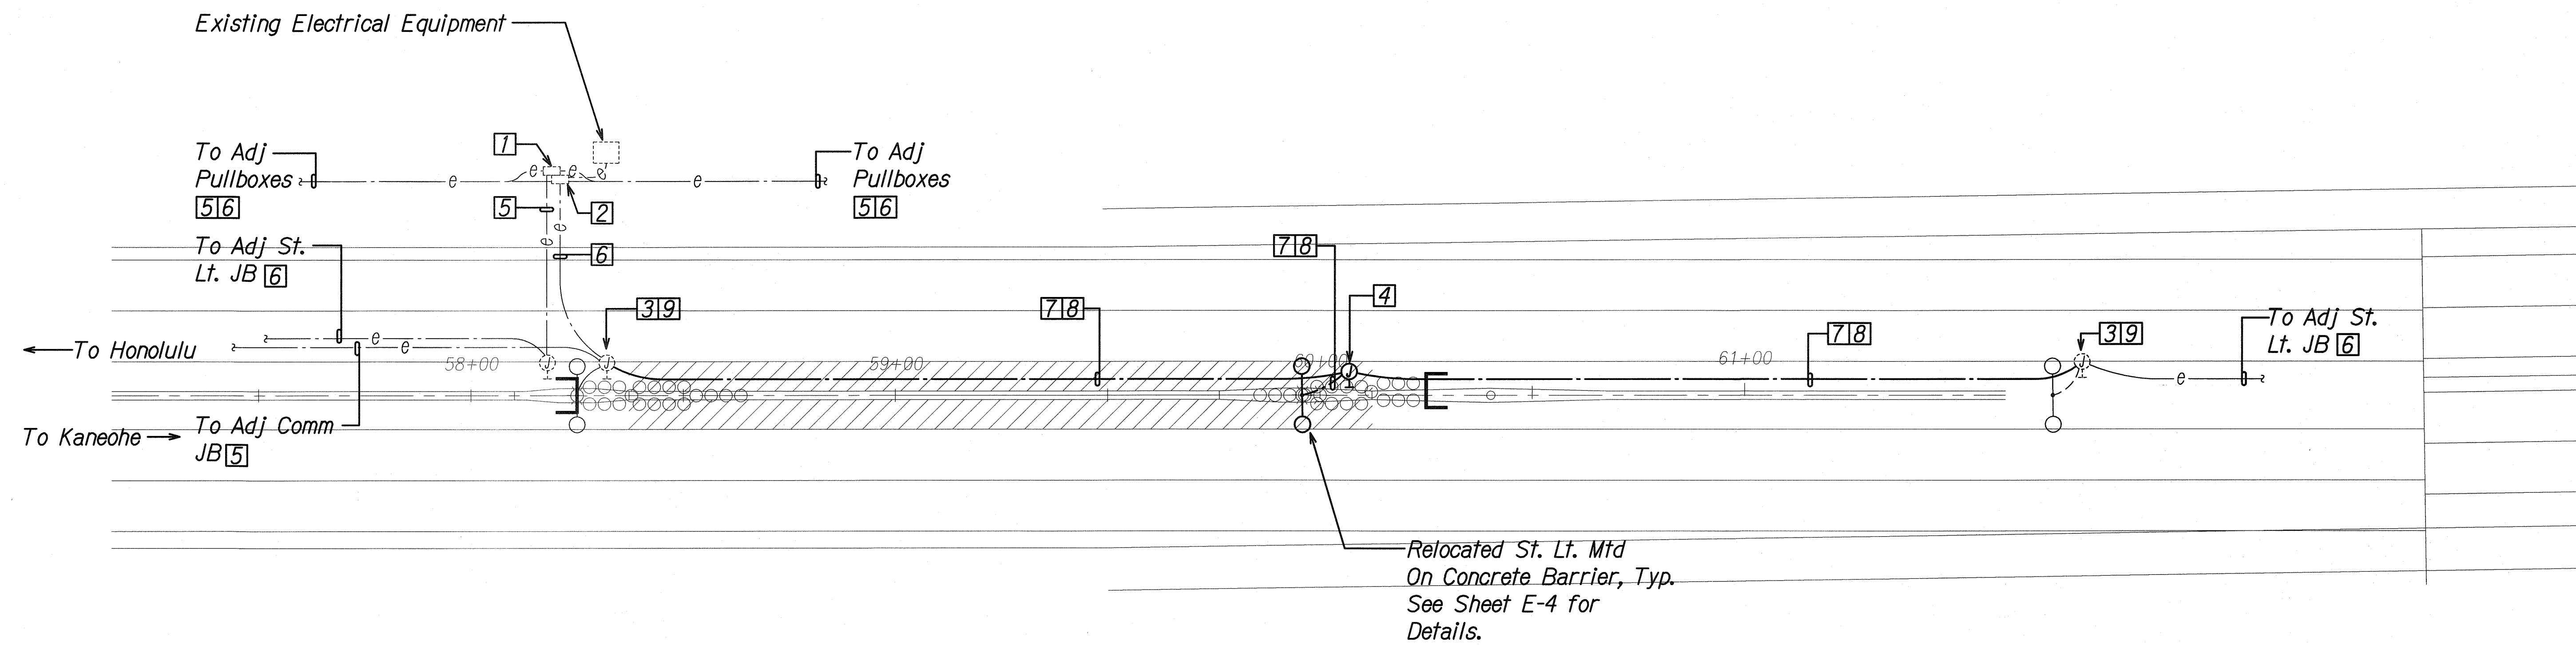

NOTES:

- Dashed Line Symbol Denotes "Existing Item". Solid Line Symbol Denotes "New Item".
- Existing 18" x 36" Telephone Pullbox.
 - Existing 2' x 4' St. Lt. Pullbox.
 - Existing JB Recessed In Concrete Barrier.
 - New 12"Sq x 6"D JB, SS, Weatherproof & Gasketed, Recessed In Concrete Barrier.
- Existing Comm Conduit.
 - Existing St. Lt. Conduit.
 - New 2"C W/ St. Lt. Conductors. Conductors Shall Be Sized to Match Existing Conductors.
 - Sawcut & Patch Existing A/C Pavement to Install Conduit. See Detail B/E-5 for Duct Section Detail.
 - Chip & Patch Existing Concrete Barrier to Install New Conduit Into Existing Recessed JB. Contractor Shall Take Necessary Precautions to Ensure That the Existing Structural Rebars Within Concrete Barrier Are Not Damaged During Construction.



ROADWAY ELECTRICAL PLAN - KANEOHE SIDE (AT H-3 OVERPASS)
SCALE: 1"=20'



THIS WORK WAS PREPARED BY ME OR UNDER MY SUPERVISION AND CONSTRUCTION OF THIS PROJECT WILL BE UNDER MY OBSERVATION.

SIGNATURE: *Sean K. Suga* April 30, 2006
EXPIRATION DATE OF THE LICENSE

LEGEND FOR AS-BUILT POSTINGS	
	Squiggly line for as-built deletion
	Double line for as-built deletion
	Text for as-built posting

STATE OF HAWAII

DEPARTMENT OF TRANSPORTATION

HIGHWAYS DIVISION

ROADWAY ELECTRICAL PLAN -

KANEOHE SIDE

LIKELIKE HIGHWAY

Wilson Tunnel Improvements

Leak and Crack Remediation

F. A. Project No. STP-063-K(22)

Scale: 1"=20'


Date: Dec 23, 2004

SHEET No. **E-3** OF **14** SHEETS

C.O. 77


SURVEY PLOTTED BY	DATE
DRAWN BY	
DESIGNED BY	
QUANTITIES BY	
CHECKED BY	
NO.	

LAST SAVE: 12/20/04 @ 10:53:27 BY: BO PILOT SC 1:20
K:\AS-BUILT\STP-063-K(22)\E-3\2206-E-3.dwg (REV) 1:20

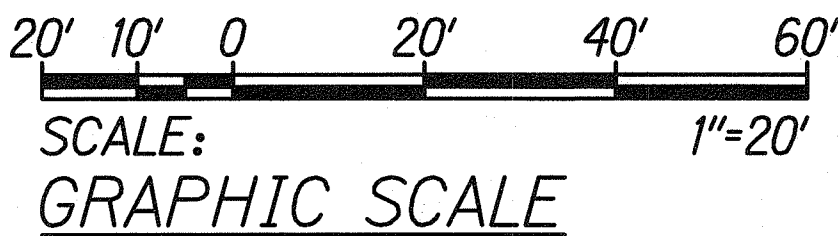


"AS-BUILT"

FED. ROAD DIST. NO.	STATE	FED. AID PROJ. NO.	FISCAL YEAR	SHEET NO.	TOTAL SHEETS
HAWAII	HAW.	STP-063-1(22)	2003	78	83

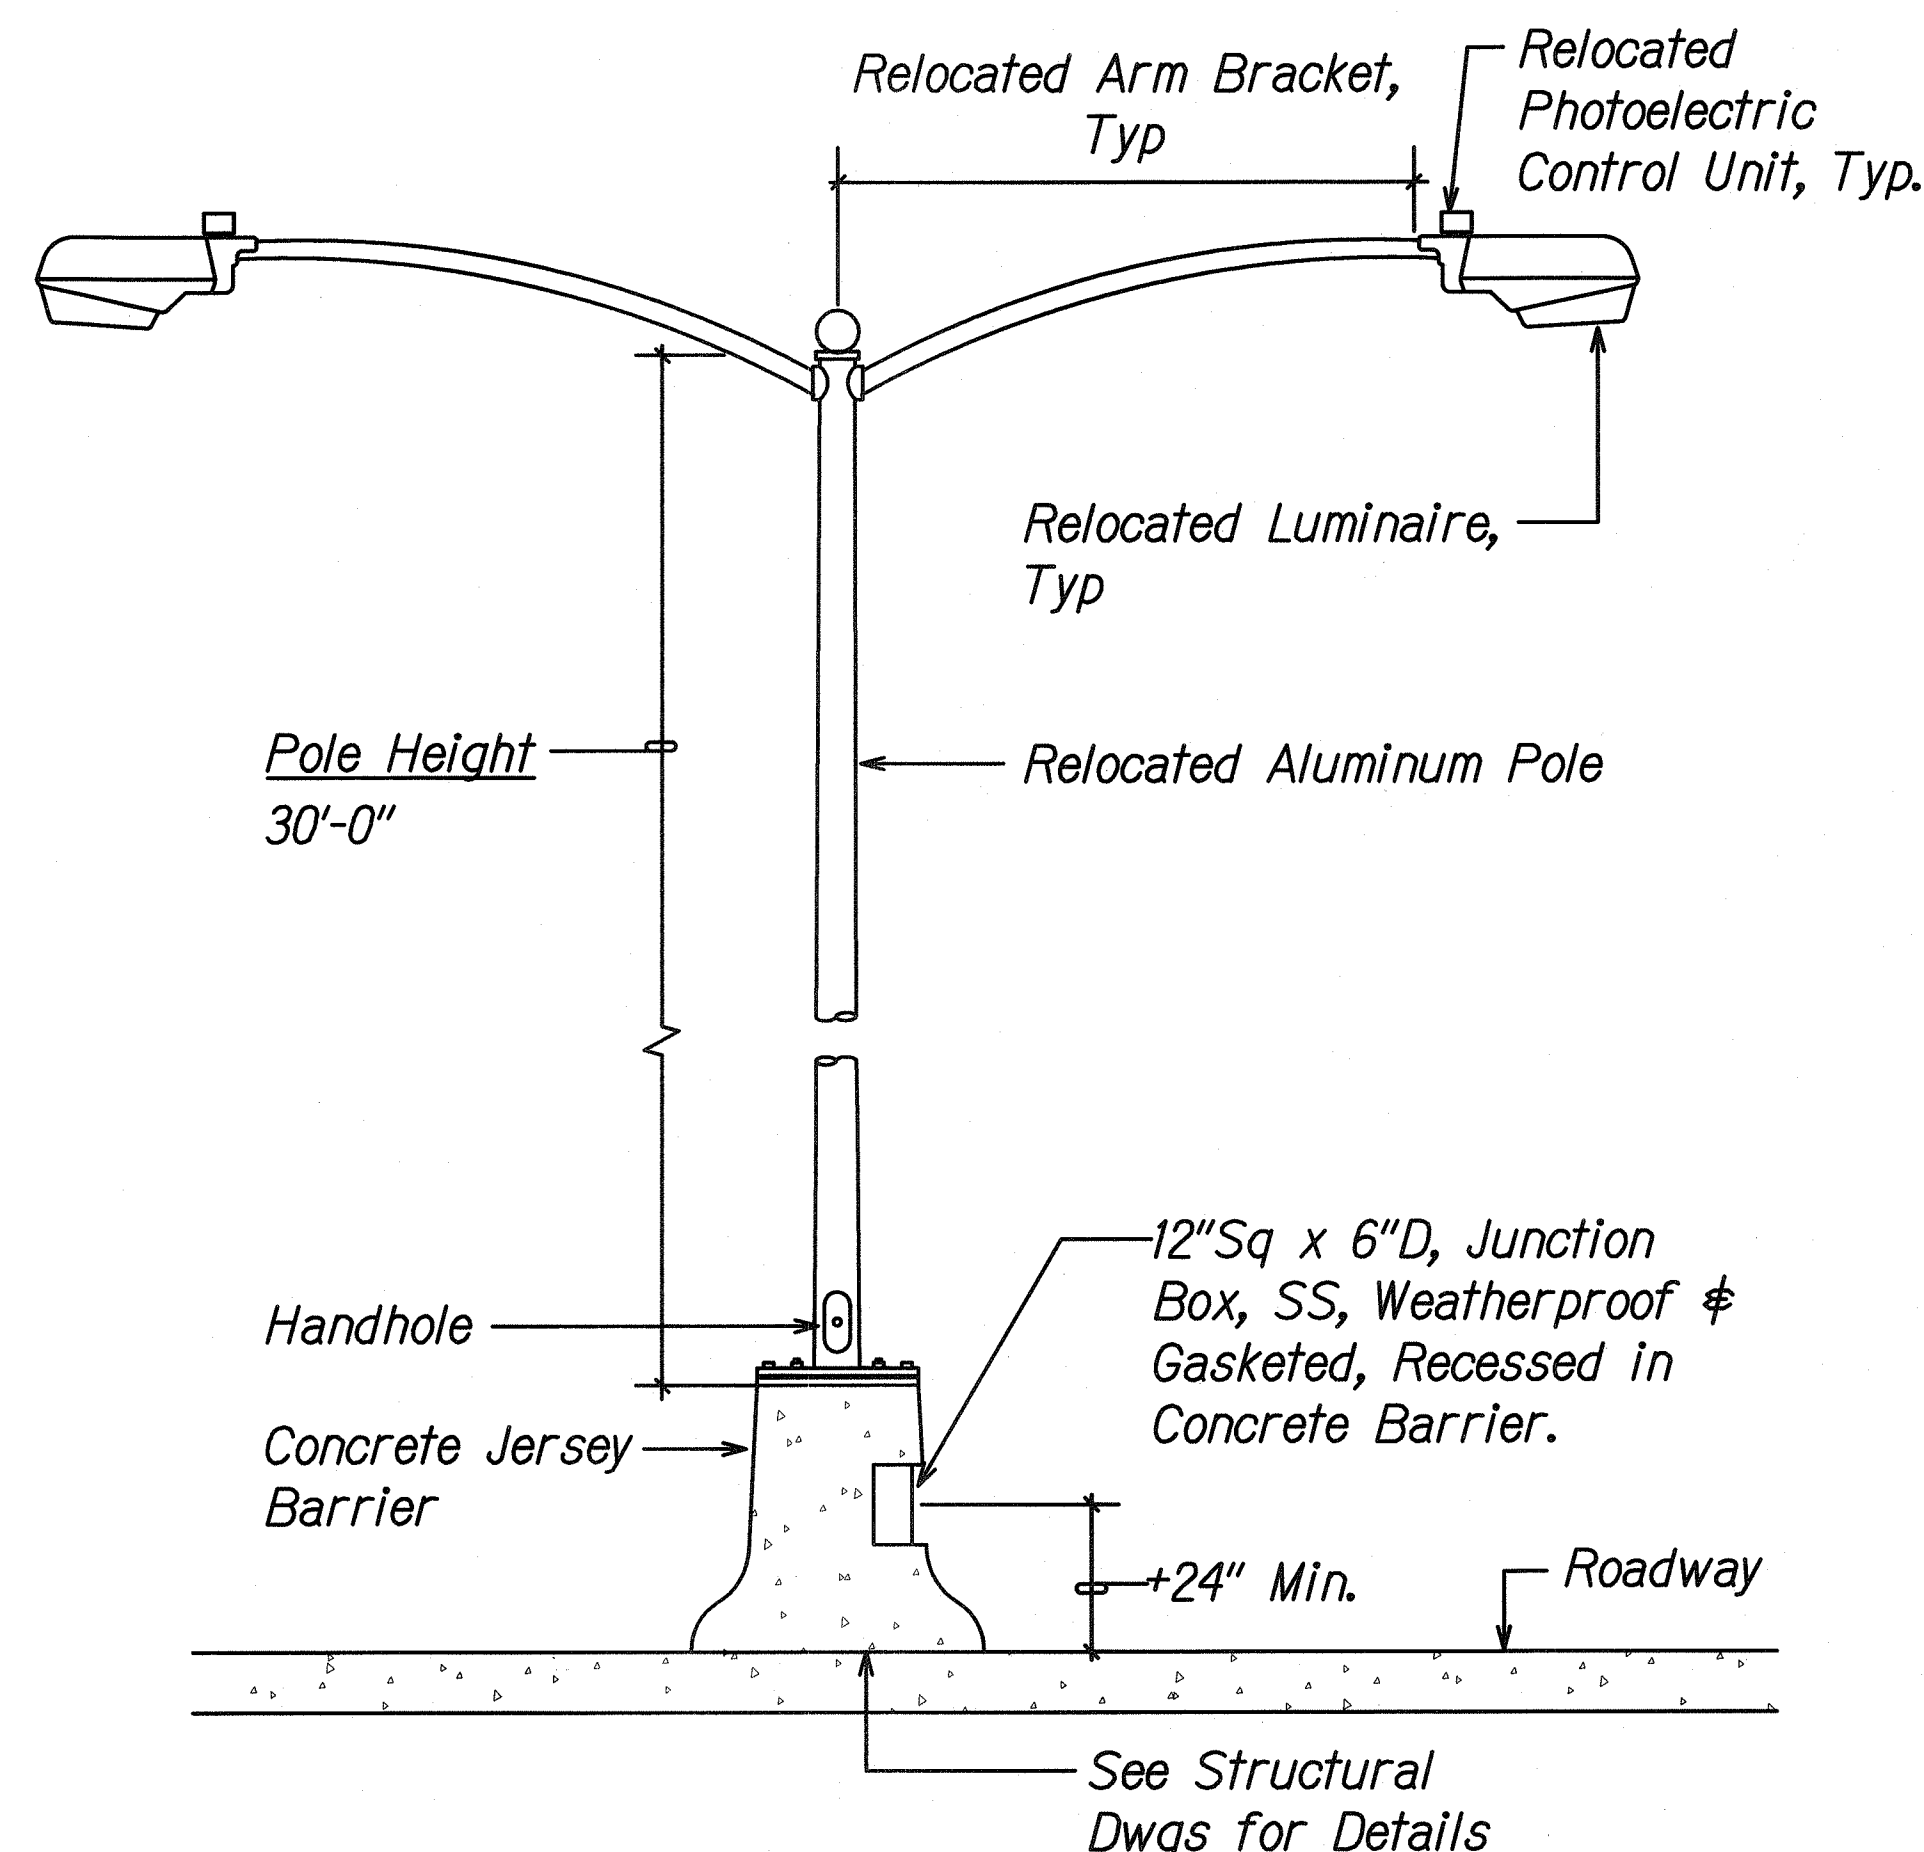

A STREET LIGHT POLE DETAIL
E-4 NOT TO SCALE

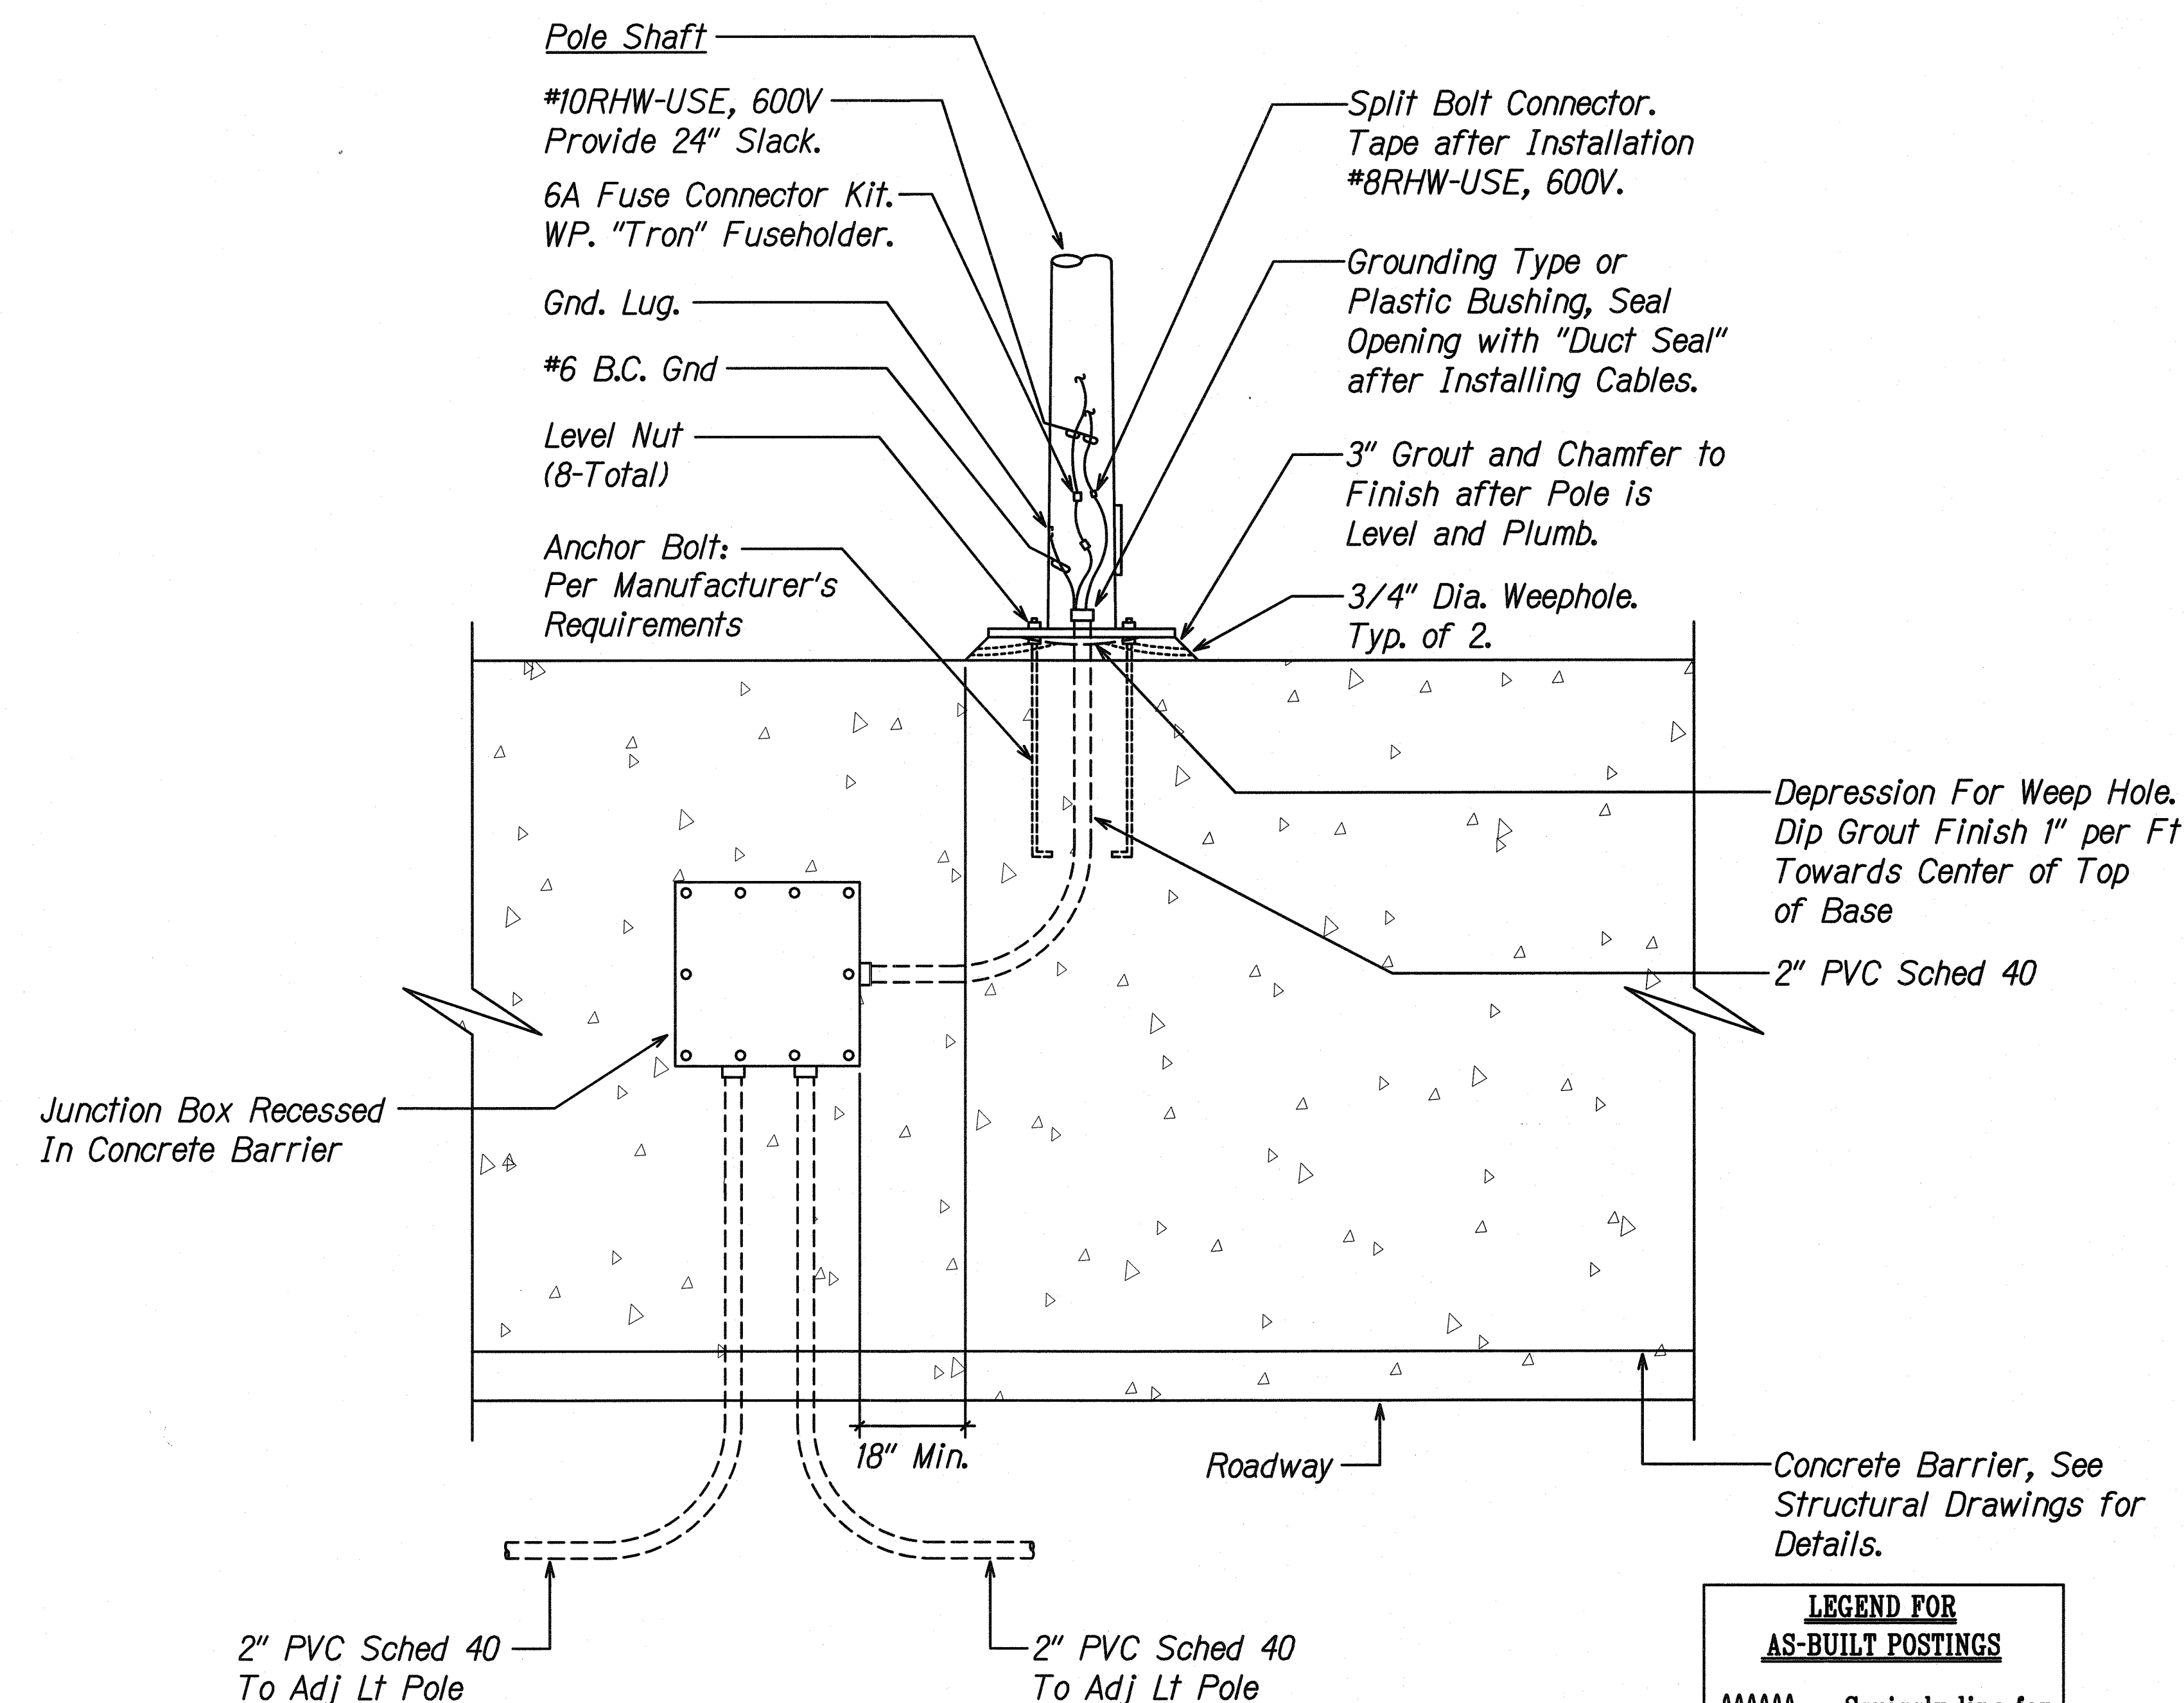


B BASE DETAIL
E-4 NOT TO SCALE

LEGEND FOR AS-BUILT POSTINGS

~~~~~~~~~ Squiggly line for as-built deletion

~~=====~~ Double line for as-built deletion

Roadway Text for as-built posting

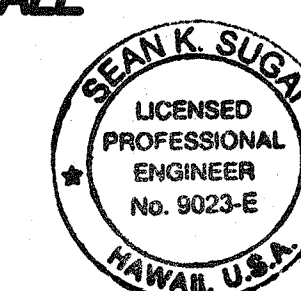

THIS WORK WAS PREPARED BY ME OR UNDER MY SUPERVISION AND CONSTRUCTION OF THIS PROJECT WILL BE UNDER MY OBSERVATION.

Signature: *Sean K. Sugar*  
Date: April 30, 2006  
EXPIRATION DATE OF THE LICENSE

STATE OF HAWAII  
DEPARTMENT OF TRANSPORTATION  
**RELOCATED STREET LIGHT POLE DETAILS**  
**LIKELIKE HIGHWAY**  
**Wilson Tunnel Improvements**  
**Leak and Crack Remediation**  
**E. A. Project No. STP-063-1(22)**

Scale: AS NOTED Date: Dec 23, 2004

SHEET No. **E-4** OF **14** SHEETS

"AS-BUILT"


C.O. 78

|               |      |
|---------------|------|
| ORIGINAL PLAN | DATE |
| DRAWN BY      |      |
| DESIGNED BY   |      |
| NOTED BY      |      |
| CHECKED BY    |      |
| NO.           |      |

LAST SAVE: 12/29/04 @ 10:31:04 BY: B0 PLT SC 1-0-0-1  
C:\AD\PROJECTS\2253\Wilson Tunnel\Drawings\04-2253-04.dwg



| FED. ROAD DIST. NO. | STATE | FED. AID PROJ. NO. | FISCAL YEAR | SHEET NO. | TOTAL SHEETS |
|---------------------|-------|--------------------|-------------|-----------|--------------|
| HAWAII              | HAW.  | STP-063-K(22)      | 2003        | 79        | 83           |

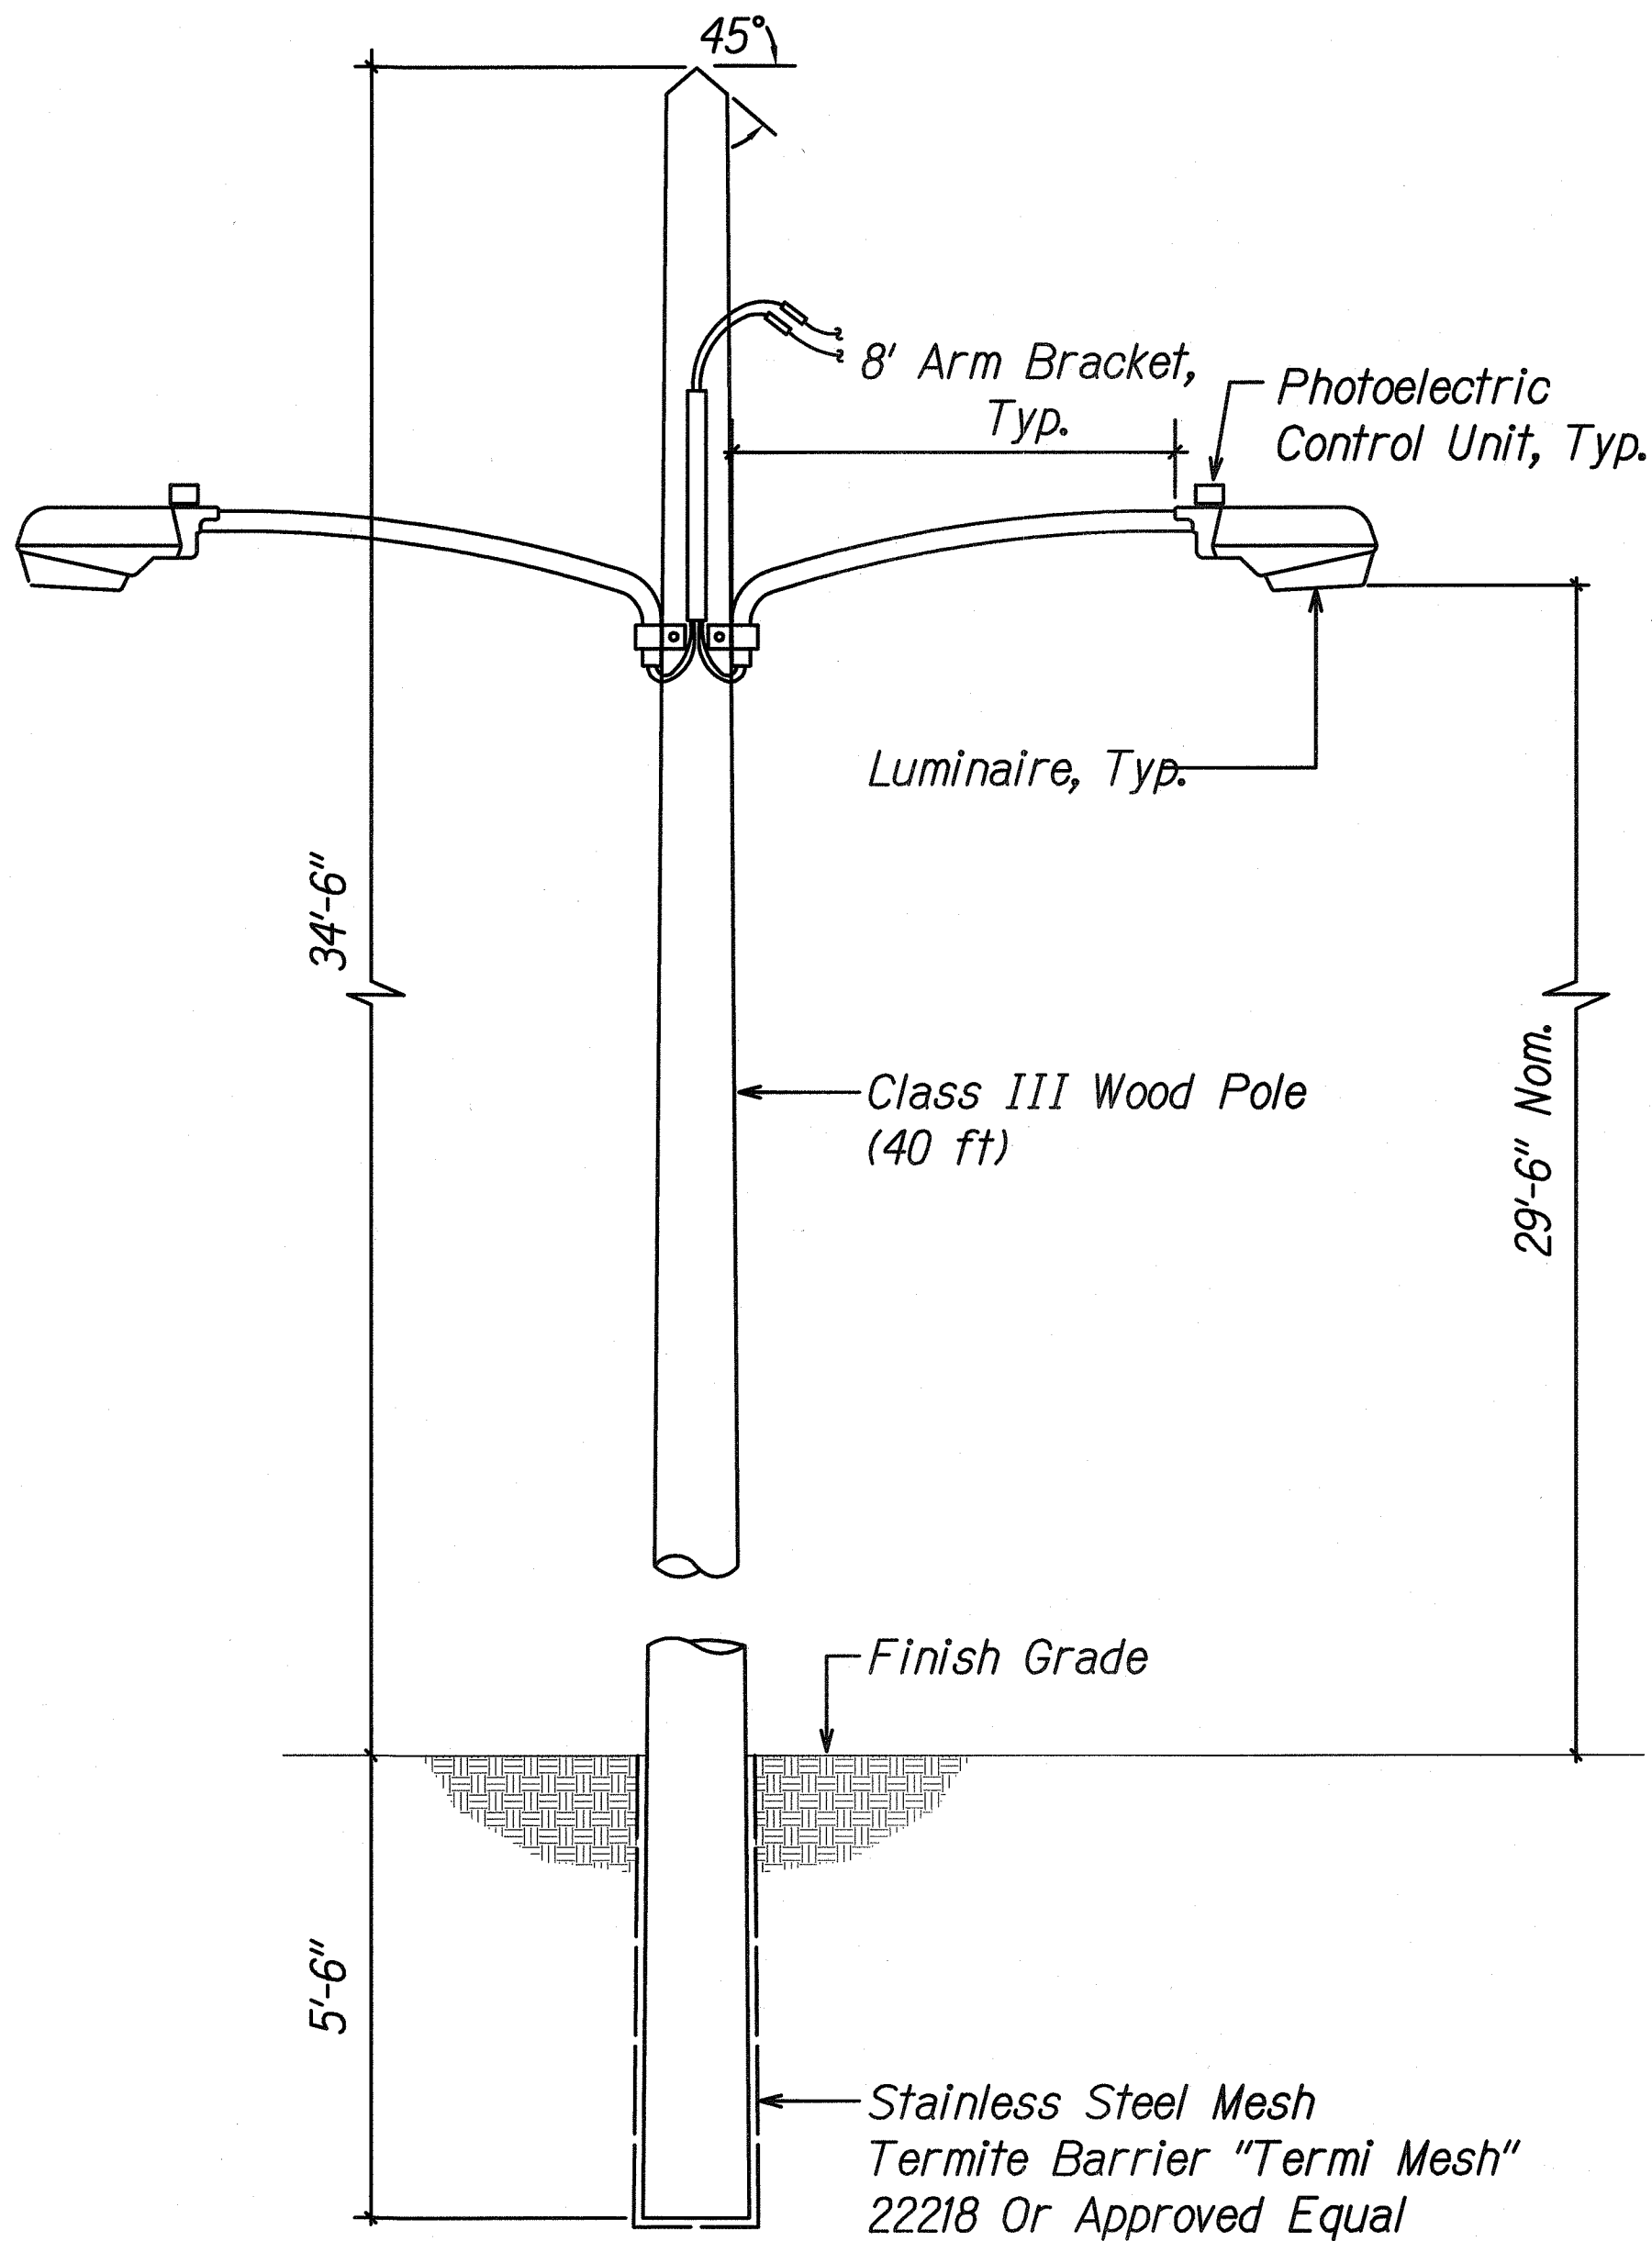


**NOTES:**

1. Minimum Top Circumference Is 23" Minimum Circumference At 6'-0" From Butt Is 37".
2. Pole Shall Be Treated With Pentachlorophenol Using The "Celon" Process, By A Licensed Termite Treatment Company.
3. Termite Treat The Bottom Of The Hole And Backfill Material With Aqueous Chemical Solution Consisting Of 0.5% Aldrin Or 0.5% Dursban. Minimum 5 Gallons Of The Solution Shall Be Used For Each Hole. Application Shall Be Performed By Contractor Licensed For This Type Of Work. Treatment Shall Be Done As The Hole Is Being Backfilled.

**A**  
**E-5** **TEMPORARY STREET LIGHT POLE DETAIL**  
**NOT TO SCALE**

- Trench Backfill Material "B"  
1. Sand Equivalent  $\geq 2$   
2. 8" Max. Lift Loose  
3. 95% Compaction
- Concrete - 3" Encasement,  
2500 PSI Compressive Strength  
@ 28 Days.

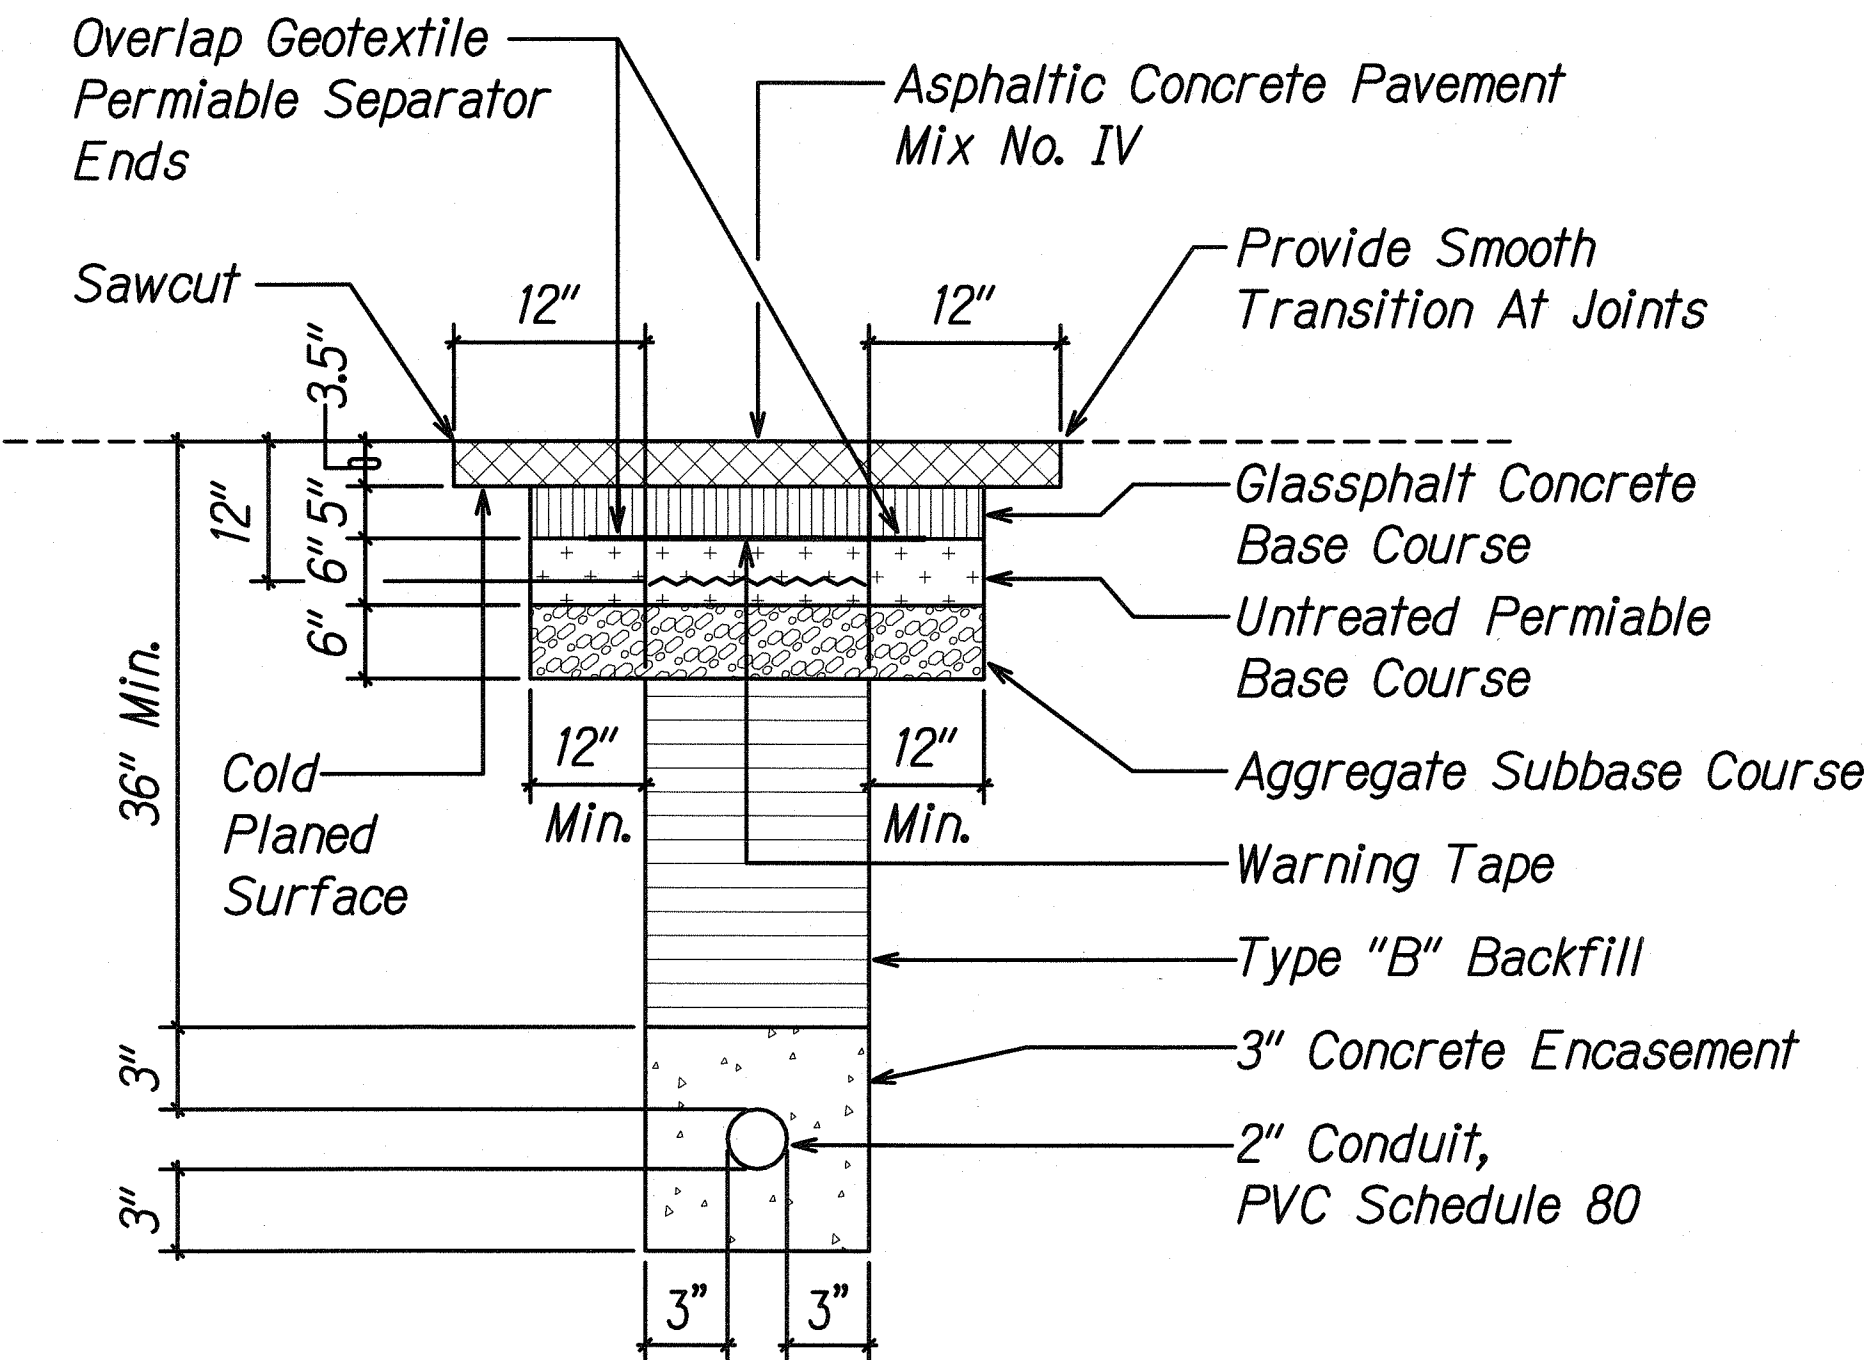


**NOTES:**

1. Tack Coat Existing Asphalt Bound Material Faces Prior To Filling Excavation With Asphalt Bound Material.
2. When Ground Water Is Encountered In Trenches. Backfill With Gravel Conforming To ASTM C-33, Size 67 Material Until One Foot Above Waterlevel. Encapsulate The Size 67 And Sides Of The Trench And Overlaps At The Top Of The Material For The Width Of The Trench. Complete Backfilling The Trench Per Detail.
3. Smoothness of Paved Surfaces:  
The Distance From The Paved Surface To The Testing Edge Of A Ten-Foot Straight Edge Between Two Points Of Contact Shall Not Exceed 3/16".
4. Base Course & Sub-Base Course Per 1994 State Standard Specifications For Highway Construction.
5. Sawcutting & Repairing Of Exst A.C. Pavement Shall Not Be Paid For Separately, But considered Incidental to the Various Contract Items.
6. The Metal Detectable Reel Warning Tape Shall Be A Minimum Of 5 Mils Thick And 4" Wide With A Continuous Metallic Backing And Corrosion Resistant 1 ± Mil Thick Foil Core. The Message On The Tape Shall Read, "Caution-State Highway Lighting Cables Buried Below", Utility 2" Series "C" Black Lettering. The Message Shall Be Repeated With A 36" Spacing. Message Shall Be Repeated With A 36" Spacing. Warning Tape For Signal Corps Conduits Shall Be Per Signal Corps Standards.

| LEGEND FOR AS-BUILT POSTINGS |                                     |
|------------------------------|-------------------------------------|
| <del>WWW</del>               | Squiggly line for as-built deletion |
| <del>###</del>               | Double line for as-built deletion   |
| Roadway                      | Text for as-built posting           |

**B**  
**E-5** **STREET LIGHT DUCT SECTION DETAIL**  
**NOT TO SCALE**

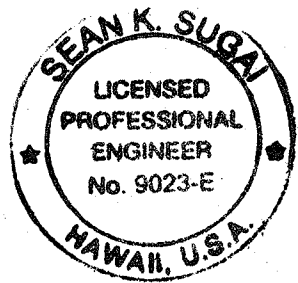

THIS WORK WAS PREPARED BY ME OR UNDER MY SUPERVISION AND CONSTRUCTION OF THIS PROJECT WILL BE UNDER MY OBSERVATION.

SIGNATURE: *Sean K. Sugan*  
Date: April 30, 2006  
EXPIRATION DATE OF THE LICENSE

STATE OF HAWAII  
DEPARTMENT OF TRANSPORTATION  
HIGHWAYS DIVISION  
**TEMPORARY STREET LIGHT POLE DETAIL**  
**LIKELIKE HIGHWAY**  
**Wilson Tunnel Improvements**  
**Leak and Crack Remediation**  
**E. A. Project No. STP-063-K(22)**  
Scale: AS NOTED Date: Dec 23, 2004  
SHEET No. **E-5** OF **14** SHEETS



C.O. 79

|                   |      |
|-------------------|------|
| SURVEY PLOTTED BY | DATE |
| DRAWN BY          |      |
| DESIGNED BY       |      |
| QUANTITIES BY     |      |
| CHECKED BY        |      |
| ORIGINAL PLAN     | No.  |

LAST SAVE: 12/20/04 @ 10:32:35 BY: BD PLOT SC: 1"=20'-1"  
W:\04\PROJECTS\2003\2003-06\03-06-03\03-06-03.dwg


"AS-BUILT"

| FED. ROAD DIST. NO. | STATE | FED. AID PROJ. NO. | FISCAL YEAR | SHEET NO. | TOTAL SHEETS |
|---------------------|-------|--------------------|-------------|-----------|--------------|
| HAWAII              | HAW.  | STP-063-1(22)      | 2003        | 80        | 69           |

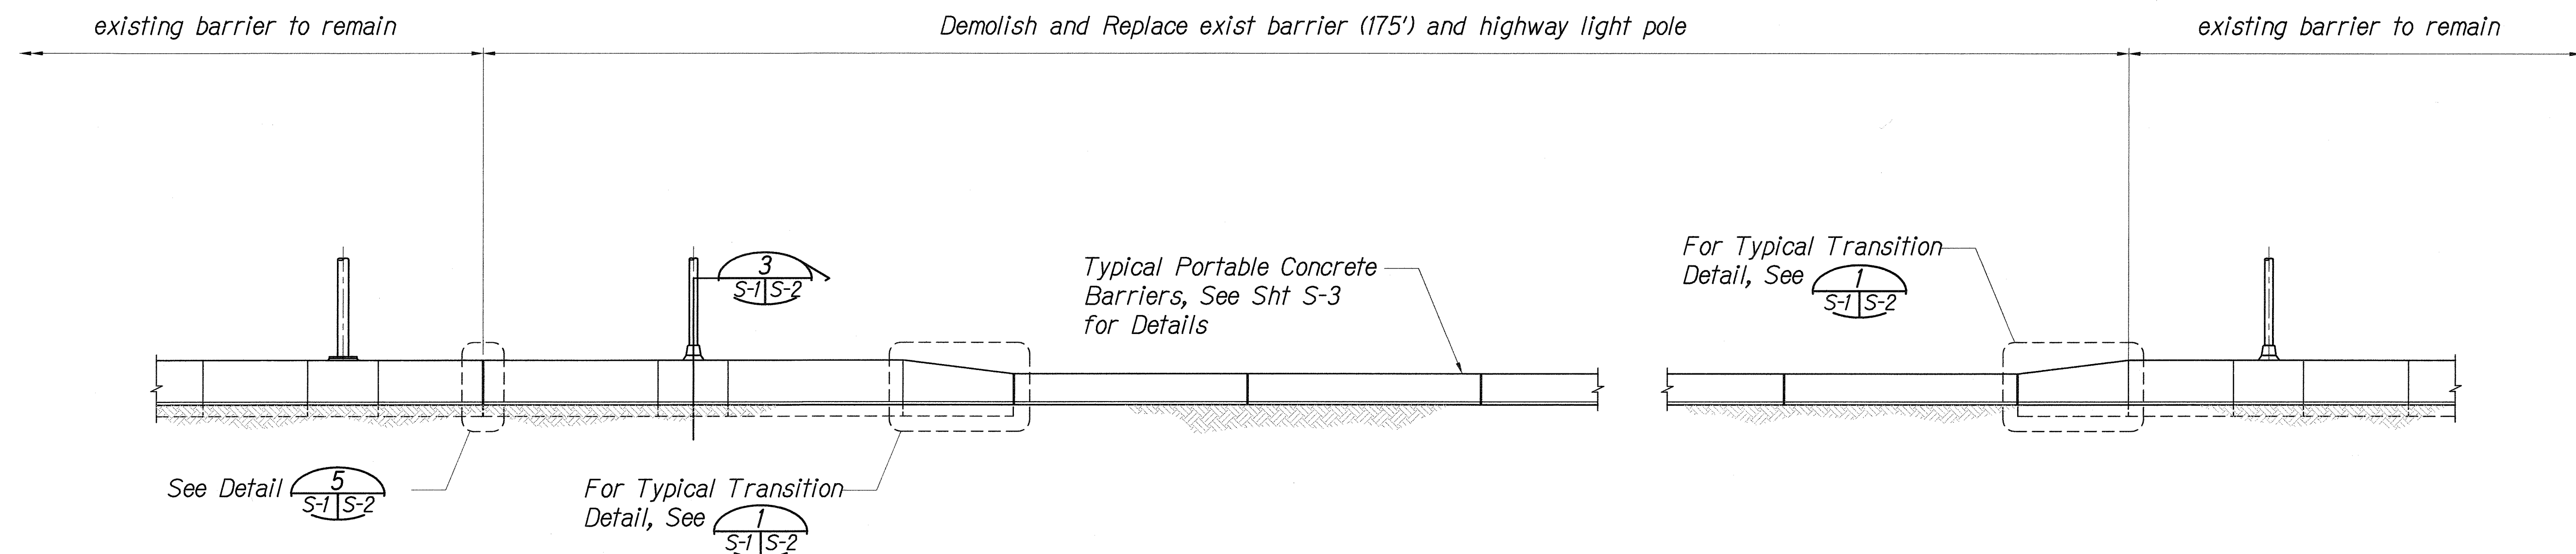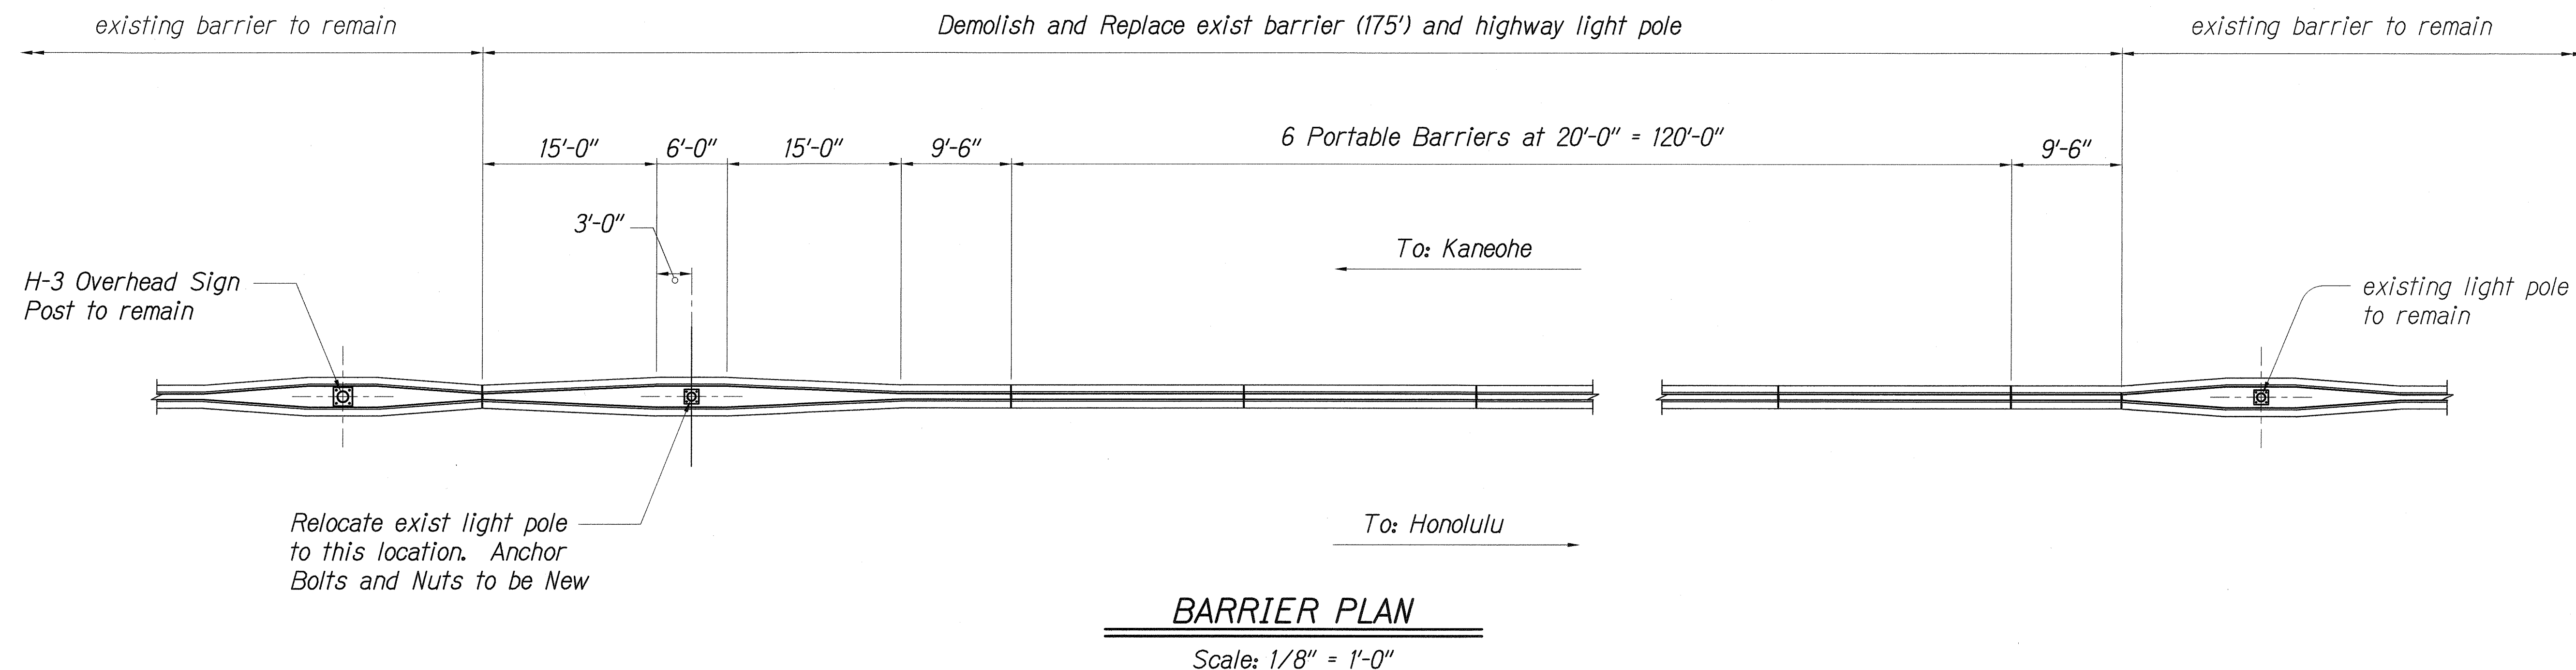

**Notes:**

1. See Electrical drawings for Site and location of conduit ducts and junction boxes to be embedded in concrete barrier.
2. Concrete to be 3,000 psi 28-day compressive strength minimum. Reinforcing steel to be Grade 60.
3. Refer to Civil drawings for layout of temporary impact attenuators. New concrete barrier to be constructed after temporary lane diversion is complete.

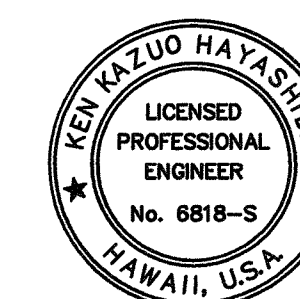

THIS WORK WAS PREPARED BY ME OR UNDER MY SUPERVISION AND CONSTRUCTION OF THIS PROJECT WILL BE UNDER MY OBSERVATION.

SIGNATURE \_\_\_\_\_ April 30, 2004  
EXPIRATION DATE OF THE LICENSE


|                                                                                                                                                                                                                                                                                        |             |
|----------------------------------------------------------------------------------------------------------------------------------------------------------------------------------------------------------------------------------------------------------------------------------------|-------------|
| 6/15/04                                                                                                                                                                                                                                                                                | Added Sheet |
| Date                                                                                                                                                                                                                                                                                   | Revision    |
| STATE OF HAWAII<br>DEPARTMENT OF TRANSPORTATION<br>HIGHWAYS DIVISION<br><b>LIGHT POLE FOUNDATION<br/>PLAN AND ELEVATION</b><br>LIKELIKE HIGHWAY<br>Wilson Tunnel Improvements<br>Leak and Crack Remediation<br>F. A. Project No. STP-063-1(22)<br>Scale: As Shown Date: April 24, 2003 |             |
| SHEET No. S-6 OF 9 SHEETS                                                                                                                                                                                                                                                              |             |

"AS-BUILT"

C.O. 80


|               |      |
|---------------|------|
| ORIGINAL PLAN | DATE |
| DRAWN BY      |      |
| DESIGNED BY   |      |
| NOTED BY      |      |
| CHECKED BY    |      |
| No.           |      |



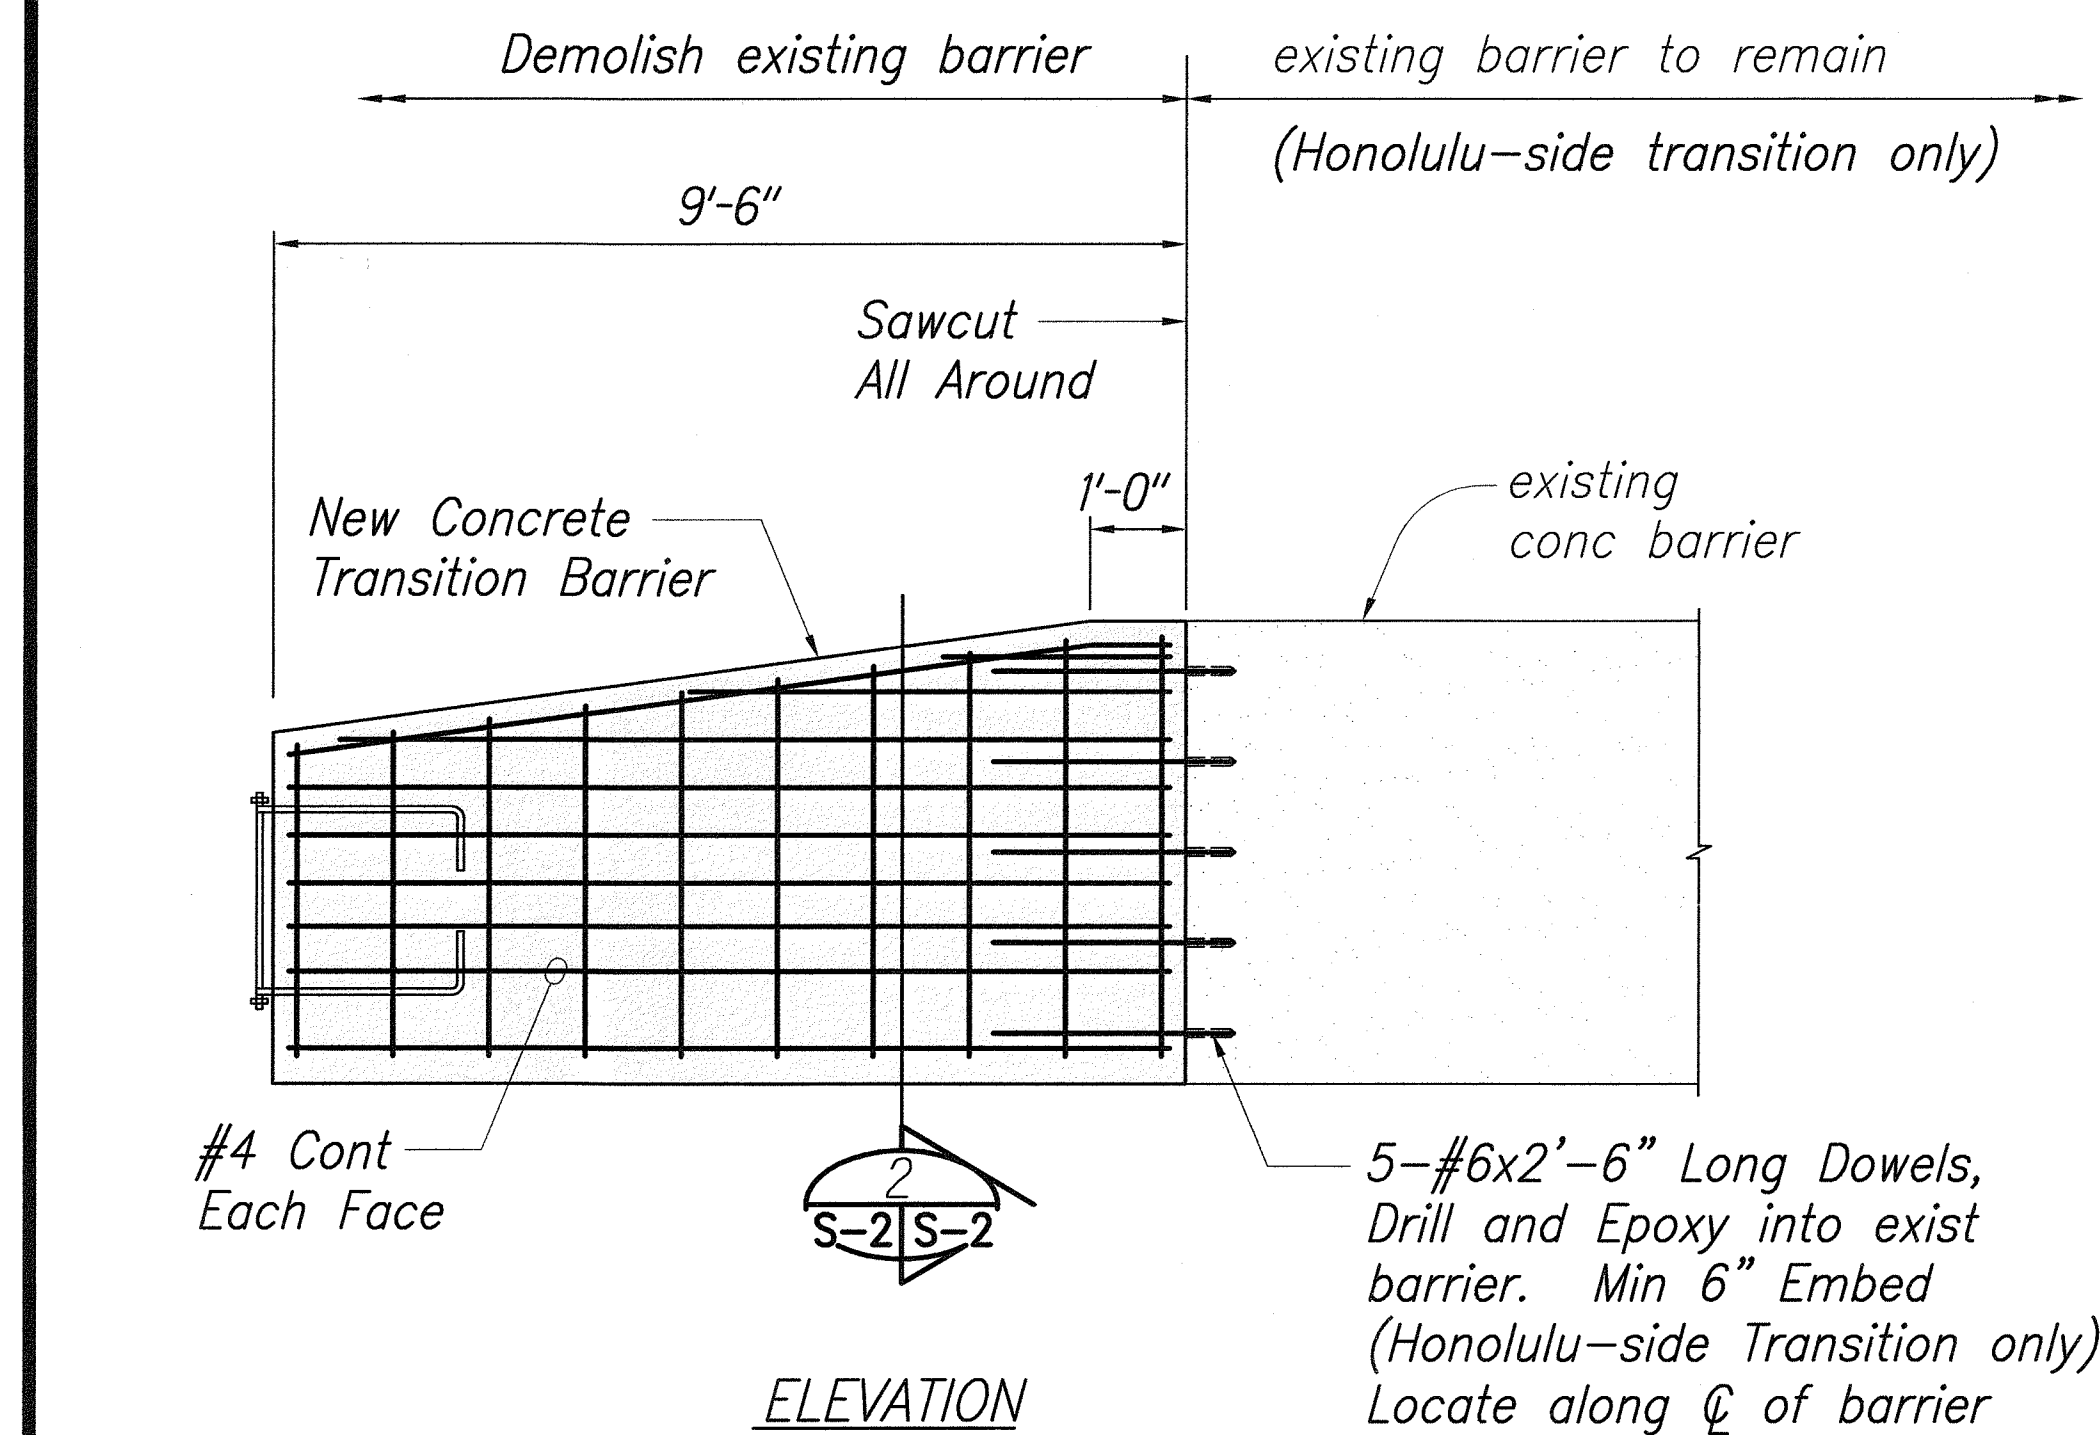


CONCRETE BARRIER HEIGHT  
TRANSITION REINFORCEMENT DETAIL


Scale :  $1/2'' = 1'-0''$

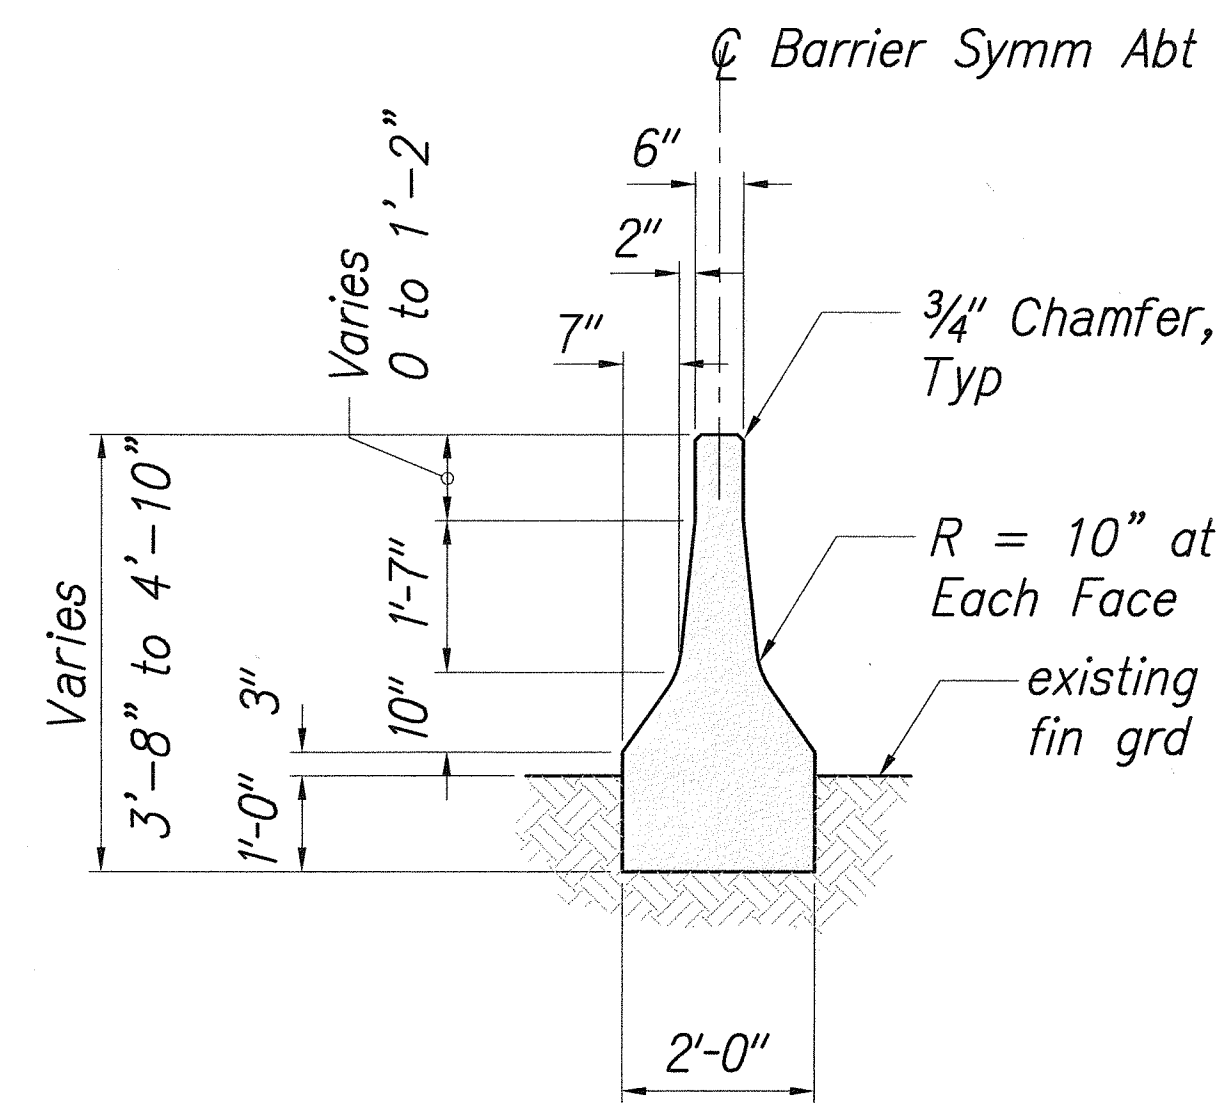


### DIMENSIONS

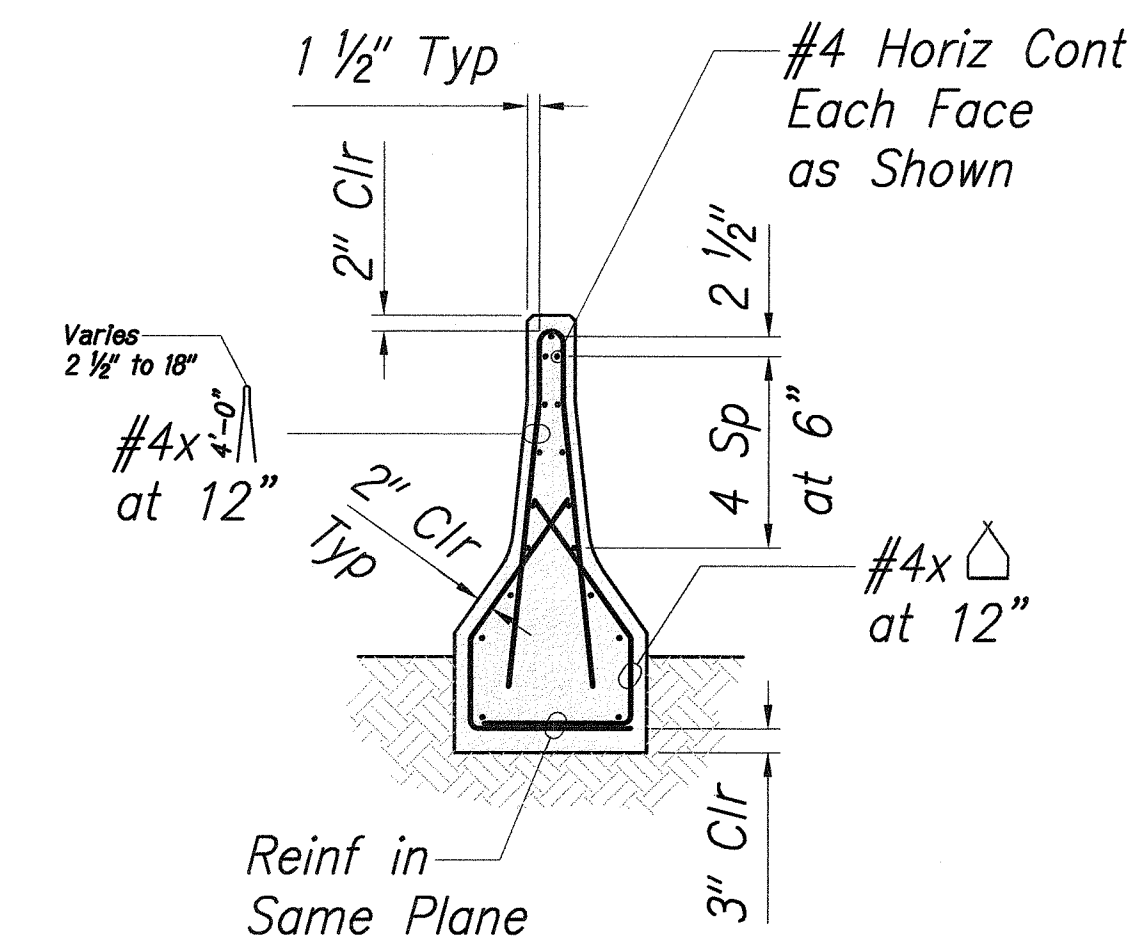


REINFORCEMENT

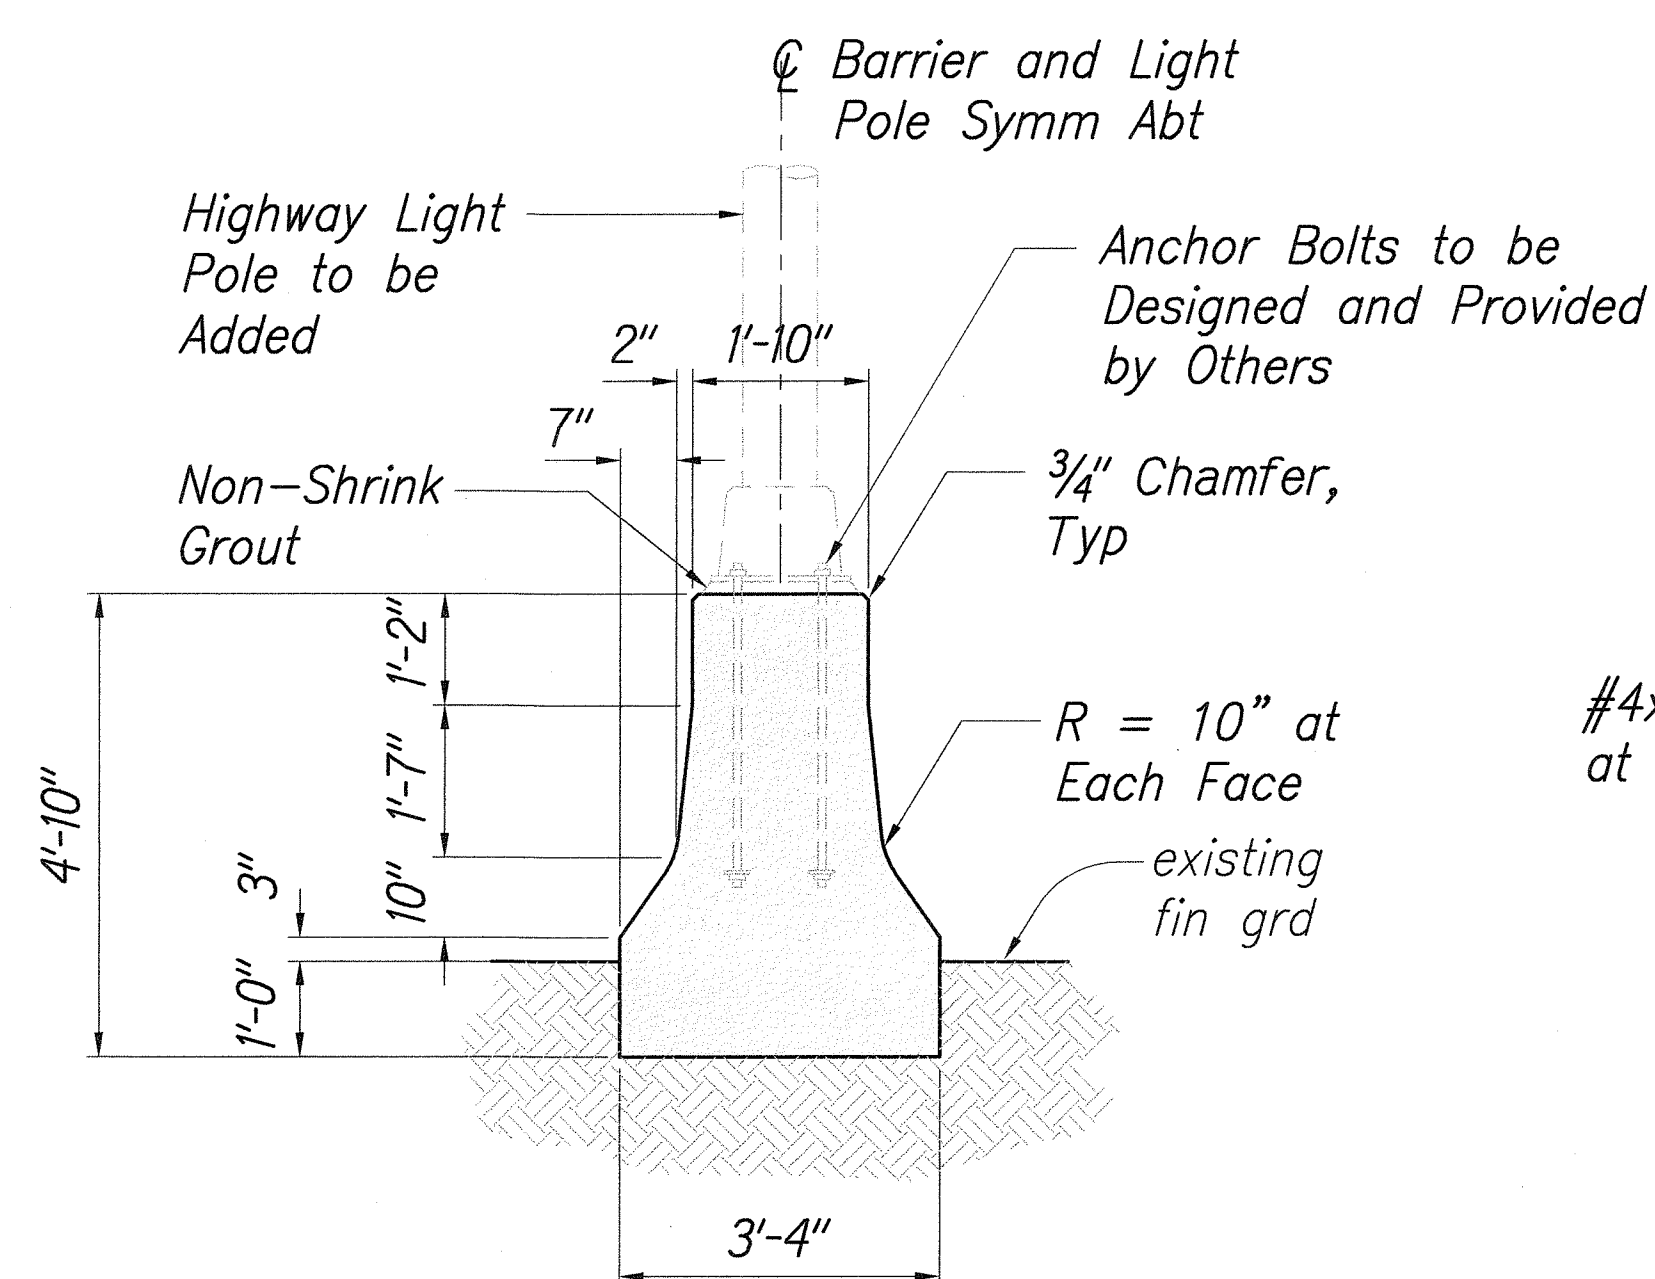

### DIMENSIONS

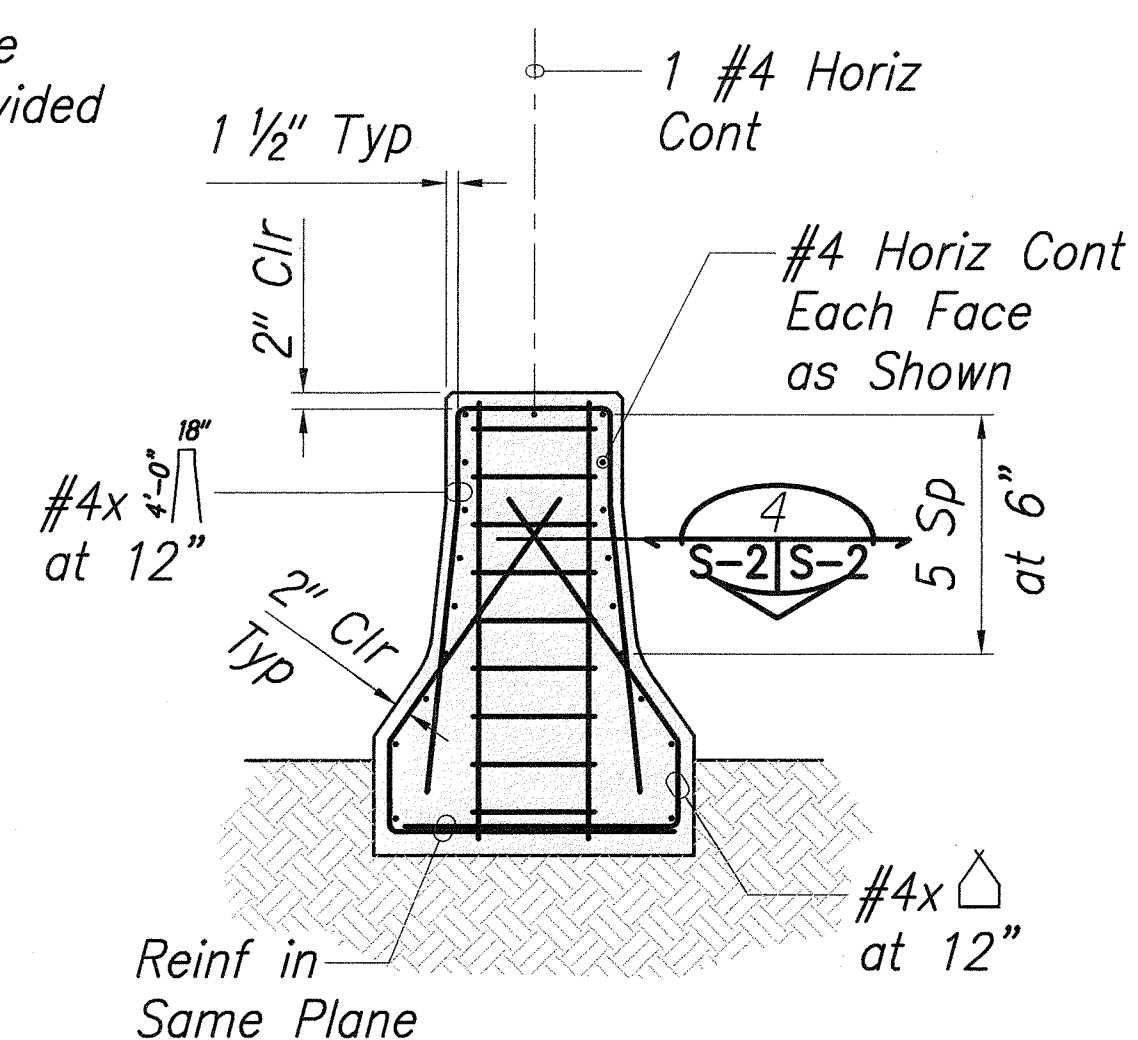


REINFORCEMENT

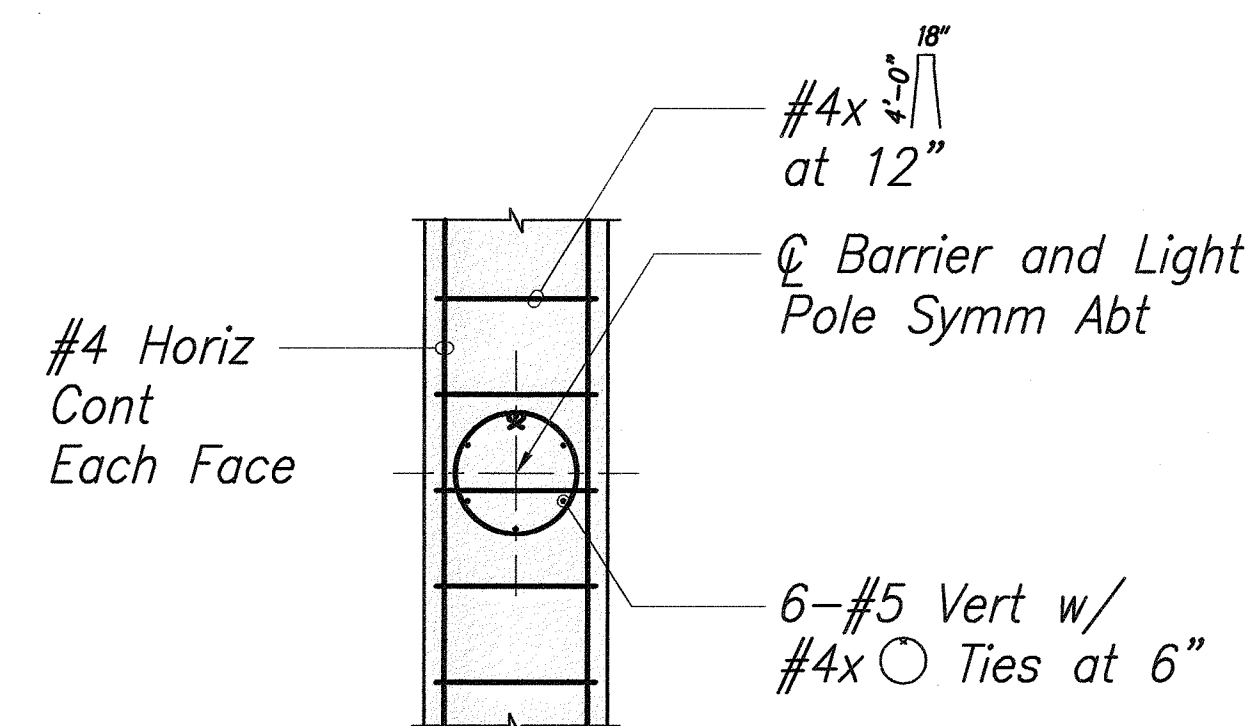


SECTION

Scale : 1/2" = 1'-0"

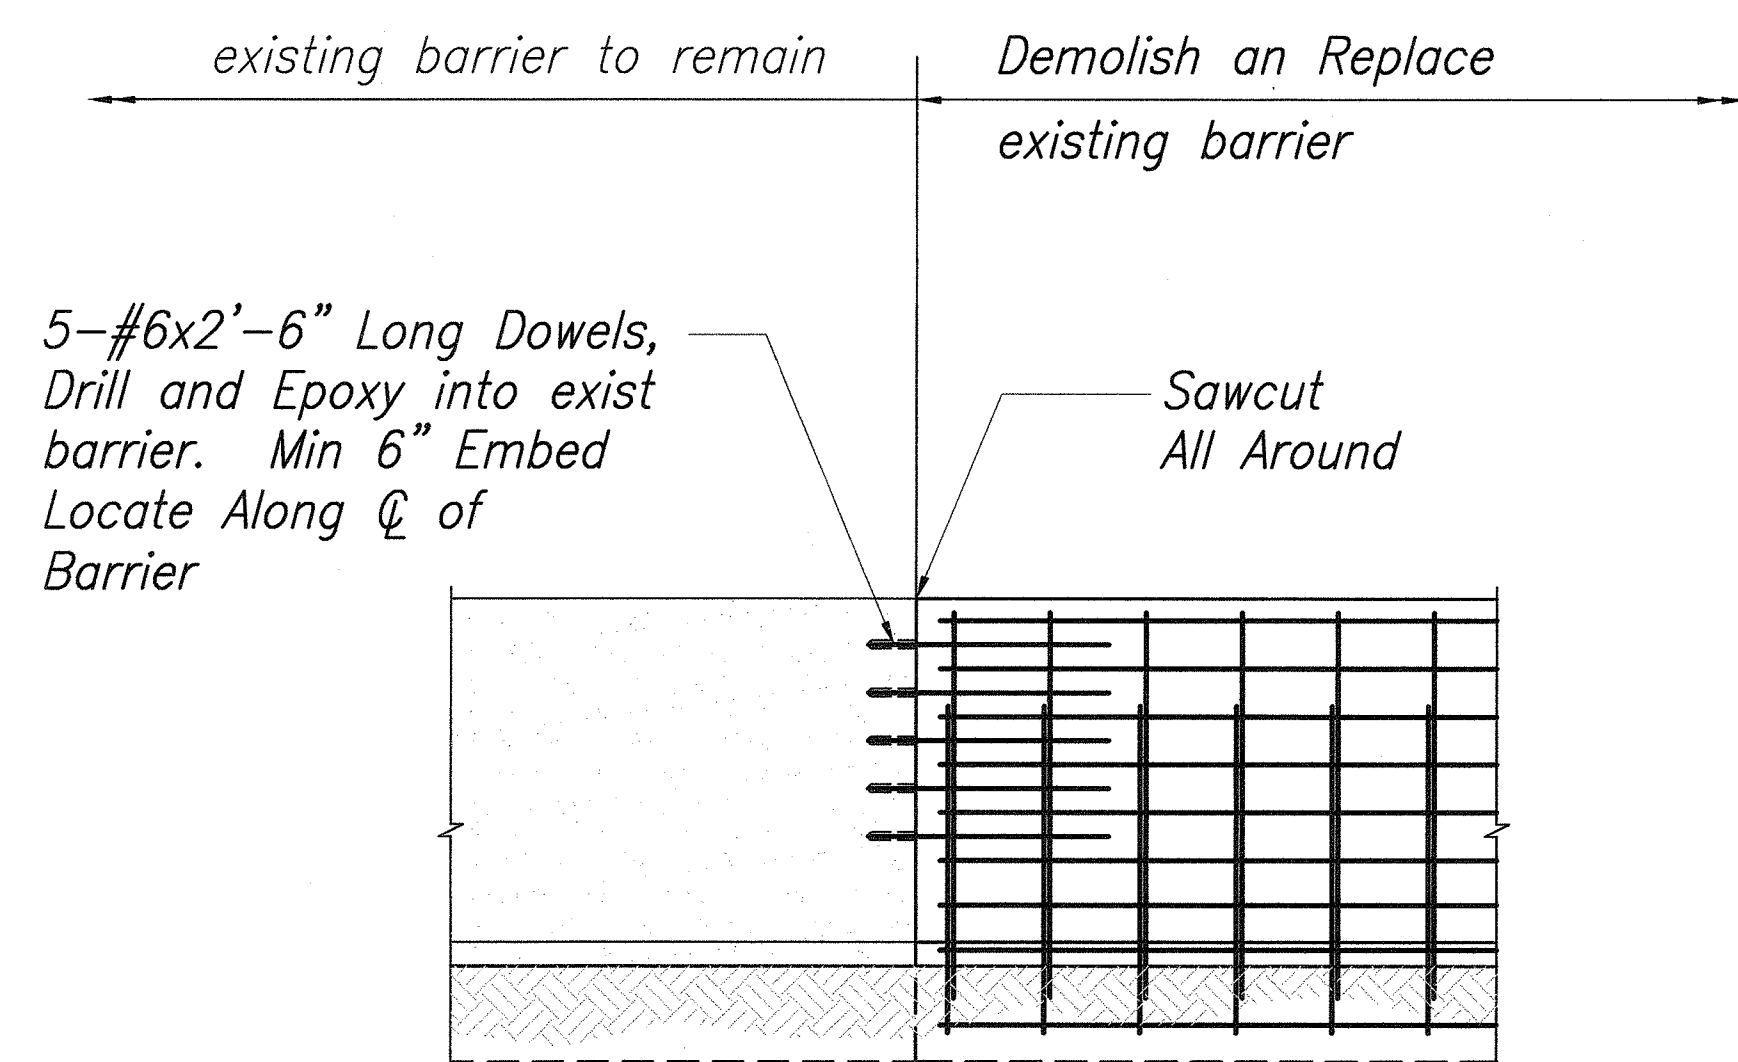

SECTION

Scale : 1/2" = 1'-0"

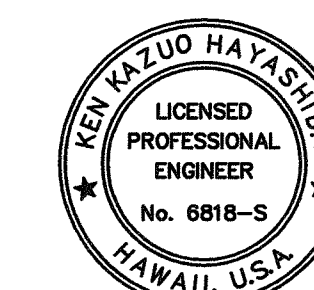

THIS WORK WAS PREPARED BY ME  
OR UNDER MY SUPERVISION AND  
CONSTRUCTION OF THIS PROJECT  
WILL BE UNDER MY OBSERVATION.

|           |                                                     |
|-----------|-----------------------------------------------------|
| SIGNATURE | April 30, 2004<br>EXPIRATION DATE<br>OF THE LICENSE |
|-----------|-----------------------------------------------------|

|         |             |
|---------|-------------|
| 6/15/04 | Added Sheet |
| Date    | Revision    |

STATE OF HAWAII  
**DEPARTMENT OF TRANSPORTATION**  
 HIGHWAYS DIVISION

**LIGHT POLE FOUNDATION**  
**DETAILS AND SECTIONS**

LIKELIKE HIGHWAY


Wilson Tunnel Improvements  
Leak and Crack Remediation

F. A. Project No. STP-063-1(22)


Scale: As Shown      Date: April 24, 2003

**SHEET No. S-7 OF 9 SHEETS**




| FED. ROAD DIST. NO. | STATE | FED. AID PROJ. NO. | FISCAL YEAR | SHEET NO. | TOTAL SHEETS |
|---------------------|-------|--------------------|-------------|-----------|--------------|
| HAWAII              | HAW.  | STP-063-1(22)      | 2003        | 82        | 69           |

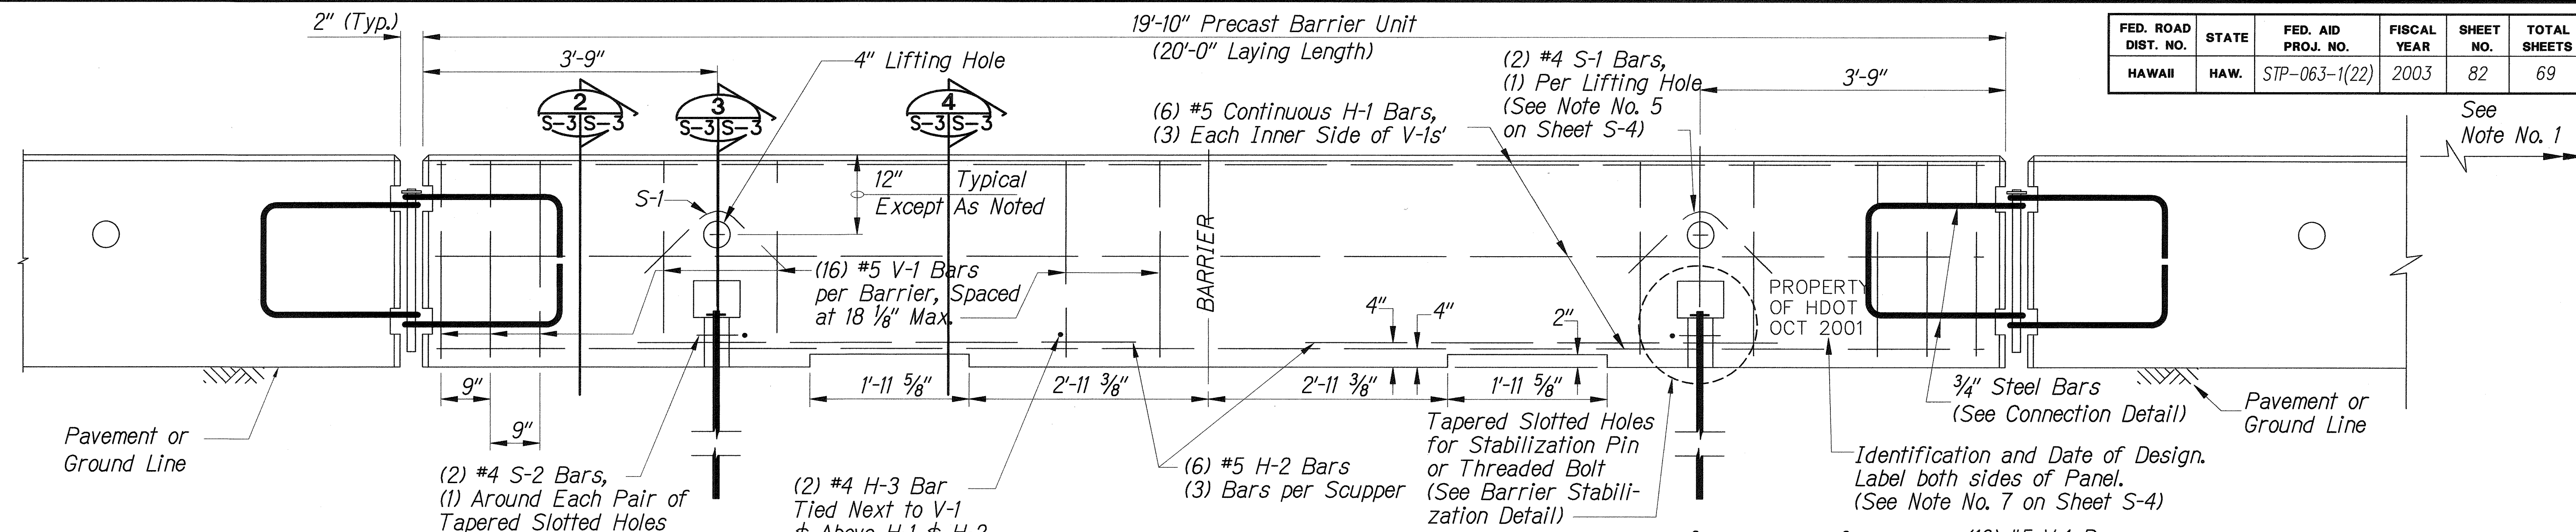



**ELEVATION-TYPICAL BARRIER**  
MASS: 3.9 tons PER PANEL

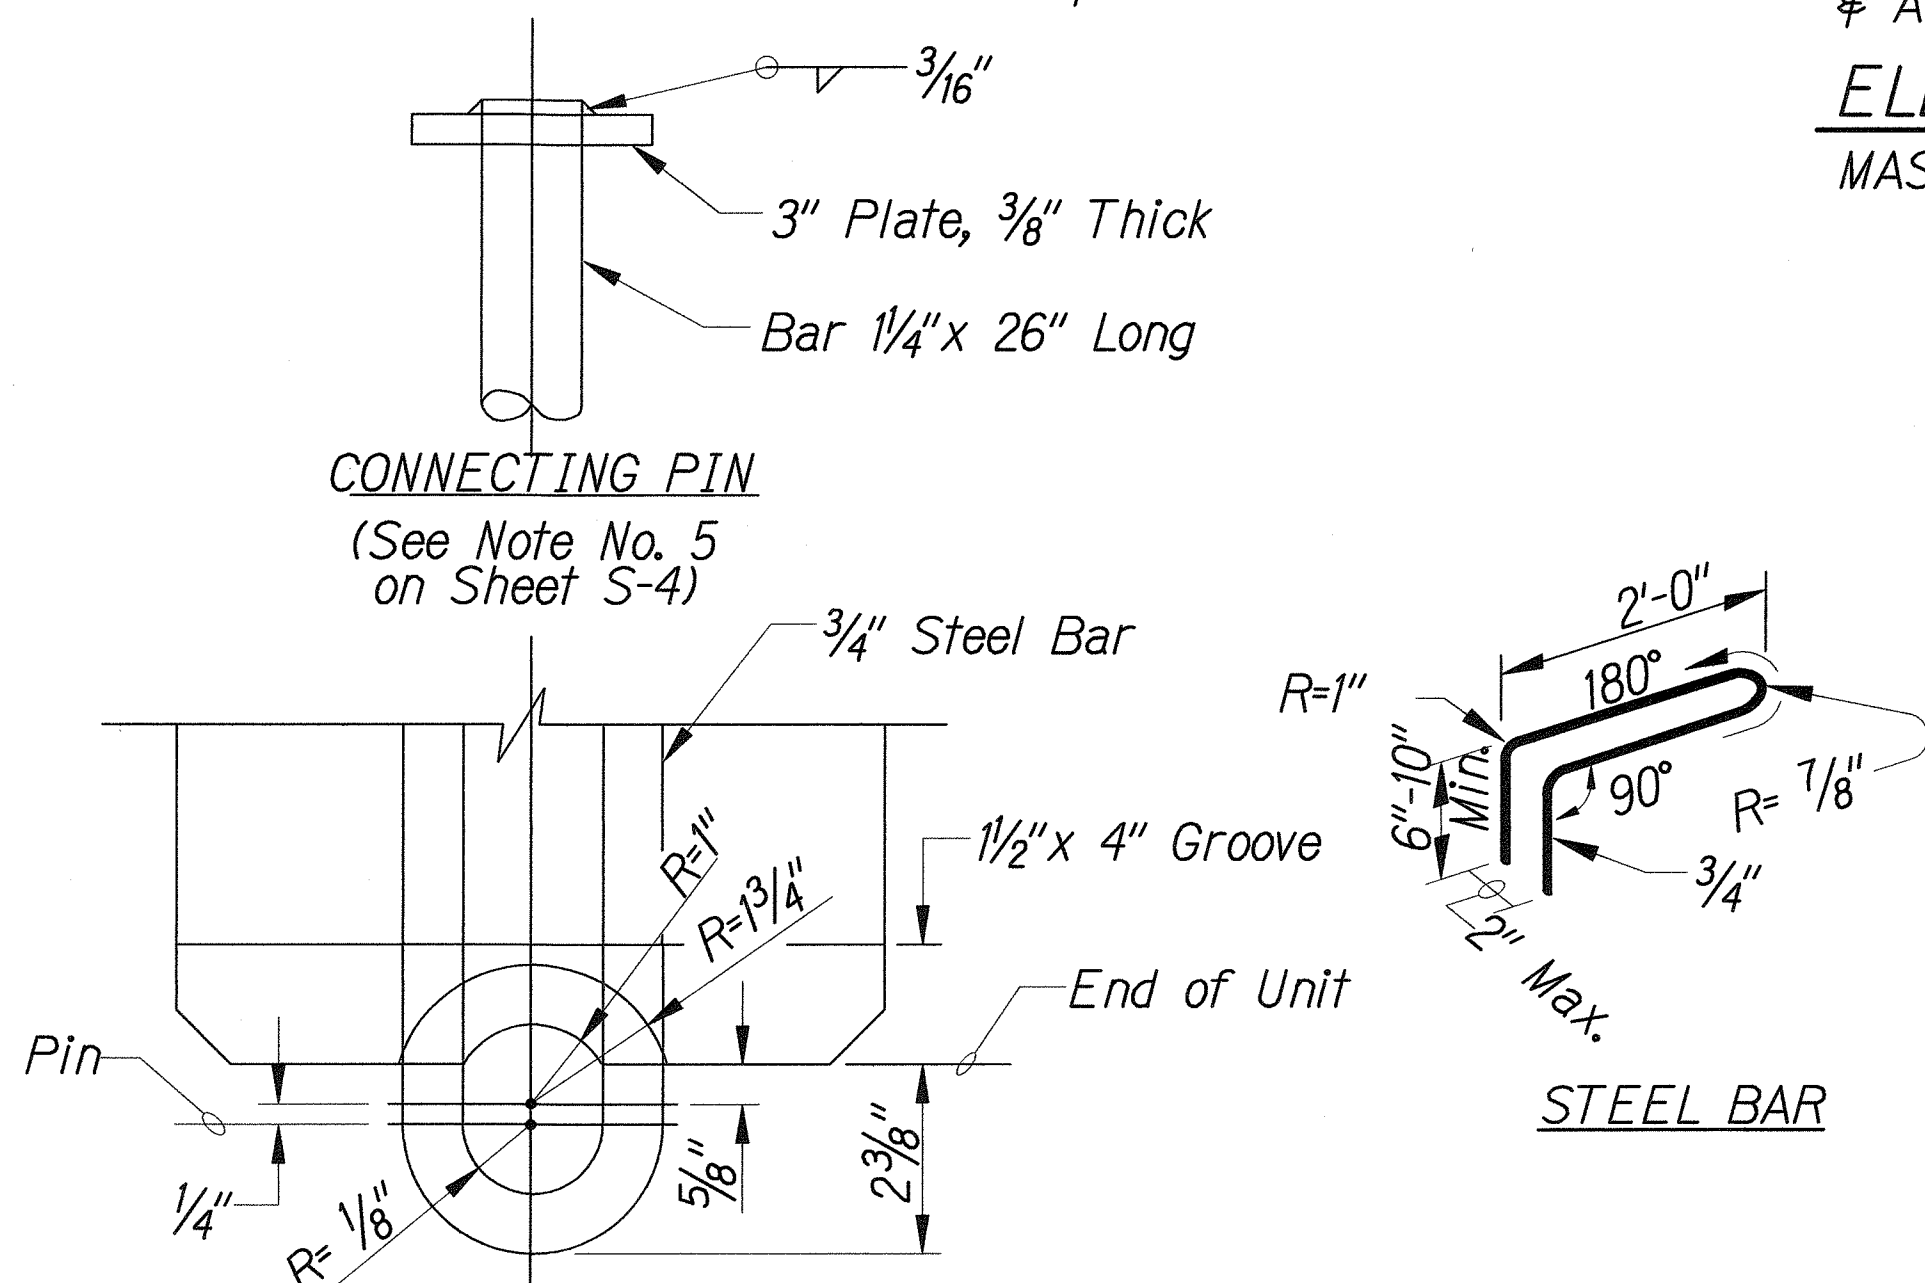


**CONNECTION DETAILS**  
(See Note No. 5 on Sheet S-4)

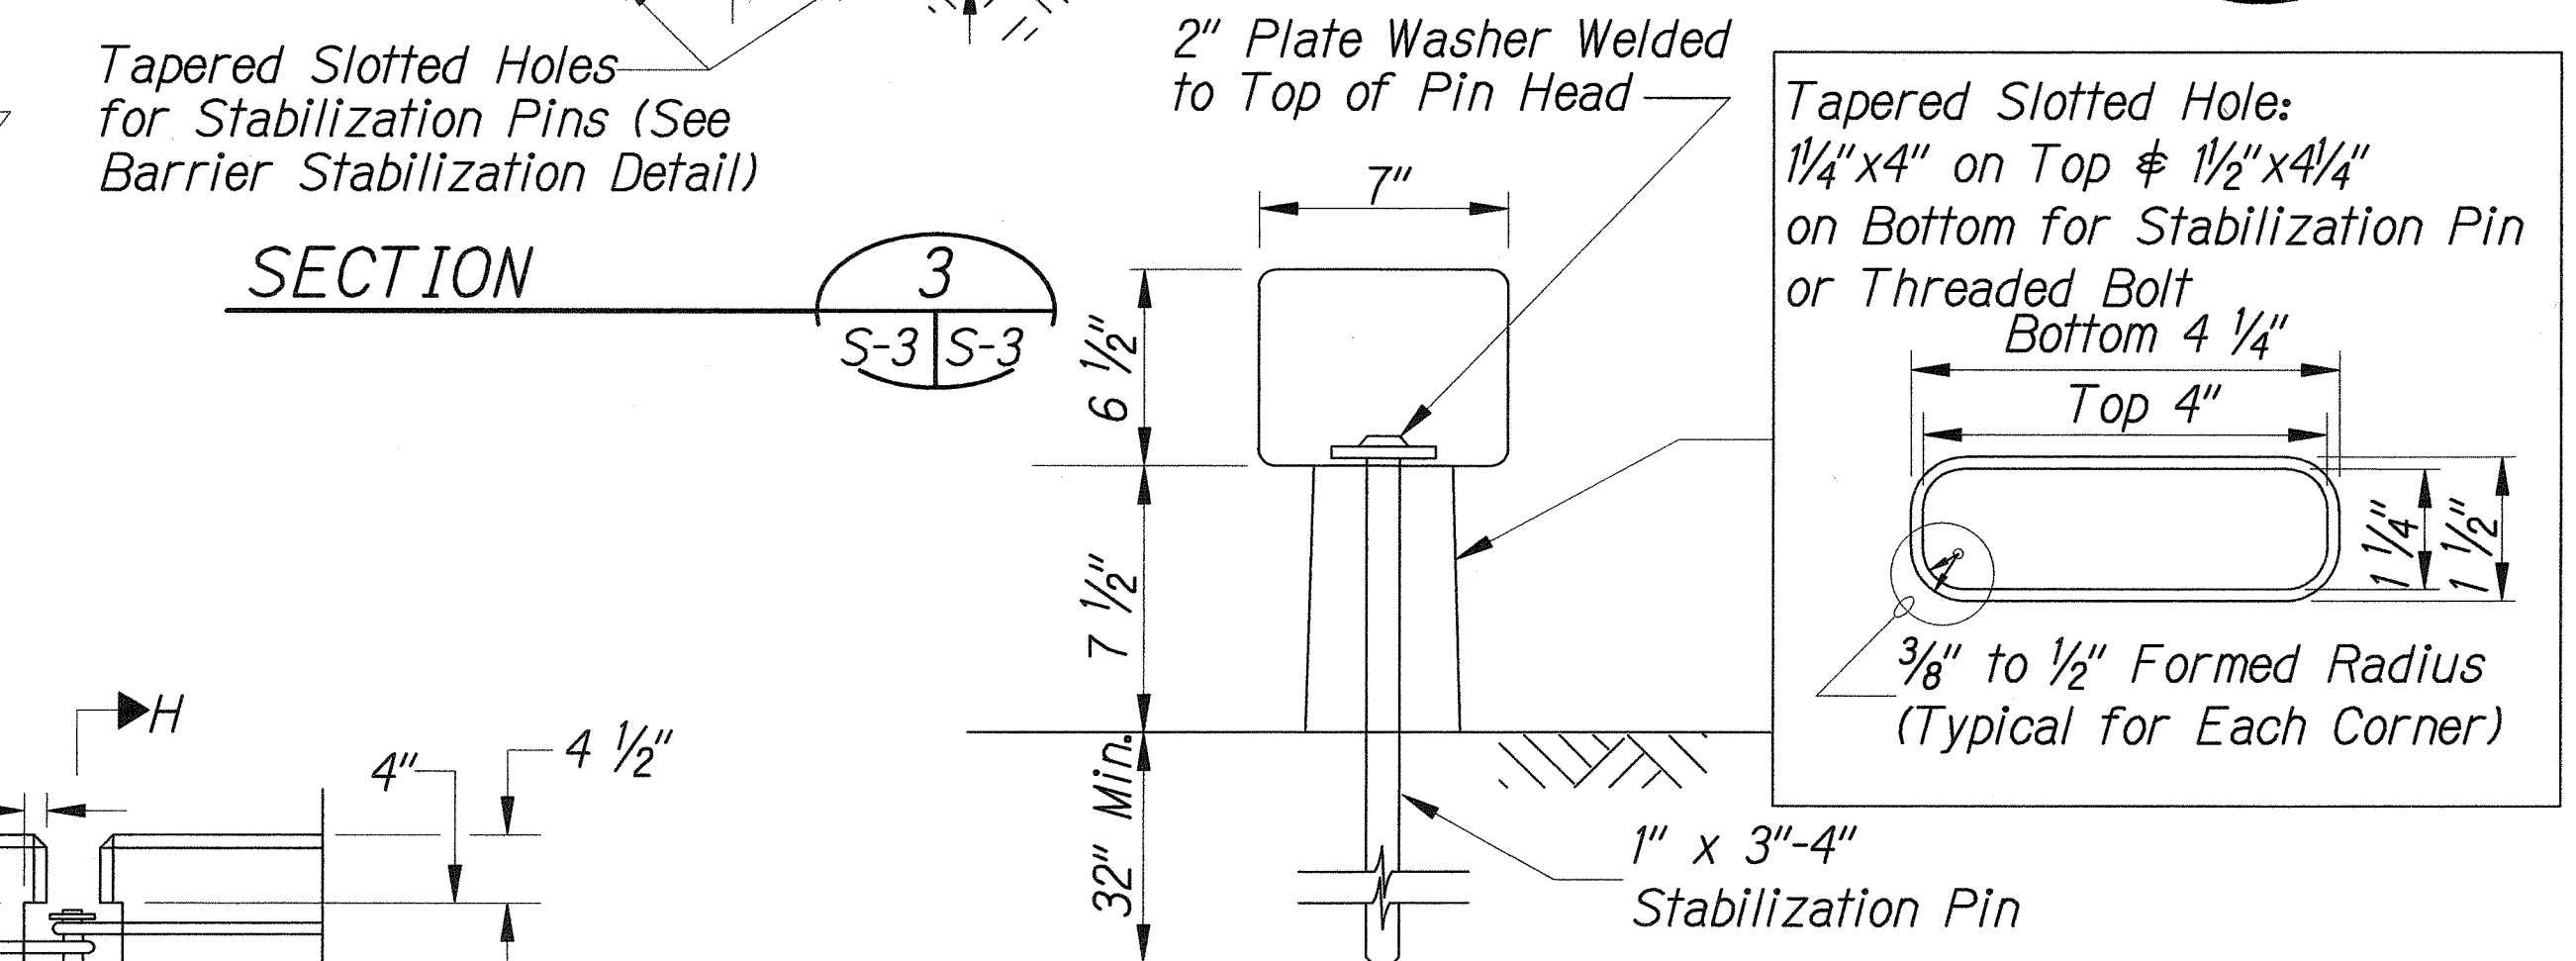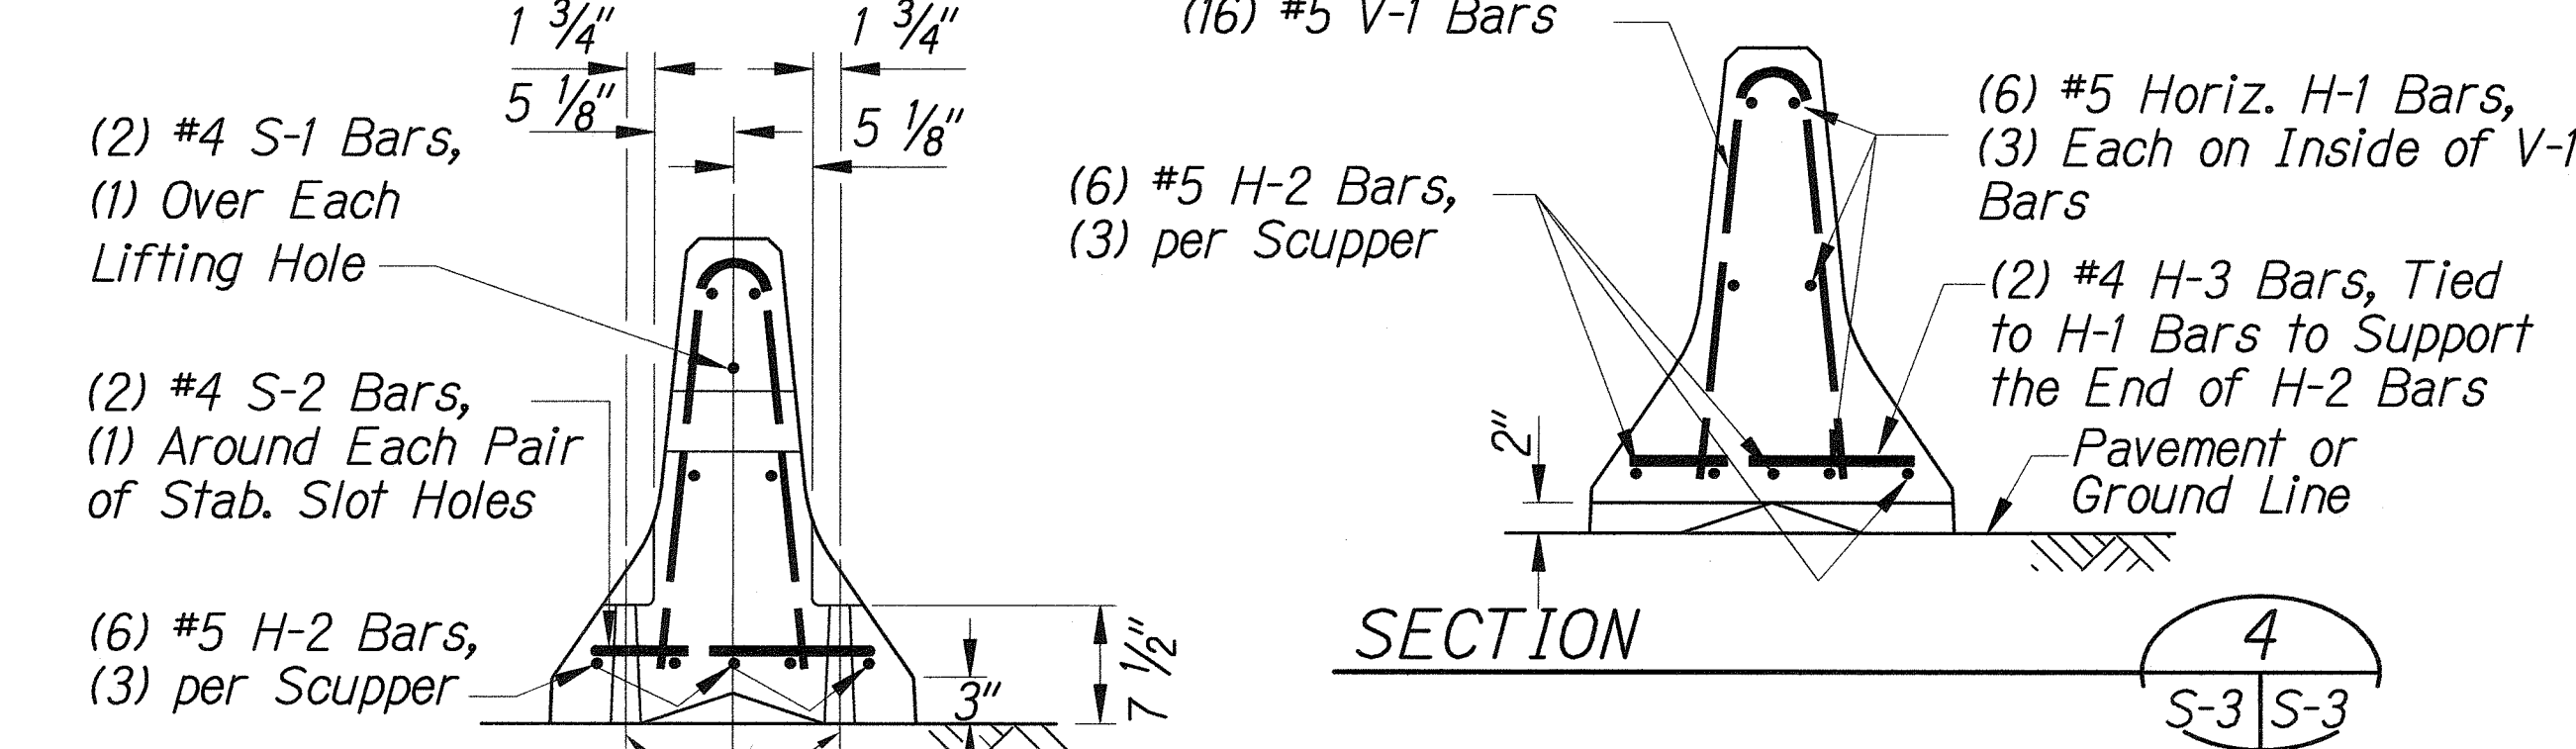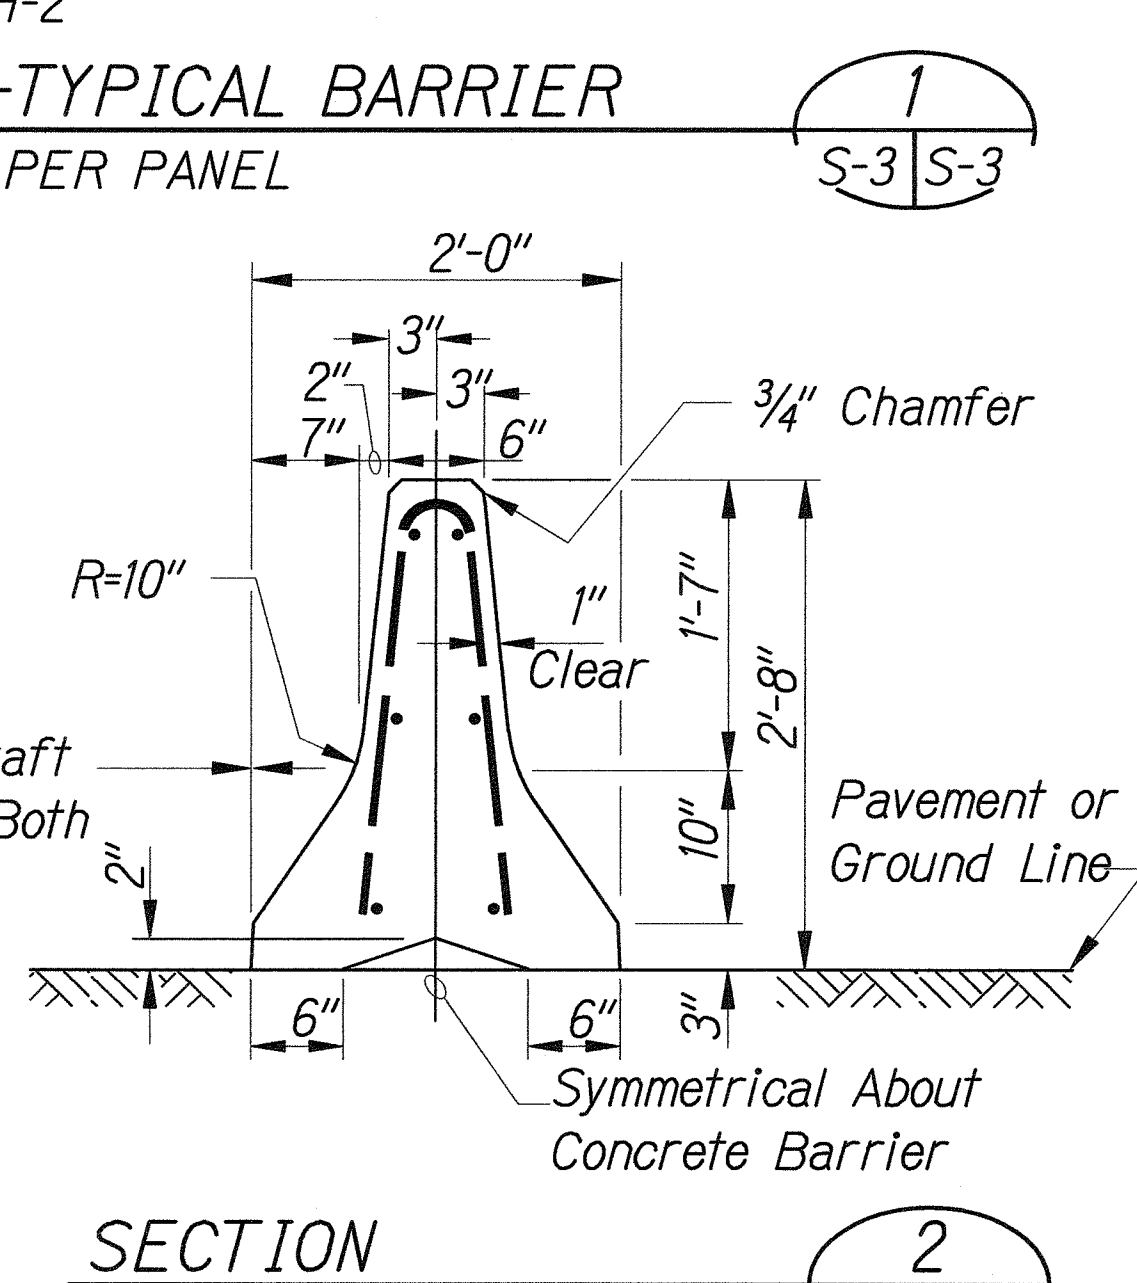

**BARRIER STABILIZATION DETAIL**  
(See Note Nos. 3 & 4 on Sheet S-4)

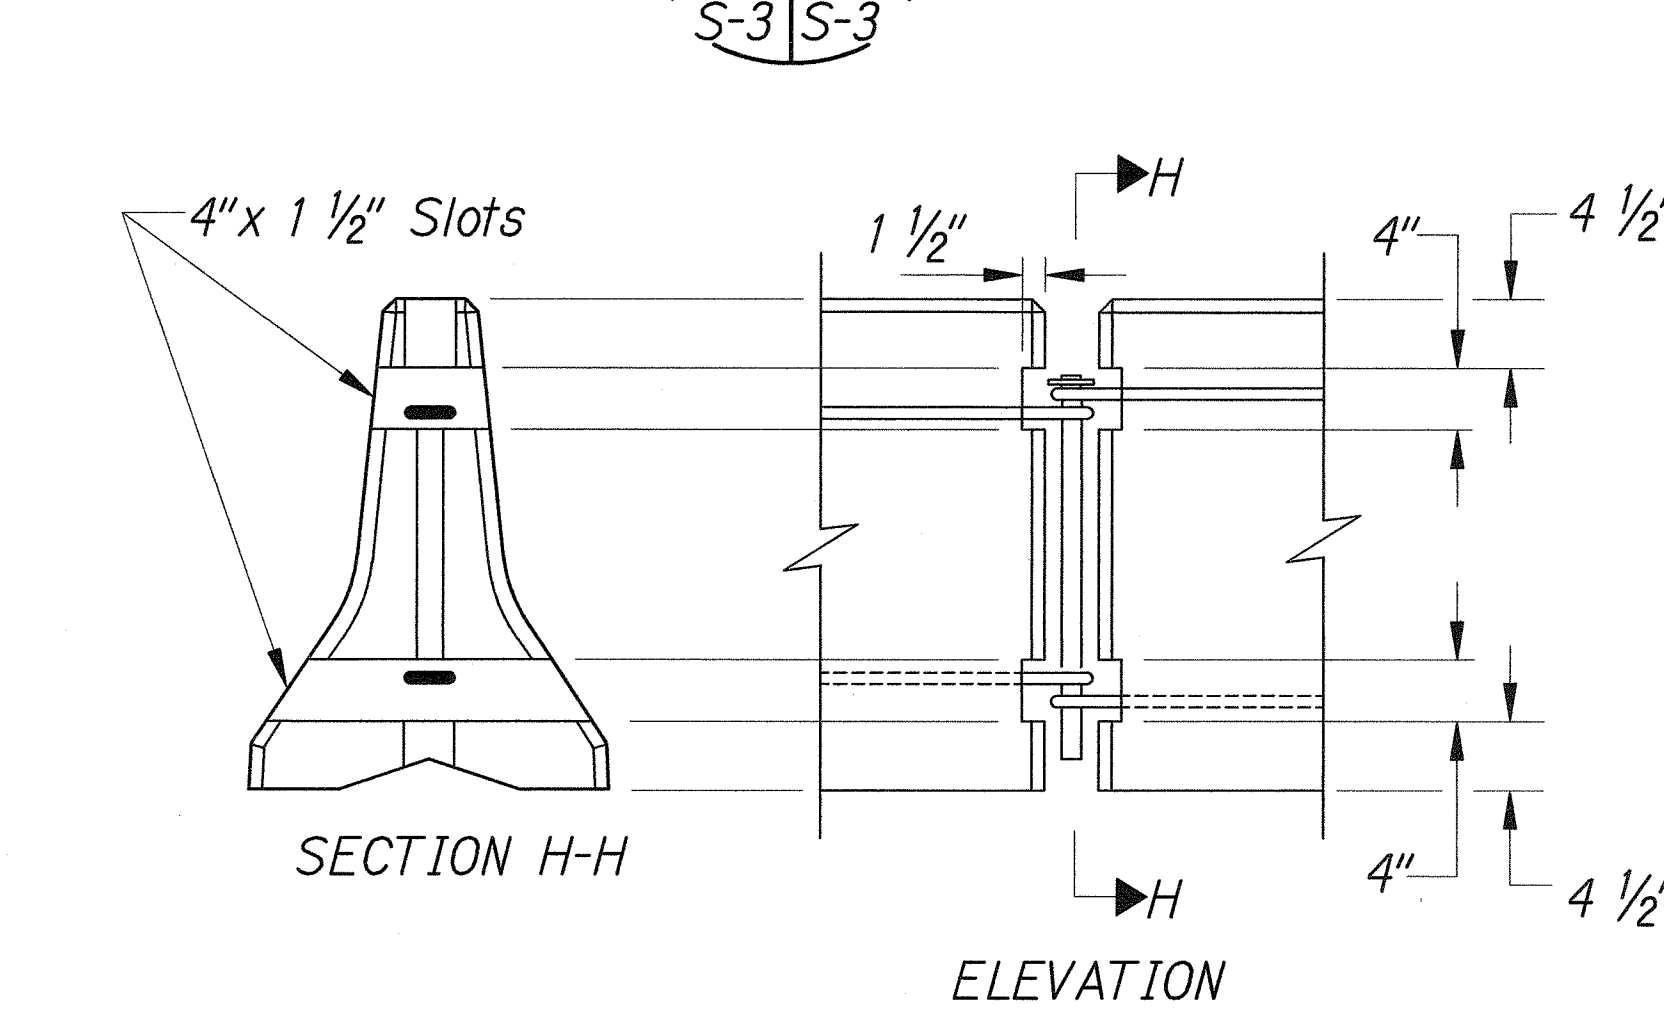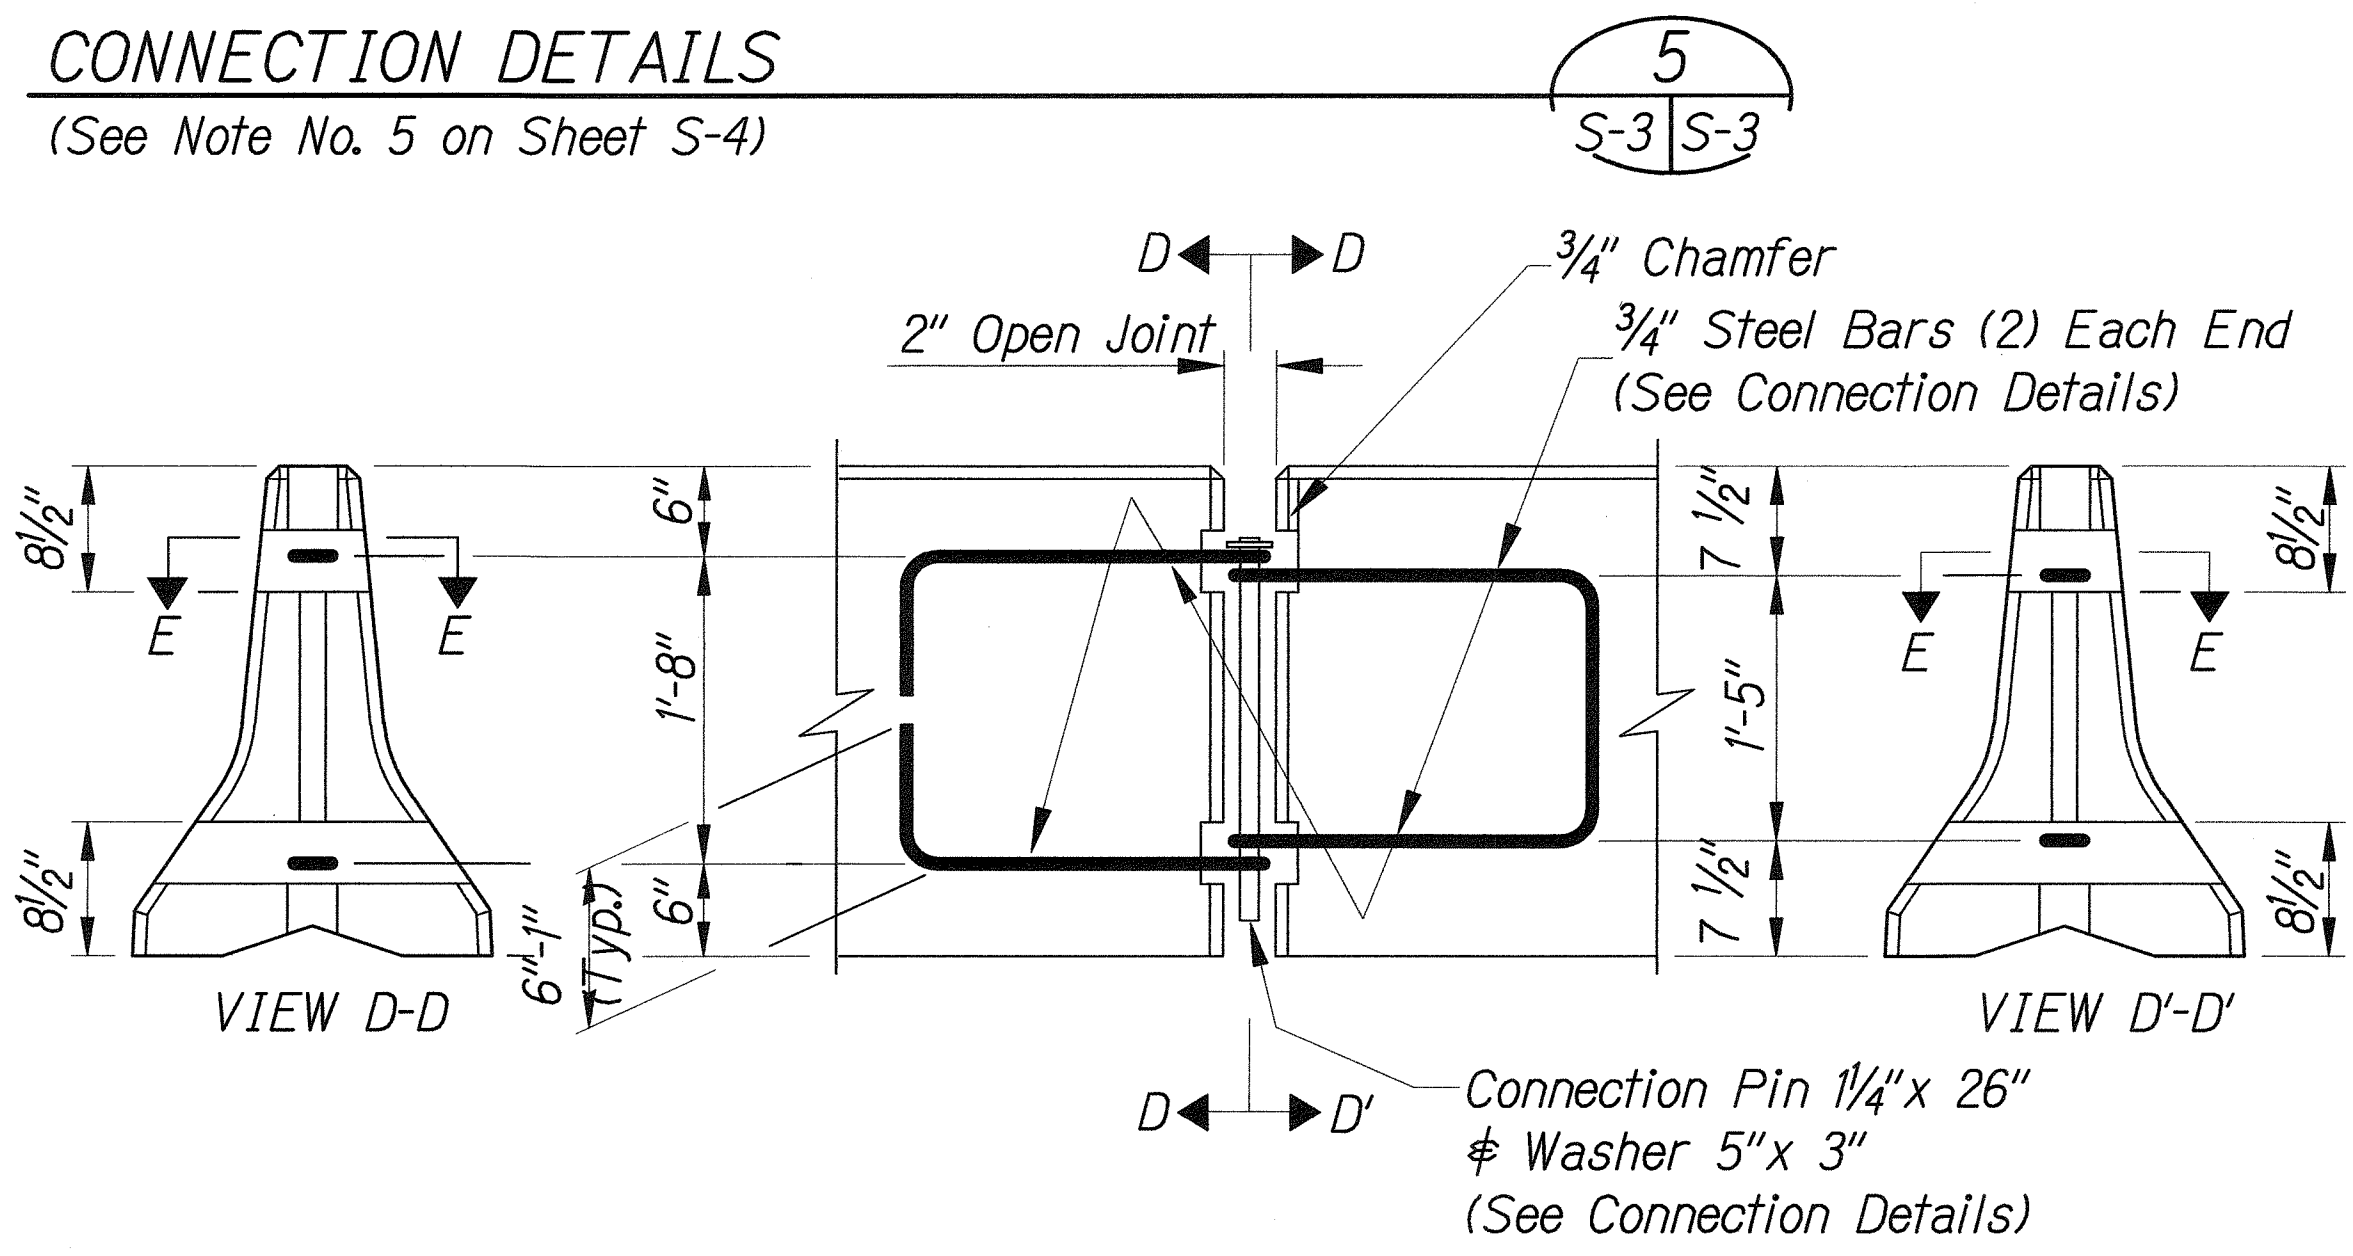

**BARRIER REMOVAL SLOT DETAILS**

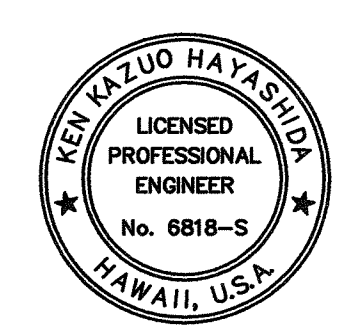

THIS WORK WAS PREPARED BY ME OR UNDER MY SUPERVISION AND CONSTRUCTION OF THIS PROJECT WILL BE UNDER MY OBSERVATION.

April 30, 2004  
EXPIRATION DATE OF THE LICENSE




|                                                                                                                        |                      |
|------------------------------------------------------------------------------------------------------------------------|----------------------|
| 6/15/04                                                                                                                | Added Sheet          |
| Date                                                                                                                   | Revision             |
| <b>DEPARTMENT OF TRANSPORTATION</b><br>HIGHWAYS DIVISION<br><b>PORTABLE CONCRETE BARRIER DETAILS</b>                   |                      |
| <b>LIKELIKE HIGHWAY</b><br>Wilson Tunnel Improvements<br>Leak and Crack Remediation<br>F. A. Project No. STP-063-1(22) |                      |
| Scale: As Shown                                                                                                        | Date: April 24, 2003 |
| SHEET No. S-8 OF 9 SHEETS                                                                                              |                      |


"AS-BUILT"

C.O. 82



| FED. ROAD DIST. NO. | STATE | FED. AID PROJ. NO. | FISCAL YEAR | SHEET NO. | TOTAL SHEETS |
|---------------------|-------|--------------------|-------------|-----------|--------------|
| HAWAII              | HAW.  | STP-063-1(22)      | 2003        | 83        | 69           |
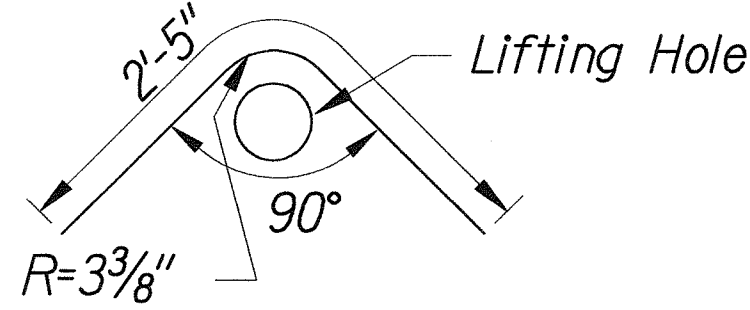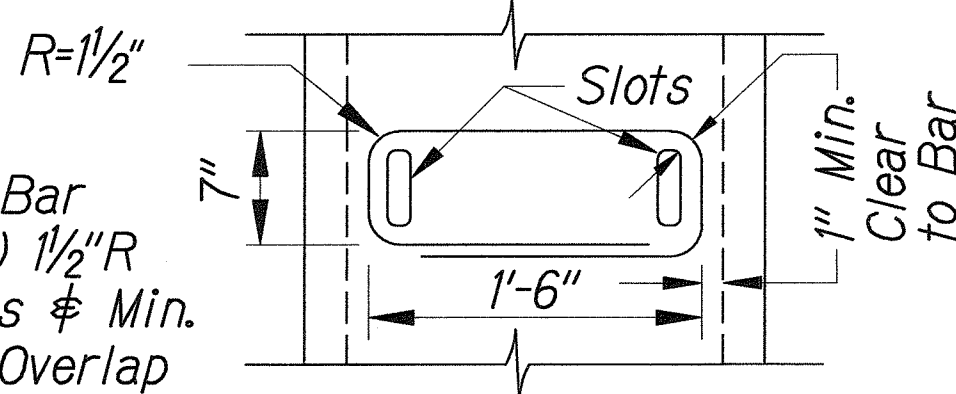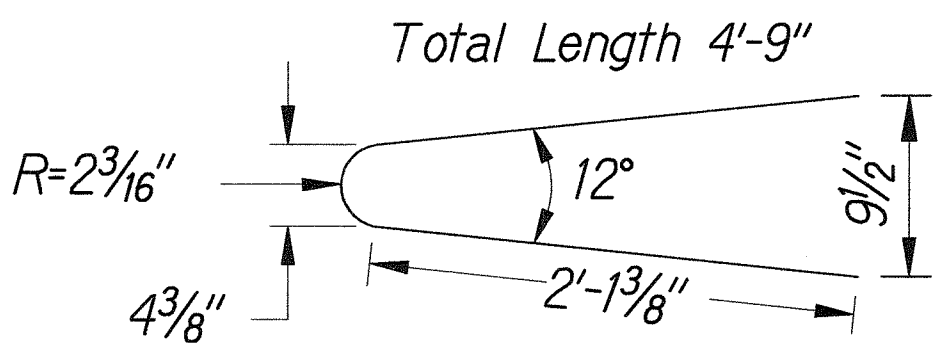
| METAL REINFORCEMENT TABLE |                                                        |          |            |                                                                                     |
|---------------------------|--------------------------------------------------------|----------|------------|-------------------------------------------------------------------------------------|
| MARK                      | LOCATION                                               | BAR SIZE | (NO. BARS) | SKETCH                                                                              |
| H-1                       | Horizontal in Barrier Tied Inside V-1 Bars             | #5       | (6)        | 19'-3"                                                                              |
| H-2                       | Centered Above Scuppers Long. & Transversely           | #5       | (6)        | 6'-6"                                                                               |
| H-3                       | Tied Above H-1 Bars to Support H-2, Tied to V-1        | #4       | (2)        | 1'-6"                                                                               |
| S-1                       | Horizontal in Top of Wing Wall & in Floor Back Wall    | #4       | (2)        |   |
| S-2                       | Horizontal Around Slots Between V-1's at Scuppers      | #4       | (2)        |   |
| V-1                       | Vertical in Barrier (3) Each End & (2) at Each Scupper | #5       | (16)       |  |

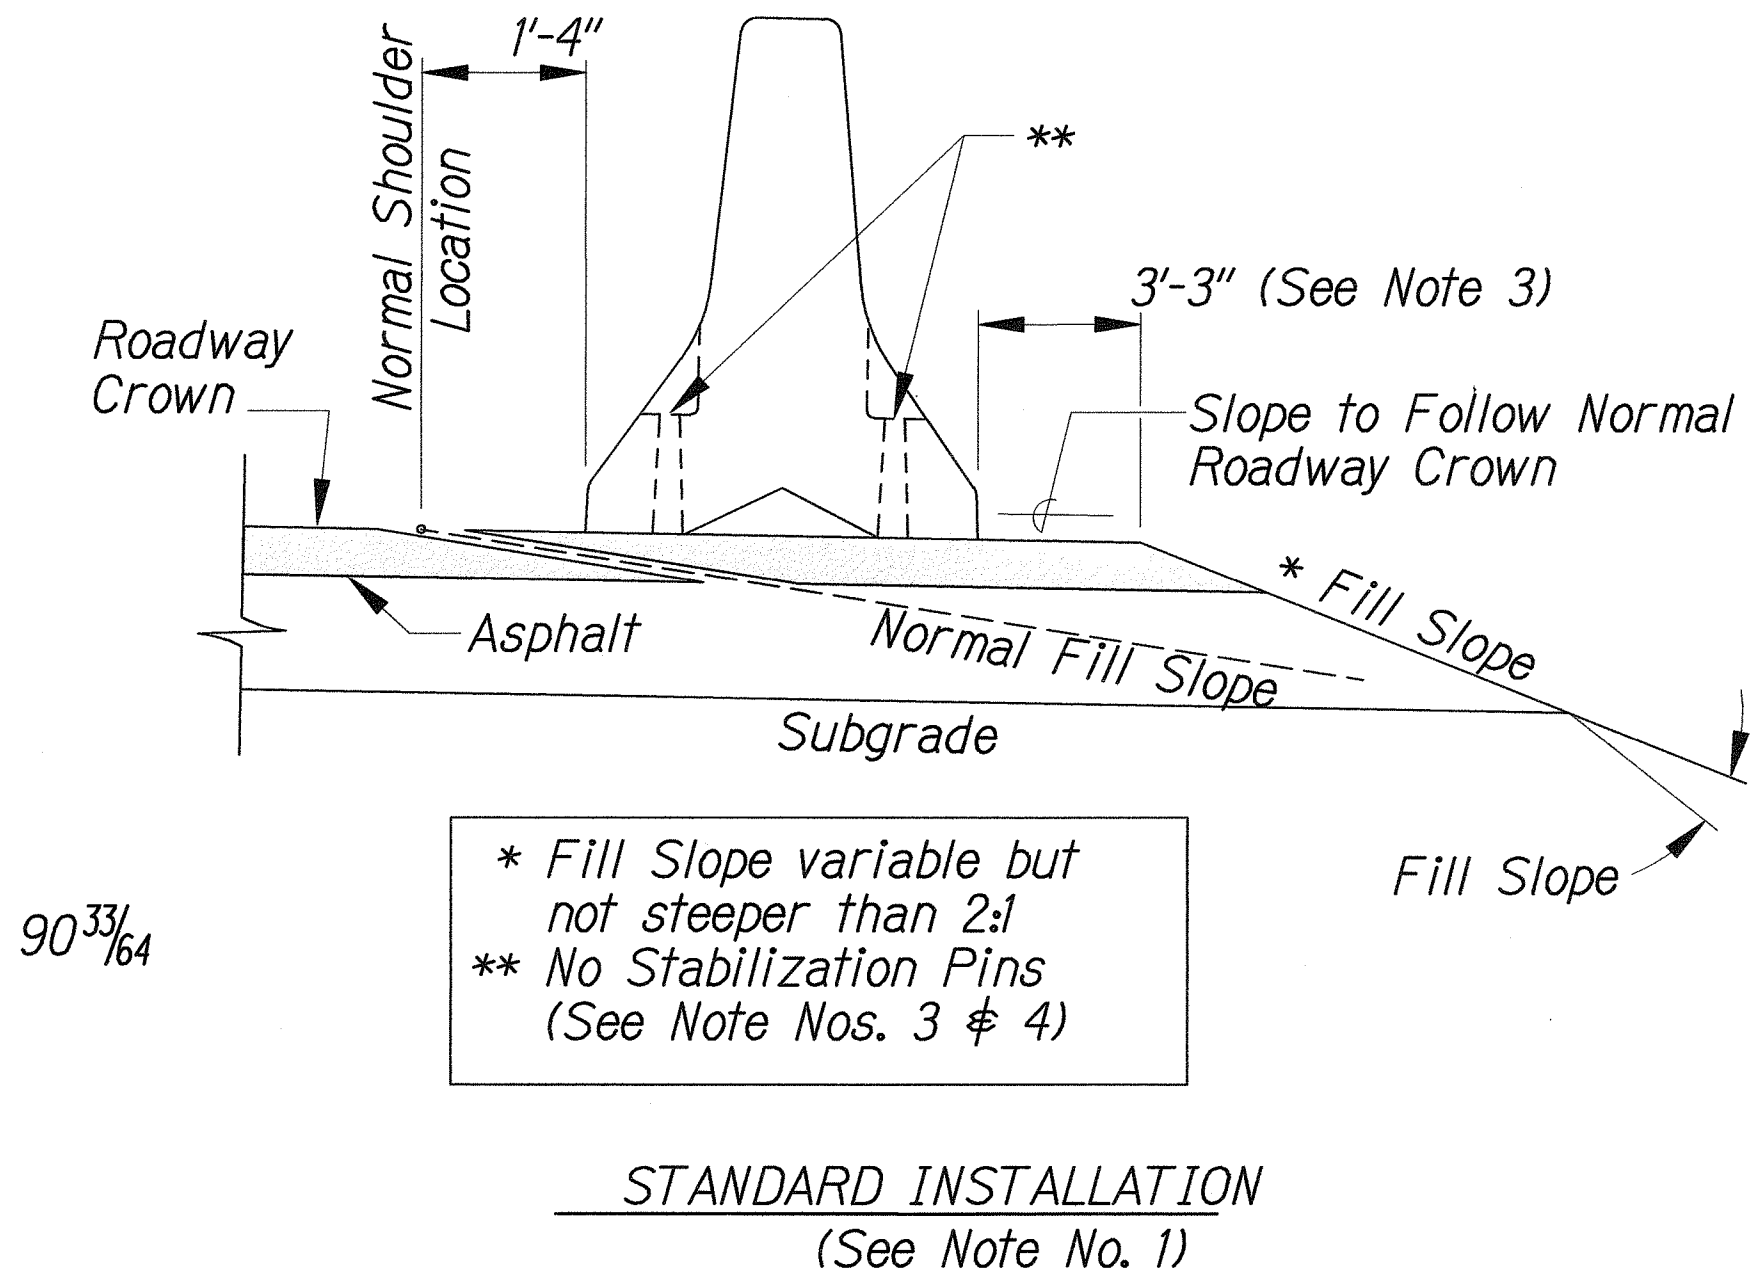

| TABLE A<br>SHY LINE OFFSETS * |                  |
|-------------------------------|------------------|
| DESIGN SPEED (mph)            | SHY LINE OFFSETS |
| 70                            | 10.0'            |
| 65                            | 9.0'             |
| 60                            | 8.5'             |
| 55                            | 7.0'             |
| 50                            | 6.5'             |
| 45                            | 6.0'             |
| 40                            | 5.0'             |
| 35                            | 4.5'             |
| 30                            | 3.5'             |
| 25                            | 2.0'             |

| TABLE B<br>MAXIMUM TAPERS<br>FOR CONCRETE BARRIER |                 |                 |
|---------------------------------------------------|-----------------|-----------------|
| DESIGN SPEED (mph)                                | TAPER           |                 |
|                                                   | INSIDE SHY LINE | BEYOND SHY LINE |
| 70                                                | 30:1            | 20:1            |
| 65                                                | 28:1            | 19:1            |
| 60                                                | 26:1            | 18:1            |
| 55                                                | 24:1            | 16:1            |
| 50                                                | 21:1            | 14:1            |
| 45                                                | 18:1            | 12:1            |
| 40                                                | 17:1            | 11:1            |
| 35                                                | 15:1            | 9:1             |
| 30                                                | 13:1            | 8:1             |


\* Note: Minimum shy line offset for tangent sections shall be 2'-0".

NOTES:

- For end treatment, layout, crash cushions and where needed see Project Plans or Special Provisions.
- Barriers must be pinned together and cannot exceed the Table of Maximum Tapers.
- The concrete barrier "Standard Installation" design allows for 3'-3" of outward lateral movement if the barrier is struck. Barrier installations that require less than the 3'-3" of outward lateral movement should have stabilization pins.
- ASTM A-36 steel shall be used for the connection pin, connection loops and stabilization pins. A one piece pin with a 3" rounded top may be used in place of the detailed connection pin if the one piece pin meets ASTM A-36 requirements.
- A 4" white PVC sleeve may be used to form the lifting hole and if used the sleeve is to be left in place.
- Concrete shall be Class A and reinforcing shall be Grade 60.
- Identification and date of design will be as follows:

PROPERTY  
OF HDOT  
OCT 2001  
Text letters and numbers shall be shown as on Standard Plan Sht. No. B-01. "PROPERTY OF HDOT" may be changed depending upon ownership. All Portable Concrete Barriers made for HDOT will be subject to rejection, if "PROPERTY OF HDOT" is not imprinted. The Contractor shall bear the cost of the rejected Portable Concrete Barriers.

|               |                   |      |
|---------------|-------------------|------|
| ORIGINAL PLAN | SURVEY PLOTTED BY | DATE |
| NOTE BOOK     | DRAWN BY          |      |
|               | DESIGNED BY       |      |
|               | QUANTITIES BY     |      |
|               | CHECKED BY        |      |

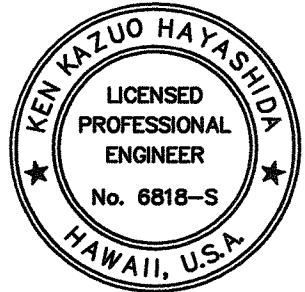

THIS WORK WAS PREPARED BY ME  
OR UNDER MY SUPERVISION AND  
CONSTRUCTION OF THIS PROJECT  
WILL BE UNDER MY OBSERVATION.

April 30, 2004  
SIGNATURE EXPIRATION DATE  
OF THE LICENSE

|                                                                                                                 |                      |
|-----------------------------------------------------------------------------------------------------------------|----------------------|
| 6/15/04                                                                                                         | Added Sheet          |
| Date                                                                                                            | Revision             |
| STATE OF HAWAII<br>DEPARTMENT OF TRANSPORTATION<br>HIGHWAYS DIVISION                                            |                      |
| PORTABLE CONCRETE BARRIER                                                                                       |                      |
| LIKELIKE HIGHWAY<br>Wilson Tunnel Improvements<br>Leak and Crack Remediation<br>F. A. Project No. STP-063-1(22) |                      |
| Scale: As Shown                                                                                                 | Date: April 24, 2003 |
| SHEET No. S-9 OF 9 SHEETS                                                                                       |                      |

"AS-BUILT"

C.O. 83