

INDEX TO DRAWINGS	
SHEET NO.	DESCRIPTION
1	TITLE SHEET
2	STANDARD PLANS SUMMARY
3 - 4	GENERAL NOTES
5 - 7	WATER POLLUTION AND EROSION CONTROL NOTES
8 - 17	TYPICAL SECTIONS AND DETAILS
18 - 24	CURB RAMPS AND DETAILS
25 - 31	INTERSECTION AND MEDIAN DETAILS
32 - 43	GUARDRAIL DETAILS AND NOTES
44 - 48	ROADWAY PLANS
49 - 66	DRAINAGE PLANS AND DETAILS
67 - 71	UTILITY PLANS
72 - 73	PAVEMENT MARKING LEGEND, DETAILS AND NOTES
74	WORK ZONE SIGNING PLAN, NOTES AND DETAILS
75	GALVANIZED SQUARE TUBE SIGN POST MOUNTING
76 - 80	PAVEMENT MARKING AND SIGNING PLANS
81	MISCELLANEOUS SIGN DETAILS
82	TRAFFIC SIGNAL NOTES AND LEGEND
83 - 91	TRAFFIC SIGNAL AND LOOP DETECTOR PLANS AND DETAILS
92 - 111	BRIDGE PLANS

STATE OF HAWAII

DEPARTMENT OF TRANSPORTATION

HIGHWAYS DIVISION

HONOLULU, HAWAII

"AS-BUILT"

PLANS FOR


LIKELIKE HIGHWAY RESURFACING

SCHOOL STREET TO EMMELINE PLACE

FEDERAL AID PROJECT NO. NH-063-1(023)

DISTRICT OF HONOLULU


ISLAND OF OAHU

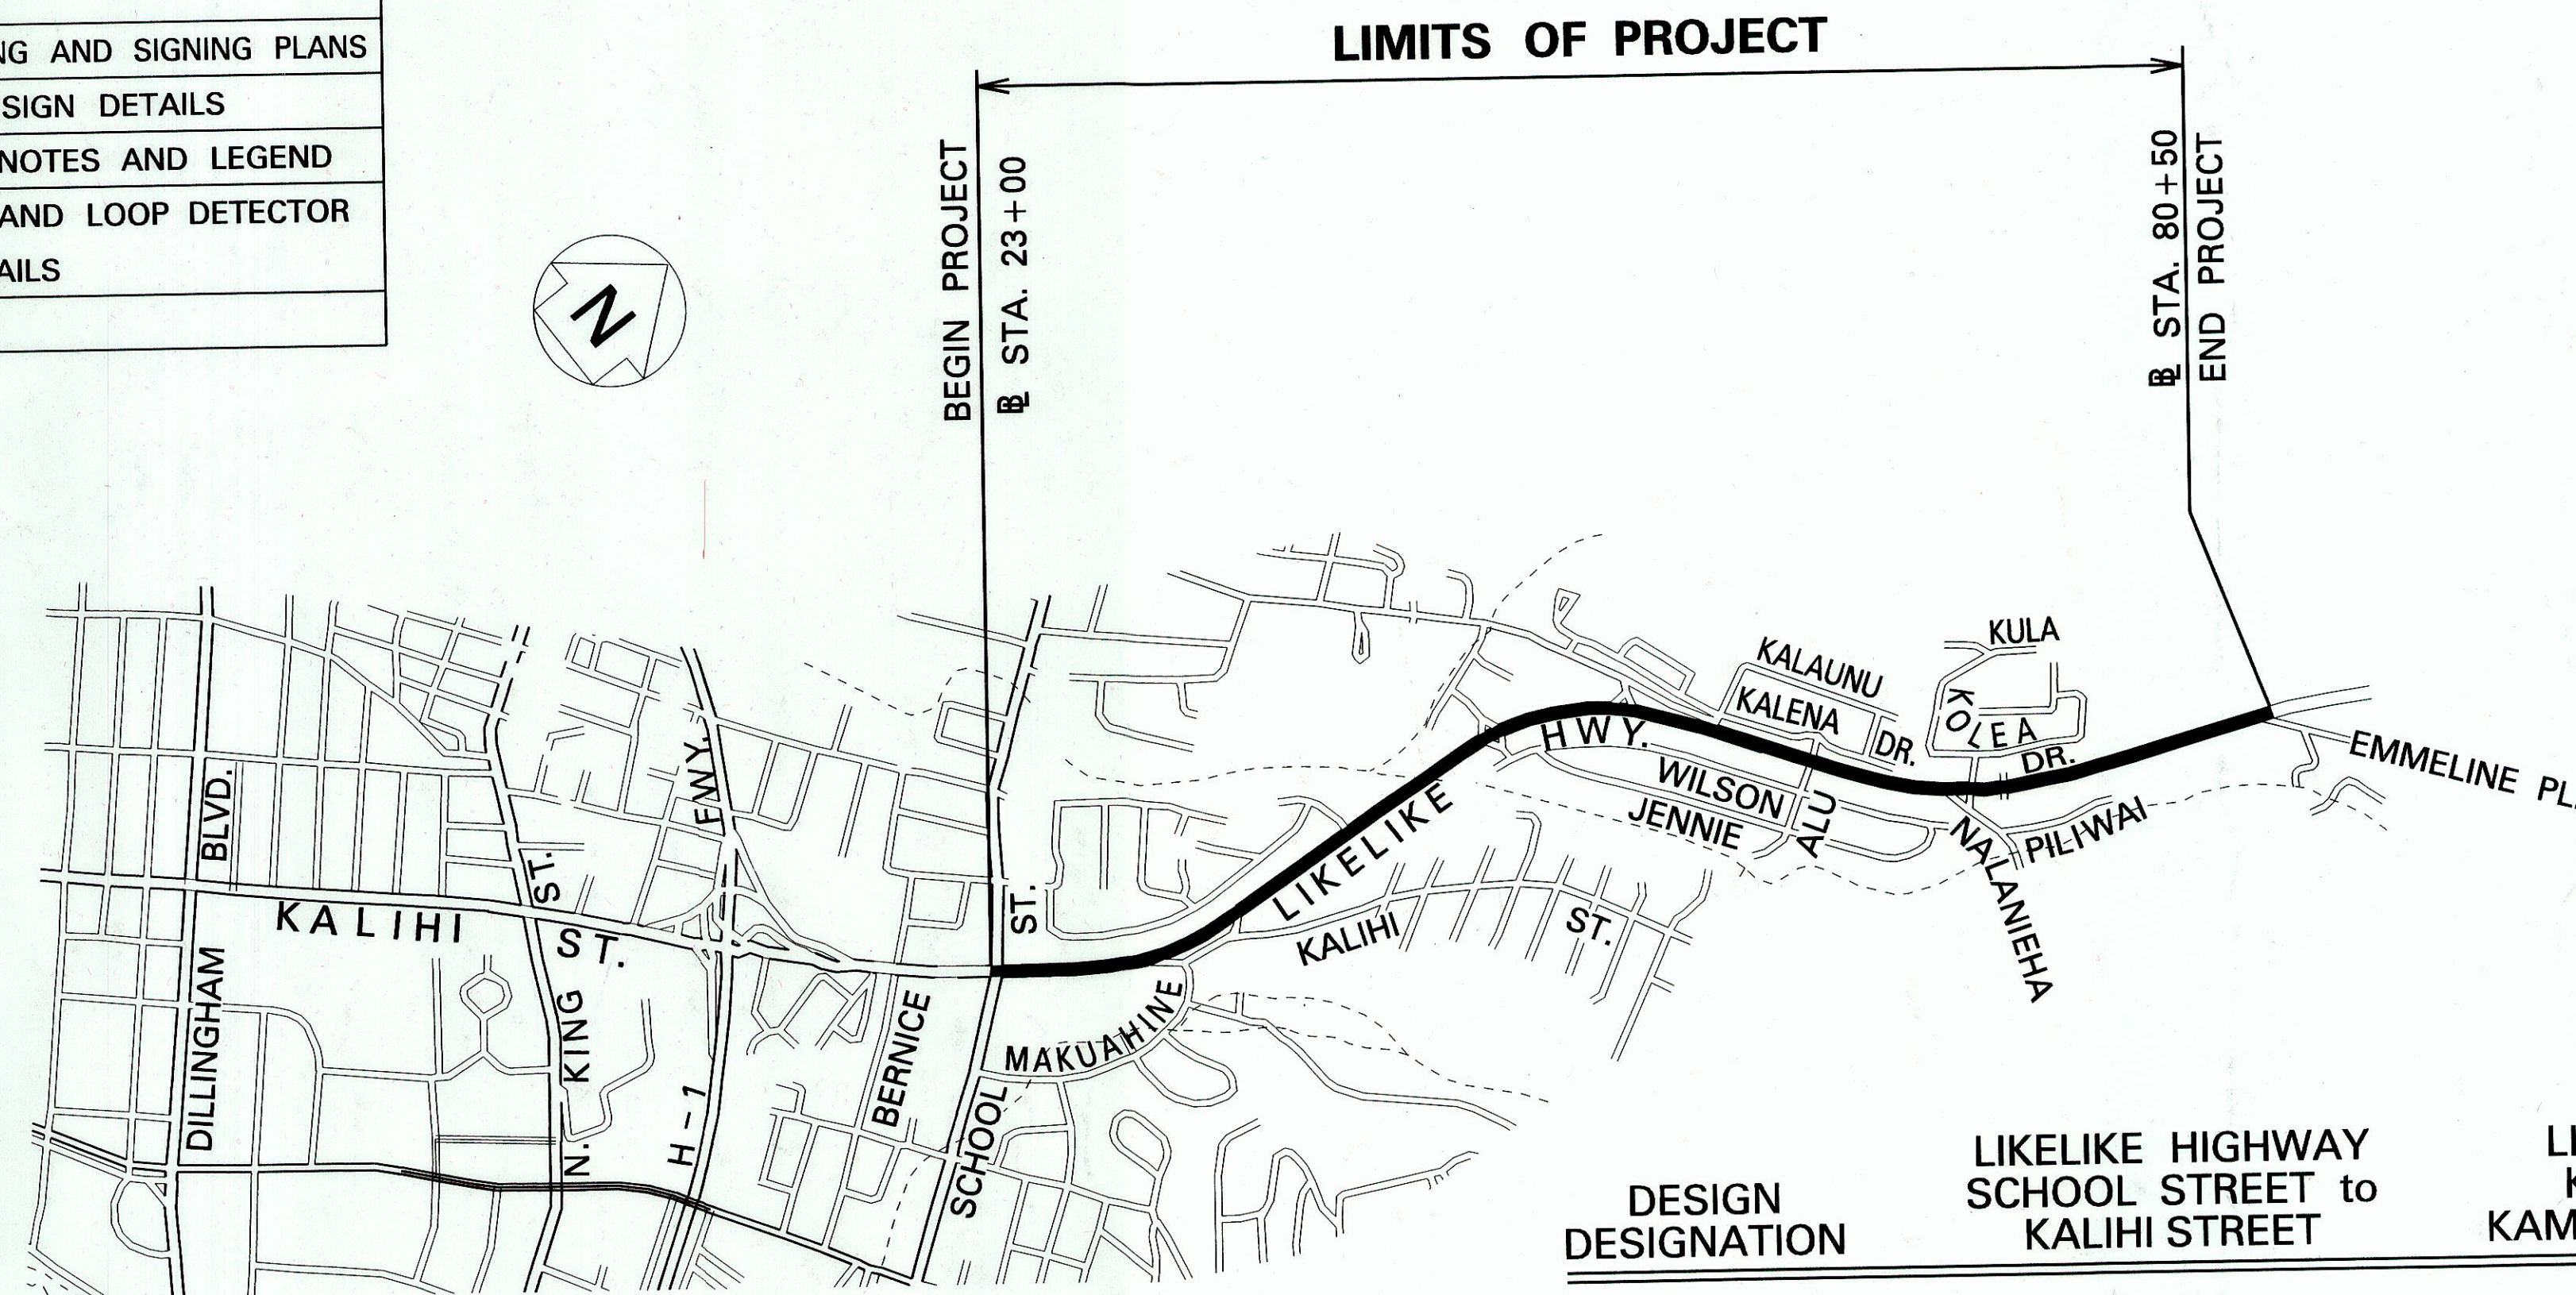

LAYOUT PLAN

GROSS LENGTH OF PROJECT.....1.52 MILES

NET LENGTH OF PROJECT.....1.52 MILES

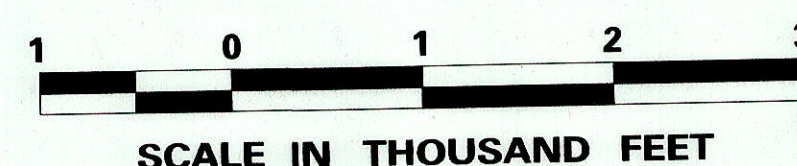

DESIGN DESIGNATION	LIKELIKE HIGHWAY SCHOOL STREET to KALIHI STREET	LIKELIKE HIGHWAY KALIHI STREET to KAMEHAMEHA IV ROAD	LIKELIKE HIGHWAY KAMEHAMEHA IV ROAD to KULA KOLEA DRIVE	LIKELIKE HIGHWAY KULA KOLEA DRIVE to EMMELINE PLACE
ADT (2015).....	44,200 .....	39,600.....	40,500 .....	38,600 .....
ADT (2025).....	45,800 .....	41,100.....	42,000.....	40,000 .....
DHV .....	3,210 .....	3,290.....	3,570.....	3,800 .....
D .....	75/25 .....	80/20 .....	80/20 .....	80/20 .....
T .....	7.0 % .....	6.0 % .....	4.0 % .....	4.0 % .....
V .....	30 M.P.H. ....	45 M.P.H. ....	45 M.P.H. ....	45 M.P.H. ....

CHANGES MADE DURING CONSTRUCTION HAVE BEEN INCORPORATED ON THESE PLANS EXCEPT CHANGES IN THE ORIGINAL THEORETICAL QUANTITIES. FOR ACTUAL QUANTITIES, REFER TO PROJECT LEDGER AND/OR COMPUTATION BOOK.

Samuel M. [Signature]

RESIDENT ENGINEER

4/1/20

DATE

DEPARTMENT OF TRANSPORTATION

STATE OF HAWAII

APPROVED:



[Signature]

DIRECTOR OF TRANSPORTATION

9/15/15

DATE

FED. ROAD DIST. NO.	STATE	FED. AID PROJ. NO.	FISCAL YEAR	SHEET NO.	TOTAL SHEETS
HAWAII	HAW.	NH-063-1(023)	2015	1	111

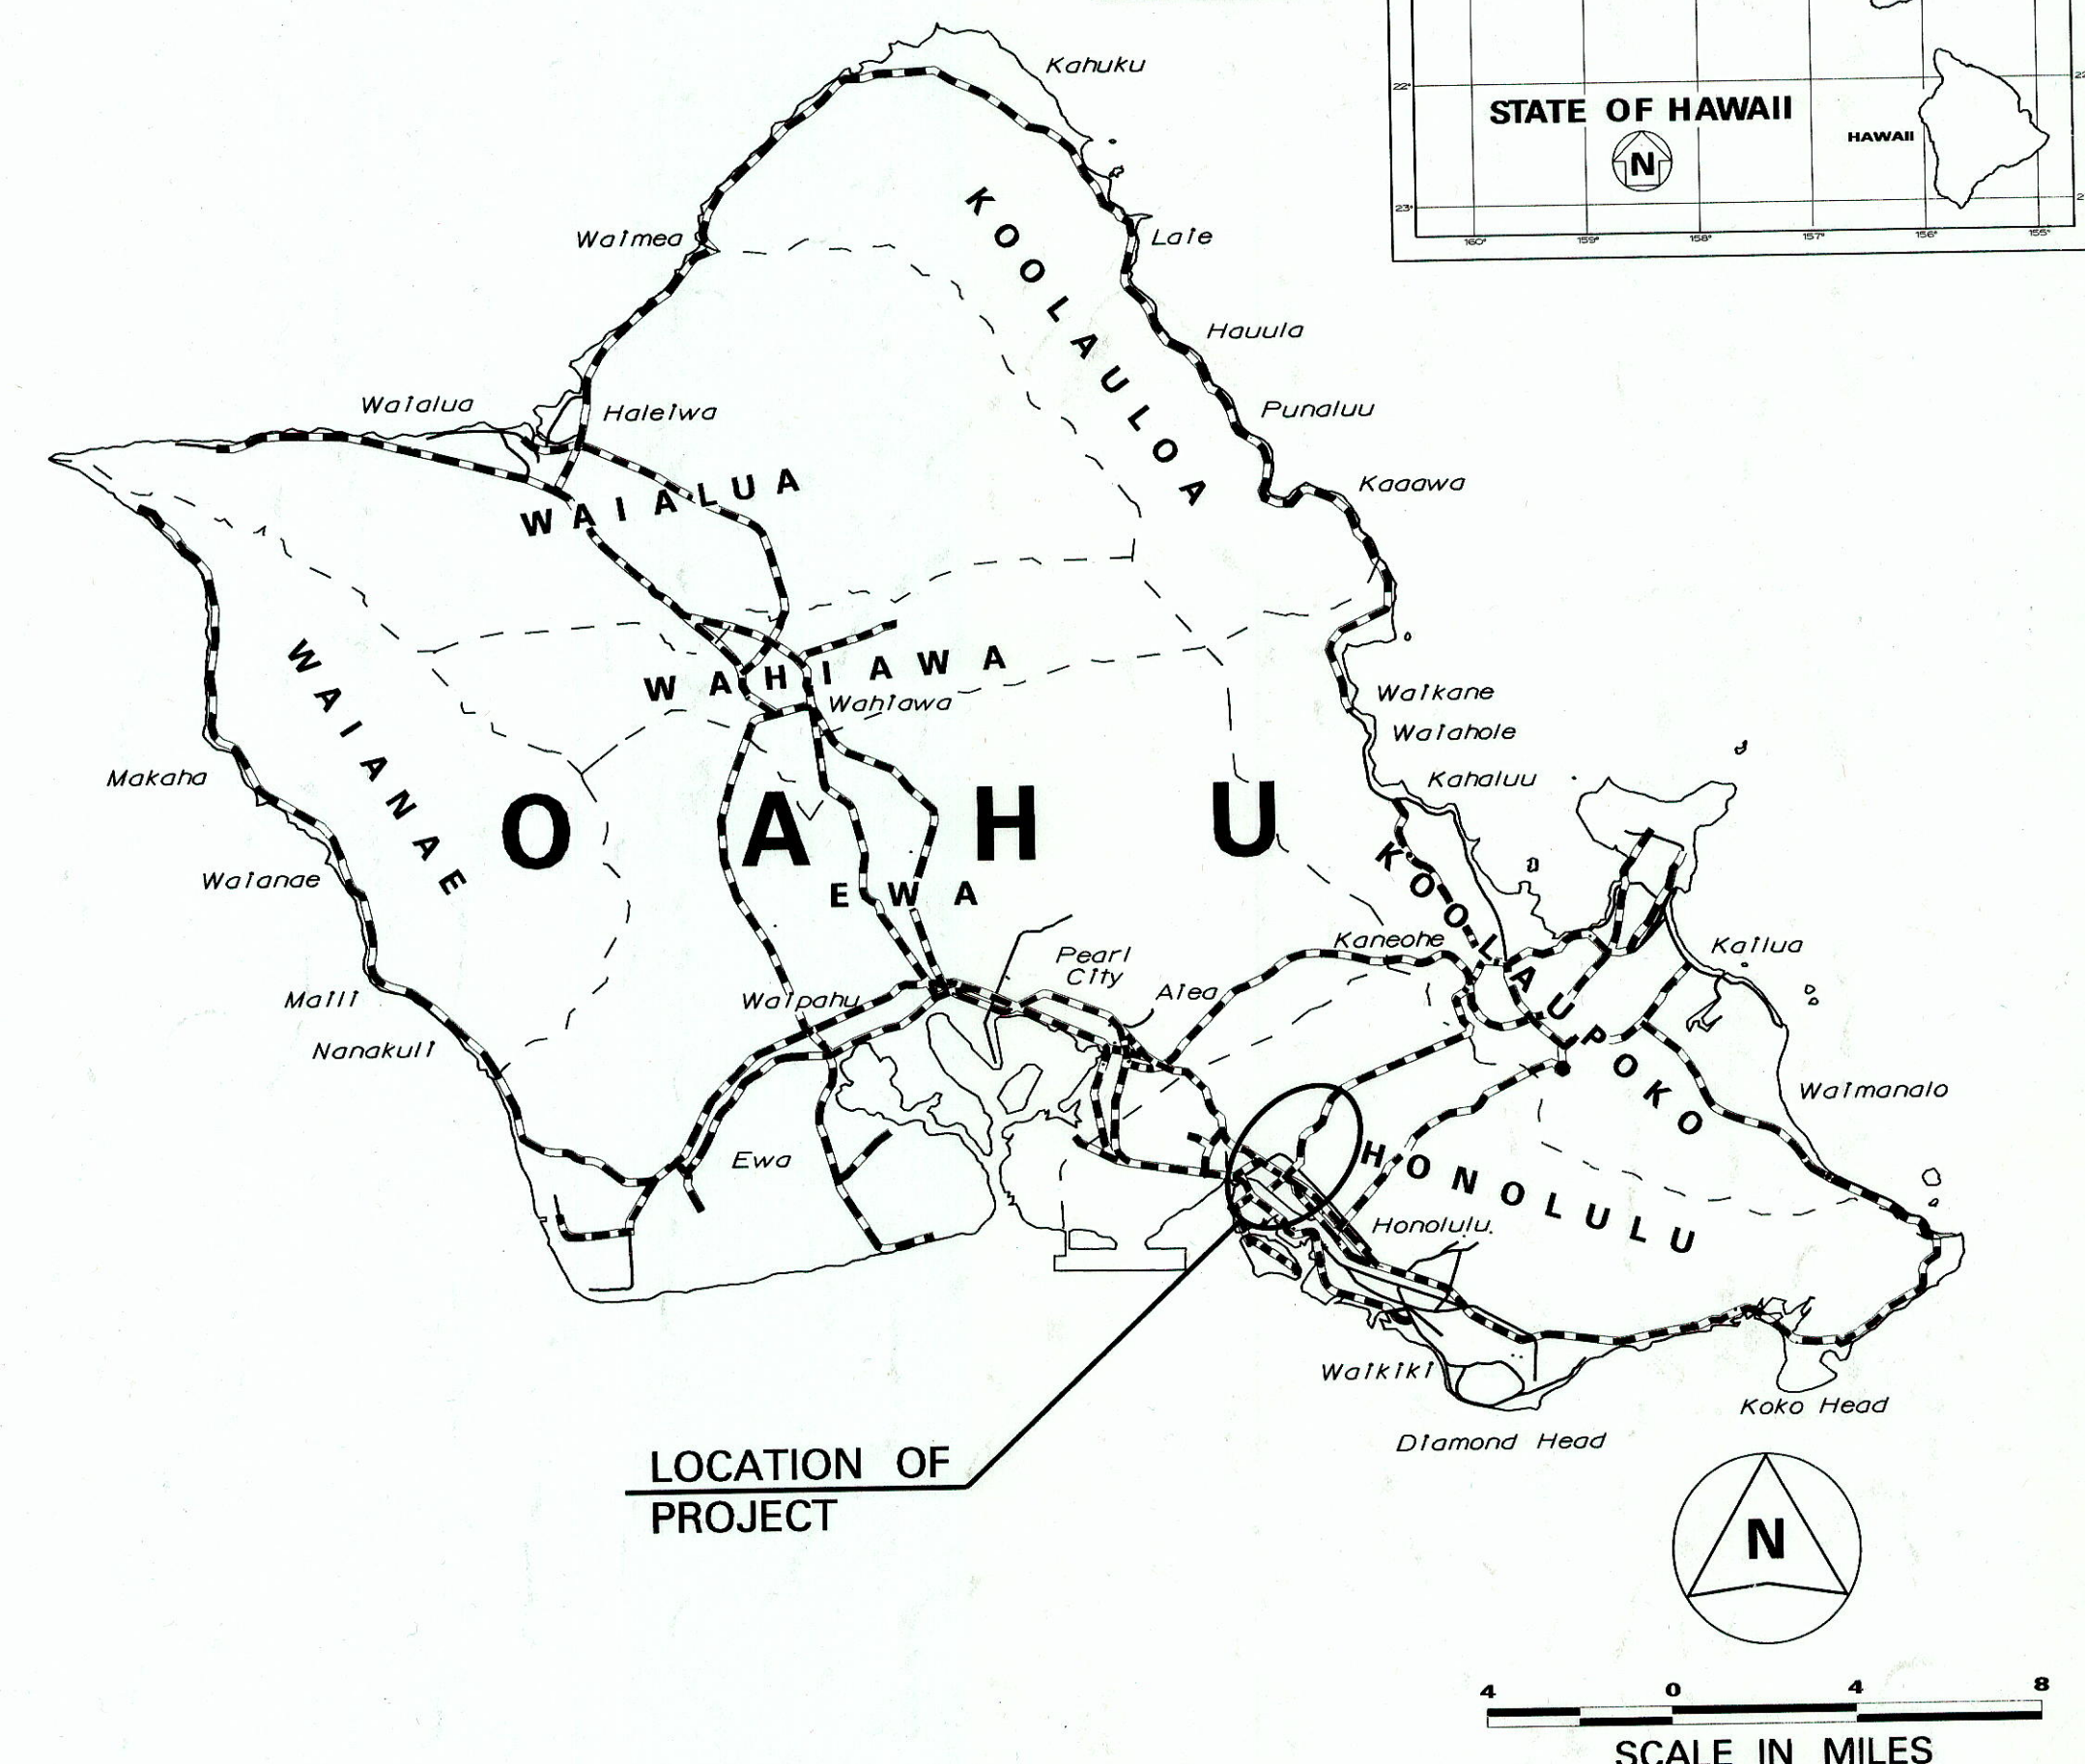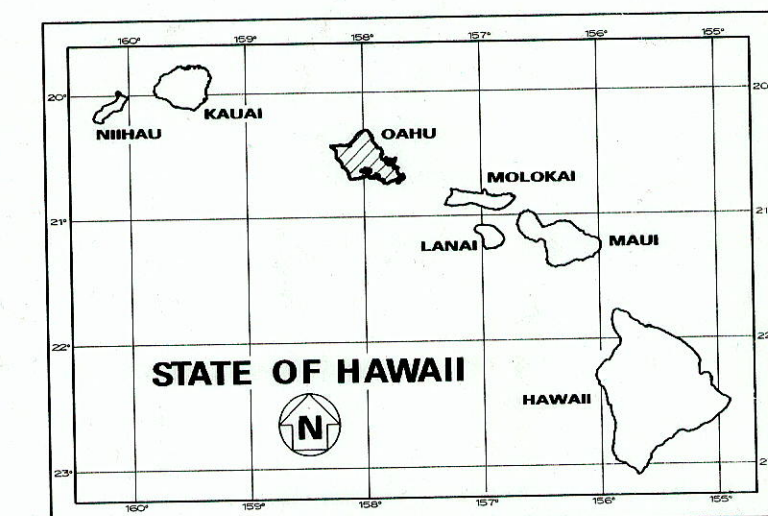

SEPT., 2015

DATE

692-7570

PHONE

HWY-DD

MANAGED BY

HWY-D

DESIGNED BY