


FED. ROAD DIST. NO.	STATE	FED. AID PROJ. NO.	FISCAL YEAR	SHEET NO.	TOTAL SHEETS
HAWAII	HAW.	HES-063-1(12)	1980	40	44

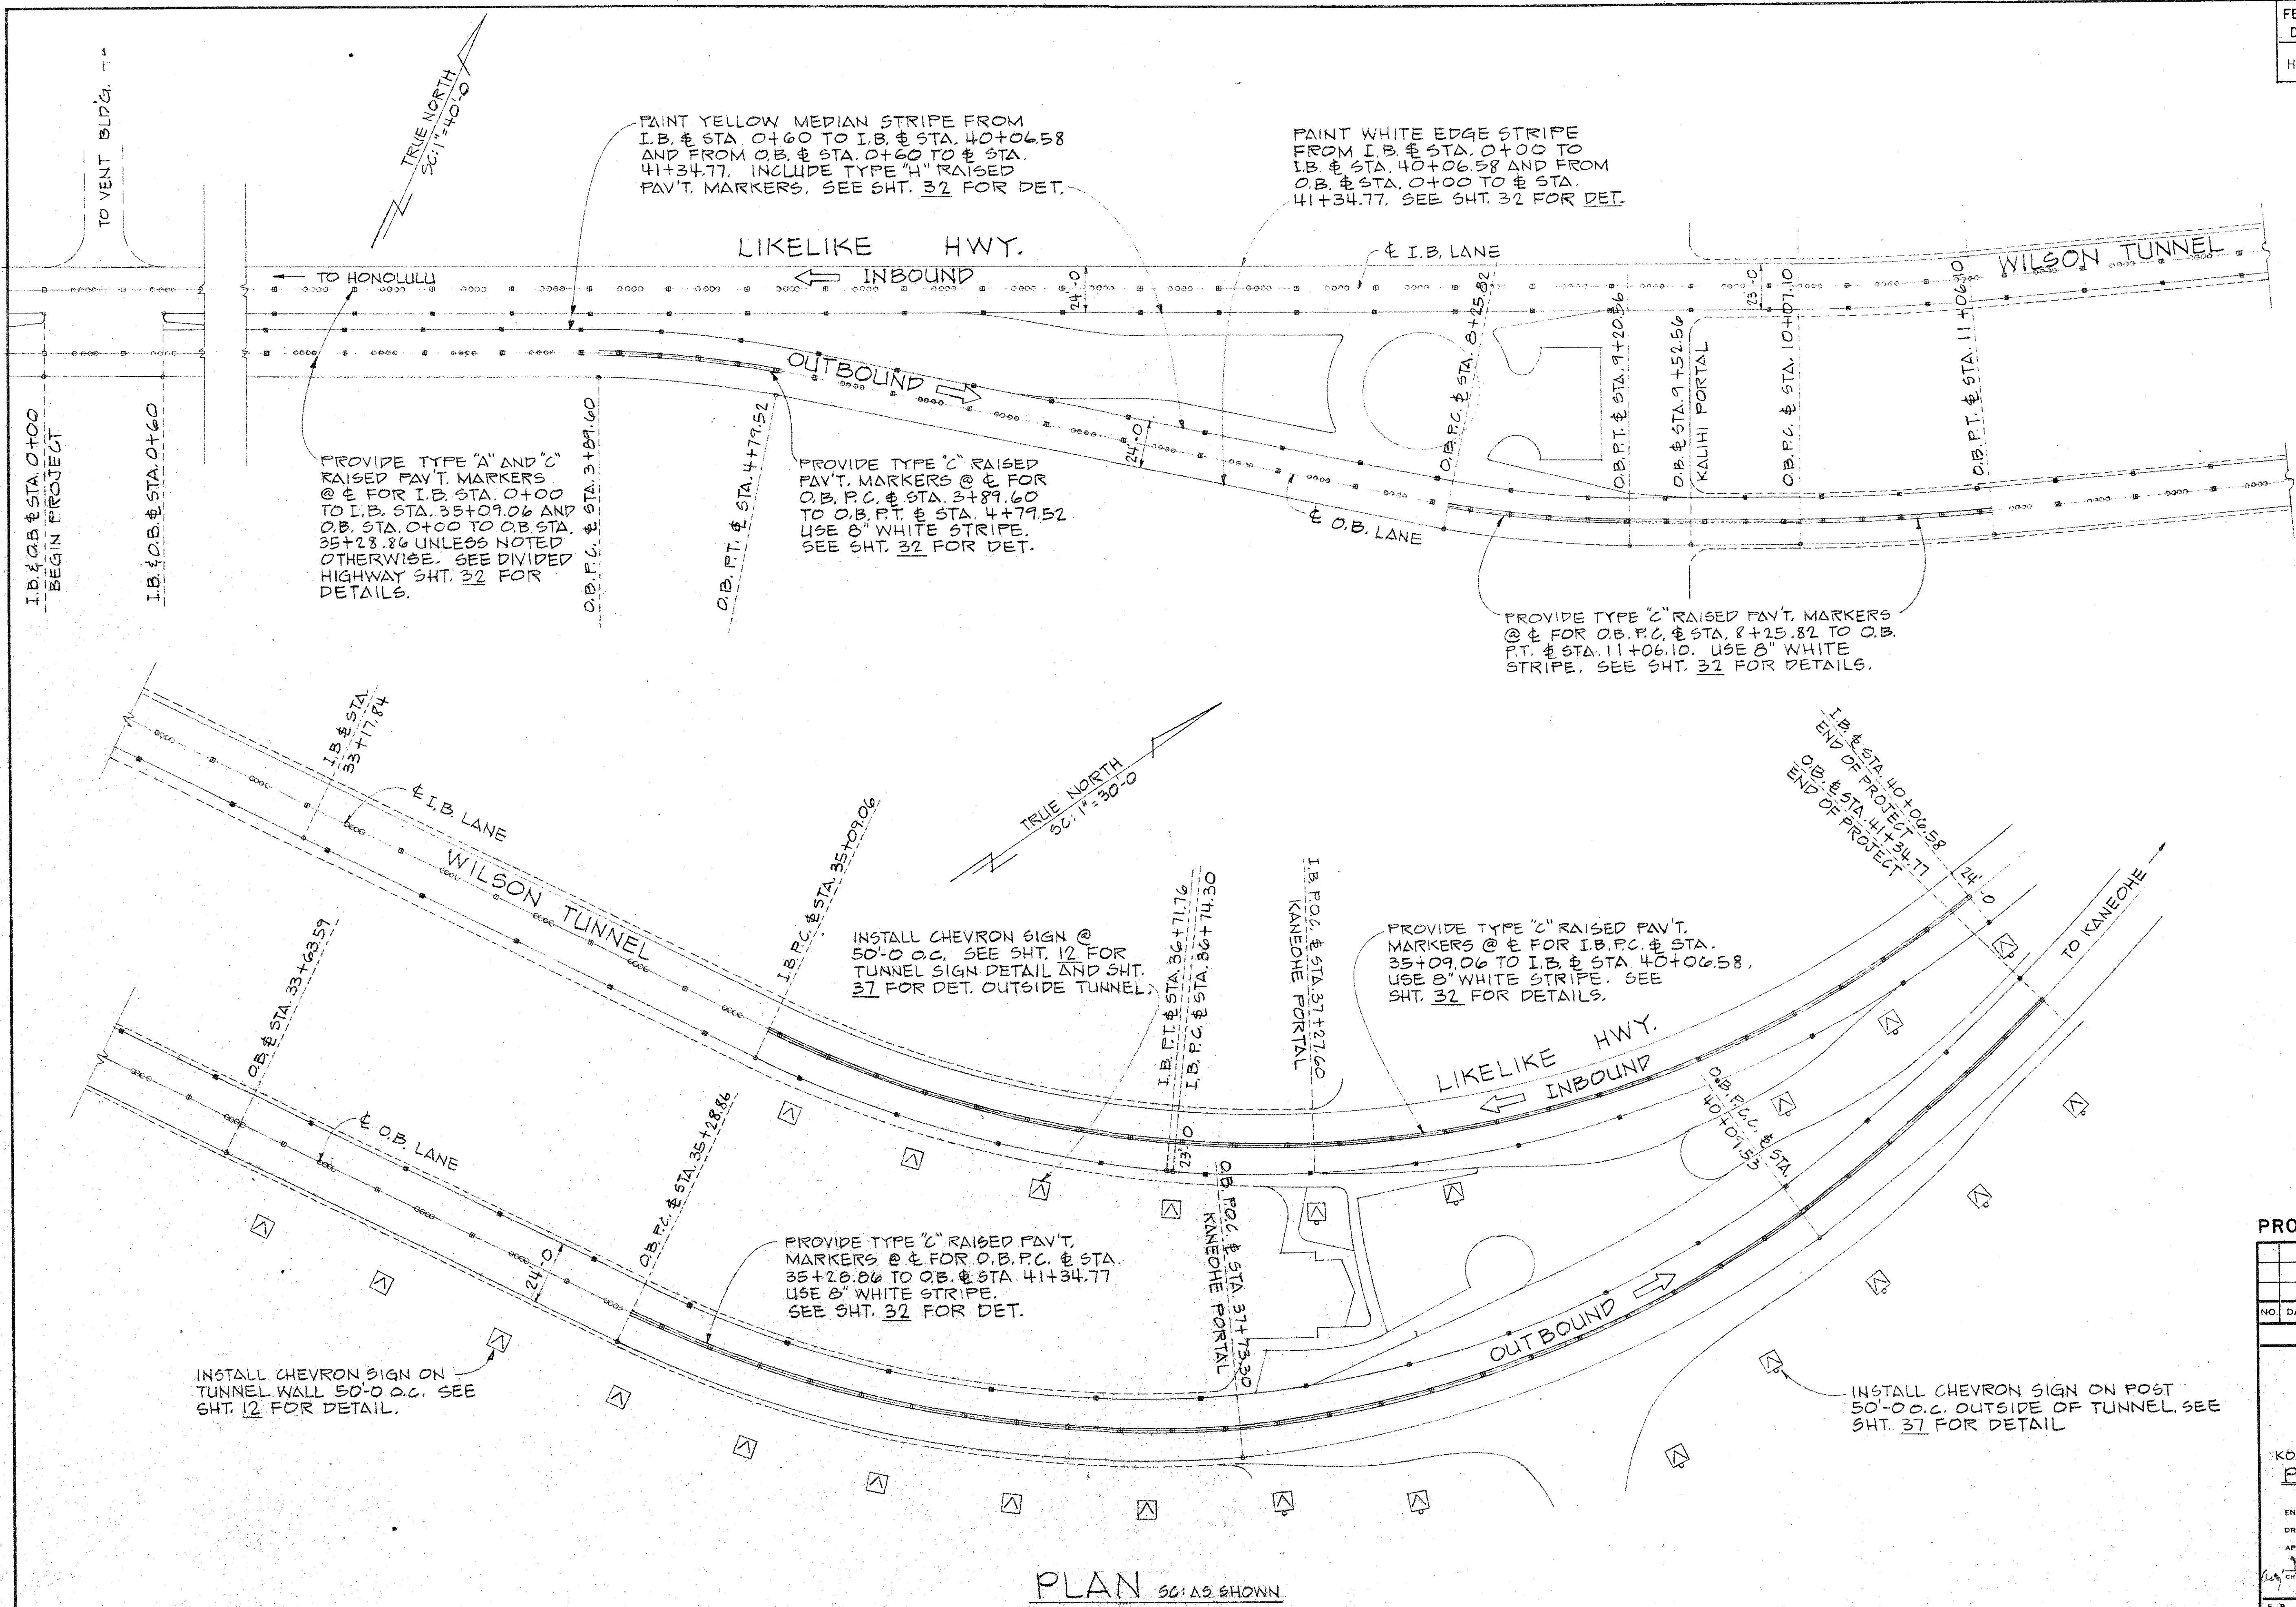

PROJECT NO. HES-063-1(12)

NO.	DATE	DESCRIPTION	ENGR.	DEPT. OR DIV.
REVISIONS				
APPR'D				
DEPARTMENT OF PUBLIC WORKS CITY AND COUNTY OF HONOLULU				
DIVISION OF ENGINEERING				
WILSON TUNNEL SAFETY IMPROVEMENTS				
KOO LAU, OAHU, HAWAII				
PAV'T MARKER & STRIPING AND CHEVRON SIGN PLAN				
ENGINEER	J.W.	D.H.	DATE	9/25/80
DRAFTSMAN	A.K.	CHECKED BY	D.T.	
APPROVED: <i>[Signature]</i> 11/13/80 CHIEF, DIVISION OF ENGINEERING				

JOB NO. 28-80