


FED. ROAD DIST. NO.	STATE	FED. AID PROJ. NO.	FISCAL YEAR	SHEET NO.	TOTAL SHEETS
HAWAII	HAW.	HES-063-1(12)	1980	4	44

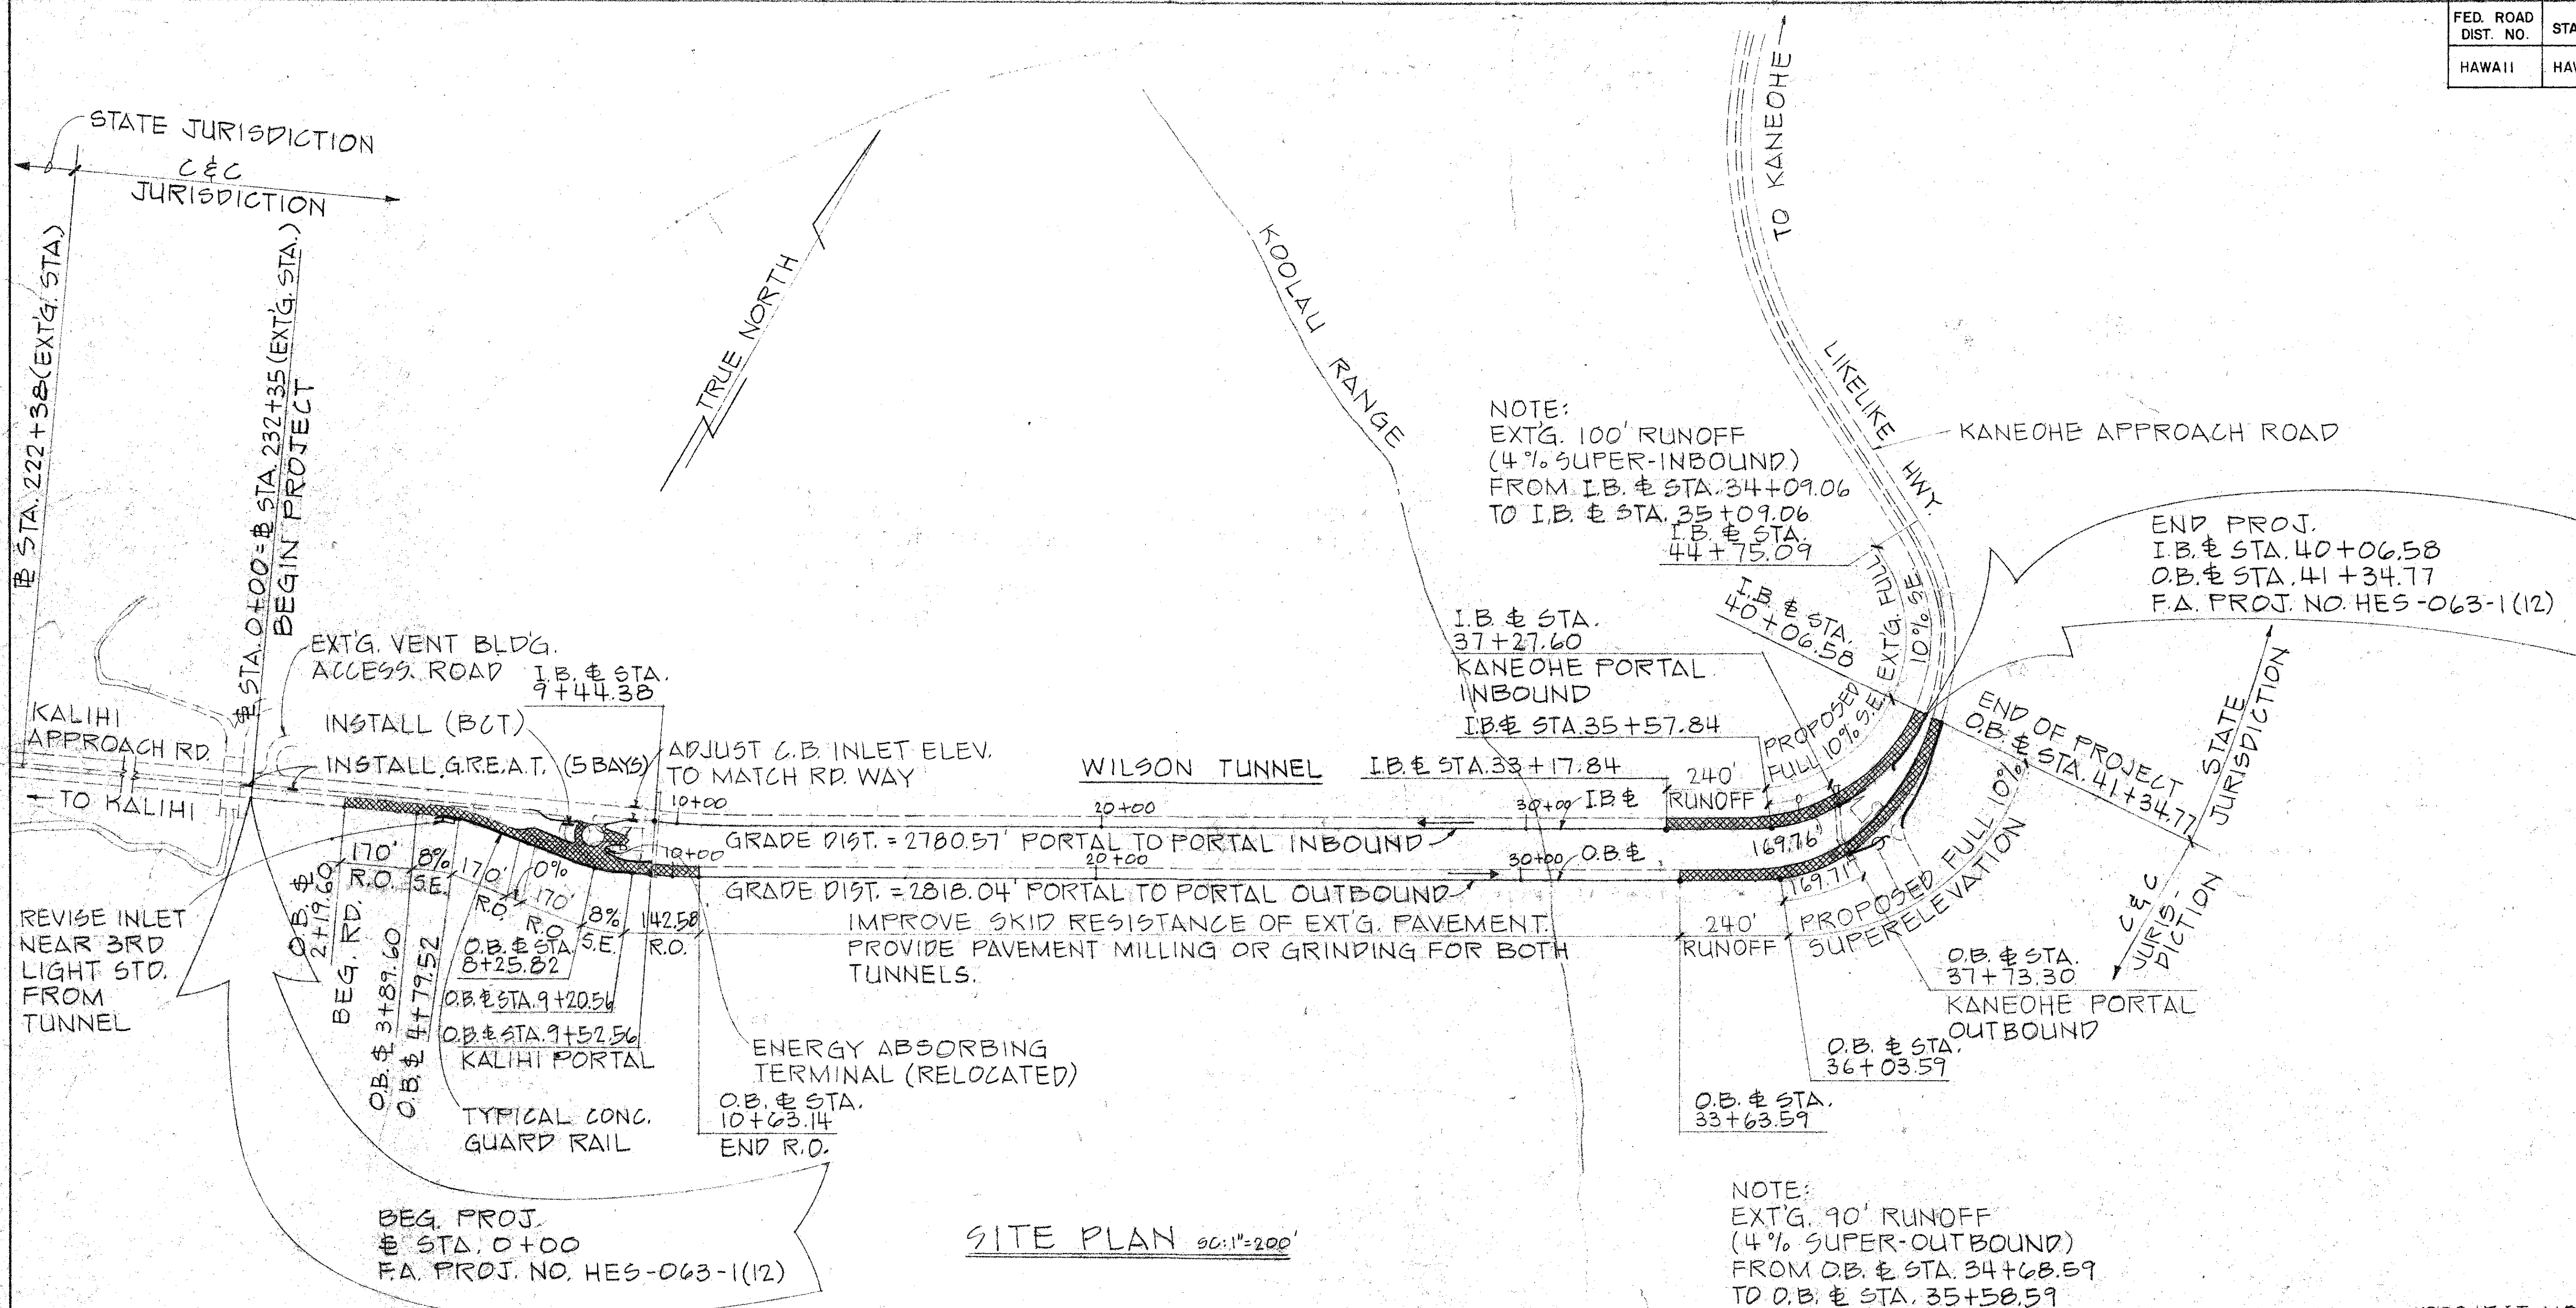

PROJECT NO. HES-063-1(12)

NO.	DATE	DESCRIPTION	ENGR.	DEPT. OR DIV.
REVISIONS		APPR'D		

DEPARTMENT OF PUBLIC WORKS
CITY AND COUNTY OF HONOLULU
DIVISION OF ENGINEERING
WILSON TUNNEL SAFETY IMPROVEMENTS
KOOLAU, OAHU, HAWAII
SITE PLAN
ENGINEER: J.W. ME DATE: 7/25/80
DRAFTSMAN: A.K. CHECKED BY: D.F.
APPROVED: [Signature]
CHIEF, DIVISION OF ENGINEERING

JOB NO. 28-80