




FED. ROAD DIST. NO.	STATE	FED. AID PROJ. NO.	FISCAL YEAR	SHEET NO.	TOTAL SHEETS
HAWAII	HAW.	HES-063-1(12)	1980	2	44

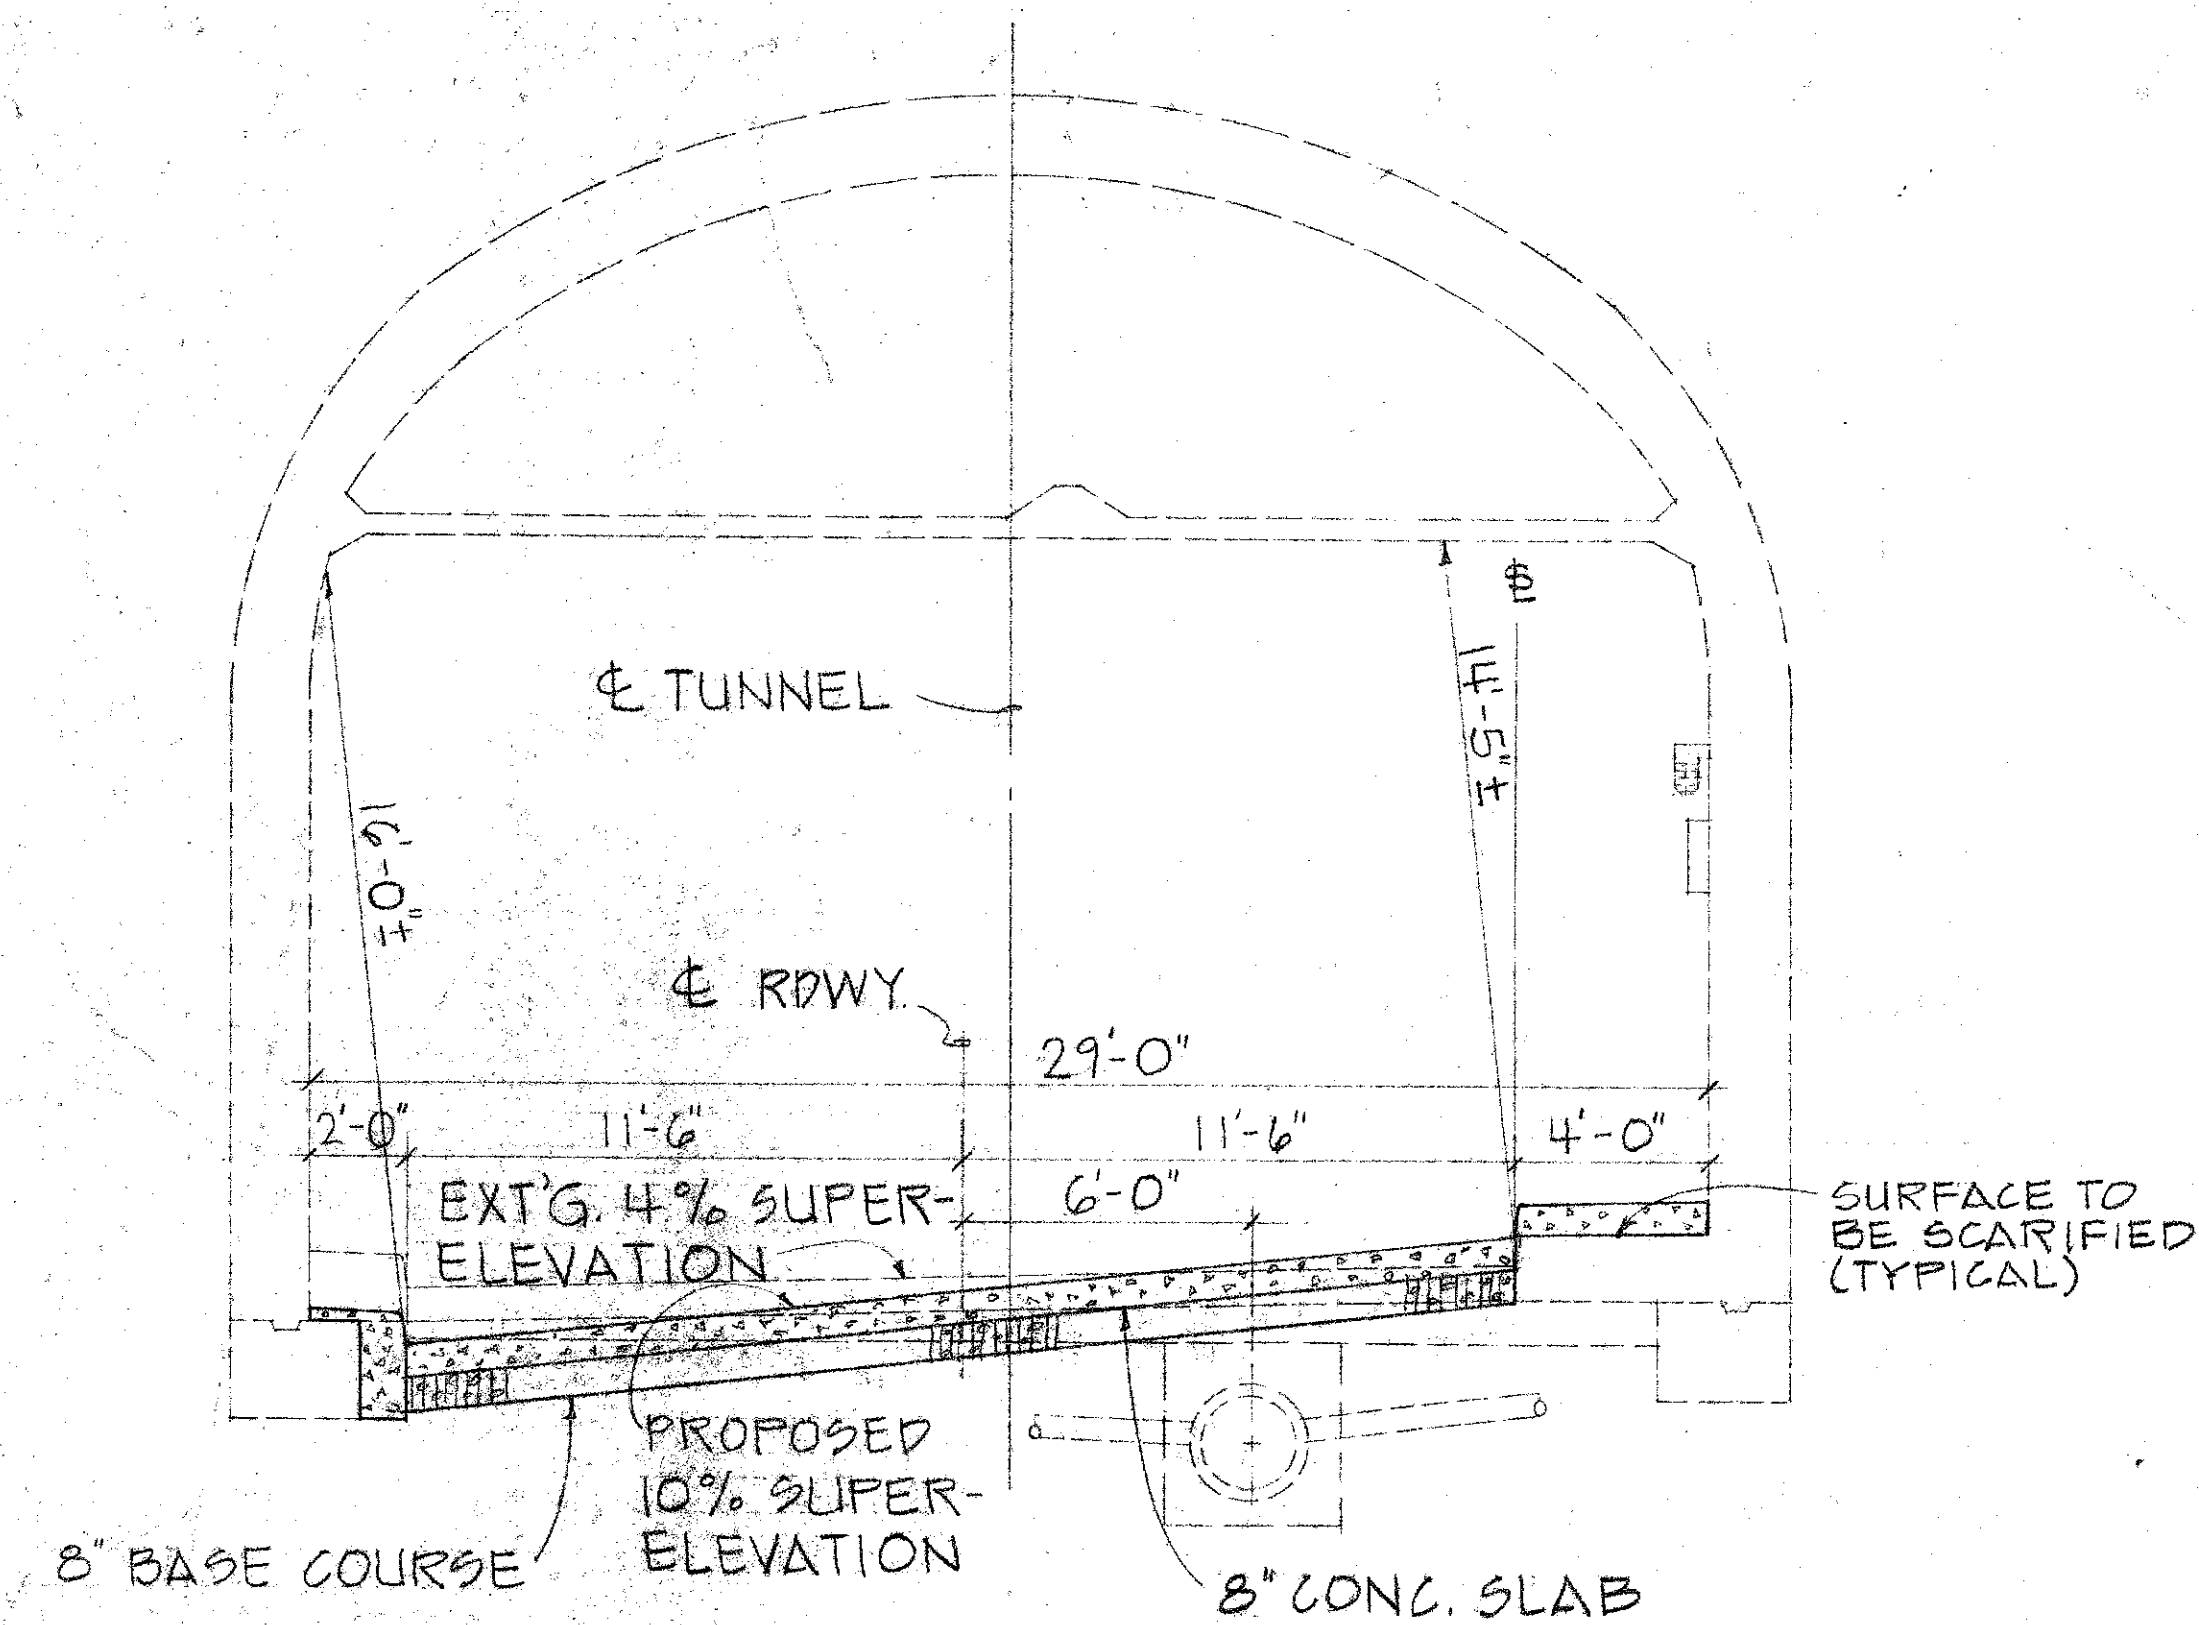

SECTION A
I.B. STA. 36+04.84

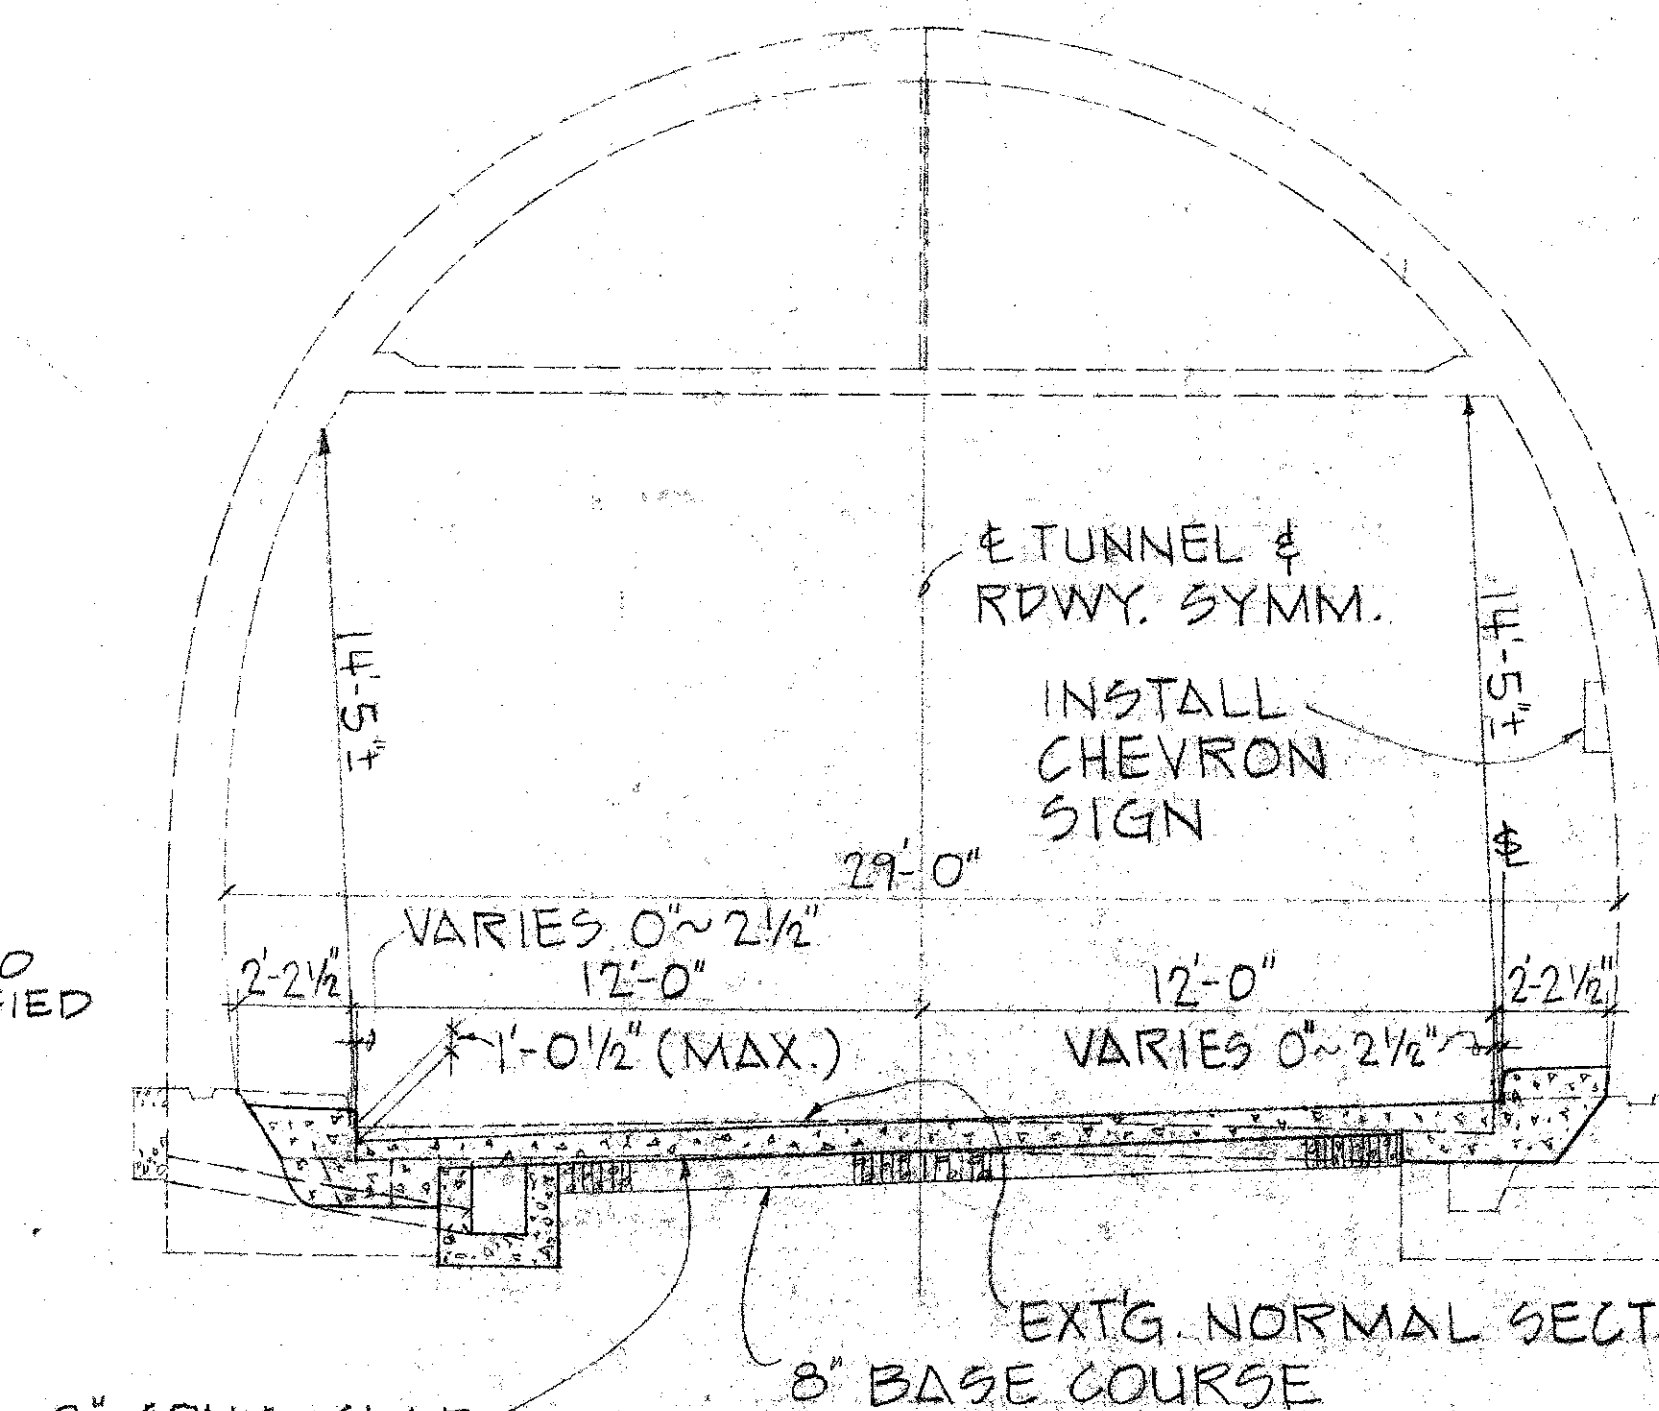


SECTION B
O.B. STA. 34+43.59

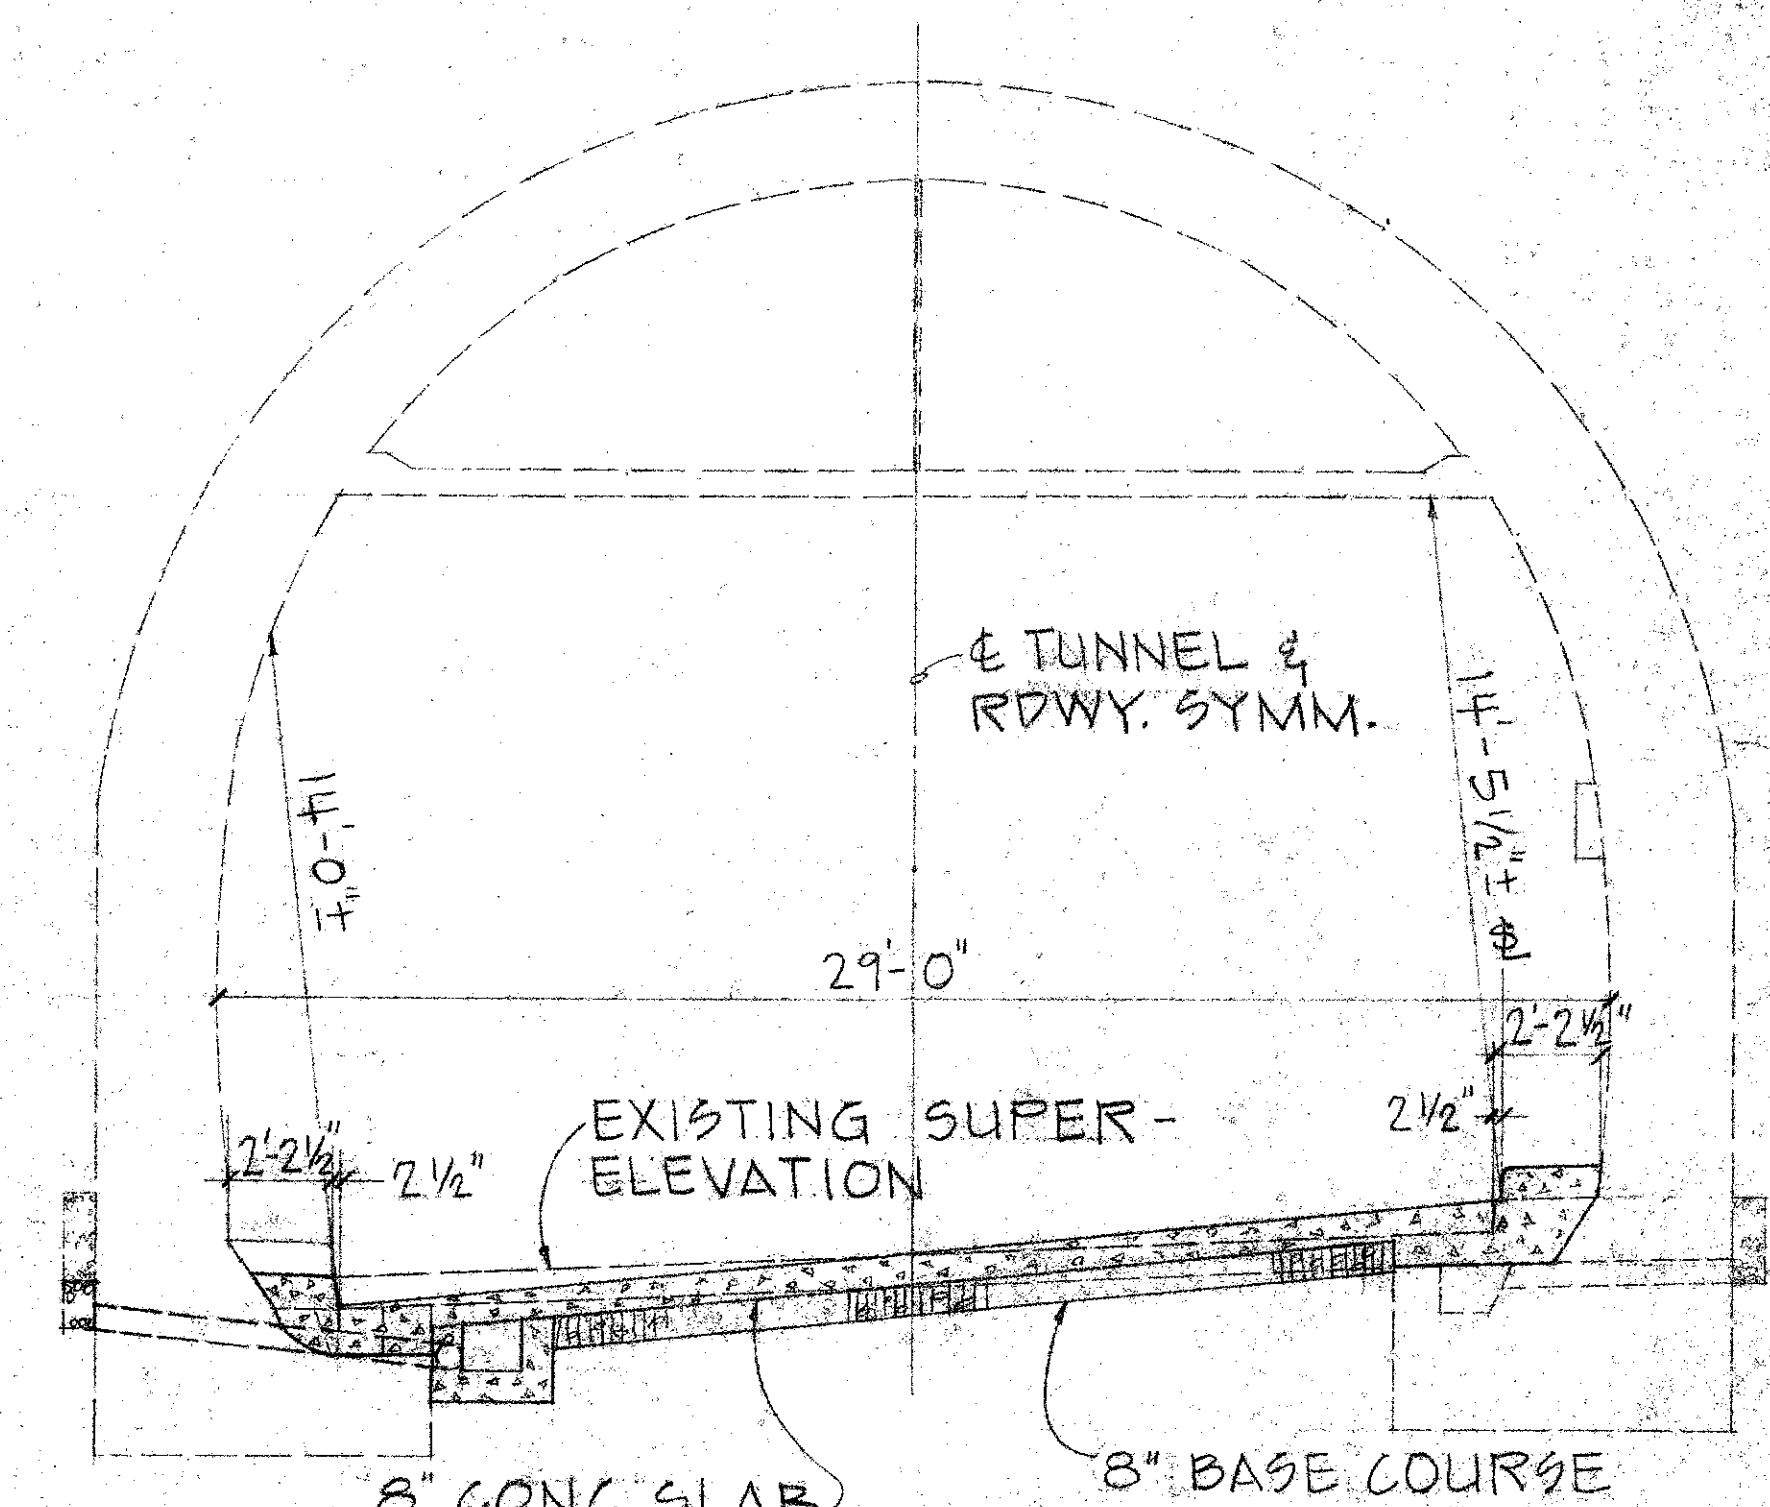


SECTION C
O.B. STA. 37+07.45

TUNNEL SECTIONS SC: 1/4" = 1'-0"

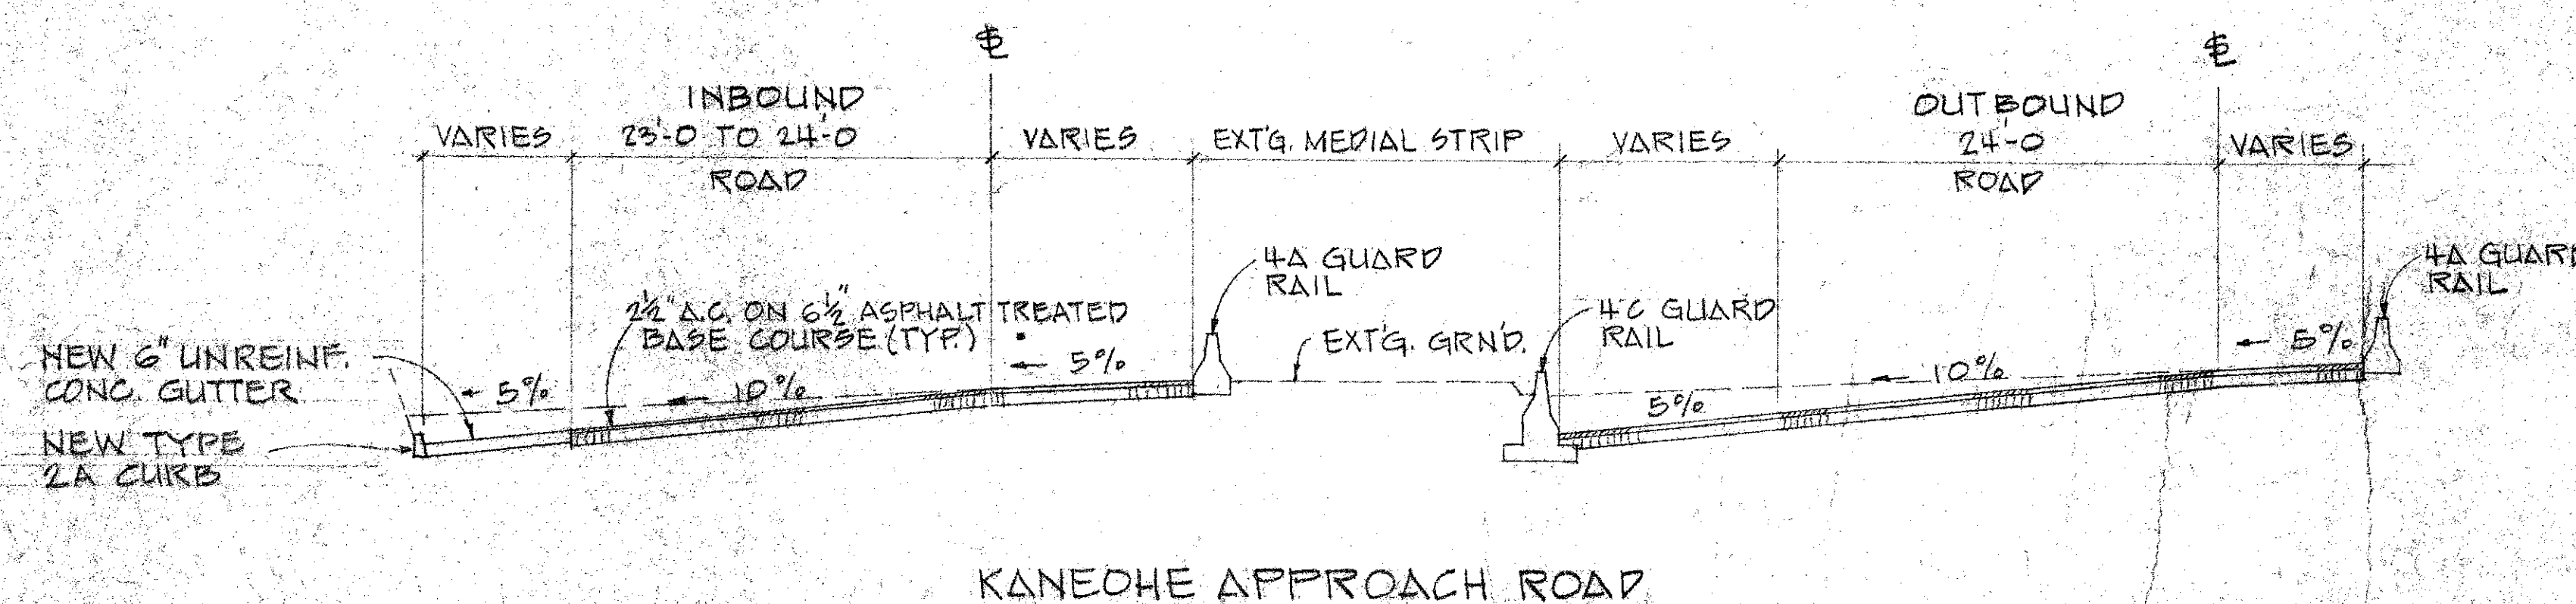

TYPICAL ROAD SECTION SC: 1/8" = 1'-0"

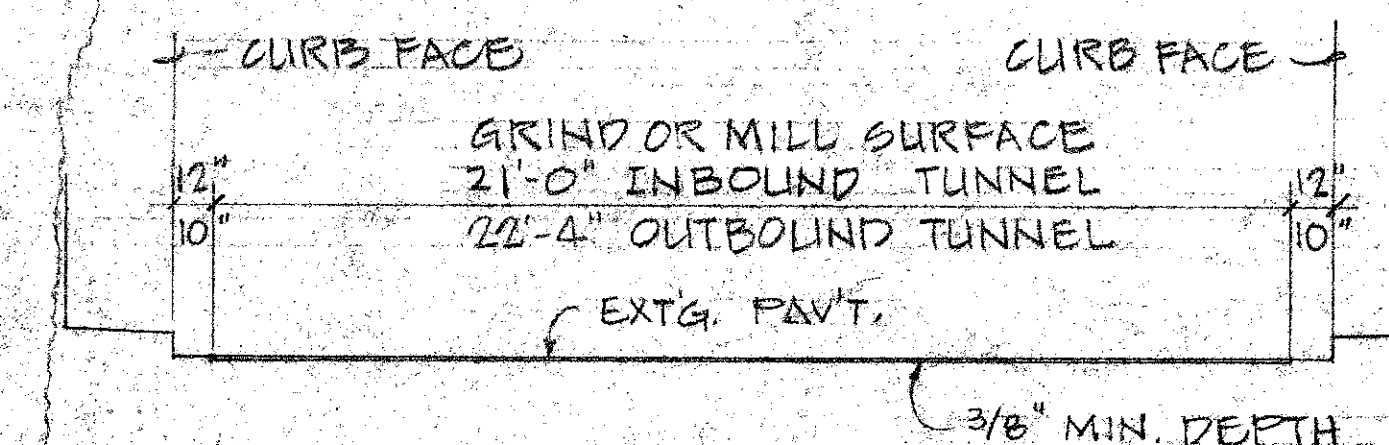

SECTION OF EXISTING TUNNEL PAVEMENT TO BE TREATED FOR SKID RESISTANCE NOT TO SCALE

I.B. STA. 9+44.38 TO STA. 33+17.84
O.B. STA. 10+03.14 TO STA. 33+63.59

PROJECT NO. HES-063-1(12)

NO.	DATE	DESCRIPTION	ENGR.	DEPT. OR DIV.
REVISIONS				
APPROVED				
DEPARTMENT OF PUBLIC WORKS				
CITY AND COUNTY OF HONOLULU				
DIVISION OF ENGINEERING				
WILSON TUNNEL SAFETY IMPROVEMENTS				
KOOLOA, OAHU, HAWAII				
TYPICAL SECTIONS				
ENGINEER	J.W. H.	DATE	9/25/80	
DRAFTER	A.K.	CHECKED BY	D.T.	
APPROVED				
10/6/80				
P.E.				

JOB NO. 28-80