





REV. DEC. 1944
REV. SEPT. 1944

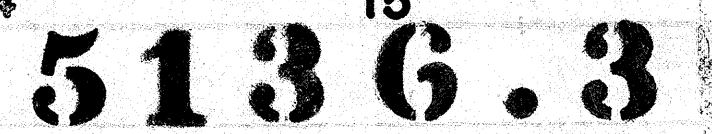

REV. DEC. 1944
REV. SEPT. 1944
REV. FEB. 1945

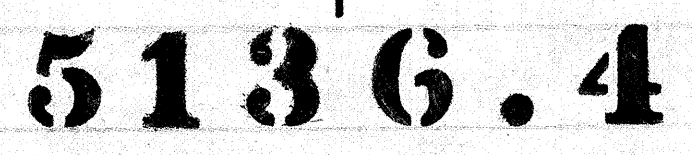

FED. ROAD DIST. NO.	STATE	FED. AID PROJ. NO.	FISCAL YEAR	SHEET NO.	TOTAL SHEETS
HAWAII	HAW	DAWR.50	1944	6	13

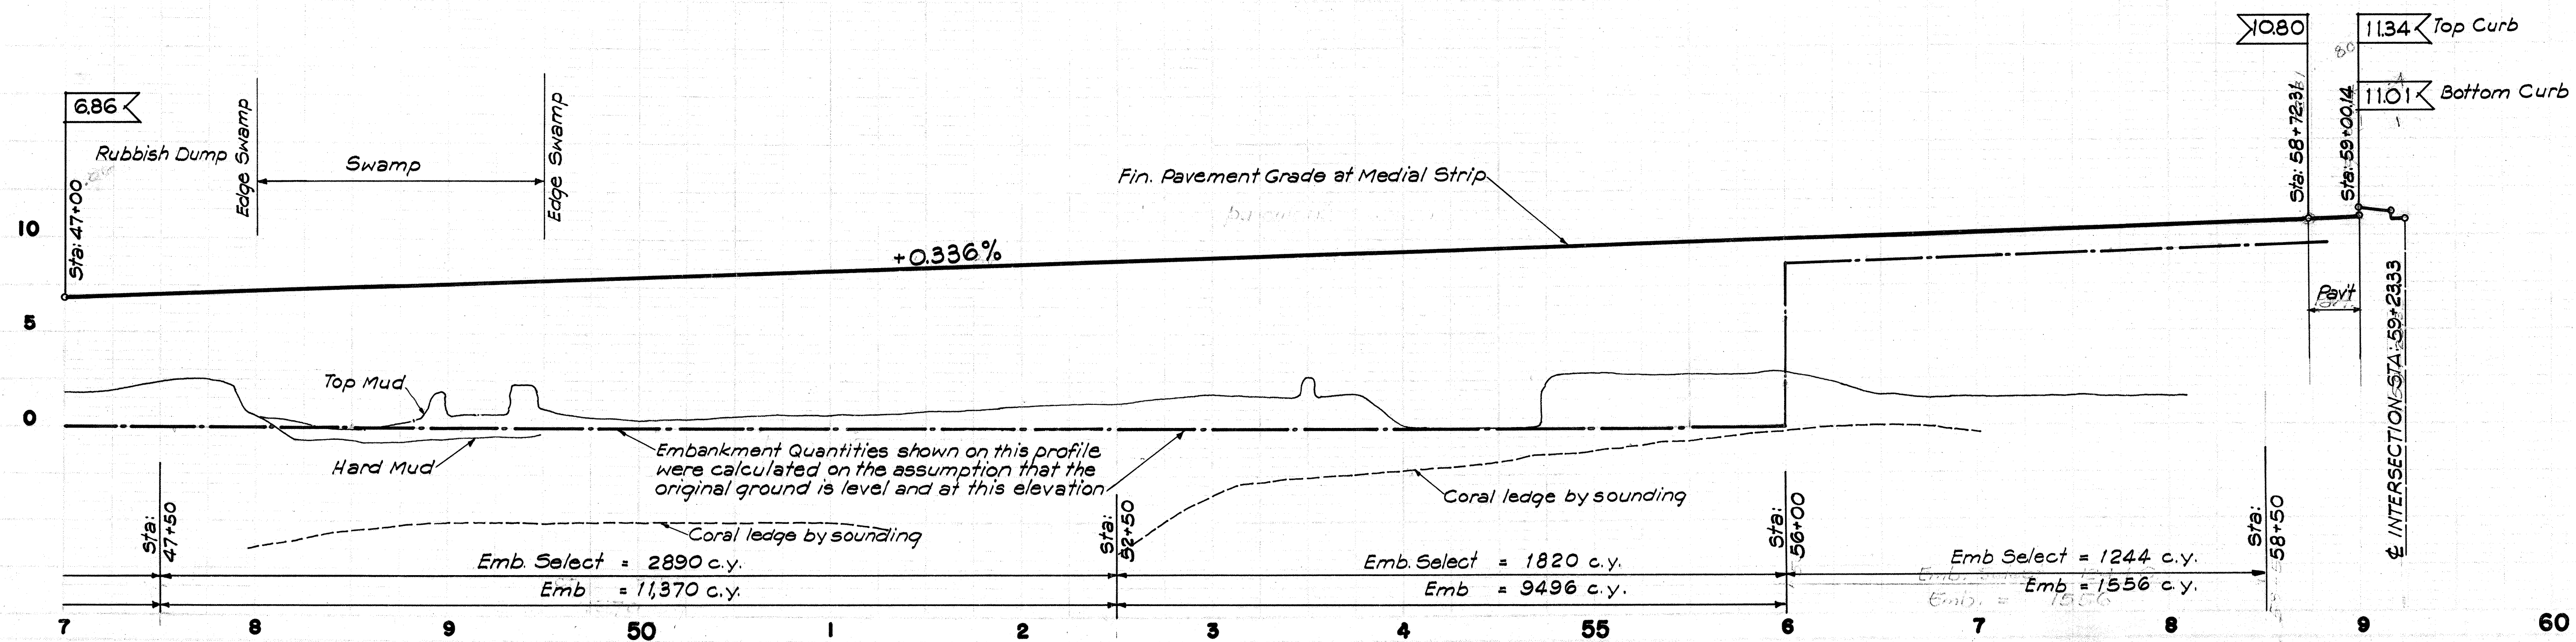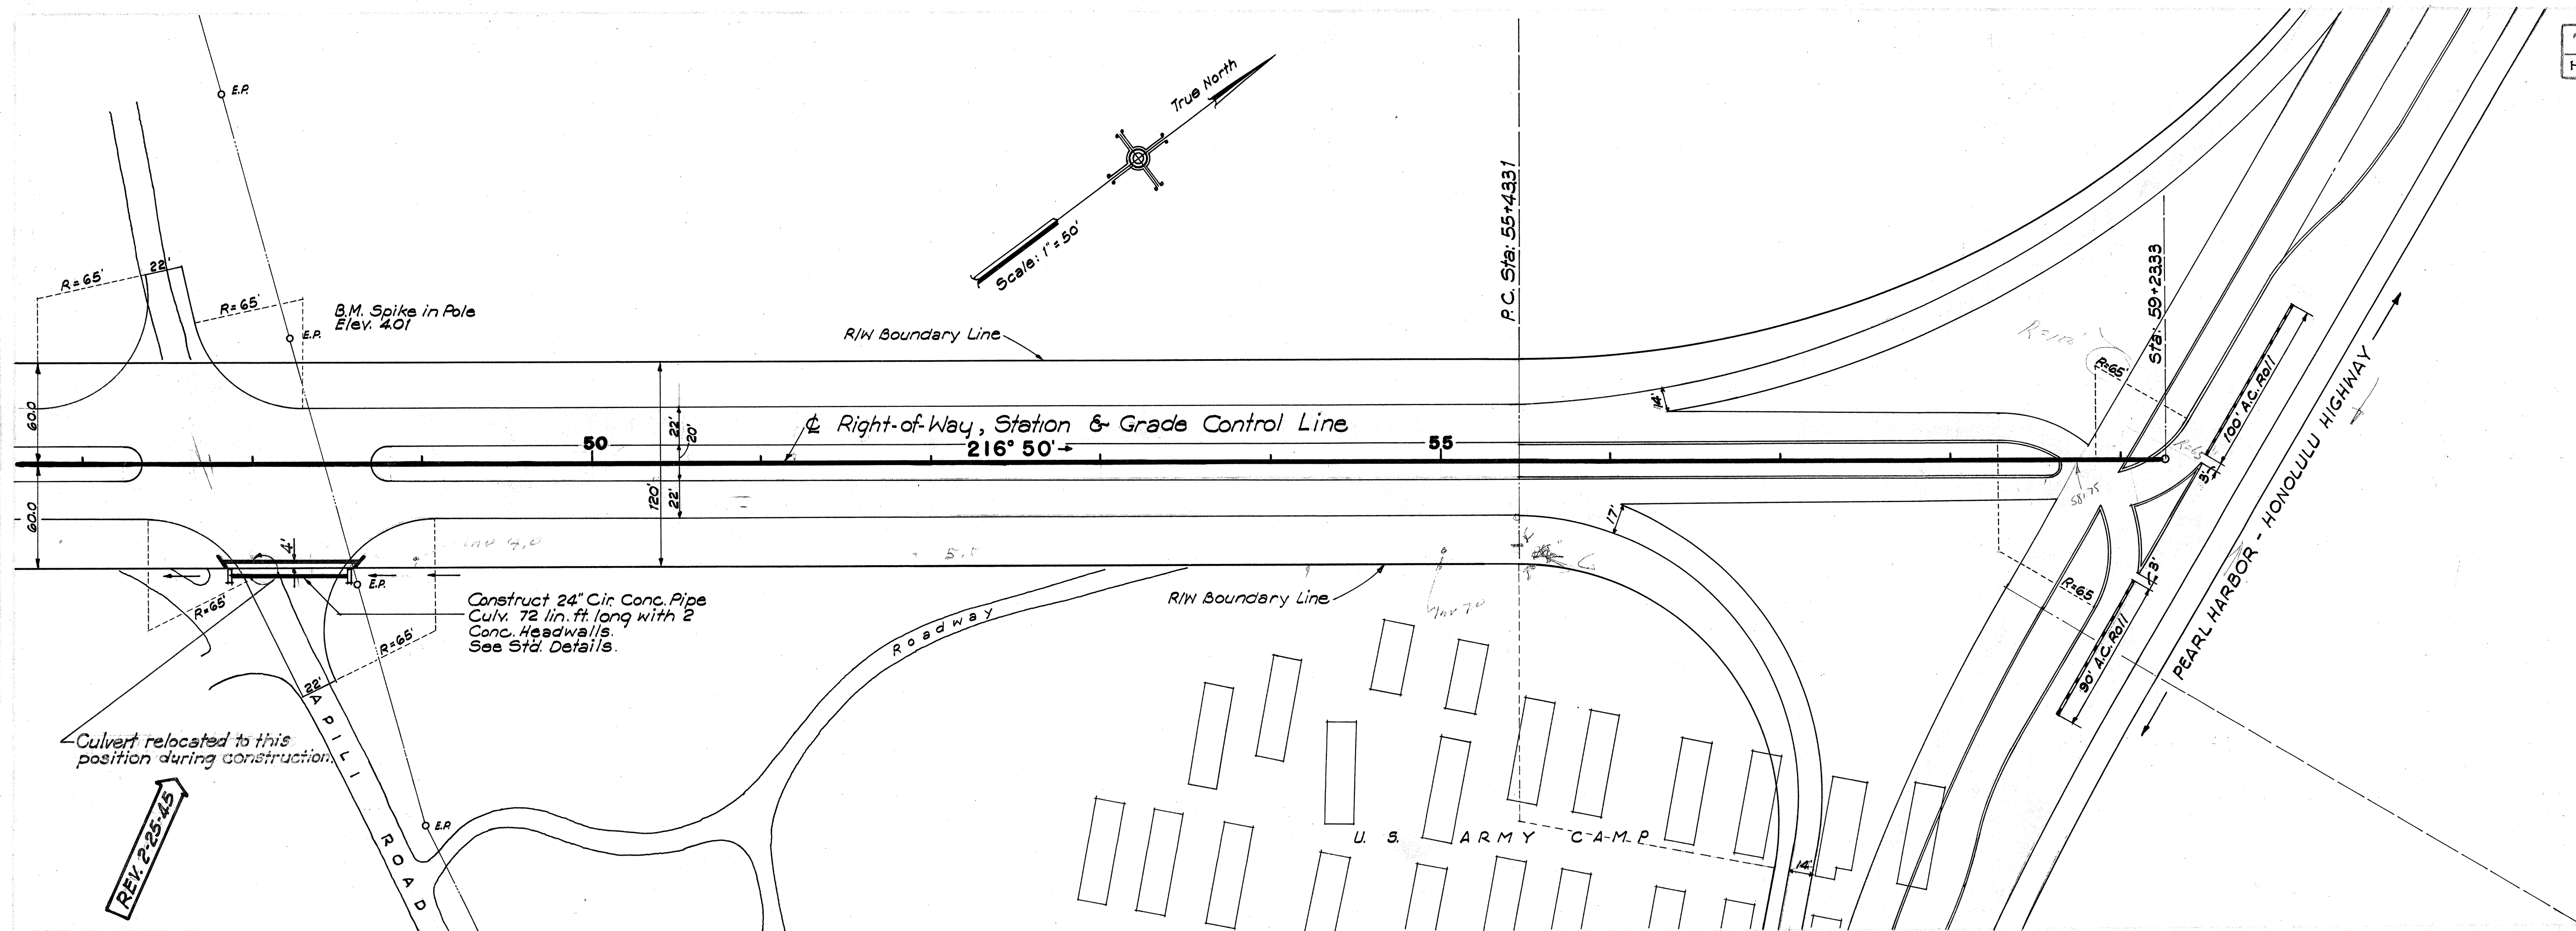

5136.6

10
5
0

60



1

2

3

REV. FEB. 1945

REV. FEB. 1945
REV. DEC. 1944
REV. OCT. 1944

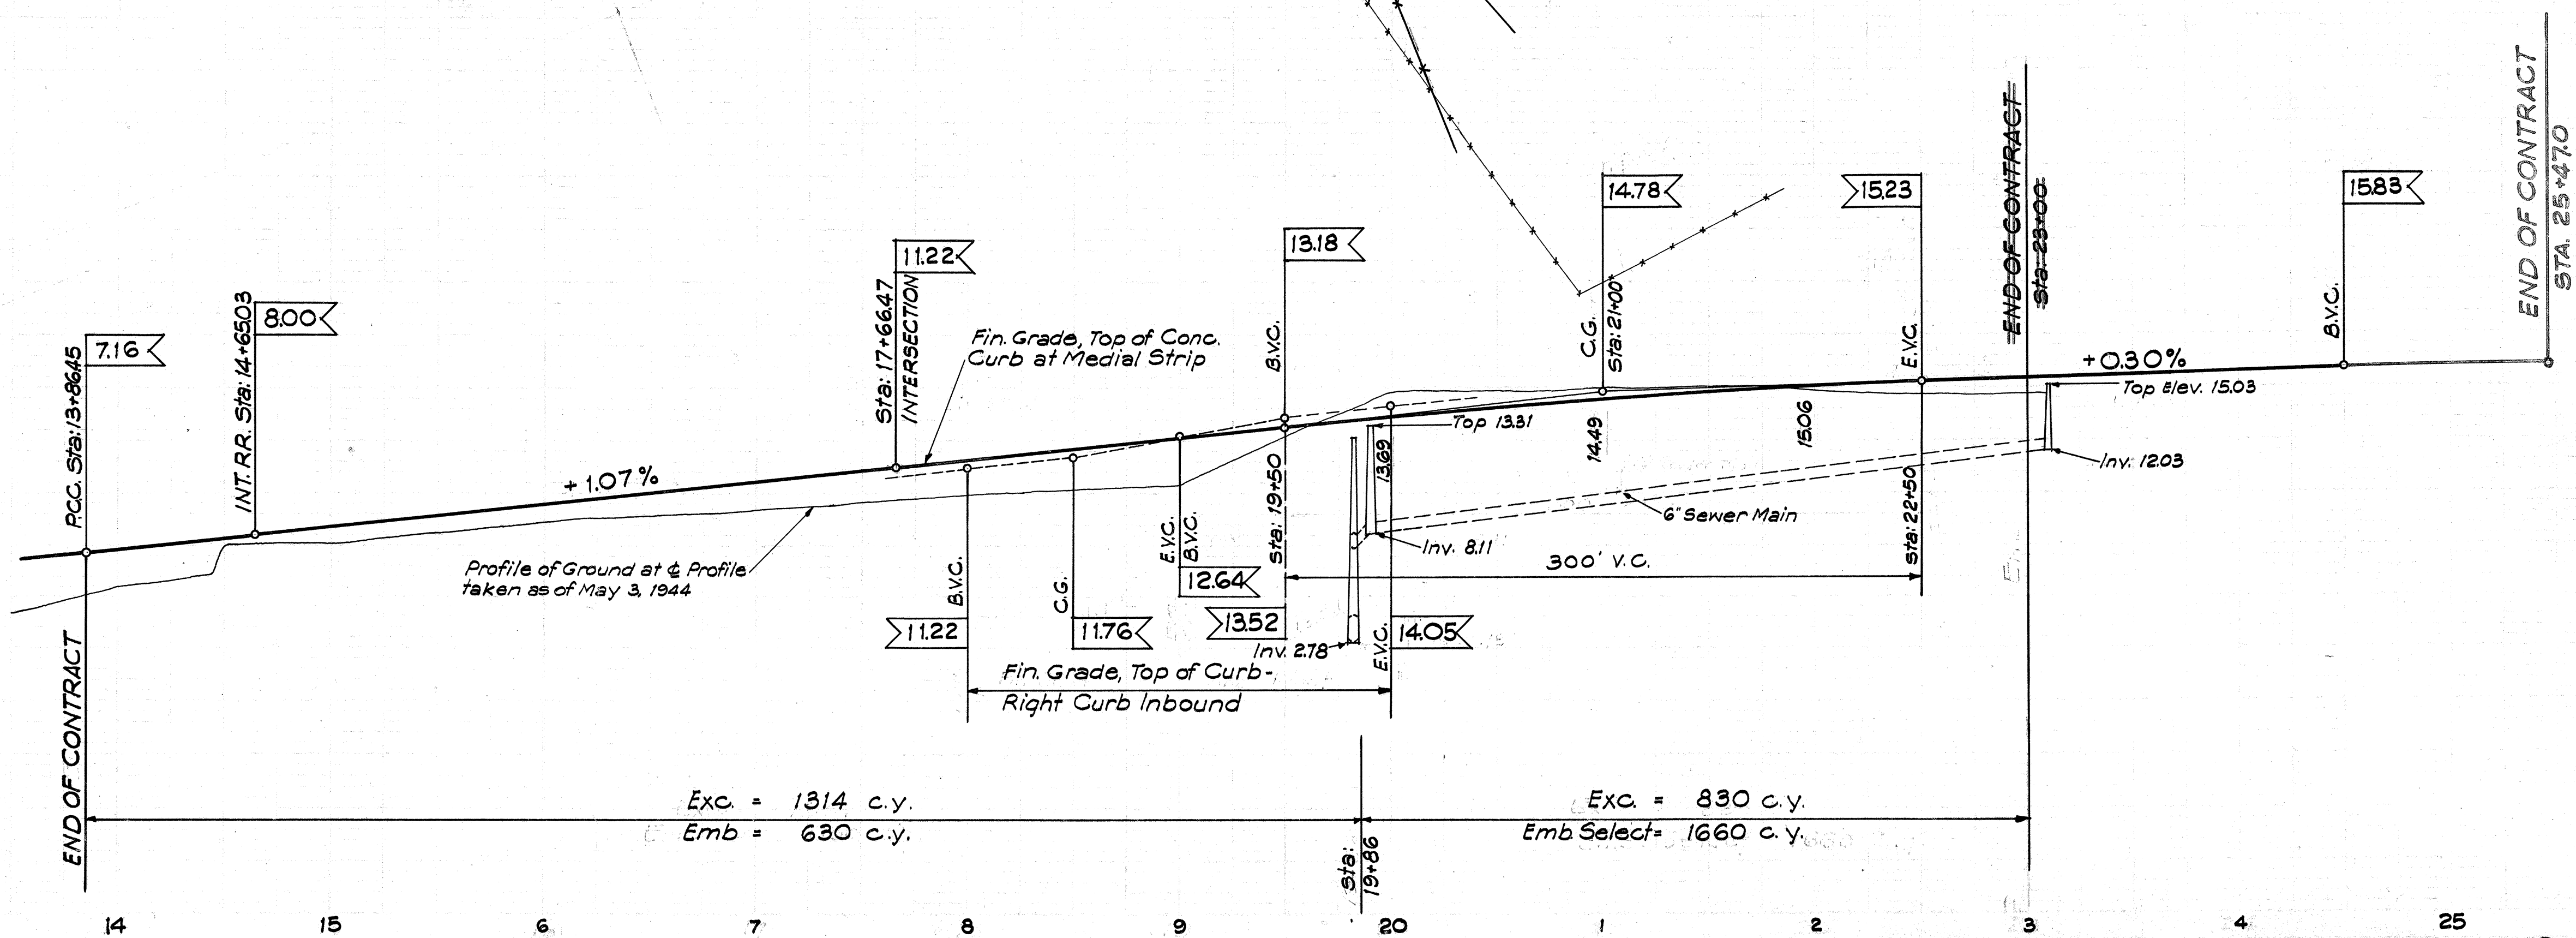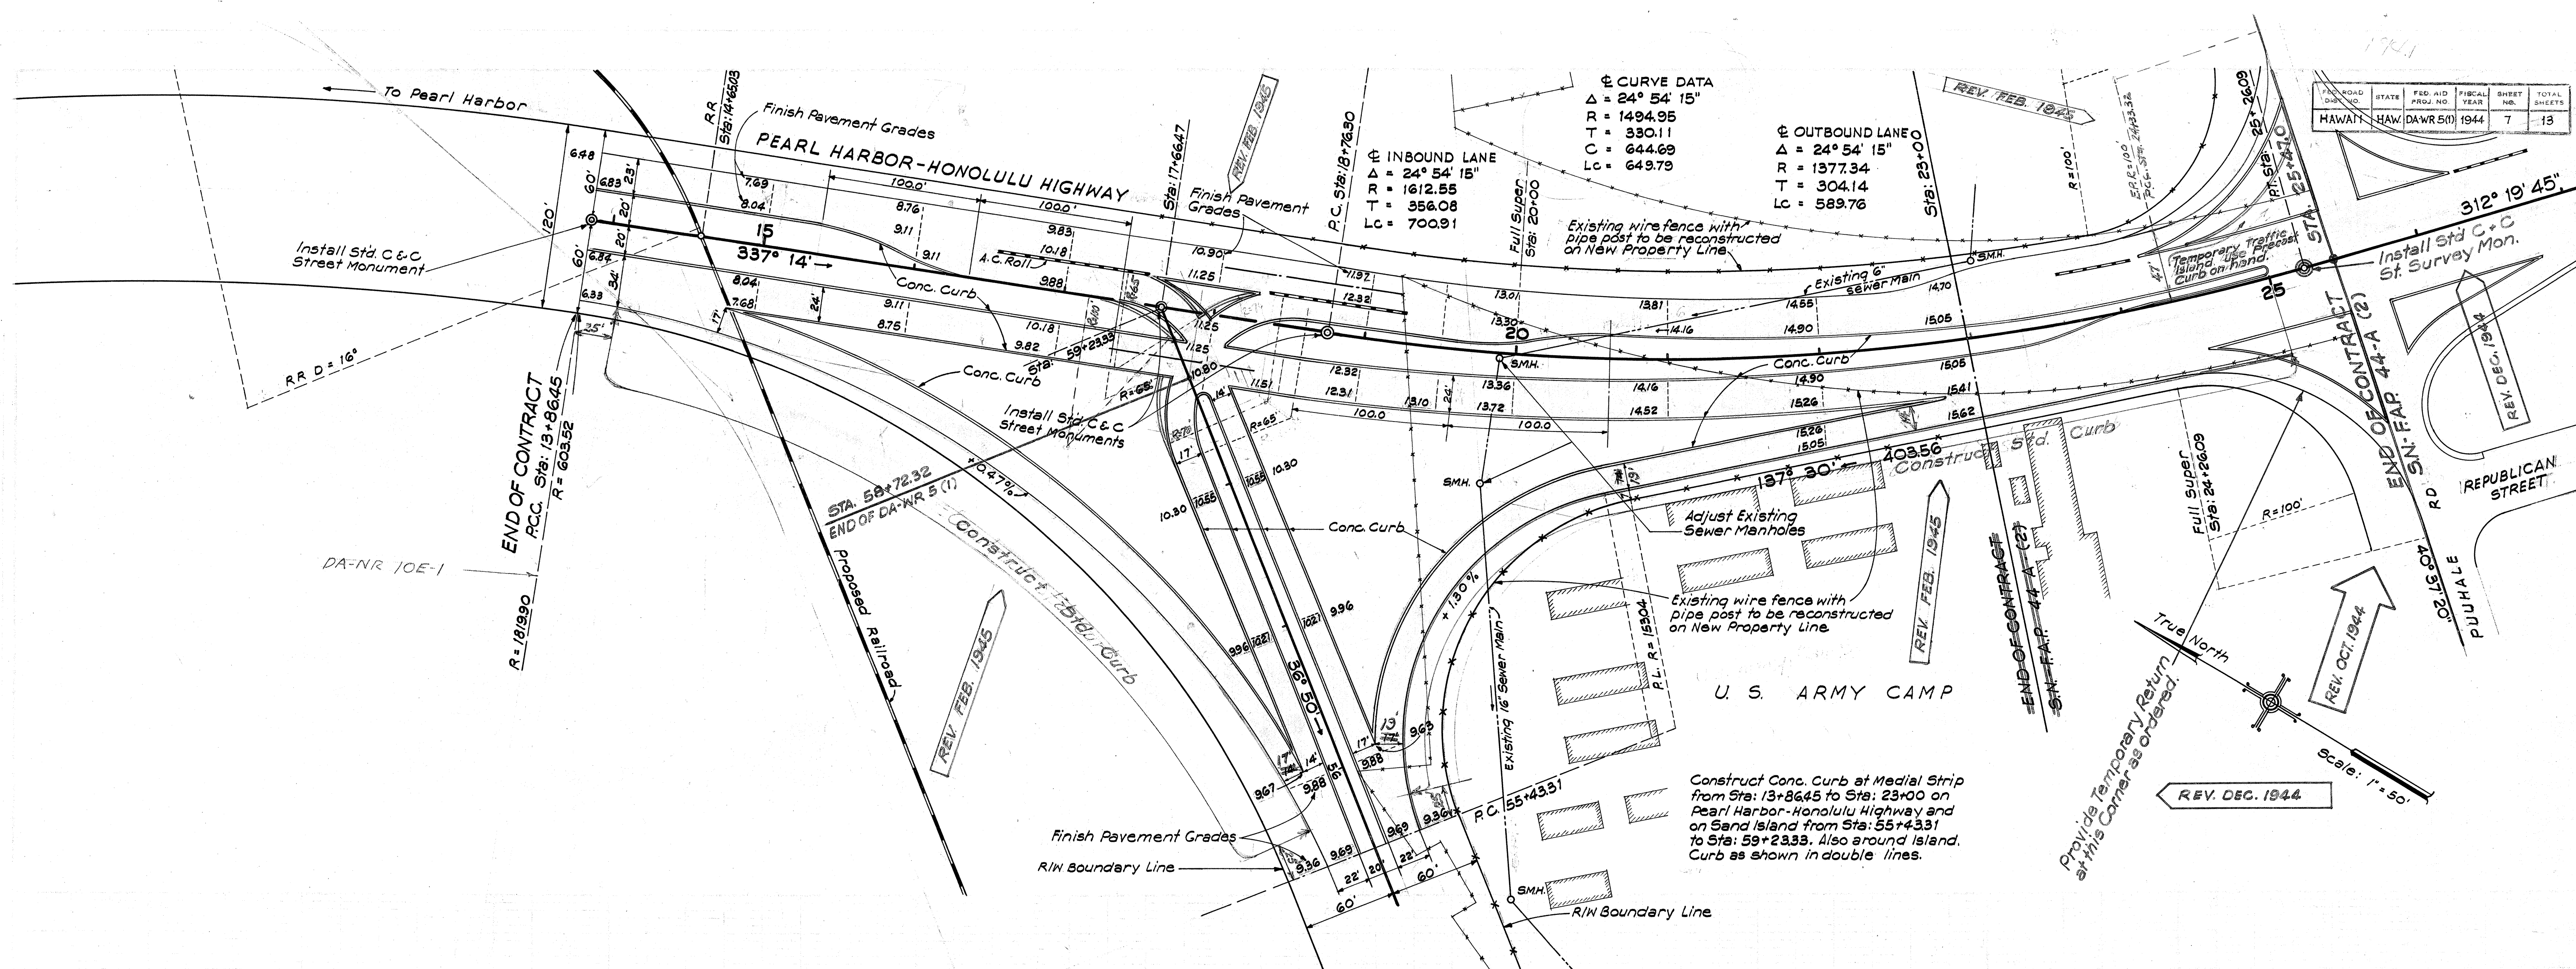

5136.7