




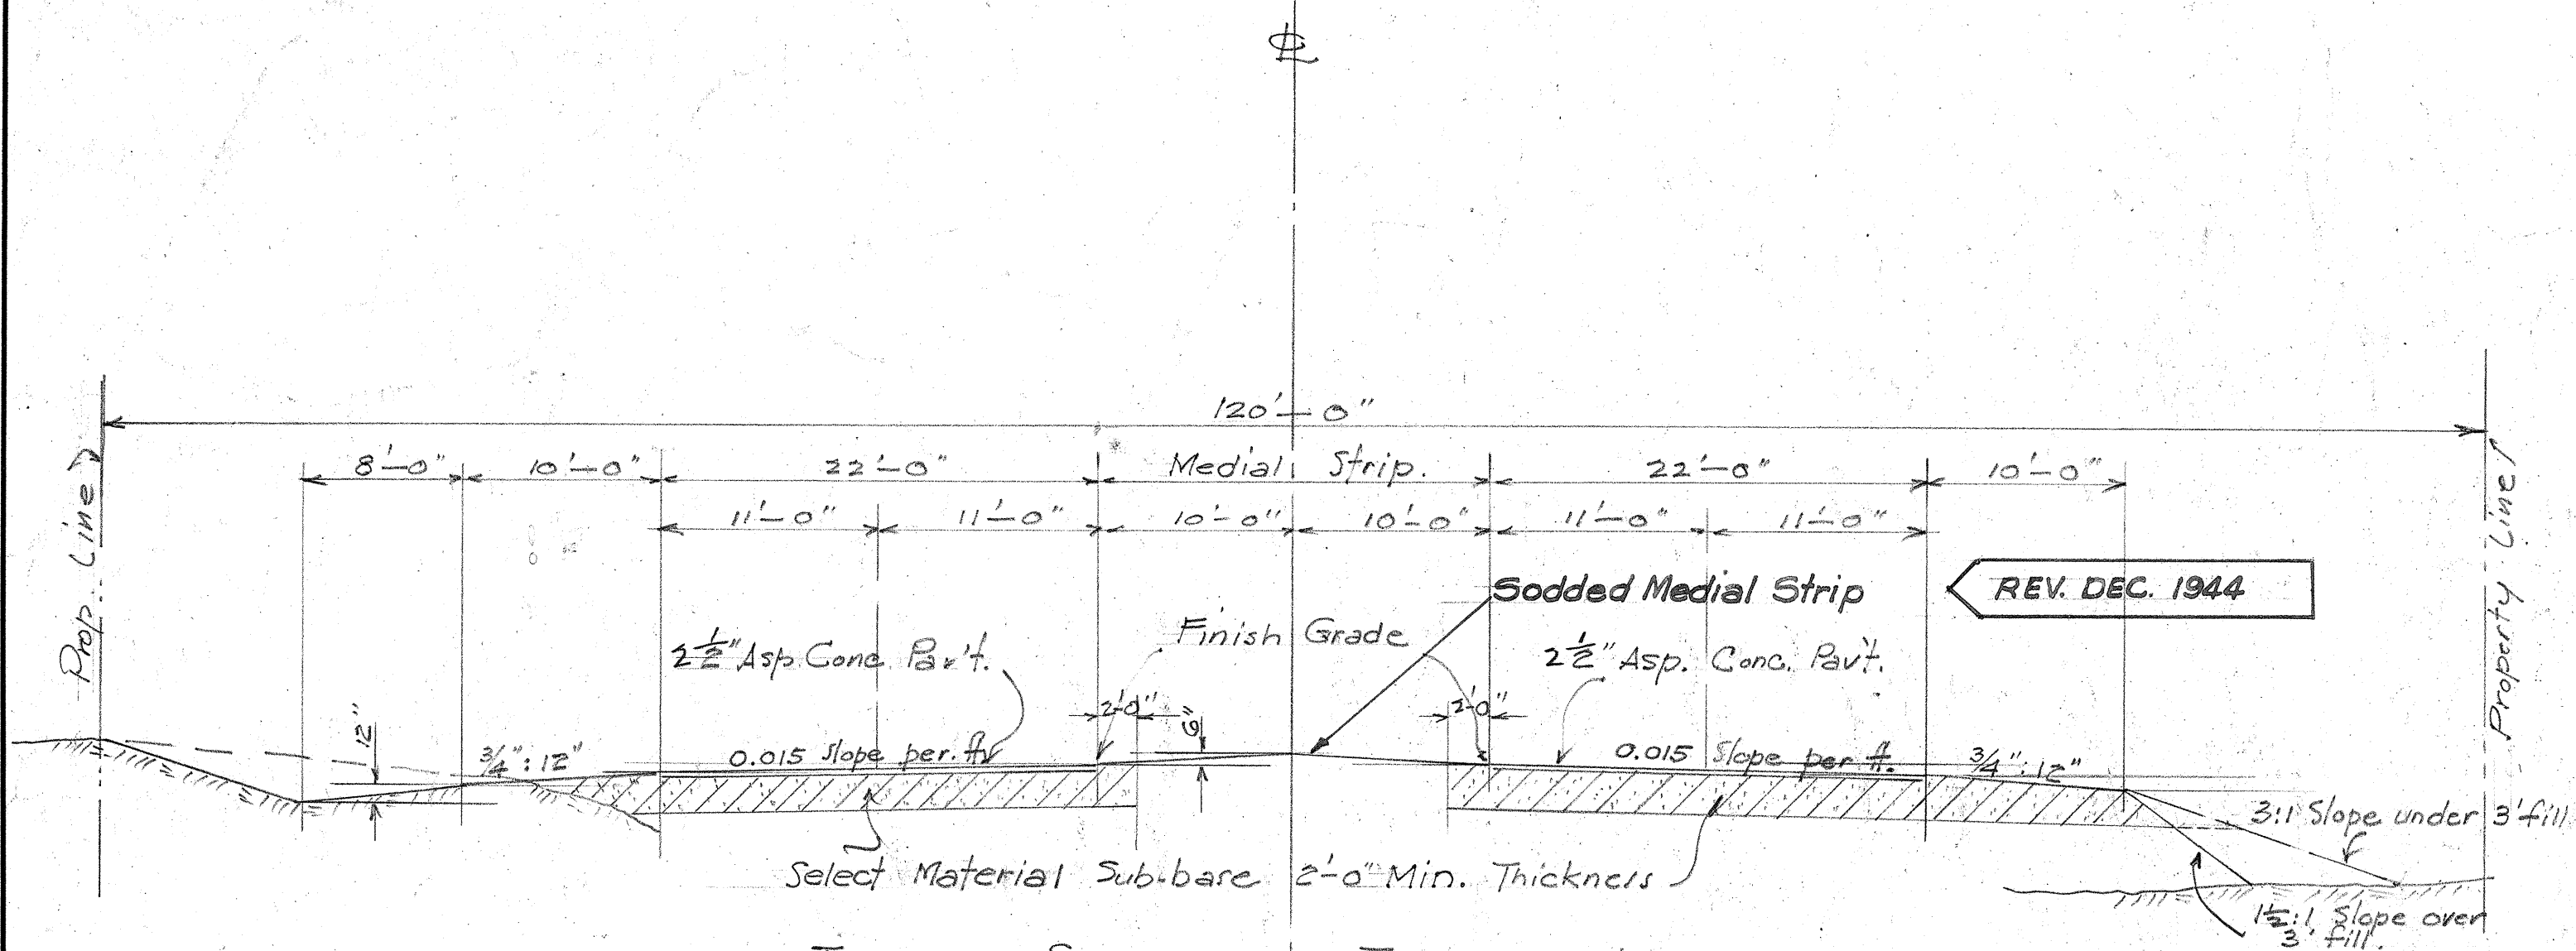


TYPICAL SECTION AT TANGENT  
STA. 24+50 TO 55+43.31

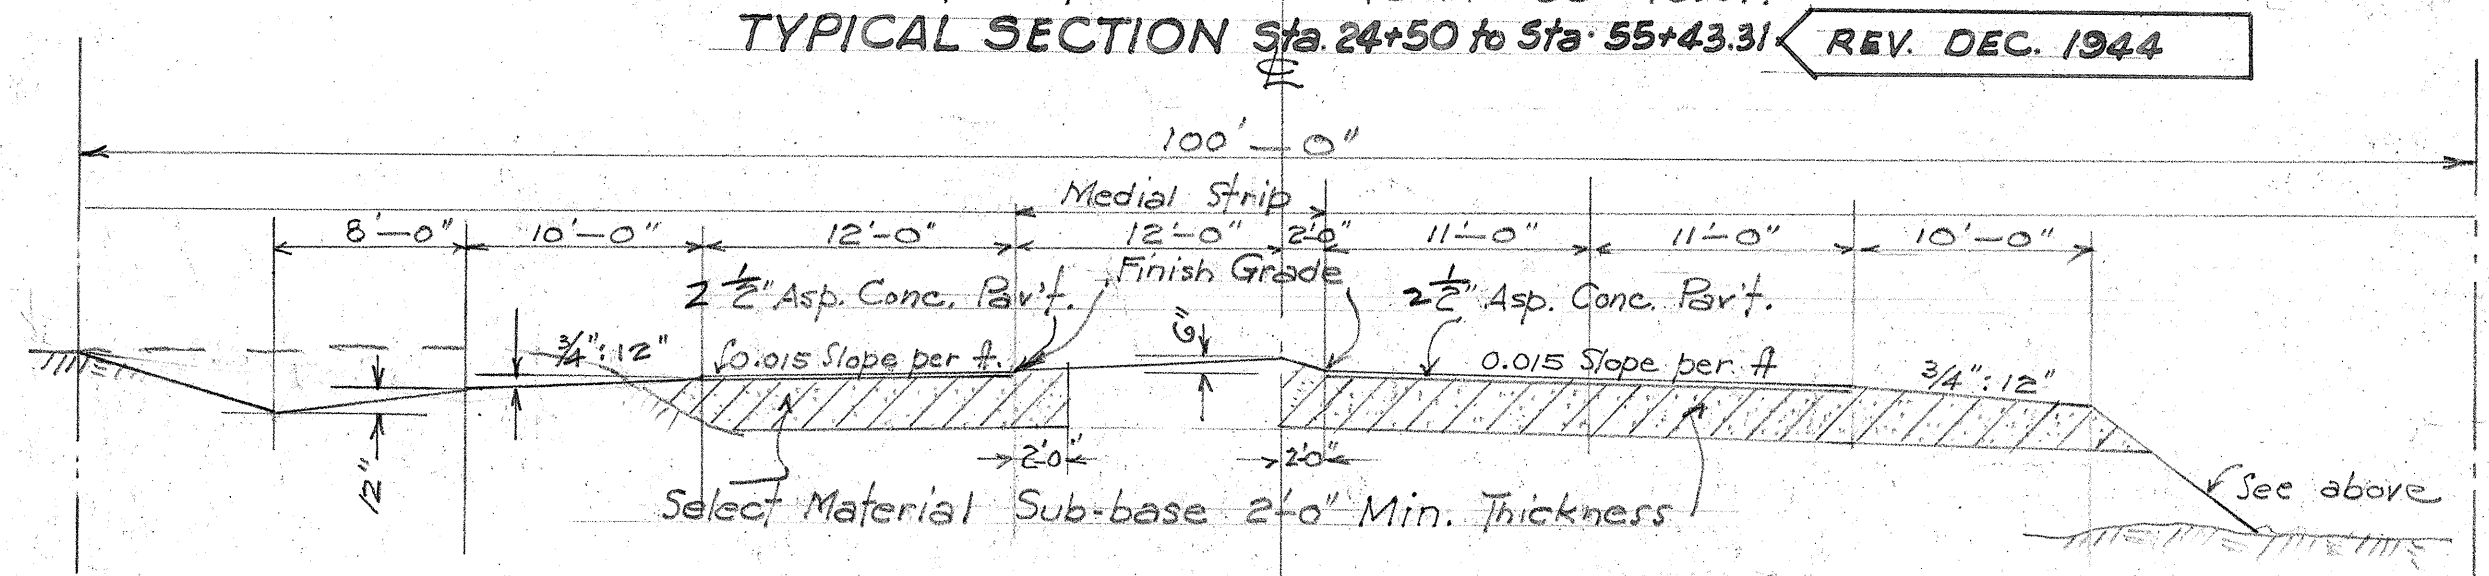


TYPICAL SECTION STA. 20+00 TO 25+00. VOID

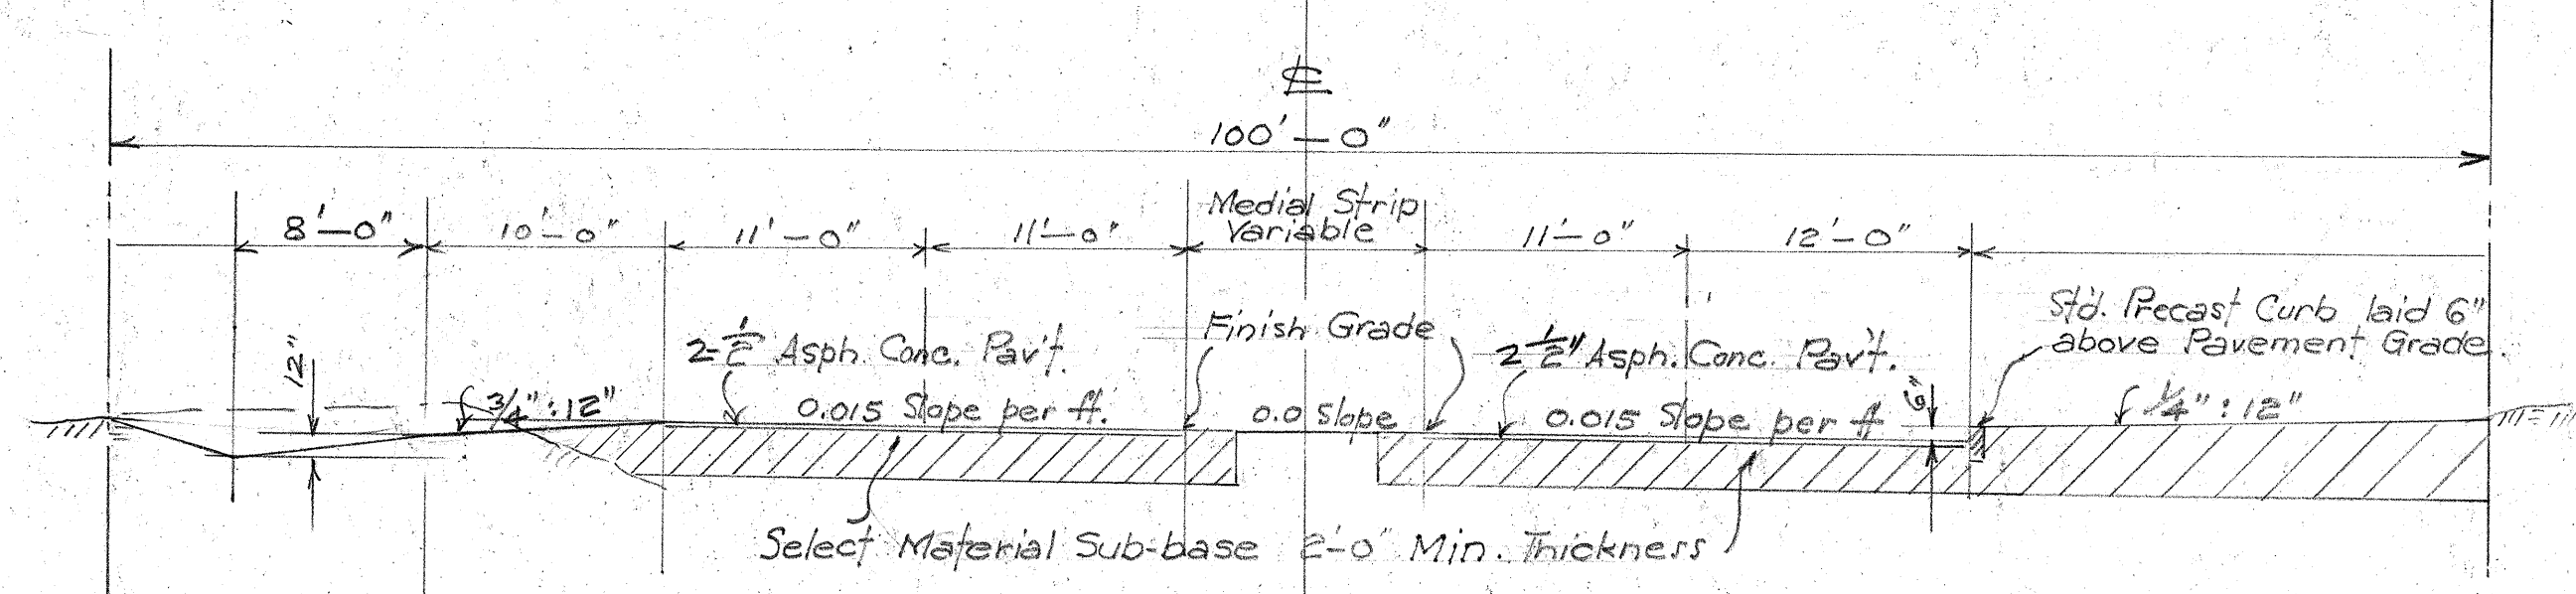





SECTION AT CURVE  
STA. 26+25.51 TO 32+00. VOID

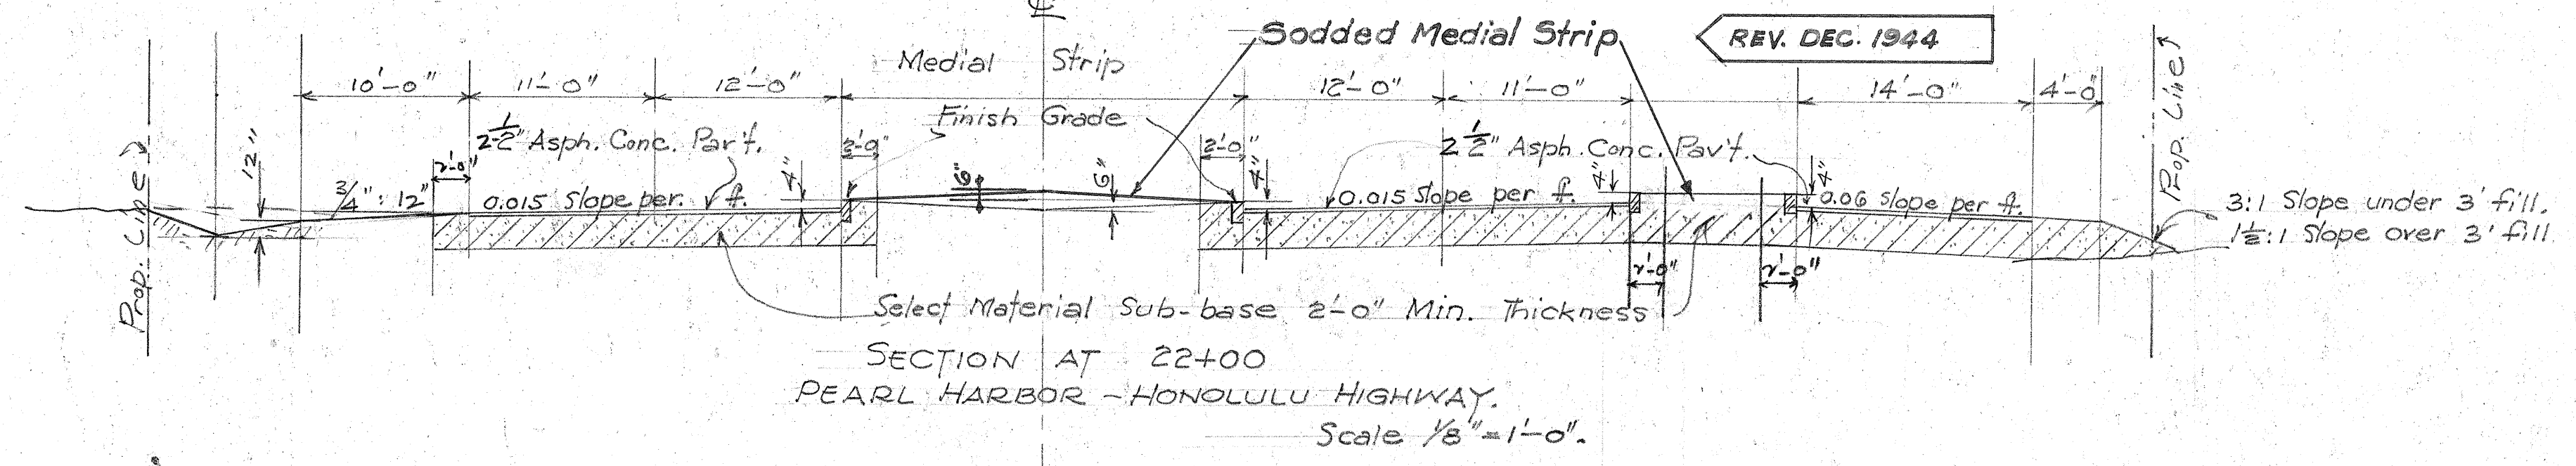

SECTION AT 22+00  
PEARL HARBOR - HONOLULU HIGHWAY.  
Scale 1/8" = 1'-0".

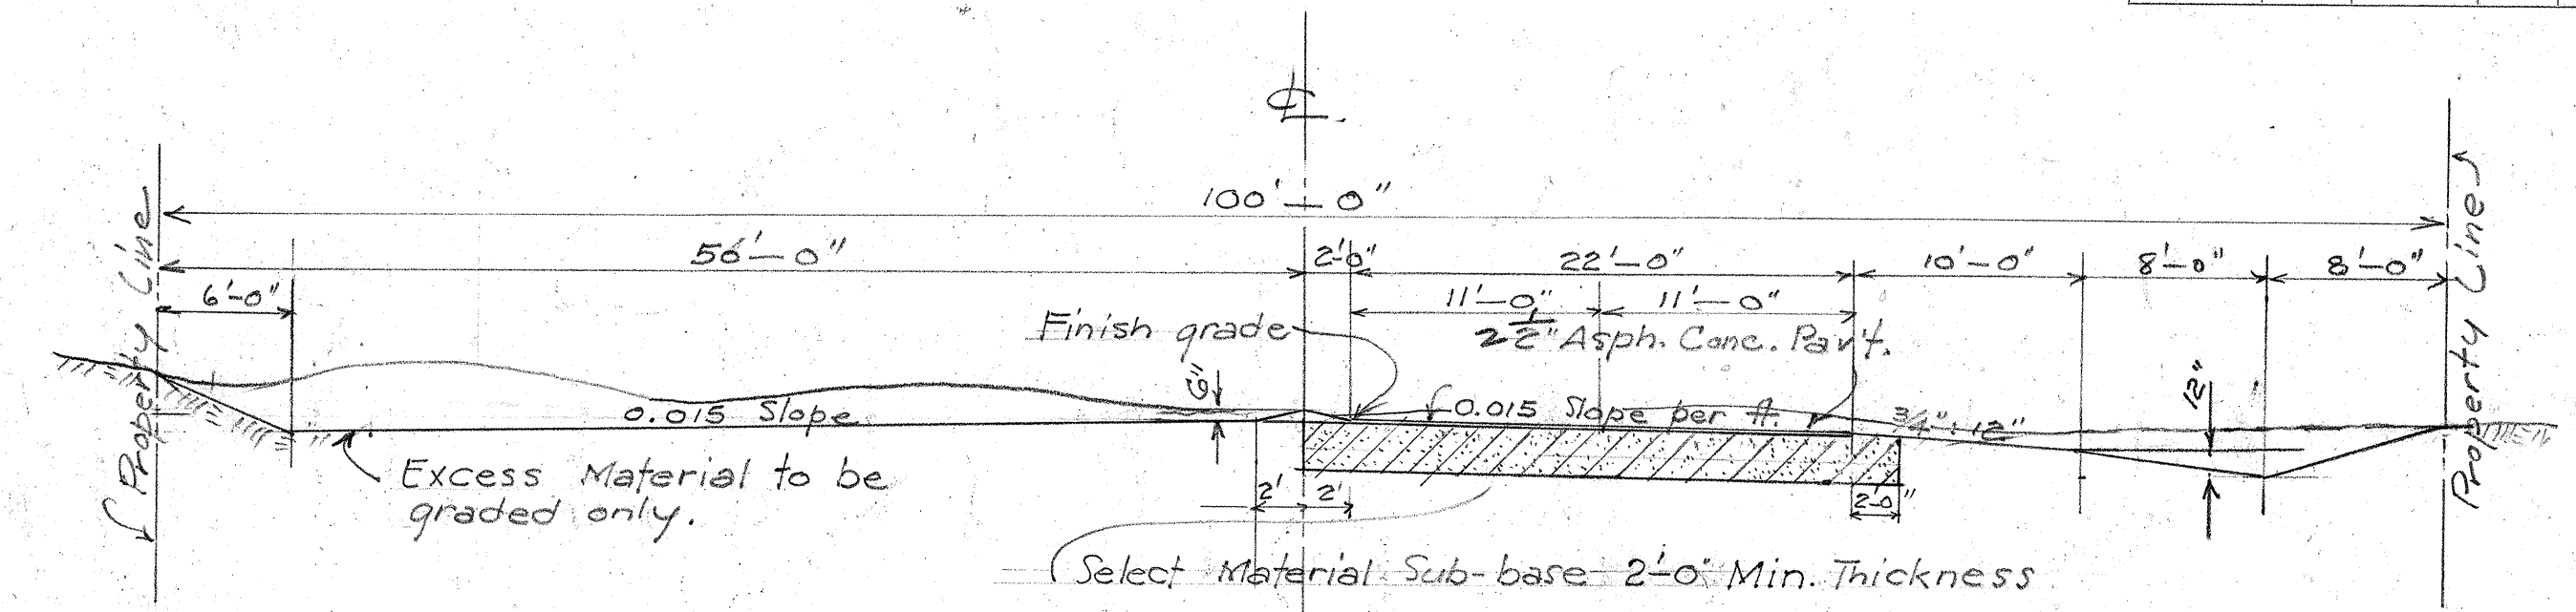

TYPICAL SECTION STA. 2+50 TO 16+50. VOID  
Scale 1/8" = 1'-0".

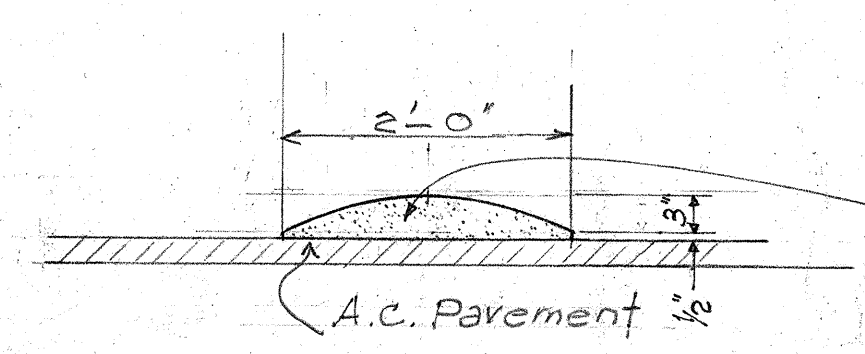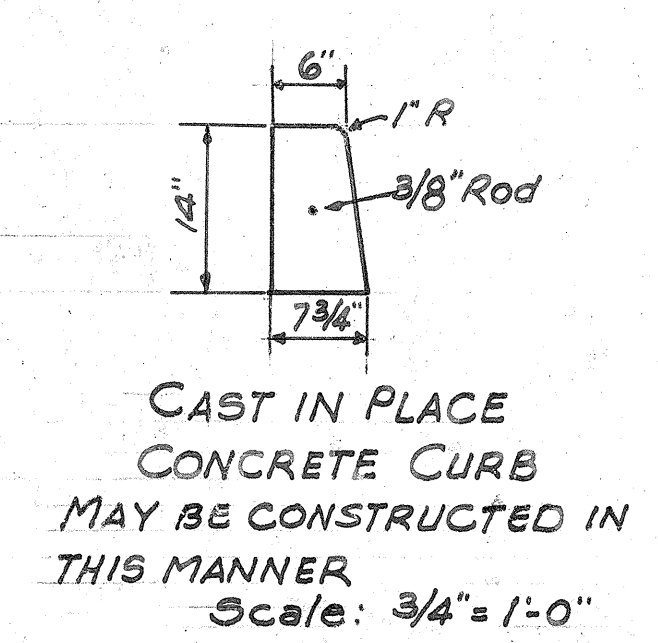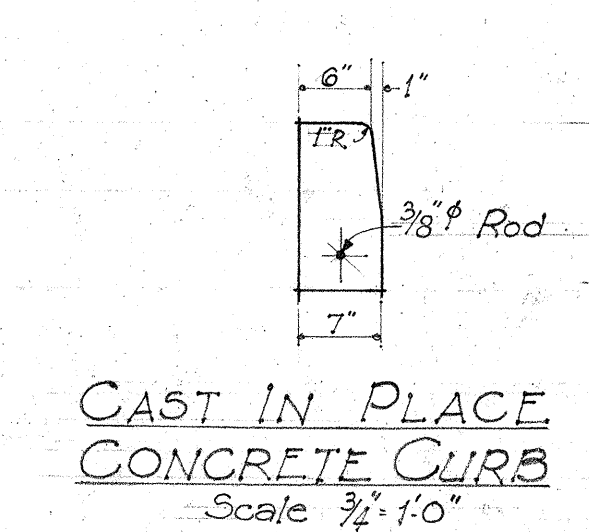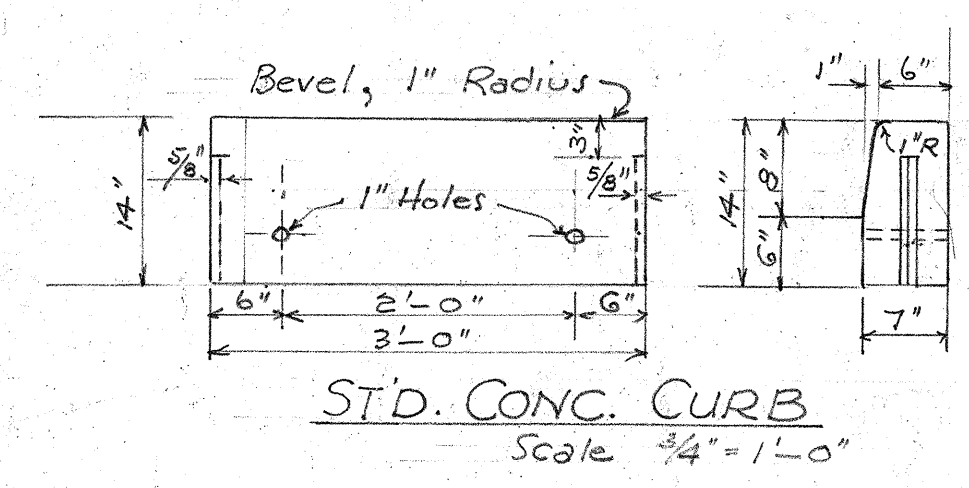

DETAIL OF A.C. ROLL

NOTE!  
If wanted, the Territory will loan the Contractor a spreader box which spreads loose material to the desired Section.

REV. DEC. 1944

REV. DEC. 1944

ORIGINAL PLAN  
DESIGNED BY  
TRACED BY  
QUANTITIES BY  
CHECKED BY