
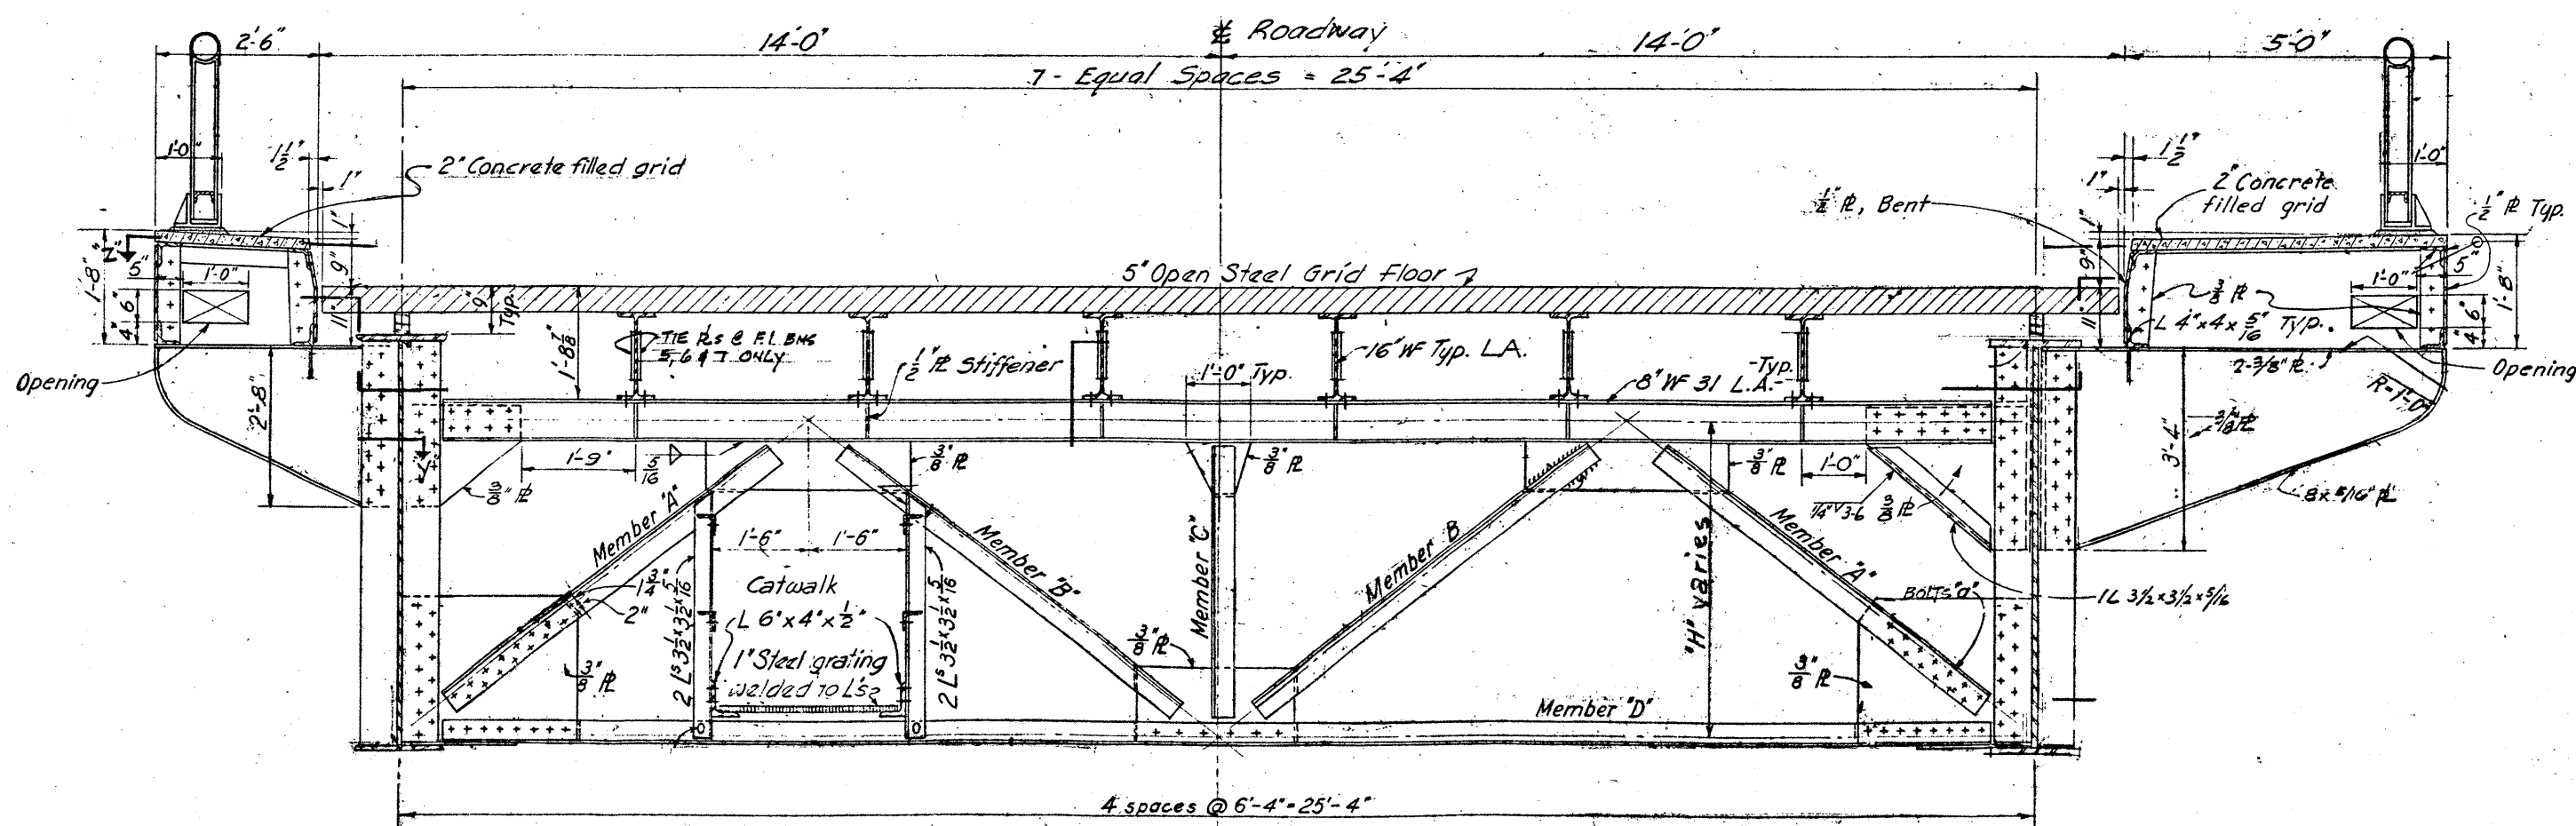
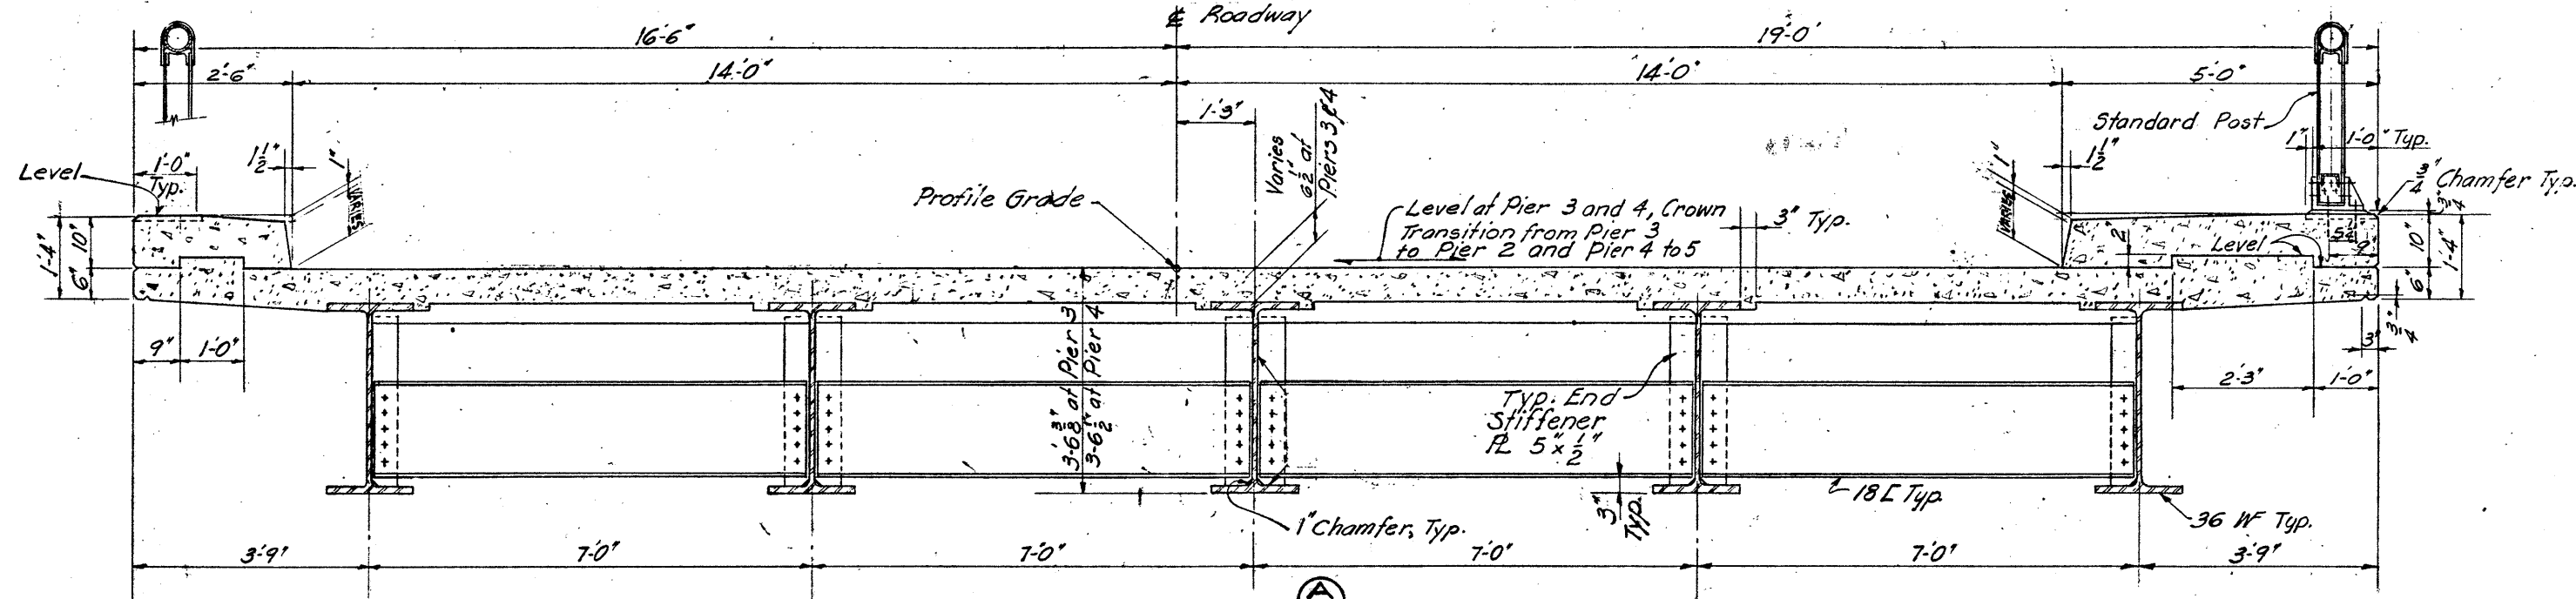
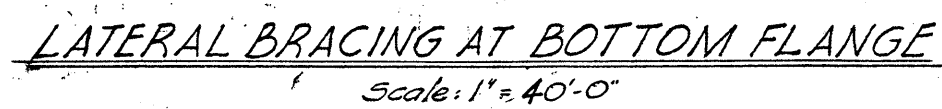


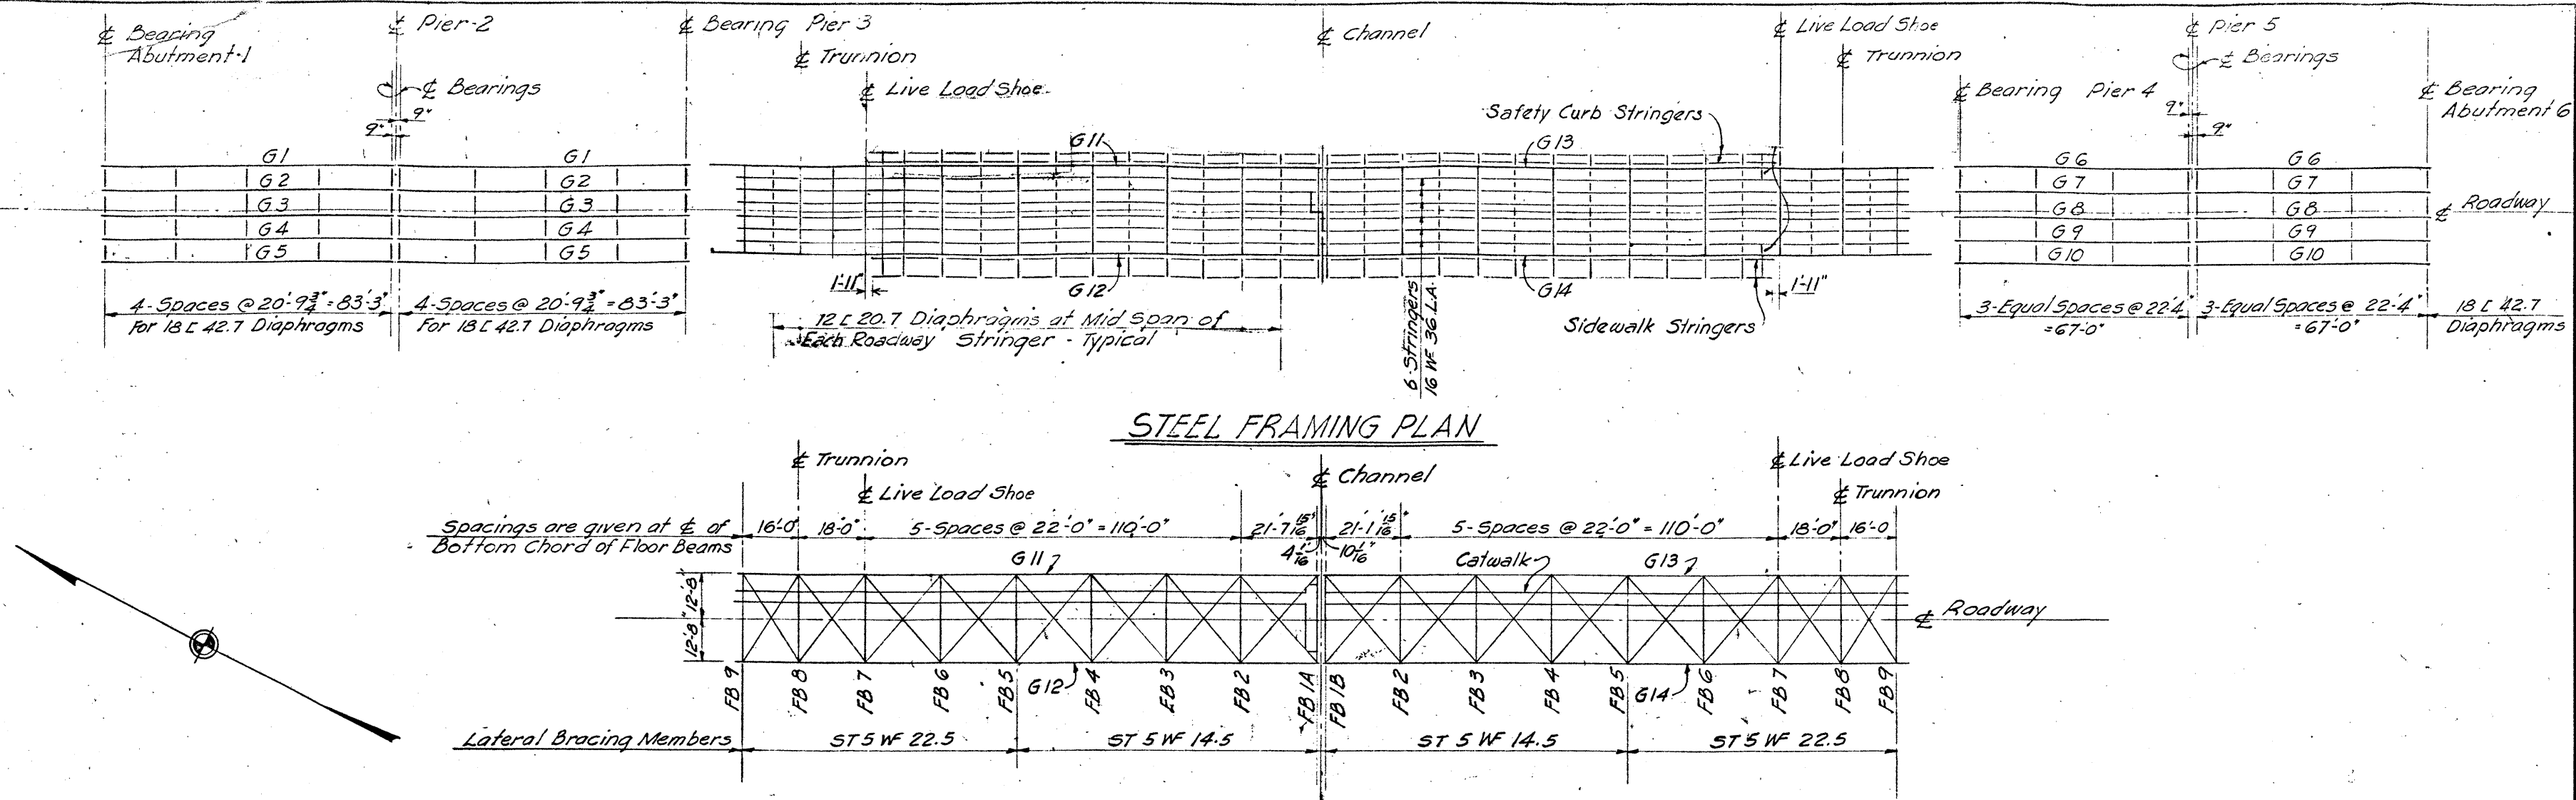

DESIGNED BY:	SUBMITTED BY:	APPROVED BY:	JOB TITLE	SHEET TITLE	JOB NUMBER	SHEET
DRAWN BY:	<i>Richard H. Esaki</i>	<i>Melvin J. Lepore</i>	STATE OF HAWAII	BRIDGE		2
CHECKED BY: <i>FE</i>	RECOMMENDED BY:	CHIEF, HARBOR DIVISION	DEPARTMENT OF TRANSPORTATION	PAINTING BASCULE BRIDGE	H.C. 1480	
DATE MAR. 1969	APPROVED BY:		HARBORS DIVISION	HONOLULU, HAWAII		OF 2 SHEETS
SCALE AS NOTED	<i>James C. Shaw</i>	DIRECTOR OF TRANSPORTATION				
REVISION NO.	DESCRIPTION	BY	DATE	APD		