




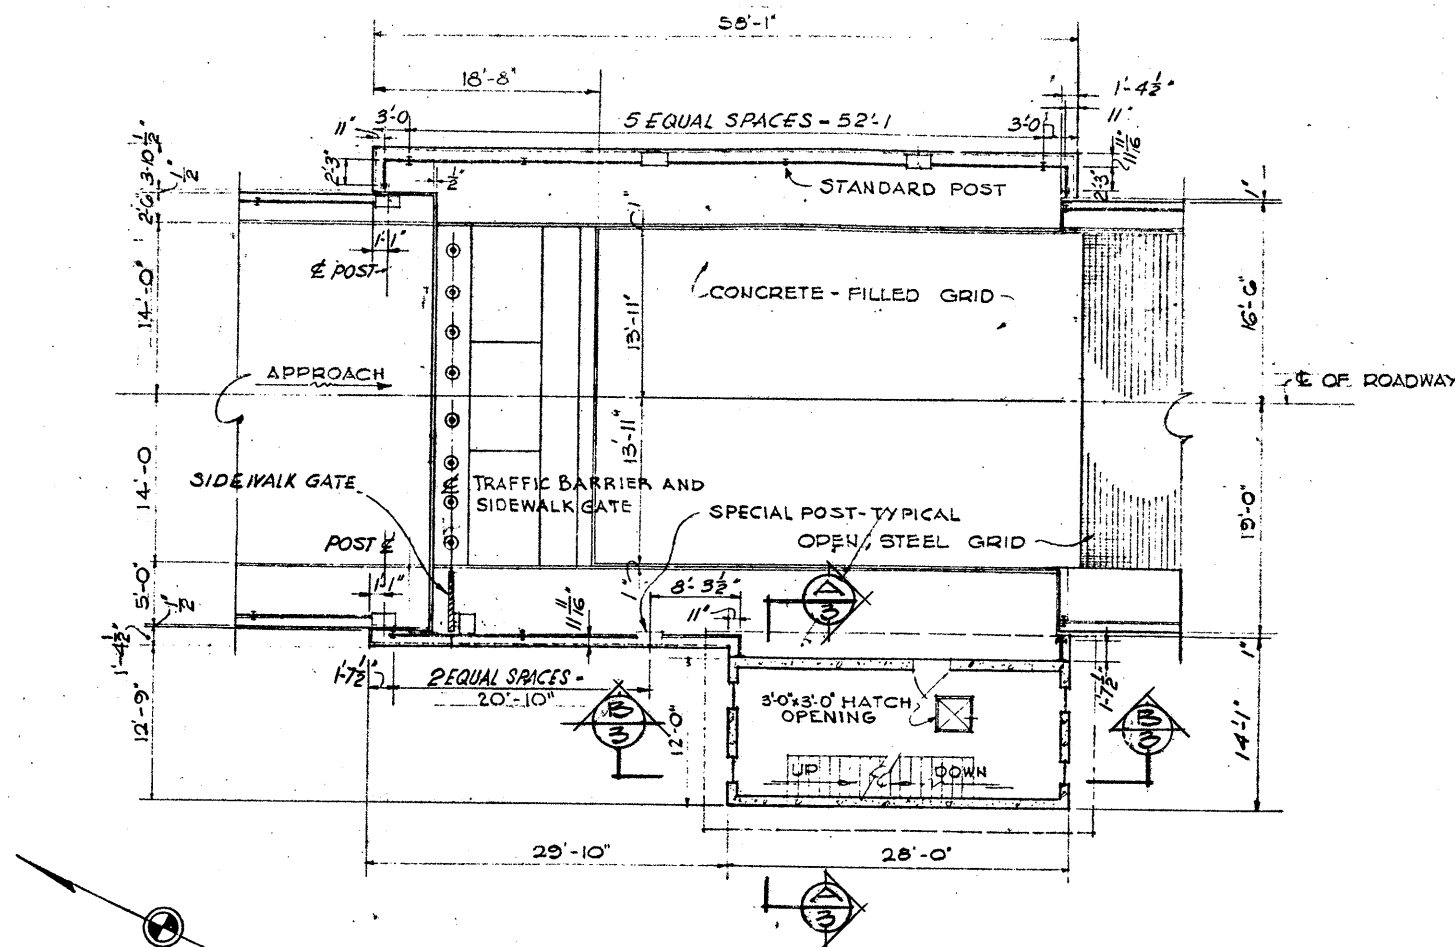


PLAN AT ROADWAY LEVEL PIER 3
SCALE: $\frac{1}{8}'' = 1'-0''$

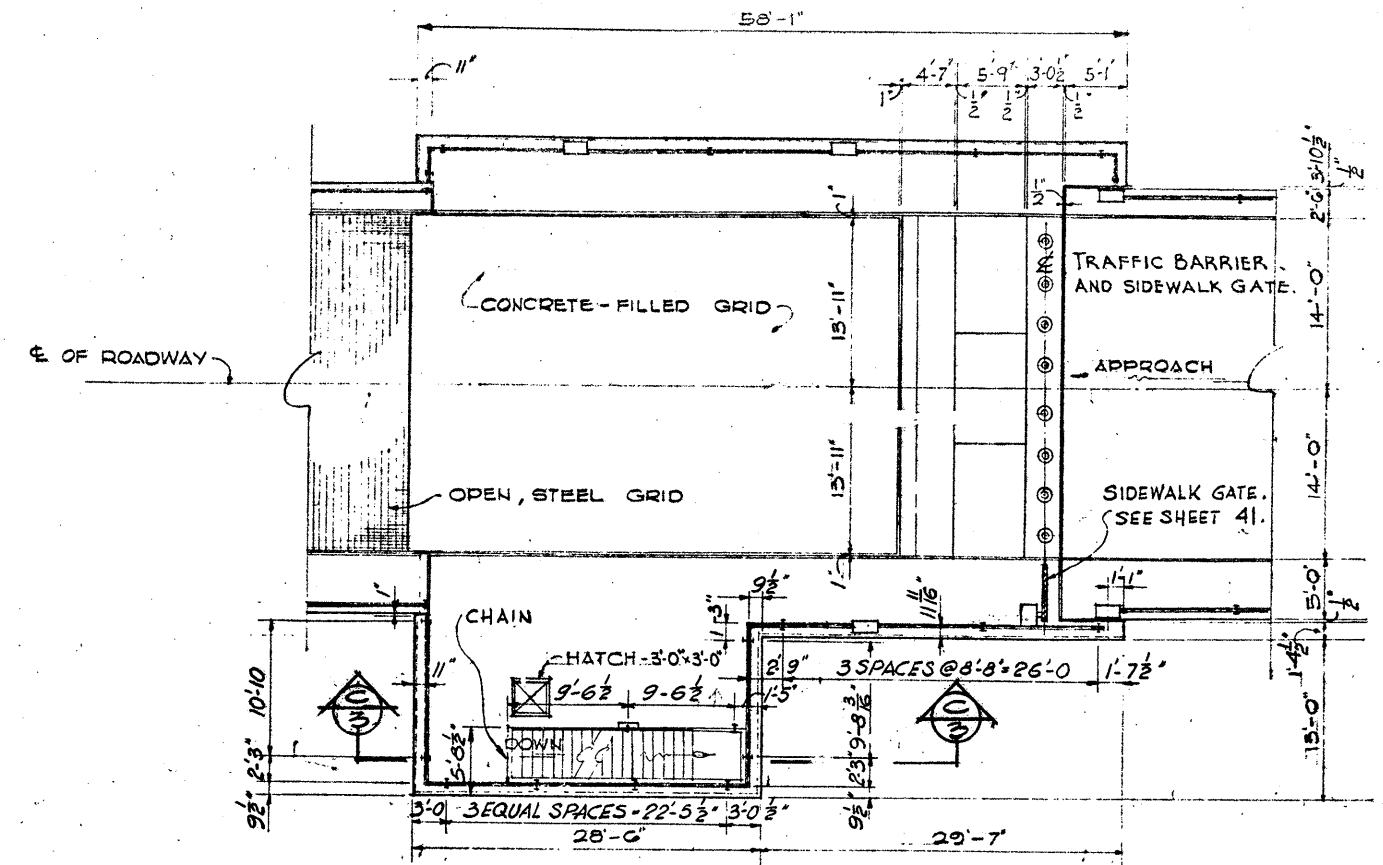


PLAN AT ROADWAY LEVEL PIER 4
SCALE: $\frac{1}{8}'' = 1'-0''$

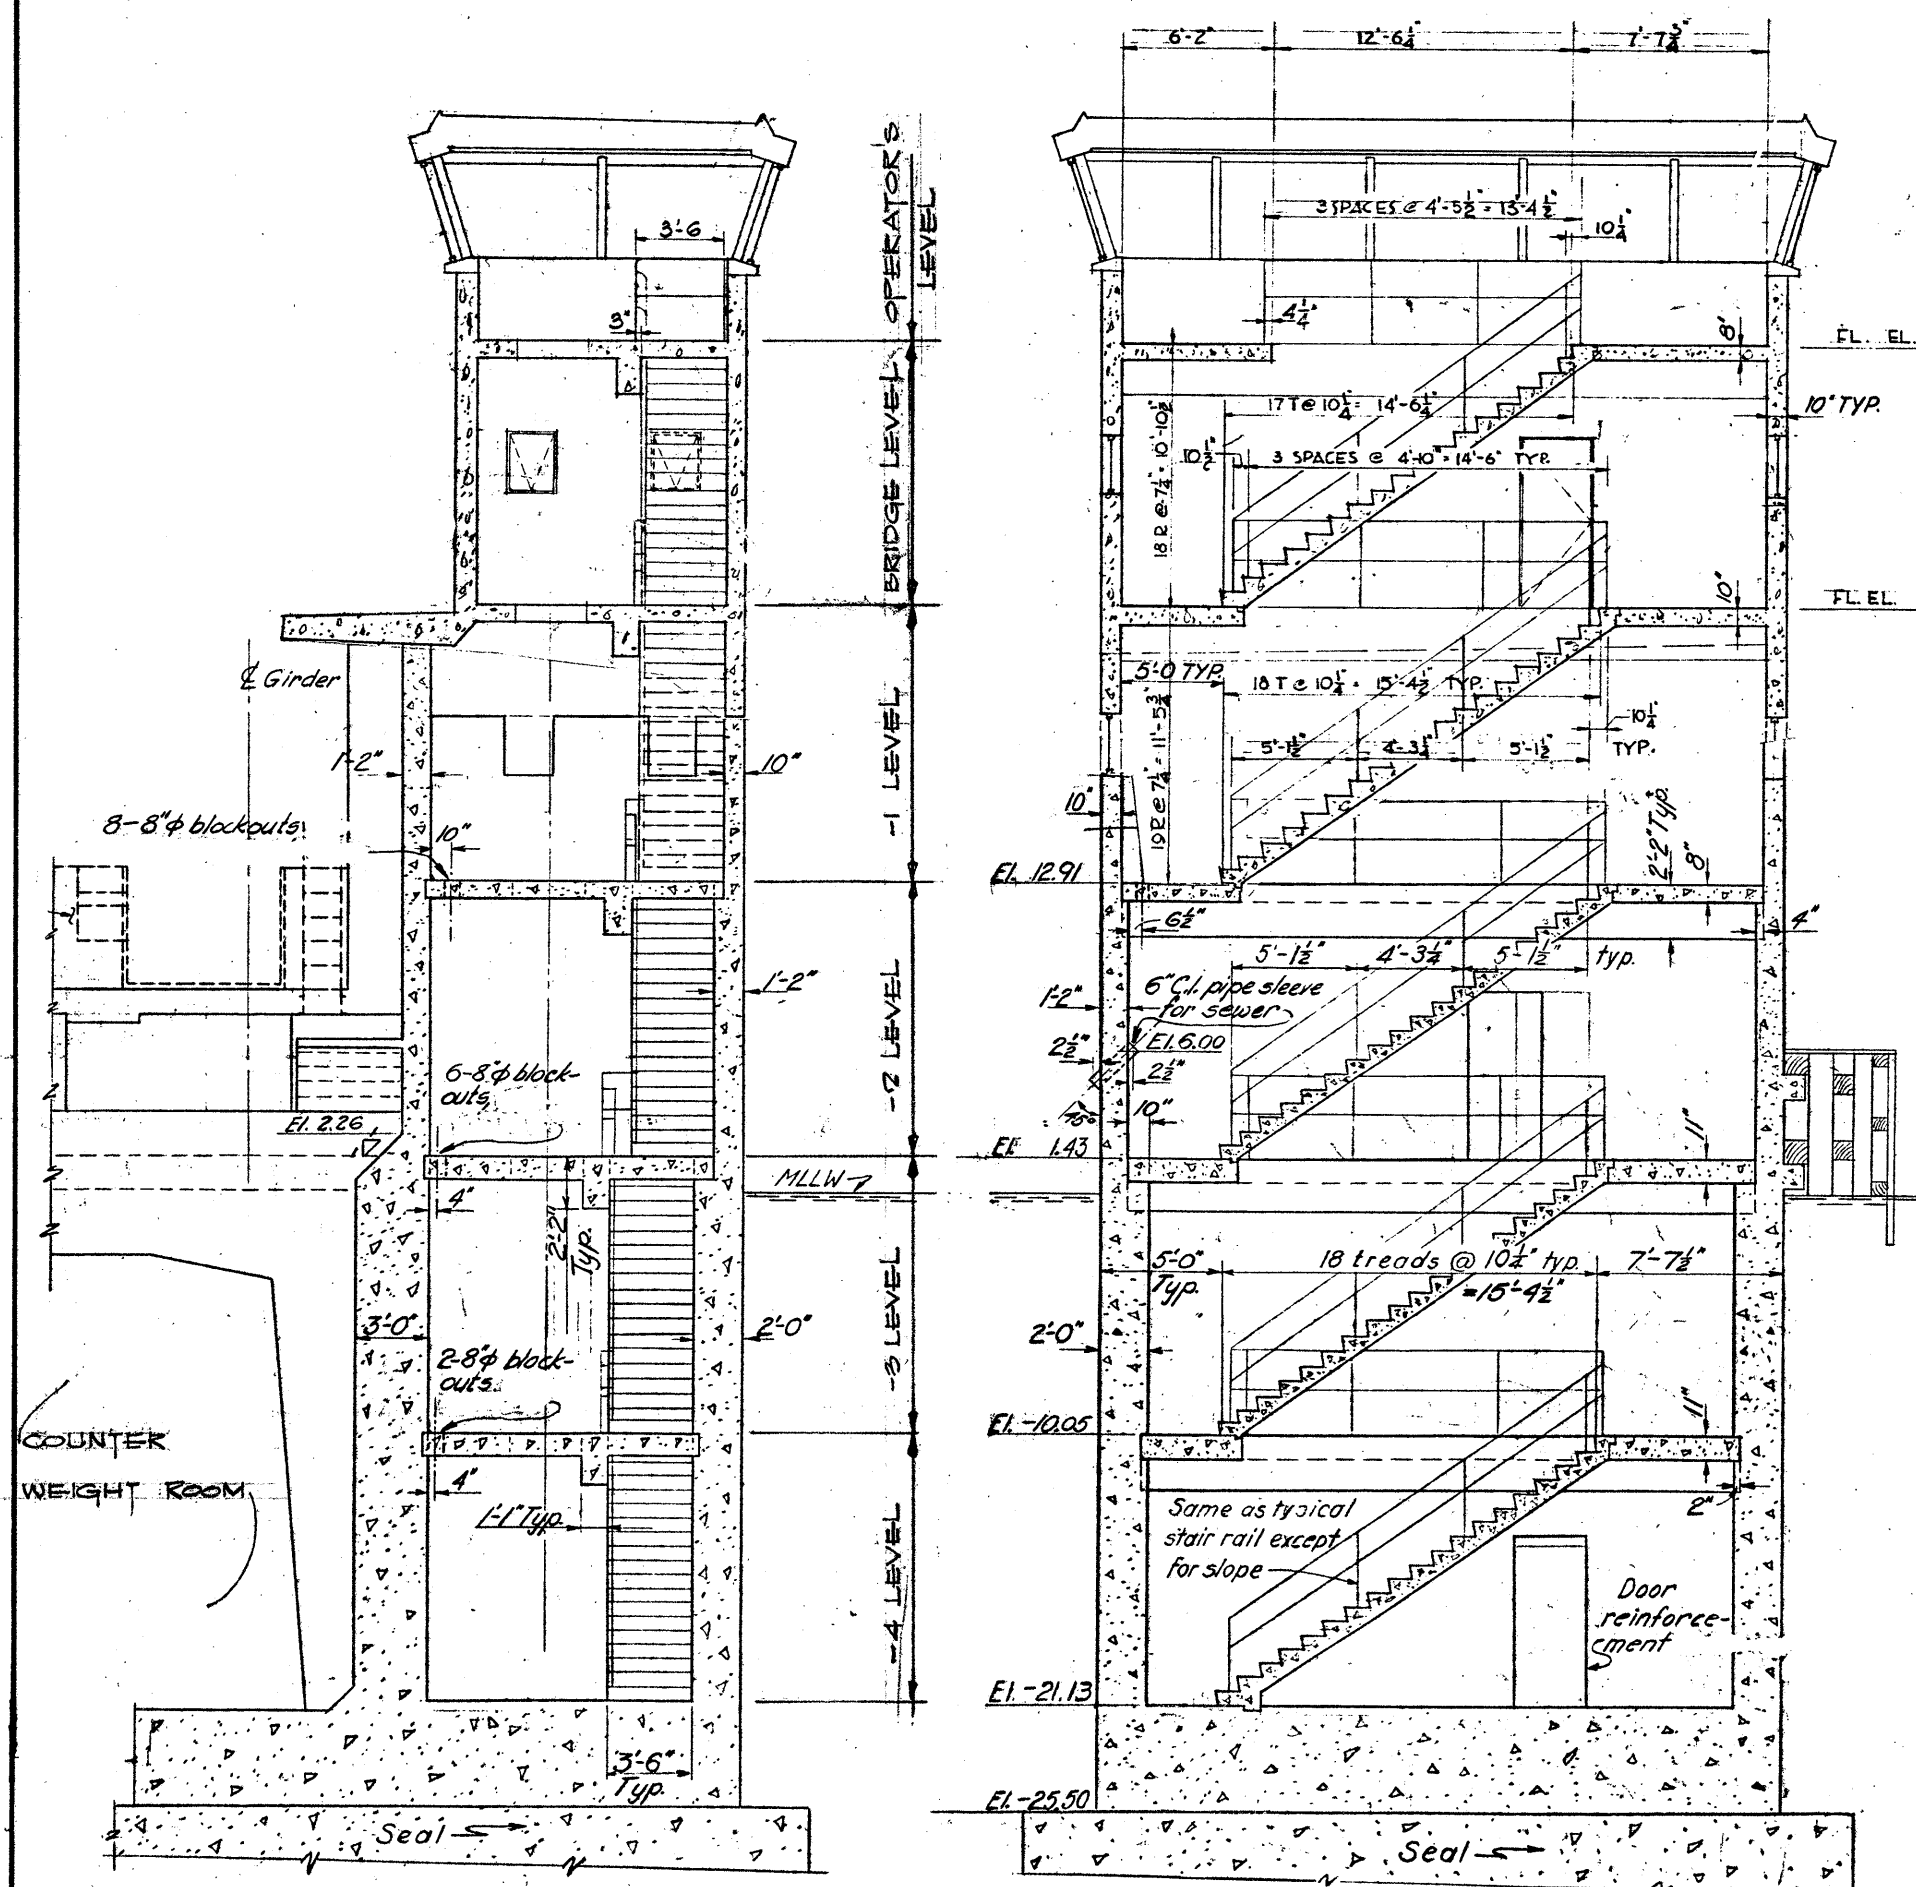

SECTION A-A

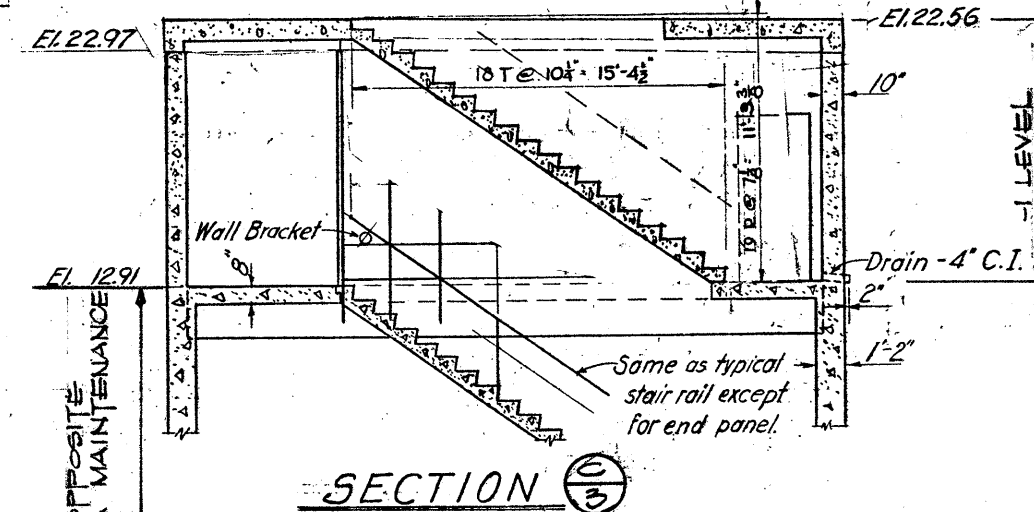

SECTION B-B

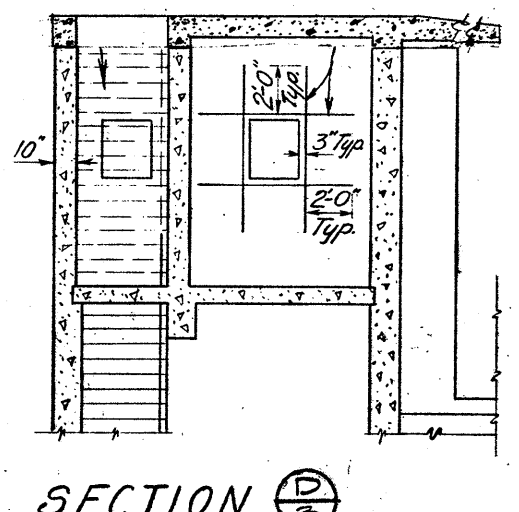

SECTION C-C

NOTE!!!

BOTH EWA AND WAIKIKI MAINTENANCE SHAFTS ARE SIMILAR BUT OPPOSITE HAND EXCEPT FOR THE -1 LEVEL. THE BRIDGE LEVEL AND OPERATOR'S LEVEL DO NOT EXIST ON THE WAIKIKI MAINTENANCE SHAFT.

WAIKIKI MAINTENANCE SHAFT
SCALE: $\frac{1}{8}'' = 1'-0''$

EWA MAINTENANCE SHAFT
SCALE: $\frac{1}{8}'' = 1'-0''$

SECTION D-D

DESIGNED BY:	SUBMITTED BY:	APPROVED BY:	JOB TITLE	SHEET TITLE	JOB NUMBER	SHEET
DRAWN BY:	Richard H. Sasaki	Mulin & Roper	PAINTING BASCULE BRIDGE	MAINTENANCE SHAFTS	H.C. 1480	3
CHECKED BY:	RECOMMENDED BY:	CHIEF, HARBORS DIVISION	HONOLULU, HAWAII			
DATE: MAR 1969	APPROVED BY:					
SCALE: AS NOTED	Gary Blair	DIRECTOR OF TRANSPORTATION				
REVISION NO.	DESCRIPTION	BY	DATE	APPROVED		

STATE OF HAWAII
DEPARTMENT OF TRANSPORTATION
HARBORS DIVISION

OF 3 SHEETS