




FED. ROAD DIST. NO.	STATE	PROJ. NO.	FISCAL YEAR	SHEET NO.	TOTAL SHEETS
HAWAII	HAW.	640A-01-74	1973	3	7

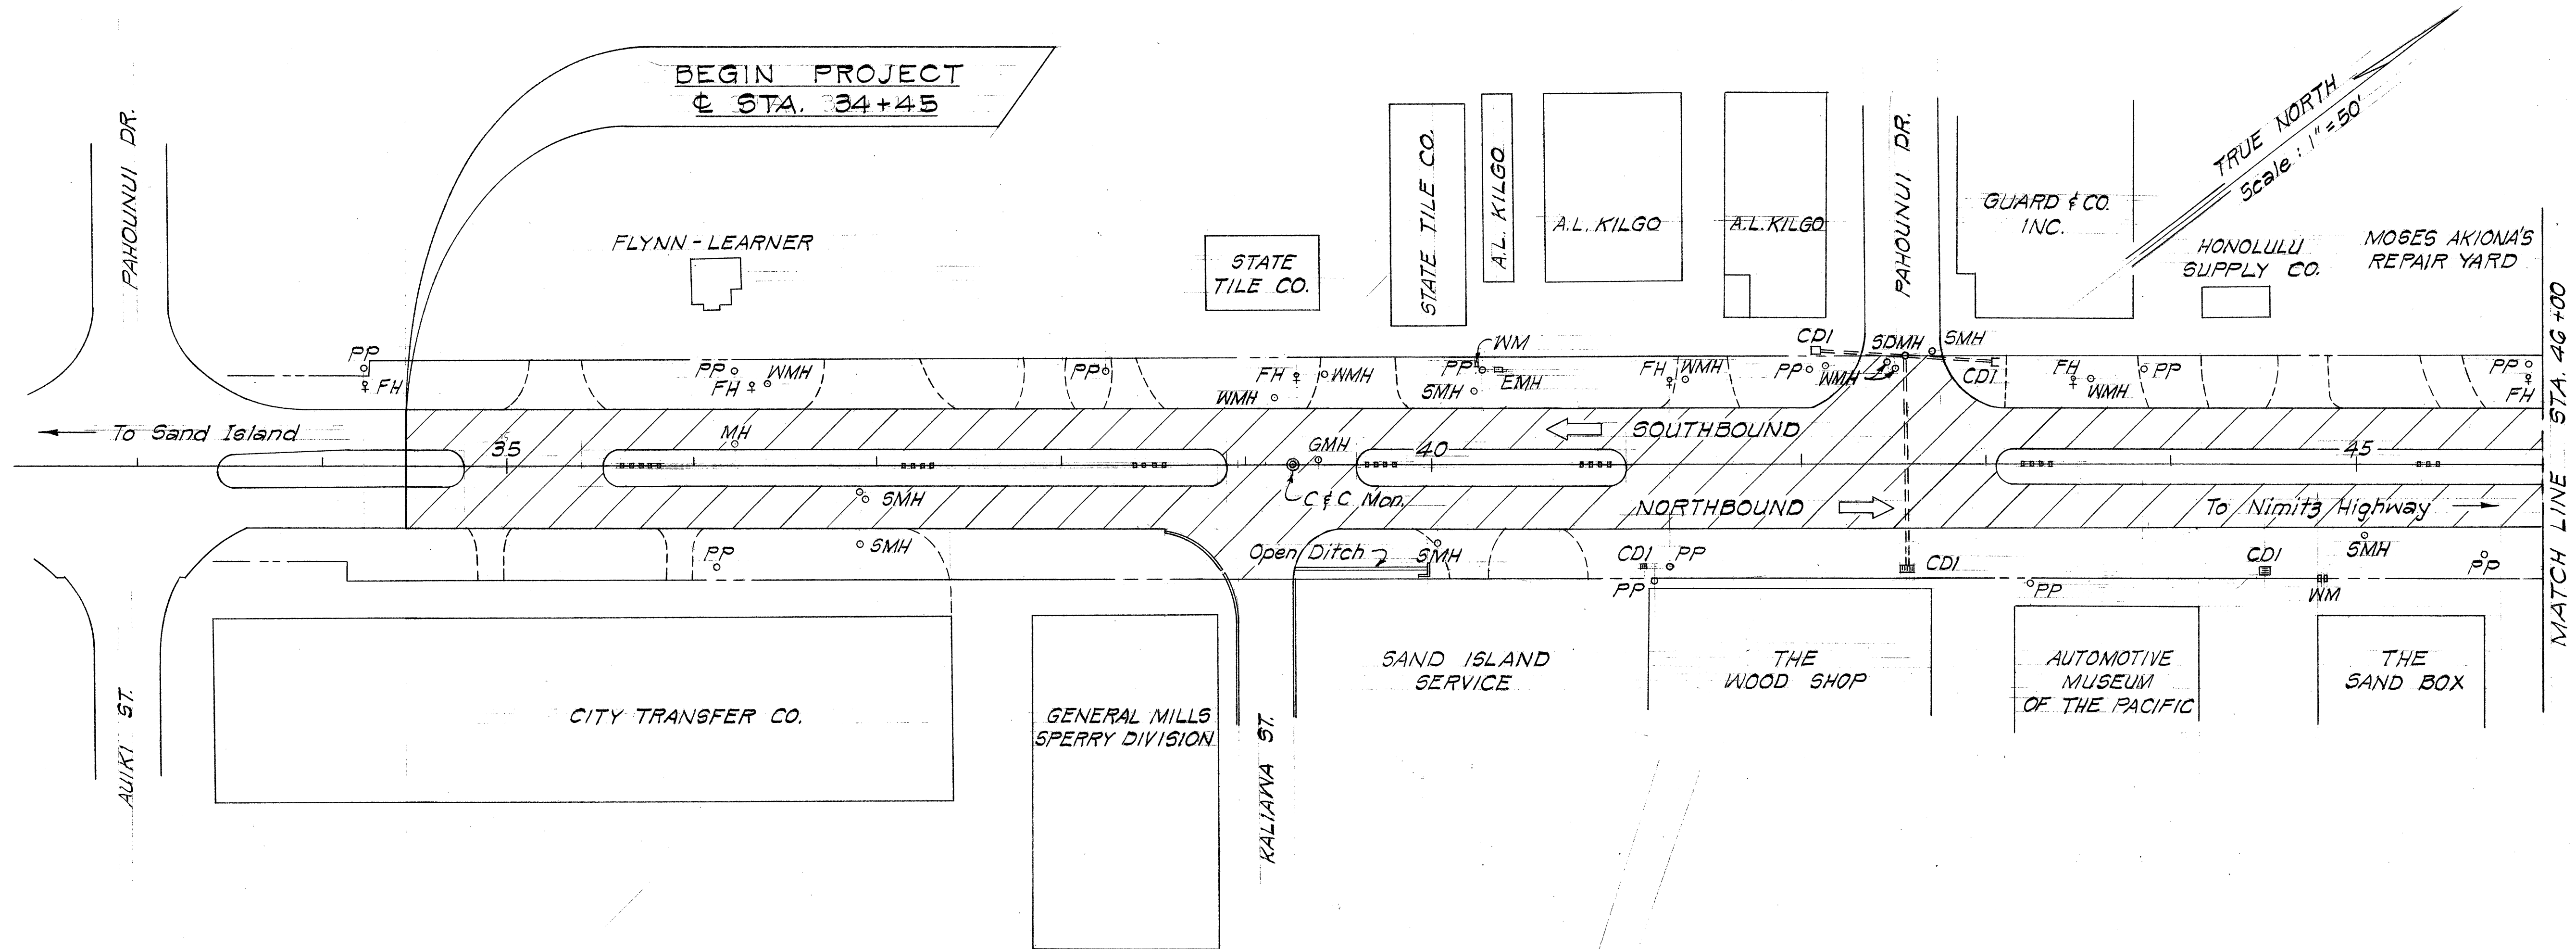

LEGEND:

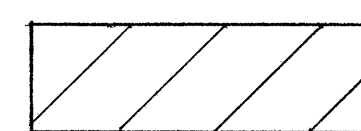

Resurfacing Area

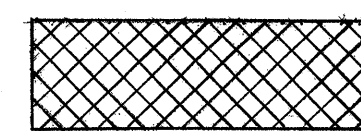

Reconstruction Area

ORIGINAL PLAN	SURVEY PLOTTED BY	DATE
NOTED BOOK	DRAWN BY	
	TRACED BY	
	QUANTITIES BY	
	CHECKED BY	

STATE OF HAWAII DEPARTMENT OF TRANSPORTATION HIGHWAYS DIVISION	
ROADWAY PLANS	
RESURFACING A PORTION OF SAND ISLAND ACCESS ROAD	
Project No. 640A-01-74	
Scale: 1"=50'	Date: Nov., 1973
SHEET No. 1 OF 2 SHEETS	

