
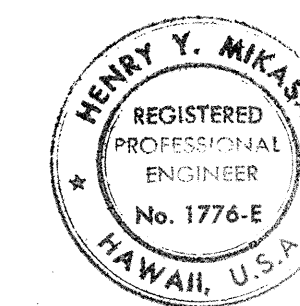


REPAIRED PILE SCHEDULE #2

PILE NO.	CATWALK "B"		CATWALK "C"		CATWALK "D"	
	DEPTH BELOW M.L.L.W. (X')	COMMENTS	DEPTH BELOW M.L.L.W. (X')	COMMENTS	DEPTH BELOW M.L.L.W. (X')	COMMENTS
1	5'		5'		6'	
2	5'		5'		6'	
3	5'		5'		6'	
4	5'		5'		6'	
5	5'		5'		6'	
6	4'		4'		4'	
7	5'		4'		4'	
8	4'		4'		5'	
9	5'		5'		5'	
10	5'		5'		5'	
11	5'		5'		5'	
12	5'		5'		5'	
13	5'		5'		5'	
14	5'		MISSING	NO PILE FROM +1 TO -28' 2' STUB STICKING ABOVE SILT	5'	
15	5'		5'		5'	
16	4'		4'		4'	
17	4'		5'		4'	
18	4'		4'		4'	
19	4'		4'		4'	

* REFER SHEET 2 FOR DIMENSION

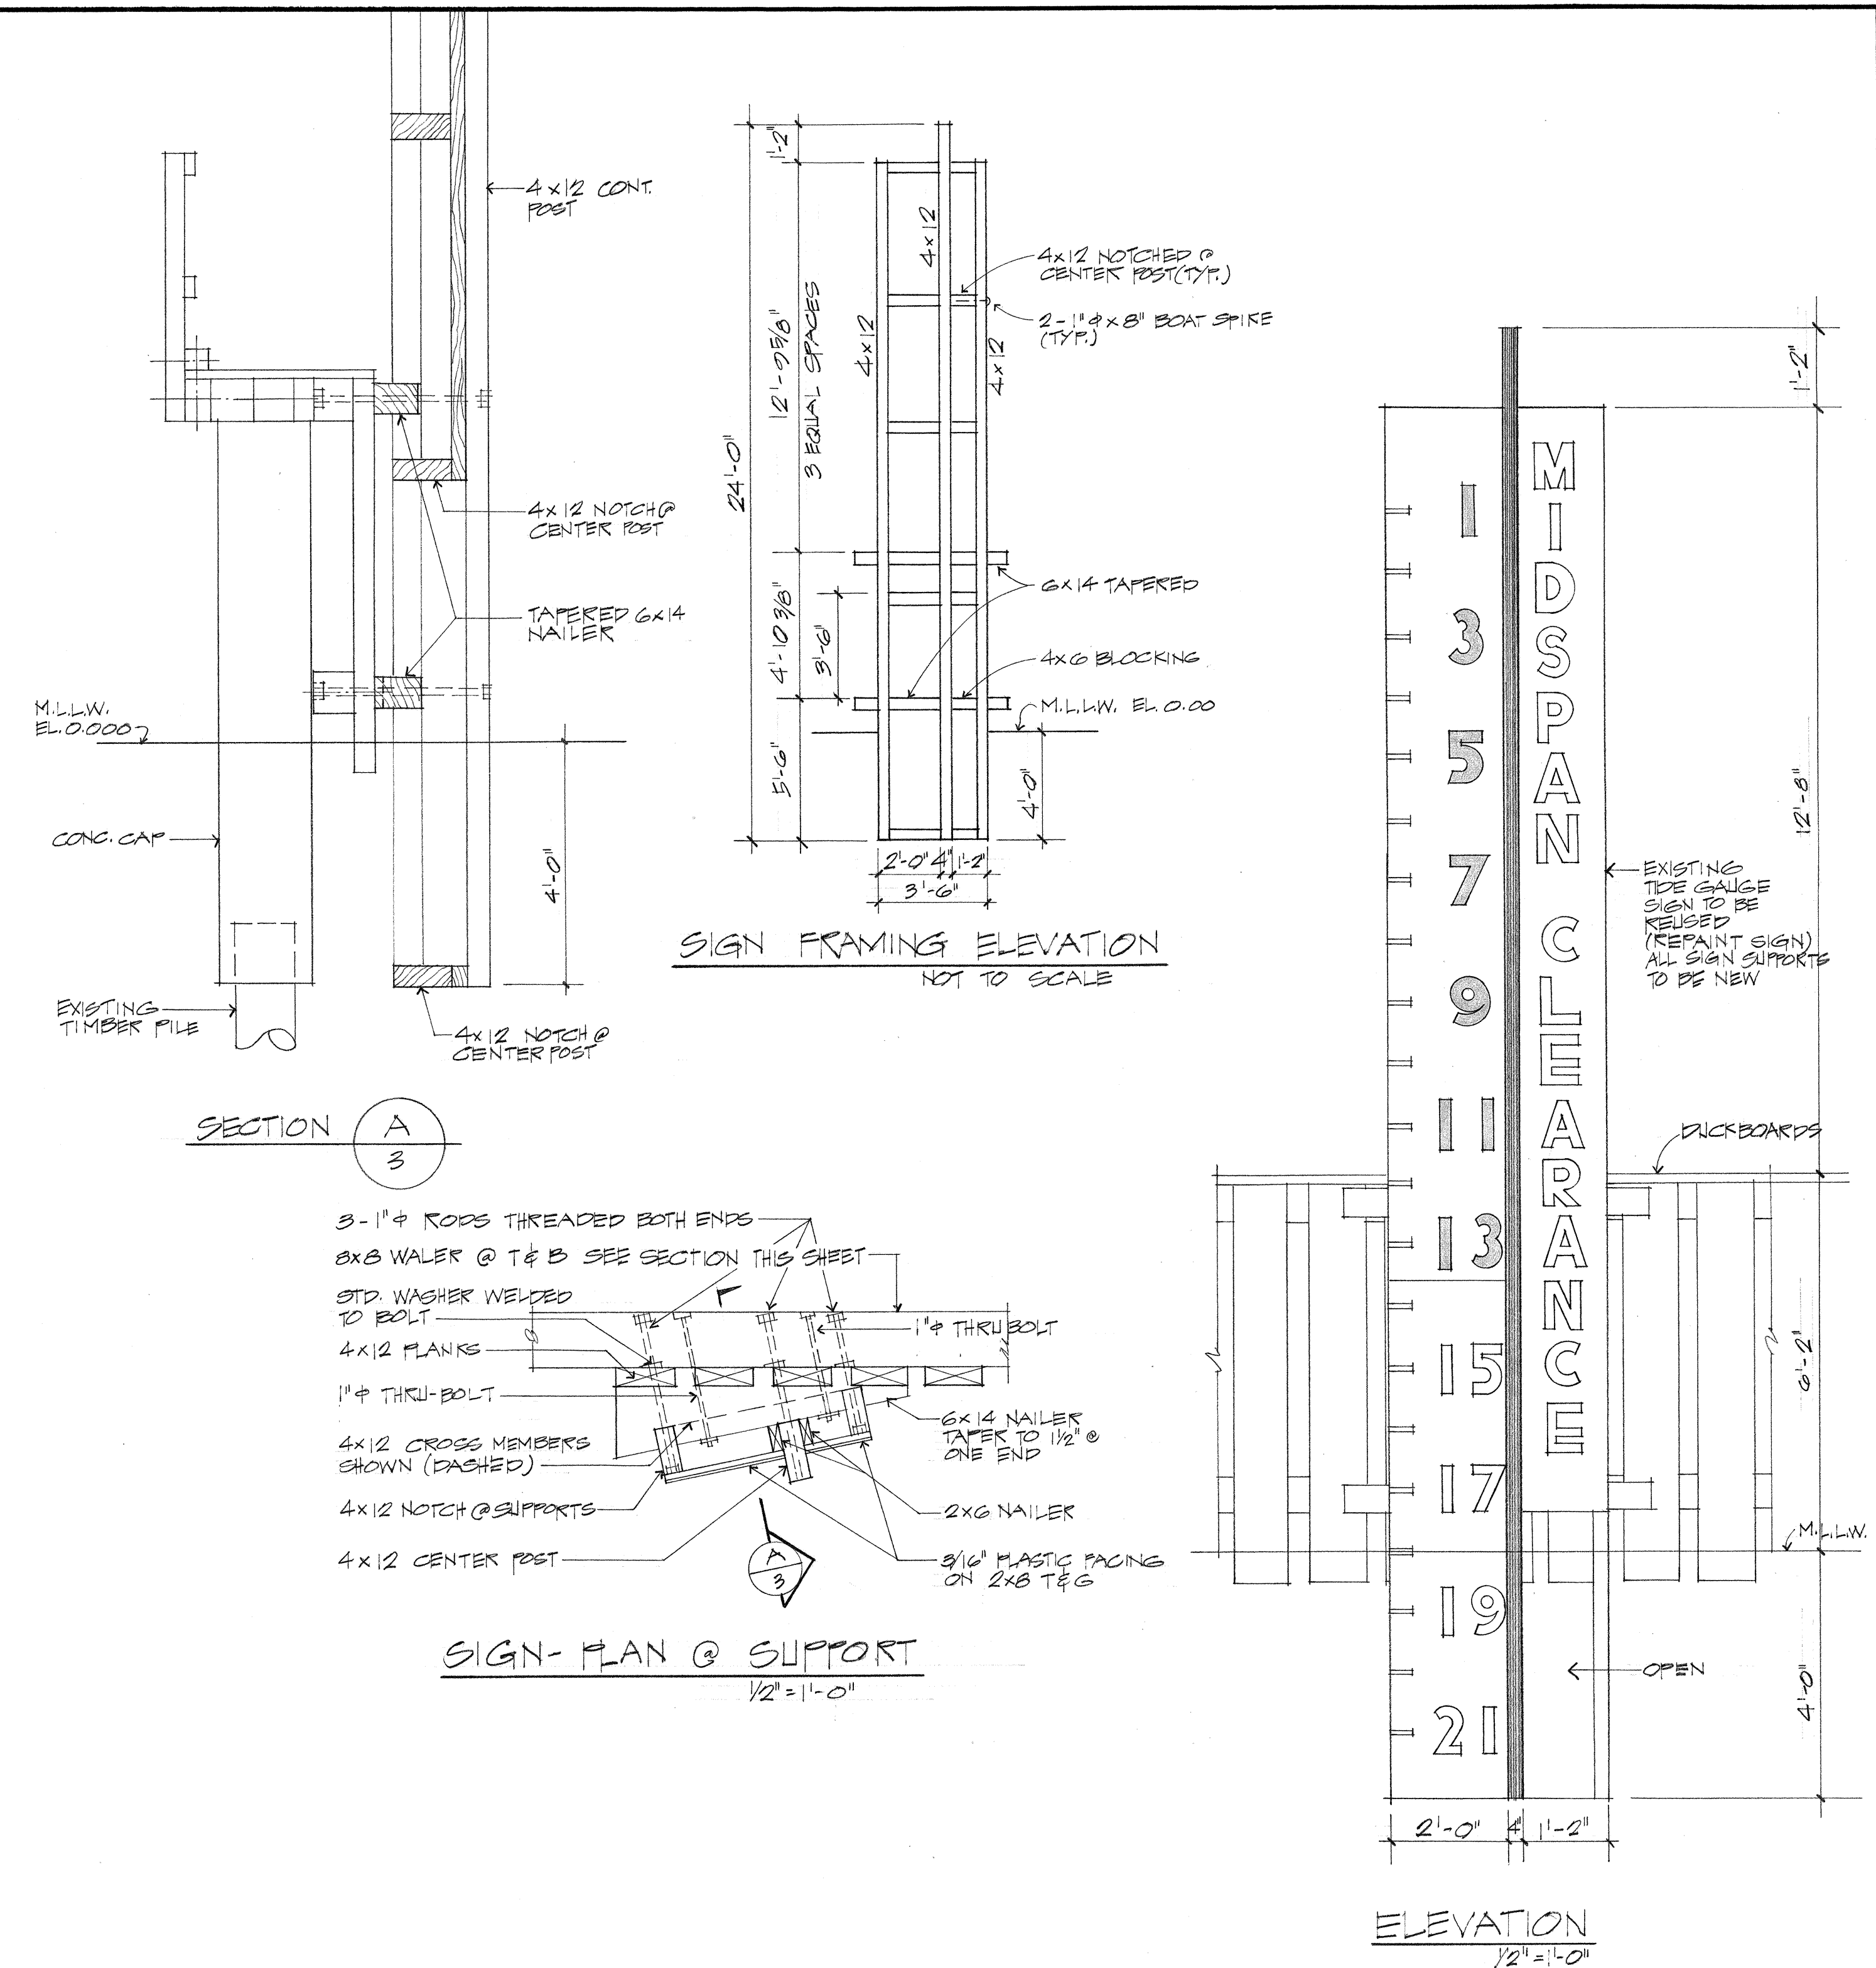

THIS WORK WAS PREPARED BY ME OR UNDER MY SUPERVISION.
Henry Y. Mikasa
 Signature

REV	DATE	DESCRIPTION	BY	APPROVED
STATE OF HAWAII DEPARTMENT OF TRANSPORTATION HARBORS DIVISION				
JOB TITLE REPAIRS TO BASCULE BRIDGE-DOLPHIN, PILES & CATWALKS HONOLULU, HAWAII				
SHEET TITLE REPAIRED PILE SCHEDULE & SIGN DETAILS				
DESIGNED BY: H.Y.M.	APPROVED BY: <i>Michael A. Linares</i>		SHEET	
DRAWN BY: FF	CHIEF, HARBORS DIVISION		3	
CHECKED BY: H.Y.M.	JOB NUMBER		OF 3 SHEETS	
DATE: 4/21/76	H.C. 1254			
SCALE: AS NOTED				